


>>>>CAUTION<<<<
CALL BEFORE YOU DIG!

NOT LESS THAN TWO OR MORE THAN TEN BUSINESS DAYS PRIOR TO COMMENCING EXCAVATION OR DEMOLITION, SECURE THE SERVICES OF A COMMERCIAL UNDERGROUND UTILITIES LOCATOR SERVICE TO IDENTIFY BELOW-GROUND IMPROVEMENTS THAT MAY NOT BE INDICATED ON THE DRAWINGS. FOR IRRIGATION SYSTEMS, CALL SEATTLE PARKS PLUMBING SHOP (206 684 7070)

>>800 424 5555<<

RECORD DRAWINGS

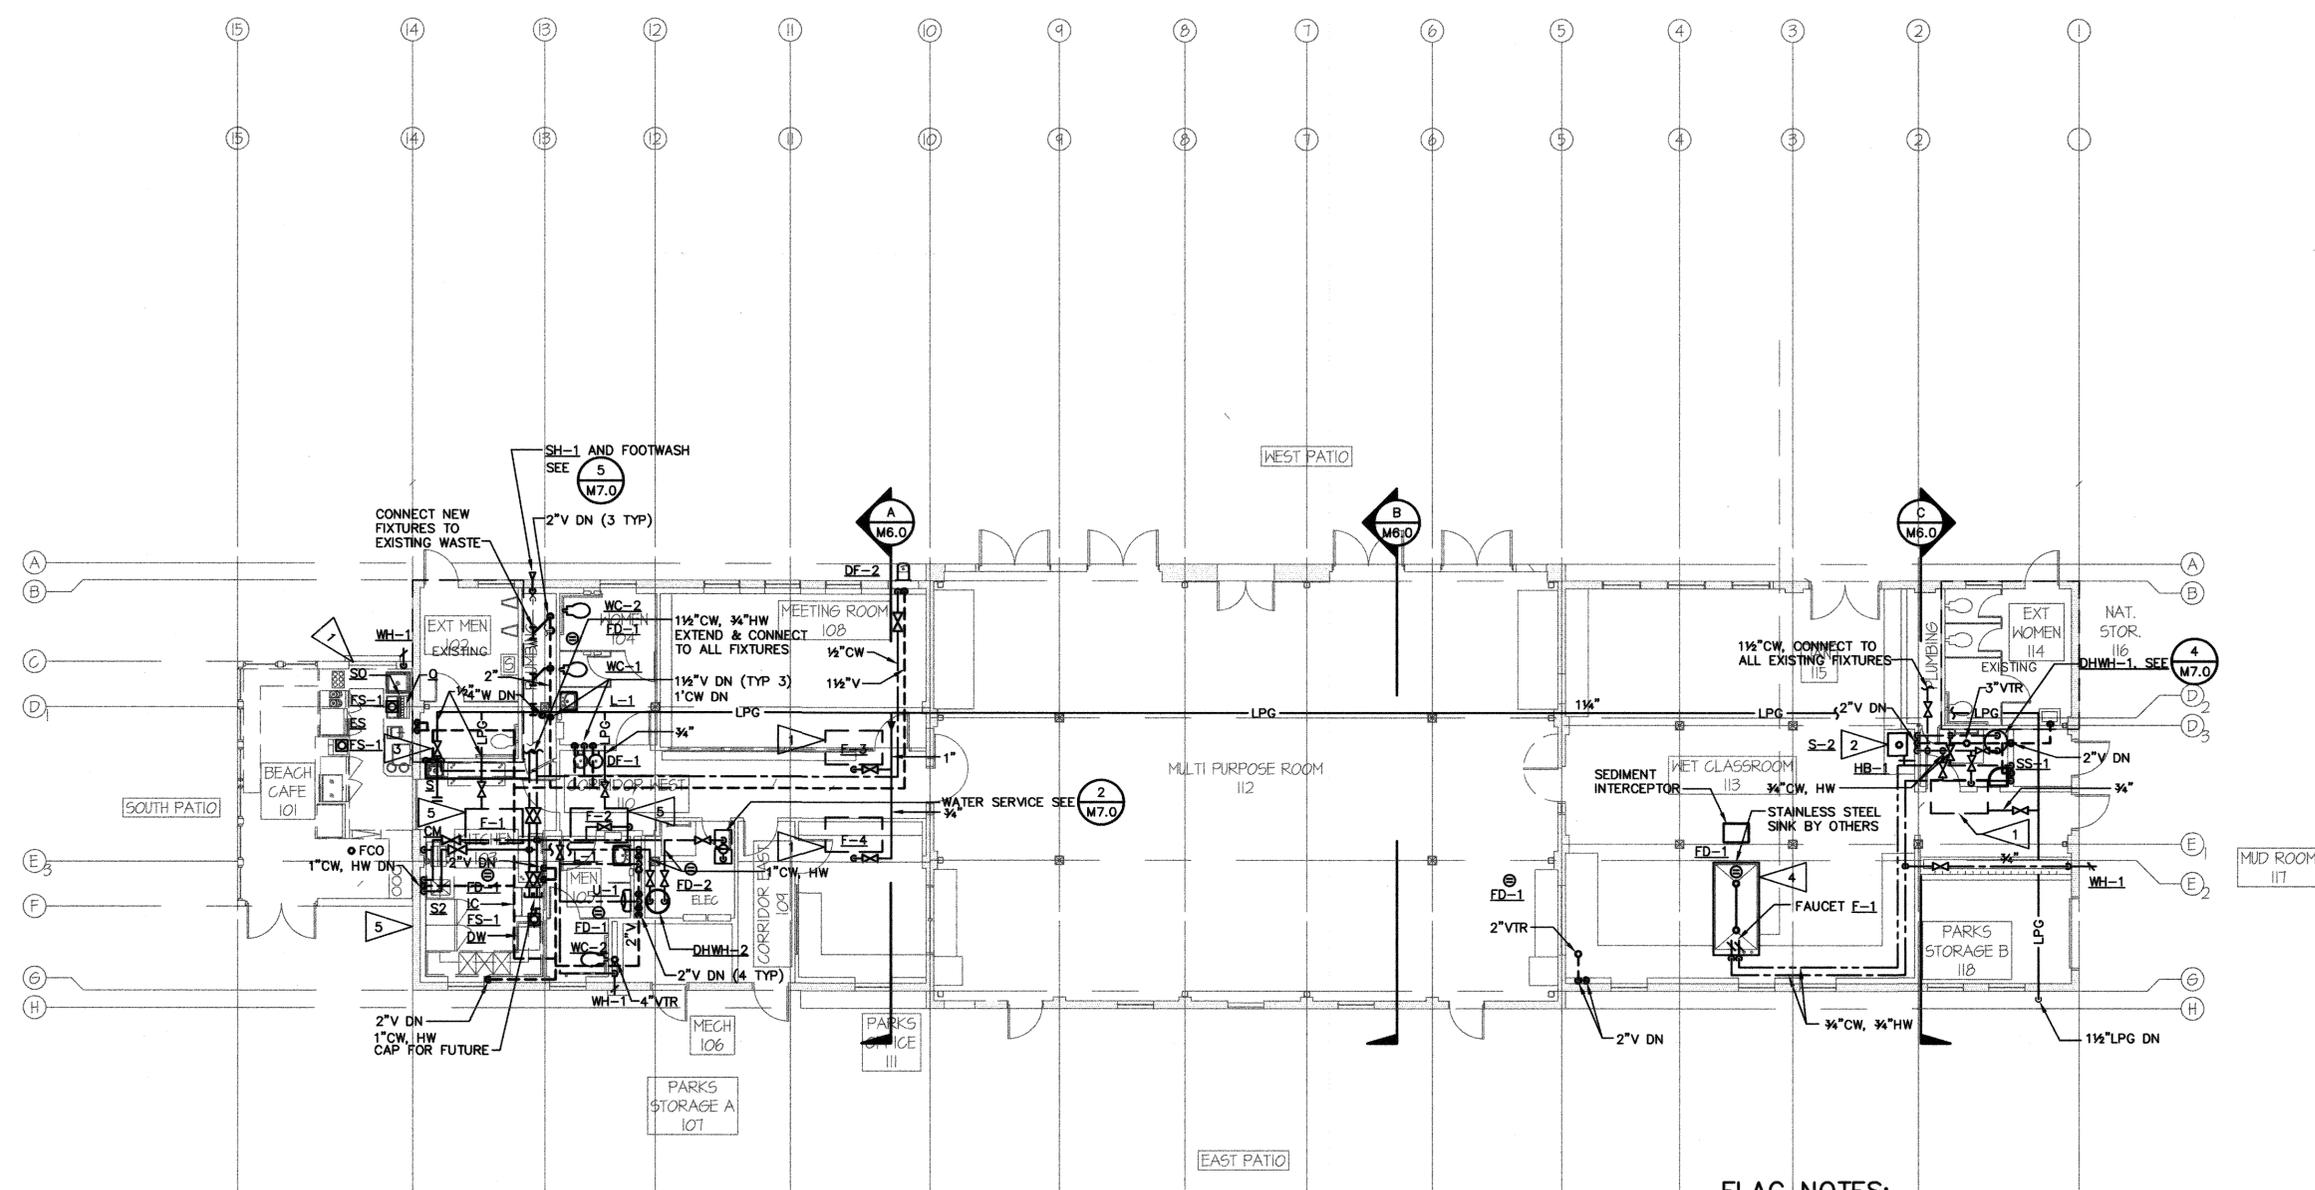

3		
2		
1	RECORD DRAWING	091304
NO.	REVISION - AS BUILT	DATE

RECORD DRAWING
 REVIEWED: PARK ENGINEER DATE
 All work done in accordance with the City of Seattle Standard Plans and Specifications in effect on the date shown above, and supplemented by Special Provisions.

BOLA
 ARCHITECTURE + PLANNING

BOLA ARCHITECTURE + PLANNING
 320 TERRY AVENUE NORTH
 SEATTLE, WASHINGTON 98109
 (206) 447-4749
 (206) 447-6462



GOLDEN GARDENS BATHHOUSE

RENOVATION

PLUMBING & PIPING PLAN

DESIGNED JG	DATE 13 SEPTEMBER 04
DRAWN MWS	DESIGN REVIEW
CHECKED JG	
120412, 120640,	
ORDINANCE NO. 120973	SHEET 49 OF 60
CONTRACT NO. 1647	
SCALE 1/8" = 1'-0"	M3.0

- FLAG NOTES:**
- 1 PROVIDE CONDENSATE DRAINAGE AND LPG PIPING FOR FURNACE. PROVIDE CONDENSATE DRAIN PIPING TO NEAREST MECHANICAL FLOOR DRAIN OR SERVICE SINK AS REQUIRED.
 - 2 PROVIDE WITH SEDIMENT TRAP.
 - 3 INSTALL PLUGGED 1 1/4" VALVE FOR LPG CONNECTION TO FUTURE KITCHEN EQUIPMENT.
 - 4 STAINLESS STEEL TUB. REFER TO ARCHITECTURAL.
 - 5 LOCATION SHOWN FOR "ROUGH IN" ONLY FOR KITCHEN AREA. (TYP).



Plumbing and Piping Plan
 SCALE: 1/8" = 1'-0"

RECORD DRAWING
 THIS DRAWING WAS PREPARED FROM INFORMATION SUPPLIED BY THE CONTRACTOR AND IS SUBJECT TO FIELD VERIFICATION

