


>>>>CAUTION<<<<
CALL BEFORE YOU DIG!

NOT LESS THAN TWO OR MORE THAN TEN BUSINESS DAYS
 PRIOR TO COMMENCING EXCAVATION OR DEMOLITION,
 SECURE THE SERVICES OF A COMMERCIAL UNDERGROUND
 UTILITIES LOCATOR SERVICE TO IDENTIFY BELOW-GROUND
 IMPROVEMENTS THAT MAY NOT BE INDICATED ON THE
 DRAWINGS. FOR IRRIGATION SYSTEMS, CALL SEATTLE
 PARKS PLUMBING SHOP (206 684 7070)

>>800 424 5555<<

RECORD DRAWINGS

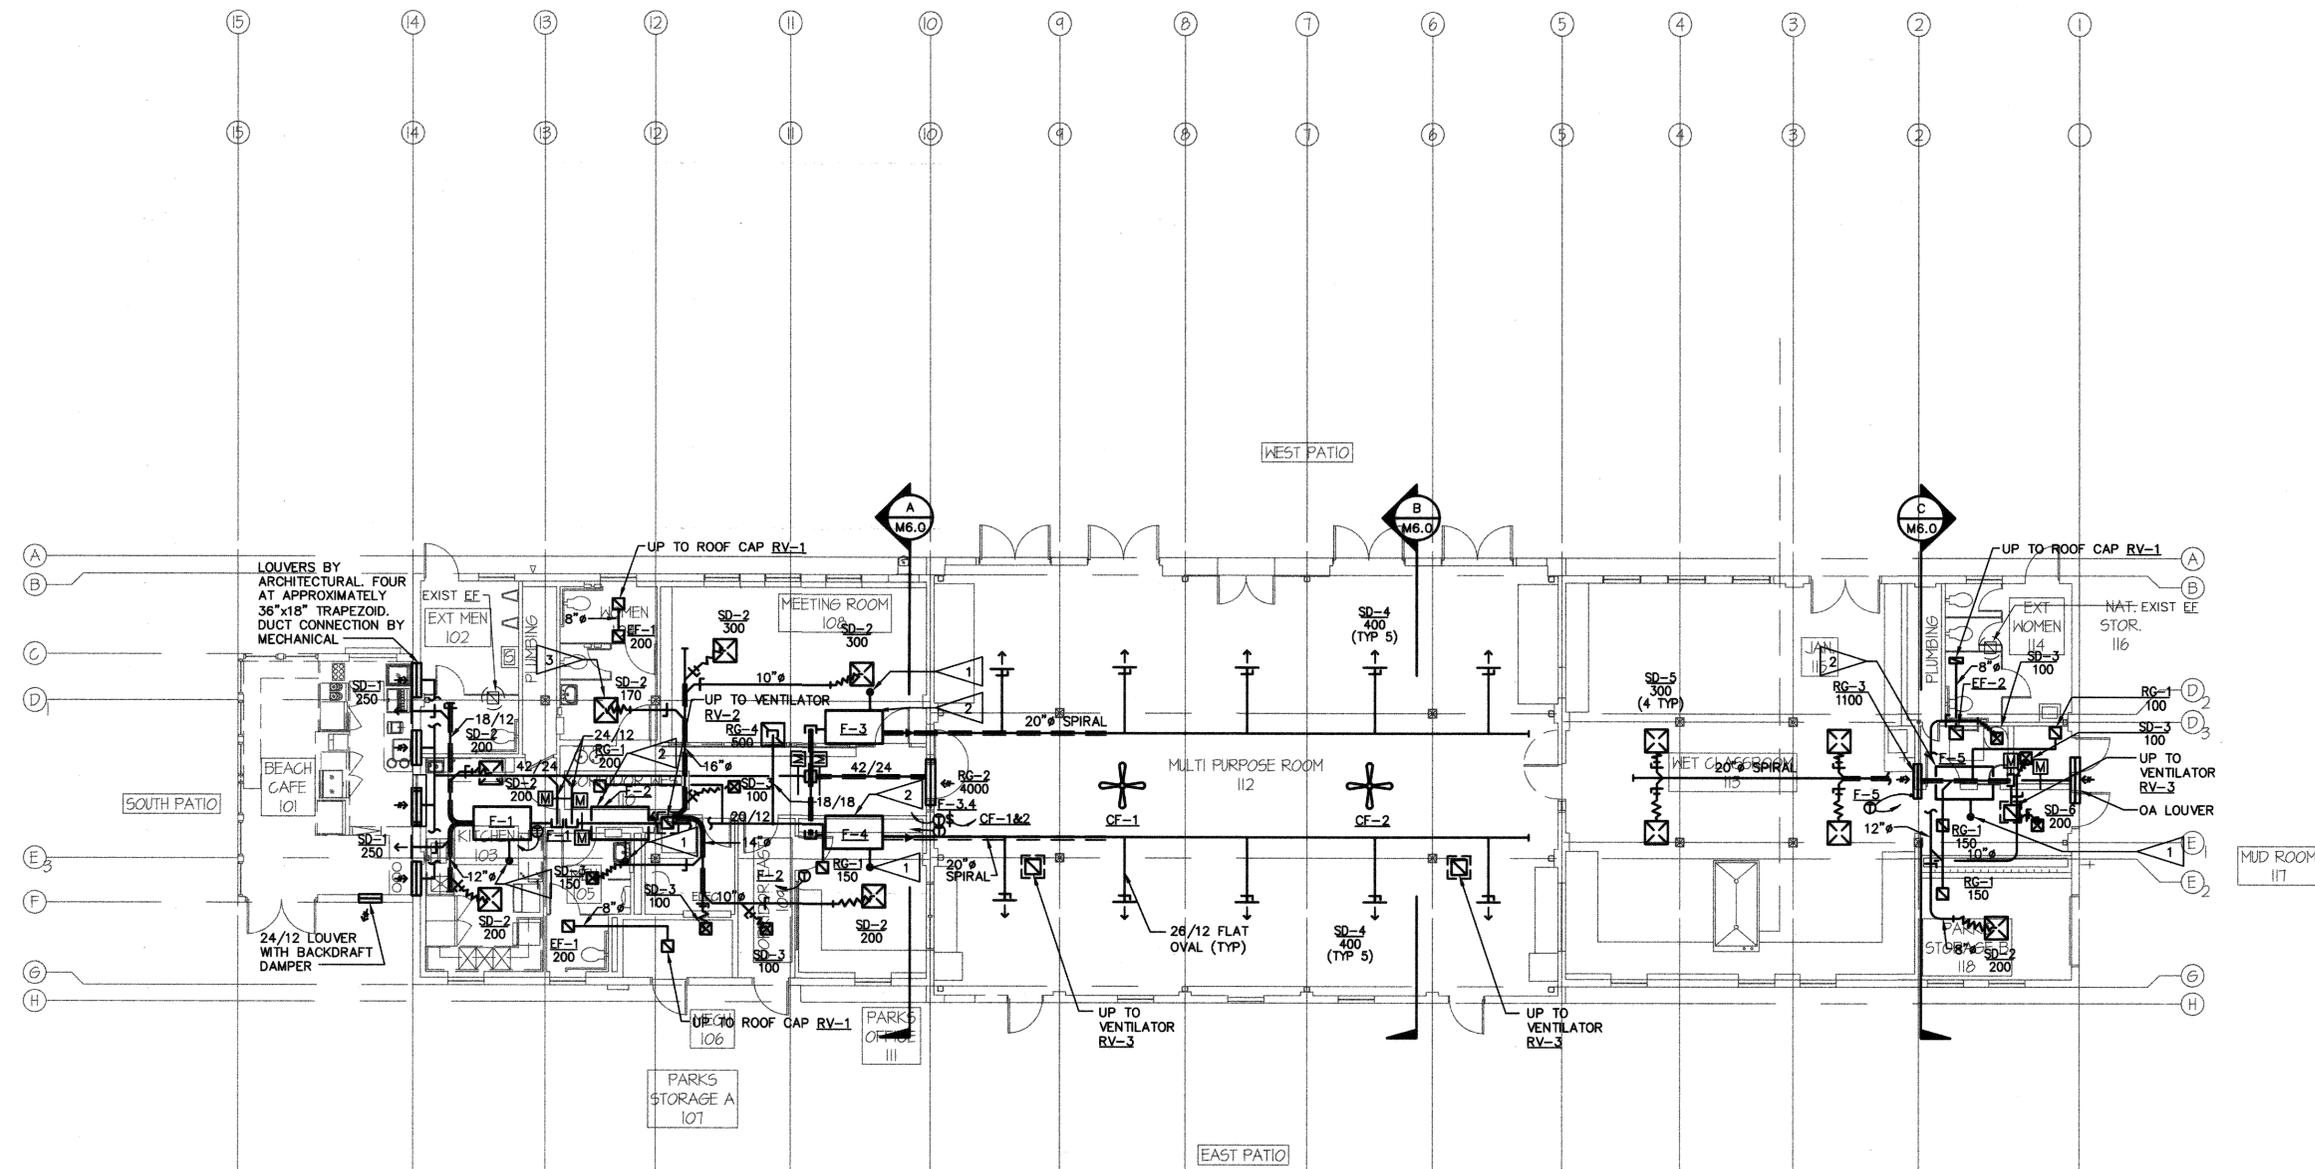

FLAG NOTE:


- 1 FURNACE COMBUSTION AND COMBUSTION AIR VENT UP.
- 2 FOR AIR FLOW DIAGRAM, SEE (3) (M6.0)
- 3 SEE (3) (M7.0) TYPICAL



HVAC Floor Plan

SCALE: 1/8" = 1'-0"

RECORD DRAWING
 THIS DRAWING WAS
 PREPARED FROM
 INFORMATION SUPPLIED
 BY THE CONTRACTOR
 AND IS SUBJECT TO
 FIELD VERIFICATION

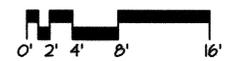


3		
2		
1	RECORD DRAWING	091304
NO.	REVISION - AS BUILT	DATE

RECORD DRAWING

REVIEWED: _____ DATE _____
 PARK ENGINEER

All work done in accordance with the City of Seattle Standard
 Plans and Specifications in effect on the date shown above, and
 supplemented by Special Provisions.

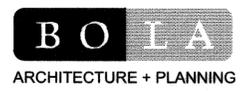

BOLA ARCHITECTURE + PLANNING
 320 TERRY AVENUE NORTH
 SEATTLE, WASHINGTON 98109
 (206) 447-4749
 (206) 447-6462



GOLDEN GARDENS BATHHOUSE

RENOVATION

HVAC PLAN

DESIGNED JG	DATE 13 SEPTEMBER 04
DRAWN MWS	DESIGN REVIEW
CHECKED JG	
120412, 120640, ORDINANCE NO. 120973	SHEET 50 OF 60
CONTRACT NO. 1647	
SCALE 1/8" = 1'-0"	M4.0

1894.4