

>>>>CAUTION<<<<
CALL BEFORE YOU DIG!

NOT LESS THAN TWO OR MORE THAN TEN BUSINESS DAYS PRIOR TO COMMENCING EXCAVATION OR DEMOLITION, SECURE THE SERVICES OF A COMMERCIAL UNDERGROUND UTILITIES LOCATOR SERVICE TO IDENTIFY BELOW-GROUND IMPROVEMENTS THAT MAY NOT BE INDICATED ON THE DRAWINGS. FOR IRRIGATION SYSTEMS, CALL SEATTLE PARKS PLUMBING SHOP (206 684 7070).

>>800 424 5555<<

PLAN NOTES

- ① TELECOMMUNICATIONS BACKBOARD
- ② PROVIDE SURFACE MOUNTED CAST ALUMINUM BOX SUPPLIED BY CONDUIT IN FLOOR SLAB.
- ③ FLUSH MOUNT RECEPTACLE IN EXTERIOR WALL.

AS-BUILTS

TRES WEST ENGINEERS, INC.
 3708 SOUTH 42ND STREET, SUITE 601
 TACOMA, WA 98409-7915
 TELEPHONE (252) 472 9900
 FAX (252) 472 9409

3		
2		
1		
NO.	REVISION - AS BUILT	DATE

RECORD DRAWING
 REVIEWED: PARK ENGINEER DATE

All work done in accordance with the City of Seattle Standard Plans and Specifications in effect on the date shown above, and supplemented by Special Provisions.

BOLA
 ARCHITECTURE + PLANNING

BOLA ARCHITECTURE + PLANNING
 320 TERRY AVENUE NORTH
 SEATTLE, WASHINGTON 98109
 (206) 447-4749
 (206) 447-6462





GOLDEN GARDENS BATHHOUSE

RENOVATION

ELECTRICAL POWER FLOOR PLANS

DESIGNED EWH	DATE 27 AUGUST 03
DRAWN GMG	DESIGN REVIEW
CHECKED EWH	
ORDINANCE NO. 120412, 120640, 120973	SHEET 56 OF 60
CONTRACT NO.	E2.0
SCALE 1/8" = 1'-0"	1895

ELECTRICAL POWER FLOOR PLAN
 SCALE: 1/8" = 1'-0"

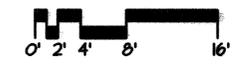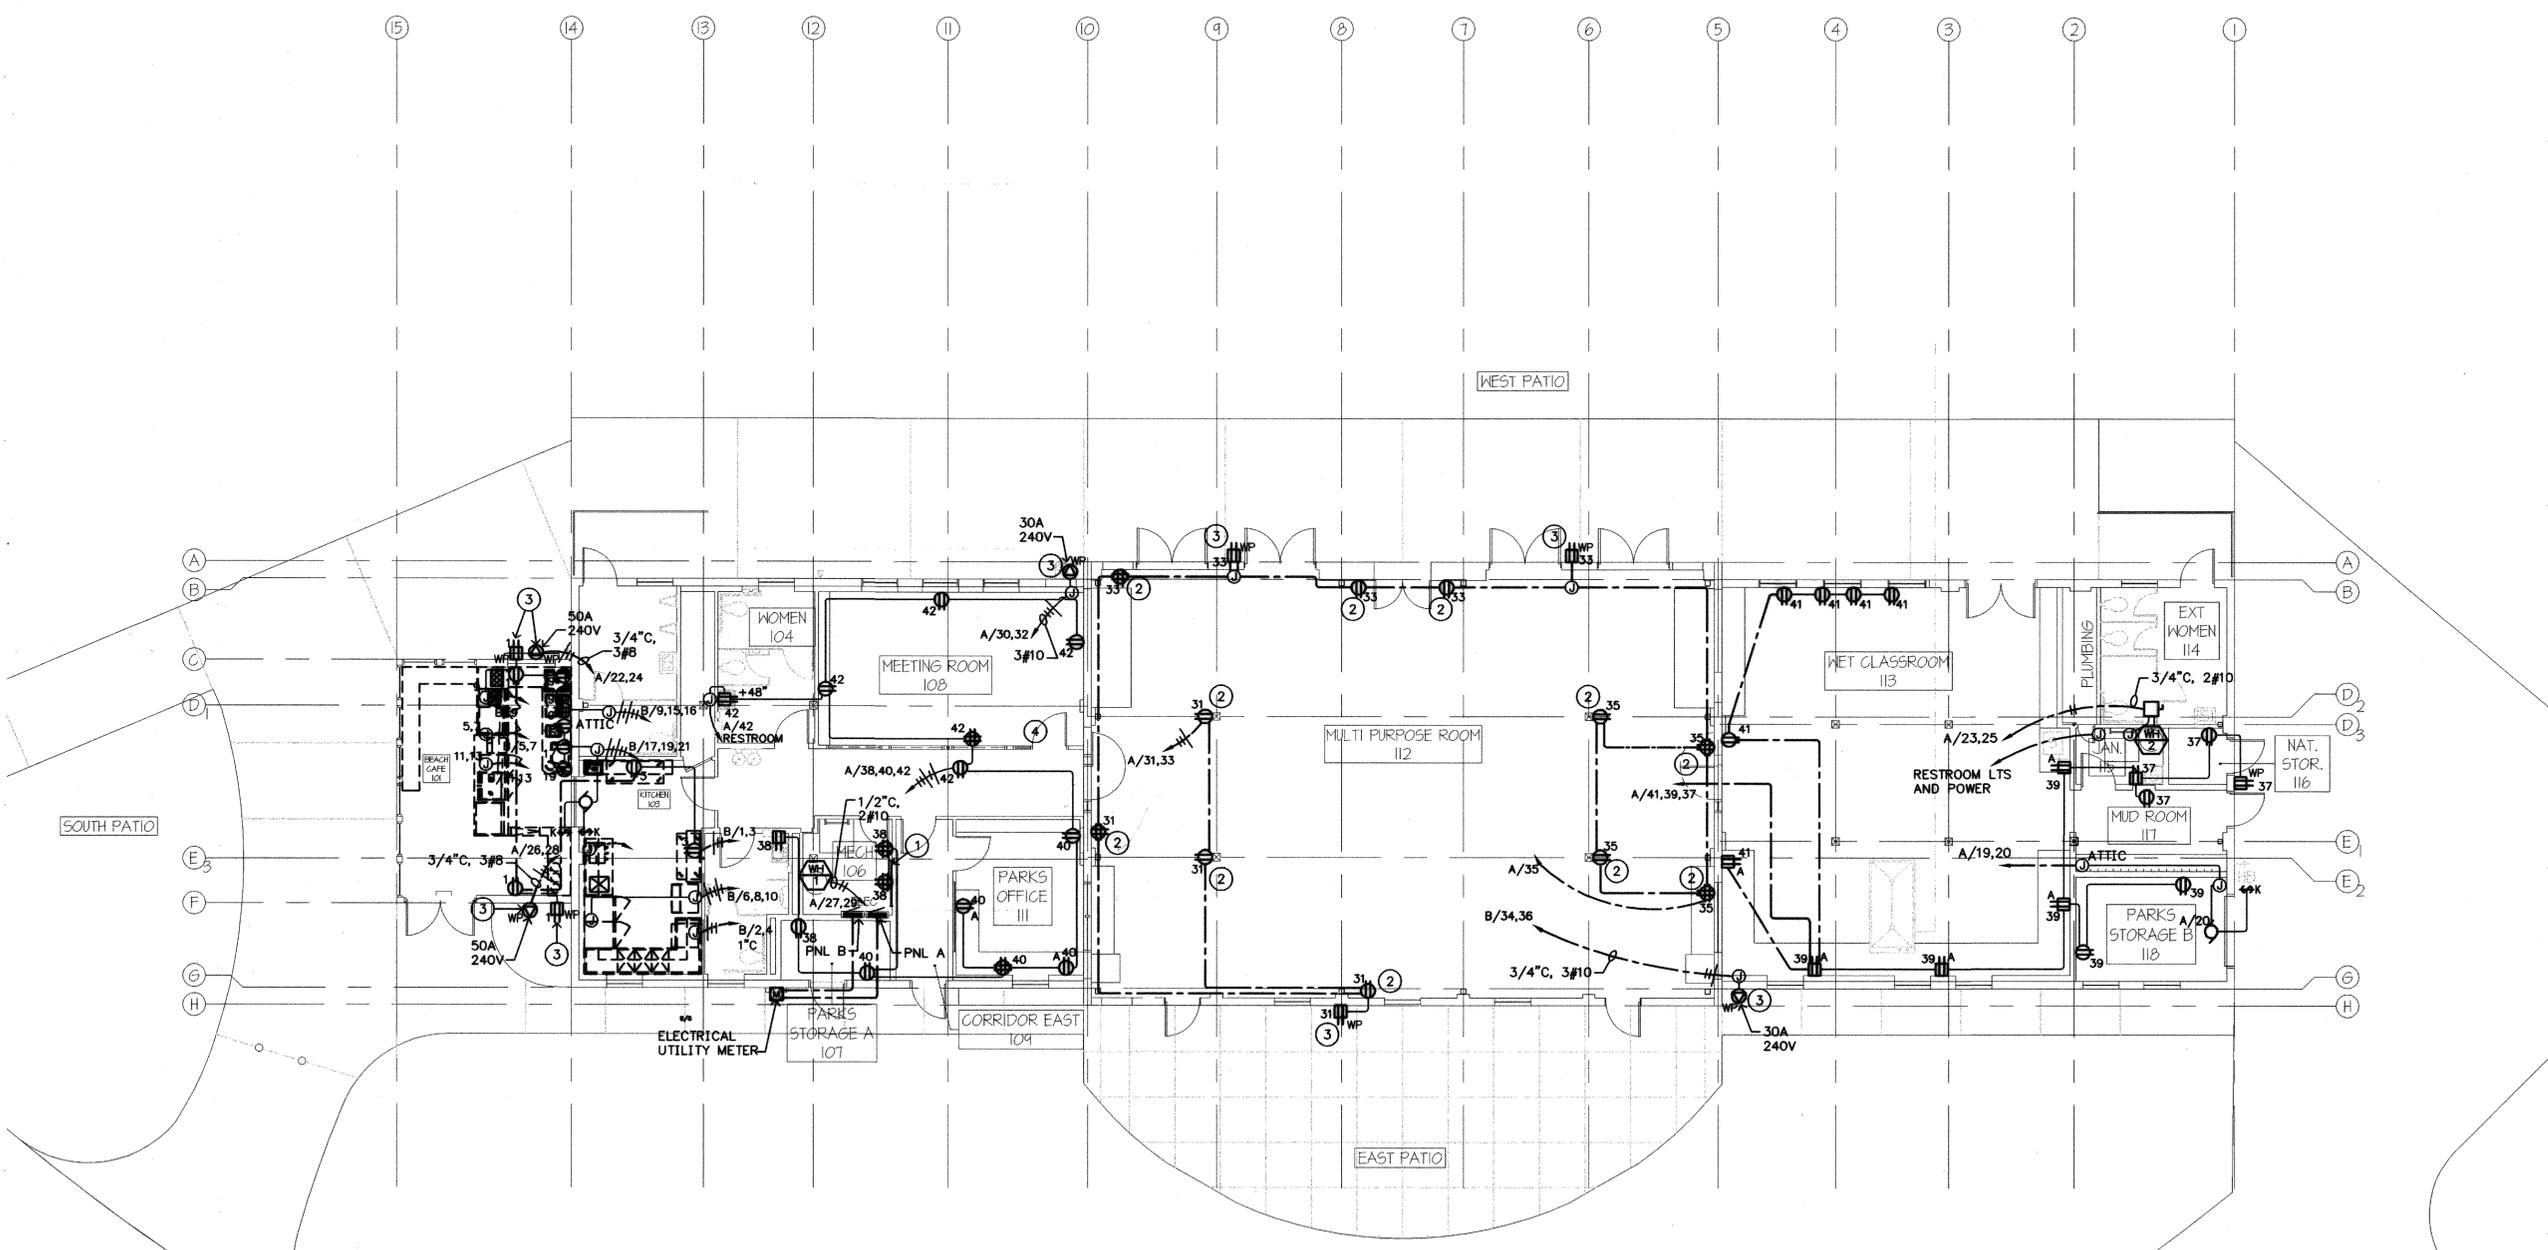

Drawing Name: 031203_E2_elec.dwg
 Plot Date/Scale: 08-10-2004, Plot Scale 1/8" = 1'-0"