

Seattle Stormwater Manual Figure Redlines—

January 2026 Review Draft

Figure Redlines for Volume 1 – Project Minimum Requirements

January 2026 Review Draft



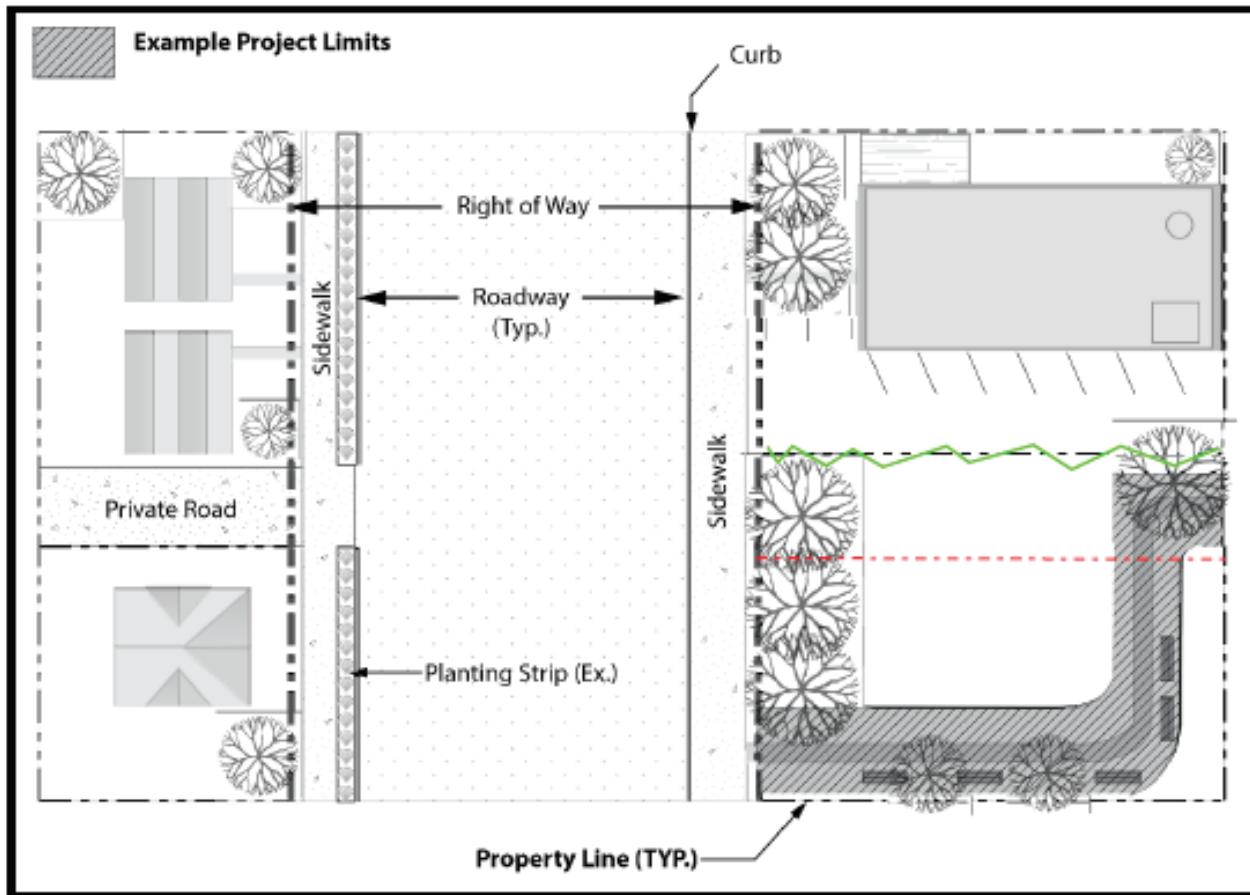


Figure 2.3. Trail Project Definition.

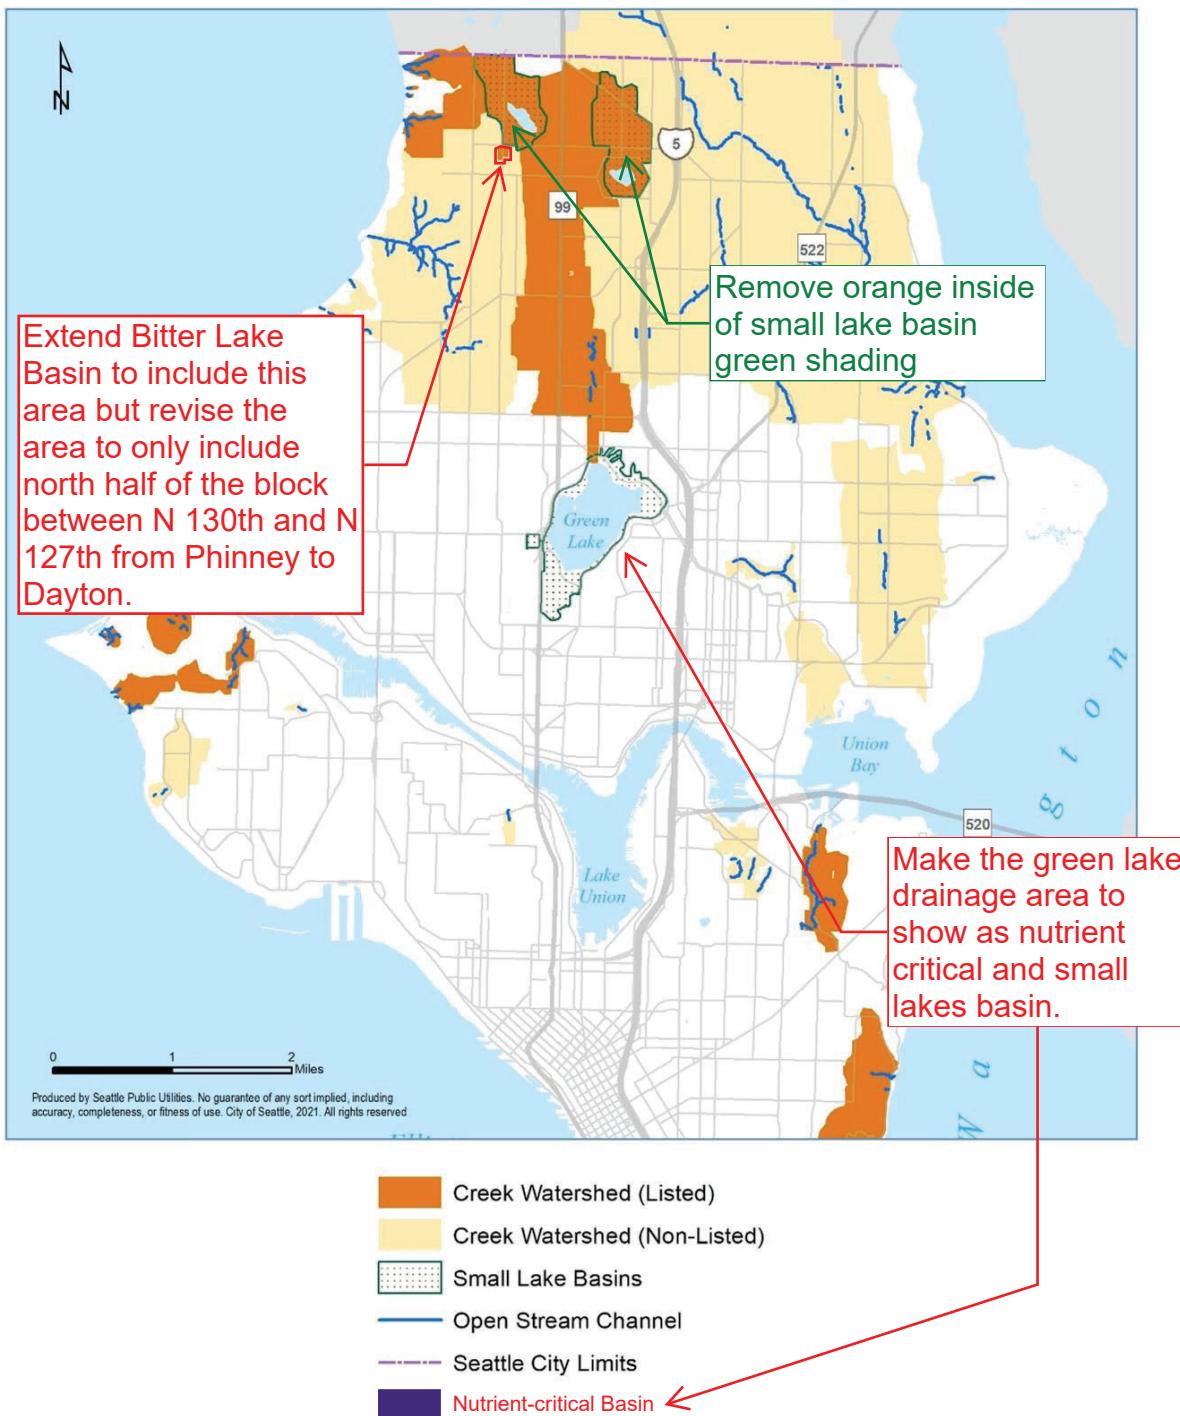


5
Figure 2.6. North End Creek and Small Lake Basins

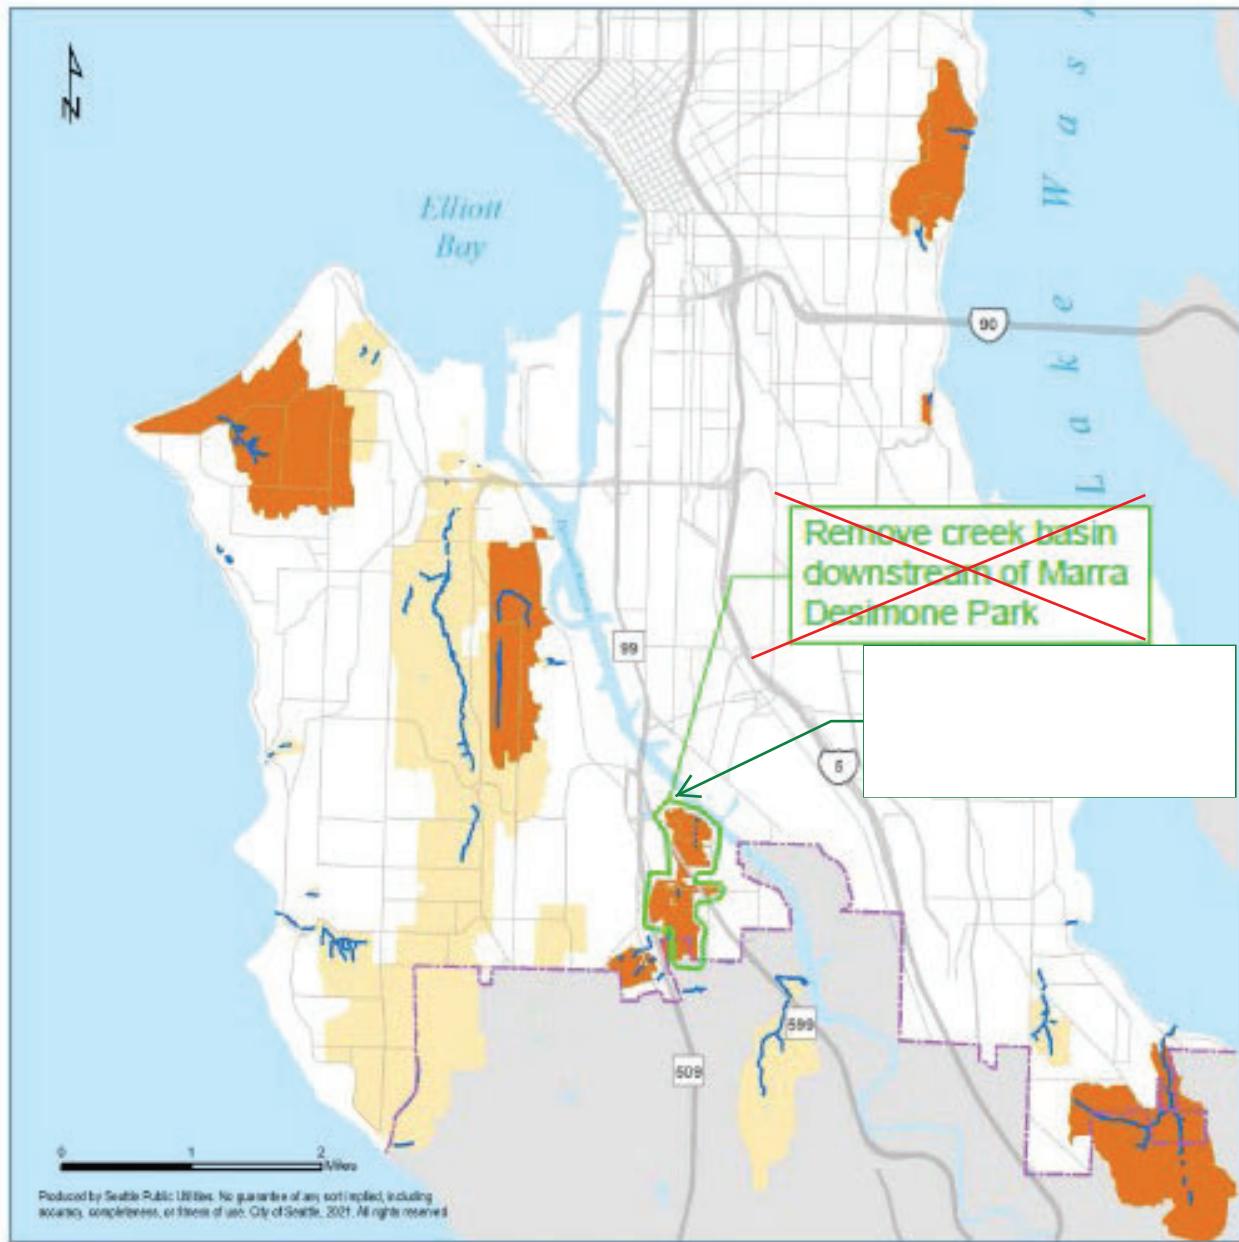

6
Figure 2.7. South End Creek Basins.



Figure 2.9. North End Designated Receiving Water Drainage Areas.

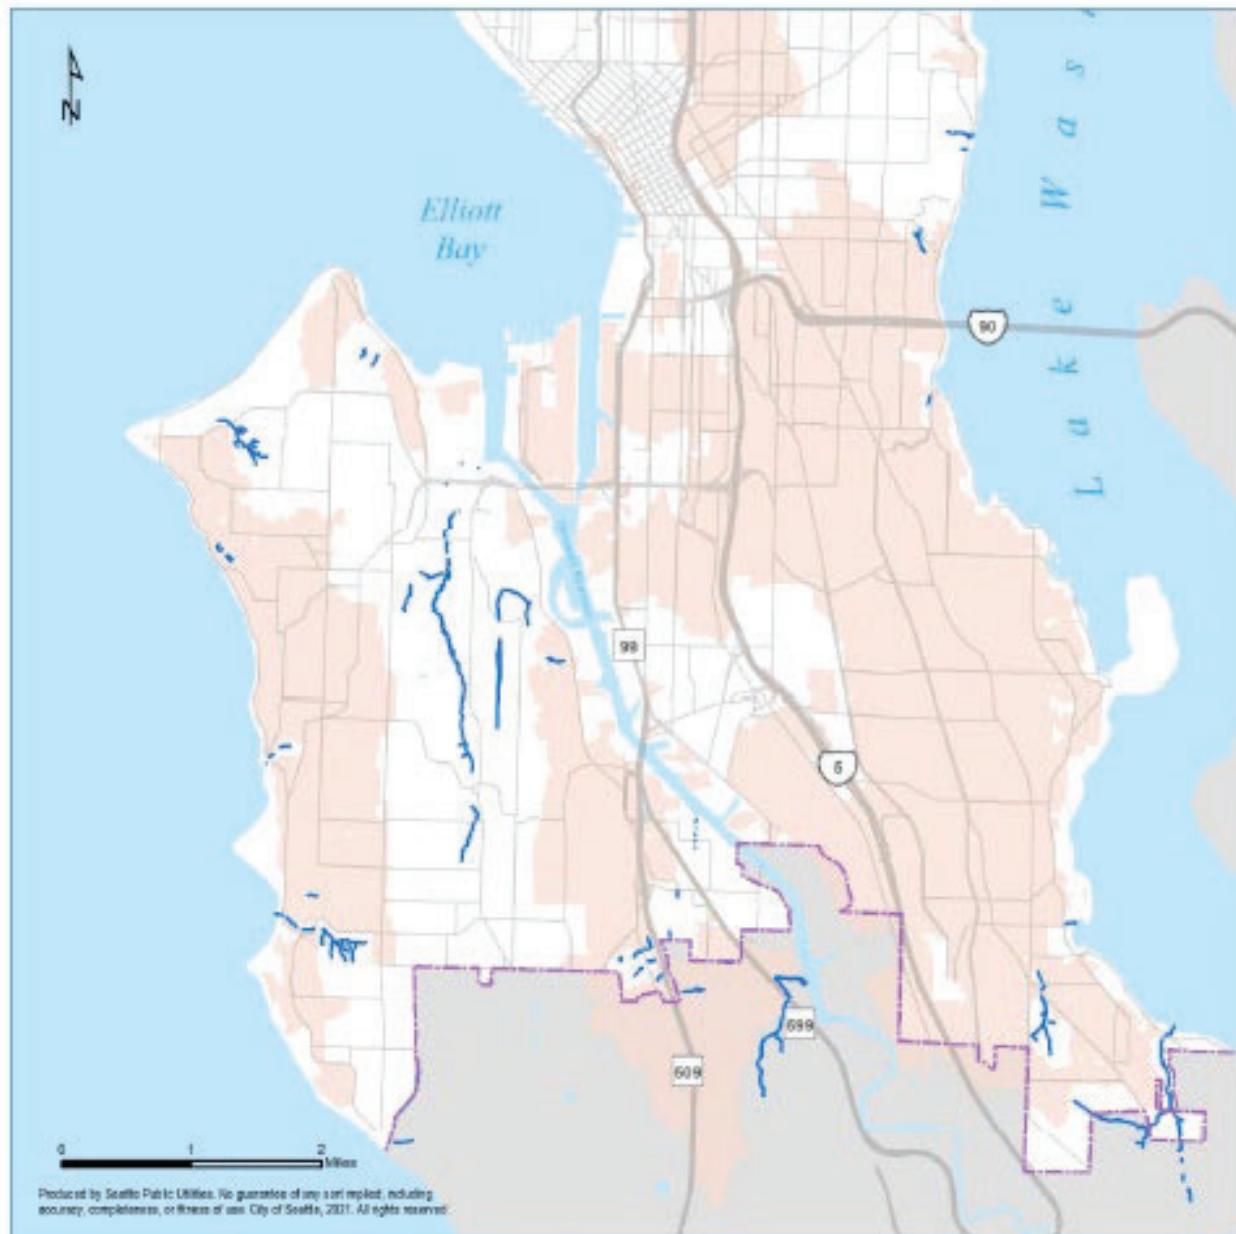

- Basins With Direct Discharge to Designated Receiving Waterbodies
- Open Stream Channel
- Seattle City Limits

Figure 2.10. South End Designated Receiving Water Drainage Areas. ⁹

The City is currently planning a project in this area which will remove its capacity constrained designation. Check with the director to confirm status of the project and code requirements.



10
Figure 2.11. Capacity-constrained Systems



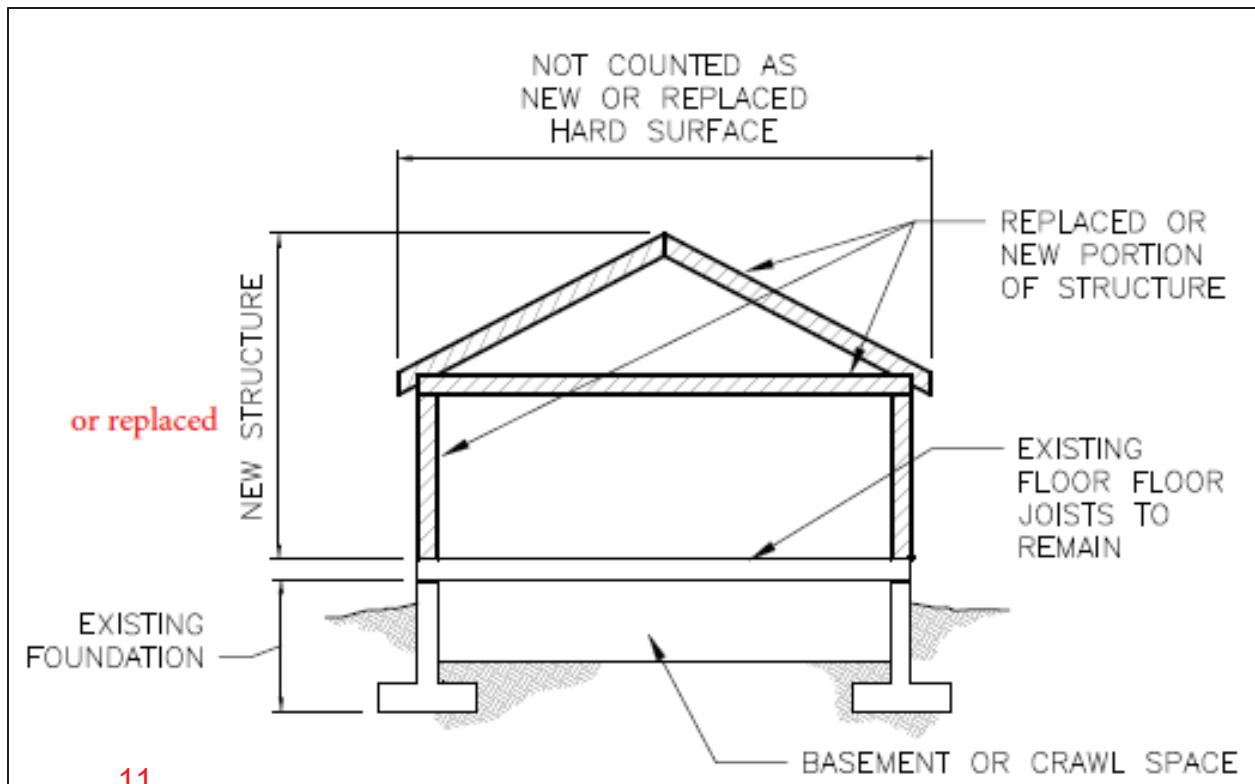


Figure 2.12. Example of Existing Hard Surface to Remain – Existing Floor Joists to Remain. (New Figure)

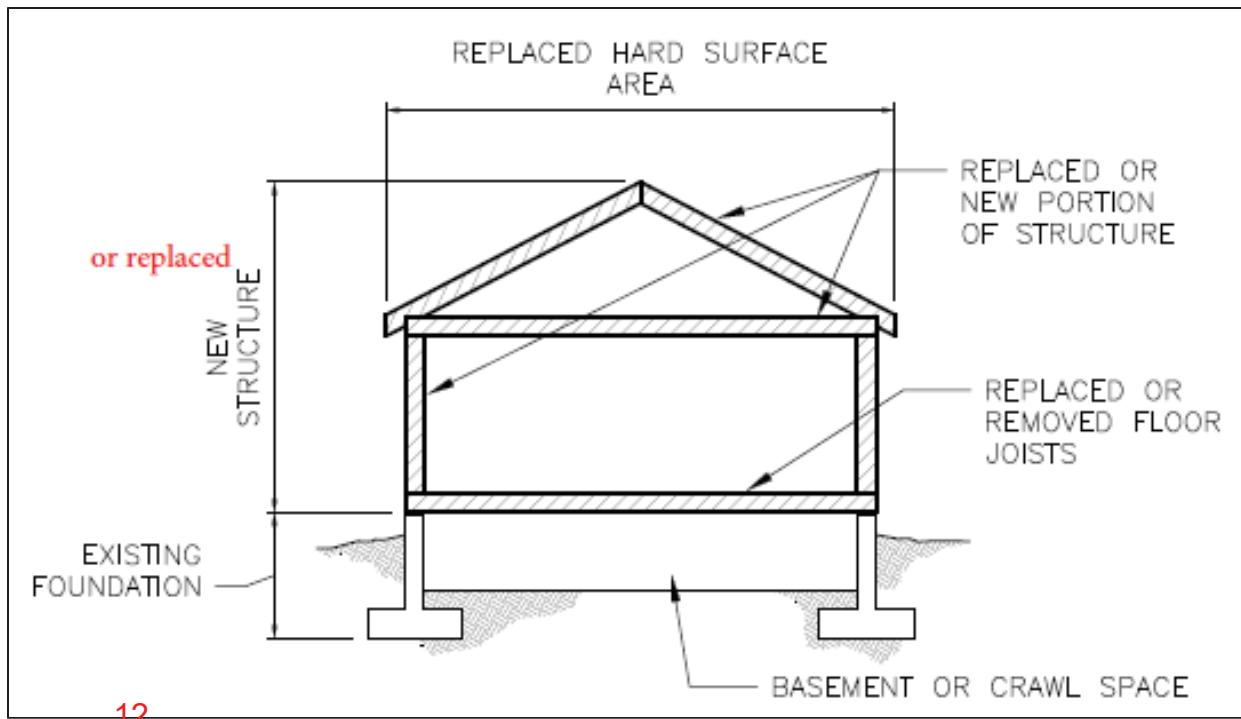

12
Figure 2.13. Example of Replaced Hard Surface – Floor Joists Removed or Replaced. (New Figure)

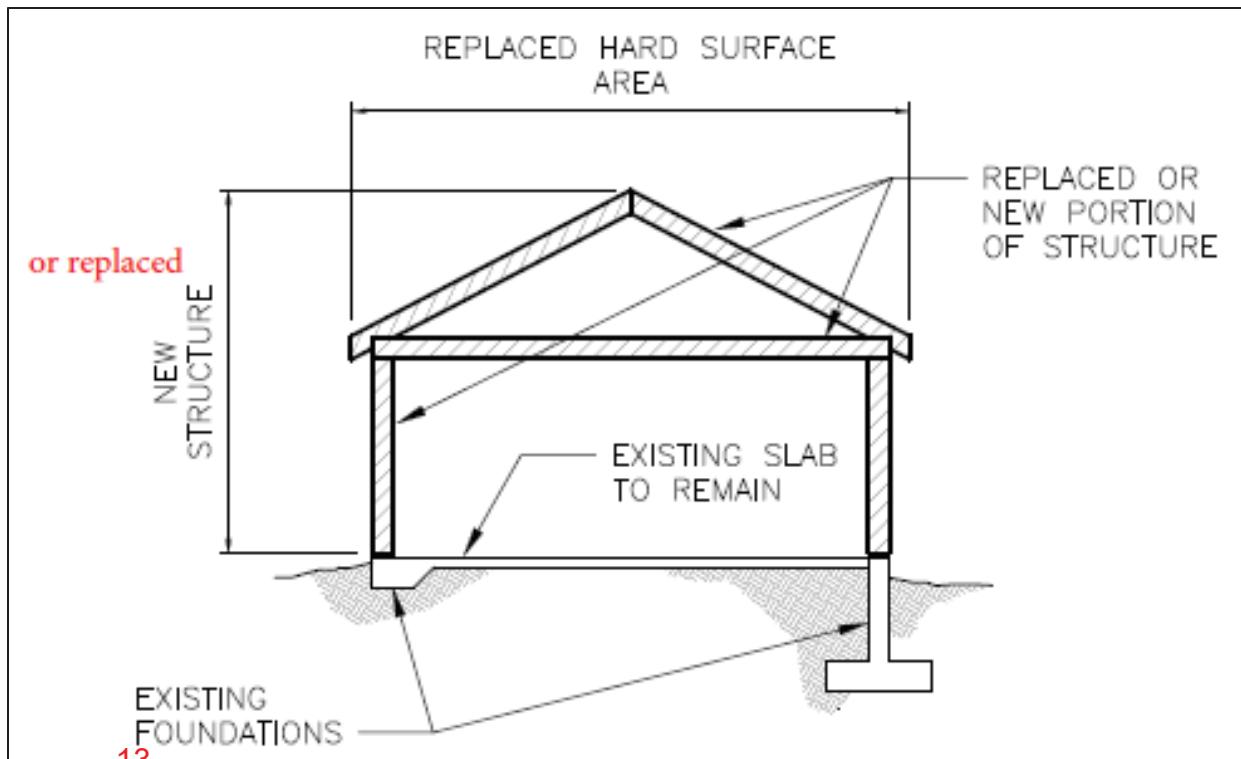

13
Figure 2.14: Example of Replaced Hard Surface – Structure Removed Down to Slab on Grade/Footings. (New Figure)

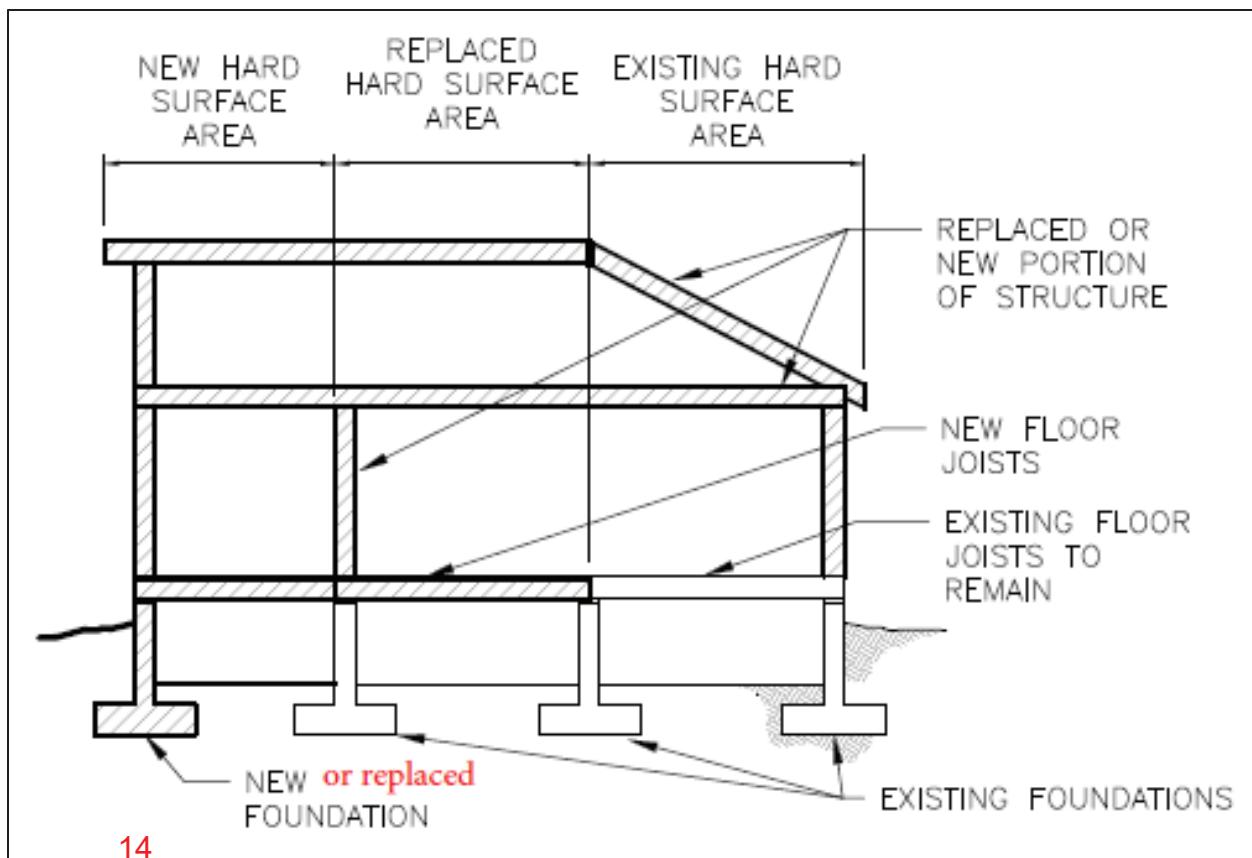


Figure 2.15. Example with New, Replaced and Existing Hard Surfaces. (New Figure)

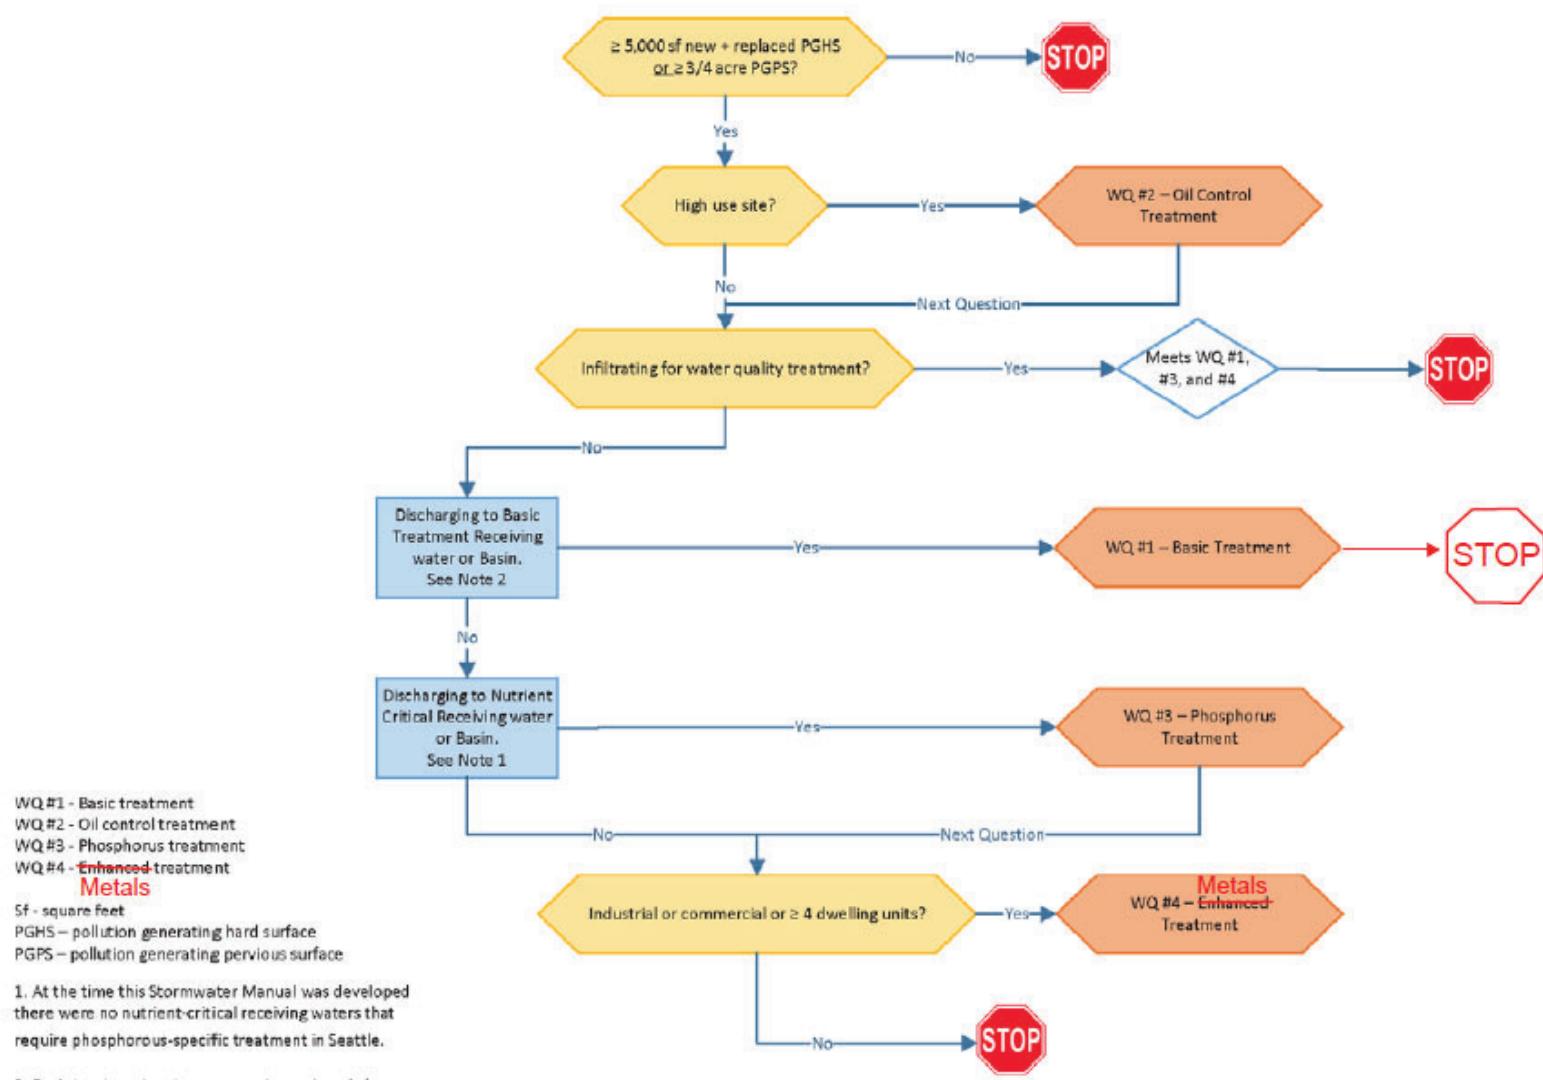


Figure 4.2C. Project Minimum Requirements for Parcel-Based Projects (continued).

1


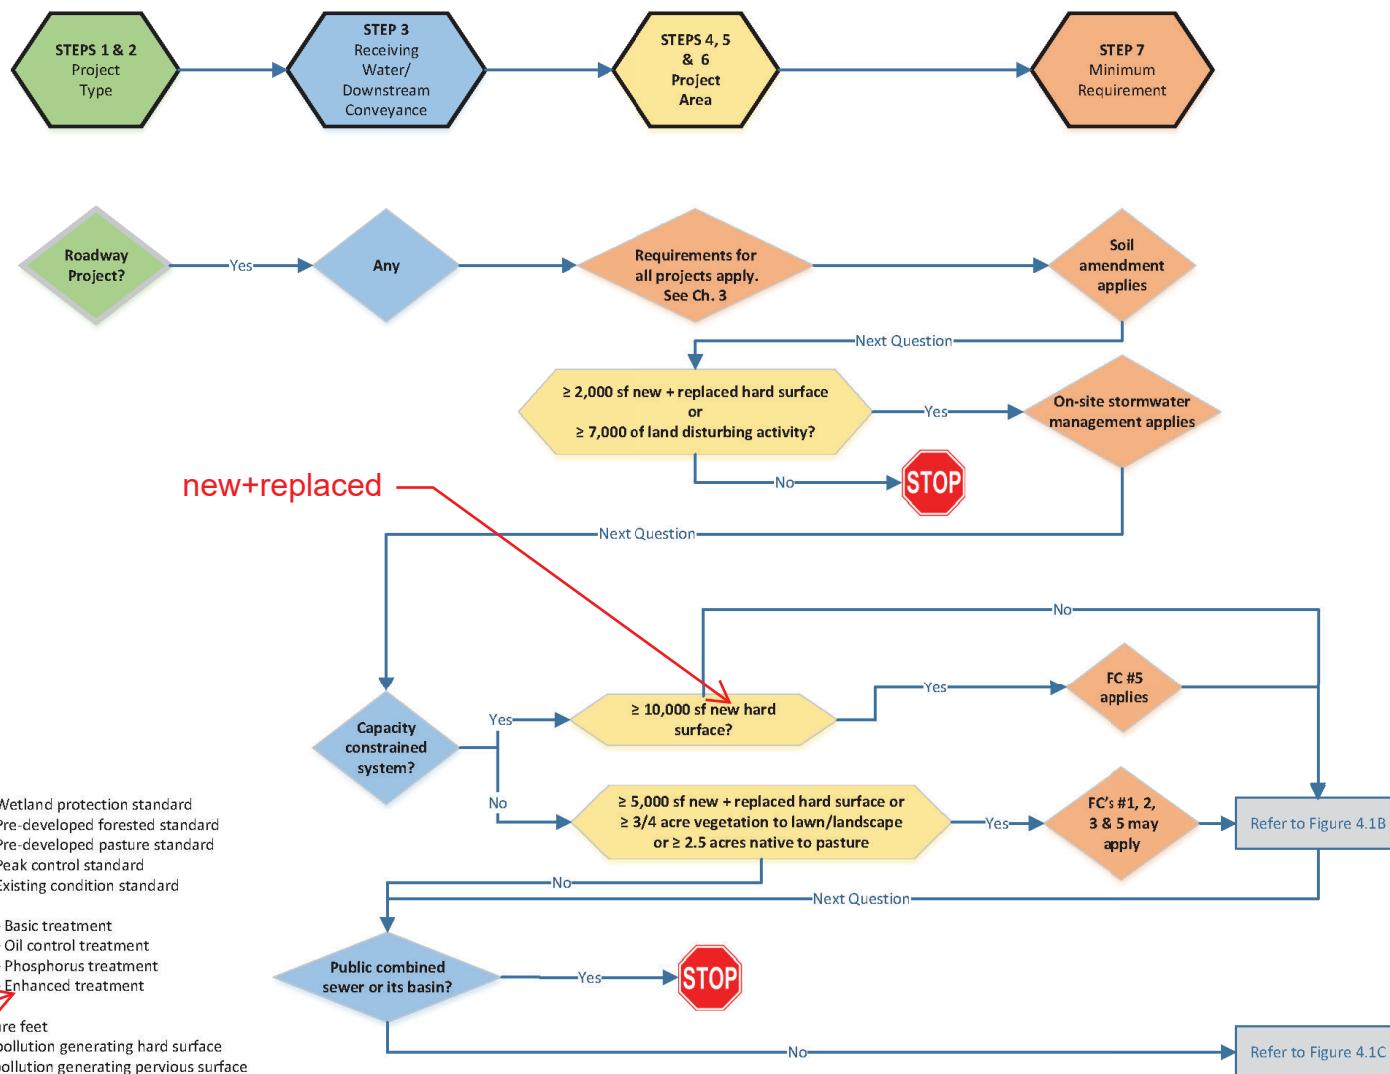


Figure 4.1A. Project Minimum Requirements for Roadway Projects.

Add note X:
 Evaluate whether FC #1 applies to only the new hard surface or all new + replaced hard surfaces when new plus replaced hard surface is >10,000 sf:
 If new hard surfaces total >50% of existing hard surfaces, FC#1 applies to new plus replaced hard surfaces. Otherwise, it applies to the total new hard surfaces.

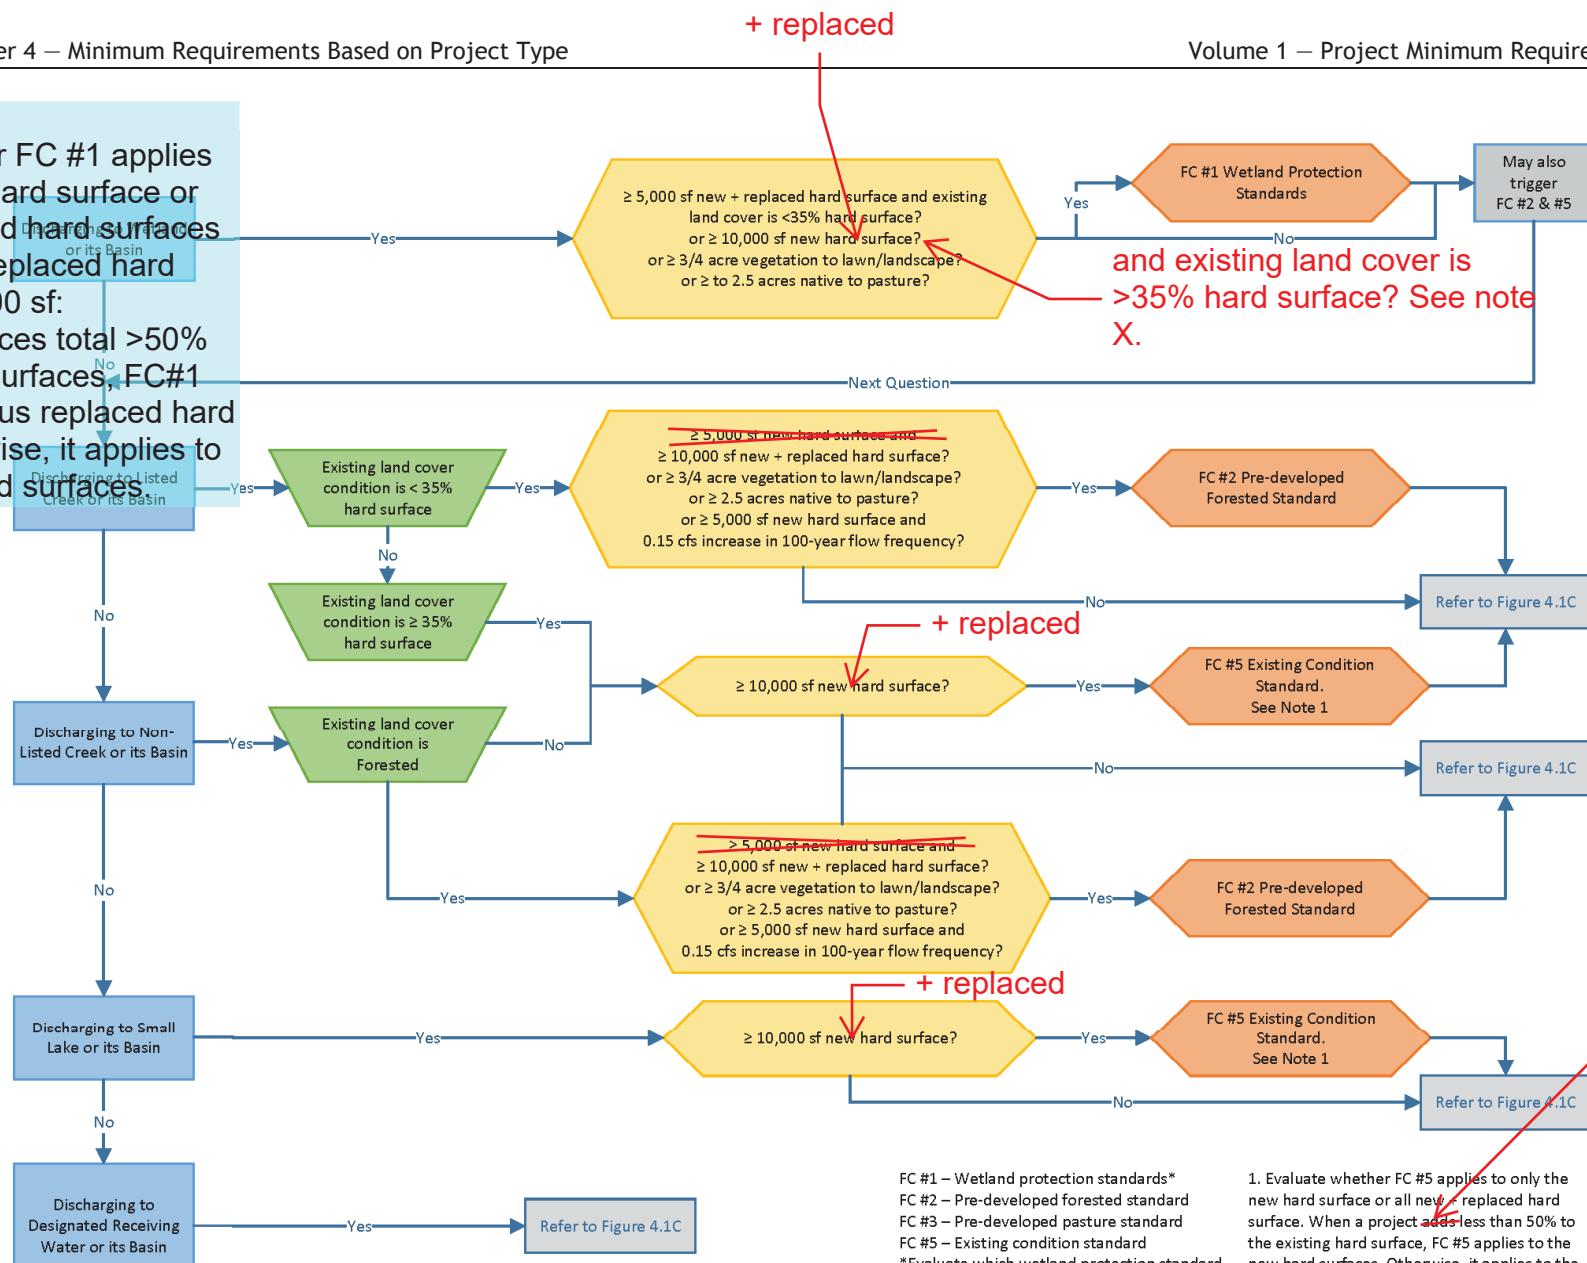

FC #1 – Wetland protection standards*
 FC #2 – Pre-developed forested standard
 FC #3 – Pre-developed pasture standard
 FC #5 – Existing condition standard
 *Evaluate which wetland protection standard applies
 sf - square feet

1. Evaluate whether FC #5 applies to only the new hard surface or all new + replaced hard surface. When a project adds less than 50% to the existing hard surface, FC #5 applies to the new hard surfaces. Otherwise, it applies to the new + replaced hard surfaces.

When a project's new + replaced hard surface totals less than 50%...

2
Figure 4.4B. Project Minimum Requirements for Roadway Projects (continued).

Add note Y:
 Evaluate whether WQ #1 applies to flows from only the new, or the total new plus replaced PGHS&PS. If the new plus replace PGHS totals $>/= 50\%$ of existing HS, treat flows from total new plus replaced PGHS&PS. Otherwise, only treat flows from the new PGHS&PS.

metals
 PGHS – pollution generating hard surface
 PGPS – pollution generating pervious surface
 AADT – Annual Average Daily Traffic

1. At the time this Stormwater Manual was developed there were no nutrient-critical receiving waters that require phosphorous-specific treatment in Seattle.
2. Basic treatment waters are marine waters, Lake Union, Lake Washington, Ship Canal and bays between Lake Washington and Puget Sound, and Duwamish River.
3. Evaluate if water quality treatment requirements apply to all PGHS or only to new PGHS (refer to SMC 22.805.060.02)

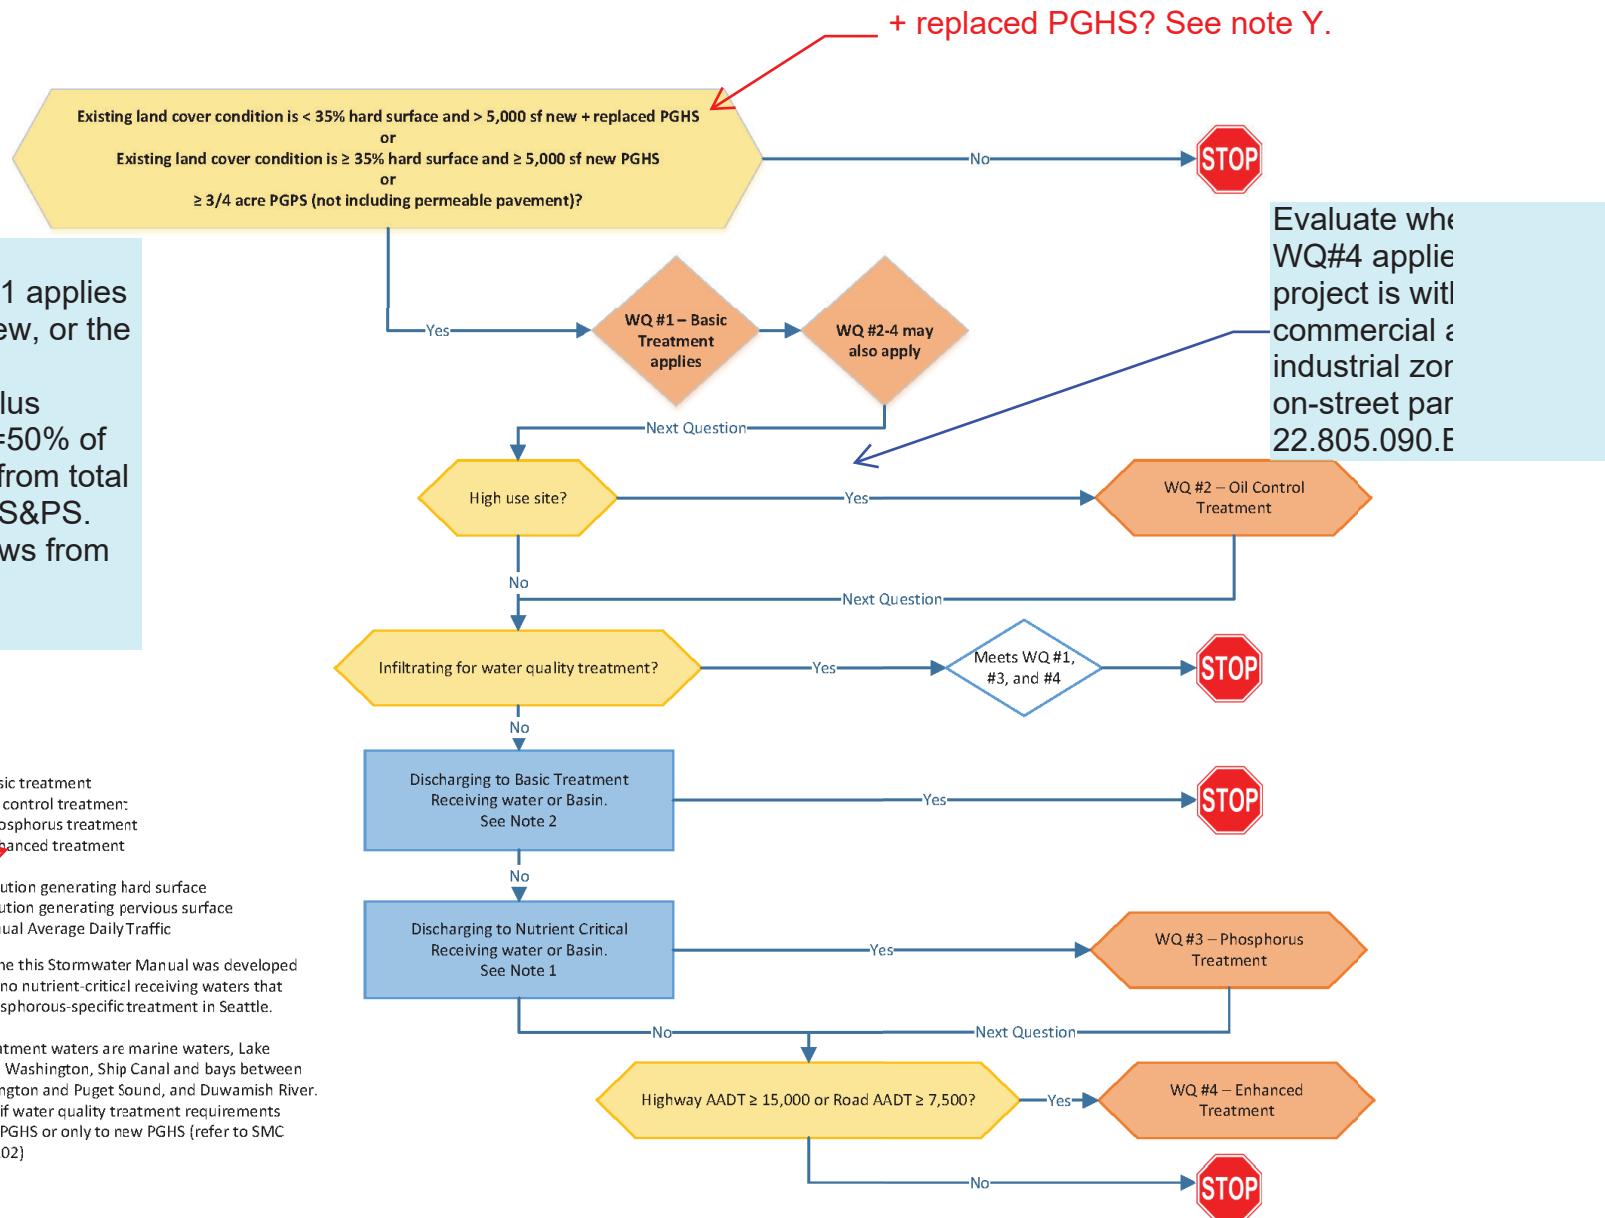


Figure 4.1C. Project Minimum Requirements for Roadway Projects (continued).

Figure Redlines for Volume 3 – Project Stormwater Control

January 2026 Review Draft

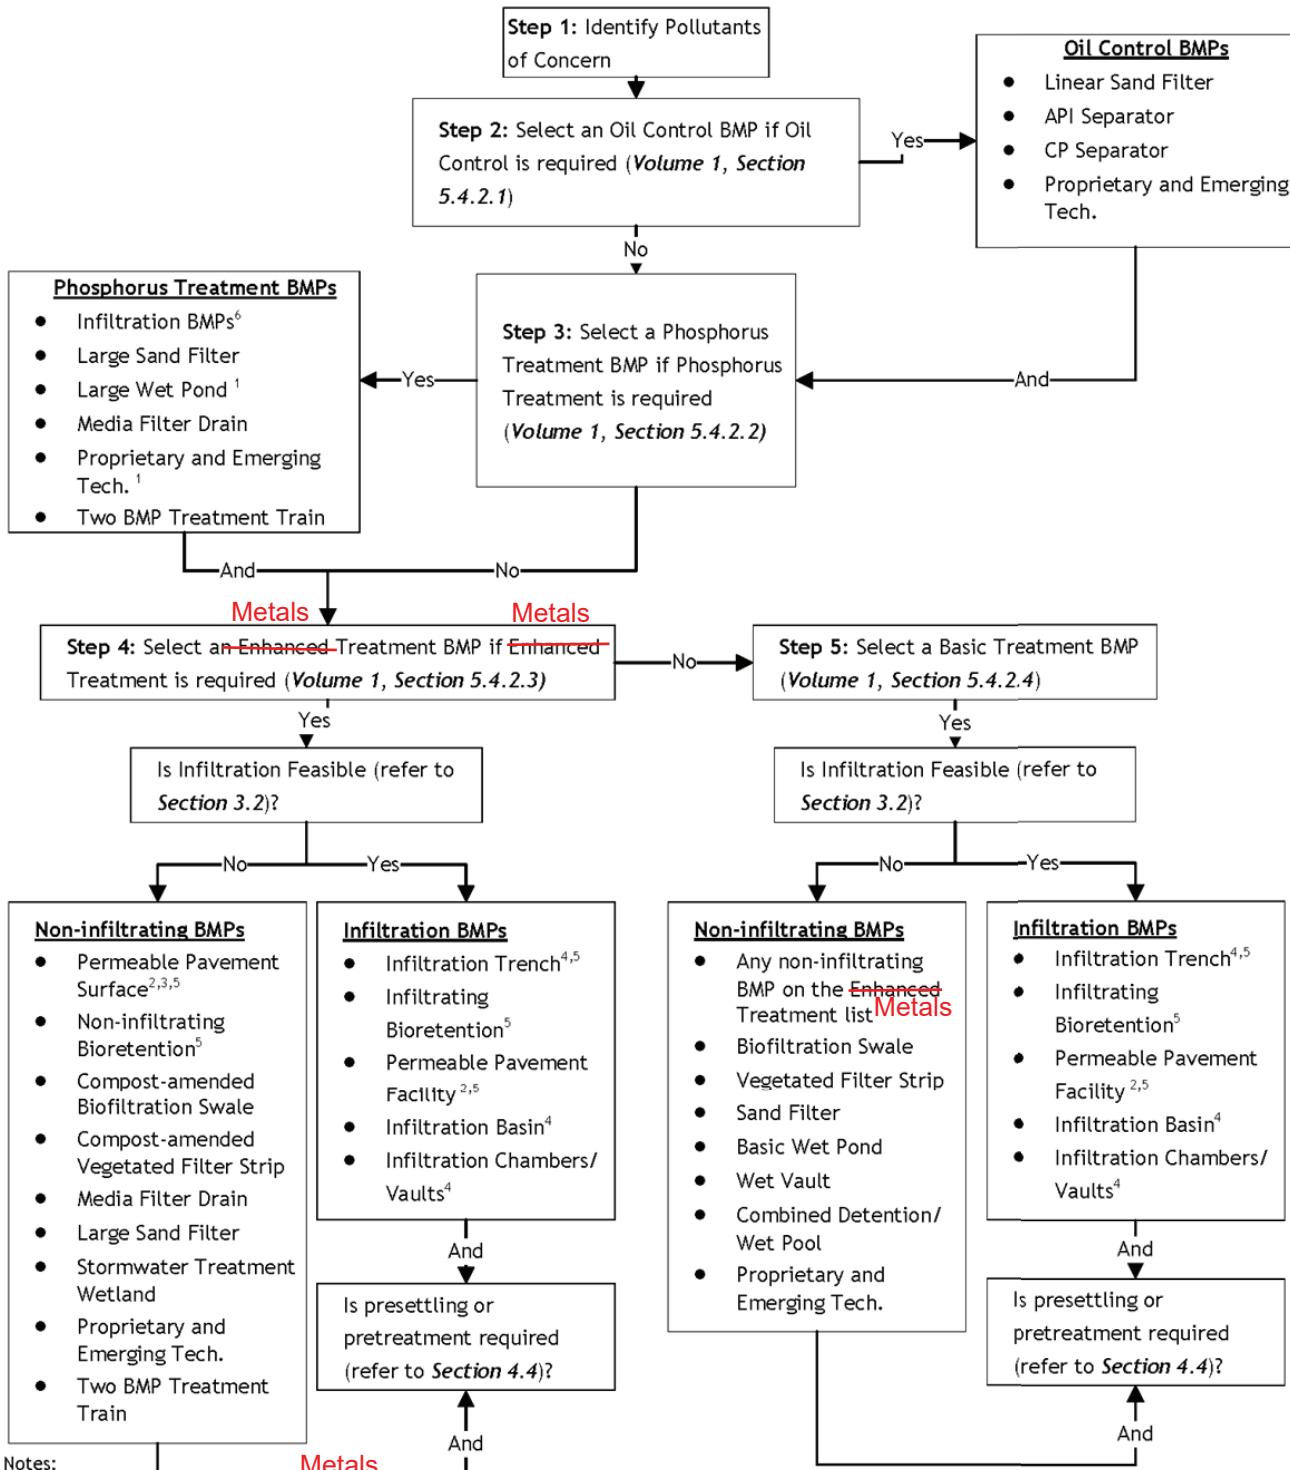


Figure 3.2 Water Quality Treatment BMP Selection Flow Chart

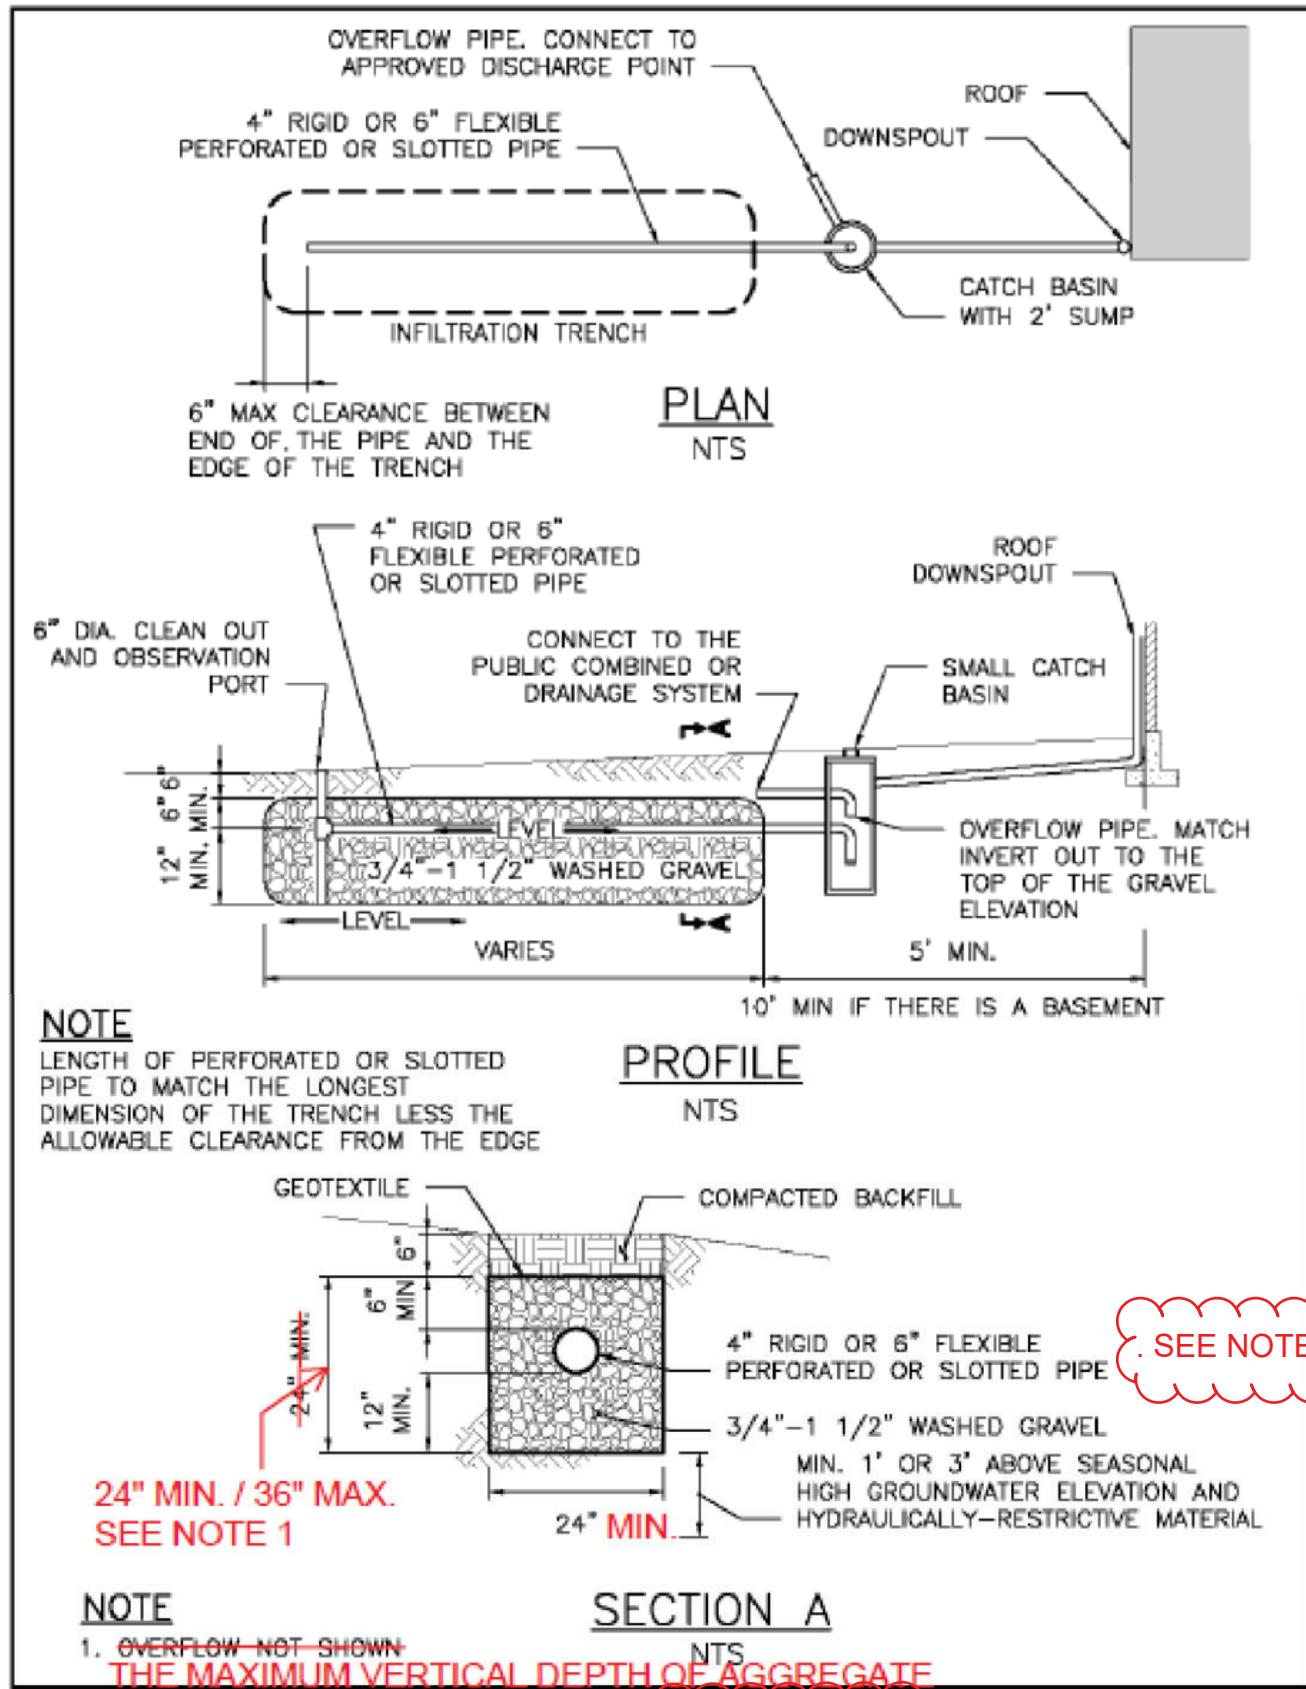


Figure 5.8 Typical Infiltration Trench Receiving Concentrated Flow.

2. IF INFILTRATION TRENCH IS TRENCH IS 8 FEET WIDE OR WIDER, PROVIDE ADDITIONAL ROW/S OF PERFORATED OR SLOTTED PIPE SPACED AT NO MORE THAN 6 FEET ON-CENTER.

Stormwater Manual Volume 3 - Figure 5-8 Redlines
January 2026 Review Draft

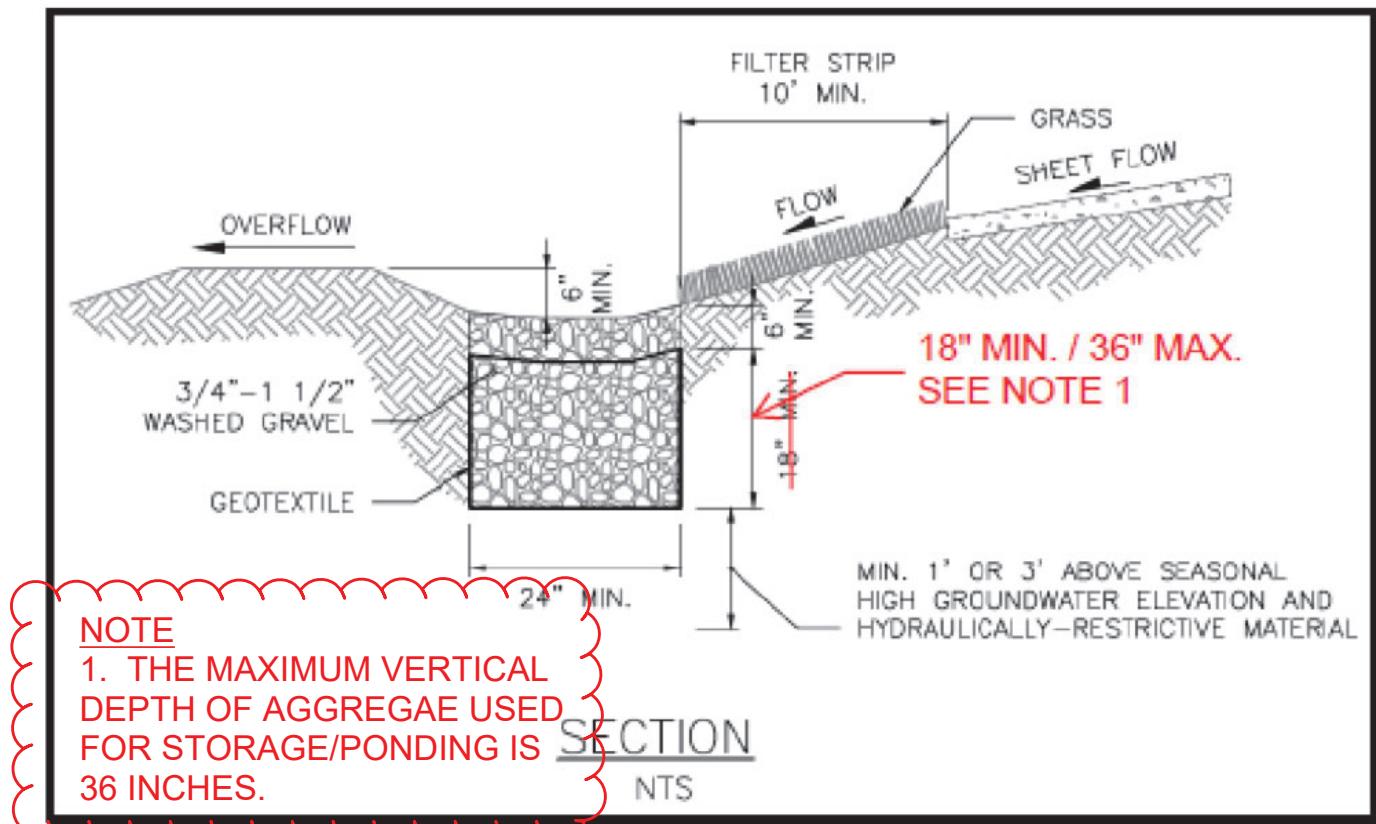


Figure 5.9. Typical Infiltration Trench Receiving Sheet Flow.

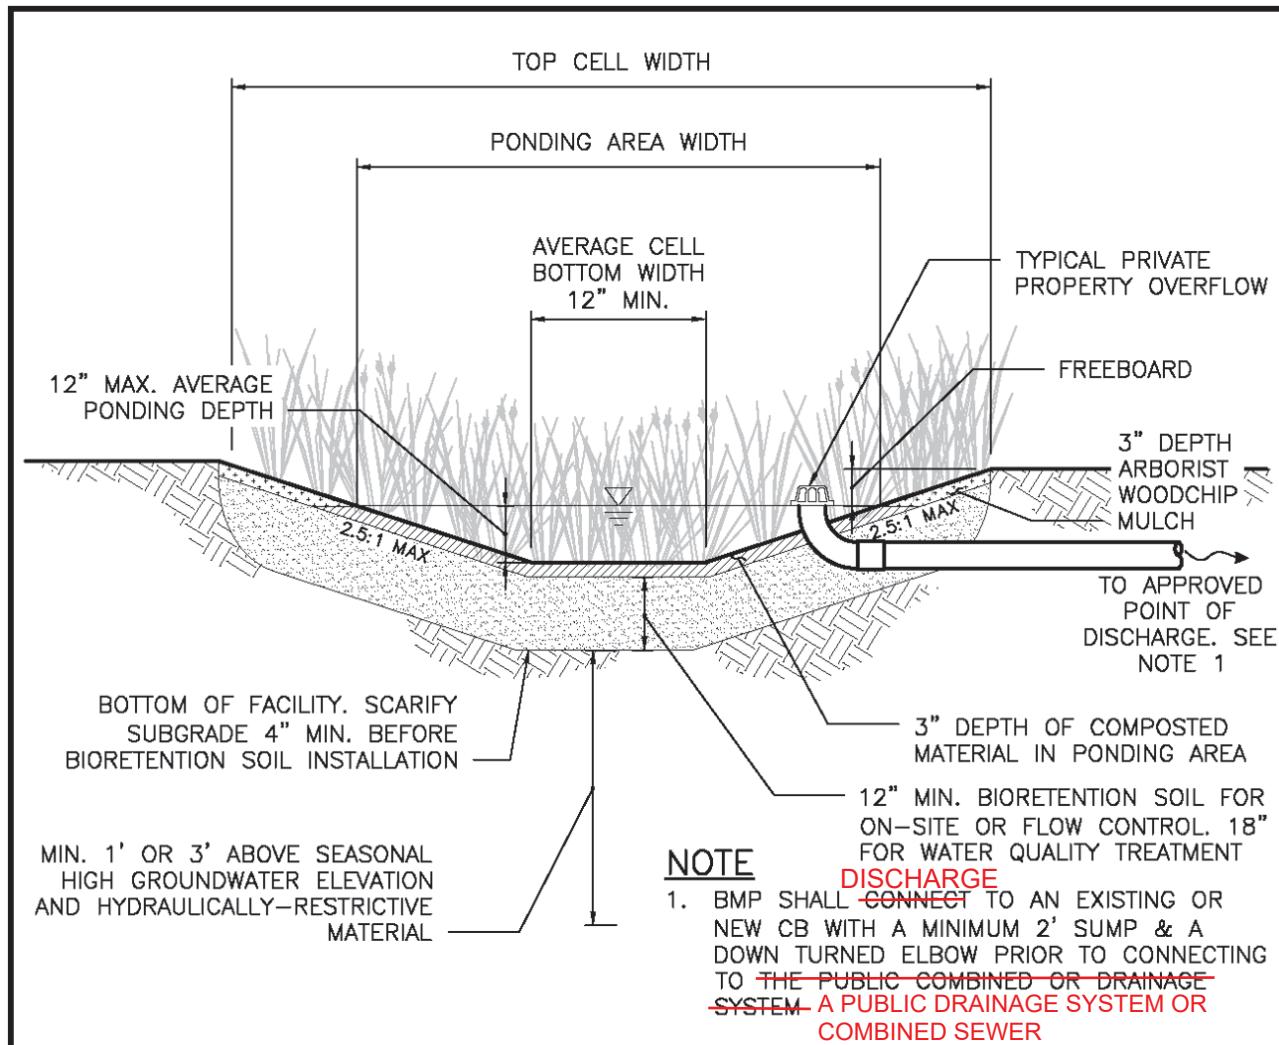


Figure 5.11. Infiltrating Bioretention Facility with Sloped Sides (without Underdrain).

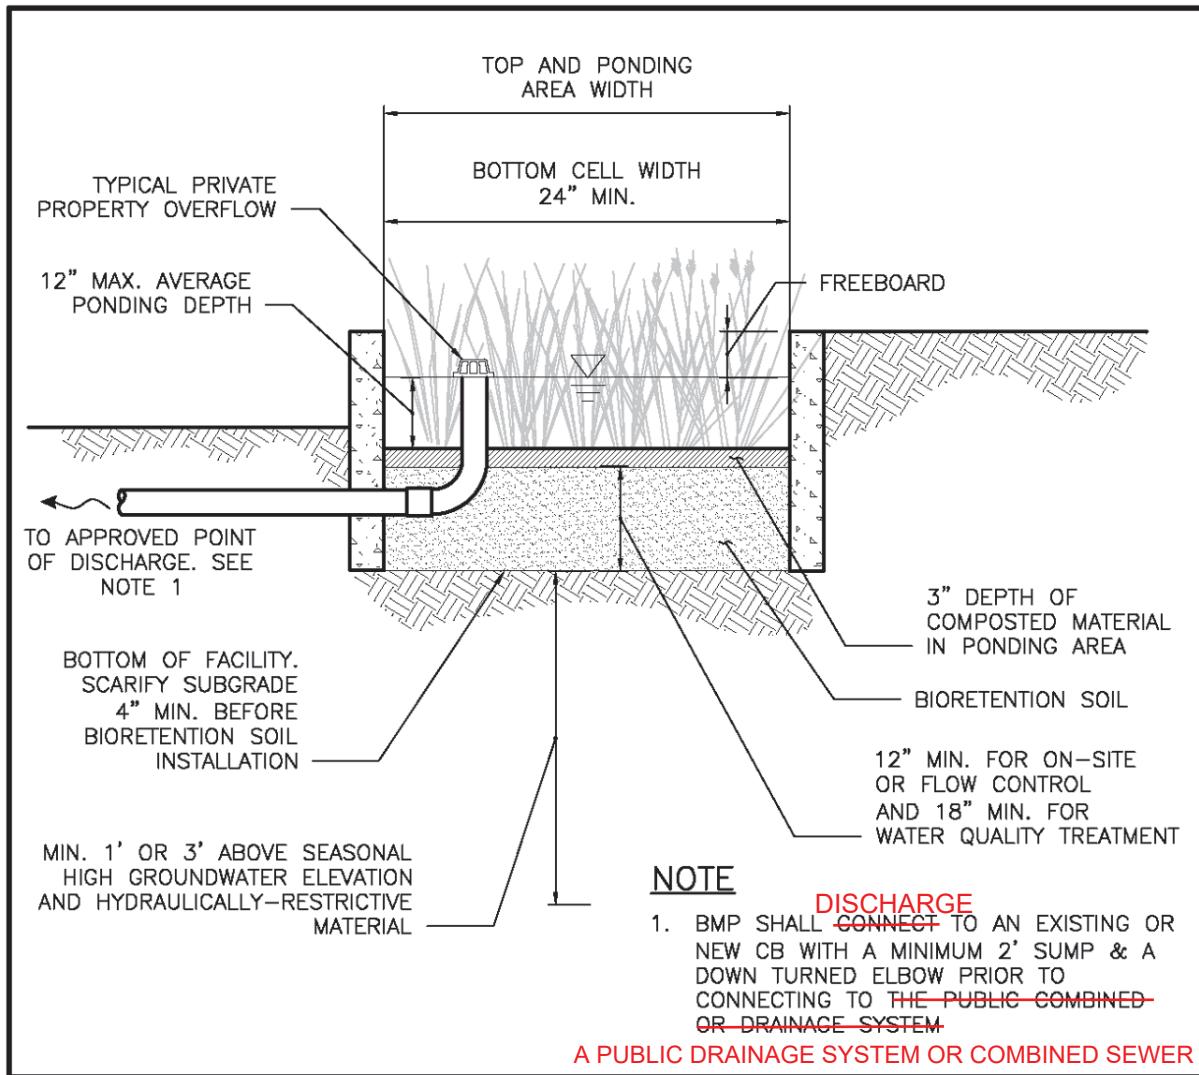


Figure 5.12. Infiltrating Bioretention Facility with Vertical Sides (without Underdrain).

2. Walls may be constructed of concrete, steel or fiberglass. Alternative material may be used with the permission of the director. Walls must be UV and corrosion resistant and able to withstand earth pressure if below ground.

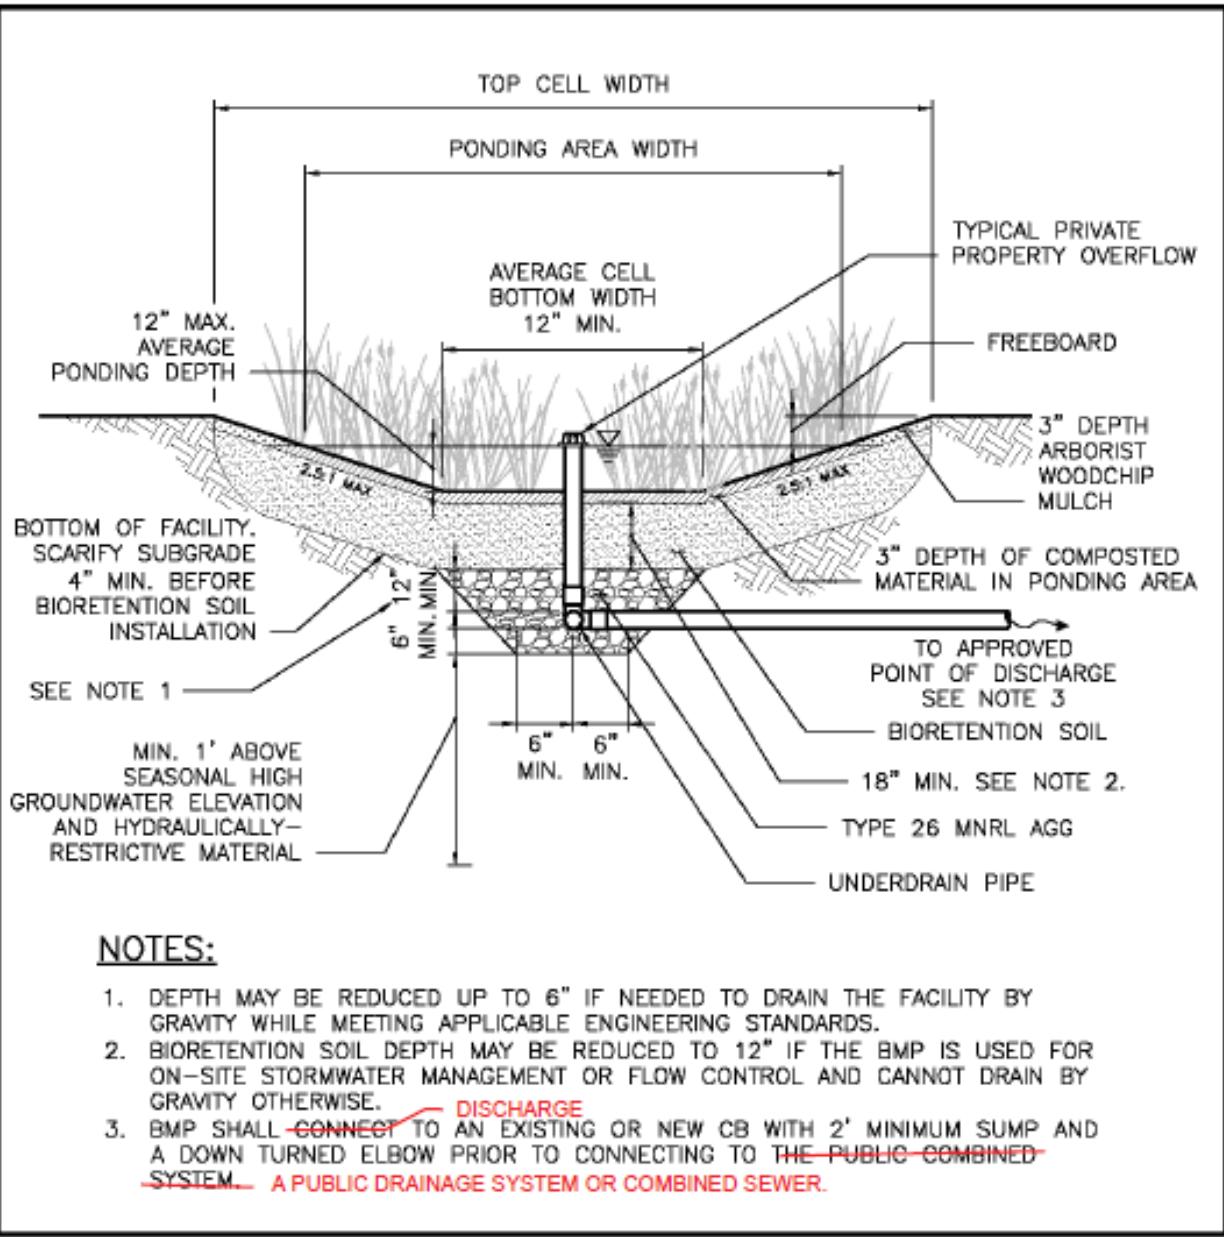


Figure 5.13. Infiltrating Bioretention Facility with Sloped Sides (with Underdrain).



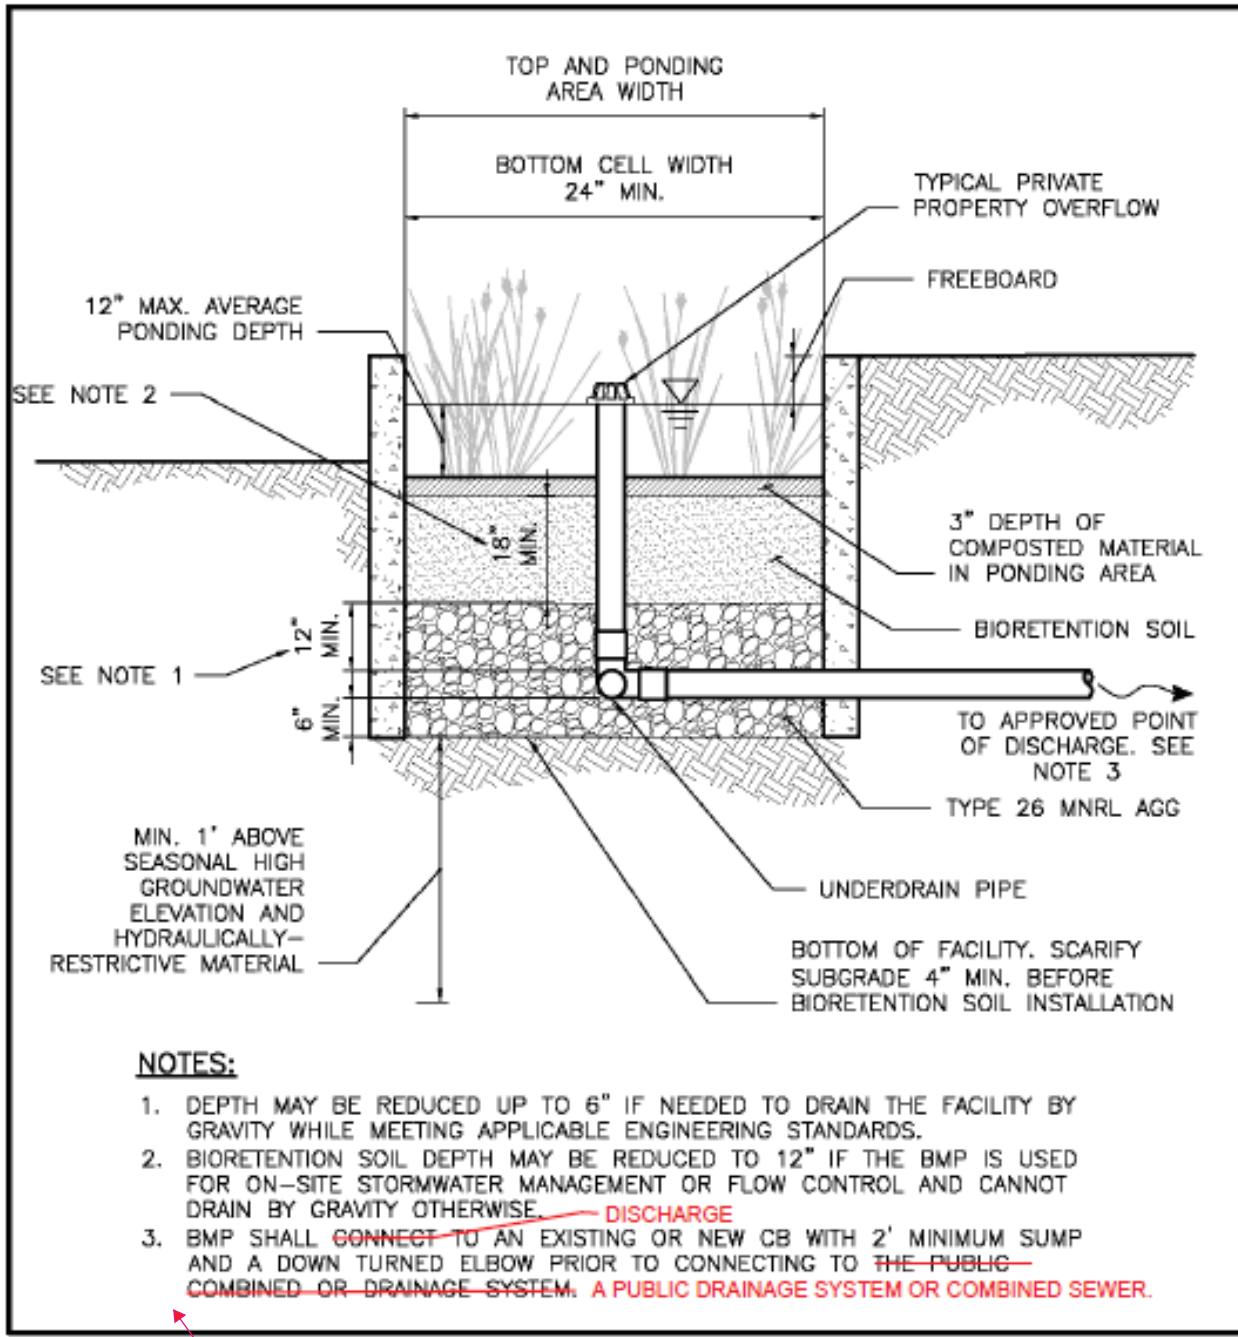


Figure 5.14. Infiltrating Bioretention Facility with Vertical Sides (with Underdrain).

4. Walls may be constructed from concrete, steel or fiberglass. Alternative material may be used with the permission of the director. Walls must be UV and corrosion resistant and able to withstand earth pressure if below ground.

Figure 5.16 Example of Infiltrating Bioretention Facility with Tree and Side Slopes (Without Underdrain)

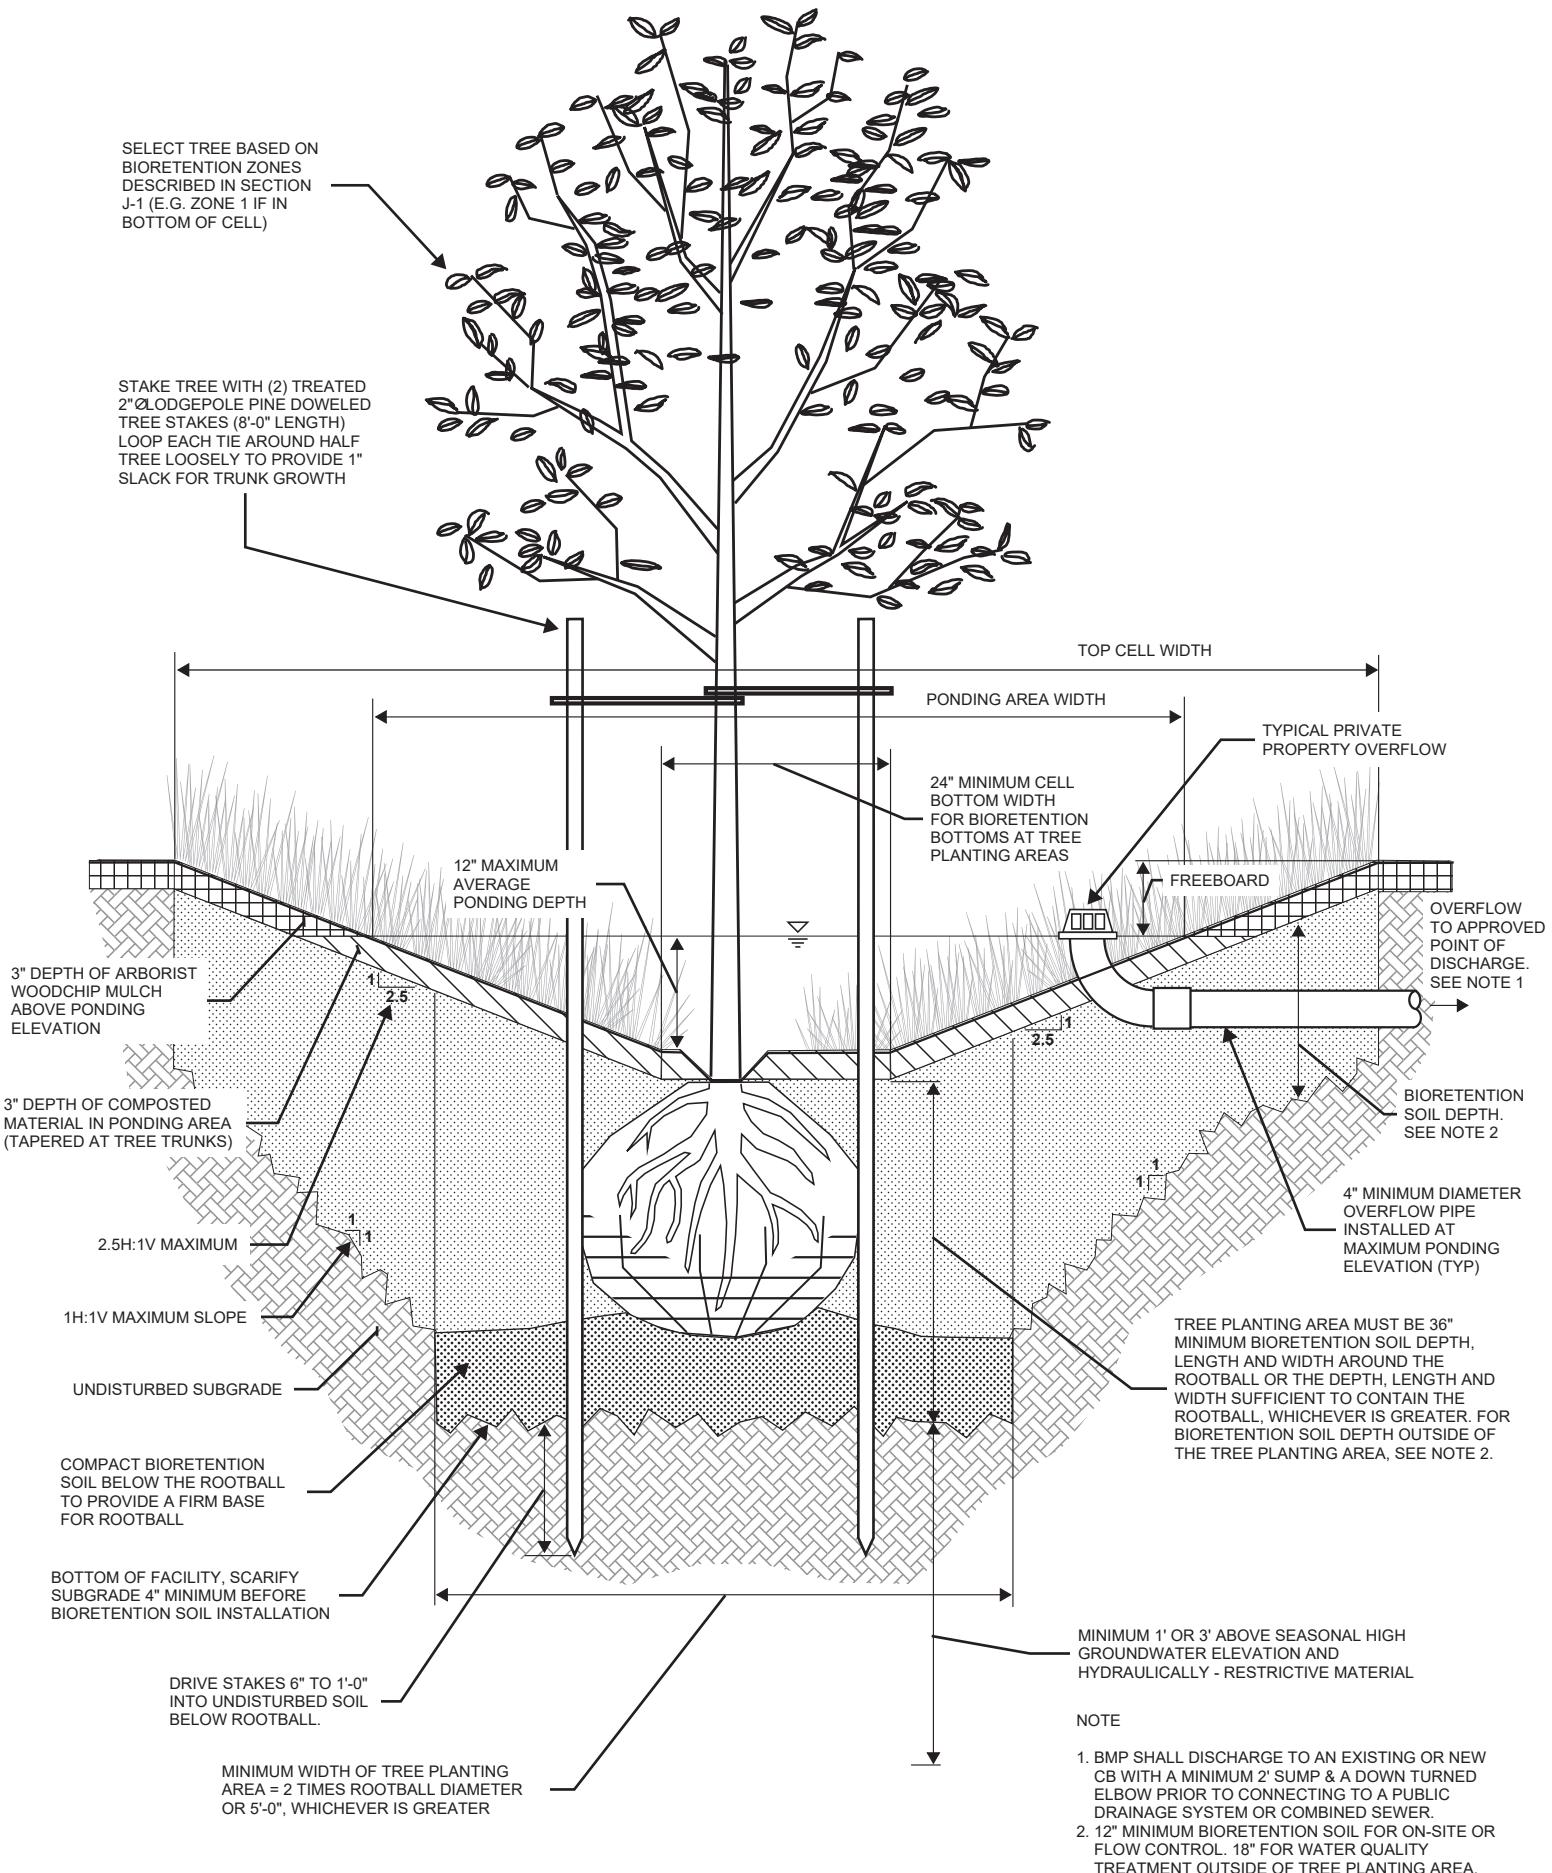

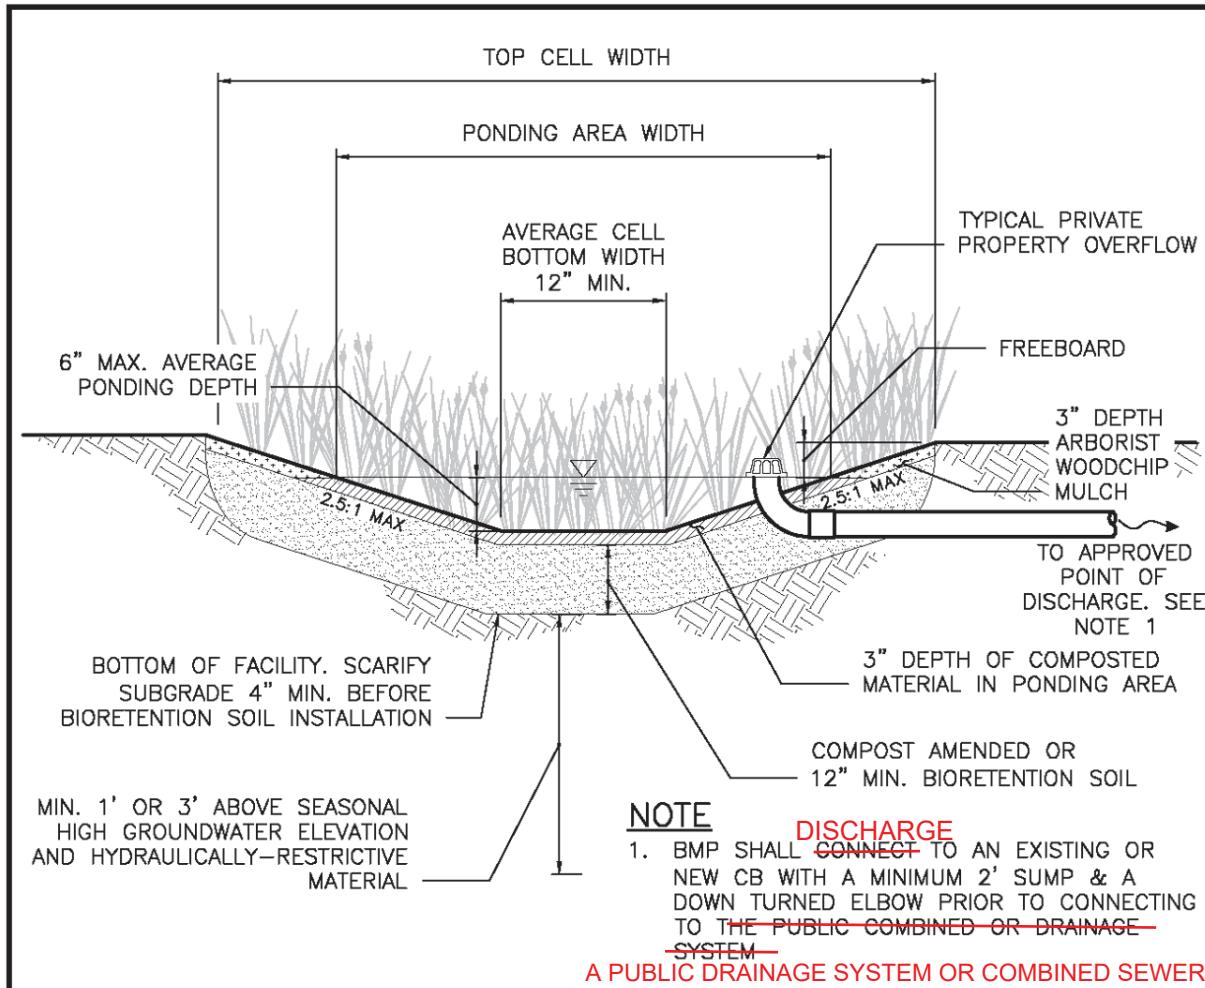

17

Figure 5.16. Typical Rain Garden.

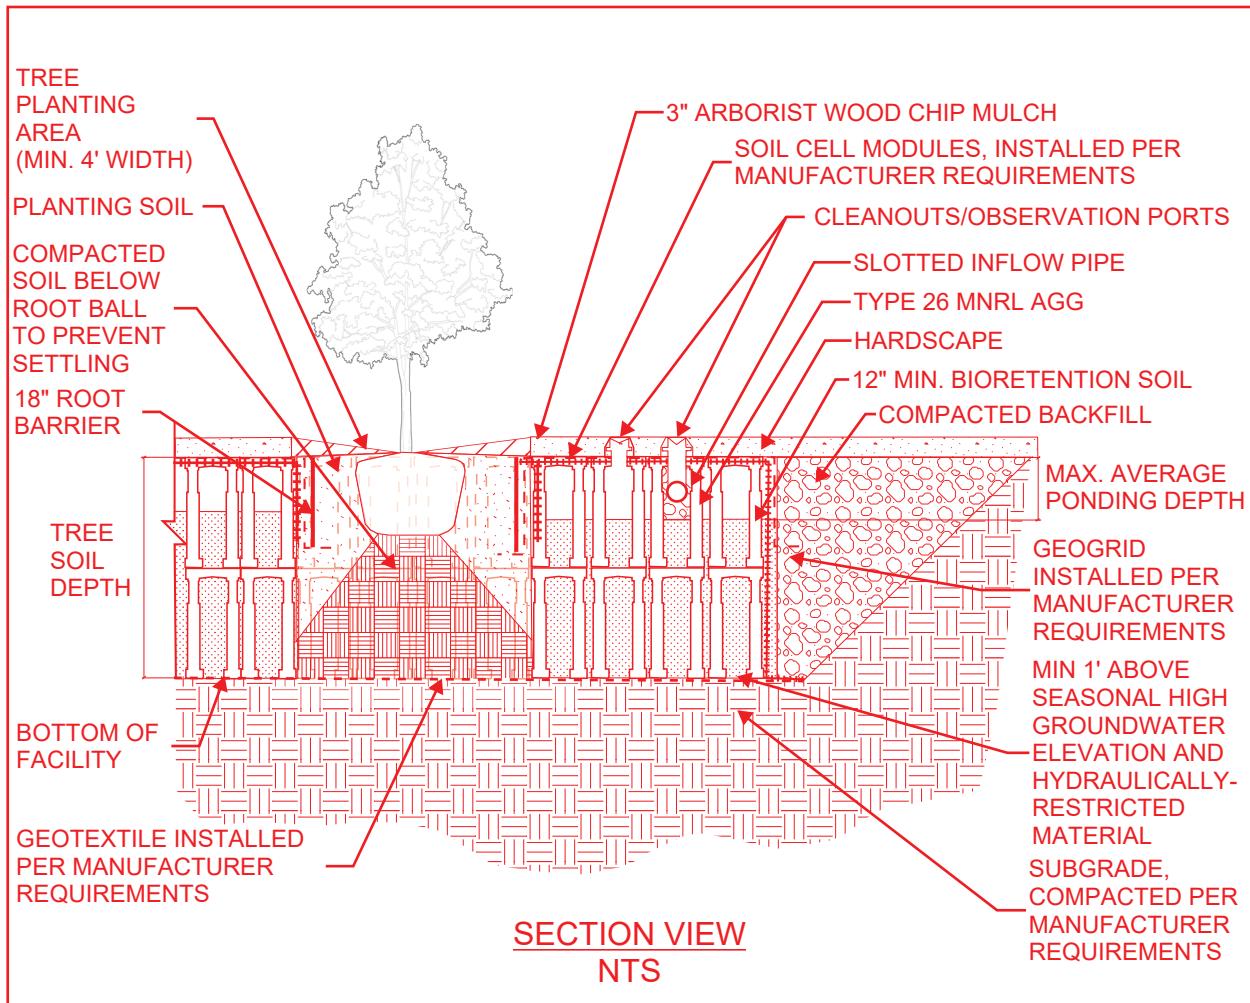


Figure 5.24. Infiltrating Soil Cell Bioretention (without Underdrain) Profile.

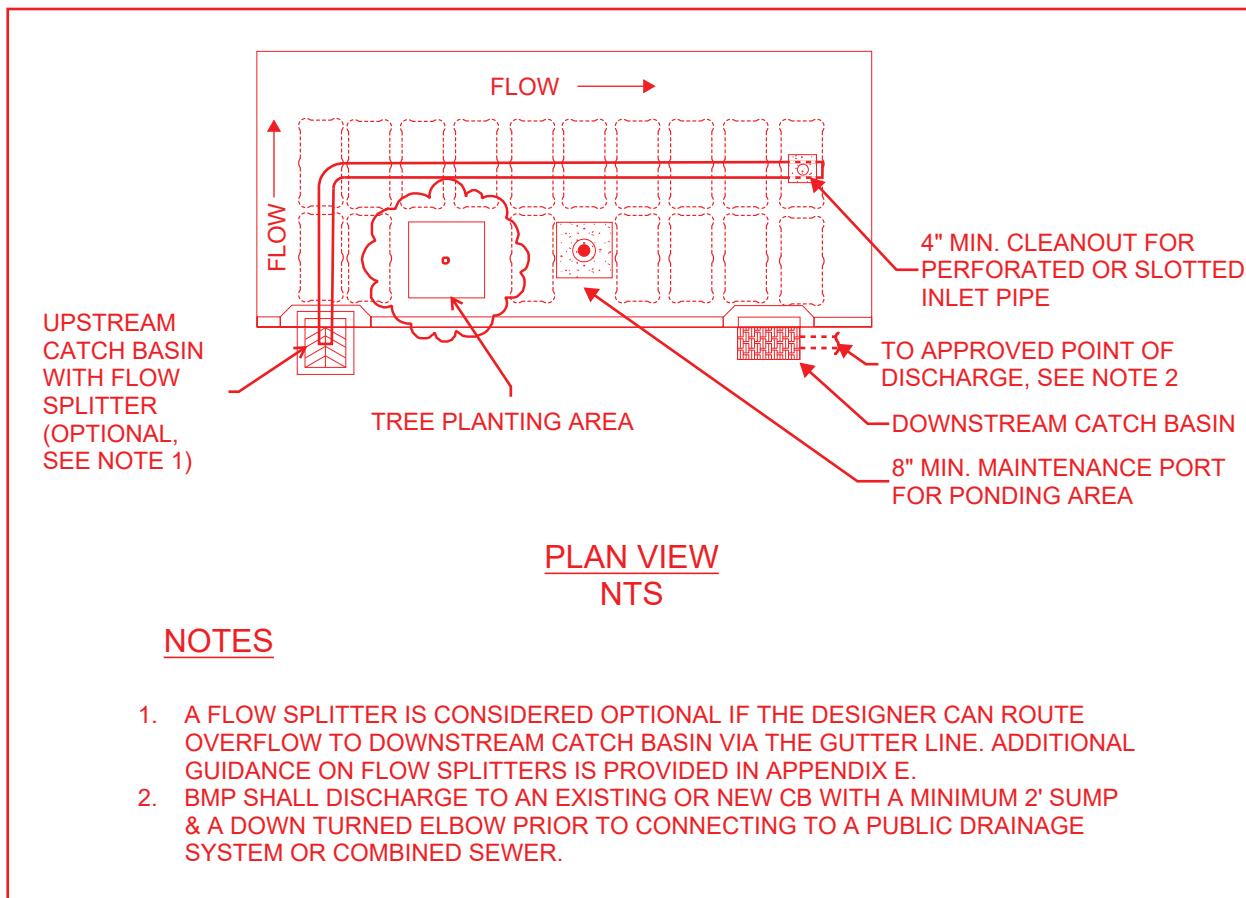


Figure 5.25. Infiltrating Soil Cell Bioretention (without Underdrain) Plan.

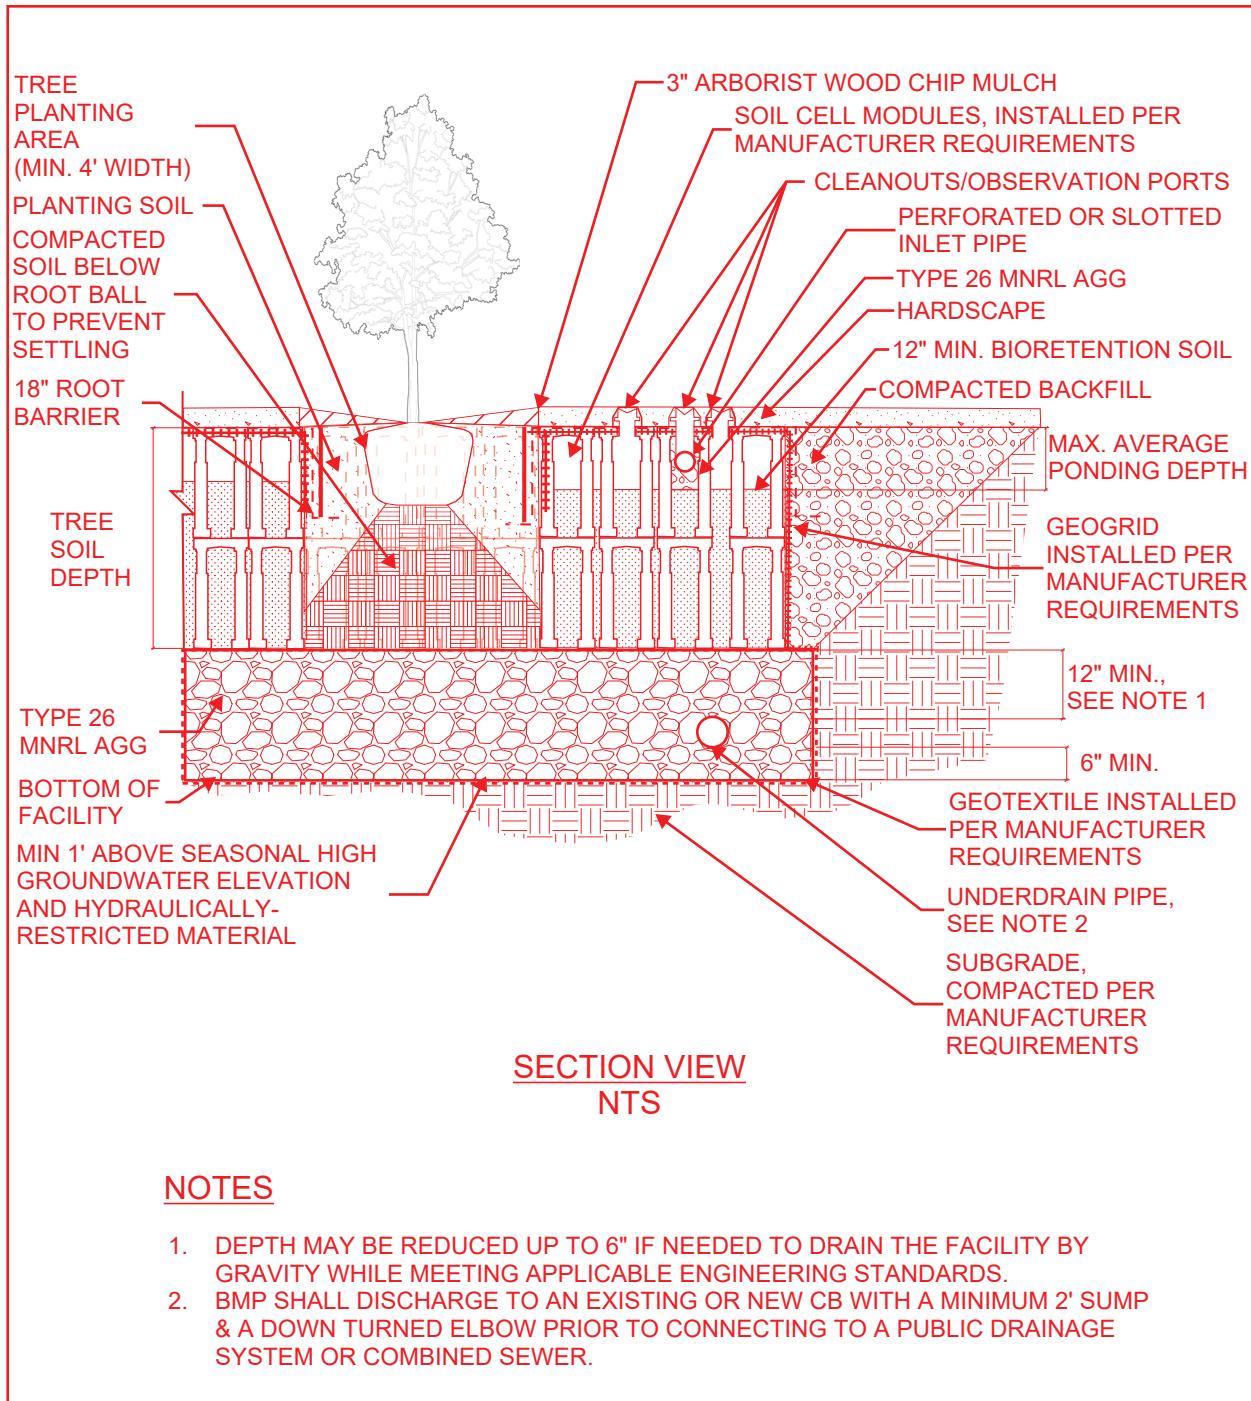


Figure 5.26. Infiltrating Soil Cell Bioretention (with Underdrain) Profile.

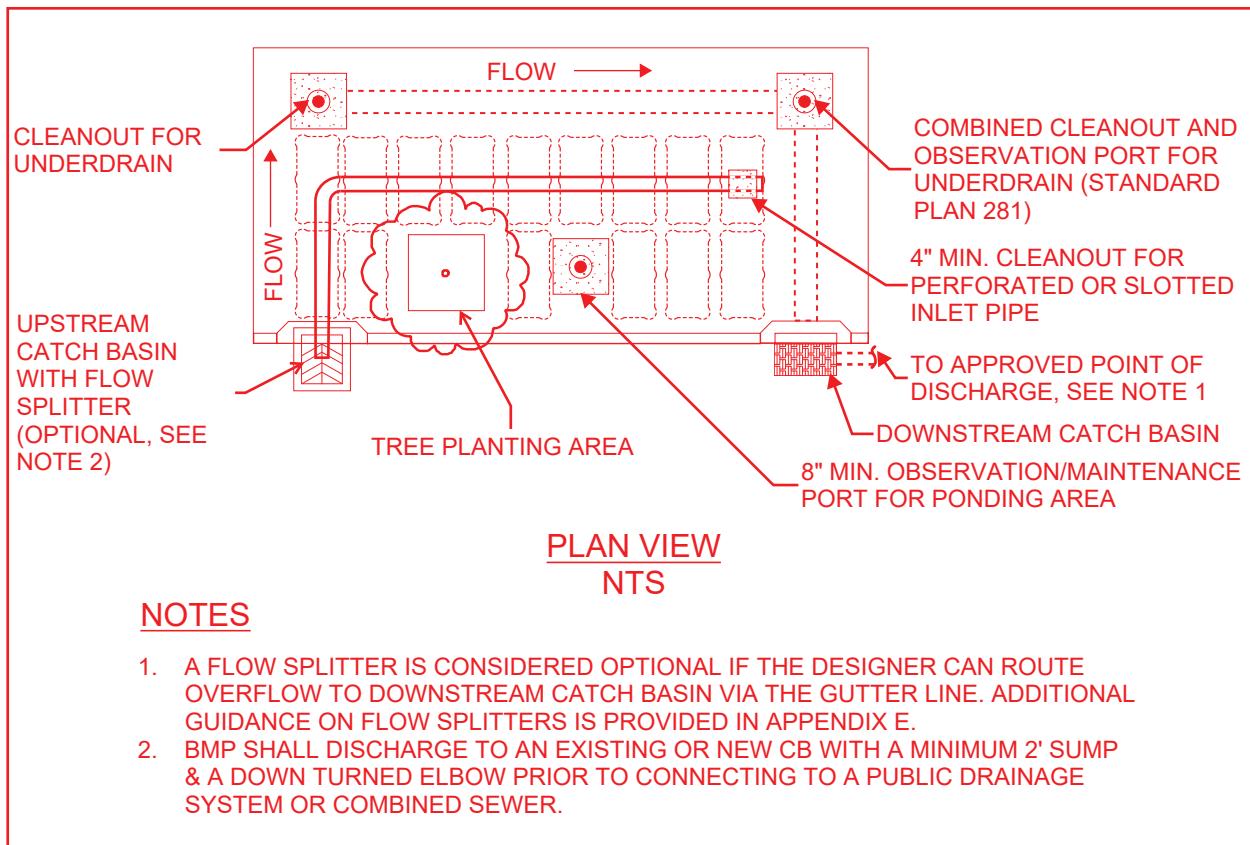


Figure 5.27. Infiltrating Soil Cell Bioretention (with Underdrain) Plan.

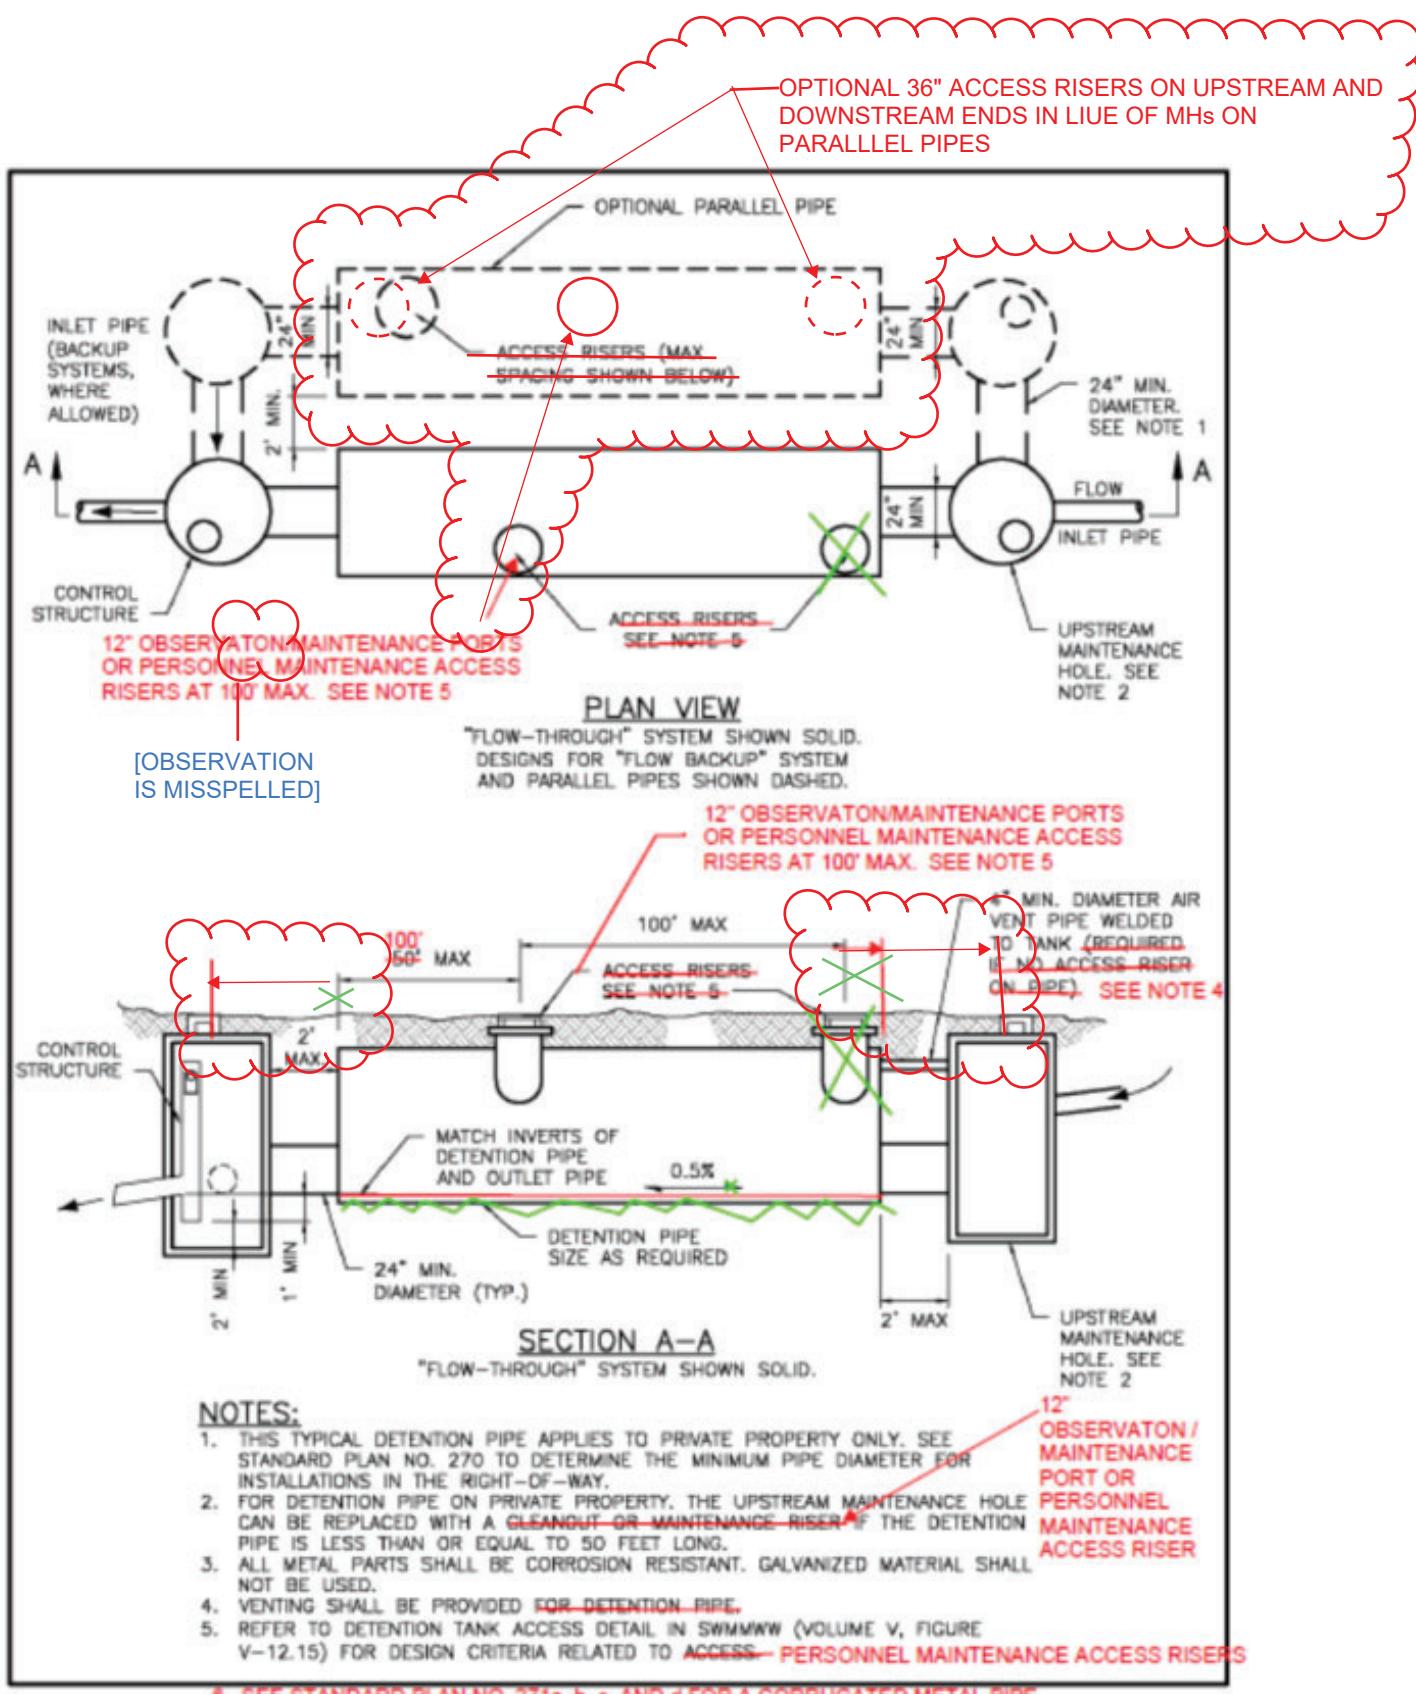


Figure 5.26

Typical Private Property Detention Pipe.

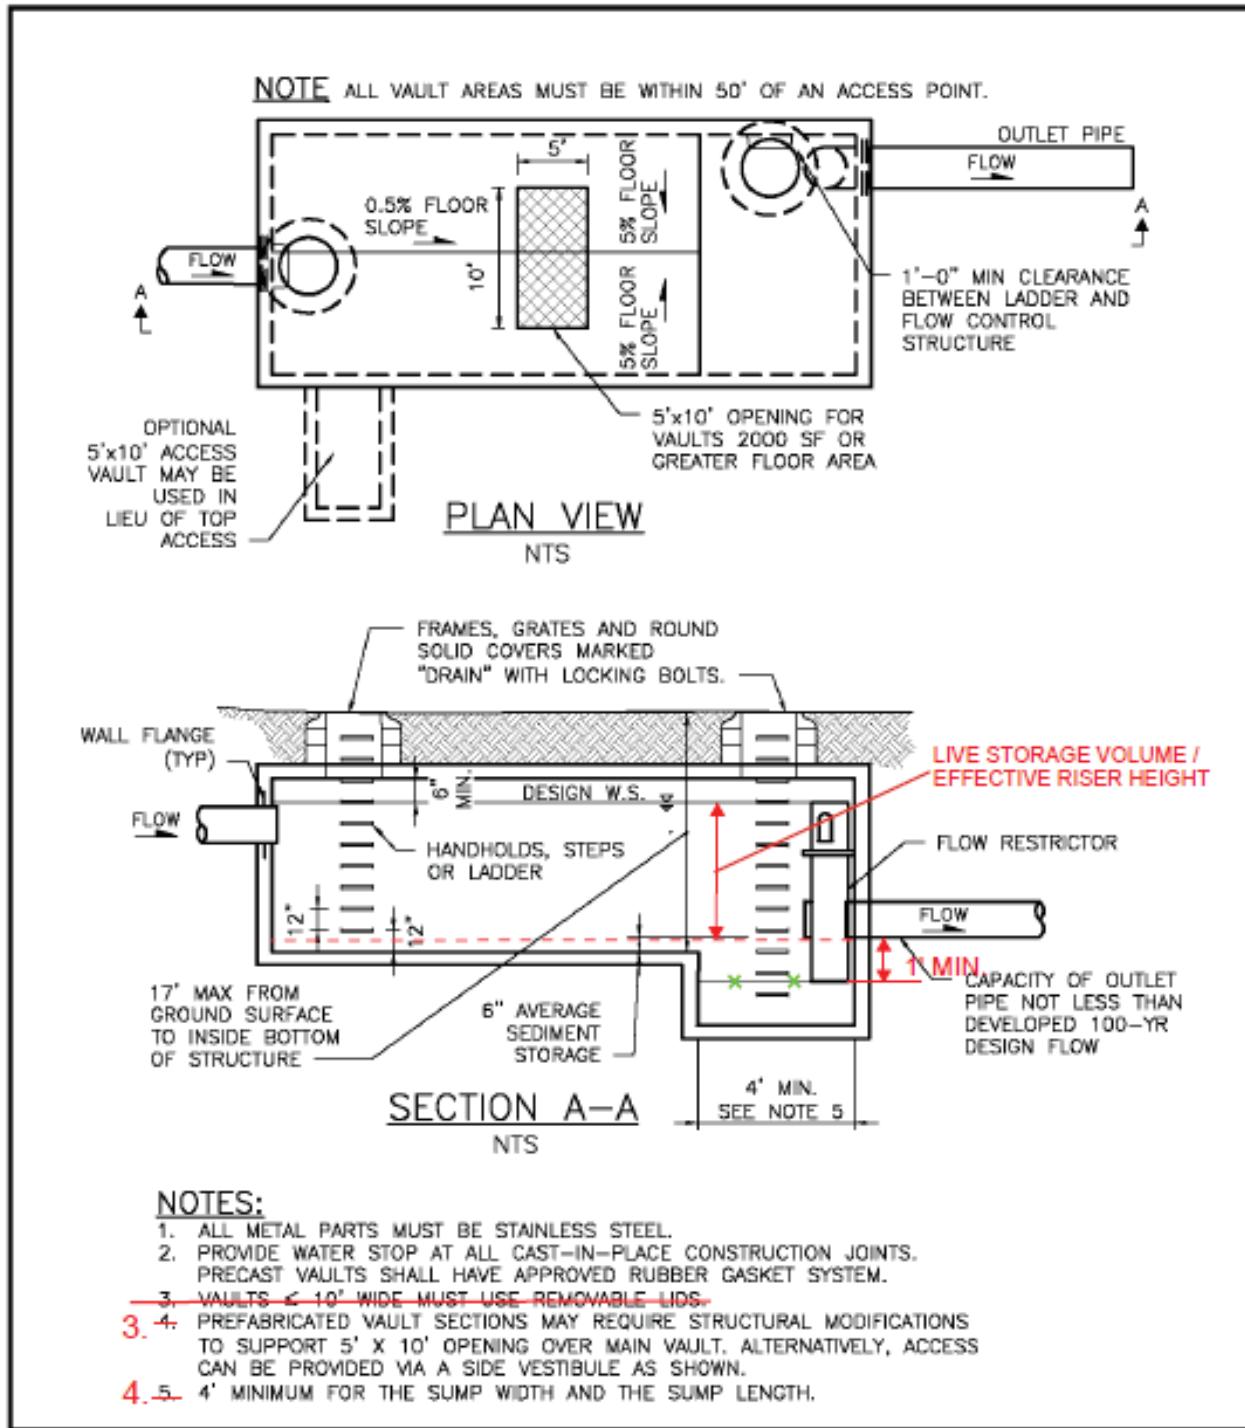


Figure 5.2729 Typical Detention Vault.

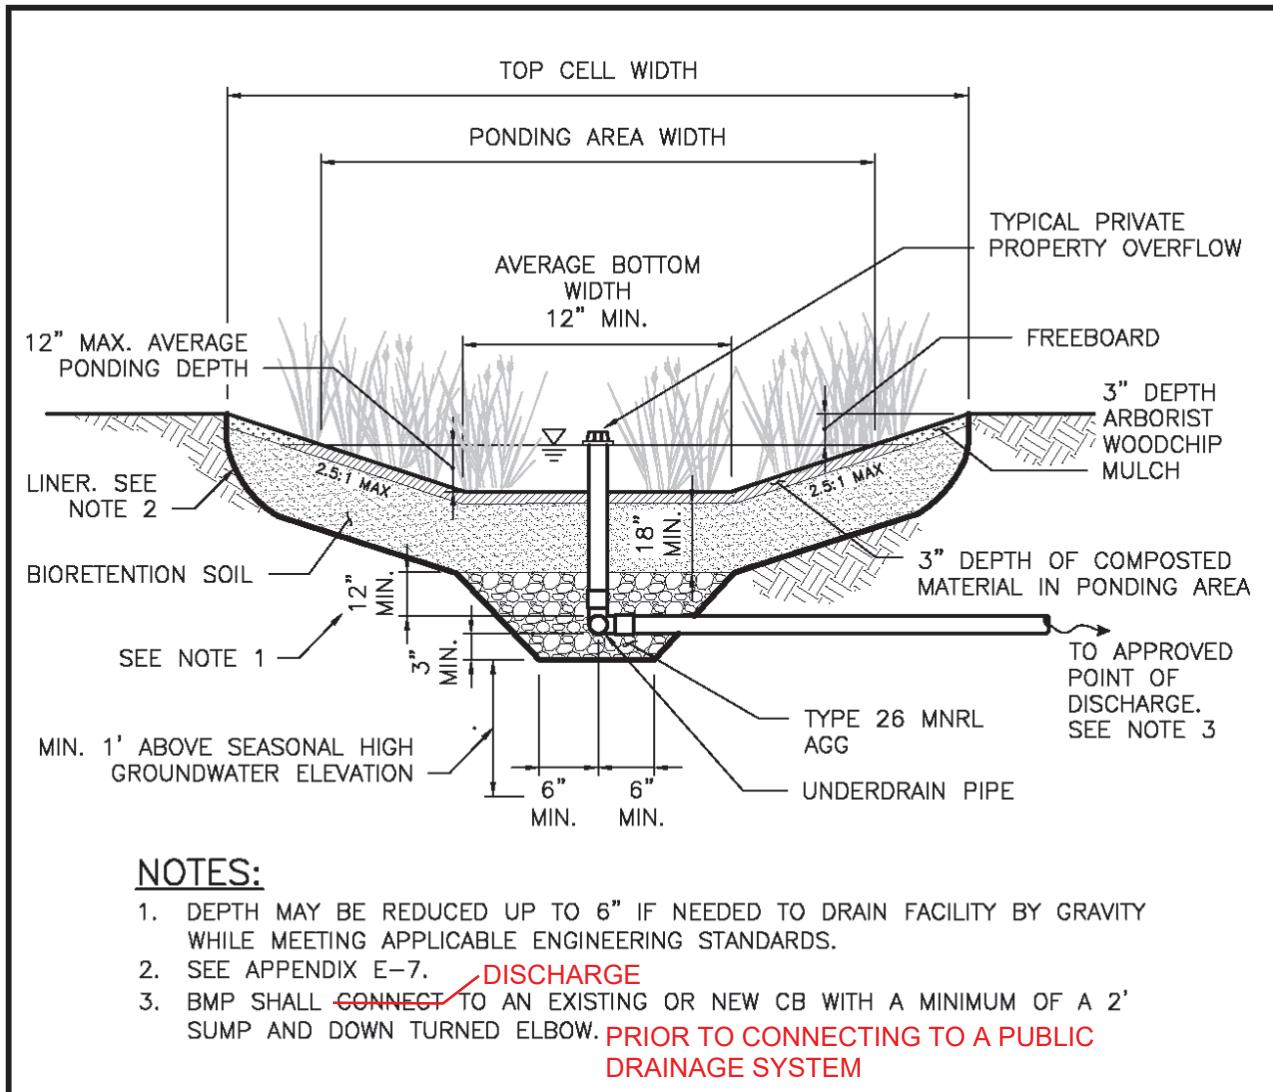


Figure 5.34. Non-infiltrating Bioretention Facility with Sloped Sides.

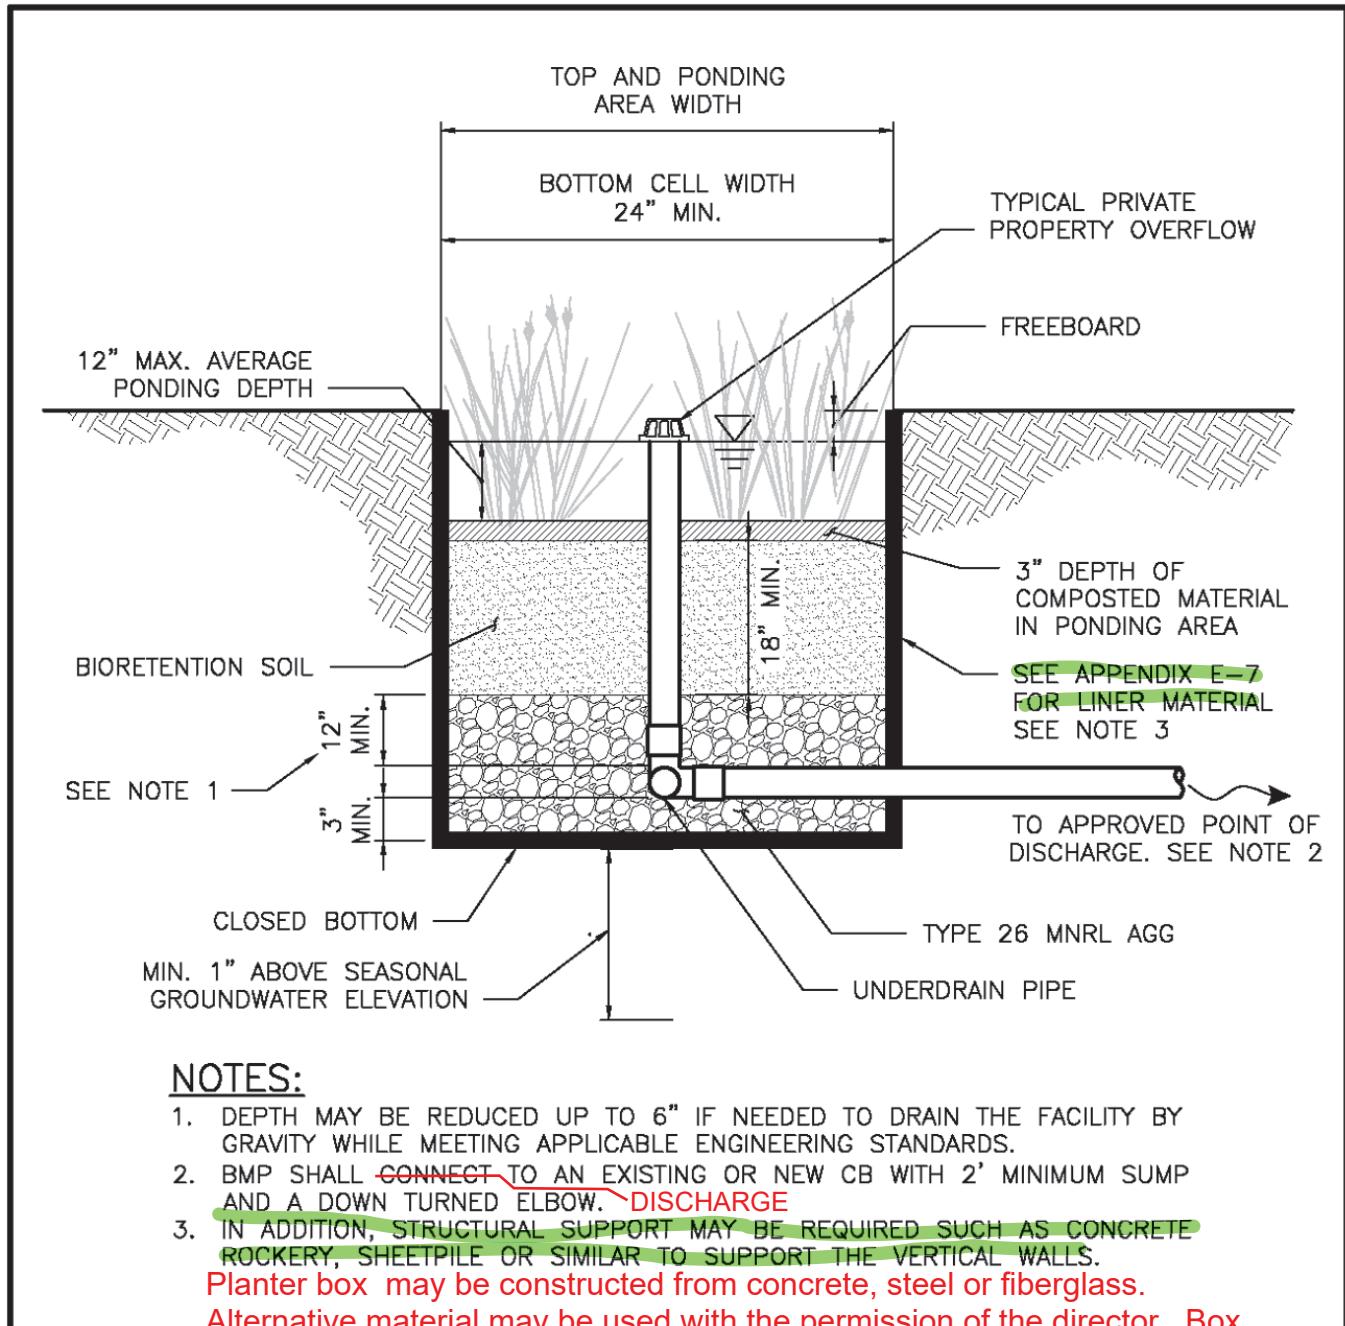


Figure 5.30. Non-infiltrating Bioretention Facility with Vertical Sides.

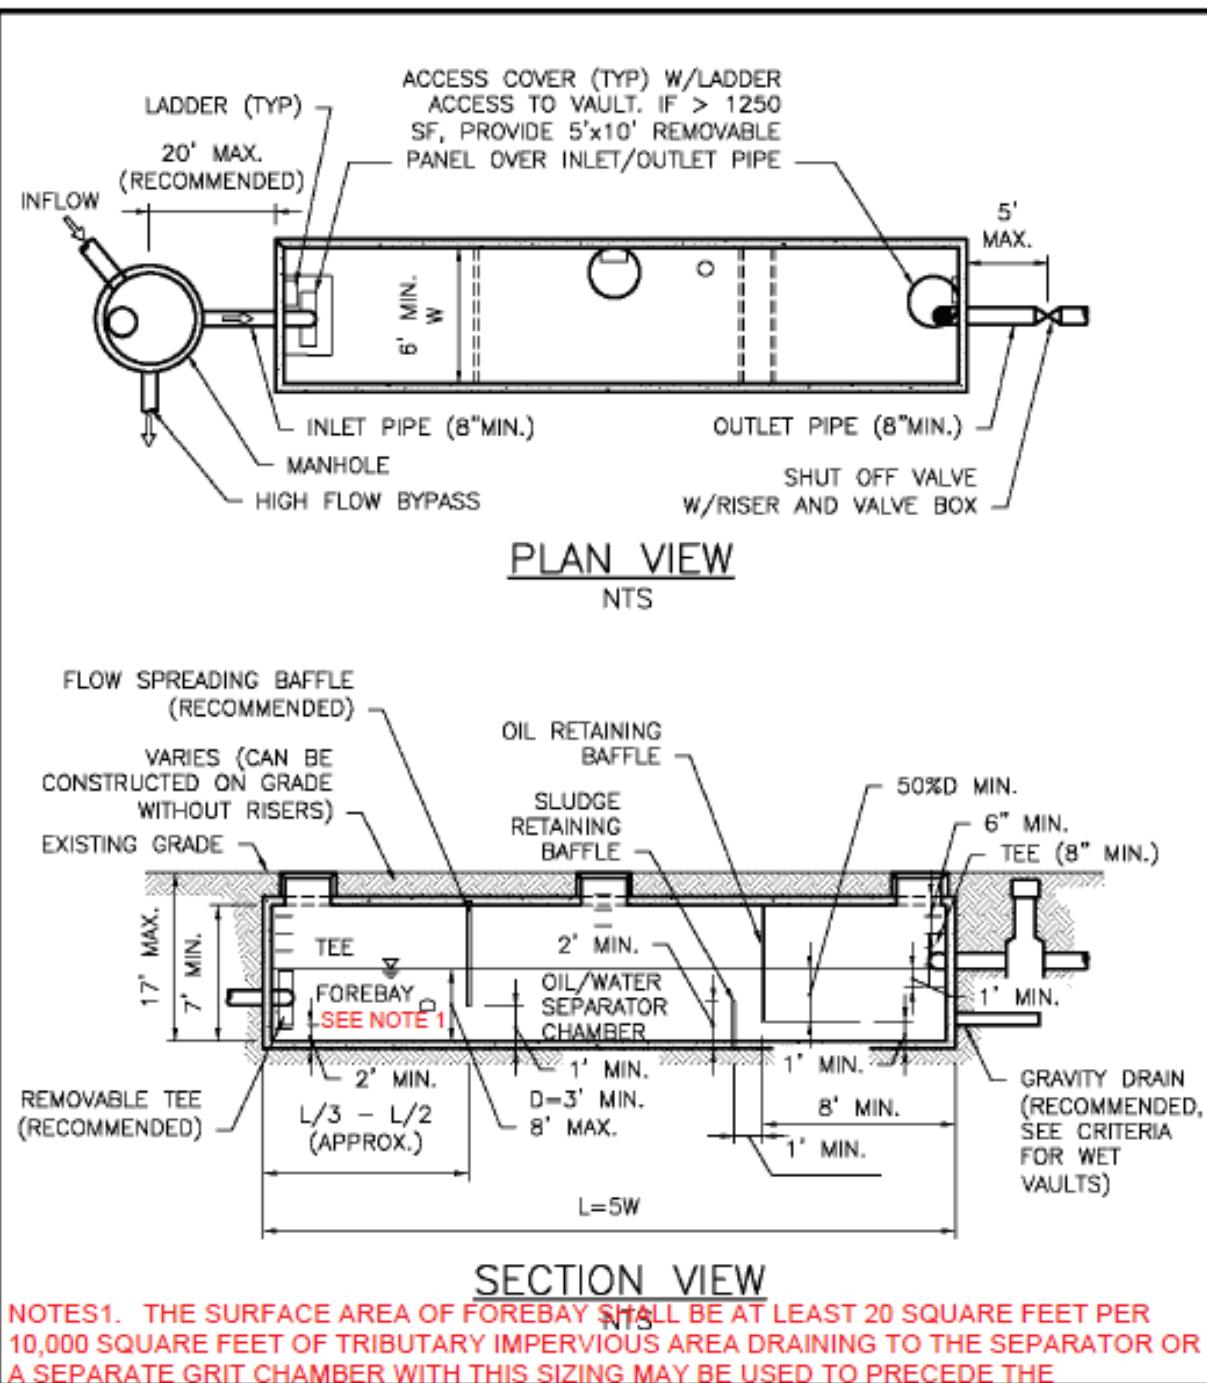


Figure 5.3335. Typical API (Baffle Type) Separator.
38

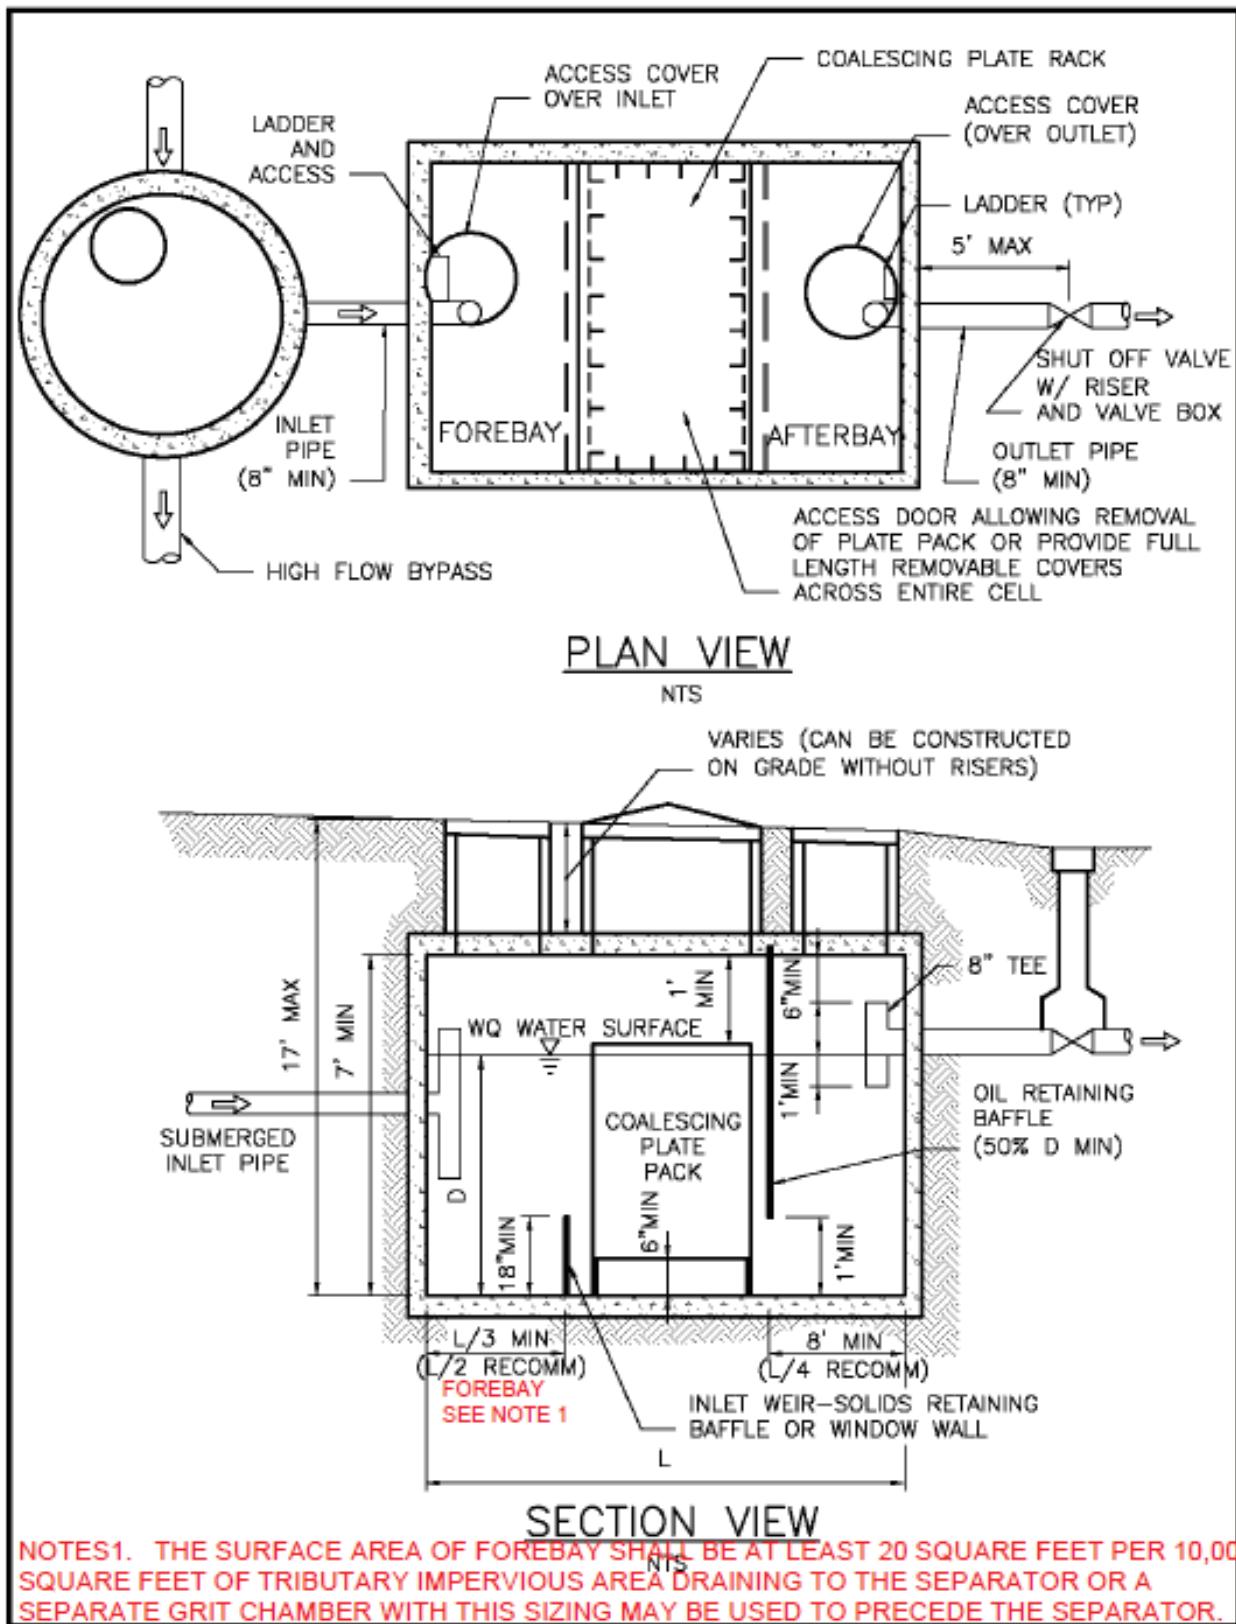


Figure 5.34 Typical Coalescing Place Separator.

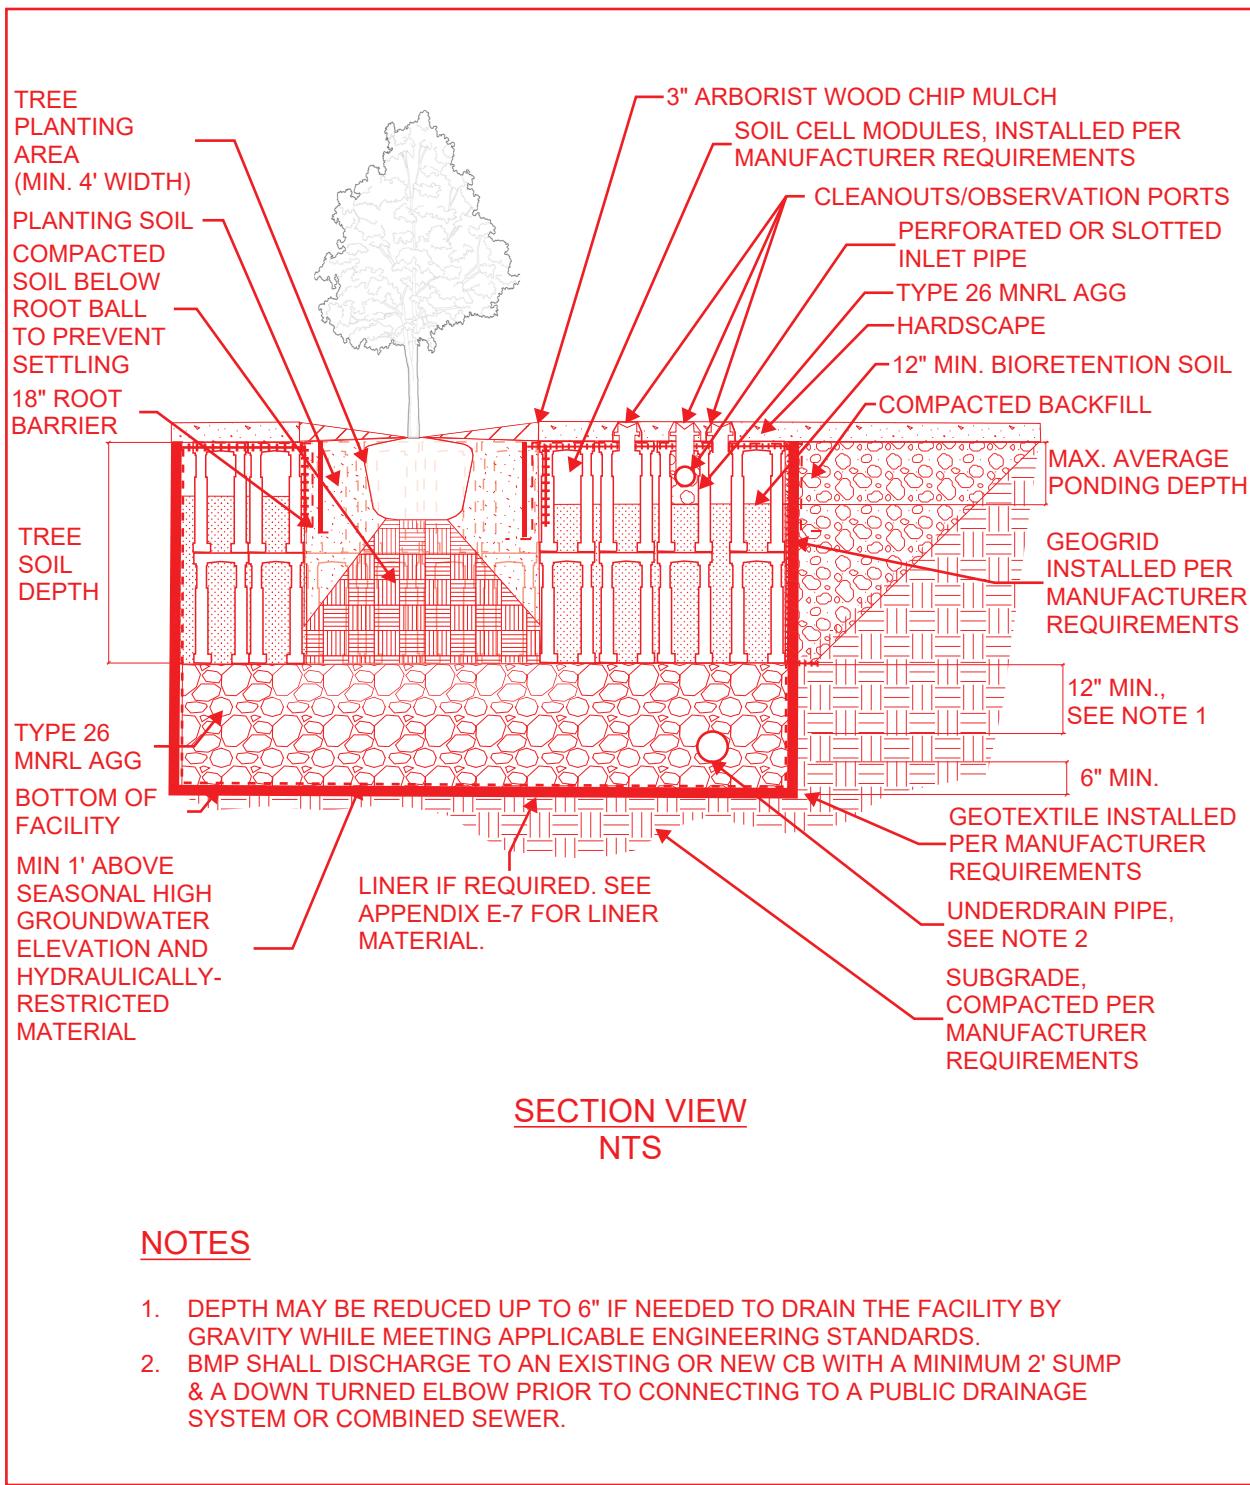


Figure 5.40. Non-infiltrating Soil Cell Bioretention Profile.

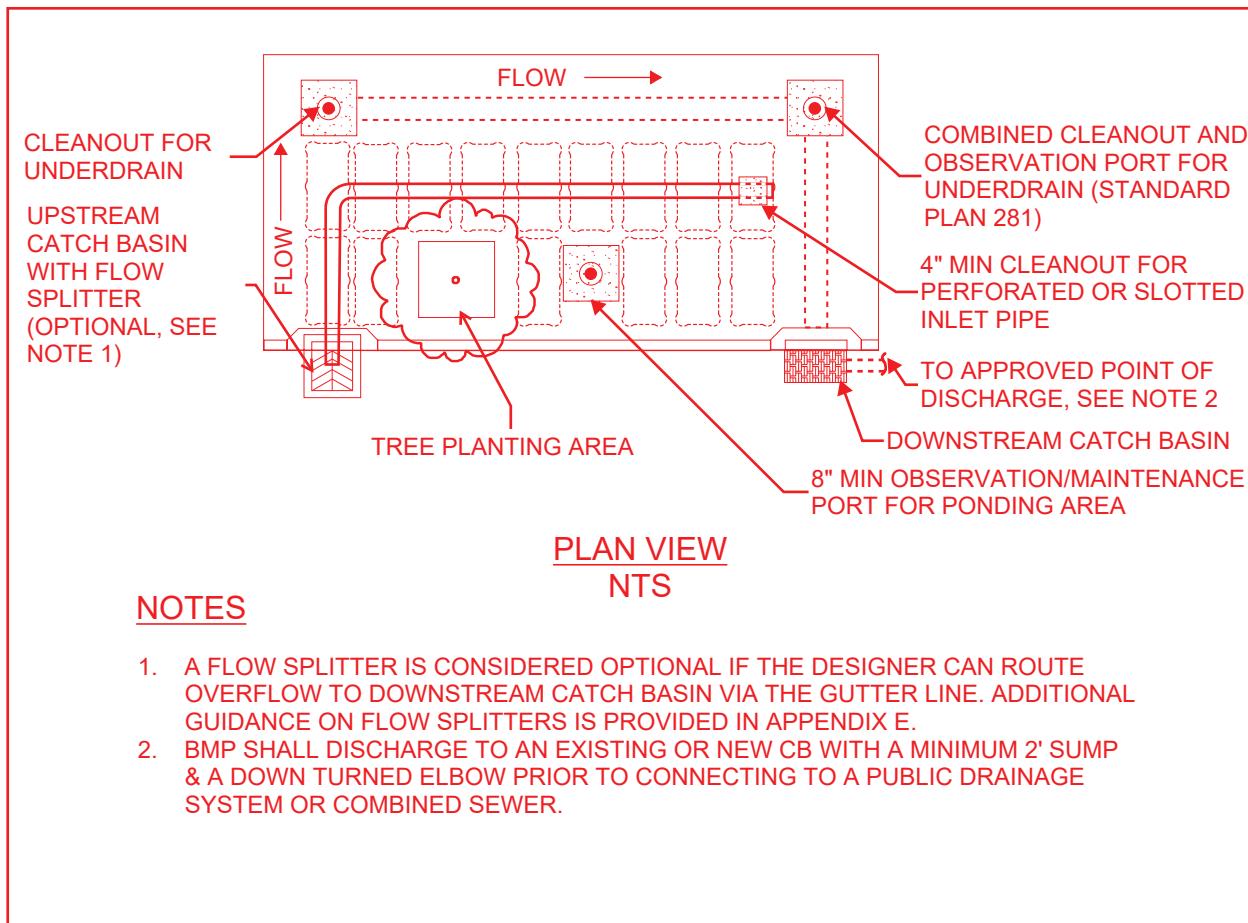


Figure 5.41. Non-infiltrating Soil Cell Bioretention Plan.

Figure Redlines for Volume 4 – Source Control

January 2026 Review Draft



Figure 2. Example of a labeled used cooking oil tote located on a level surface with a secure lid. (New Figure)


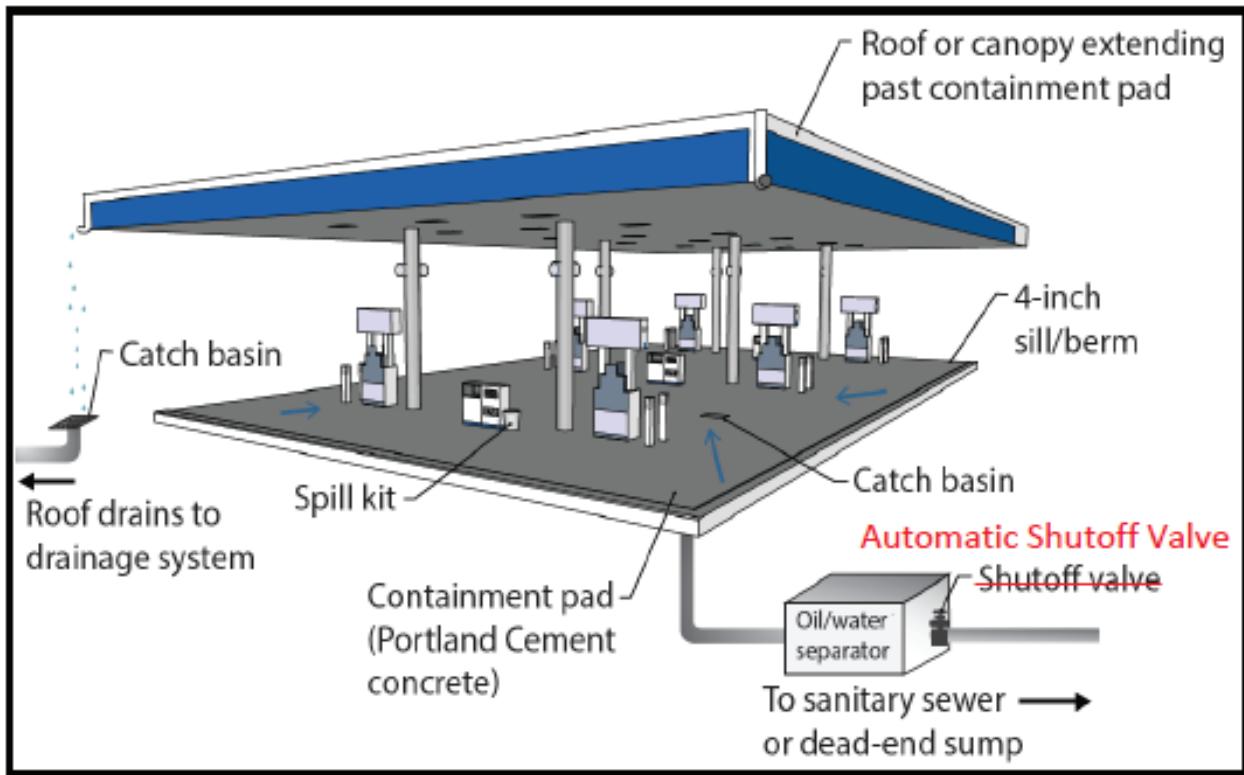


Figure 34. Fueling Island Schematic.

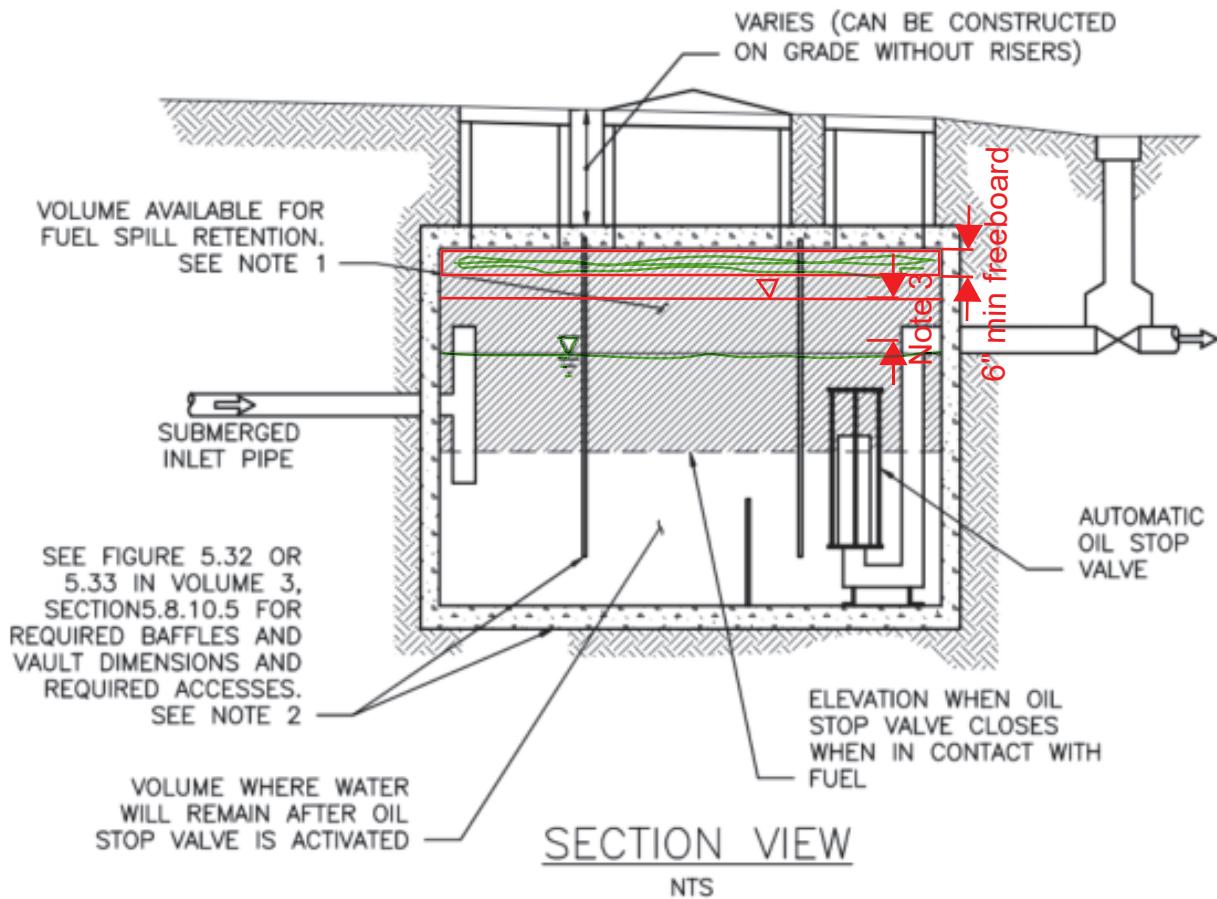

NOTES


1. THE VOLUME AVAILABLE FOR FUEL SPILL RETENTION MUST BE EQUAL TO OR GREATER THAN 15 MINUTES FOR THE FLOW RATE OF THE DISPENSING MECHANISM WITH HIGHEST THROUGH-PUT RATE OR 50 GALLONS, WHICHEVER IS GREATER.
2. FUEL PADS WITH NO RUN-ON), THEN THE SMALLEST AVAILABLE OIL/WATER VAULT THAT WILL RETAIN THE REQUIRED FUEL VOLUME MAY BE USED. IF THE OIL/WATER SEPARATOR RECEIVES STORMWATER, THEN IT MUST BE SIZED AND DESIGNED FOR THE WATER QUALITY FLOWRATE PER THE REQUIREMENTS VOLUME 3, SECTION 5.8.10.

FIG 6 – OIL/WATER SEPARATOR FOR FUEL SPILL RETENTION

Note 3: Distance from the max water surface elevation to the centerline of the outlet must be equal to or greater than the headloss through the valve for the design flow.


Figure Redlines for Appendix E

January 2026 Review Draft

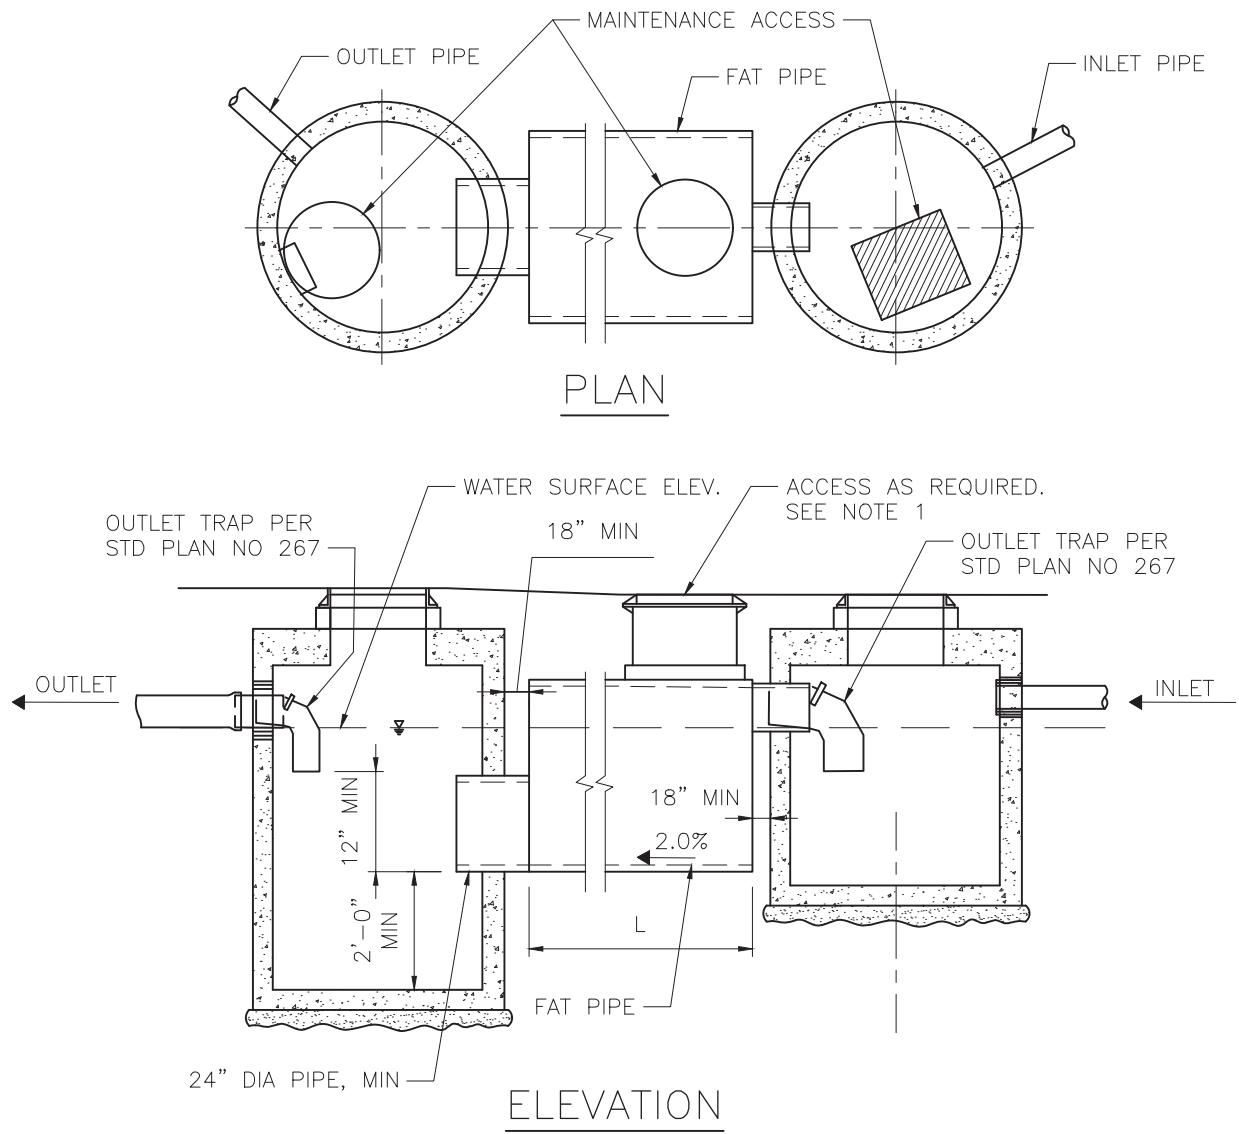

PRESETTLING FAT PIPE 1
61

Figure E.9. "Fat Pipe" Presettling Vault.

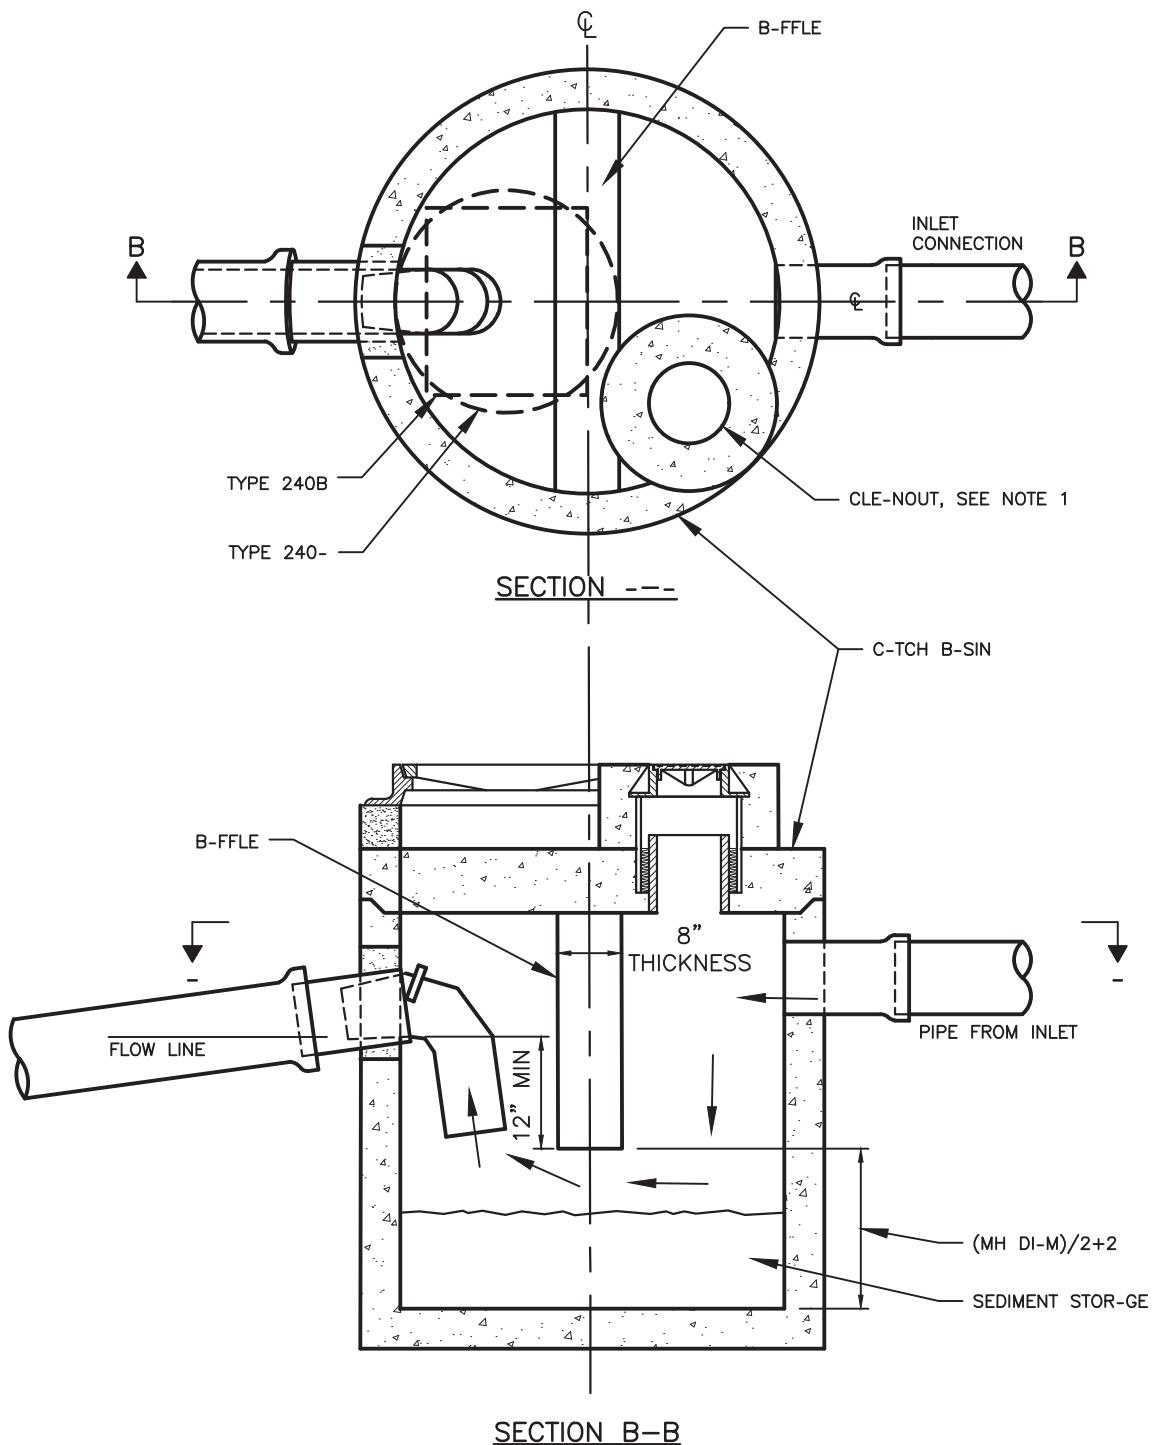

NOTES:

1. FOR CB LESS TH-N 60" DI-M, PROVIDE CLE-N-OUT -CESS WITH FR-ME -ND COVER PER STD PL-N NO 280 ON THE INLET SIDE. STRUCTURE 60" DI-M OR GRE-TER MUST PROVIDE ST-ND-RD CB FR-ME -ND COVER ON BOTH SIDES OF THE B-FFLE FOR -CESS.

Figure E.10. Catch Basin/Maintenance Hole with an Extended Sump and a Baffle.

EXTENDED SUMP

Figure Redlines for Appendix J

January 2026 Review Draft

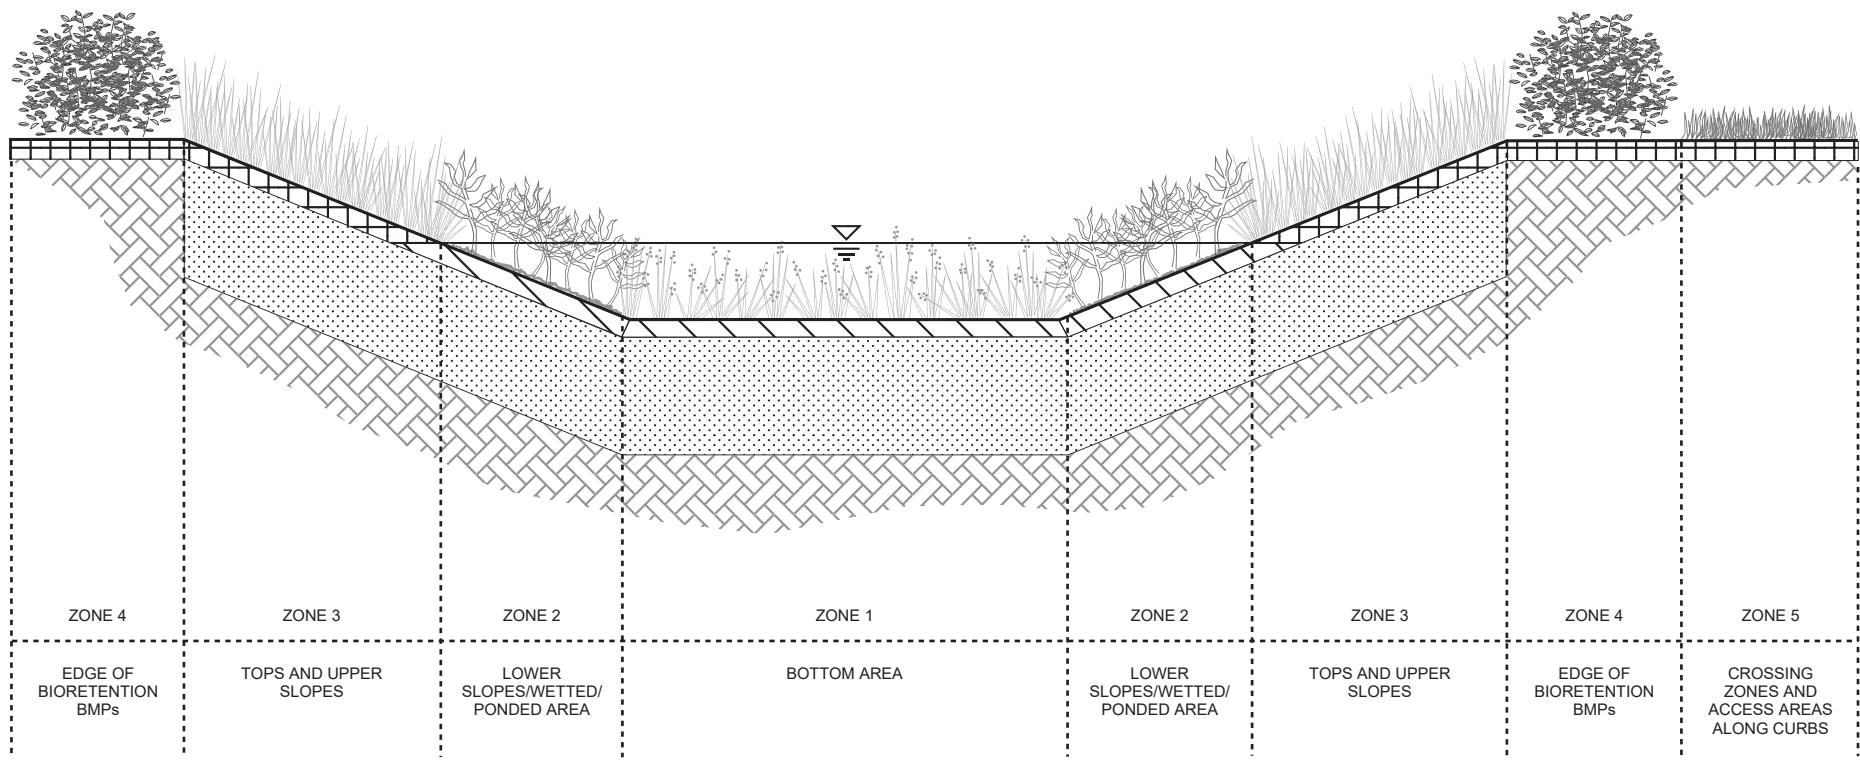


Figure J.1. Bioretention Planting Zones.