

SDOT-TRANSPORTATION OPERATIONS CONCURRENCE PRIOR TO CONSTRUCTION		
ROUTING	DATE	INITIAL


- L-P/4W2 (PAINT) 4-IN WHITE 2'-4' SKIP LINE
- L-P/4WS (PAINT) 4-IN WHITE SOLID STRIPE
- L-P/4YD (PAINT) TWO PARALLEL 4-IN YELLOW SOLID STRIPES WITH 4-IN GAP BETWEEN STRIPES AND A TYPE 2A RPM EVERY 30-FT ON CENTER
- L-P/SL16 (PAINT) 16-IN WHITE STRIPE
- L-P/XWK (PAINT) PAIRS OF LONGITUDINAL 8-IN WHITE BARS WITH AN 8-IN GAP BETWEEN, REPEATED IN A PATTERN AVOIDING WHEELS PATHS PEDESTRIAN PATH
- L-T/6WS (THERMOPLASTIC) 6-IN WHITE SOLID STRIPE
- L-T/SL24 (THERMOPLASTIC) 24-IN WHITE STRIPE
- L-T/4Y2 (THERMOPLASTIC) 4-IN YELLOW 2'-4' SKIP LINE
- L-T/4Y3 (THERMOPLASTIC) 4-IN YELLOW 3'-6' SKIP LINE
- L-T/4YS (THERMOPLASTIC) 4-IN YELLOW SOLID STRIPE
- L-T/XWK (THERMOPLASTIC) PAIRS OF LONGITUDINAL 8-IN WHITE BARS WITH AN 8-IN GAP BETWEEN, REPEATED IN A PATTERN AVOIDING WHEELS PATHS PEDESTRIAN PATH

### CHANNELIZATION LEGEND

- L-TP28W 28-IN WHITE TUFF POST
- L-SP909 18-IN BARRIER PER STD 909
- L-SP910 18-IN BULLNOSE PER STD 910
- S-T/720C (THERMOPLASTIC) RIGHT ARROW SYMBOL PER COS STD 720C
- S-T/721A (THERMOPLASTIC) LEFT & THROUGH ARROW SYMBOL PER COS STD 721A
- S-T/721B (THERMOPLASTIC) RIGHT & THROUGH ARROW SYMBOL PER COS STD 721B
- S-T/730A (THERMOPLASTIC) "ONLY" LEGEND PER COD STD 730A
- S-T/770A (THERMOPLASTIC) HELMETED BICYCLIST SYMBOL WITH ARROW PER COS STD 770A
- S-T/771A (THERMOPLASTIC) SHARROW SYMBOL PER COS STD 771A
- S-T/780A (THERMOPLASTIC) ONE-WAY GREEN/WHITE CROSS BIKE PER COS STD 780A
- S-T/780B (THERMOPLASTIC) TWO-WAY GREEN/WHITE CROSS BIKE PER COS STD 780B
- S-T/781 (THERMOPLASTIC) TWO-WAY GREEN DRIVEWAY BIKE PER COS STD 781

### GENERAL NOTES

2. REMARK CROSSWALKS/STOP LINES IF IN POOR CONDITION.

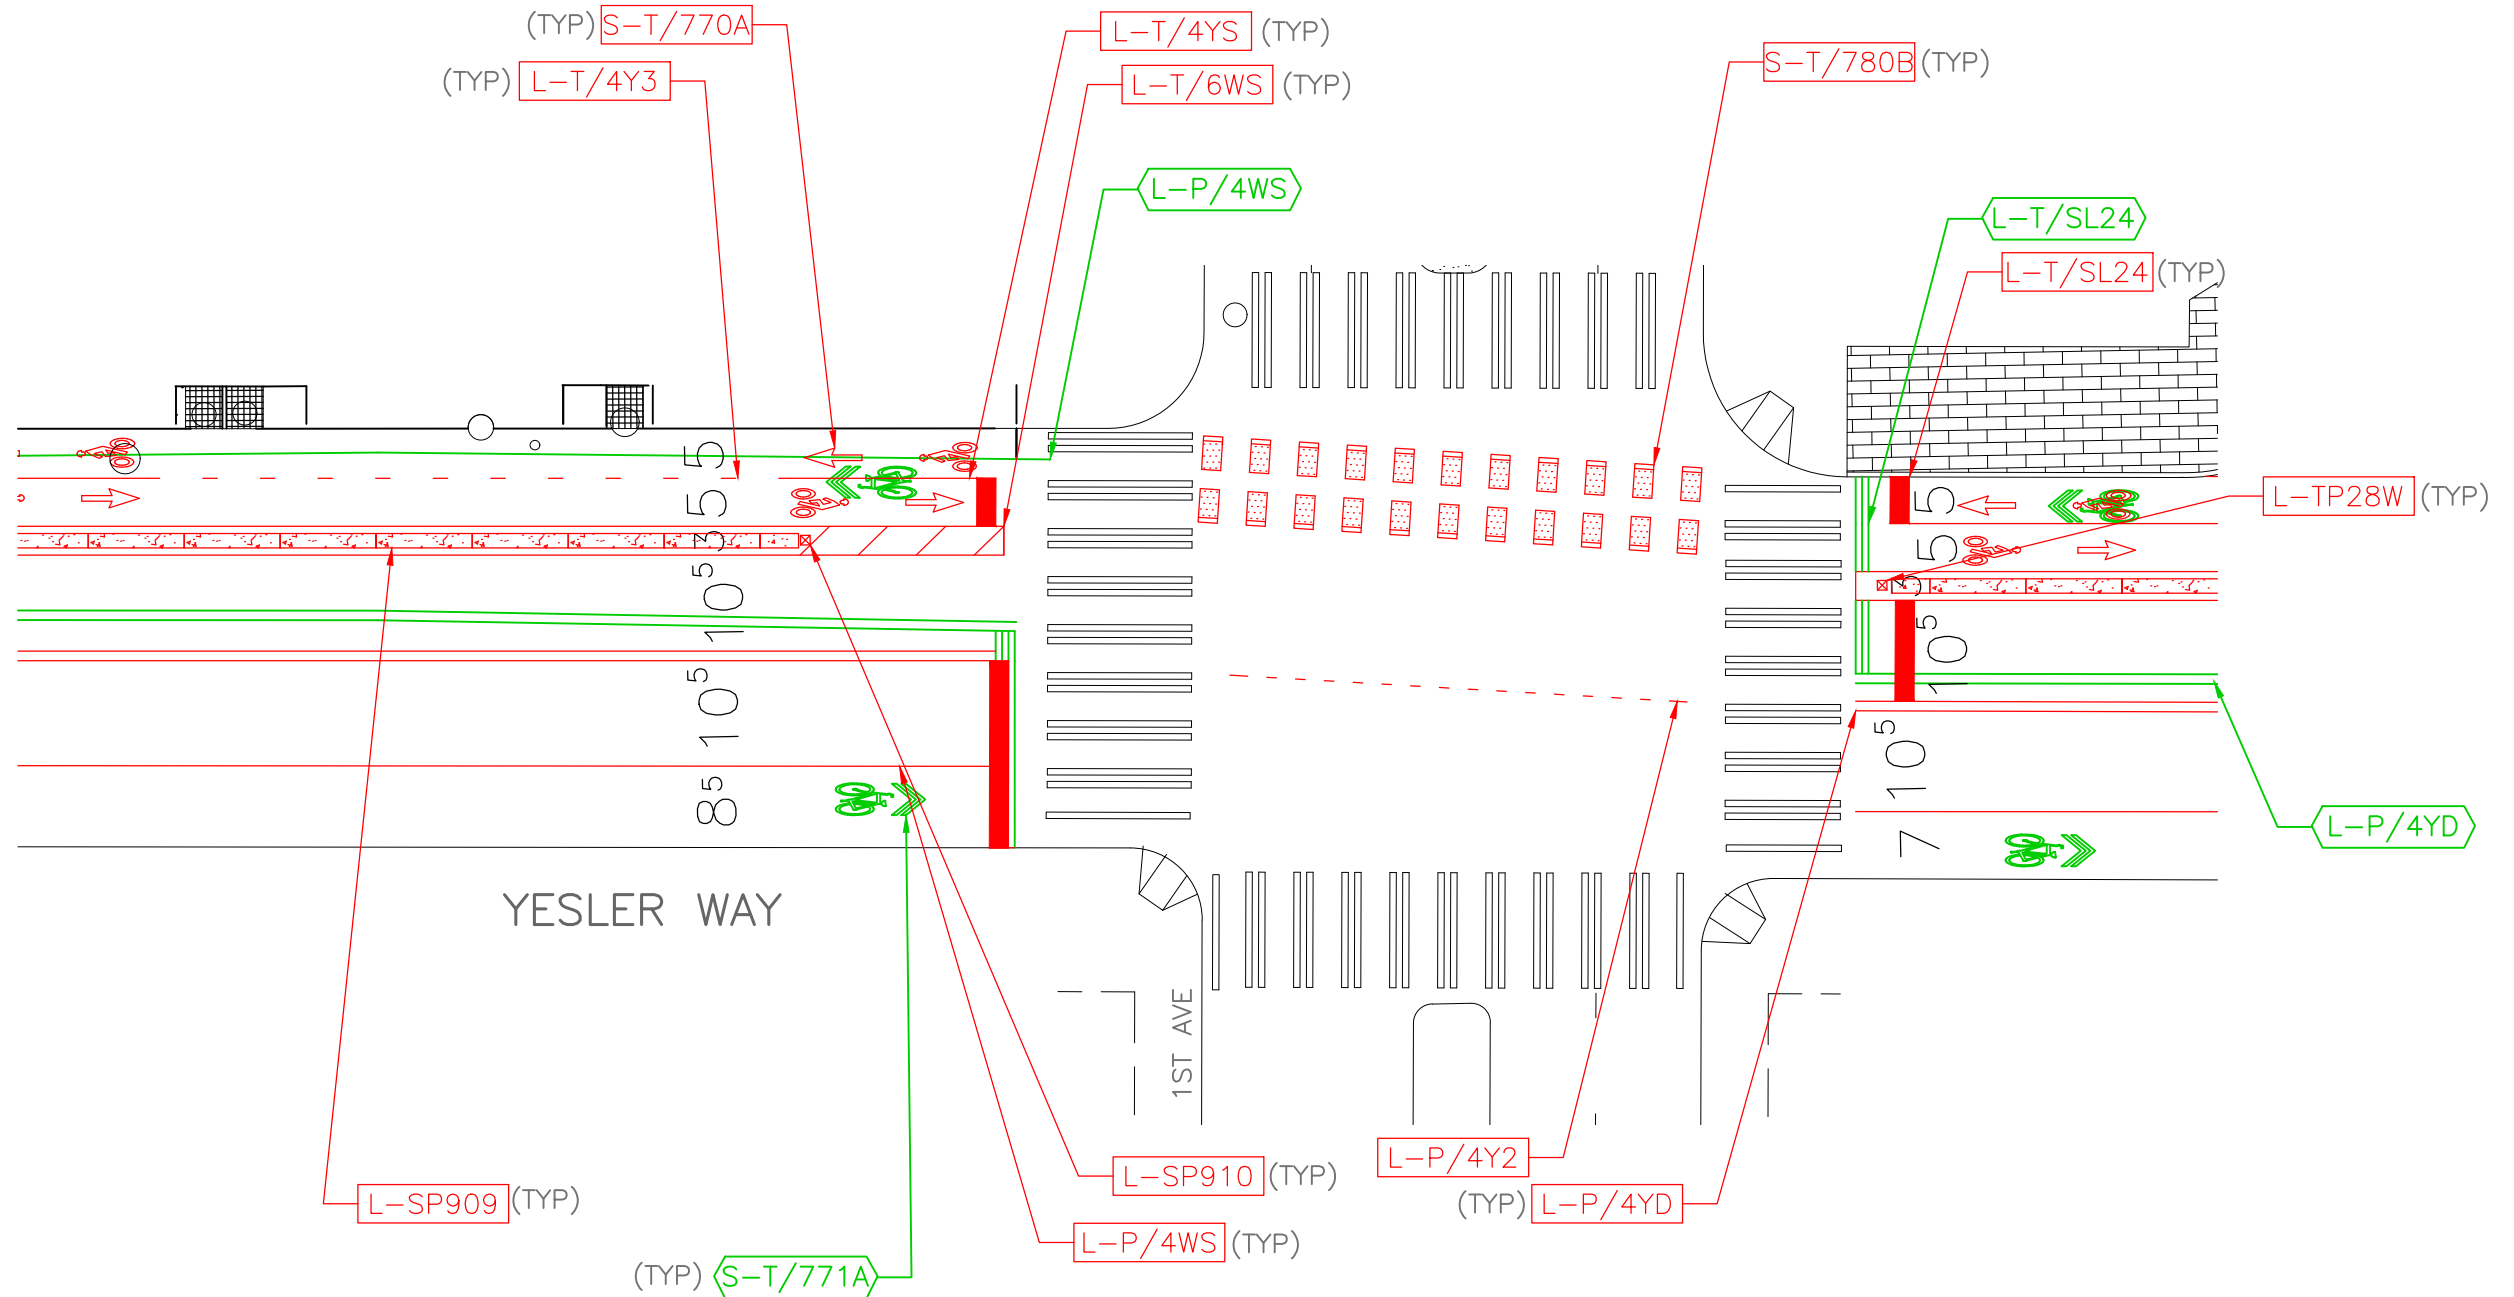

**WO# 1099716**  
**SPEEDTYPE: TRC0987-S0300**

YESLER WAY AND 1ST AVE  
 CHANN

APPROVED FOR ADVERTISING  
 LIZ ALZEER  
 DEPARTMENT OF FINANCE & ADMINISTRATIVE SERVICES  
 SEATTLE, WASHINGTON . . . . . 20 . . . . .

INITIALS AND DATE		INITIALS AND DATE	
DESIGNED	CHECKED	REVIEWED:	CONST.
		DES.	PROJ. MGR.
		SDOT	
DRAWN	CHECKED	RECEIVED	REVISD AS BUILT

**Seattle Department of Transportation**

ORDINANCE NO. PW NO.  
 SUBPROJECT ID:  
 SCALE:

**YESLER PROTECTED BICYCLE LANE CONNECTION**

PC CO  
 VPI #  
**CH2**  
 SHEET 2 OF 3

ALL WORK SHALL BE DONE IN ACCORDANCE WITH THE CITY OF SEATTLE STANDARD PLANS AND SPECIFICATIONS AND OTHER DOCUMENTS CALLED FOR IN SECTION 0-02.3 OF THE PROJECT MANUAL.

C:\Users\galloga\OneDrive - City of Seattle\2\_PostPIS\_2026 Work Plan\Projects\1C - Yesler Way btwn Occidental Ave and Western Ave - Signs Marking PBL - U:\2B MSP\Design\Y - City of Seattle\Yesler PBL Connection\_Chann uG2.dwg  
 Jan-21-26 12:21pm  
 VAILT SERIAL NO. DATE MARK NATURE REVISIONS MADE CHK'D REV'D

