NOTE: INSTALL NEW S.S. FLASHING AROUND CHIMNEY. INSTALL COUNTER FLASHING REGLET AROUND CHIMNEY A MIN. 7" HIGH FROM ROOF MEMBERS. CAULK REGLET. EXTEND MODIFIED BITUMEN FLASHING UP BENEATH COUNTER FLASHING FOR 4" LAP. AT LEAST ELEVATION EXIST. ROOF: INSTALL NEW S.S. CAP FLASHING AS SHOWN IN ELEVATION.

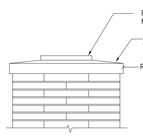

1 CHIMNEY CAP DETAIL
SCALE 1"=1'-0"

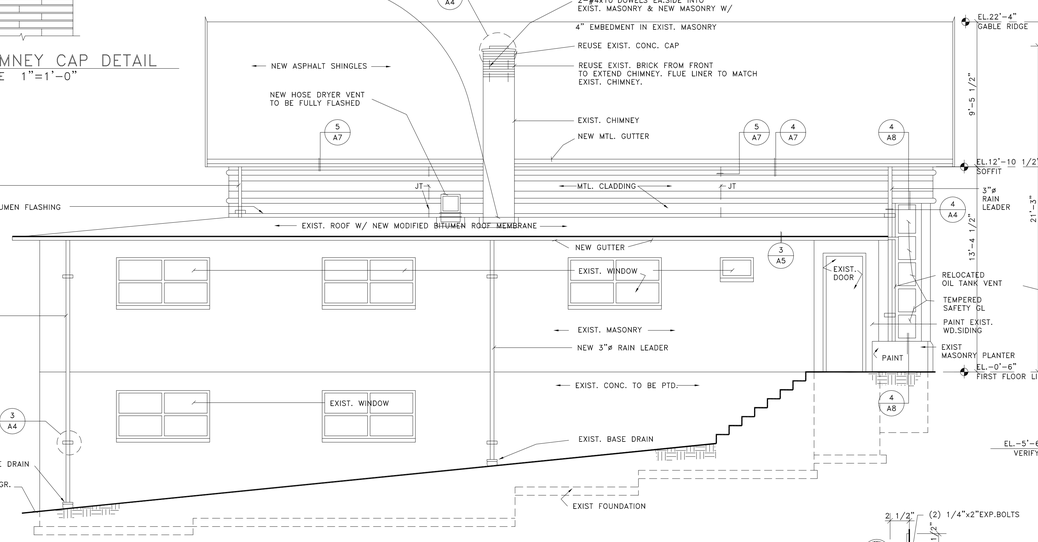

SOUTH ELEVATION
SCALE 1/4"=1'-0"

NOTE: REMOVE EXIST. GABLE LIGHT FIXTURE

O.H. DOOR & STOREFRONT SYSTEM CONTRACTORS NOTE:

SPACING & COORDINATION OF MULLIONS IS CRITICAL. DOOR & WINDOW MULLIONS MUST LINE UP. DIMENSIONS SHOWN ARE CRITICAL. SHOP DRAWING SUBMITTALS MUST INDICATE MULLION SPACING FOR APPROVAL BY ARCHITECT.

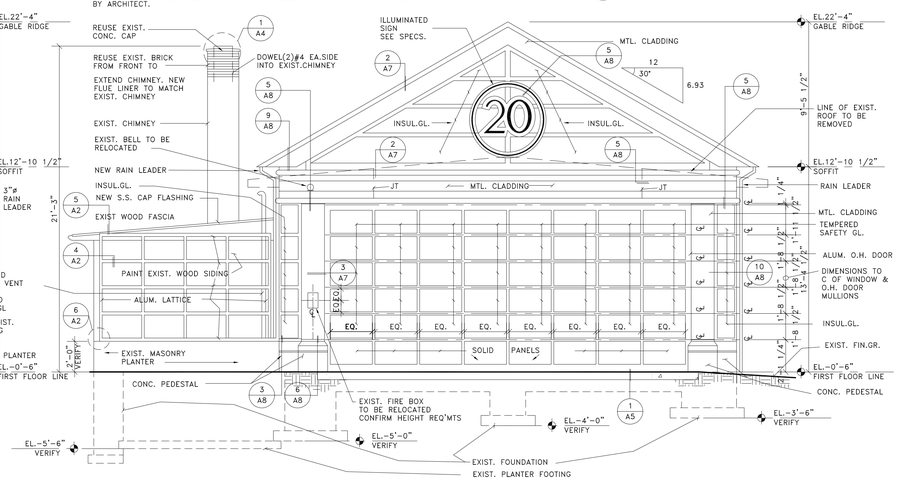

EAST ELEVATION
SCALE 1/4"=1'-0"

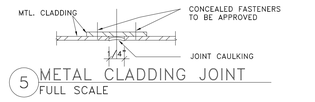

5 METAL CLADDING JOINT
FULL SCALE

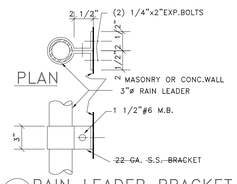

PLAN

3 RAIN LEADER BRACKET
SCALE 1 1/2"=1'-0"

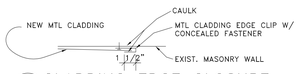

4 CLADDING EDGE CLOSURE
SCALE 1 1/2"=1'-0"

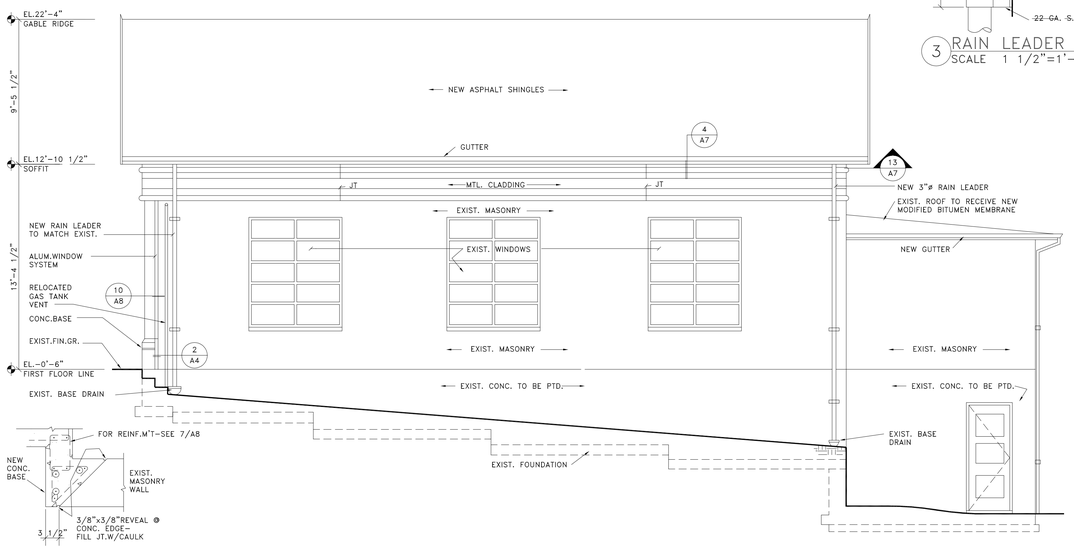

3 CONC.BASE
SCALE 3/4"=1'-0"

NORTH ELEVATION
SCALE 1/4"=1'-0"

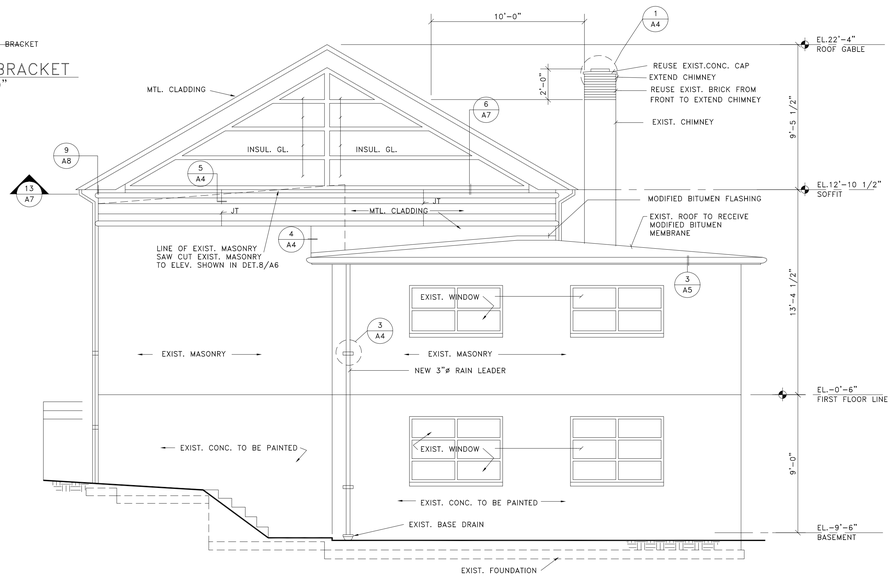

WEST ELEVATION
SCALE 1/4"=1'-0"

NOTE:
TOUCH UP PAINT WORK UNDER EXIST. SOFFIT


APPROVED BY DEPT. OF ADMINISTRATIVE SERVICES ARCHITECTURAL SERVICES DATE

APPROVED FOR ADVERTISING BY THE BOARD OF PUBLIC WORKS SEATTLE, WA. DATE CHAIRMAN ARCHITECTURAL DIRECTOR

REVISIONS: AS BUILT - DEC 87/GG.

PROJECT #: ___ CHK BY: ___
DN BY: ___
SCALE: 1/4"=1'-0"
DATE: 7 - 23 - 86
APPROVED BY: ___

MODIFICATIONS OF
FIRE STATION NO. 20
CITY OF SEATTLE
3209 13TH AVE. W SEATTLE, WA.
ELEVATIONS

KUMATA & ASSOCIATES, ARCHITECTS
1109 WEST SQUAW MAN, SEATTLE, WA. 98119 (206)282-9271

DRAWING FILE INFORMATION
FILENAME:
F20-ELEV.DWG
LAYERS:

DRAWING NO.