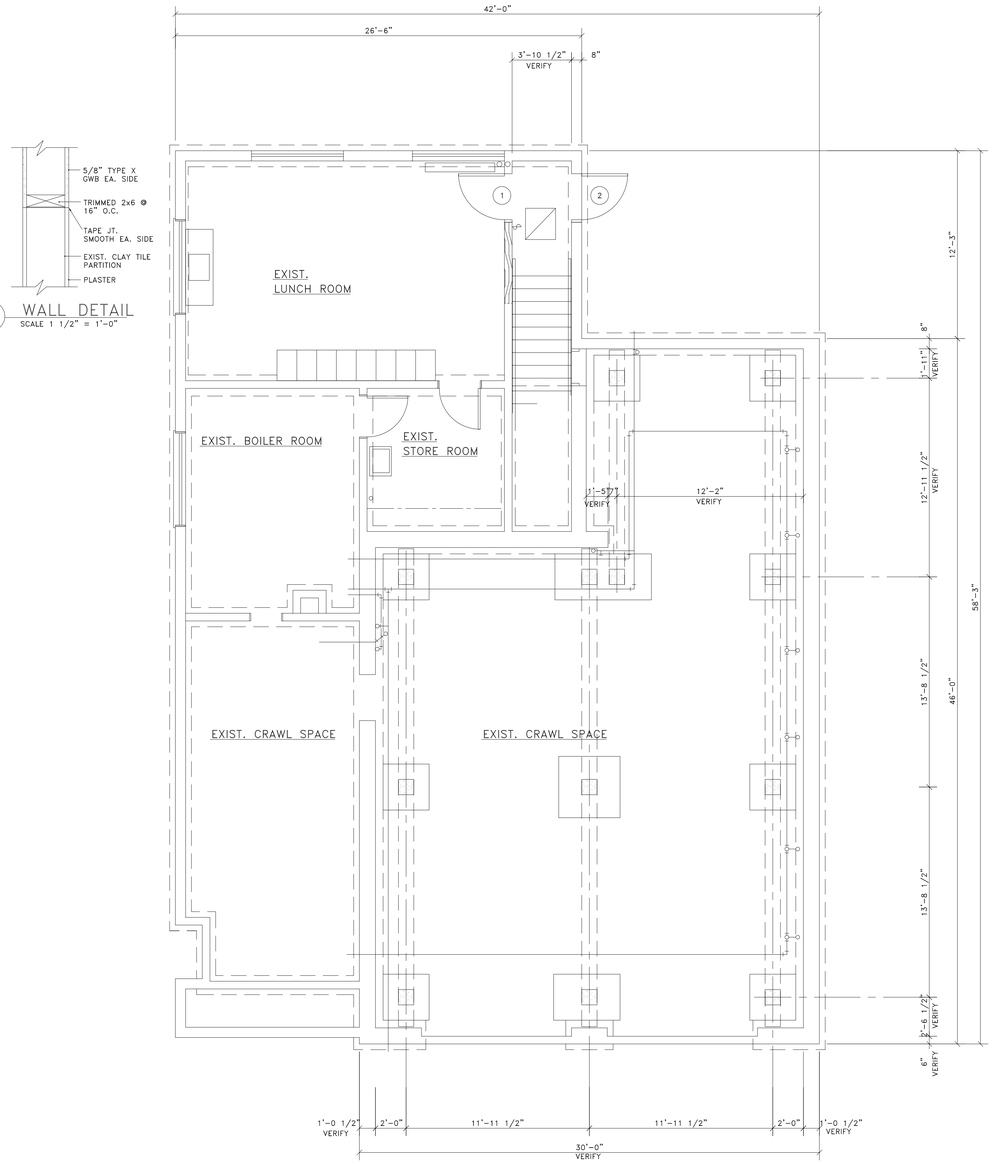

BASEMENT PLAN

SCALE 1/4" = 1'-0"

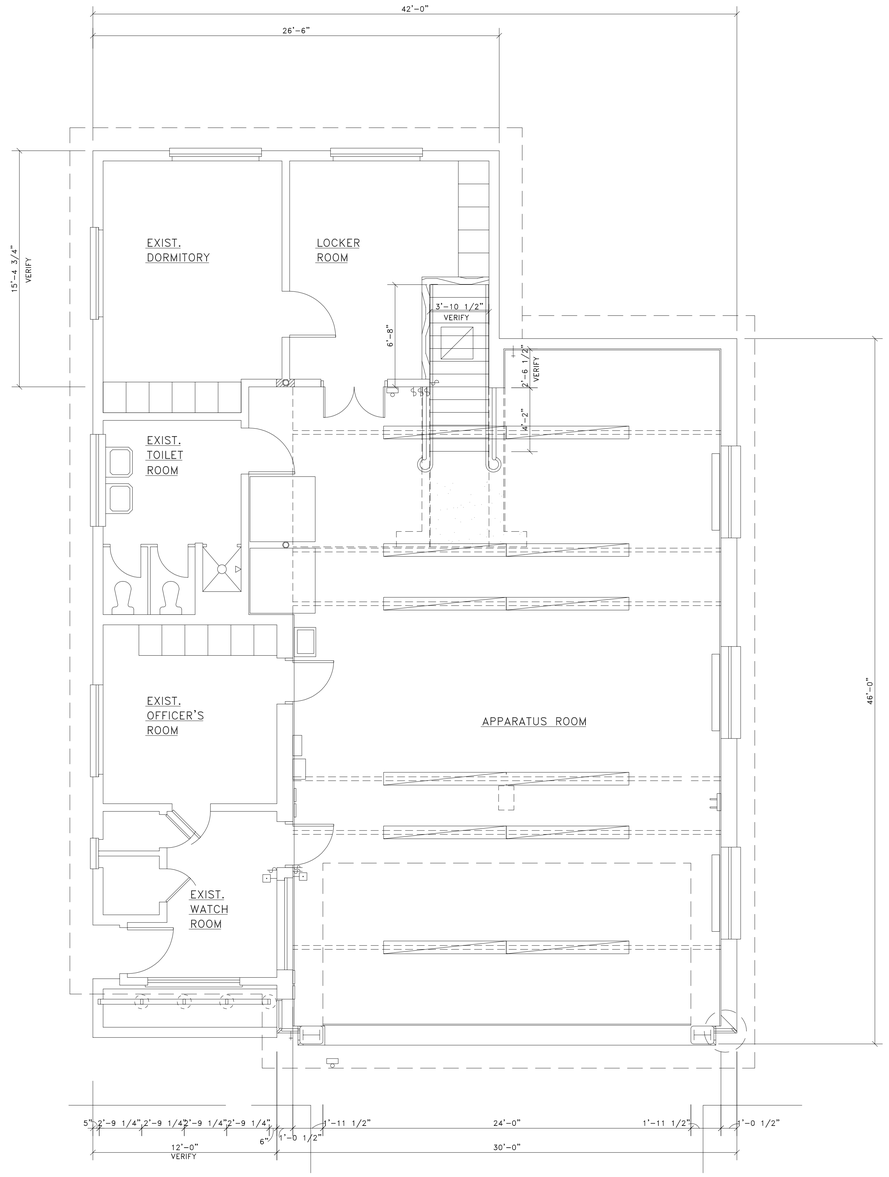

FIRST FLOOR PLAN

SCALE 1/4" = 1'-0"

N

N

ELECTRICAL LEGEND

- EXIST. 3 BUTTON O.H. DOOR CONTROL
- CIRCUIT TO BE CONNECTED TO ALARM SYSTEM – TO AUTOMATICALLY TURN ON LIGHTS WHEN FIRE ALARM GONGS ARE RUNG.
- EXIST. ALARM & FIRE BOX TO BE RELOCATED
- FLUORESCENT FIXTURE
- TRANSFORMER
- RETRACTABLE CORD–110V. 1000W. A.C.

LEGEND

- NEW PRECAST CONC. FLOOR PLANKS W/CONC. TOPPING

TOOLS · TALENT · TECHNOLOGY · DEPARTMENT OF ADMINISTRATIVE SERVICES

APPROVED BY
DEPT. OF ADMINISTRATIVE SERVICES
CITY OF SEATTLE
DIRECTOR DATE
DIR. ARCHITECTURAL SERVICES DATE

APPROVED FOR ADVERTISING
BY THE BOARD OF PUBLIC WORKS
SEATTLE, WA 1986
EXECUTIVE DIRECTOR

REVISIONS:
AS BUILT, DEC 87 GG

PROJECT #:
DN BY: CHK BY:
SCALE: 1/4"=1'-0"
DATE: 7/25/86
APPROVED BY:

MODIFICATIONS OF
FIRE STATION NO. 20
CITY OF SEATTLE
KUMATA & ASSOCIATES, ARCHITECTS 109 WEST DENNY WAY SEATTLE, WA 98119 (206)282-9271
FIRST FLOOR PLAN
BASEMENT PLAN

DRAWING FILE INFORMATION
FILENAME:
F20-01.DWG
LAYERS:

DRAWING NO.
1