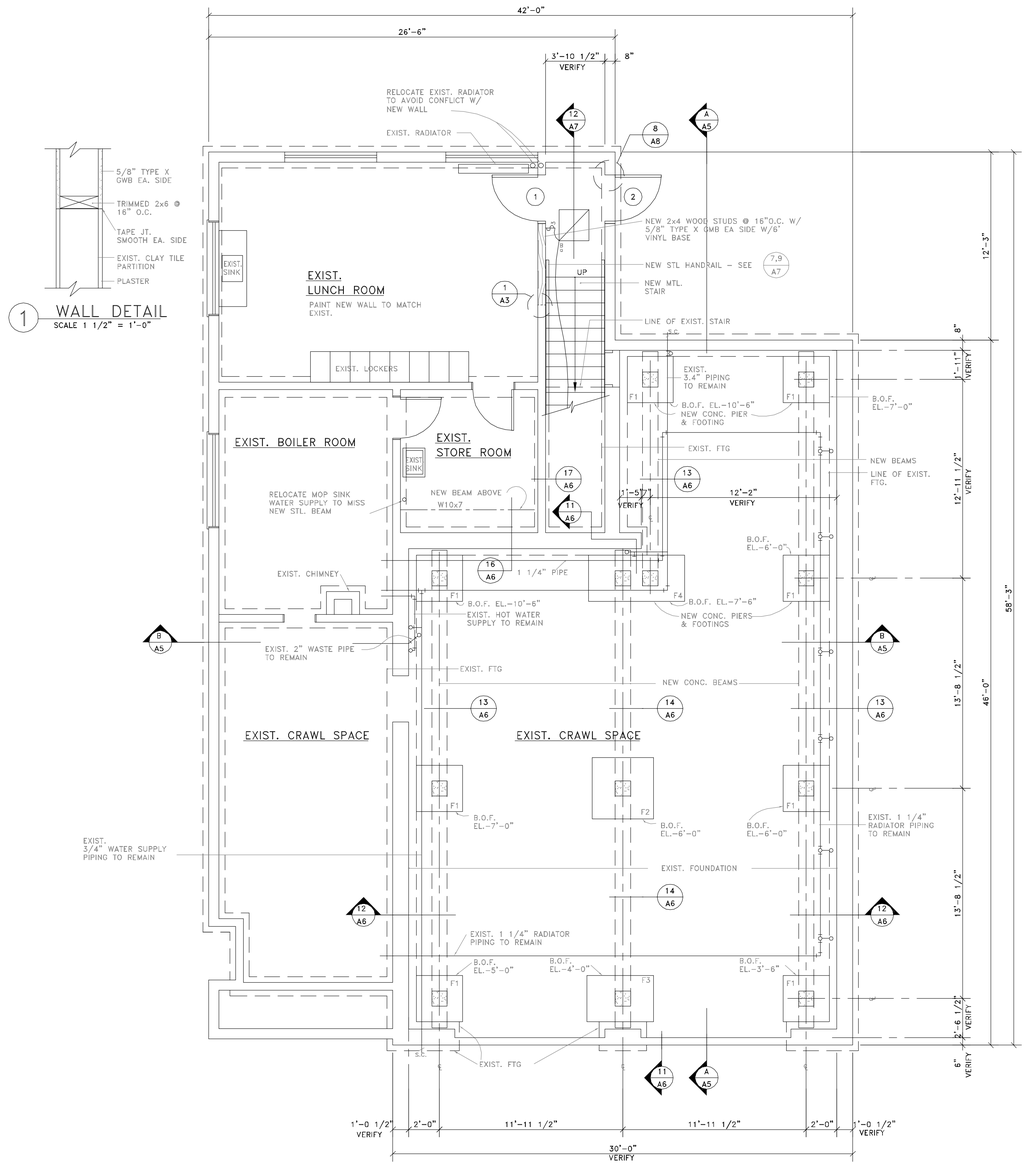

BASEMENT PLAN

SCALE 1/4" = 1'-0"

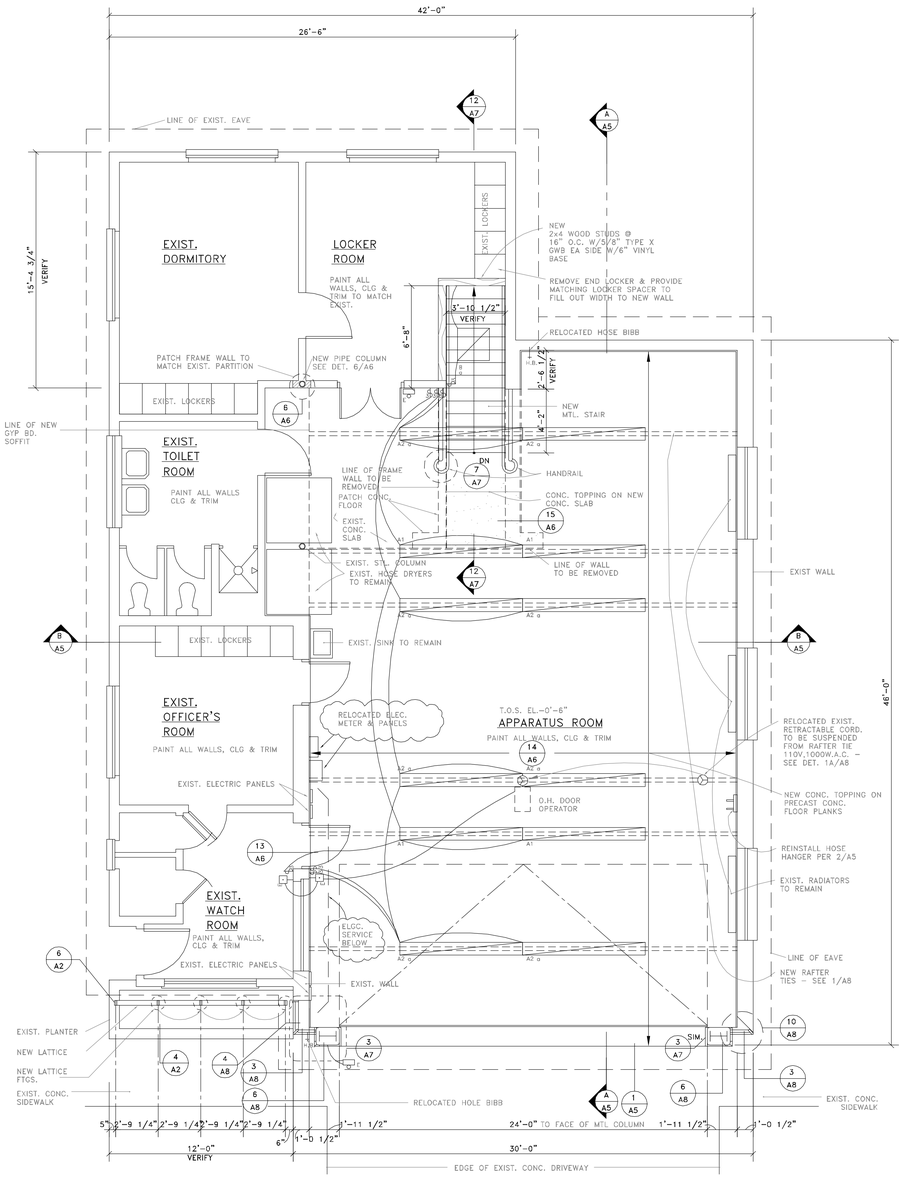

FIRST FLOOR PLAN

SCALE 1/4" = 1'-0"

N

ELECTRICAL LEGEND

- E — EXIST. 3 BUTTON O.H. DOOR CONTROL
- a — CIRCUIT TO BE CONNECTED TO ALARM SYSTEM - TO AUTOMATICALLY TURN ON LIGHTS WHEN FIRE ALARM GONGS ARE RUNG.

NOTE: SEE SPEC.S FOR FIXTURE SCHEDULE

- E — EXIST. ALARM & FIRE BOX TO BE RELOCATED
- FLUORESCENT FIXTURE
- T — TRANSFORMER
- RETRACTABLE CORD-110V. 1000W. A.C.

NOTE:

FIELD VERIFY ALL EXISTING DIMENSIONS.
ALL MASONRY DIMENSIONS ARE TO FACE OF WALL UNLESS NOTED OTHERWISE.
ALL STUD WALL DIMENSIONS ARE TO FACE OF STUD UNLESS NOTED OTHERWISE.

LEGEND

NEW PRECAST CONC. FLOOR PLANKS W/CONC. TOPPING

NOTE: SEE SPEC.S FOR FIXTURE SCHEDULE

KUMATA & ASSOCIATES, ARCHITECTS 109 WEST DENNY WAY SEATTLE, WA 98119 (206)282-9271

MODIFICATIONS OF FIRE STATION NO. 20
CITY OF SEATTLE
FIRST FLOOR PLAN
BASEMENT PLAN

DRAWING FILE INFORMATION
FILENAME: F20-01.DWG
LAYERS:

DRAWING NO. 1

APPROVED BY DEPT. OF ADMINISTRATIVE SERVICES CITY OF SEATTLE — DIR. OF ARCHITECTURAL SERVICES — DATE 1-25-86

APPROVED FOR ADVERTISING BY THE BOARD OF PUBLIC WORKS SEATTLE, WA. 1986 — EXECUTIVE DIRECTOR

REVISIONS: AS BUILT, DEC 87 /CG

PROJECT #: DN BY: CHK BY: SCALE: 1/4"=1'-0" DATE: 1/25/86 APPROVED BY:

DEPARTMENT OF ADMINISTRATIVE SERVICES · TOOLS · TECHNOLOGY