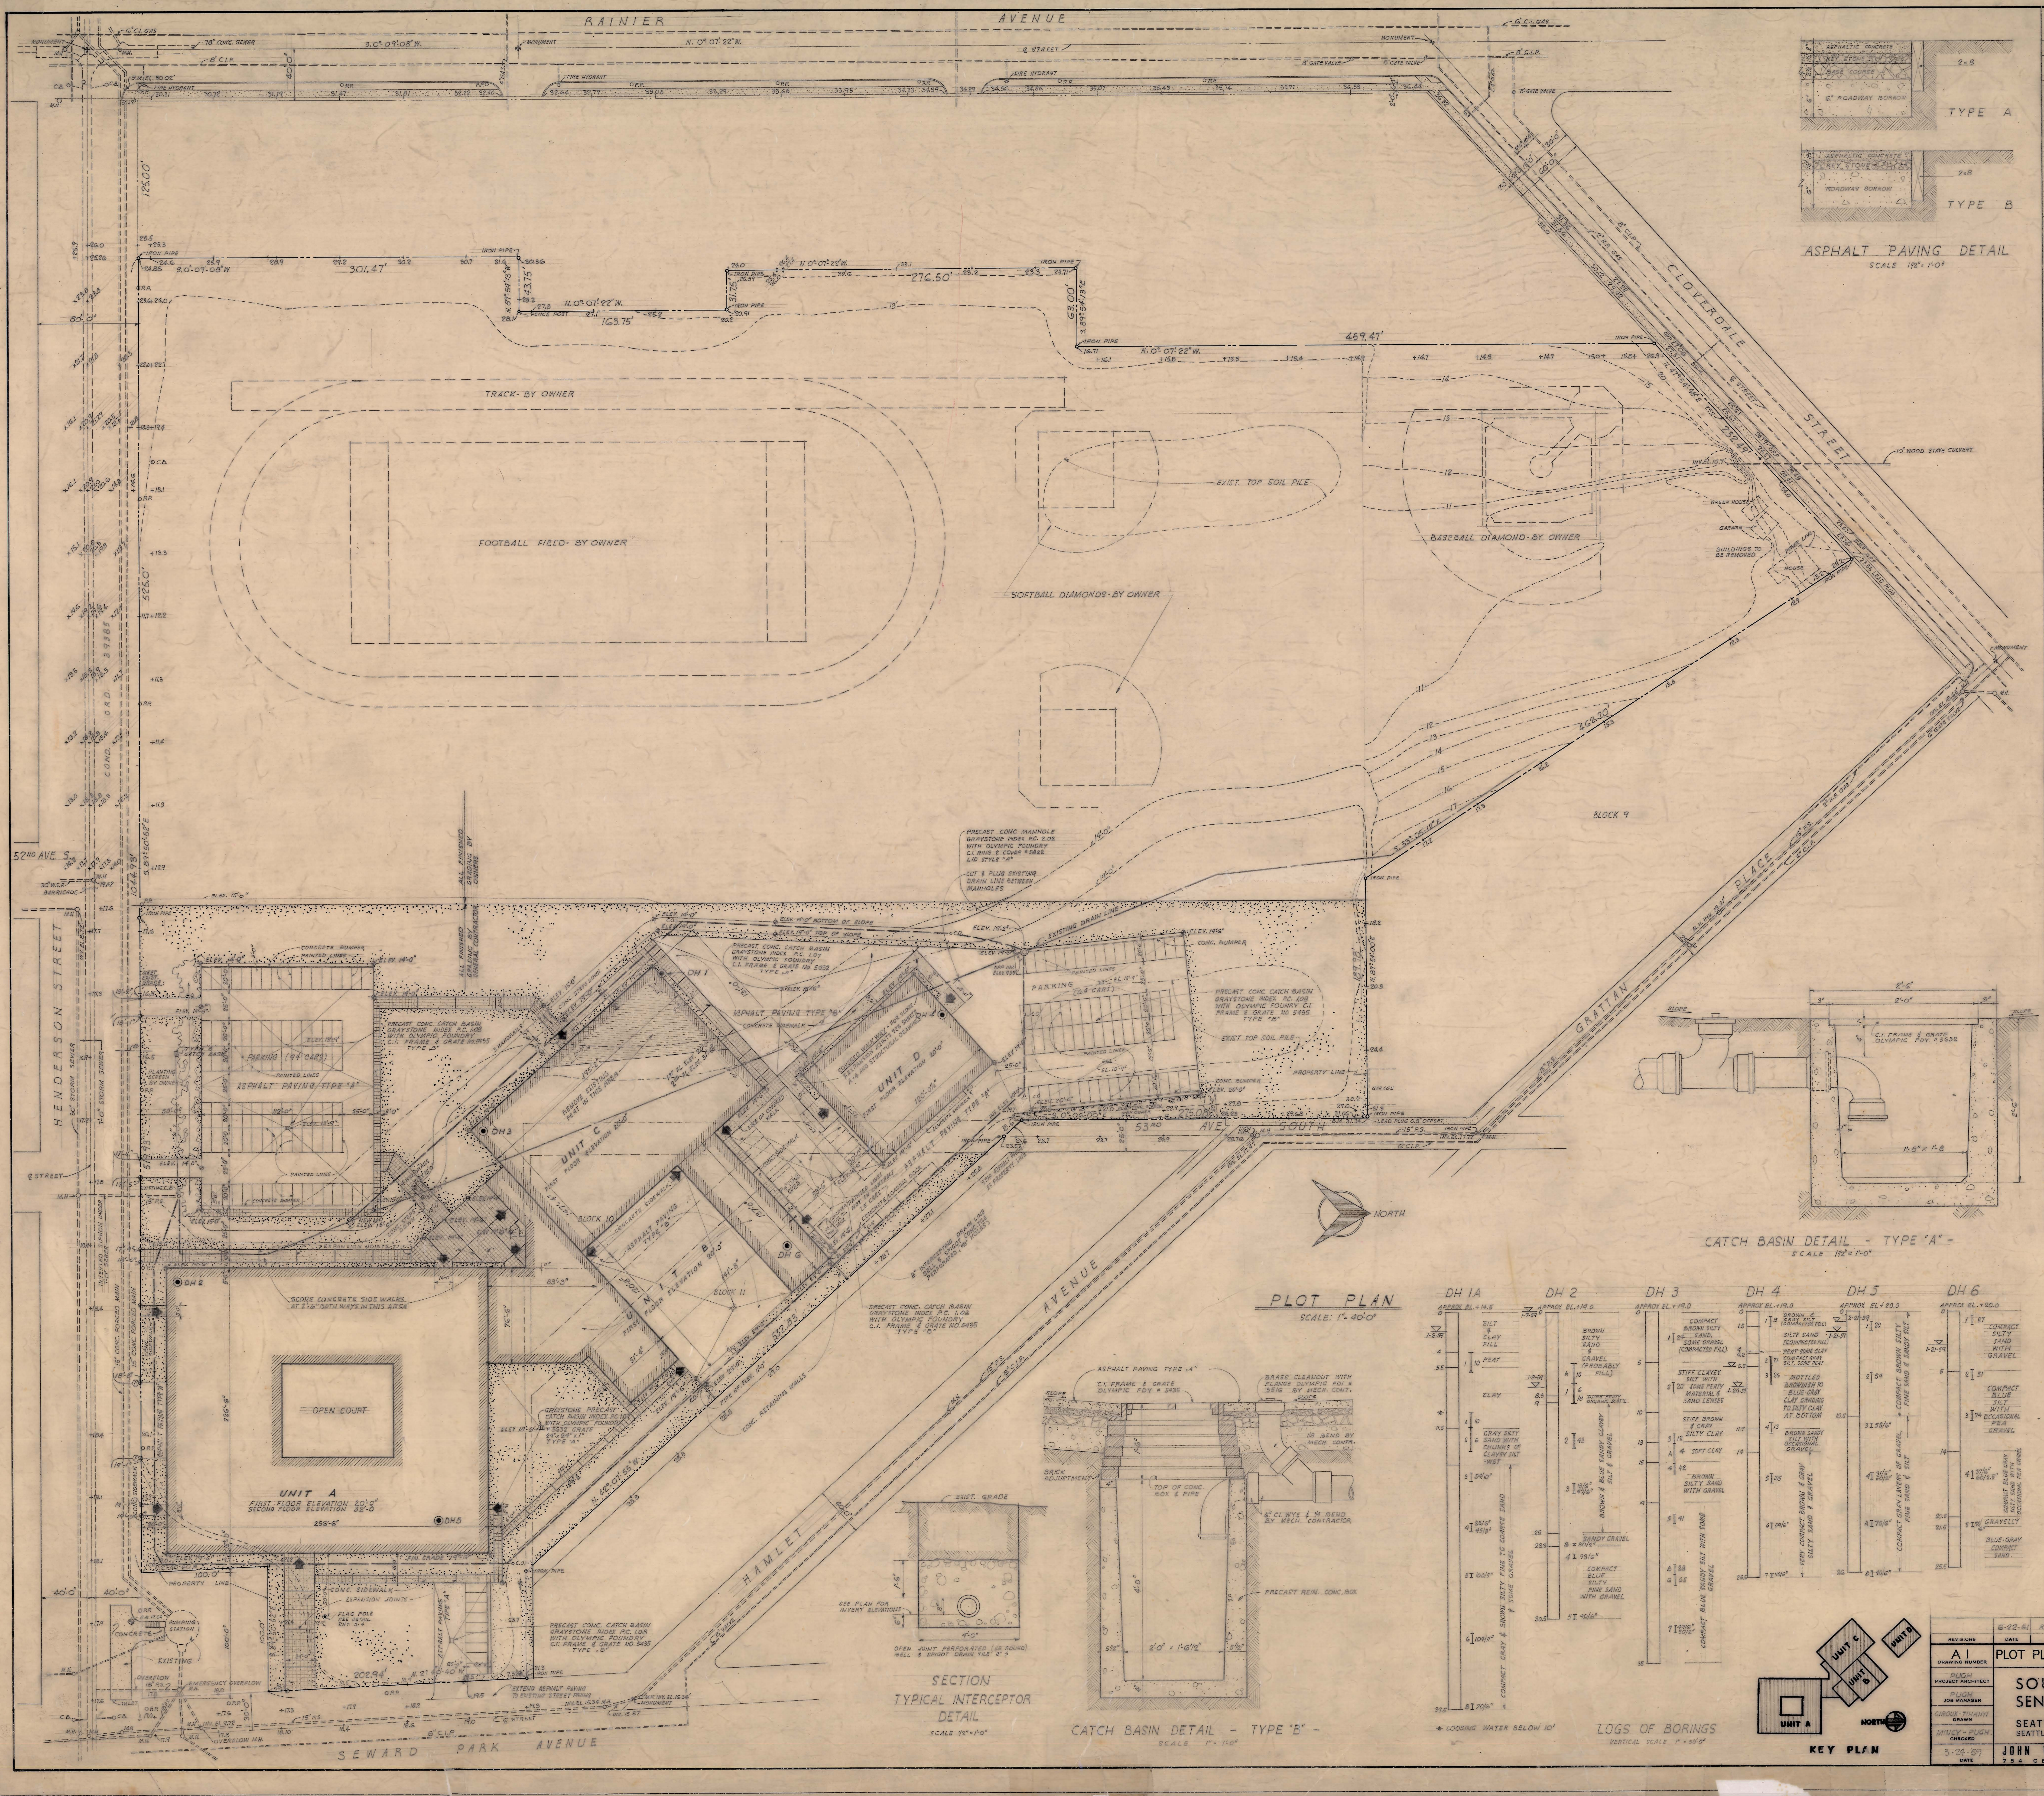

INDEX TO DRAWINGS

DWG. No	TITLE	UNIT
	ARCHITECTURAL	
A 1	PLOT PLAN, INDEX & TEST HOLE DATA	
A 2	SURVEY	
A 3	KEY & COORDINATE PLAN, GENERAL NOTES & SYMBOLS	
A 4	ROOF PLAN & DETAILS & COVERED WALK DETAILS	
A 5	FOUNDATION PLAN	A
A 6	ROOM SCHEDULE FIRST FLOOR	A
A 7	FIRST FLOOR PLAN	A
A 8	ROOM SCHEDULE SECOND FLOOR	A
A 9	SECOND FLOOR PLAN	A
A 10	ELEVATIONS	A
A 11	SECTIONS, STAIR & ENTRANCE DETAILS	A
A 12	FOUNDATION PLAN	B
A 13	ROOM SCHEDULE FIRST FLOOR	B
A 14	FIRST FLOOR PLAN & INCINERATOR DETAILS	B
A 15	CLERESTORY PLAN	B
A 16	ELEVATIONS & SECTIONS	B
A 17	FOUNDATION PLAN	C
A 18	ROOM SCHEDULE FIRST FLOOR	C
A 19	FIRST FLOOR PLAN & ELEVATIONS	C
A 20	ROOM SCHEDULE SECOND FLOOR	C
A 21	SECOND FLOOR PLAN & SECTIONS	C
A 22	FOUNDATION PLAN, SECTIONS & DETAILS	D
A 23	ROOM SCHEDULE FIRST FLOOR	D
A 24	FIRST FLOOR PLAN, ELEVATIONS & DETAILS	D
A 25	WINDOW & ELEVATOR DETAILS	A, B & C
A 26	DOOR SCHEDULE, TYPES & JAMB DETAILS	A, B, C & D
A 27	DOOR SCHEDULE & ENTRANCE DETAILS	A, B, C & D
A 28	TOILET ROOM DETAILS	A, B, & C
A 29	ADMINISTRATION AREA - & TYPICAL CLASSROOM PLANS & DETAILS	A & B
A 30	OFFICE PRACTICE RELIGHTS & BOOK ROOM DETAILS	A
A 31	KITCHEN PLAN & DETAILS	A
A 32	FOODS LABORATORY, GENERAL PURPOSE ROOM & SEWING ROOM PLANS & DETAILS	A
A 33	LIBRARY PLAN & DETAILS	A
A 34	BIOLOGY & GENERAL SCIENCE PLAN & DETAILS	A
A 35	CHEMISTRY & PHYSICS PLAN & DETAILS	A
A 36	ART ROOM PLANS & DETAILS & SCIENCE DETAILS	A
A 37	AUDITORIUM PLAN & DETAILS	B
A 38	AUDITORIUM SECTION & DETAILS	B
A 39	BAND & CHORAL ROOM PLANS & DETAILS	B
A 40	BAND & CHORAL ROOM DETAILS	B
	AUDIO-VISUAL ROOM PLAN & DETAILS	A
A 41	SHOWER & LOCKER ROOM PLAN & DETAILS	C
A 42	AUDITORIUM ALTERNATE	B
	STRUCTURAL	
S 1	FOUNDATION PLAN	A
S 2	FIRST FLOOR FRAMING PLAN	A
S 3	SECOND FLOOR FRAMING PLAN	A
S 4	ROOF FRAMING PLAN	A
S 5	SECTIONS AND COLUMN SCHEDULE	A
S 6	FOUNDATION PLAN	B
S 7	ROOF FRAMING PLAN	B
S 8	SECTIONS AND COLUMN SCHEDULE	B
S 9	FOUNDATION PLAN	C
S 10	FIRST FLOOR FRAMING PLAN	C
S 11	SECOND FLOOR FRAMING PLAN	C
S 12	ROOF FRAMING PLAN	C
S 13	FOUNDATION PLAN	D
S 14	ROOF FRAMING PLAN	D
S 15	GENERAL NOTES AND TYPICAL DETAILS	A, B, C & D
	MECHANICAL	
M 1	PLOT PLAN AND BOILER ROOM	
M 2	FOUNDATION PLAN	A
M 3	FIRST FLOOR PLAN	A
M 4	SECOND FLOOR PLAN	A
M 5	FOUNDATION PLAN	B
M 6	FIRST FLOOR PLAN	B
M 7	CEILING SPACE PLAN	B
M 8	FOUNDATION FLOOR PLAN	C
M 9	FIRST AND SECOND FLOOR PLANS	C
M 10	FOUNDATION PLAN	D
M 11	FLOOR PLAN	D
	ELECTRICAL	
E 1	PLOT PLAN, PANEL SCHEDULE AND DIAGRAM	
E 2	FIRST FLOOR PLAN	A
E 3	SECOND FLOOR PLAN	A
E 4	FIRST FLOOR PLAN	B
E 5	CLERESTORY PLAN	B
E 6	FIRST AND SECOND FLOOR PLANS	C
E 7	FLOOR PLAN	D

LEGEND

- DEPTH OF BORING IN FEET
- WATER ELEVATION IN TEST HOLE
- DH BORINGS MADE AFTER 1958 GRADING
- B BORINGS MADE BEFORE 1958 GRADING
- SPLIT SPOON STANDARD PENETRATION SAMPLE
- SHELBY SAMPLE

NUMBERS TO RIGHT OF SAMPLE INDICATE NUMBER OF BLOWS/FOOT PENETRATION, UNLESS OTHERWISE INDICATED, USING A 140 LB. WEIGHT DROPPED 30 INCHES

LETTER TO LEFT OF SAMPLE SYMBOL INDICATES NO RECOVERY

- LOCATION OF BORING

NOTE: AVERAGE BLOW COUNT IN COMPACTED FILL MATERIAL, PORTER HOLES DH 3A, 3B IS 30 BLOWS/6 INCHES

REVISIONS	DATE	DESCRIPTION	PRINTS	DATE	ISSUED TO
	6-22-61	REVISED AS BUILT			

A 1 DRAWING NUMBER — PLOT PLAN, INDEX & TEST HOLE DATA

PUGH — PROJECT ARCHITECT
PUGH — JOB MANAGER
GIROUX-TIHANYI — DRAWN
MINCY-PUGH — CHECKED
3-24-59 — DATE

SOUTHEAST JUNIOR SENIOR HIGH SCHOOL
FOR
SEATTLE SCHOOL DISTRICT No. 1
SEATTLE, WASHINGTON

JOHN W. MALONEY ARCHITECT AIA
754 CENTRAL BUILDING - SEATTLE

JOHN W. MALONEY — LICENSE RENEWED TO JUNE 1, 1959 — L-10 — STATE OF WASHINGTON — REGISTERED ARCHITECT

021-J-0010

ARCHITECTURAL SYMBOLS

STONE, BRONZE (IN SECTION)	FLUSH VALVE WATER CLOSET
BRICK	URINAL - STALL TYPE
CONCRETE	D.F. DRINKING FOUNTAIN SINGLE
CONCRETE OR SHALE BLOCK	D.F. DRINKING FOUNTAIN DOUBLE
EARTH	F.E.C. FIRE EXTINGUISHER CABINET
FIRE BRICK LINING	LAVATORY
GLASS BLOCK	SINK
GRAVEL	WASH SINK
GLAZED BLOCK OR CER. TILE	L.T. LAUNDRY TRAYS
METAL (LARGE SCALE SECTION) (SMALL SCALE SECTION)	SHOWER HEAD
METAL, (ELEVATION)	TELEPHONE
ROCK	ELECTRIC PANEL
PLASTER (SECTION)	101 ROOM NUMBER
PLASTER, CUT STONE, CONC. (ELEV.)	3 COLUMN NUBER
TERAZZO	A SECTION "A-A"
WOOD (SMALL SCALE PLANS)	18/A2 DETAIL NO. 18 ON DRAWING NO. A2
WOOD (SECTION)	41 DOOR NUMBER
INSULATION	A WINDOW TYPE
	FLUORESCENT FIXTURE
	F.D. FLOOR DRAIN
	R.D. ROOF DRAIN
	95'-6" FINISH GRADE
	50 FINISH CONTOUR
	EXISTING CONTOUR
	ORIGINAL CONTOUR

GENERAL NOTES

1. ROOM FINISH SCHEDULE AND DOOR SCHEDULE SHOW MATERIALS AND FINISHES WHICH SHALL BE PROVIDED. SEE SPECIFICATIONS FOR MATERIALS AND FINISHES OF ITEMS NOT COVERED IN THESE SCHEDULES. IF MATERIALS AND FINISHES SHOWN IN THESE SCHEDULES ARE NOT SPECIFIED IN THE SPECIFICATIONS, SUCH MATERIALS AND FINISHES OF FIRST GRADE QUALITY AND WORKMANSHIP SHALL BE PROVIDED AND SPECIFICATIONS FOR SAME WILL BE FURNISHED BY THE ARCHITECT AT THE CONTRACTORS REQUEST.
2. DIMENSIONS ON FLOOR PLANS ARE TO ROUGH WORK EXCEPT WHERE NOTED OTHERWISE.
3. CONSULT MECHANICAL AND ELECTRICAL PLANS FOR LOCATION OF DUCTS, CONDUITS, PIPING, CABINETS, ETC.., WHERE DUCTS PIERCE FIRE WALLS THEY SHALL BE PROVIDED WITH AUTOMATIC CLOSING FIRE SHUTTERS.
4. CONTRACTOR SHALL VERIFY ALL GRADE DIMENSIONS AND EXISTING DIMENSIONS ON JOB.
5. ROOM NUMBERS SHOWN ON DRAWINGS ARE FOR CONSTRUCTION PURPOSES ONLY. CONTRACTOR SHALL CONSULT WITH OWNER FOR NUMBERS AND NAMES TO BE PAINTED ON DOORS OR ELSEWHERE AS REQUIRED.
6. ROOMS WHICH HAVE EARTH FILL BEHIND WALLS SHALL HAVE SUCH WALLS DAMPPROOFED ON EARTH SIDE.
7. SEE STRUCTURAL, MECHANICAL, & ELECTRICAL DRAWINGS FOR ADDITIONAL NOTES & SYMBOLS.
8. ALL EXPOSED CORNERS OF ARCHITECTURAL CONCRETE SHALL HAVE 1/2" BEVEL UNLESS NOTED OTHERWISE.
9. CONTRACTOR SHALL VERIFY ALL ROUGH-IN DIMENSIONS FOR EQUIPMENT FURNISHED AND INSTALLED BY HIMSELF OR OTHER CONTRACTORS.
10. CONTRACTOR SHALL VERIFY DIMENSIONS OF ALL DUCTS & ACCESS OPENINGS THRU SLABS, WALLS, ETC. WITH MECHANICAL DRAWINGS.
11. ALL WORK SHALL COMPLY WITH APPLICABLE CODES AND ORDINANACES.
12. OBTAIN ENGINEERING DEPARTMENT PERMIT FOR WORK ON PUBLIC PROPERTY.
13. OWNER SHALL SECURE CERTIFICATE OF OCCUPANCY AFTER COMPLETION OF BUILDING.

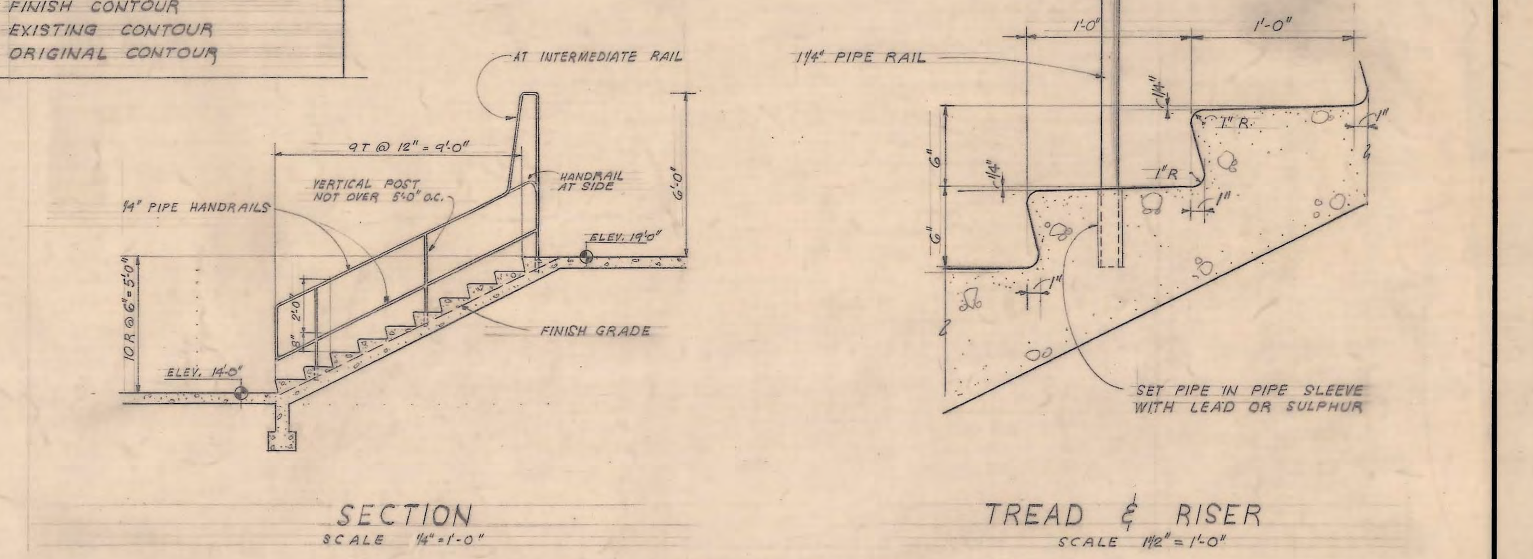

SECTION
SCALE 1/4"=1'-0"

TREAD & RISER
SCALE 1 1/2"=1'-0"

TYPICAL EXTERIOR STAIR DETAILS

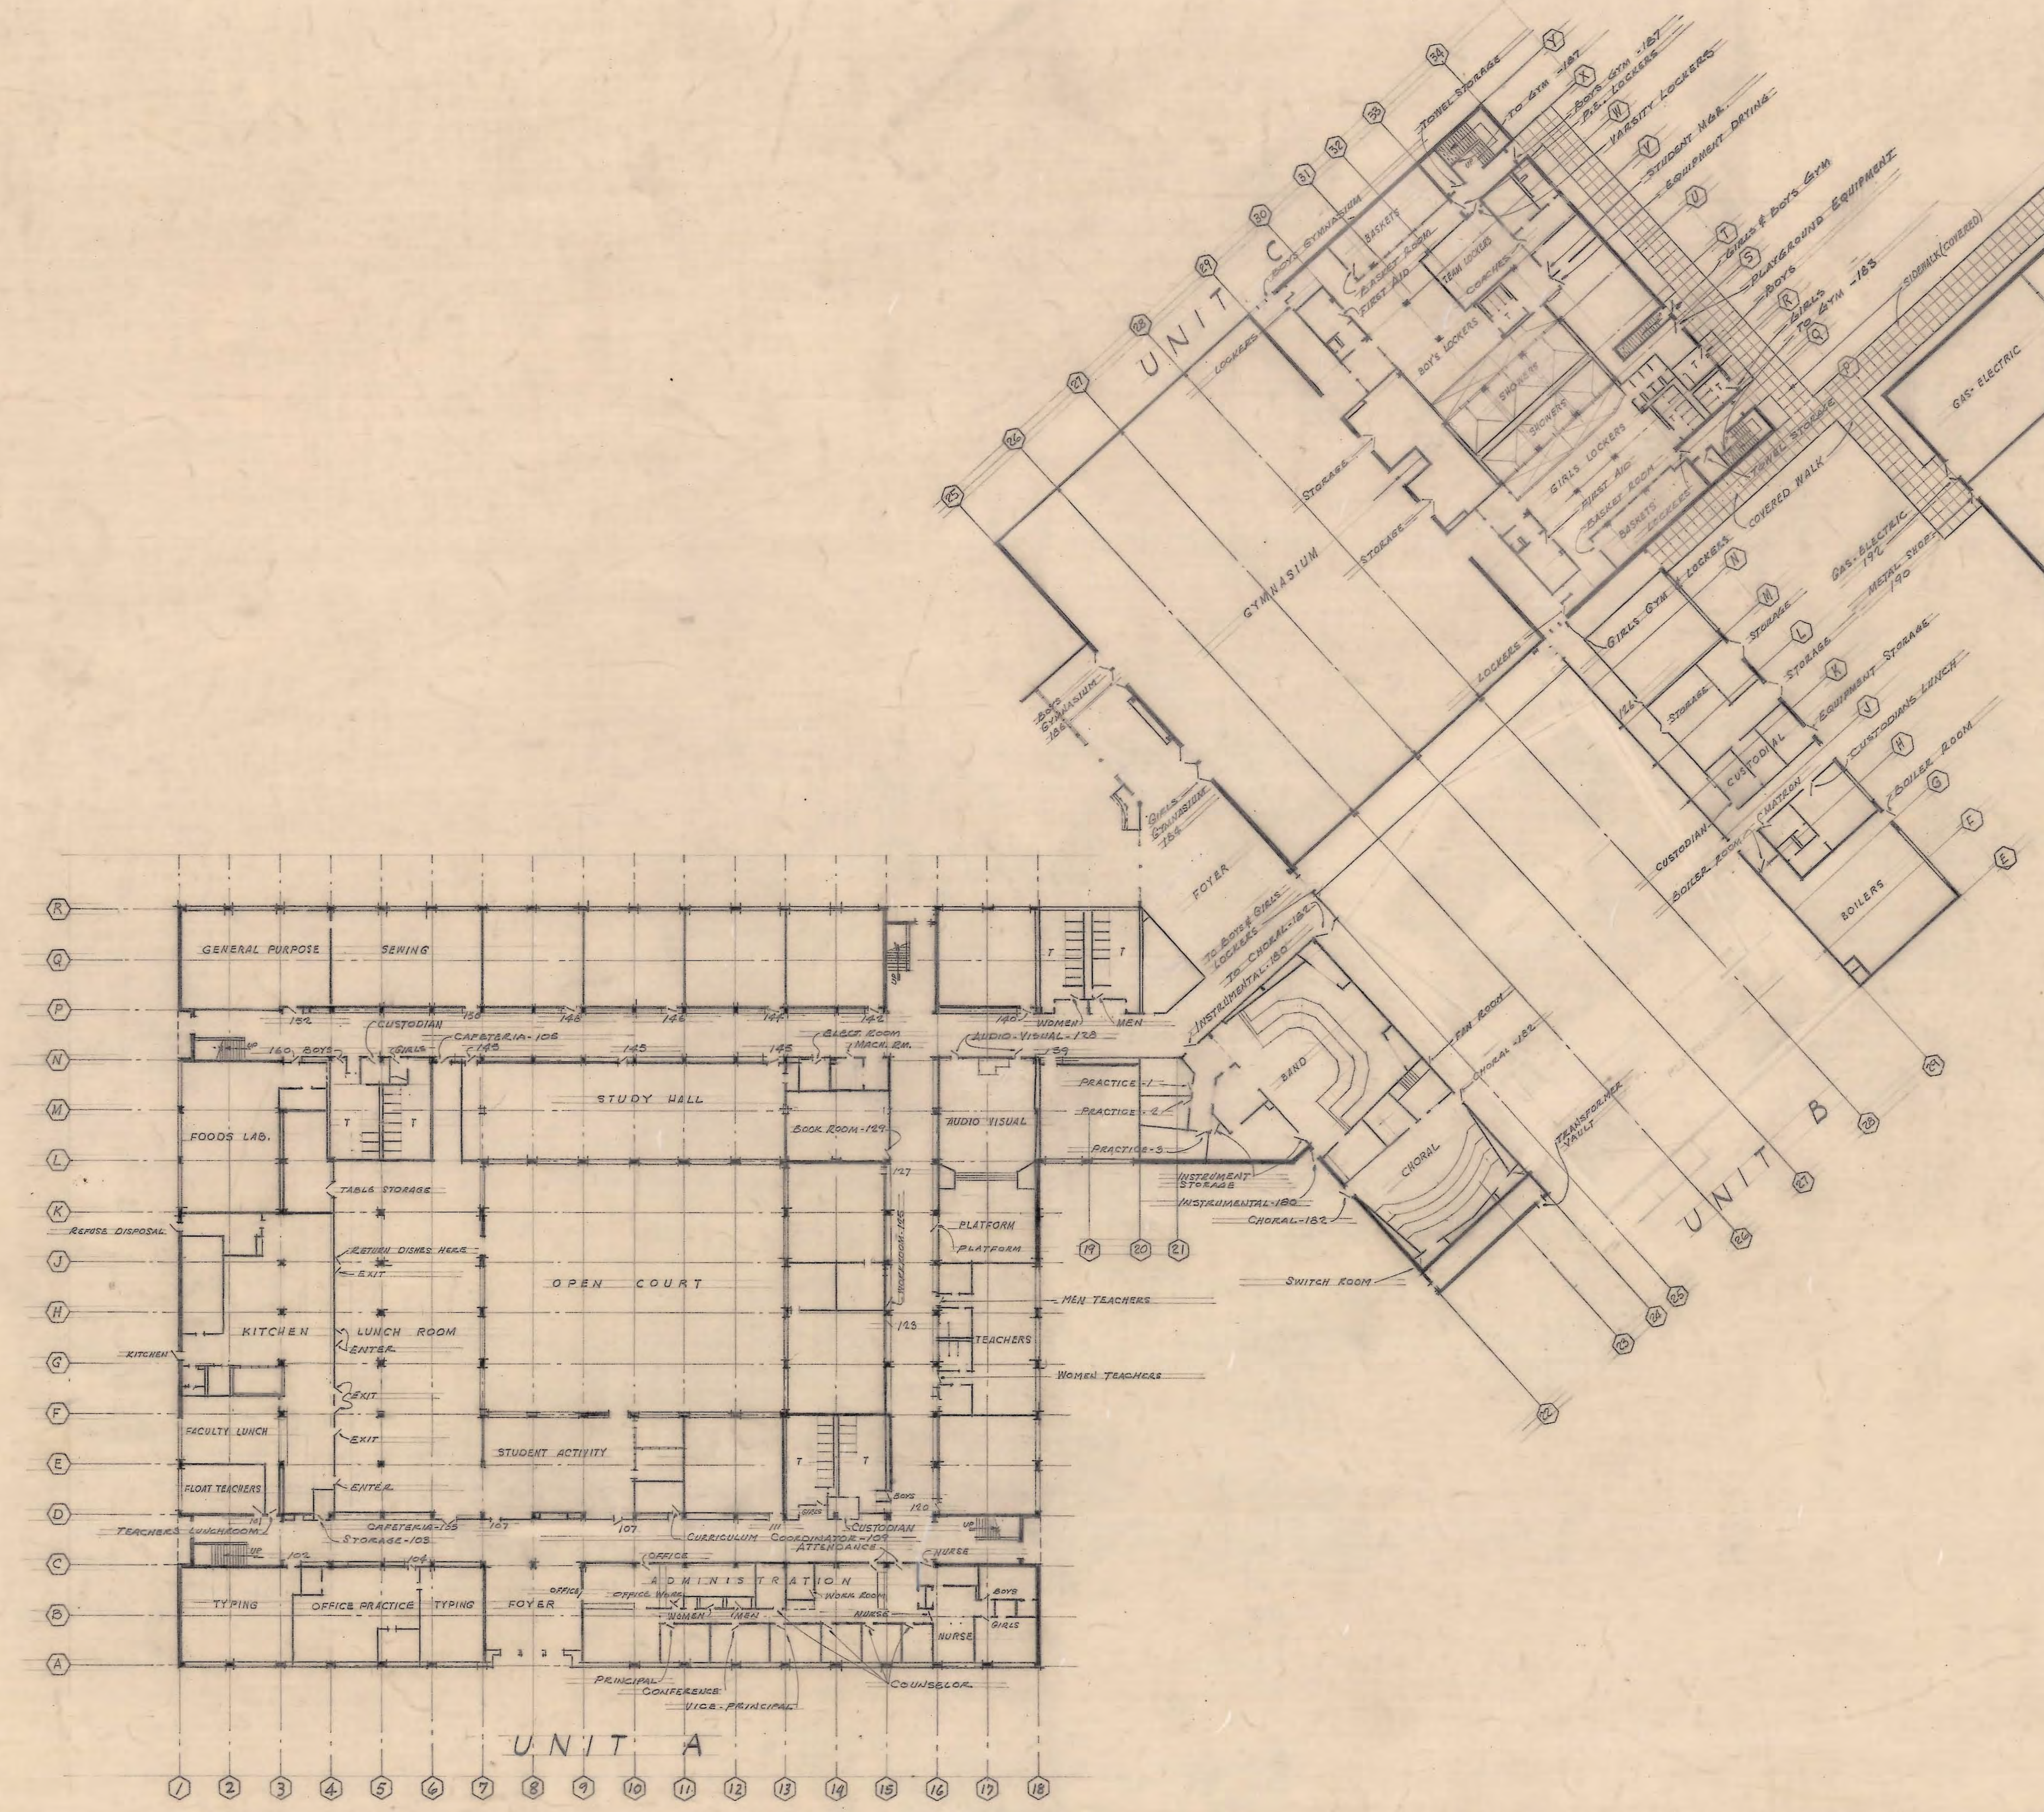

FIRST FLOOR PLAN
SCALE: 1/32"=1'-0"

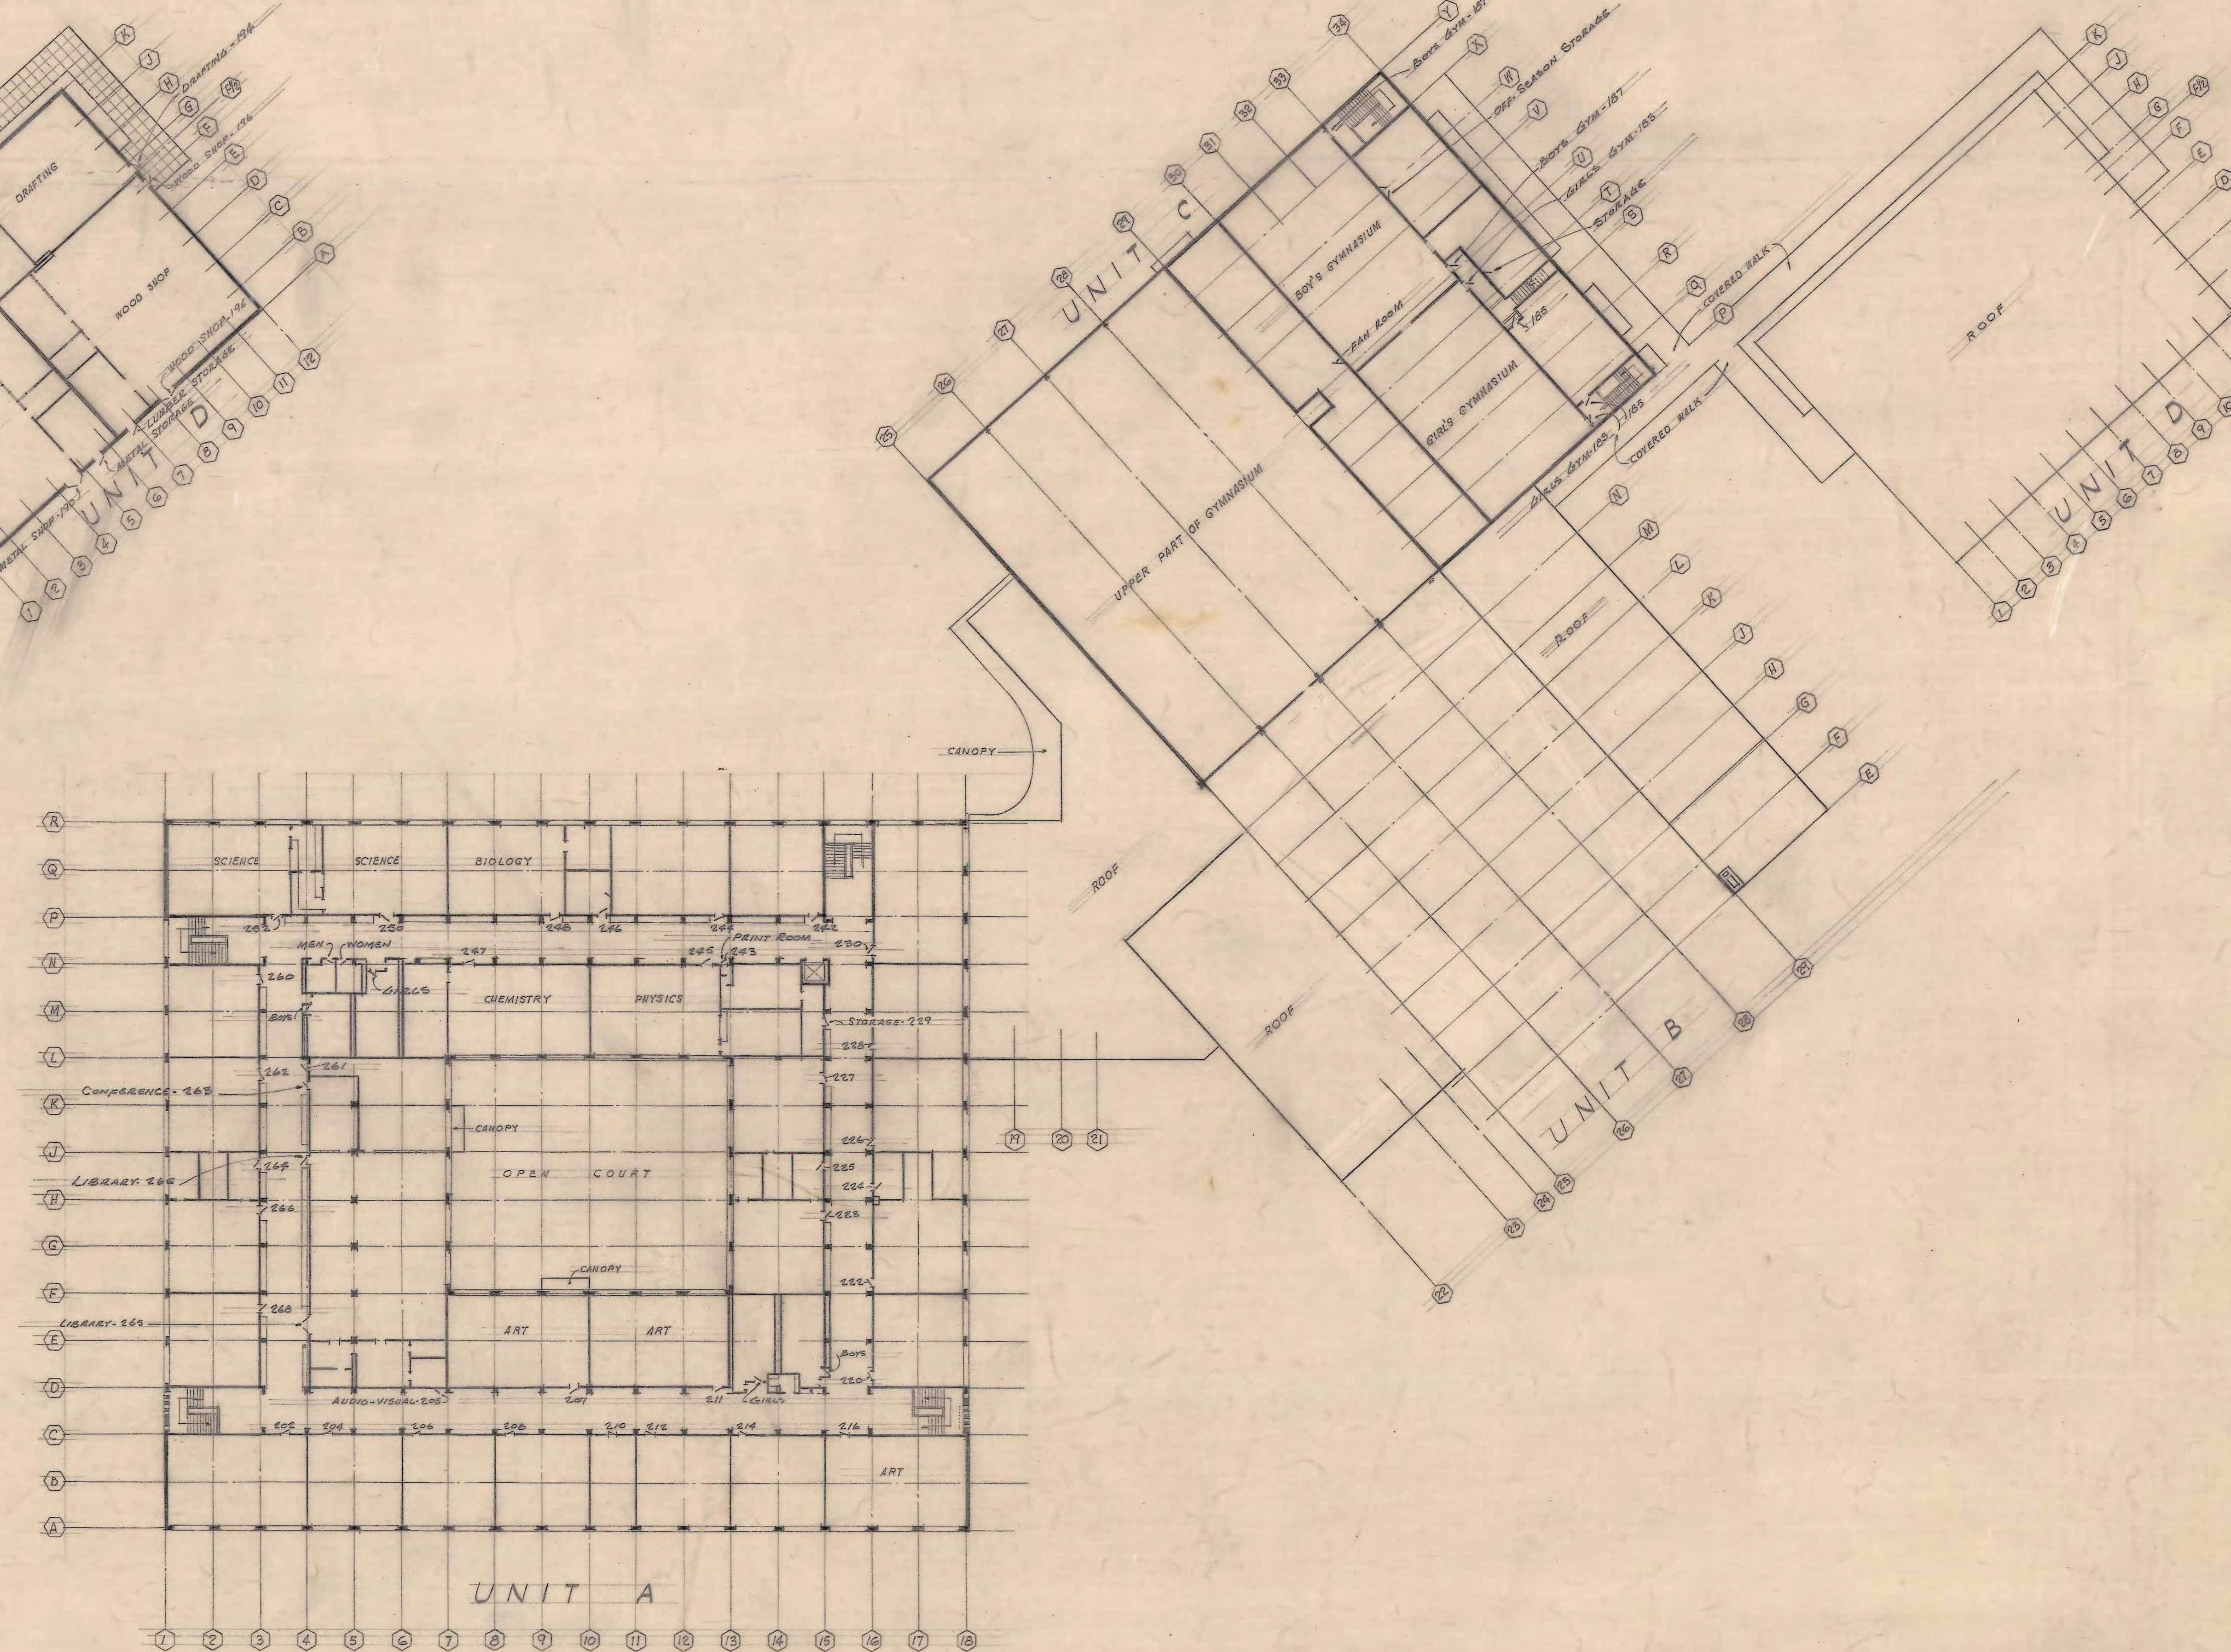

SECOND FLOOR PLAN
SCALE: 1/32"=1'-0"

KEY & COORDINATE PLANS

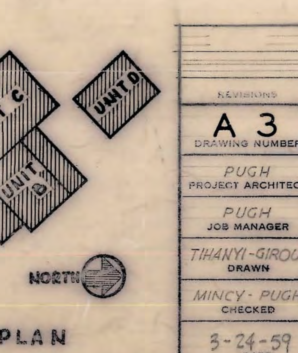

KEY PLAN

REVISIONS	DATE	DESCRIPTION	PRINTS	DATE	ISSUED TO
	6-22-61	REVISED AS BUILT			
	7-13-60	ADDED ROOM NO'S.			

A 3
DRAWING NUMBER

KEY & COORDINATE PLAN, GENERAL NOTES, SYMBOLS

PUGH
PROJECT ARCHITECT

PUGH
JOB MANAGER

TIHANYI-GIROUX
DRAWN

MINCY-PUGH
CHECKED

3-24-59
DATE

SOUTHEAST JUNIOR SENIOR HIGH SCHOOL
FOR
SEATTLE SCHOOL DISTRICT No. 1
SEATTLE, WASHINGTON

JOHN W. MALONEY ARCHITECT AIA
754 CENTRAL BUILDING - SEATTLE

JOHN W. MALONEY
LICENSE RENEWED TO JUNE 1,
1959
John W Maloney
L-10
STATE OF WASHINGTON
REGISTERED ARCHITECT

021-J-0013


DETAIL PLAN OF MASONRY WALL ANCHORAGE TO CONCRETE WALL OR COLUMN UNITS A,B,C & D
TYPICAL FLASHING DETAIL WHERE LOW ROOFS OR CANOPYS MEET A BRICK VENEER WALL
TYPICAL CONCEALED FLASHING DETAIL
ROOF DRAIN DETAIL
NOTE: INSTALLATION IN TECTUM & T & G SIMILAR
TYPICAL VENTILATOR CURB DETAILS
ELEVATION
CURB SECTION A-A
STEEL LADDER DETAIL
ROOF SCUTTLE DETAIL
AT GLAZED OR CONC. BLOCK WALL
AT CONCRETE WALL
DETAIL OF SUPPORT FOR WALL HUNG RADIATORS UNITS A,B,C & D
IN ASPHALT TILE FLOOR
PIPE TUNNEL ACCESS DOOR UNITS A,B,C & D
HALF FULL SIZE
IN CONCRETE FLOOR
PIPE TUNNEL ACCESS DOOR UNITS A,B,C & D
HALF FULL SIZE
FLAGPOLE DETAIL
UNIT 'C'
UNIT 'B'
UNIT 'D'
PLAN OF COVERED WALK
NORTH
DETAIL 'E' (UNIT D)
DETAIL 'B'
TYPICAL JOINT IN STEEL DECK
UNIT - C
UNIT - D
UNIT - B
UNIT - A
OPEN COURT
DETAIL "A"
SECTION "A-A"
SECTION THRU COVERED WALK
SCALE: HALF FULL SIZE
PLAN & DETAILS OF COVERED WALK
ROOF PLAN
NORTH
KEY PLAN
UNIT A
UNIT B
UNIT C
UNIT D
NORTH
6-22-61 REVISED AS BUILT
REVISIONS
DATE
DESCRIPTION
PRINTS
DATE
ISSUED TO
A4
DRAWING NUMBER
ROOF PLAN & DETAILS & COVERED WALK DETAILS
PUGH
PROJECT ARCHITECT
PUGH
JOB MANAGER
GIROUX - TIHANYI
DRAWN
MINCY - PUGH
CHECKED
3-24-59
DATE
SOUTHEAST JUNIOR SENIOR HIGH SCHOOL
FOR
SEATTLE SCHOOL DISTRICT No. 1
SEATTLE, WASHINGTON
JOHN W. MALONEY ARCHITECT AIA
754 CENTRAL BUILDING - SEATTLE
JOHN W. MALONEY
LICENSE RENEWED TO JUNE 1,
1959
L-10
STATE OF WASHINGTON
REGISTERED ARCHITECT
021-J-0014

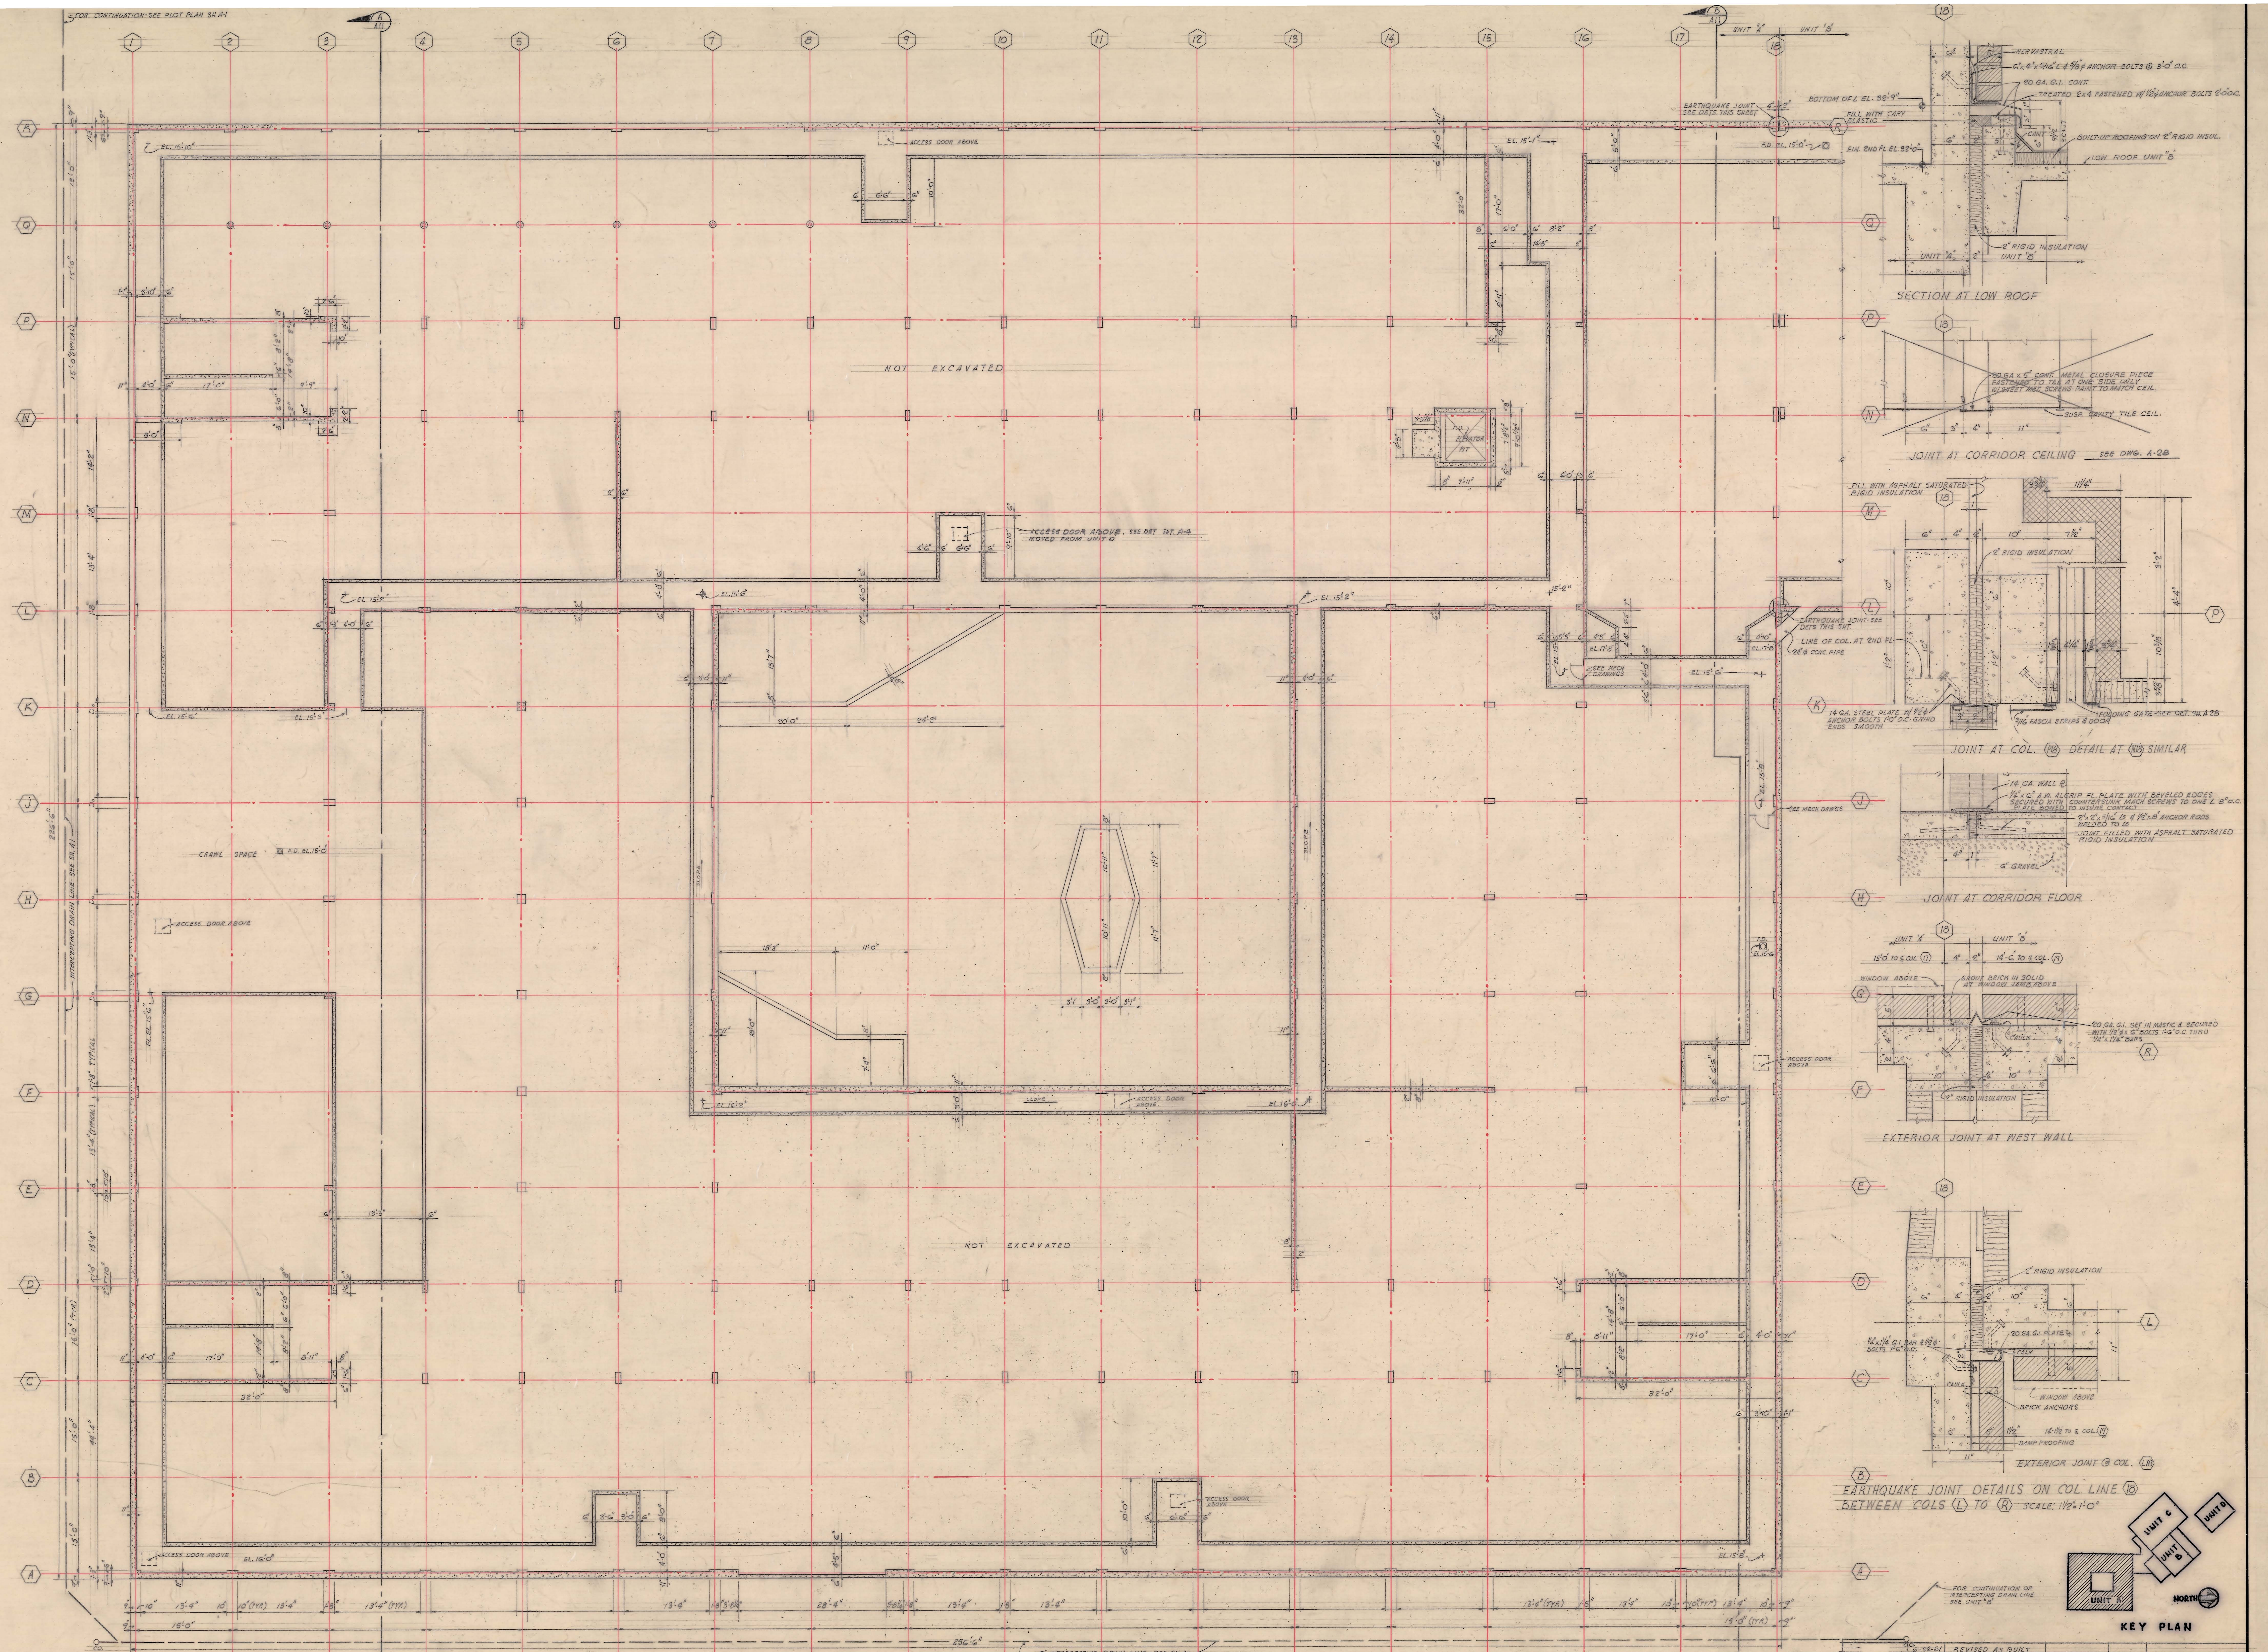

REVISIONS	DATE	DESCRIPTION	PRINTS	DATE	ISSUED TO
	6-22-61	REVISED AS BUILT			

A5 DRAWING NUMBER

FOUNDATION PLAN — UNIT A

SOUTHEAST JUNIOR SENIOR HIGH SCHOOL
FOR
SEATTLE SCHOOL DISTRICT No. 1
SEATTLE, WASHINGTON

PUGH — PROJECT ARCHITECT
PUGH — JOB MANAGER
RAMALEY — DRAWN
MINCY - PUGH — CHECKED
3-24-59 — DATE

JOHN W. MALONEY ARCHITECT AIA
754 CENTRAL BUILDING - SEATTLE

JOHN W. MALONEY
LICENSE RENEWED TO JUNE 1, 1959
L-10
STATE OF WASHINGTON
REGISTERED ARCHITECT

021-J-0015

REVISIONS	DATE	DESCRIPTION	PRINTS	DATE	ISSUED TO
CLT.	9-11-68	ADDED SINK IN ACTIVITY RM A-155			
	6-22-61	REVISED AS BUILT			

A 7 DRAWING NUMBER

FIRST FLOOR PLAN — UNIT A

PUGH — PROJECT ARCHITECT
PUGH — JOB MANAGER
GIROUX — DRAWN
MINCY - PUGH — CHECKED
5-24-59 — DATE

SOUTHEAST JUNIOR SENIOR HIGH SCHOOL
FOR
SEATTLE SCHOOL DISTRICT No. 1
SEATTLE, WASHINGTON

JOHN W. MALONEY ARCHITECT AIA
754 CENTRAL BUILDING–SEATTLE

JOHN W. MALONEY — LICENSE RENEWED TO JUNE 1, 1959 — L-10 — STATE OF WASHINGTON — REGISTERED ARCHITECT

021-J-0008

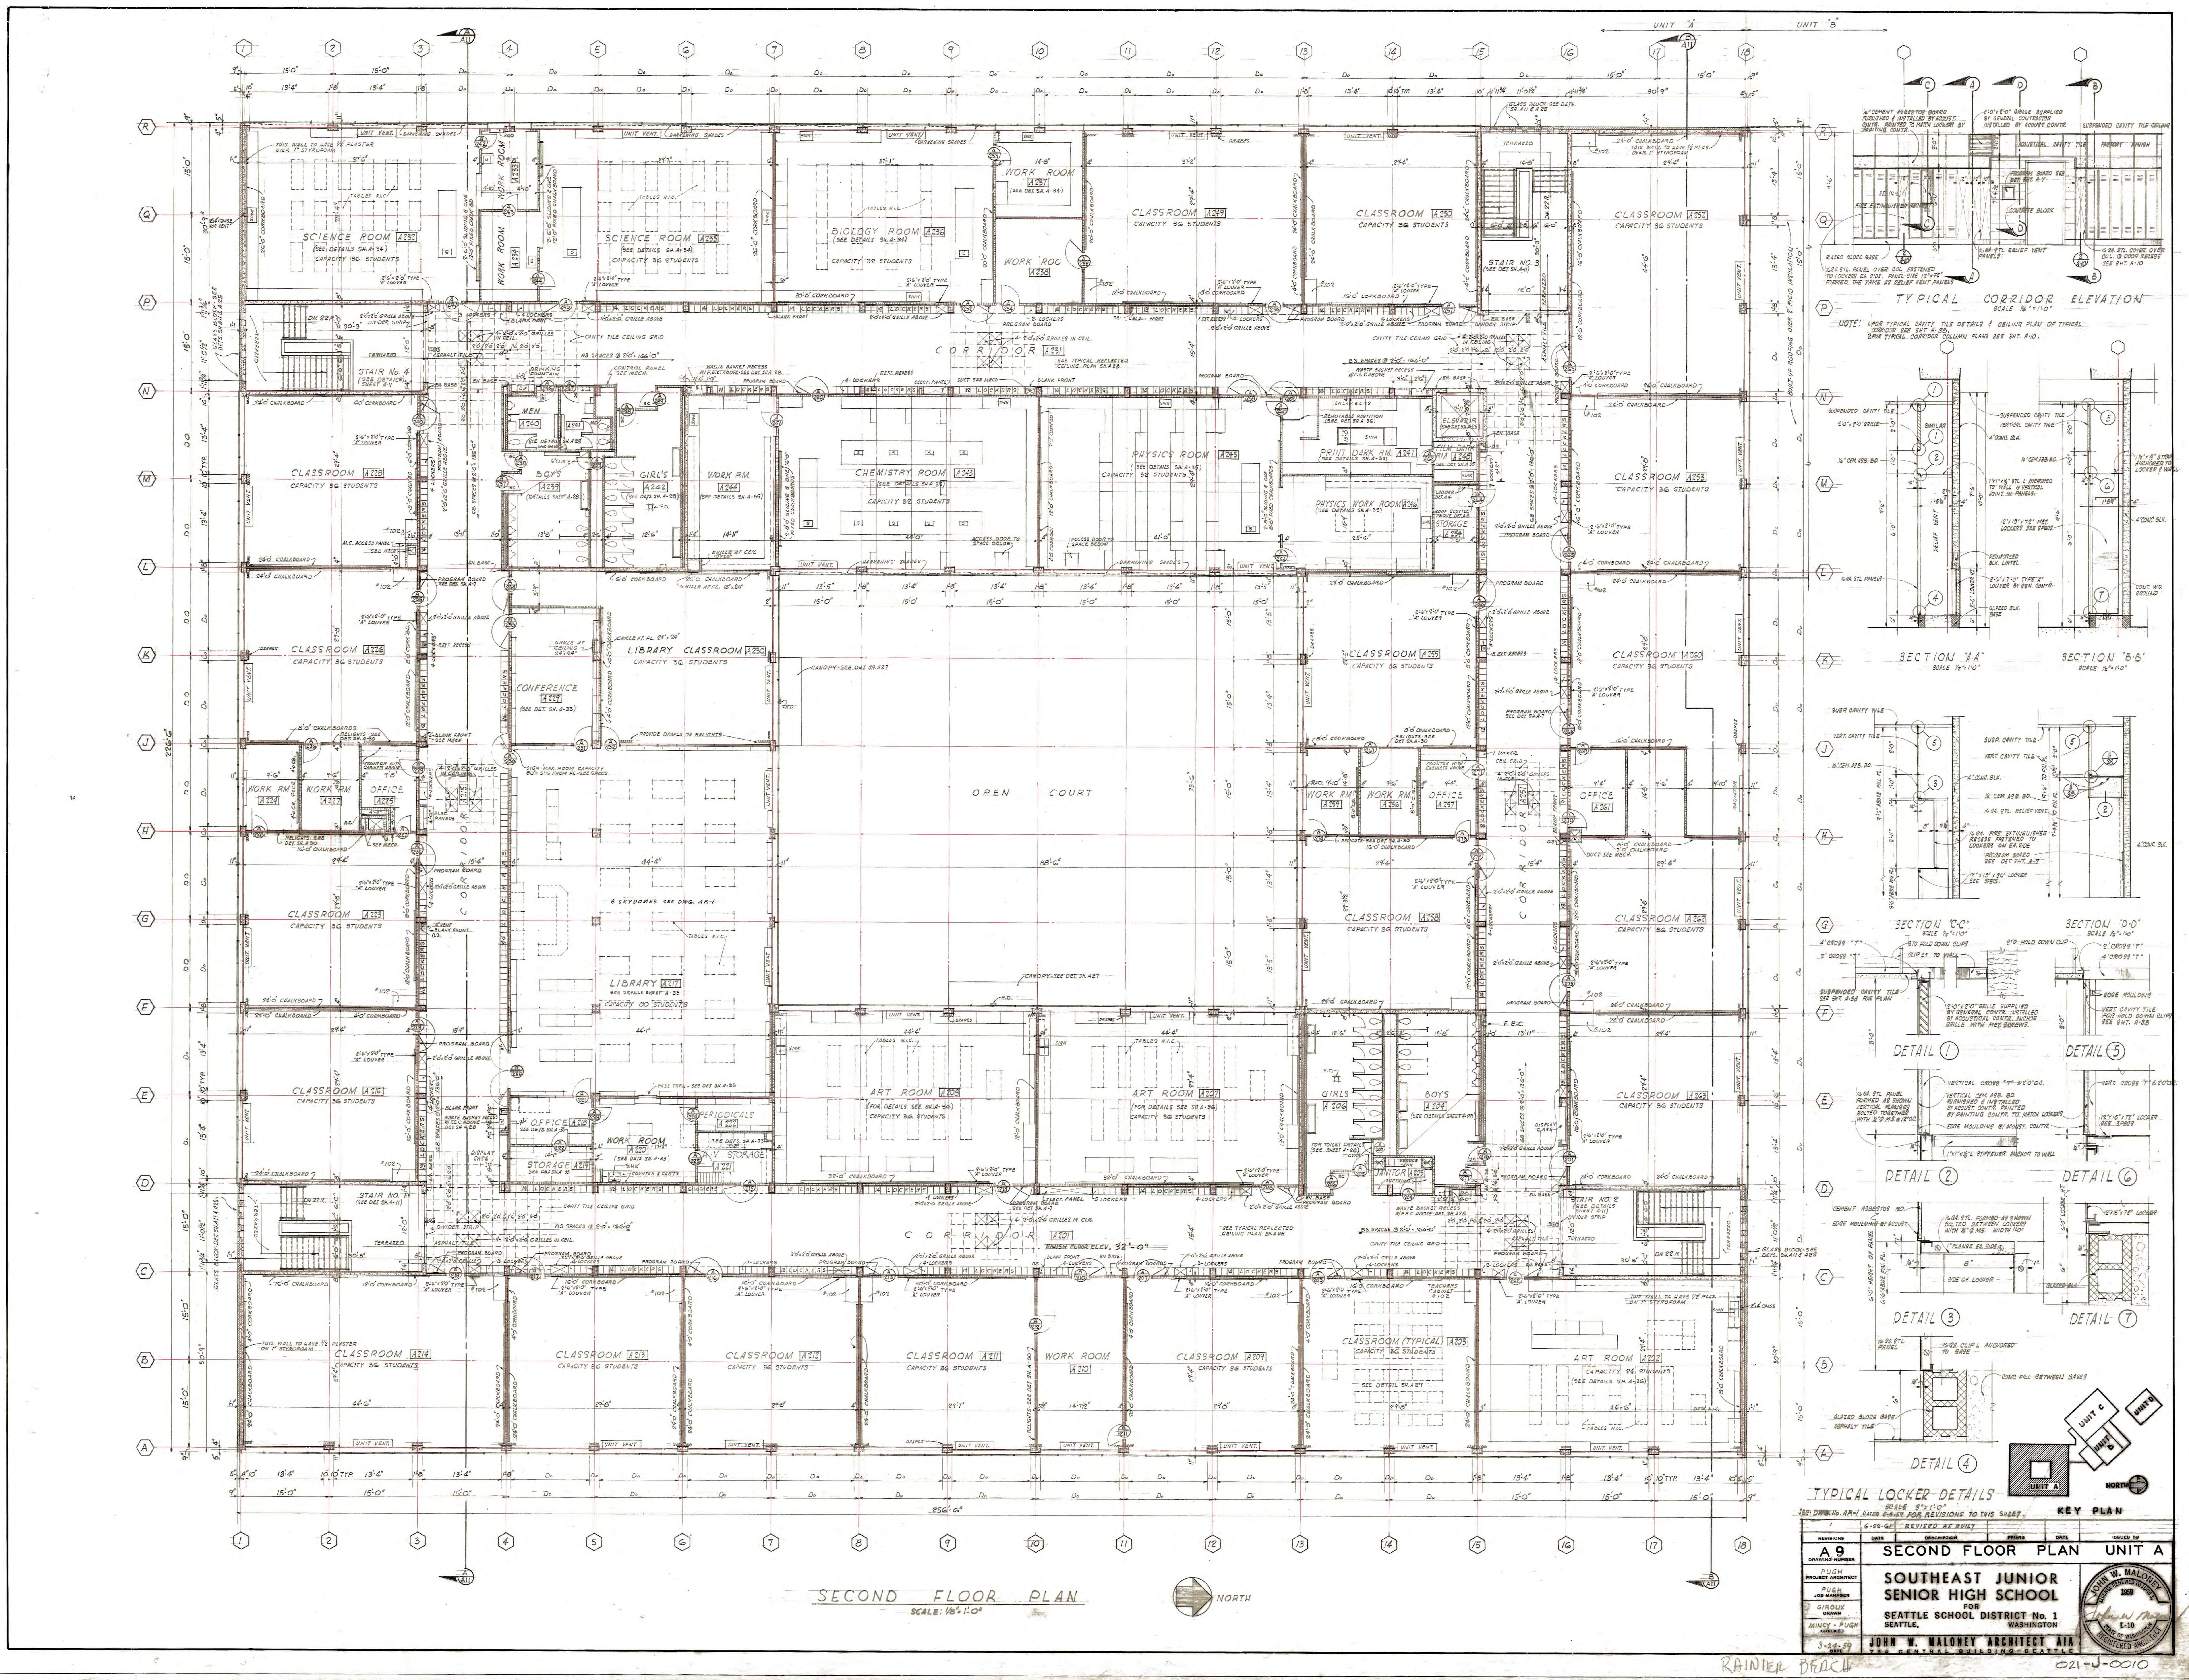
SECOND FLOOR PLAN
SCALE: 1/8"=1'-0"
NORTH
OPEN COURT
LIBRARY CLASSROOM
LIBRARY
CHEMISTRY ROOM
PHYSICS ROOM
BIOLOGY ROOM
SCIENCE ROOM
ART ROOM
CORRIDOR
TYPICAL CORRIDOR ELEVATION
SECTION "A-A"
SECTION "B-B"
SECTION "C-C"
SECTION "D-D"
DETAIL 1
DETAIL 2
DETAIL 3
DETAIL 4
DETAIL 5
DETAIL 6
DETAIL 7
TYPICAL LOCKER DETAILS
SCALE 3"=1'-0"
SEE DWG. No. AR-1 DATED 8-4-59 FOR REVISIONS TO THIS SHEET.
KEY PLAN
UNIT A
UNIT B
UNIT C
UNIT D
6-22-61 REVISED AS BUILT
REVISIONS
DATE
DESCRIPTION
PRINTS
DATE
ISSUED TO
A9
DRAWING NUMBER
SECOND FLOOR PLAN UNIT A
PUGH
PROJECT ARCHITECT
PUGH
JOB MANAGER
GIROUX
DRAWN
MINCY - PUGH
CHECKED
3-24-59
DATE
SOUTHEAST JUNIOR
SENIOR HIGH SCHOOL
FOR
SEATTLE SCHOOL DISTRICT No. 1
SEATTLE, WASHINGTON
JOHN W. MALONEY ARCHITECT AIA
754 CENTRAL BUILDING-SEATTLE
JOHN W. MALONEY
LICENSE RENEWED TO JUNE 1, 1959
L-10
STATE OF WASHINGTON
REGISTERED ARCHITECT
RAINIER BEACH
021-J-0010

REVISIONS	DATE	DESCRIPTION	PRINTS	DATE	ISSUED TO
	6-22-61	REVISED AS BUILT			

A 10
DRAWING NUMBER

1/8" ELEVATIONS UNIT A

SOUTHEAST JUNIOR SENIOR HIGH SCHOOL
FOR
SEATTLE SCHOOL DISTRICT No. 1
SEATTLE, WASHINGTON

PUGH — PROJECT ARCHITECT
PUGH — JOB MANAGER
PETERSON — DRAWN
MINCY - PUGH — CHECKED
3-24-59 — DATE

JOHN W. MALONEY ARCHITECT AIA
754 CENTRAL BUILDING - SEATTLE

JOHN W. MALONEY
LICENSE RENEWED TO JUNE 1, 1959
L-10
STATE OF WASHINGTON
REGISTERED ARCHITECT

021-J-0020

REVISIONS	DATE	DESCRIPTION	PRINTS	DATE	ISSUED TO
	6-22-61	REVISED AS BUILT			

A11 DRAWING NUMBER

SECTIONS, STAIR & ENTRANCE DETAILS - UNIT A

PUGH PROJECT ARCHITECT
PUGH JOB MANAGER
RAMALEY, DRAWN
MINCY- PUGH CHECKED
3-24-'59 DATE

SOUTHEAST JUNIOR SENIOR HIGH SCHOOL
FOR
SEATTLE SCHOOL DISTRICT No. 1
SEATTLE, WASHINGTON

JOHN W. MALONEY ARCHITECT AIA
754 CENTRAL BUILDING - SEATTLE

JOHN W. MALONEY LICENSE RENEWED TO JUNE 1, 1959 L-10 STATE OF WASHINGTON REGISTERED ARCHITECT

021-J-0021

DOOR SCHEDULE

DOOR NUMBER	OPENING			DOOR							JAMB					HARDWARE				KICKPLATE			THRESHOLD	REMARKS
	TYPE	WIDTH OF OPENING	HEIGHT OF OPENING	THICKNESS	MATERIAL	FINISH	CORE	GLASS	GRILLE TYPE	GRILLE SIZE	TYPE	MATERIAL	FINISH	CASING MATERIAL	CASING FINISH	TYPE	HAND	FINISH (SEE SPEC.)	STOP	MATERIAL	HEIGHT	SIDE		
C150	A	3'-0"	7'-0"	1 3/4"	BIRCH	ST&V	S	—	—	—	1	STL.	EN.	—	—	12				—	—	—	—	
C151	A	3'-0"	7'-0"	1 3/4"	BIRCH	ST&V.	S	—	—	—	1	STL.	EN.	—	—	12				—	—	—	—	

NOTE: ALL OTHER DOORS TO REMAIN

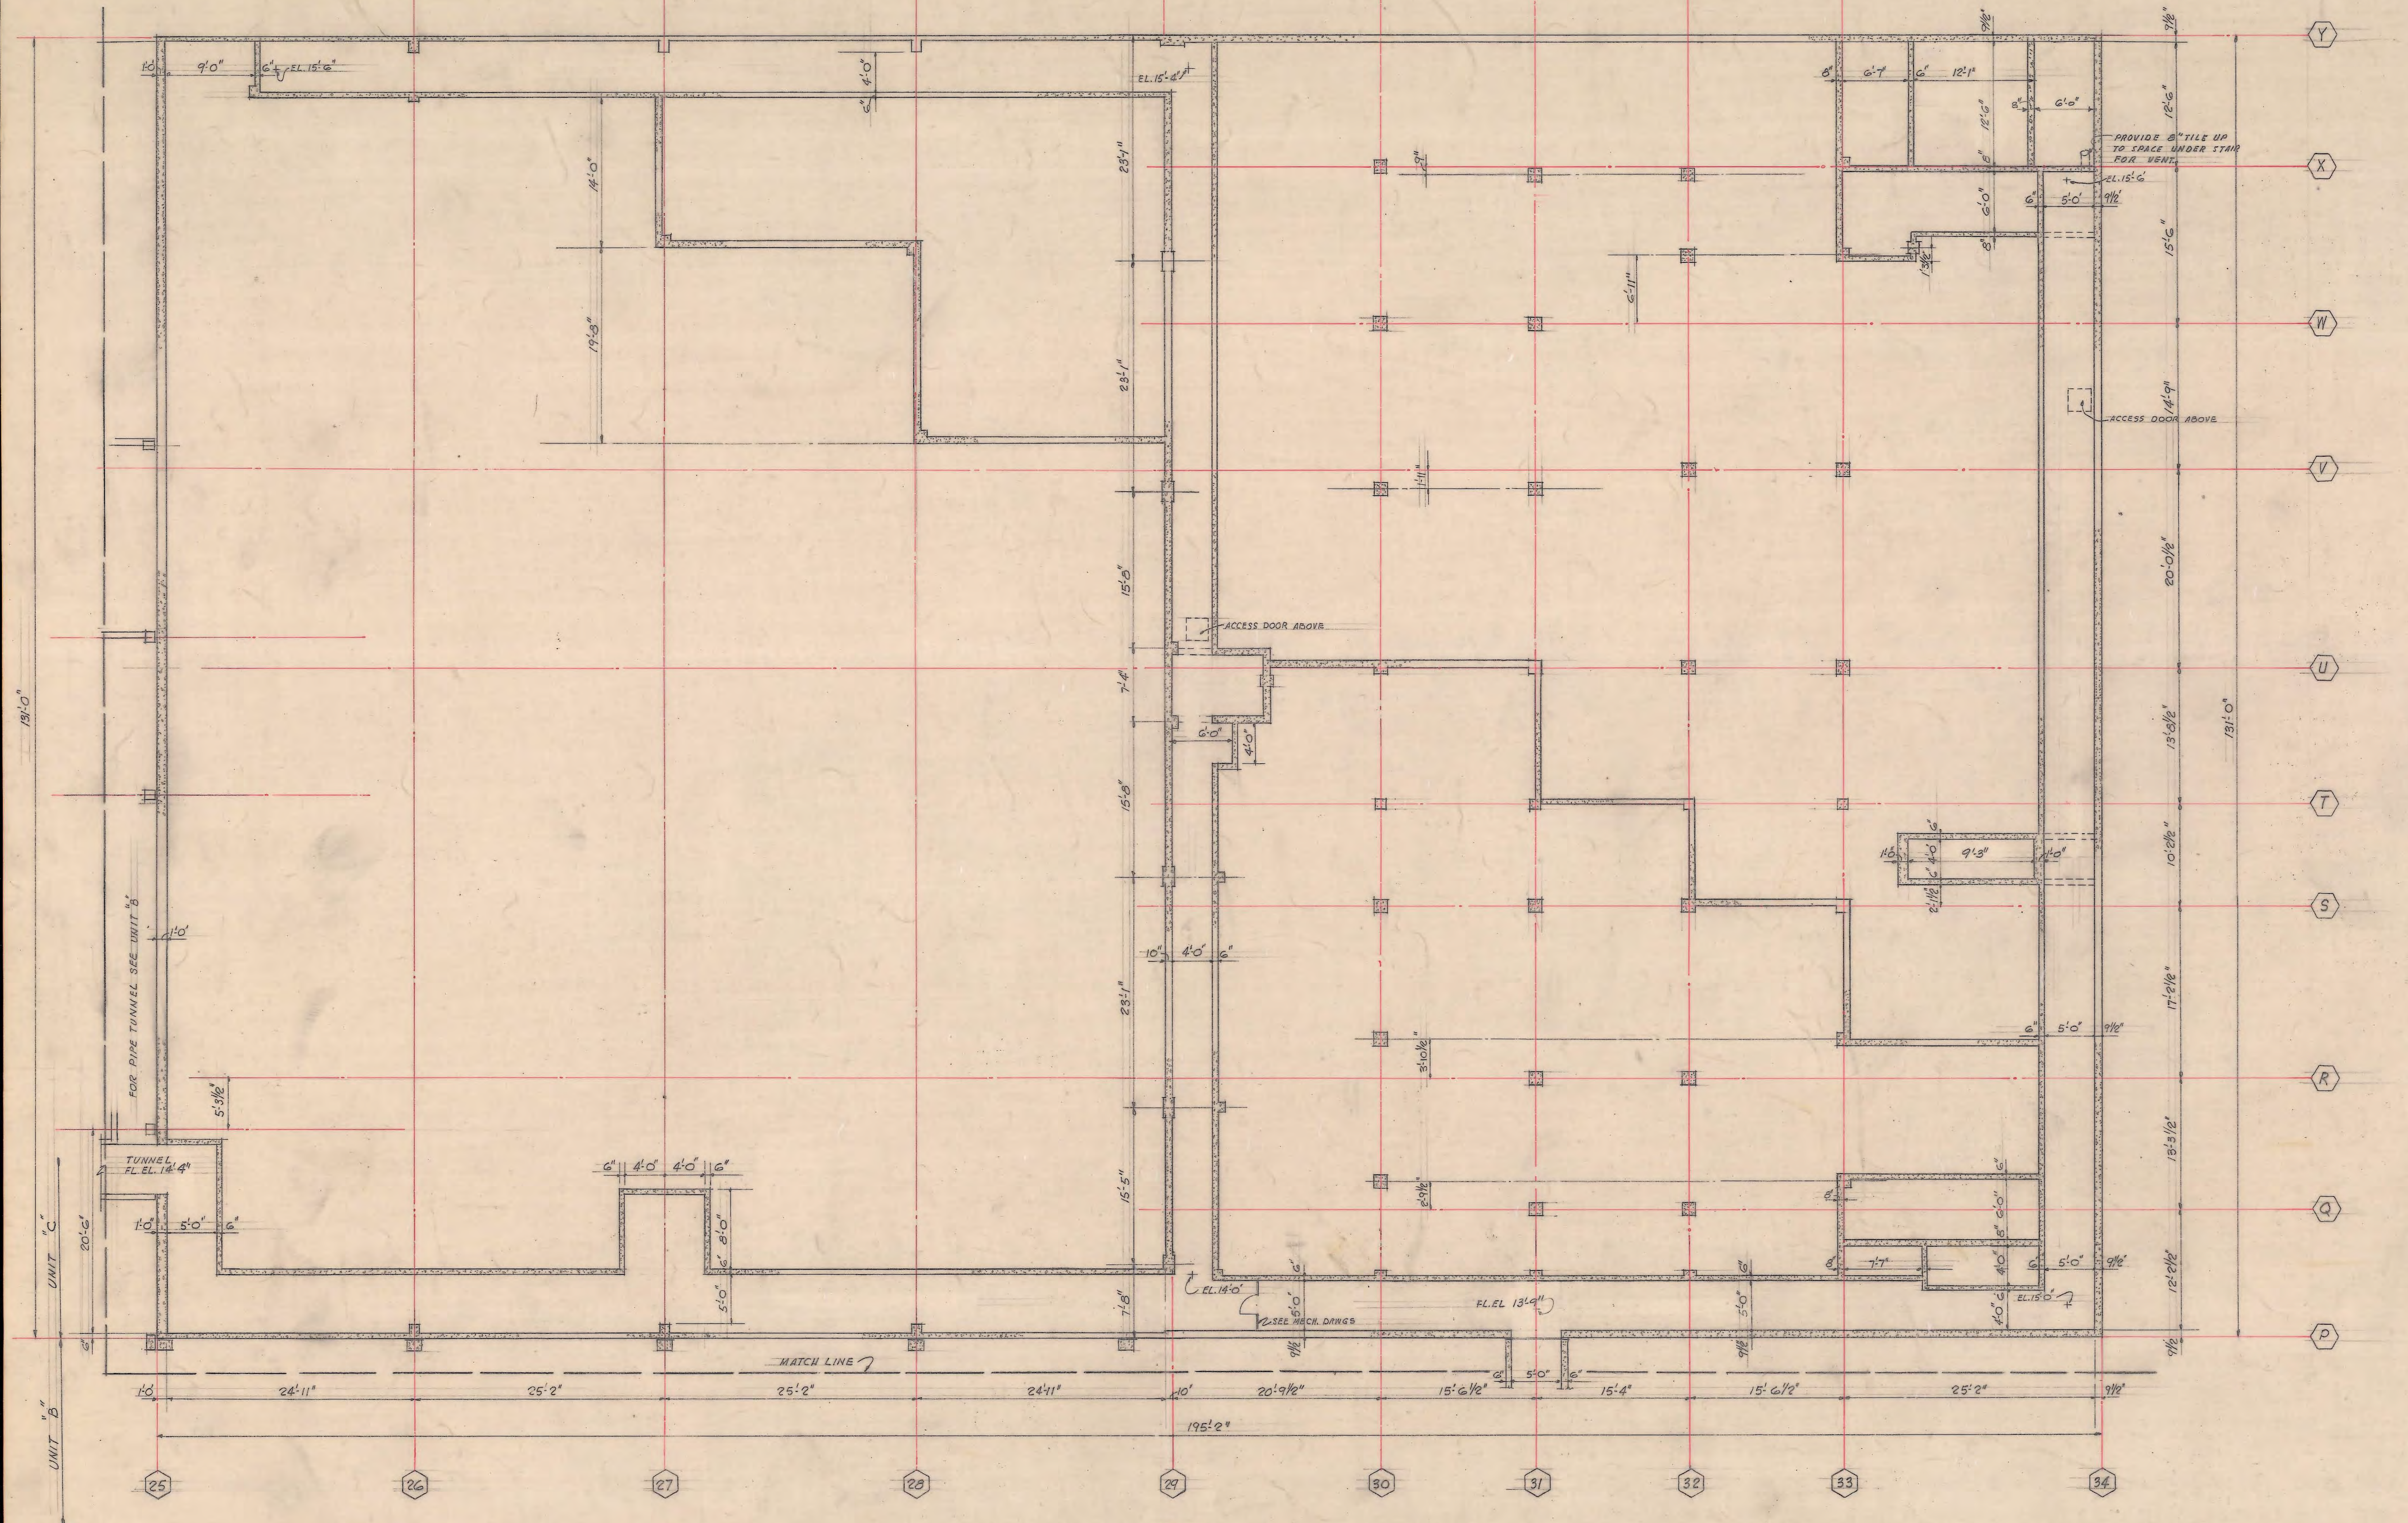

NOTE: FOUNDATION PLAN FOR ALTERNATE #2 TO BE THE SAME

FOUNDATION PLAN UNIT "C"
SCALE: 1/8" = 1'-0"

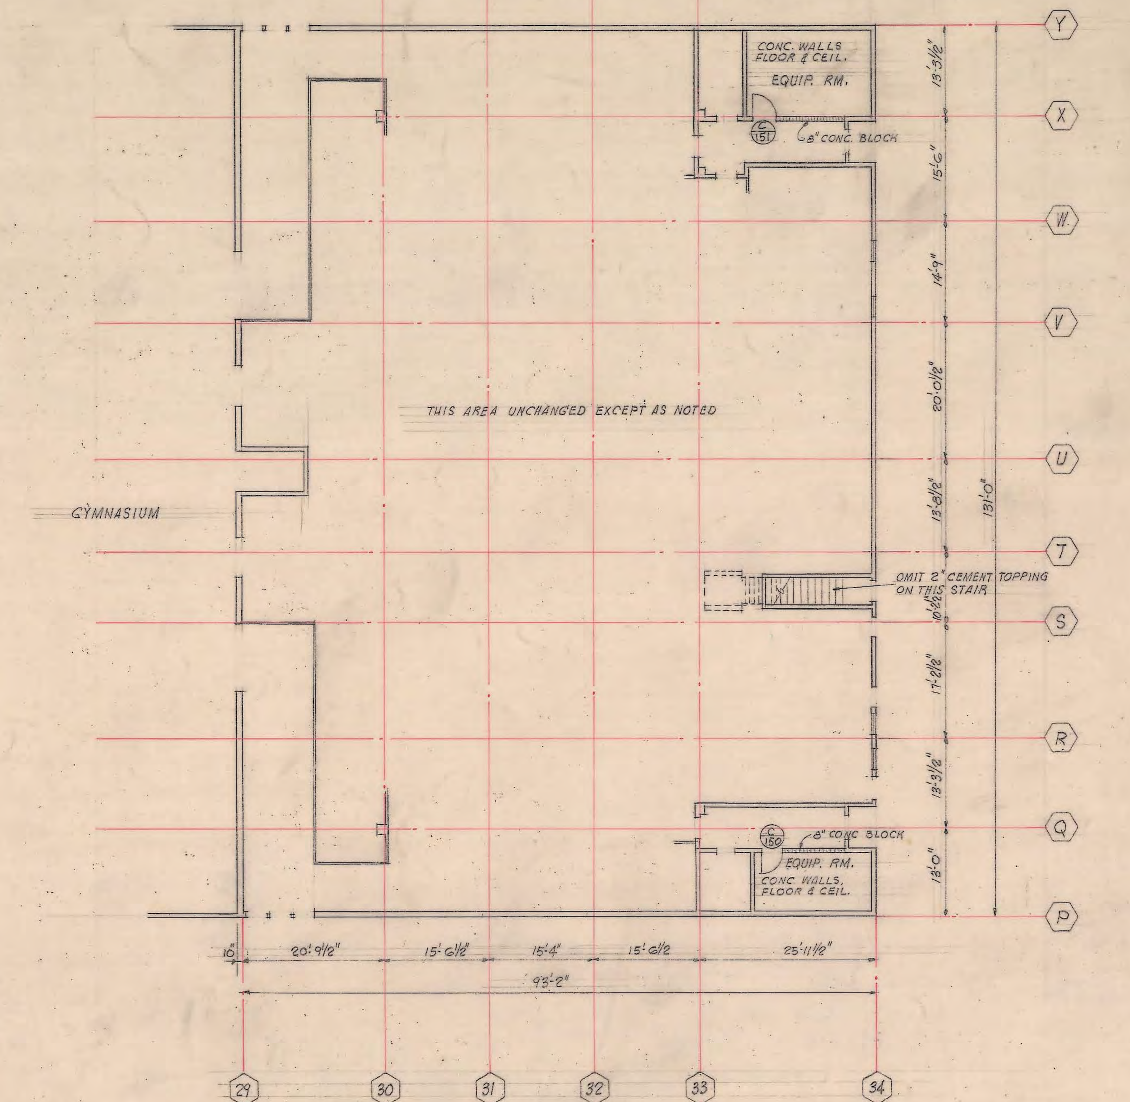

FIRST FLOOR PLAN - ALTERNATE Nº 2
SCALE: 1/16" = 1'-0"

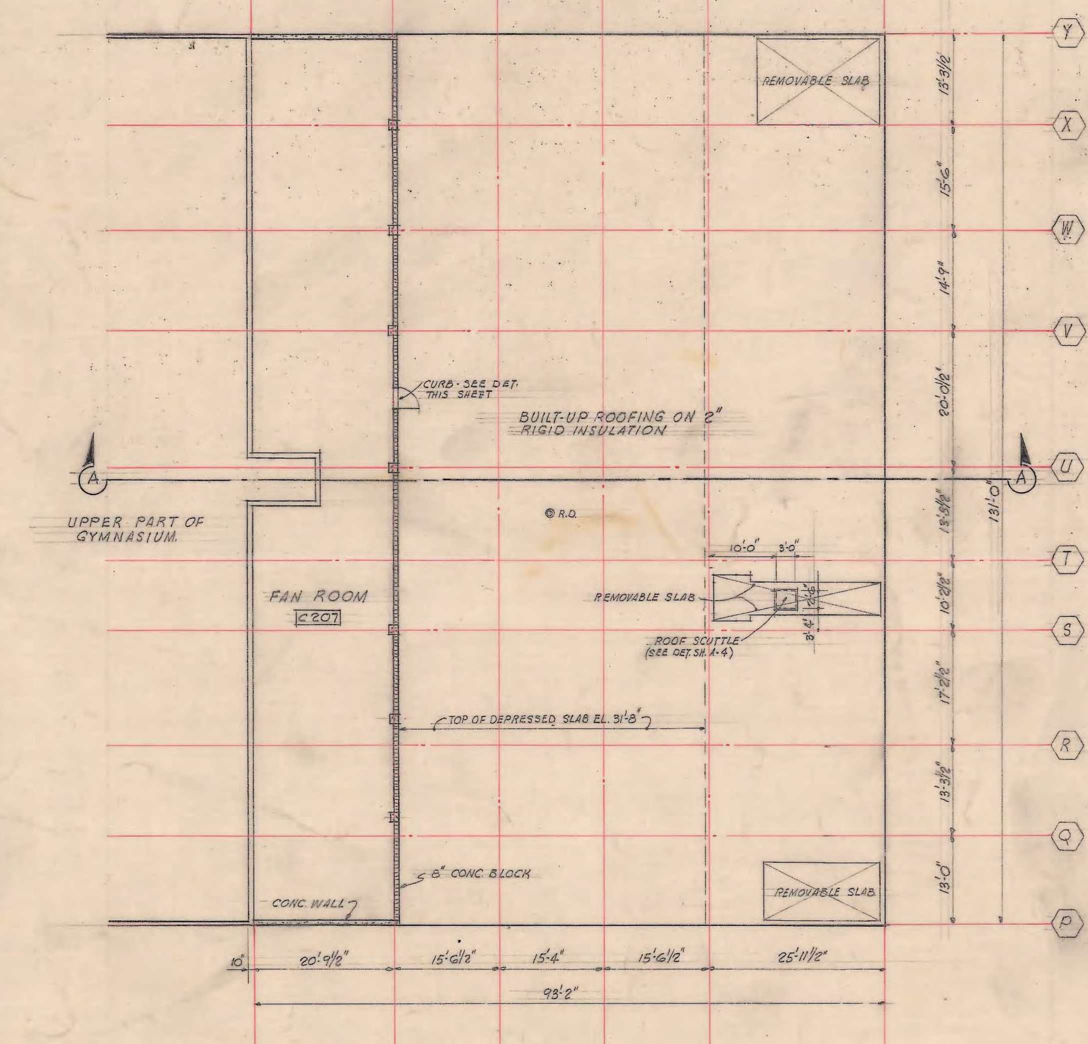

SECOND FLOOR PLAN - ALTERNATE Nº 2
SCALE: 1/16" = 1'-0"

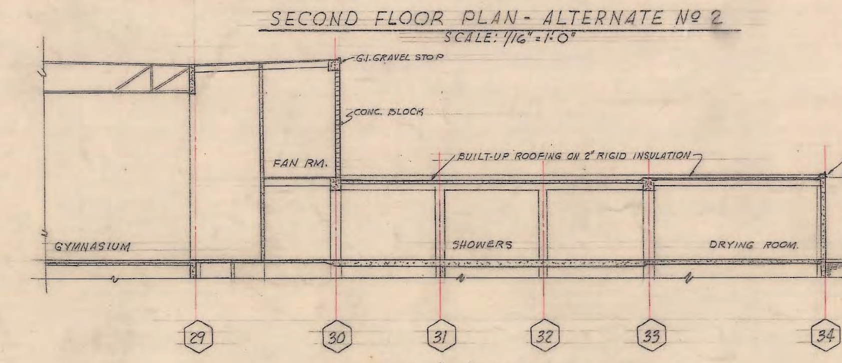

SECTION A-A' - ALTERNATE Nº 2
SCALE: 1/16" = 1'-0"

ALTERNATE Nº 2 (OMIT TWO SMALL GYMNASIUMS)

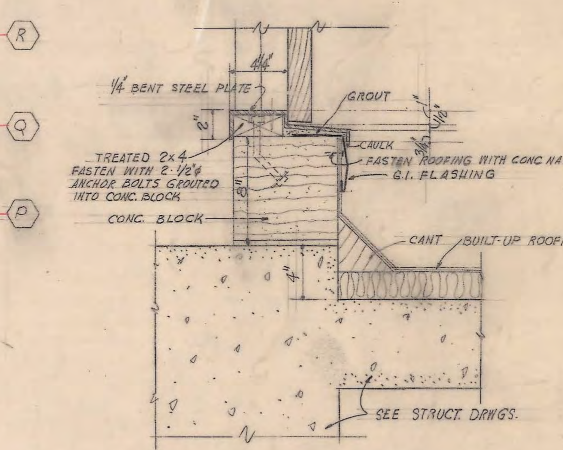

CURB DETAIL AT DOOR TO FAN ROOM
SCALE: 1 1/2" = 1'-0"

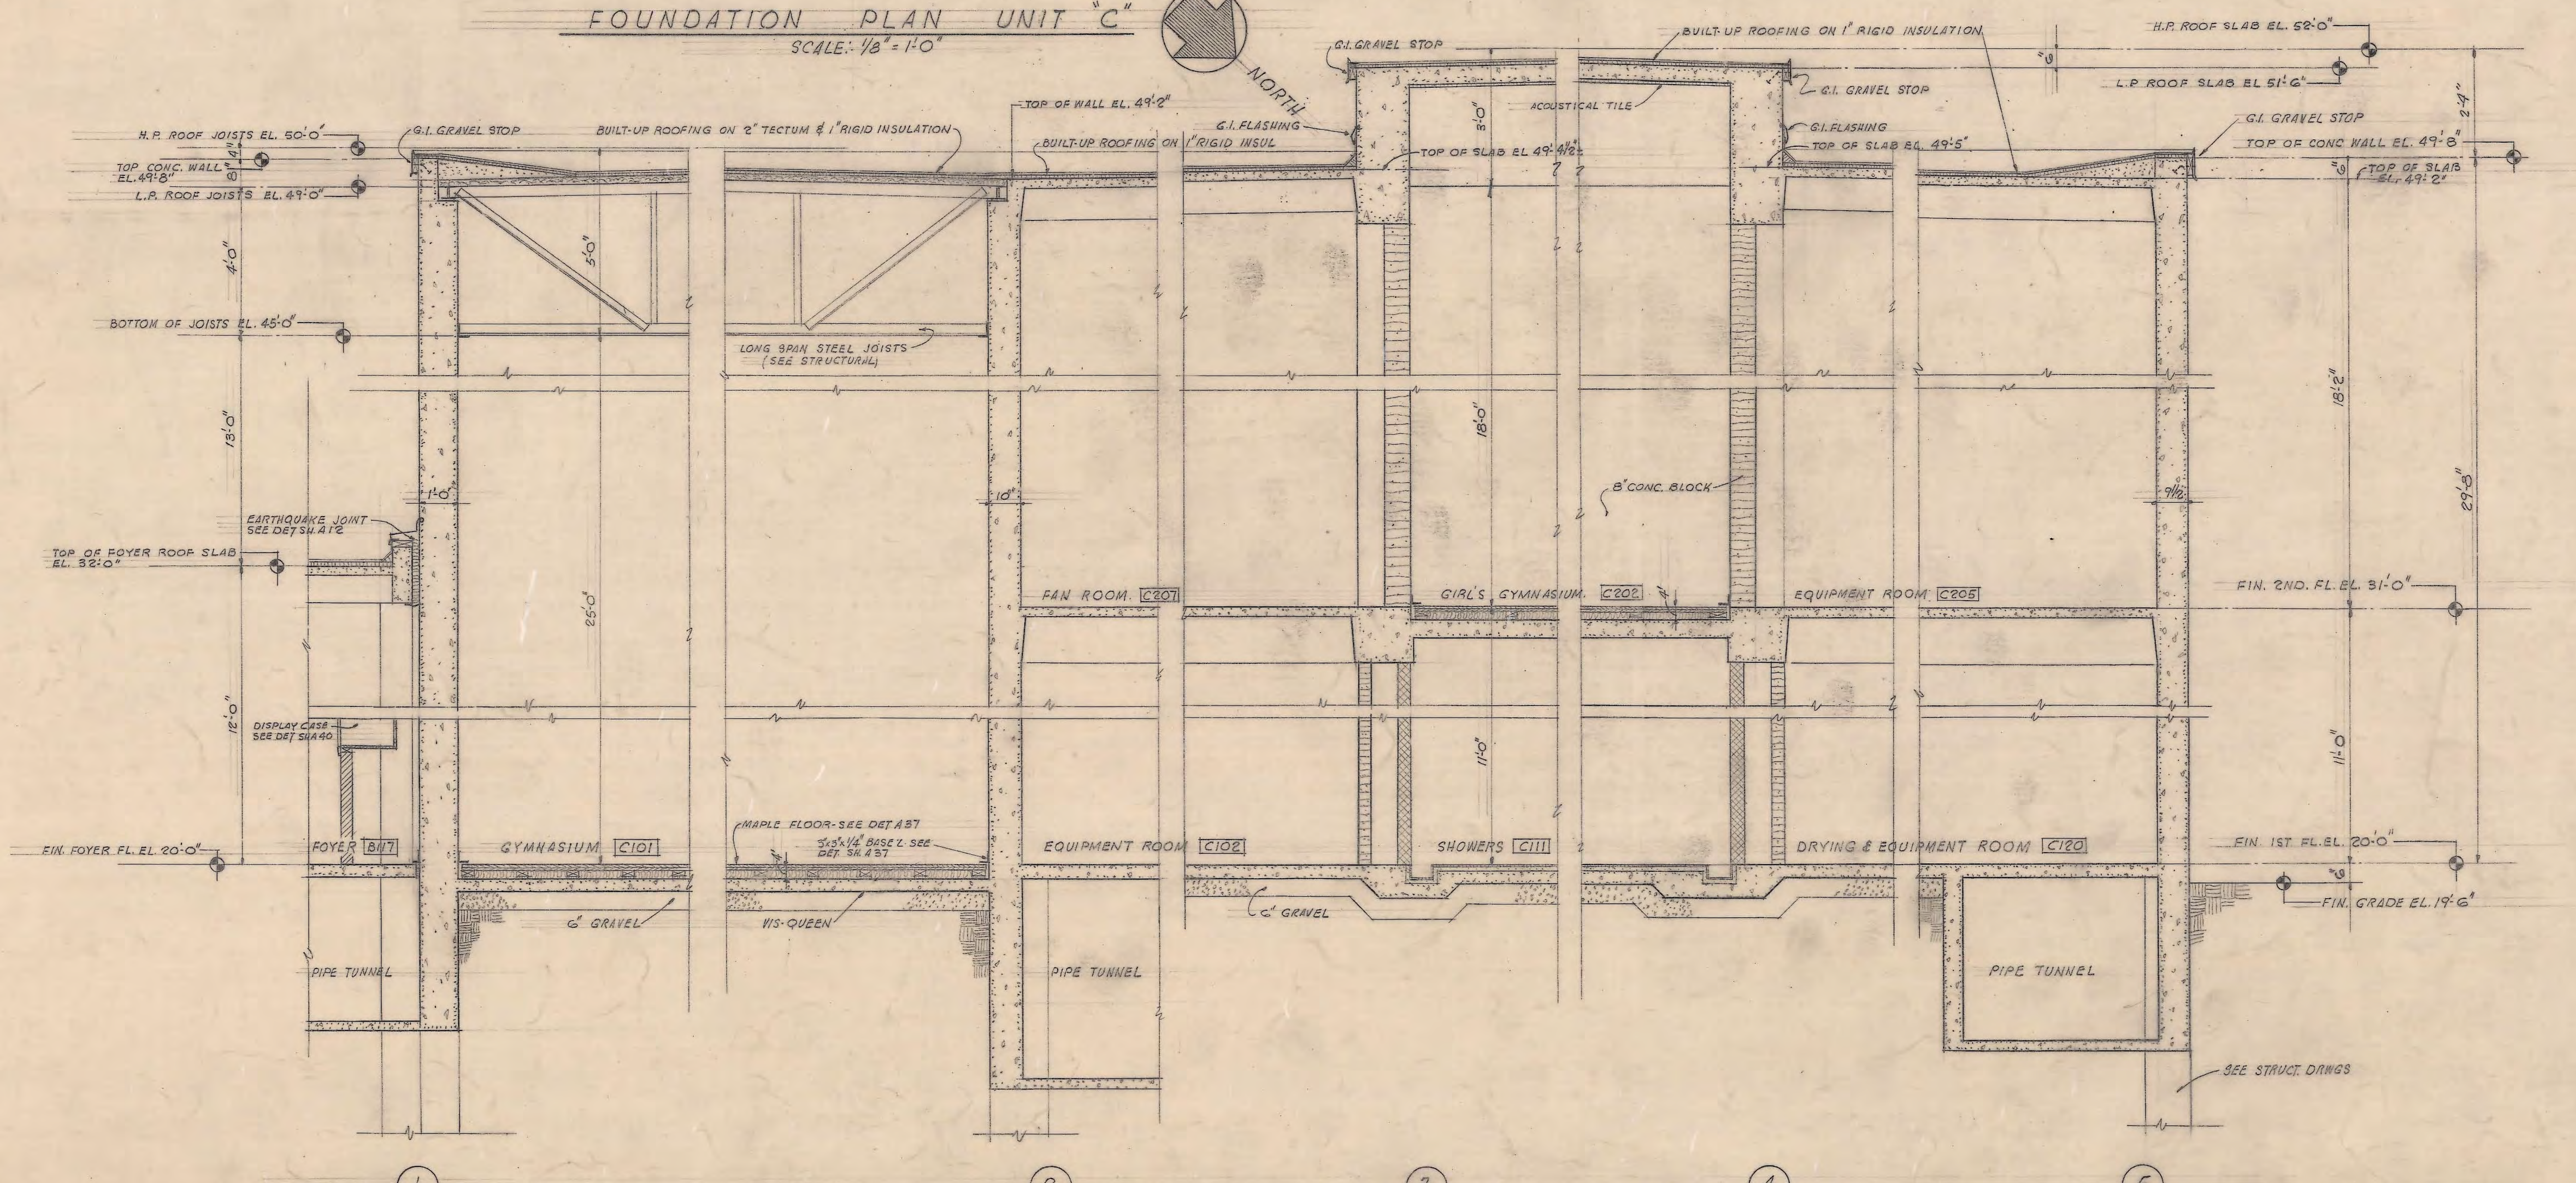

WALL SECTIONS SCALE: 3/16" = 1'-0"

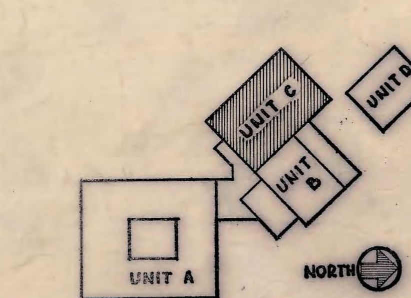

KEY PLAN

REVISIONS	DATE	DESCRIPTION	PRINTS	DATE	ISSUED TO
	6-22-61	REVISED AS BUILT			

A 17
DRAWING NUMBER

FOUNDATION PLAN — UNIT C

PUGH
PROJECT ARCHITECT
PUGH
JOB MANAGER
GIROUX
DRAWN
MINCY - PUGH
CHECKED
3-24-59
DATE

SOUTHEAST JUNIOR SENIOR HIGH SCHOOL
FOR
SEATTLE SCHOOL DISTRICT No. 1
SEATTLE, WASHINGTON

JOHN W. MALONEY ARCHITECT AIA
754 CENTRAL BUILDING - SEATTLE

JOHN W. MALONEY
LICENSE RENEWED TO JUNE 1, 1959
L-10
STATE OF WASHINGTON
REGISTERED ARCHITECT

021-J-0027

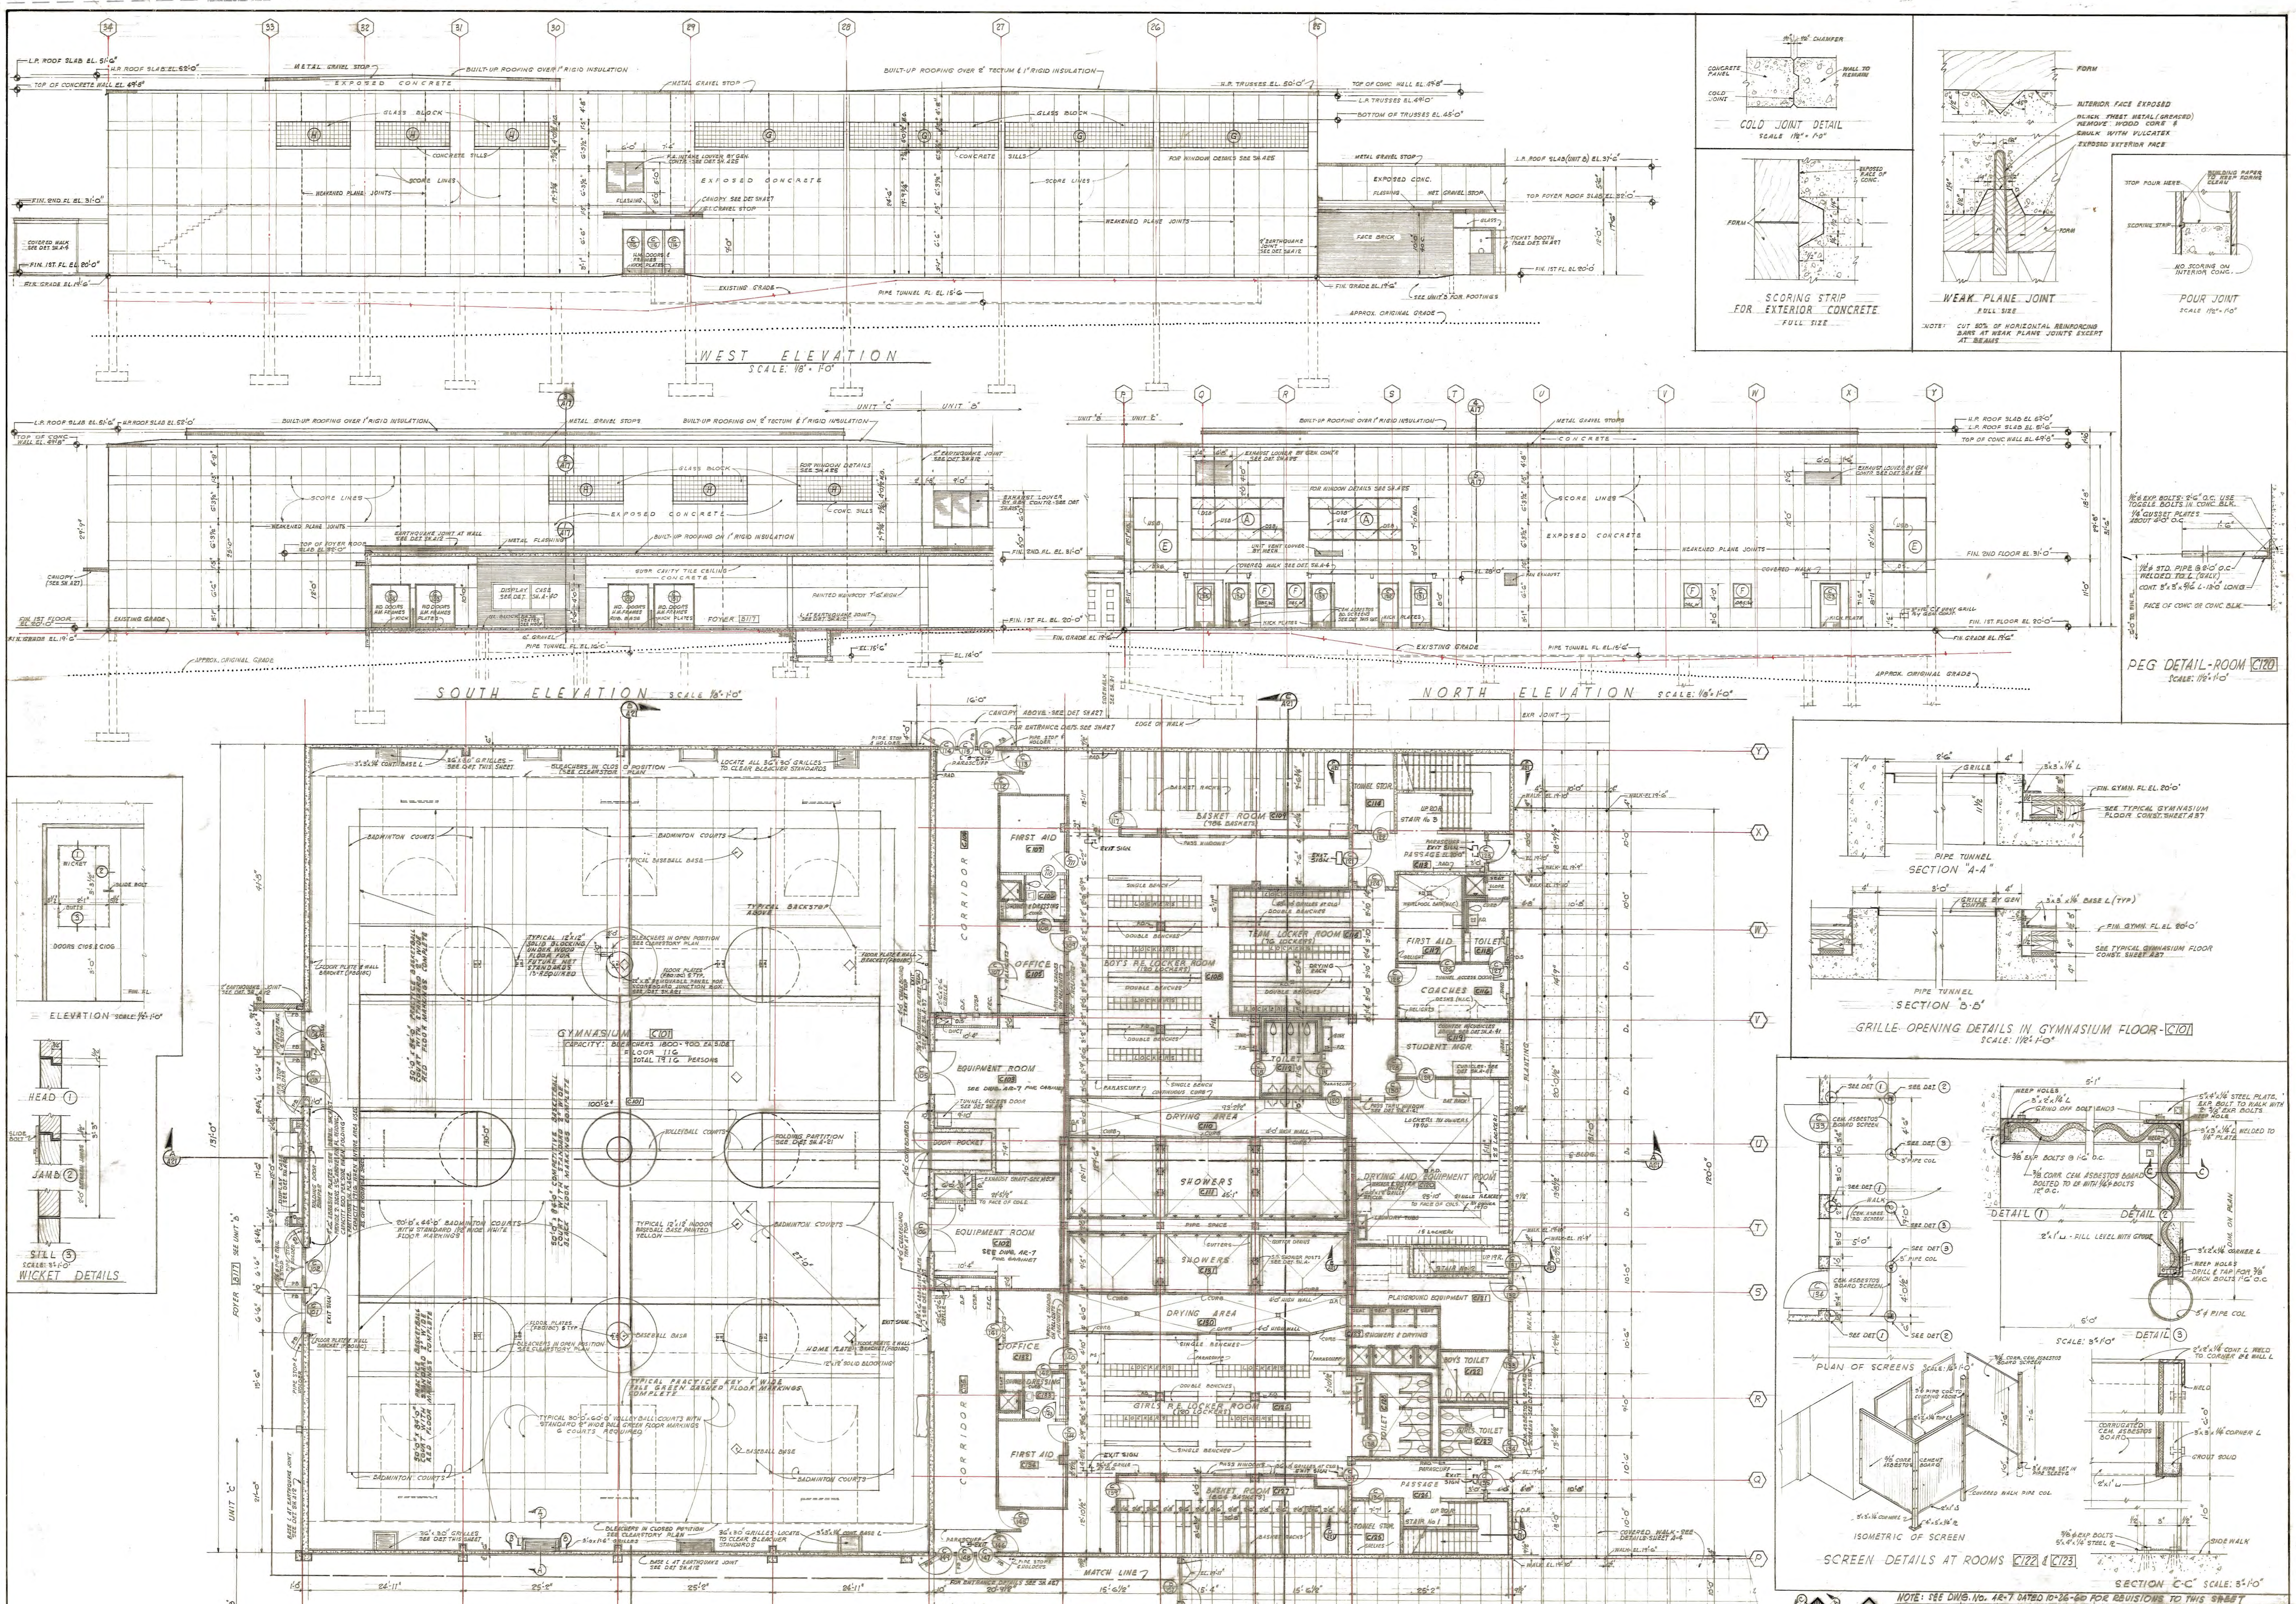

NOTE: SEE DWG. No. AR-7 DATED 10-26-60 FOR REVISIONS TO THIS SHEET

	6-26-61	REVISED AS BUILT			
REVISIONS	DATE	DESCRIPTION	PRINTS	DATE	ISSUED TO

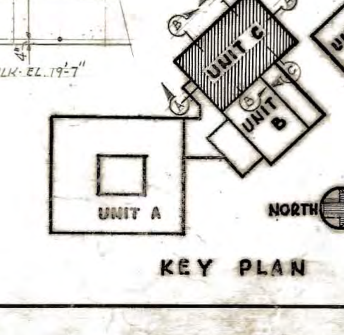

A19 DRAWING NUMBER	FIRST FLOOR PLAN & ELEVATIONS - UNIT C
PUGH PROJECT ARCHITECT	SOUTHEAST JUNIOR SENIOR HIGH SCHOOL FOR SEATTLE SCHOOL DISTRICT No. 1 SEATTLE, WASHINGTON
PUGH JOB MANAGER	
GIROUX DRAWN	
MINCY-PUGH CHECKED	
3-24-59 DATE	JOHN W. MALONEY ARCHITECT AIA 754 CENTRAL BUILDING - SEATTLE

JOHN W. MALONEY · LICENSE RENEWED TO JUNE 1, 1959 · C-10 · STATE OF WASHINGTON · REGISTERED ARCHITECT

021-J-0020

REVISIONS	DATE	DESCRIPTION	PRINTS	DATE	ISSUED TO
	6-22-61	REVISED AS BUILT			

A22 DRAWING NUMBER

FOUNDATION PLAN, SECTIONS & DETAILS – UNIT D

PUGH — PROJECT ARCHITECT
PUGH — JOB MANAGER
DOWNING — DRAWN
MINCY - PUGH — CHECKED
3-24-59 — DATE

SOUTHEAST JUNIOR SENIOR HIGH SCHOOL

FOR

SEATTLE SCHOOL DISTRICT No. 1
SEATTLE, WASHINGTON

JOHN W. MALONEY ARCHITECT AIA
754 CENTRAL BUILDING – SEATTLE

JOHN W. MALONEY
LICENSE RENEWED TO JUNE 1, 1959
L-10
STATE OF WASHINGTON
REGISTERED ARCHITECT

021-J-0032

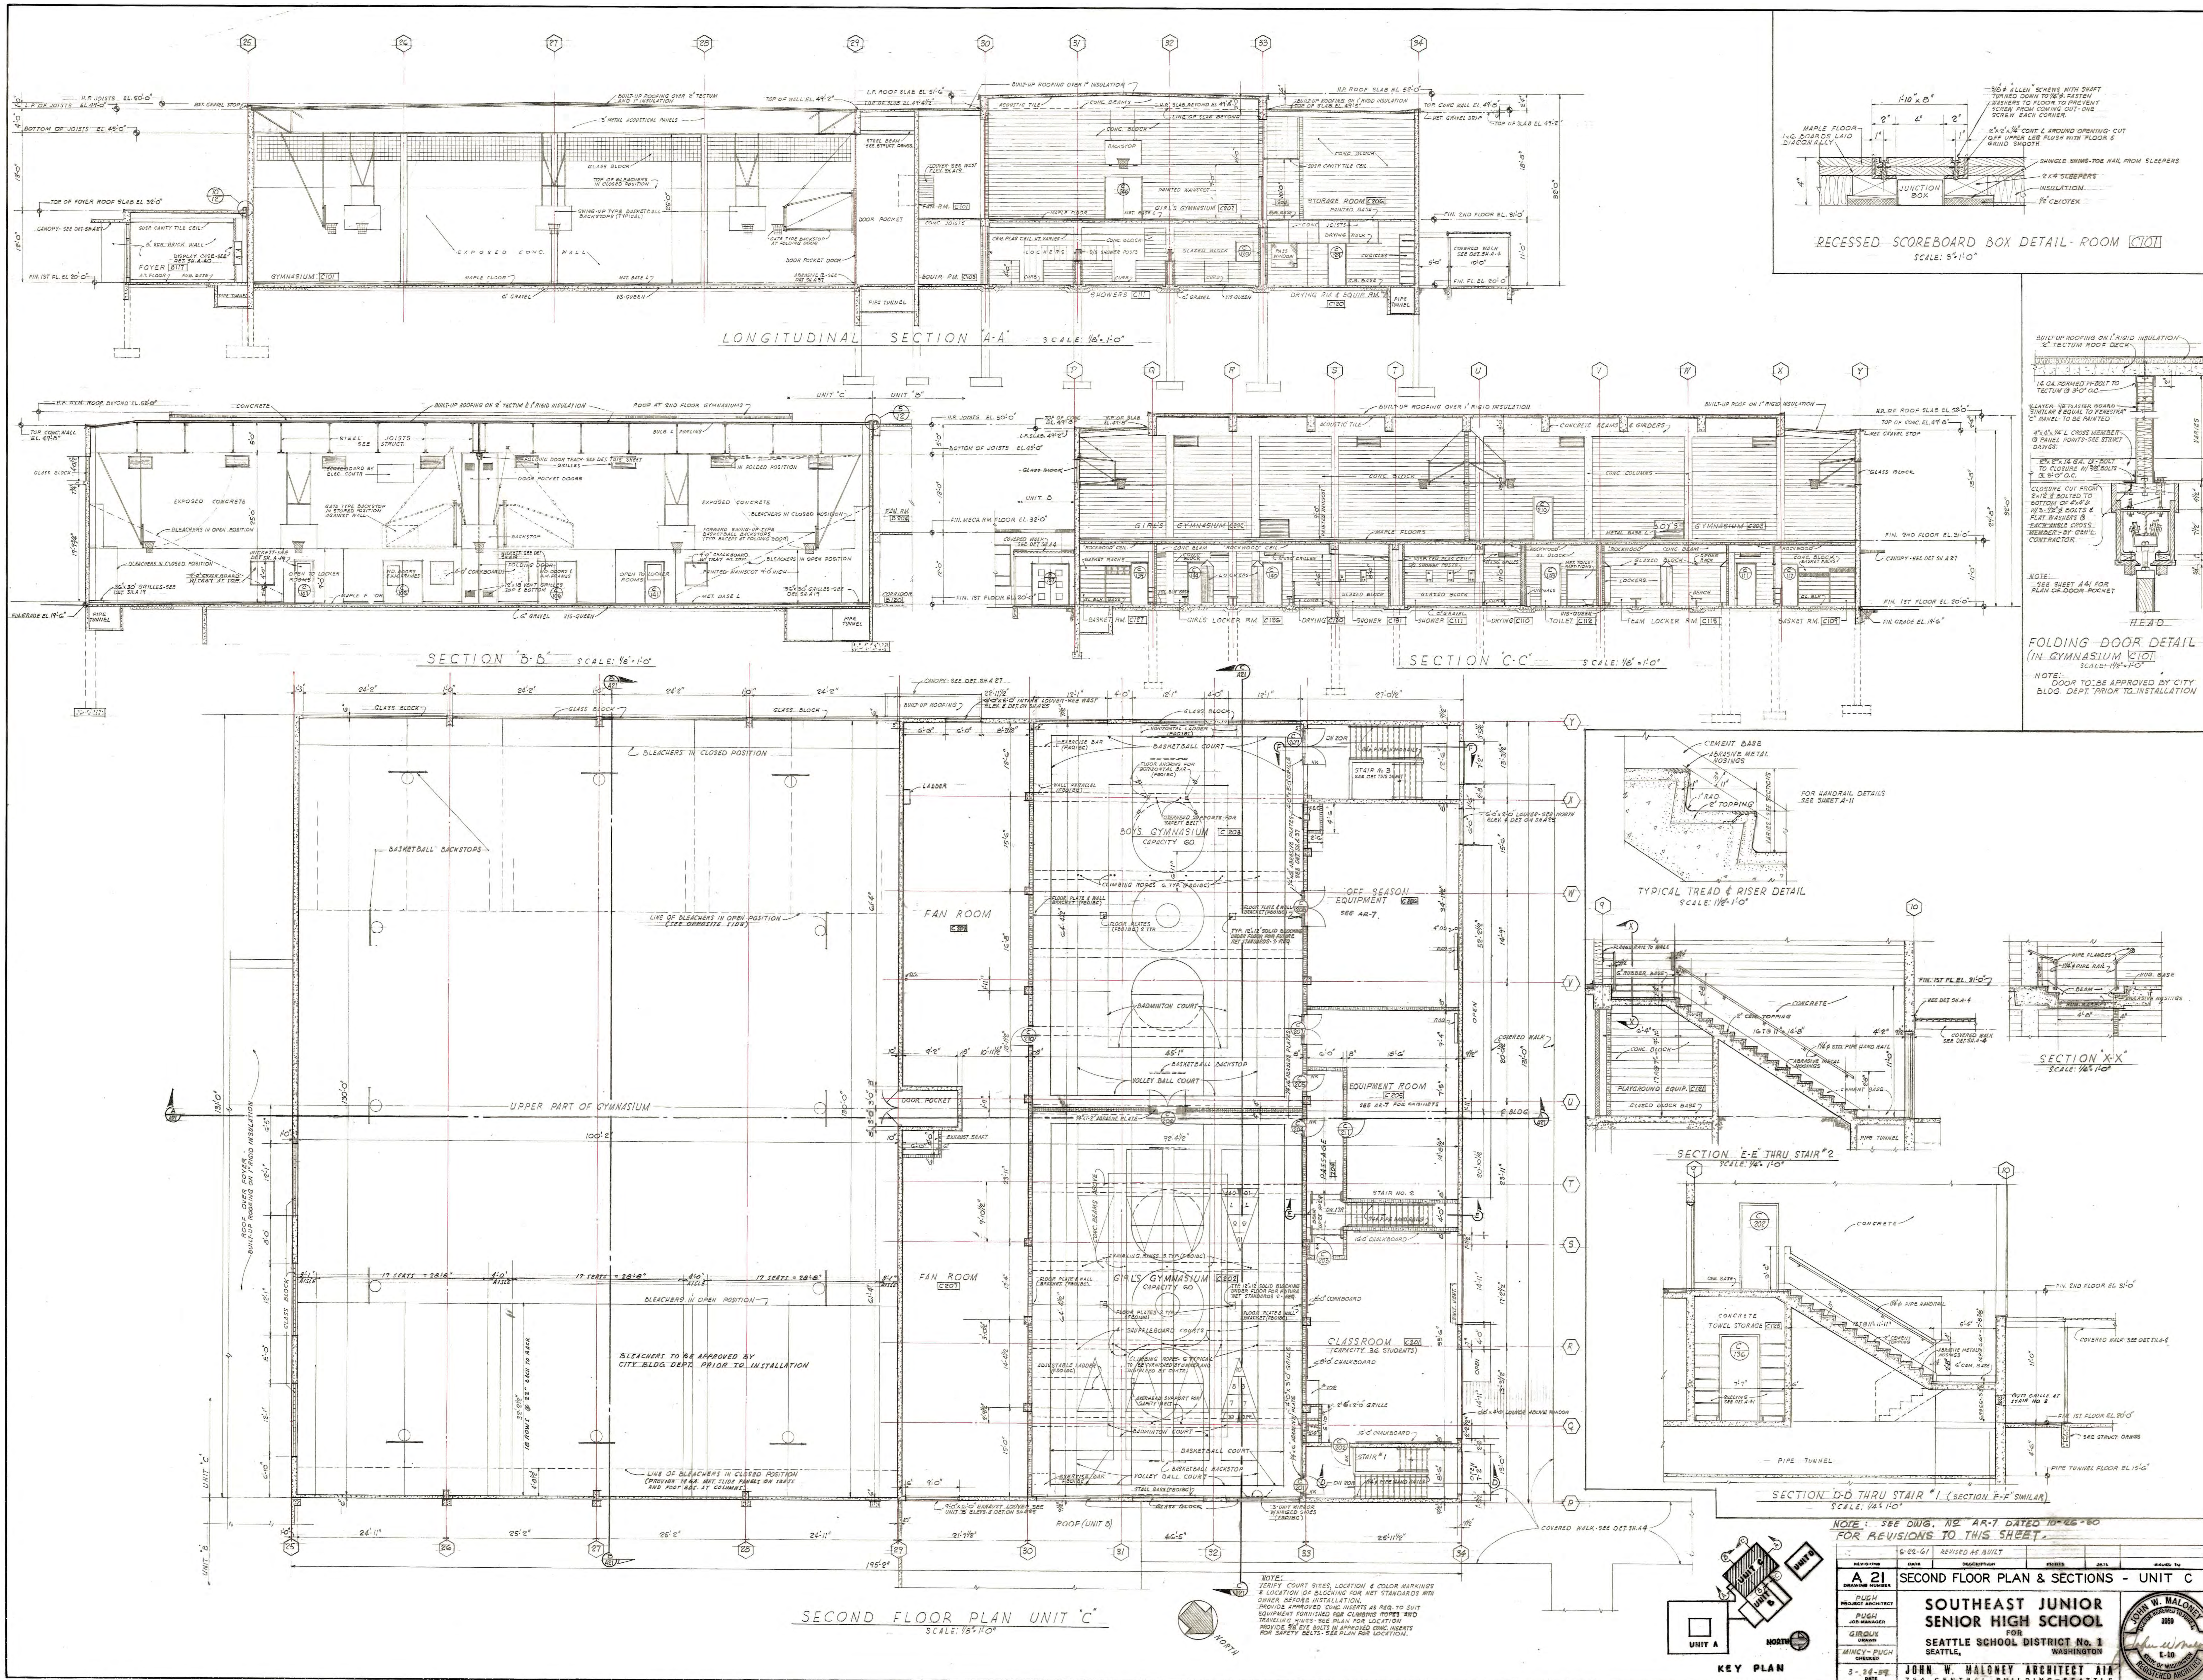

NOTE: SEE DWG. No AR-7 DATED 10-26-60 FOR REVISIONS TO THIS SHEET.

REVISIONS	DATE	DESCRIPTION	PRINTS	DATE	ISSUED TO
	6-22-61	REVISED AS BUILT			

A 21 DRAWING NUMBER

SECOND FLOOR PLAN & SECTIONS - UNIT C

PUGH — PROJECT ARCHITECT
PUGH — JOB MANAGER
GIROUX — DRAWN
MINCY-PUGH — CHECKED
3-24-59 — DATE

SOUTHEAST JUNIOR SENIOR HIGH SCHOOL
FOR
SEATTLE SCHOOL DISTRICT No. 1
SEATTLE, WASHINGTON

JOHN W. MALONEY ARCHITECT AIA
754 CENTRAL BUILDING - SEATTLE

JOHN W. MALONEY — LICENSE RENEWED TO JUNE 1, 1959 — L-10 — STATE OF WASHINGTON — REGISTERED ARCHITECT

2-3-59 W+S & B+G
2-5-59 MAC
2-3-59 EASTON & MAC
3-9-59 B+G

021-J-0022

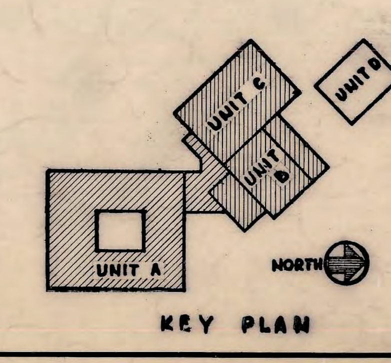

REVISIONS	DATE	DESCRIPTION	PRINTS	DATE	ISSUED TO
	6-22-61	REVISED AS BUILT			

A 25
DRAWING NUMBER

WINDOW & ELEVATOR DETAILS – UNITS A,B,C.

PUGH
PROJECT ARCHITECT

PUGH
JOB MANAGER

RAMALEY & PUGH
DRAWN

MINCY - PUGH
CHECKED

3-24-59
DATE

SOUTHEAST JUNIOR
SENIOR HIGH SCHOOL
FOR
SEATTLE SCHOOL DISTRICT No. 1
SEATTLE, WASHINGTON

JOHN W. MALONEY ARCHITECT AIA
754 CENTRAL BUILDING – SEATTLE

JOHN W. MALONEY
LICENSE RENEWED TO JUNE 1, 1959
L-10
STATE OF WASHINGTON
REGISTERED ARCHITECT

021-J-0035

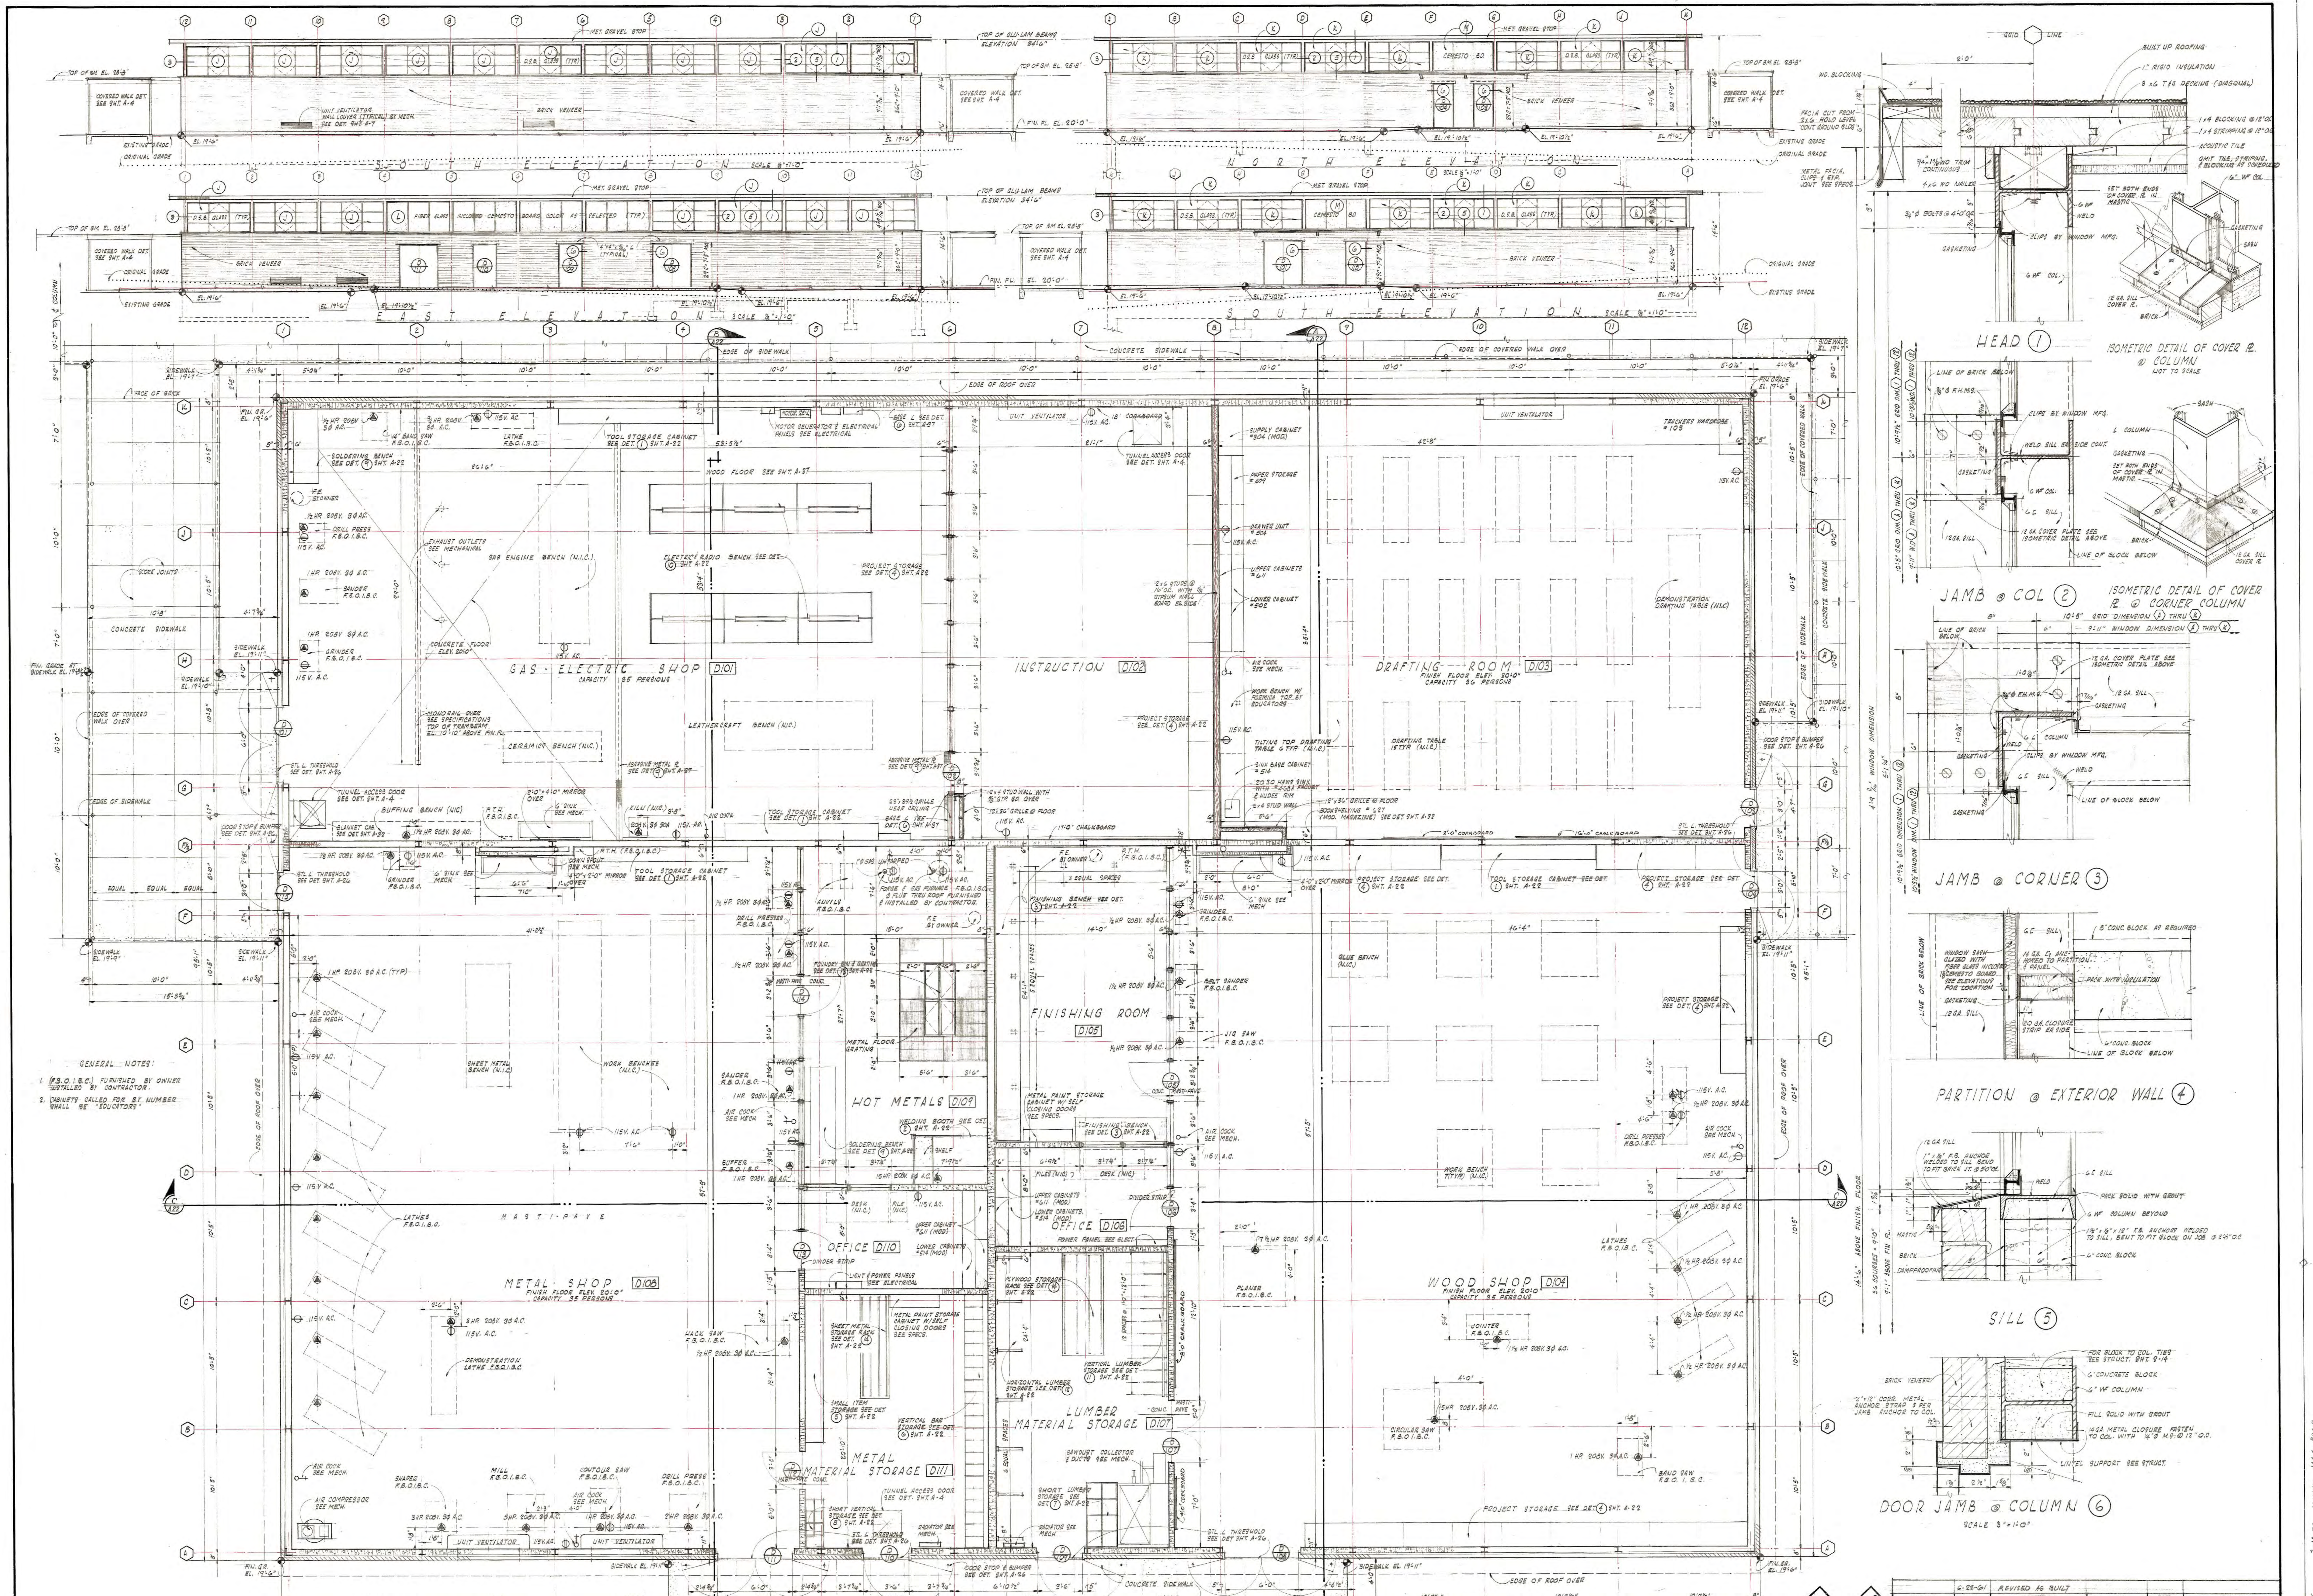

REVISIONS	DATE	DESCRIPTION	PRINTS	DATE	ISSUED TO
	6-22-61	REVISED AS BUILT			

A 24
DRAWING NUMBER

FIRST FLOOR PLAN
ELEVATIONS & DETAILS

UNIT D

PUGH
PROJECT ARCHITECT

PUGH
JOB MANAGER

DOWNING
DRAWN

MINCY - PUGH
CHECKED

3-24-59
DATE

SOUTHEAST JUNIOR
SENIOR HIGH SCHOOL
FOR
SEATTLE SCHOOL DISTRICT No. 1
SEATTLE, WASHINGTON

JOHN W. MALONEY ARCHITECT AIA
754 CENTRAL BUILDING - SEATTLE

JOHN W. MALONEY
LICENSE RENEWED TO JUNE 1, 1959
L-10
STATE OF WASHINGTON
REGISTERED ARCHITECT

021-J-0025

3-12-59 MINCY
1-30-59 O.R.G.
12-19-58 CASTON
2-19-59 B+G

NOTE:
ALL CABINETS, SHELVING, AND WORK BENCHES SHOWN ON DRAWINGS ARE NOT A PART OF THE CONTRACT.

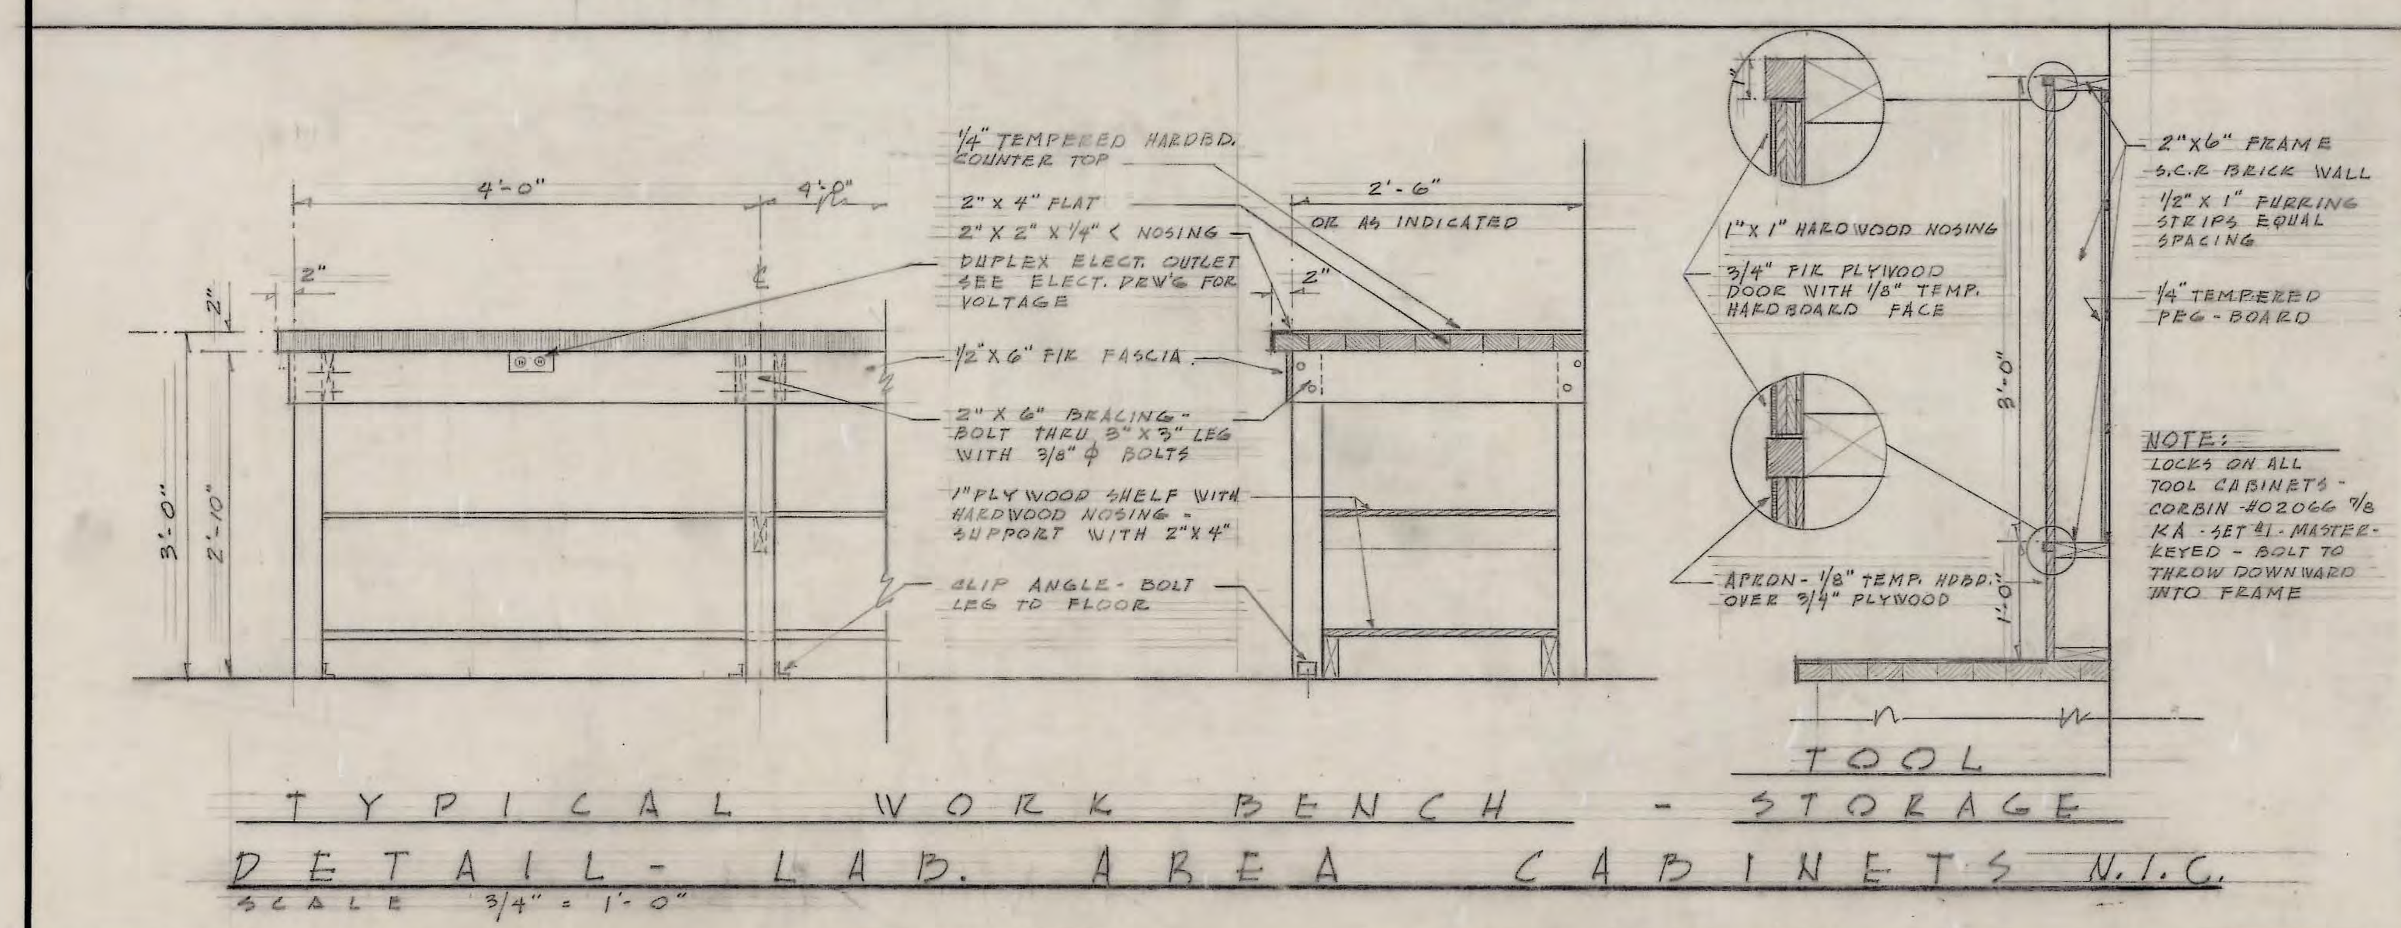

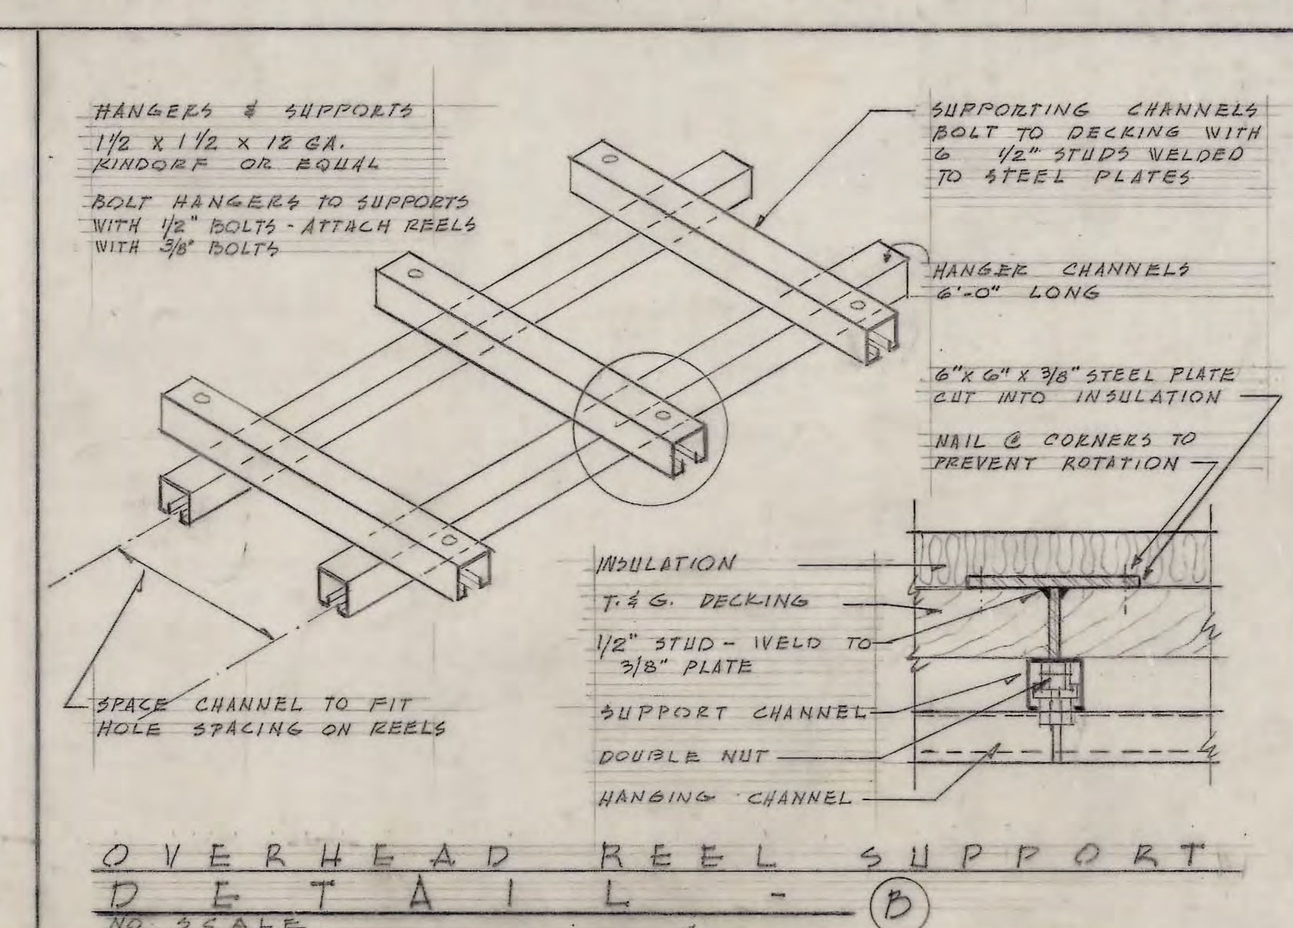

RAINIER BEACH JUNIOR - SENIOR HIGH SCHOOL
AUTOMOTIVE SERVICE LABORATORY

INTERIOR ELEVATIONS AND DETAILS

DATE	SEATTLE SCHOOL DISTRICT No. 1 MAINTENANCE & OPERATIONS WALTER E. LARSEN, DIRECTOR	SHEET
DRAWN BY	810 DEXTER AVENUE NORTH SEATTLE, WASHINGTON	A-5
CHECKED BY T.A.S.		

021-F-0129


SECTION - A-A
SECTION - B-B
SECTION - C-C
TYPICAL WALL SECTIONS
SCALE - 3/4" = 1'-0"
FINISH CEIL'G
3"x6" T.& G. DIAGONAL ROOF DECKING
G W" BEAM
7" x 26" GLU-LAM BEAM
6" x 8" HOLLOW STRUCTURAL TUBE COLUMNS
6" S.C.R. BRICK
#10 GA. STEEL - 1 1/2" DIAMOND MESH WITH 1" CHANNEL FRAME 1 1/2" x 3/4" CHANNEL FRAMES
3/4" PLYWOOD FLOOR
LOFT FLOOR
4"x6" T.& G. DECKING - SECURE WITH 3/4" ϕ BOLTS @ 2'-0" O.C.
STORE RM. CEILING
8 [11.5 CONTINUOUS - WELD @ COLUMNS - SEE STRUCTURAL DRAWINGS
6" S.C.R. BRICK WALL - REINFORCED SEE STRUCTURAL DRAWINGS FOR DETAILS
G.M. METAL FLASHING - NOTCH BRICK
FOR BASE ANCHOR DETAILS SEE STRUCTURAL DRAWINGS
FINISH FLOOR
5 1/2" CONCRETE SLAB
FINISH GRADE
6" GRAVEL FILL WITH POLYETHYLENE VAPOR BARRIER
METAL FASCIA & GUTTER BUILT-UP ROOFING
2"x6" BLOCKING
G W" BEAM
7" x 26" GLU-LAM BEAM SEE STRUCTURAL DRAWINGS FOR CONNECTIONS
3" ϕ DOWNSPOUT
6"x8" STEEL TUBE COLUMN
1/4" PLATE GLASS
8 [8E SILL - PACK SOLID WITH GROUT
2"x8" FASCIA
3"x8" PLATE - ANCHOR WITH 3/4" ϕ BOLTS @ 2'-0" O.C.
BOND BEAM @ DOORWAY
8" CONCRETE BLOCK - SEE STRUCTURAL DRAWINGS REINFORCING & ANCHORING DETAILS - SEE FOUNDATION PLAN FOR FOOTING DETAILS
11 COURSES BLOCK
6" S.C.R. BRICK REINFORCED
G.M. METAL FLASHING - NOTCH BRICK TO REC'V
FOR BASE ANCHOR DETAILS SEE STRUCTURAL DRAWINGS
FINISH FLOOR
FINISH GRADE
VARIES WITH ROOF SLOPE
14'-8 5/8" @ N.W. CORNER - 14'-11 5/8" @ N.E. CORNER
14'-0" @ N.W. CORNER - 14'-5" @ N.E. CORNER
BUILT-UP ROOFING
1" RIGID INSULATION
3"x6" T.& G. DECKING APPLY DIAGONALLY
3/4" x 1 3/8" CONTINUOUS WOOD TRIM
4"x6" WOOD NAILER
3/4" ϕ BOLTS @ 4'-0" O.C.
G W" BEAM
GASKETING
ALUMINUM WINDOW SASH GLAZED WITH LAM. FIREPROOF HETRON RESIN PLASTIC PANELS
RECTANGULAR 6"x8" HOLLOW STEEL STRUCTURAL SECTION USED AS COLUMN SEE STRUCTURAL DETAILS
MAXIMUM LIFT - 9'-4" WIDE x 12'-0" HIGH OVERHEAD GARAGE DOOR ON 2" TRACK - ALUMINUM - MANUALLY OPERATED - WEATHER SEAL - RUBBER HEAD GASKET - "U" SHAPED RUBBER ASTRAGAL @ BOTTOM OF DOOR
6"x4" RECTANGULAR HOLLOW STEEL TUBE HEADER
HEAD
10'-6" GRID
6"x8" STEEL TUBE COLUMN
4"x6" STEEL TUBE JAMB
RUBBER JAMB GASKET - MOUNTED CONTINUOUSLY BETWEEN METAL JAMB & TRACK
MAX. LIFT 1 3/4" PANELED GARAGE DOOR
6" S.C.R. BRICK MOUNT WITH 1"x1" CLIP & CHIP BRICK AS REQ'D
7"x26" GLU-LAM BEAM OVER SEE STRUCTURAL DRAWINGS FOR DETAIL
SIDE JAMB
CENTER JAMB
DETAIL 9 GARAGE DOORS
SCALE - 3" = 1'-0"
BUILT-UP ROOFING
WOOD BLOCKING
1" RIGID INSULATION
3"x6" T.& G. DECKING DIAGONAL
3" ϕ SCH. 40 GALVANIZED DOWNSPOUT - CAULK WELL @ GUTTER
WOOD FACIA CUT FROM 2"x8"
METAL FACIA, GUTTER, CLIPS & EXPANSION JOINT
3/4" ϕ BOLTS @ 4'-0" O.C.
4"x6" NAILER
G W" BEAM
GASKETING BETWEEN W" & ALUM. SASH
HEAD
ALUM. SASH & SILL
8 [8.2 SILL - PACK SOLID WITH GROUT
6" S.C.R. BRICK - SEE STRUCTURAL DETAILS FOR ANCHORING
SILL
DETAIL 10 HIGH WINDOWS
SCALE - 3" = 1'-0"
1 3/4" OVERHEAD GARAGE DOORS
"U" TYPE RUBBER ASTRAGAL
SLOPE CONC. SLAB
THRESHOLD
SCALE 3" = 1'-0"
3/4" x 1 3/8" CONT. WOOD TRIM
6"x8" TUBE COLUMN
CAULK WELL BETWEEN ALUM. CHANNEL & W" BEAM
1"x4" BLOCKING @ 2'-0" O.C.
1"x4" STRIPPING @ 12" O.C. OR 5/8" PLASTER BD.
3/4 ACOUSTICAL TILE
ALUMINUM CHANNEL 4" x 6 1/4" x 1/8" - FASTEN WITH 3/16" F.H.M. METAL SCREWS
HEAD & JAMB
LAMINATED PLASTIC FILLER PANELS
VERT. MULLION
NOTE: ALL EXTERIOR GLASS TO BE 1/4" PLATE
HORIZ. MULLION TYPICAL
FILLER PANEL: LAMINATED FIREPROOF HETRON RESIN PLASTIC PANELS - CONST. AS FOLLOWS - 1/8" PLASTIC - 1/2" WATERPROOF PLYWOOD - 1/8" PLASTIC - COLOR BY ARCH.
2"x5"x1/8" ALUM. SILL - CLAMPS BY WINDOW MFG.
ALUM. SILL - CONT. CAULK WELL @ LIP
SILL
14'-0" @ S.W. CORNER - 14'-5" @ S.E. CORNER
DETAIL 11 LOW WINDOWS
SCALE 3" = 1'-0"
S.C.R. BRICK
6"x8" STEEL TUBE COLUMNS
BLOCKING AS REQUIRED DRILL & TAP TUBE FOR 3/8" ANCHOR BOLT @ 2'-0"
8" V-GROOVE CONC. BLOCK
1/2" BIRCH FACE PIECE
1 3/4" DOOR - STAIN WALNUT
CRYSTAL GLASS
2"x6" FRAMING
SPACE FOR ELECT. WIRING
1/2" G.P.X. BOARD PLASTIC BOTH SIDES
G.P.X. BOARD 1/2" PLASTIC BOTH SIDES
GLU-LAM BEAM
GLASS
4" RUBBER BASE CONC. FL.
4" RUBBER BASE - VINYL ASBESTOS FLOOR
BLOCKING AS REQ'D
2"x6"
12'-1" TO FLOOR
NOTE: ALL TRIM PIECES TO BE 1/2" BIRCH - FINISH - STAIN WALNUT. G.P.X. PANELS TO BE PAINTED - COLOR TO BE SELECTED BY ARCHITECT
INTERIOR RE-LIGHT PARTITIONS
SCALE 1 1/2" = 1'-0"
2"x6" STEEL TUBE JAMB - WELD TO 6"x8" COLUMN
1/2" x 2 1/2" METAL STOP - WELD TO JAMB
HOLLOW METAL DOOR
JAMB @ COLUMN
4"x2"x1/4" STEEL BASE PLATE - WELD TO BASE OF 2"x6" TUBE JAMB (CAP INSIDE FACE OF TUBE SO PLATE CAN SET INSIDE) 3/4" ANCHOR BOLT - IMBED 1'-0" @ CENTER OF PLATE TO ANCHOR @ SILL. CUT HOLE IN JAMB @ SILL TO TIGHTEN BOLT
2"x6" STEEL TUBE HEAD & JAMB WITH 1/2" x 2 1/2" STOP
HEAD & JAMB 12
EXTERIOR DOORS
SCALE 3" = 1'-0"
GROUT
CORRUGATED ANCHORS 3 PER JAMB
HEAD & JAMB 13
VINYL-ASBESTOS FL.
MANHATTEN METAL DIVIDER STRIP
FINISH CONC FLOOR
THRESHOLD 14
SLIDING HOLLOW METAL DOOR MOUNT HASP FOR PADLOCK ON SIDE OF JAMB
CORRUGATED ANCHORS 3 PER JAMB
GROUT
8" V-GROOVE CONC. BLOCK
HEAD & JAMB - ROOM - 06 15
BIRCH STOPS GLASS SET IN MASTIC
DETAIL 16 WINDOW
INTERIOR DOORS
SCALE 3" = 1'-0"
RAINIER BEACH JUNIOR - SENIOR HIGH SCHOOL
AUTOMOTIVE SERVICE LABORATORY ADDITION
8815 SEWARD PARK AVE. SO.
TYPICAL WALL SECTIONS, DOOR AND WINDOW DETAILS
DATE DEC. 1, 1967
DRAWN BY E. PETERSON
CHECKED BY T.A.S.
SEATTLE SCHOOL DISTRICT No. 1
MAINTENANCE & OPERATIONS
WALTER E. LARSEN, DIRECTOR
810 DEXTER AVENUE NORTH
SEATTLE, WASHINGTON
SHEET A-4
021-F-0128
KEUFFEL & ESSER CO.

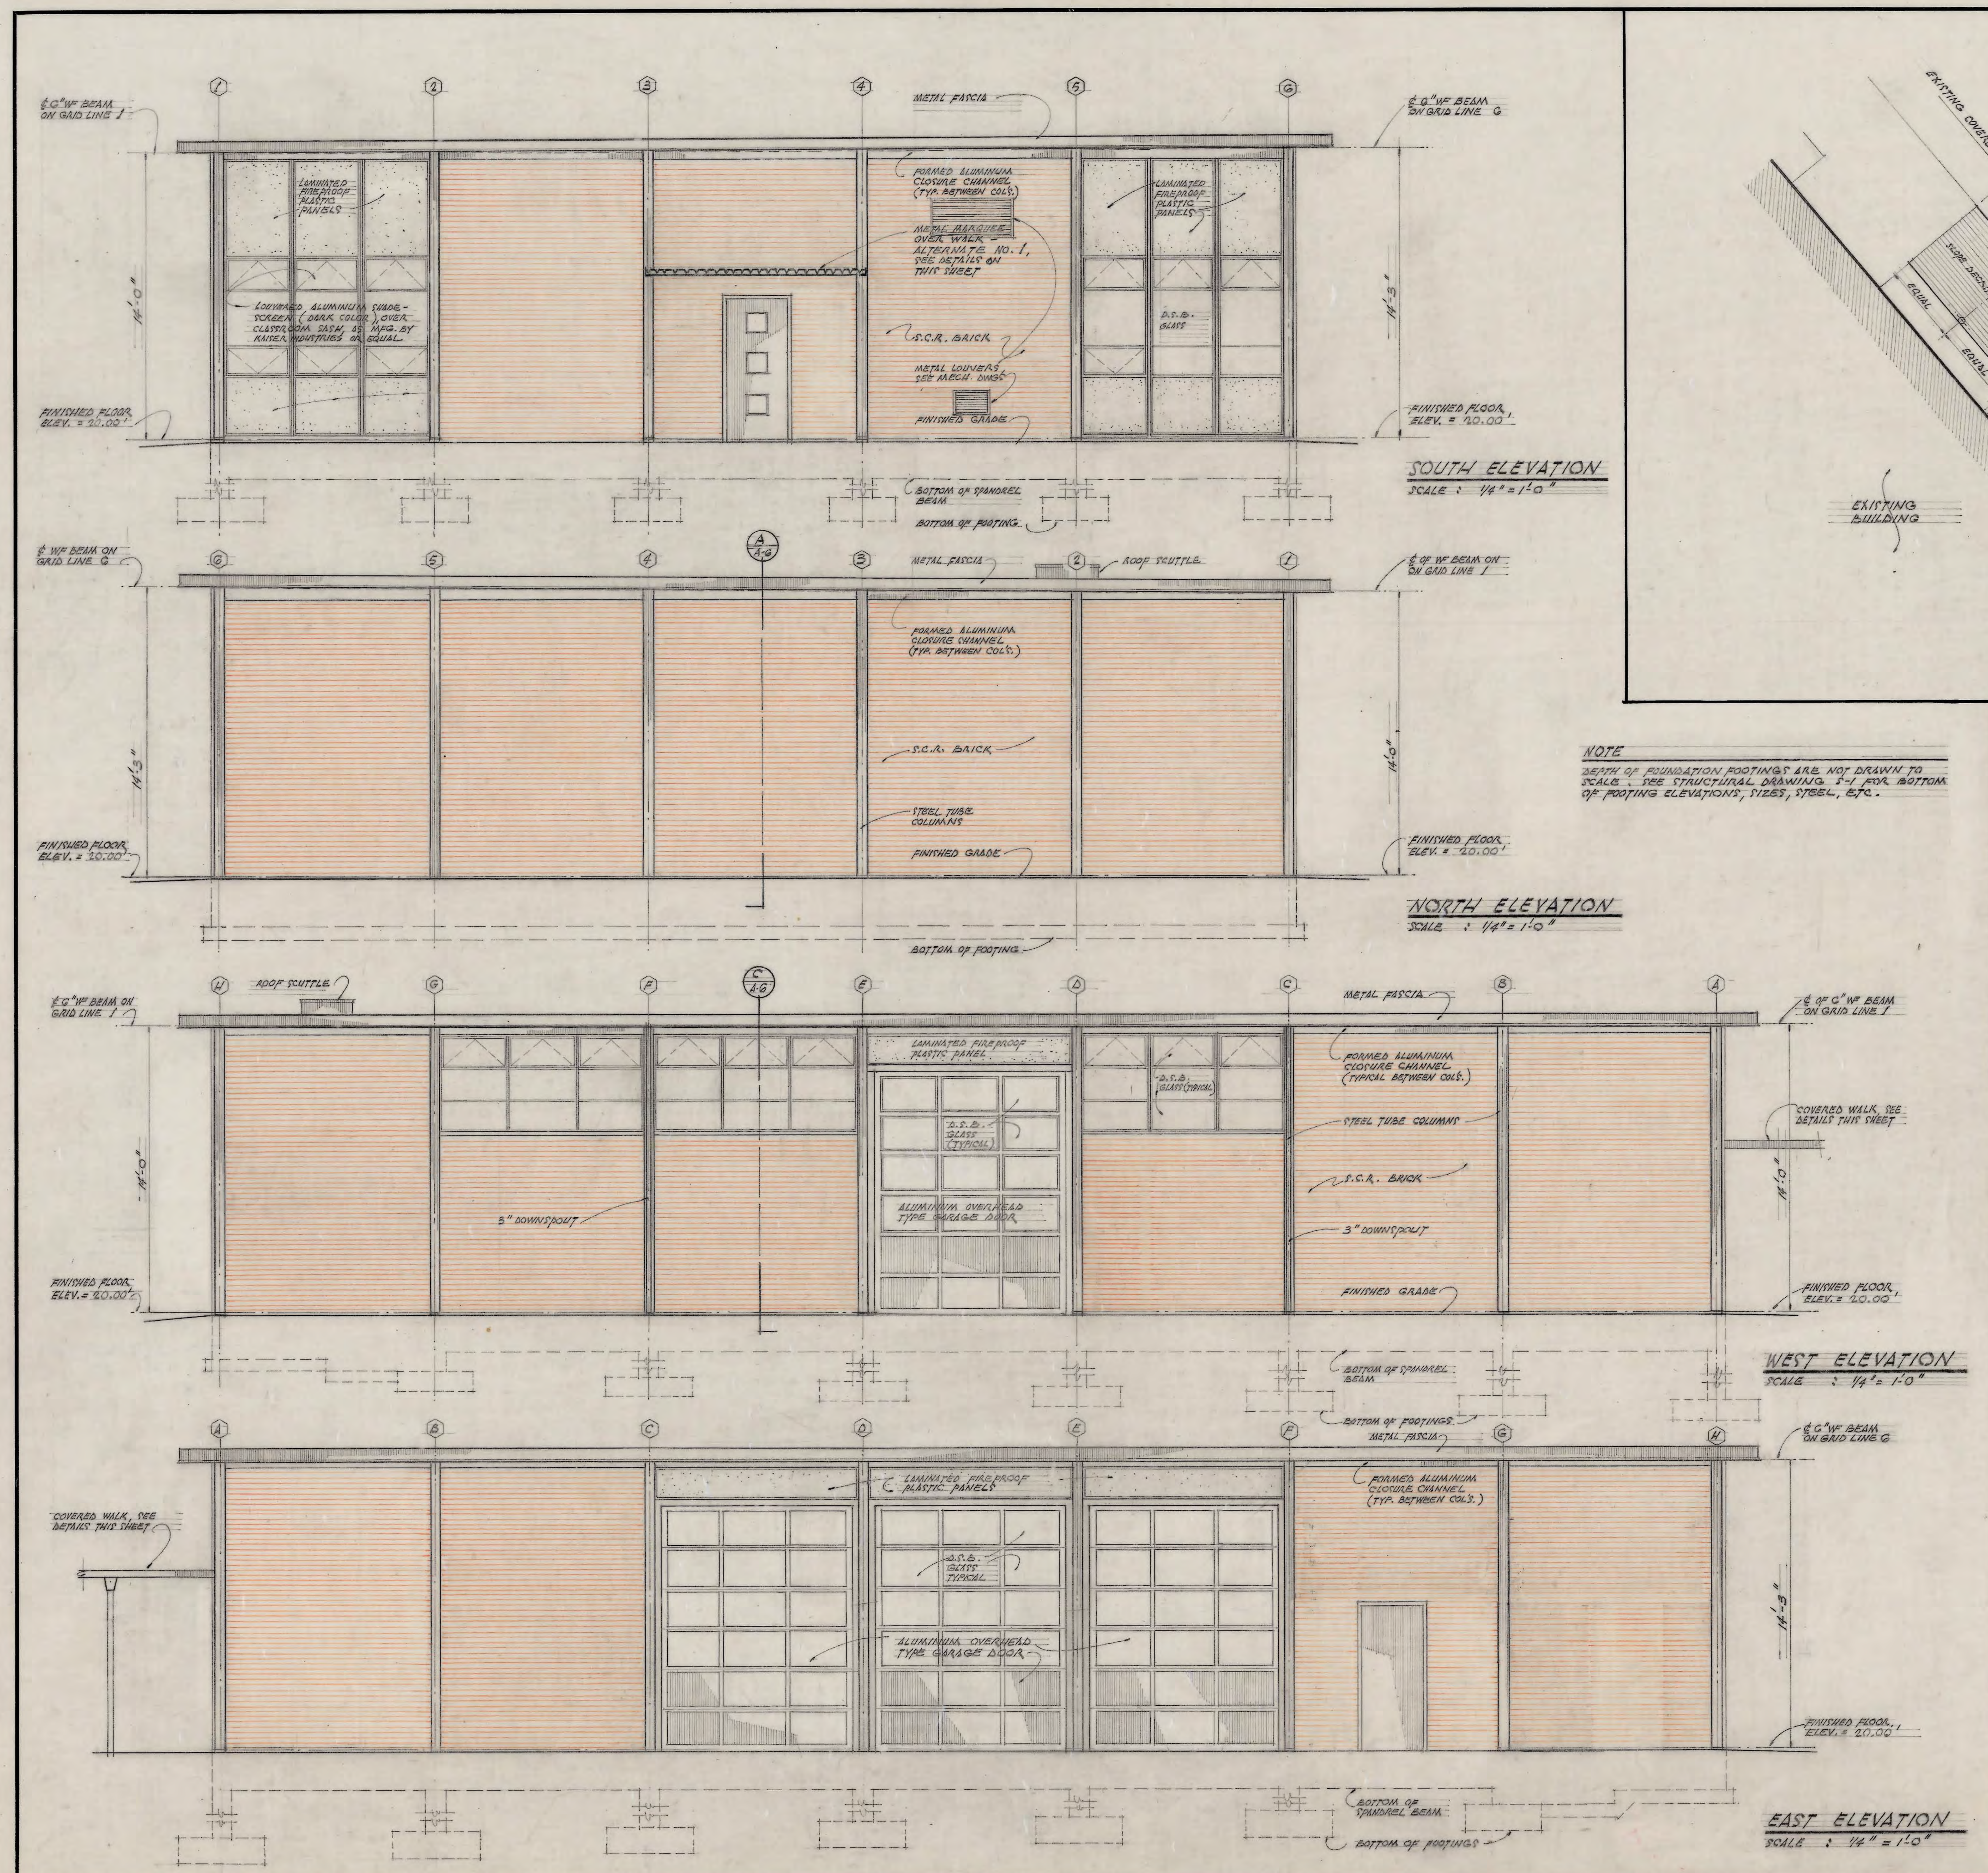

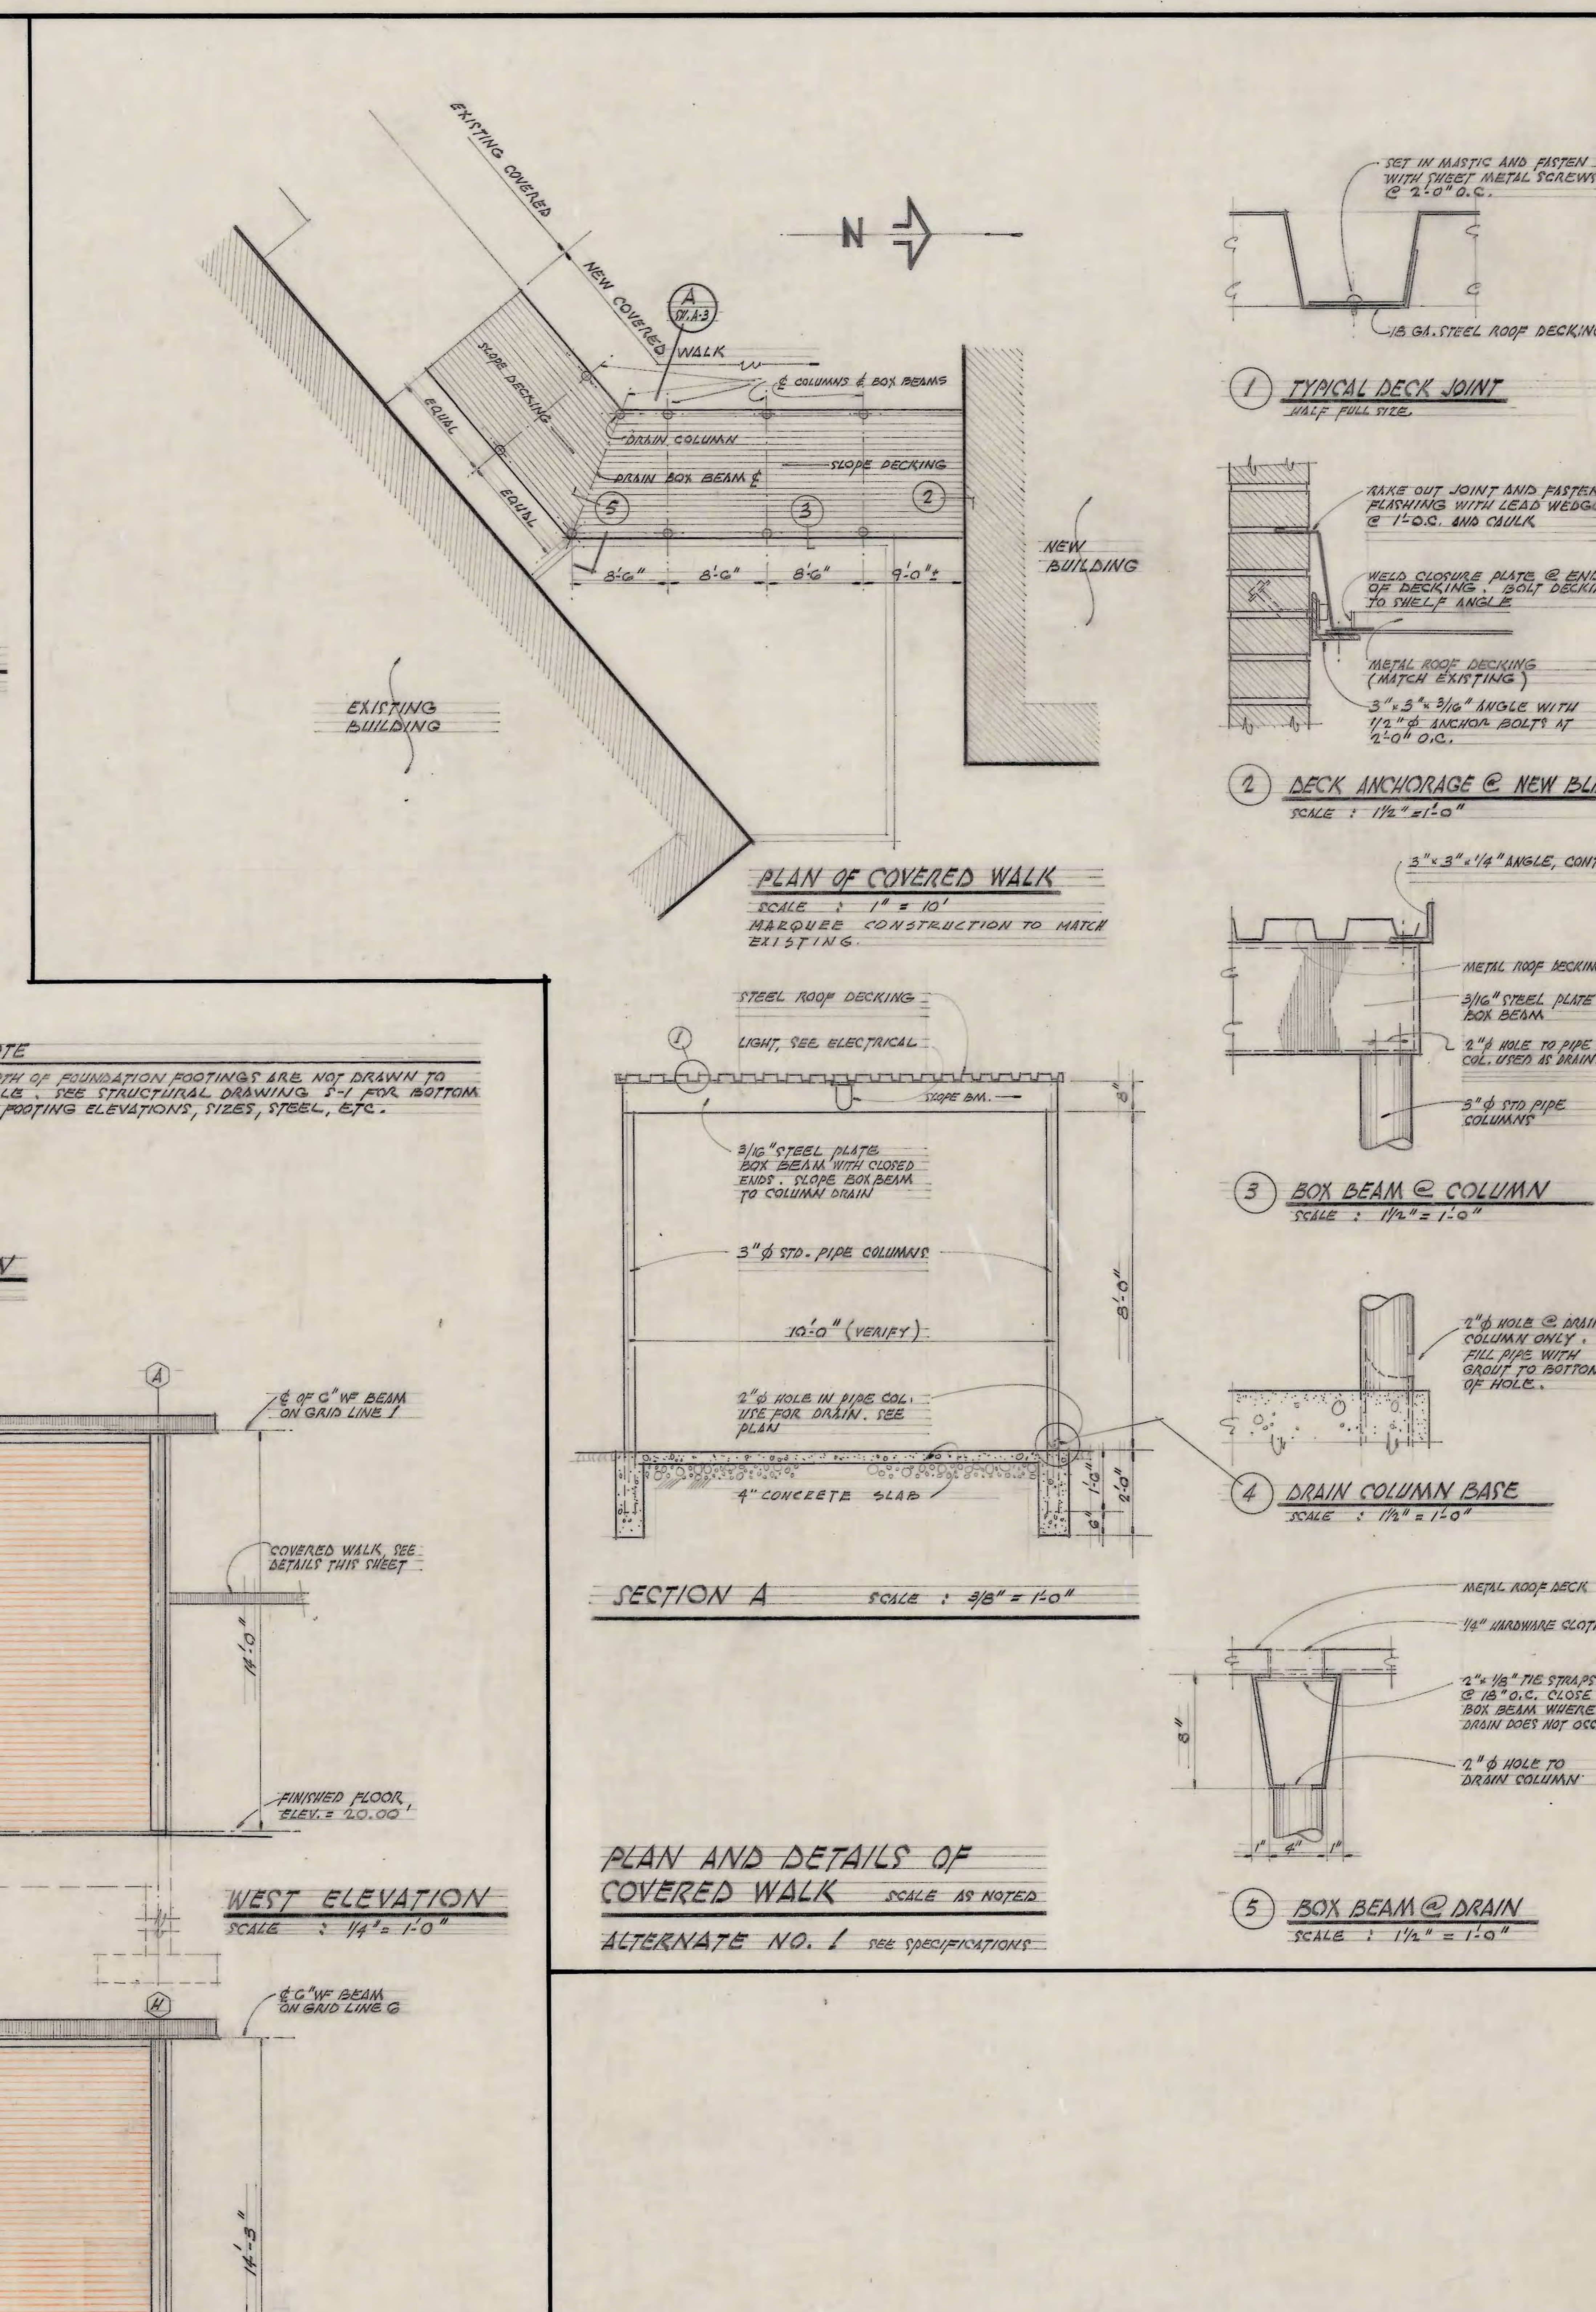

RAINIER BEACH JUNIOR-SENIOR HIGH SCHOOL
AUTOMOTIVE SERVICE LABORATORY ADDITION
8815 SEWARD PARK AVE. SO.

EXTERIOR ELEVATIONS AND
COVERED WALK DETAILS

DATE DEC. 1, 1967	SEATTLE SCHOOL DISTRICT No. 1 MAINTENANCE & OPERATIONS WALTER E. LARSEN, DIRECTOR 810 DEXTER AVENUE NORTH SEATTLE, WASHINGTON
DRAWN BY E. PETERSON E. TAZIOLI	
CHECKED BY TAS	

SH
A

021-F-0127

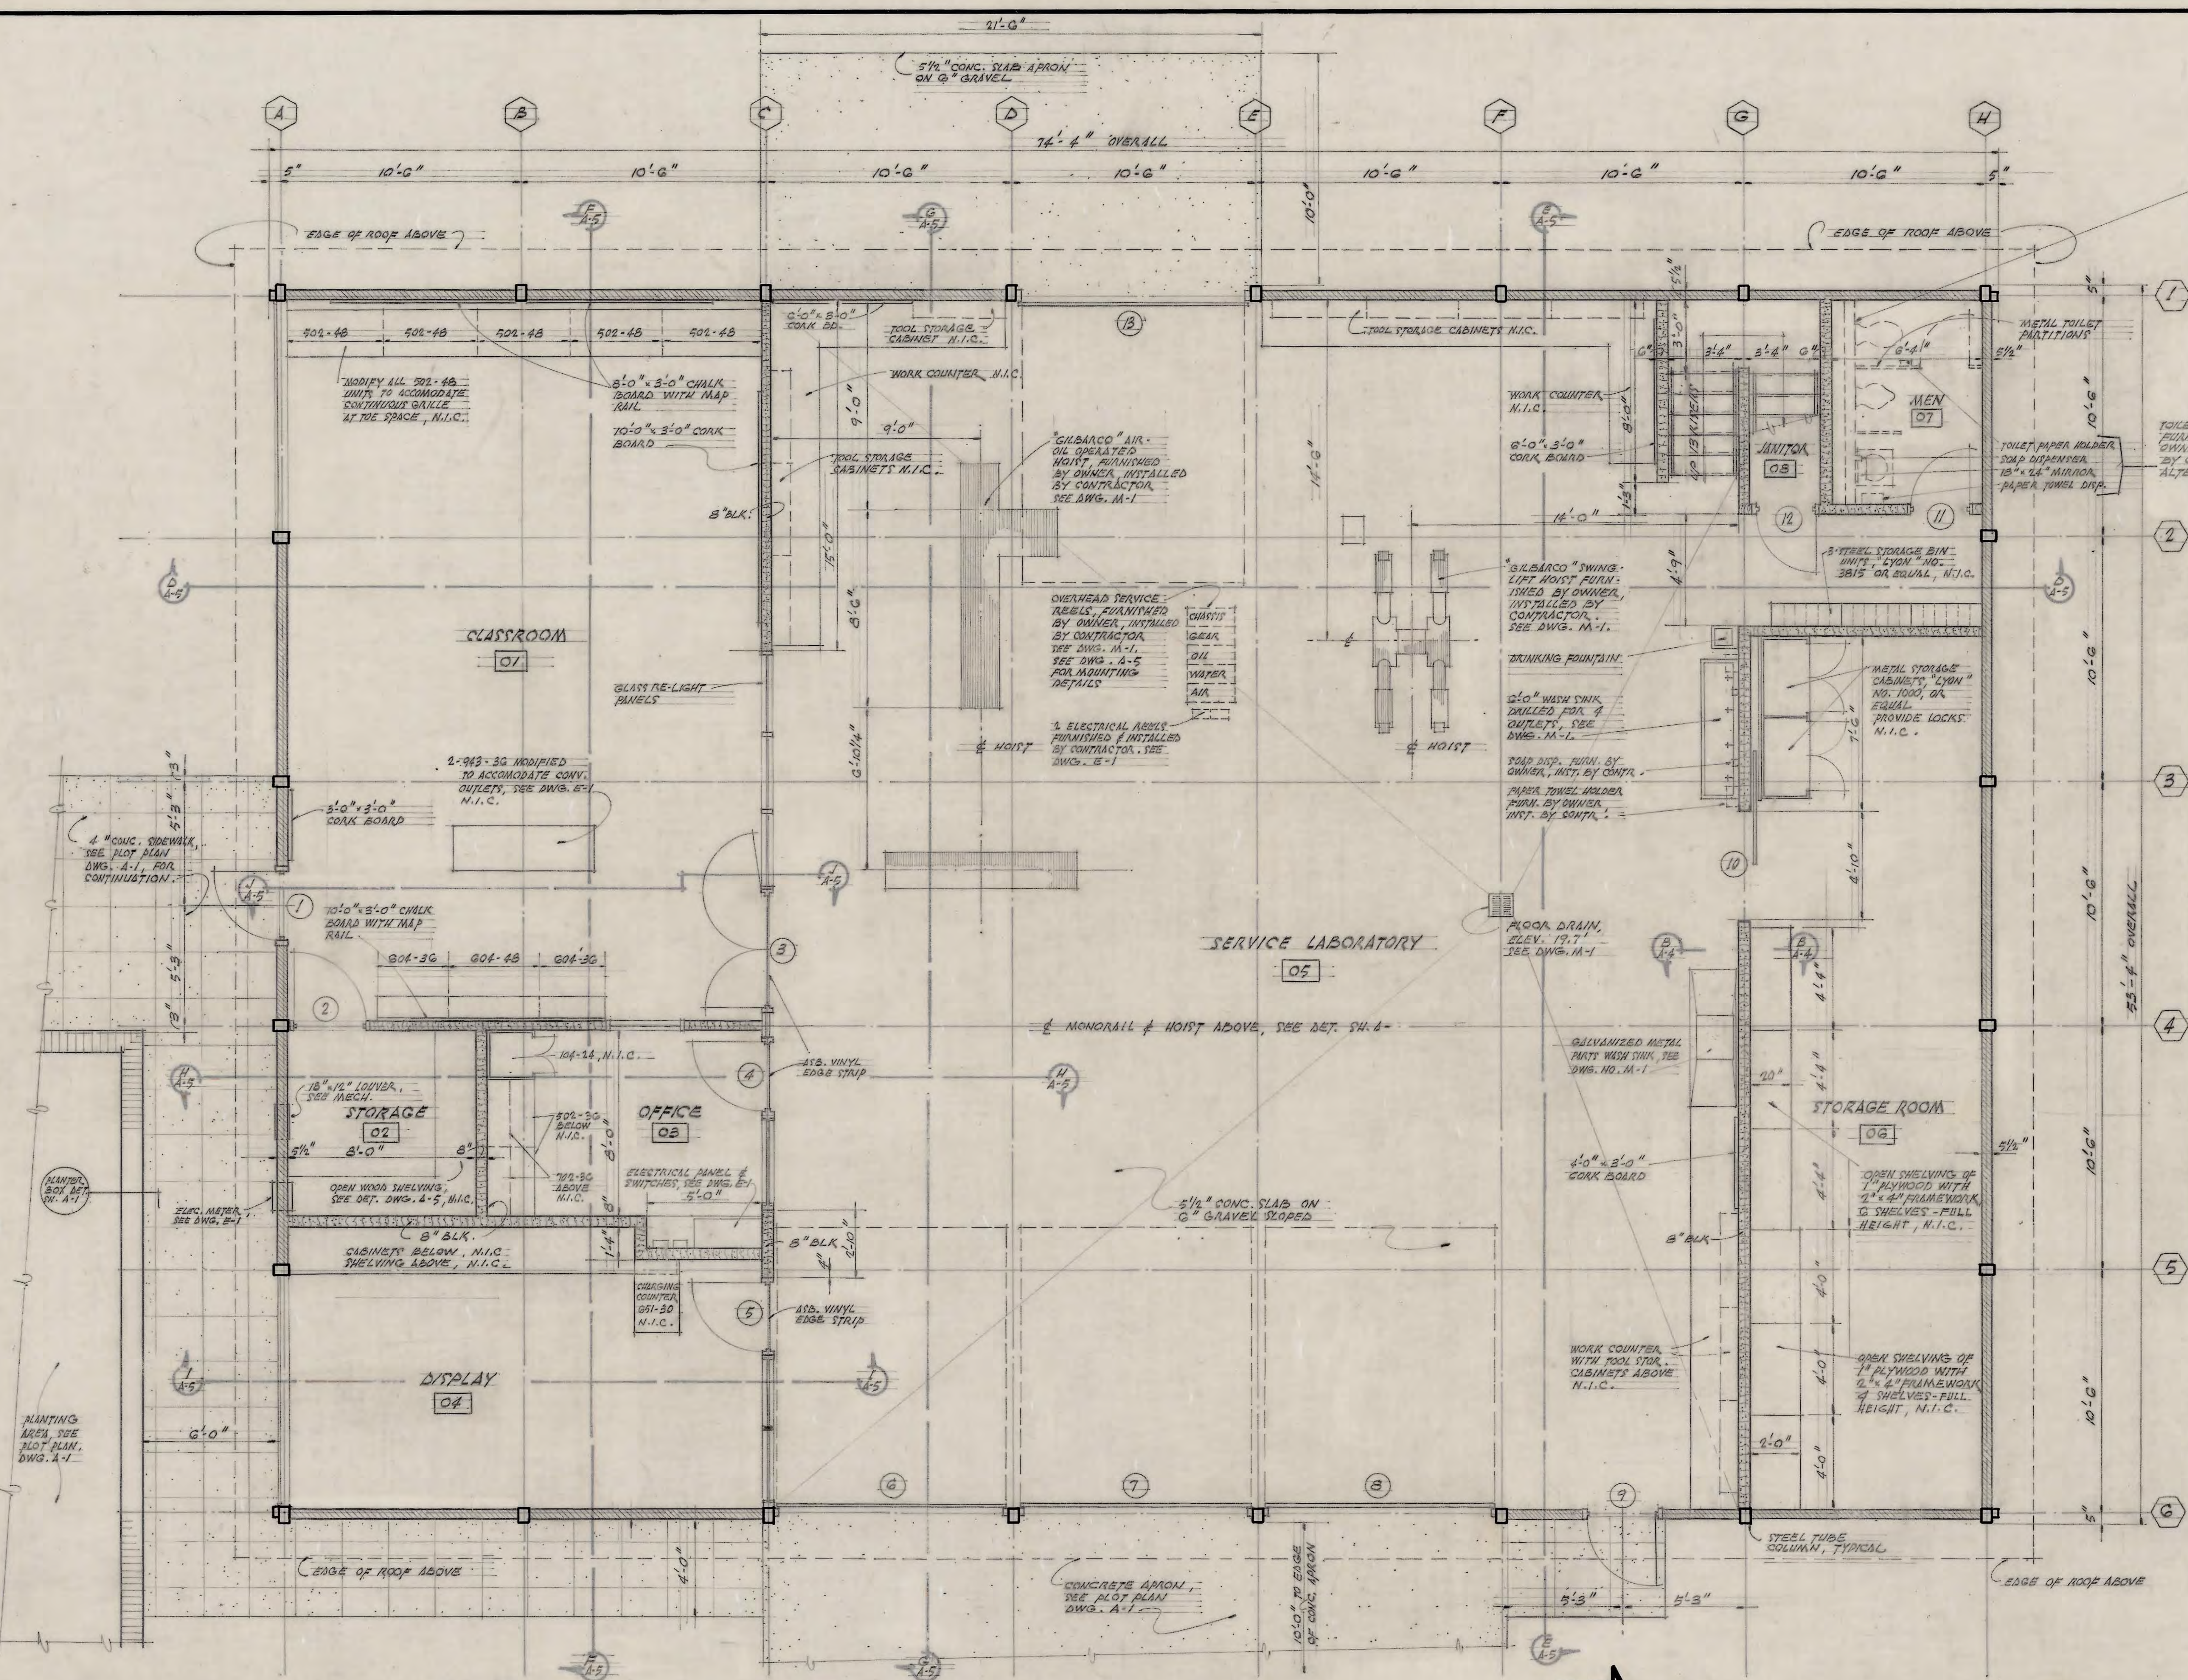

FLOOR PLAN SCALE : 1/4" = 1'-0"

N ⇨

NOTE :
DOTTED LINES IN ROOMS 07 & 10 INDICATE WALLS AND FIXTURES TO BE INSTALLED UNDER ALTERNATE NO. 3. ASB. VINYL FLOOR, RUBBER BASE, & PAINTING OF THESE ROOMS AS CALLED FOR IN FINISH SCHEDULE SHALL BE INCLUDED IN ALTERNATE NO. 3. DOORS NO. 11 & 14 SHALL BE INCLUDED IN BASIC BID.

AUTOMOTIVE EQUIPMENT SCHEDULE			
ITEM	MFG. OR DEALER	FURN. BY :	INST. BY :
AIR-OIL OPERATED 2 POST HOIST	GILBERT-BARKER MFG. CO. W. SPRINGFIELD, MASS.	OWNER	CONTR.
SWING RAIL LIFT	GILBERT-BARKER MFG. CO. W. SPRINGFIELD, MASS.	OWNER	CONTR.
AIR COMPRESSOR 80 GAL., 5 H.P.	GILBERT-BARKER MFG. CO. W. SPRINGFIELD, MASS.	OWNER	CONTR.
CHASSIS REEL WITH CONNECTING HOSES & METER	ALEMITE CO. SEATTLE, WN.	OWNER	CONTR.
GEAR REEL WITH CONNECTING HOSES & METER	ALEMITE CO. SEATTLE, WASH.	OWNER	CONTR.
OIL REEL WITH CONNECTING HOSES & METER	ALEMITE CO. SEATTLE, WASH.	OWNER	CONTR.
AIR REEL WITH HOSES & GAUGE	ALEMITE CO. SEATTLE, WN.	OWNER	CONTR.
WATER REEL WITH HOSE AND VALVE	ALEMITE CO. SEATTLE, WN.	OWNER	CONTR.
2 - ELECTRICAL REELS		CONTR.	CONTR.
50 TO 1 RATIO PUMP	ALEMITE CO. SEATTLE, WN.	OWNER	CONTR.
4 TO 1 RATIO PUMP	ALEMITE CO. SEATTLE, WASH.	OWNER	CONTR.
4 TO 1 RATIO PUMP	ALEMITE CO. SEATTLE, WN.	OWNER	CONTR.

NOTES :

1.) ALL INTERIOR WALLS ARE CENTERED ON GRID LINES UNLESS DIMENSIONED OTHERWISE.

2.) CABINET WORK NUMBERS SHOWN ON PLAN ARE CATALOG NUMBERS OF EDUCATORS MFG. CO. OF TACOMA, WN. CABINETS REQ'D ARE NOT RESTRICTED TO THAT MFG. SEE SPECIFICATIONS.

3.) STAIR CONSTRUCTION AS FOLLOWS :
TREADS : CUT FROM 2" x 12"
RISER : 3/4" PLYWOOD
STRINGERS : 2" x 10" (
PROVIDE RUBBER TREAD AND NOSING.

4.) ALL CABINETS, SHELVING, AND WORK COUNTERS SHOWN ON DRAWINGS ARE NOT A PART OF THIS CONTRACT.

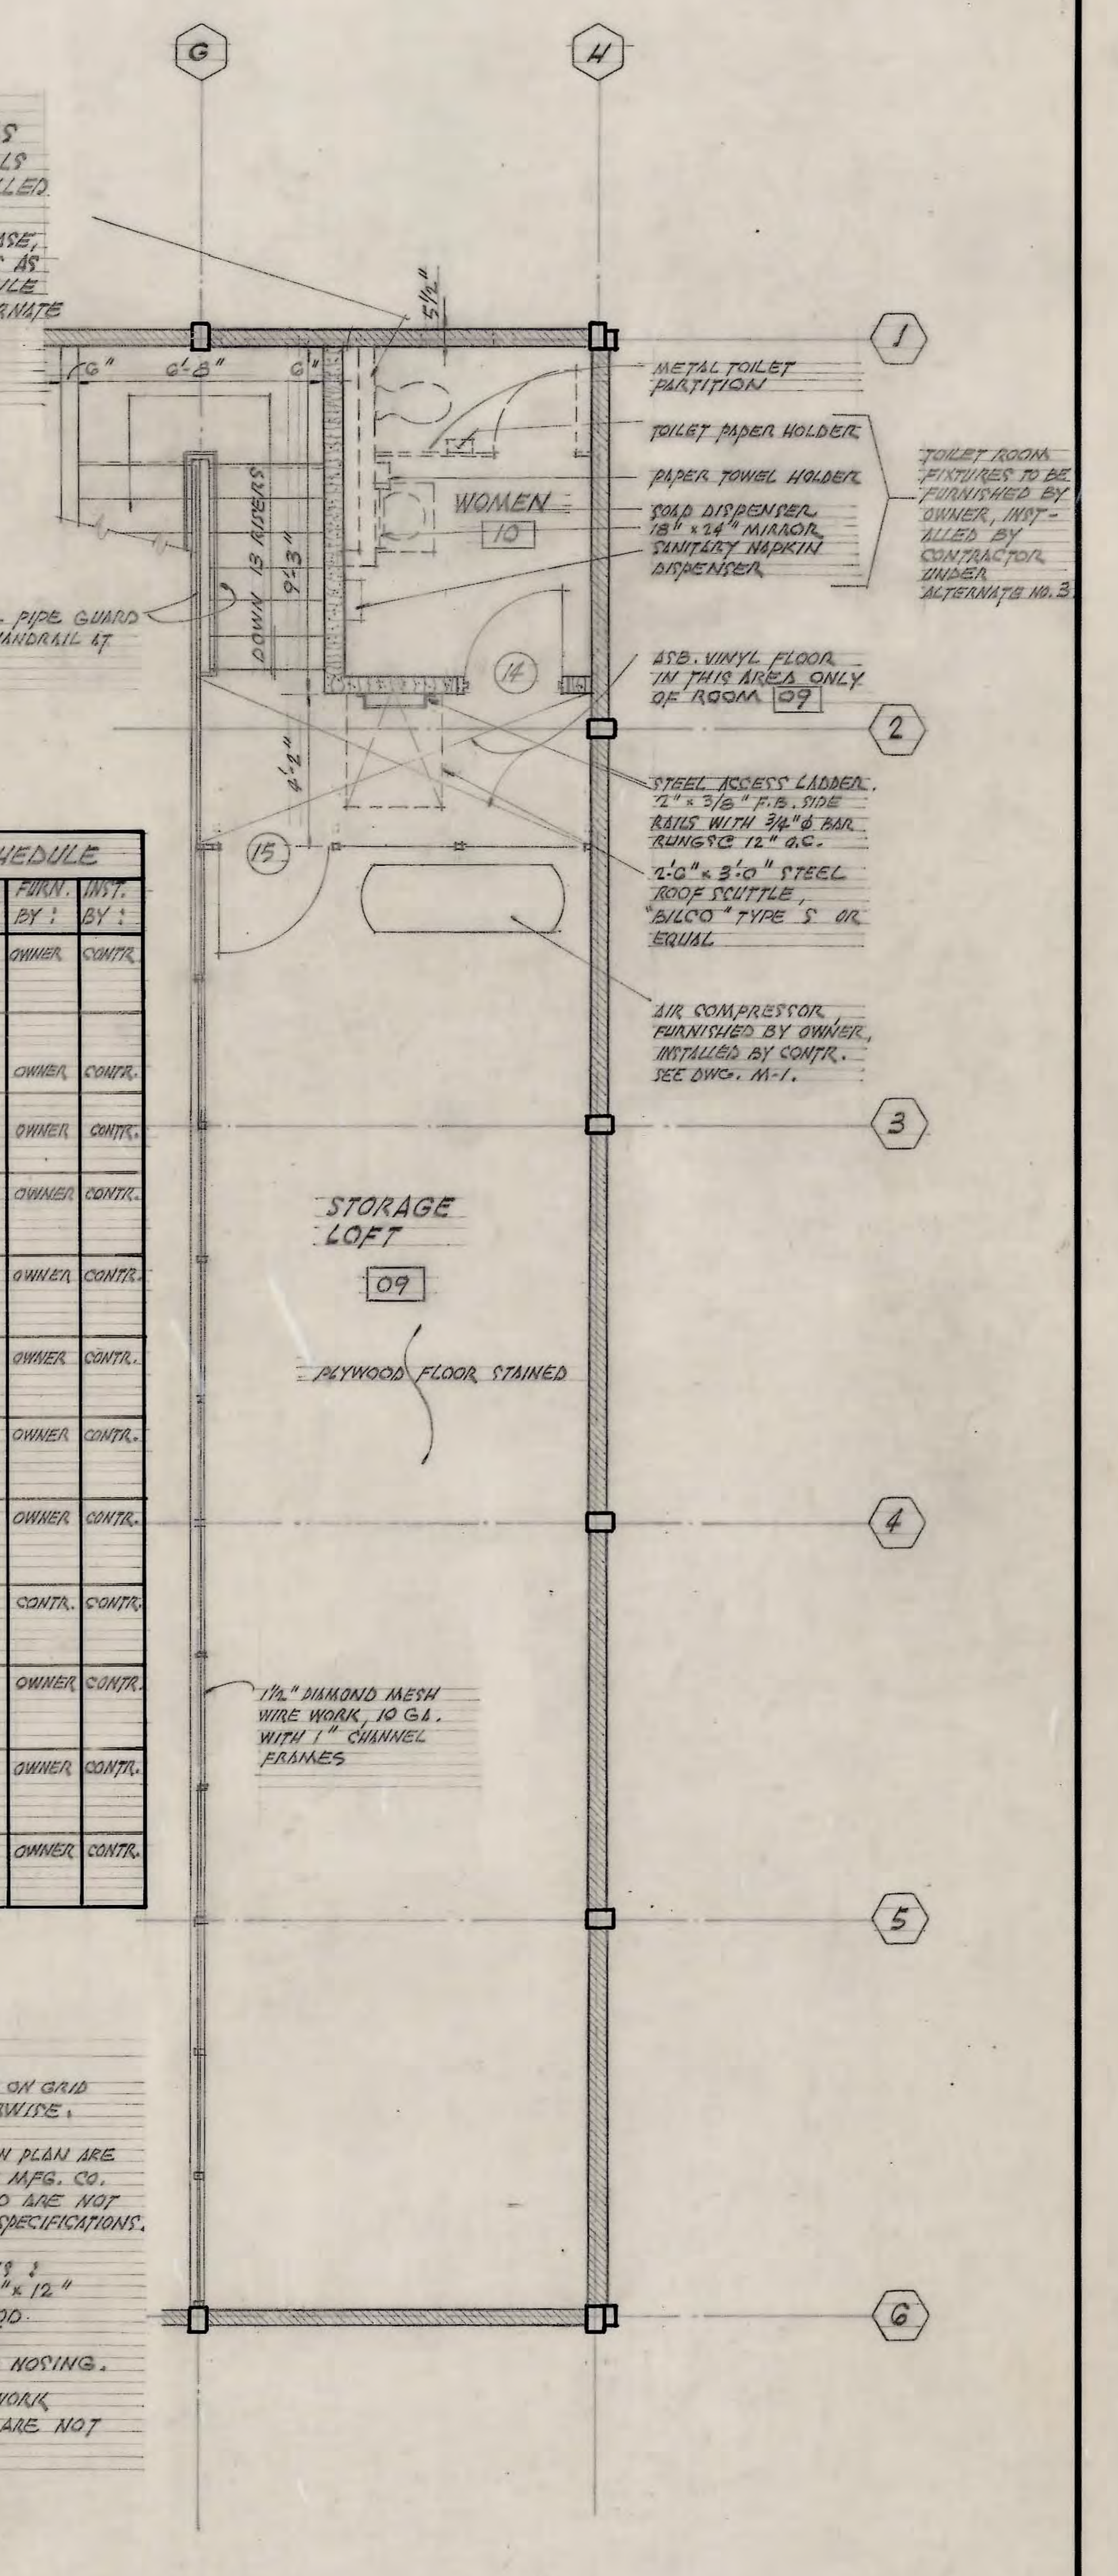

STORAGE LOFT PLAN SCALE : 1/4" = 1'-0"

ROOM FINISH SCHEDULE

NO.	ROOM	WALLS MATERIAL	WALLS FIN.	FLOOR MATERIAL	FLOOR FIN.	BASE MATERIAL	BASE FIN.	CEILING MATERIAL	CEILING FIN.	CLG. HGHT.	REMARKS
01	CLASSROOM	CONC. BLK. WOOD	P. ST.	ASB. VINYL.	F.F.	4" RUBBER	F.F.	AC. T.	F.F.	14'-0" ±	
02	STORAGE	CONC. BLK.	P.	ASB. VINYL	F.F.	4" RUBBER	F.F.	WOOD	P.	14'-0" ±	
03	OFFICE	CONC. BLK. WOOD	P. ST. & V.	ASB. VINYL	F.F.	4" RUBBER	F.F.	AC. T.	F.F.	8'-0"	
04	DISPLAY	CONC. BLK. WOOD	P. ST. & V.	ASB. VINYL	F.F.	4" RUBBER	F.F.	AC. T.	F.F.	14'-0" ±	
05	SERVICE LABORATORY	CONC. BLK. WOOD S.C.R. BRICK	P. ST. & V. —	CONC.	—	—	—	WOOD	P.	14'-0" ±	
06	STORAGE	CONC. BLK. S.C.R. BRICK	P. —	CONC.	—	—	—	WOOD	P.	7'-6"	
07	TOILET, MEN	CONC. BLK. S.C.R. BRICK	P. —	CONC.	—	4" RUBBER	F.F.	1/2" PLAS. BD.	P.	7'-6"	
08	JANITOR	CONC. BLK.	P.	CONC.	—	—	—	WOOD	P.	7'-6"	
09	STORAGE LOFT	S.C.R. BRICK CONC. BLK.	— P.	3/4" PLYWOOD * ASB. VINYL.	— F.F.	—	—	WOOD	P.	6'-10" ±	* ASB. VINYL FLOOR AT WEST END, SEE PLAN.
10	TOILET, WOMEN	S.C.R. BRICK CONC. BLK.	— P.	* ASB. VINYL	—	4 RUBBER	F.F.	1/2" PLAS. BD.	P.	6'-9" ±	* ON 3/4" PLYWOOD

ABBREVIATIONS

CONC. BLK.	CONCRETE BLOCK
ASB.	ASBESTOS
CONC.	CONCRETE
PLAS. BD.	PLASTER BOARD
MET.	METAL
H.C.	HOLLOW CORE
S.C.	SOLID CORE
N.I.C.	NOT IN CONTRACT

DOOR TYPES

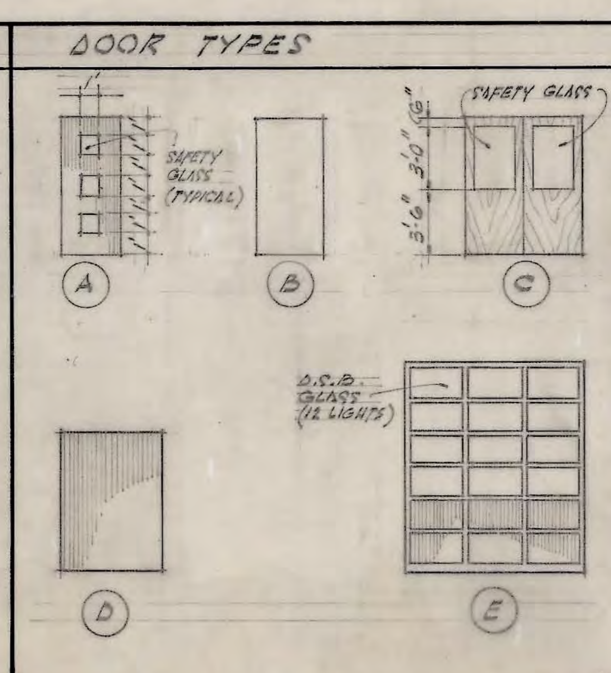

DOOR SCHEDULE

NO.	TYPE	SIZE	MATERIAL	FRAME HEAD	FRAME JAMB	FRAME THRES.	HARDWARE	GLASS	REMARKS
1	A	3'-0" x 7'-0" x 1 3/4"	HOLLOW METAL	MET.	MET.	MET.	SEE SPECIFICATIONS	3 LIGHT	KICKPLATE
2	B	3'-0" x 7'-0" x 1 3/4"	BIRCH, H.C.	MET.	MET.	MET.	SEE SPECIFICATIONS	—	KICKPLATE
3	C	PAIR, 2'-6" x 7'-0" x 1 3/4"	BIRCH, S.C.	WOOD	WOOD	WOOD	SEE SPECIFICATIONS	1 LIGHT EACH	KICKPLATES,
4	B	3'-0" x 7'-0" x 1 3/4"	BIRCH, S.C.	WOOD	WOOD	WOOD	SEE SPECIFICATIONS	—	KICKPLATE
5	B	3'-0" x 7'-0" x 1 3/4"	BIRCH, S.C.	WOOD	WOOD	WOOD	SEE SPECIFICATIONS	—	KICKPLATE
6	E	10'-0" x 12'-0"	ALUMINUM	STEEL	STEEL	STEEL	OVERHEAD	12 LIGHTS	SEE SPECIFICATIONS
7	E	10'-0" x 12'-0"	ALUMINUM	STEEL	STEEL	STEEL	OVERHEAD	12 LIGHTS	SEE SPECIFICATIONS
8	E	10'-0" x 12'-0"	ALUMINUM	MET.	MET.	MET.	OVERHEAD	12 LIGHTS	SEE SPECIFICATIONS
9	B	3'-0" x 7'-0" x 1 3/4"	HOLLOW METAL	MET.	MET.	MET.	SEE SPECIFICATIONS	—	KICKPLATE
10	D	5'-0" x 7'-0" x 1 3/4"	HOLLOW METAL	MET.	MET.	MET.	SLIDING DOOR	—	UNDERCUT 3/4"
11	B	2'-6" x 7'-0" x 1 3/4"	BIRCH, H.C.	MET.	MET.	MET.	SEE SPECIFICATIONS	—	UNDERCUT 1/2"
12	B	2'-6" x 7'-0" x 1 3/4"	BIRCH, H.C.	MET.	MET.	MET.	SEE SPECIFICATIONS	—	
13	E	10'-0" x 12'-0"	ALUMINUM	MET.	MET.	MET.	OVERHEAD	12 LIGHTS	
14	B	2'-6" x 6'-0" x 1 3/4"	BIRCH, H.C.	MET.	MET.	MET.	SEE SPECIFICATIONS	—	UNDERCUT 1/2"
15	WIRE GATE								

RAINIER BEACH JUNIOR-SENIOR HIGH SCHOOL
AUTOMOTIVE SERVICE LABORATORY ADDITION
8815 SEWARD PARK AVE SOUTH

FLOOR PLAN, STORAGE LOFT PLAN, ROOM FINISH SCHEDULE, DOOR SCHEDULE

DATE DEC. 1, 1967
DRAWN BY E. TAZIOLI
CHECKED BY TAS

SEATTLE SCHOOL DISTRICT No. 1
MAINTENANCE & OPERATIONS
WALTER E. LARSEN, DIRECTOR
810 DEXTER AVENUE NORTH
SEATTLE, WASHINGTON

SHEET A-2

021-F-0126

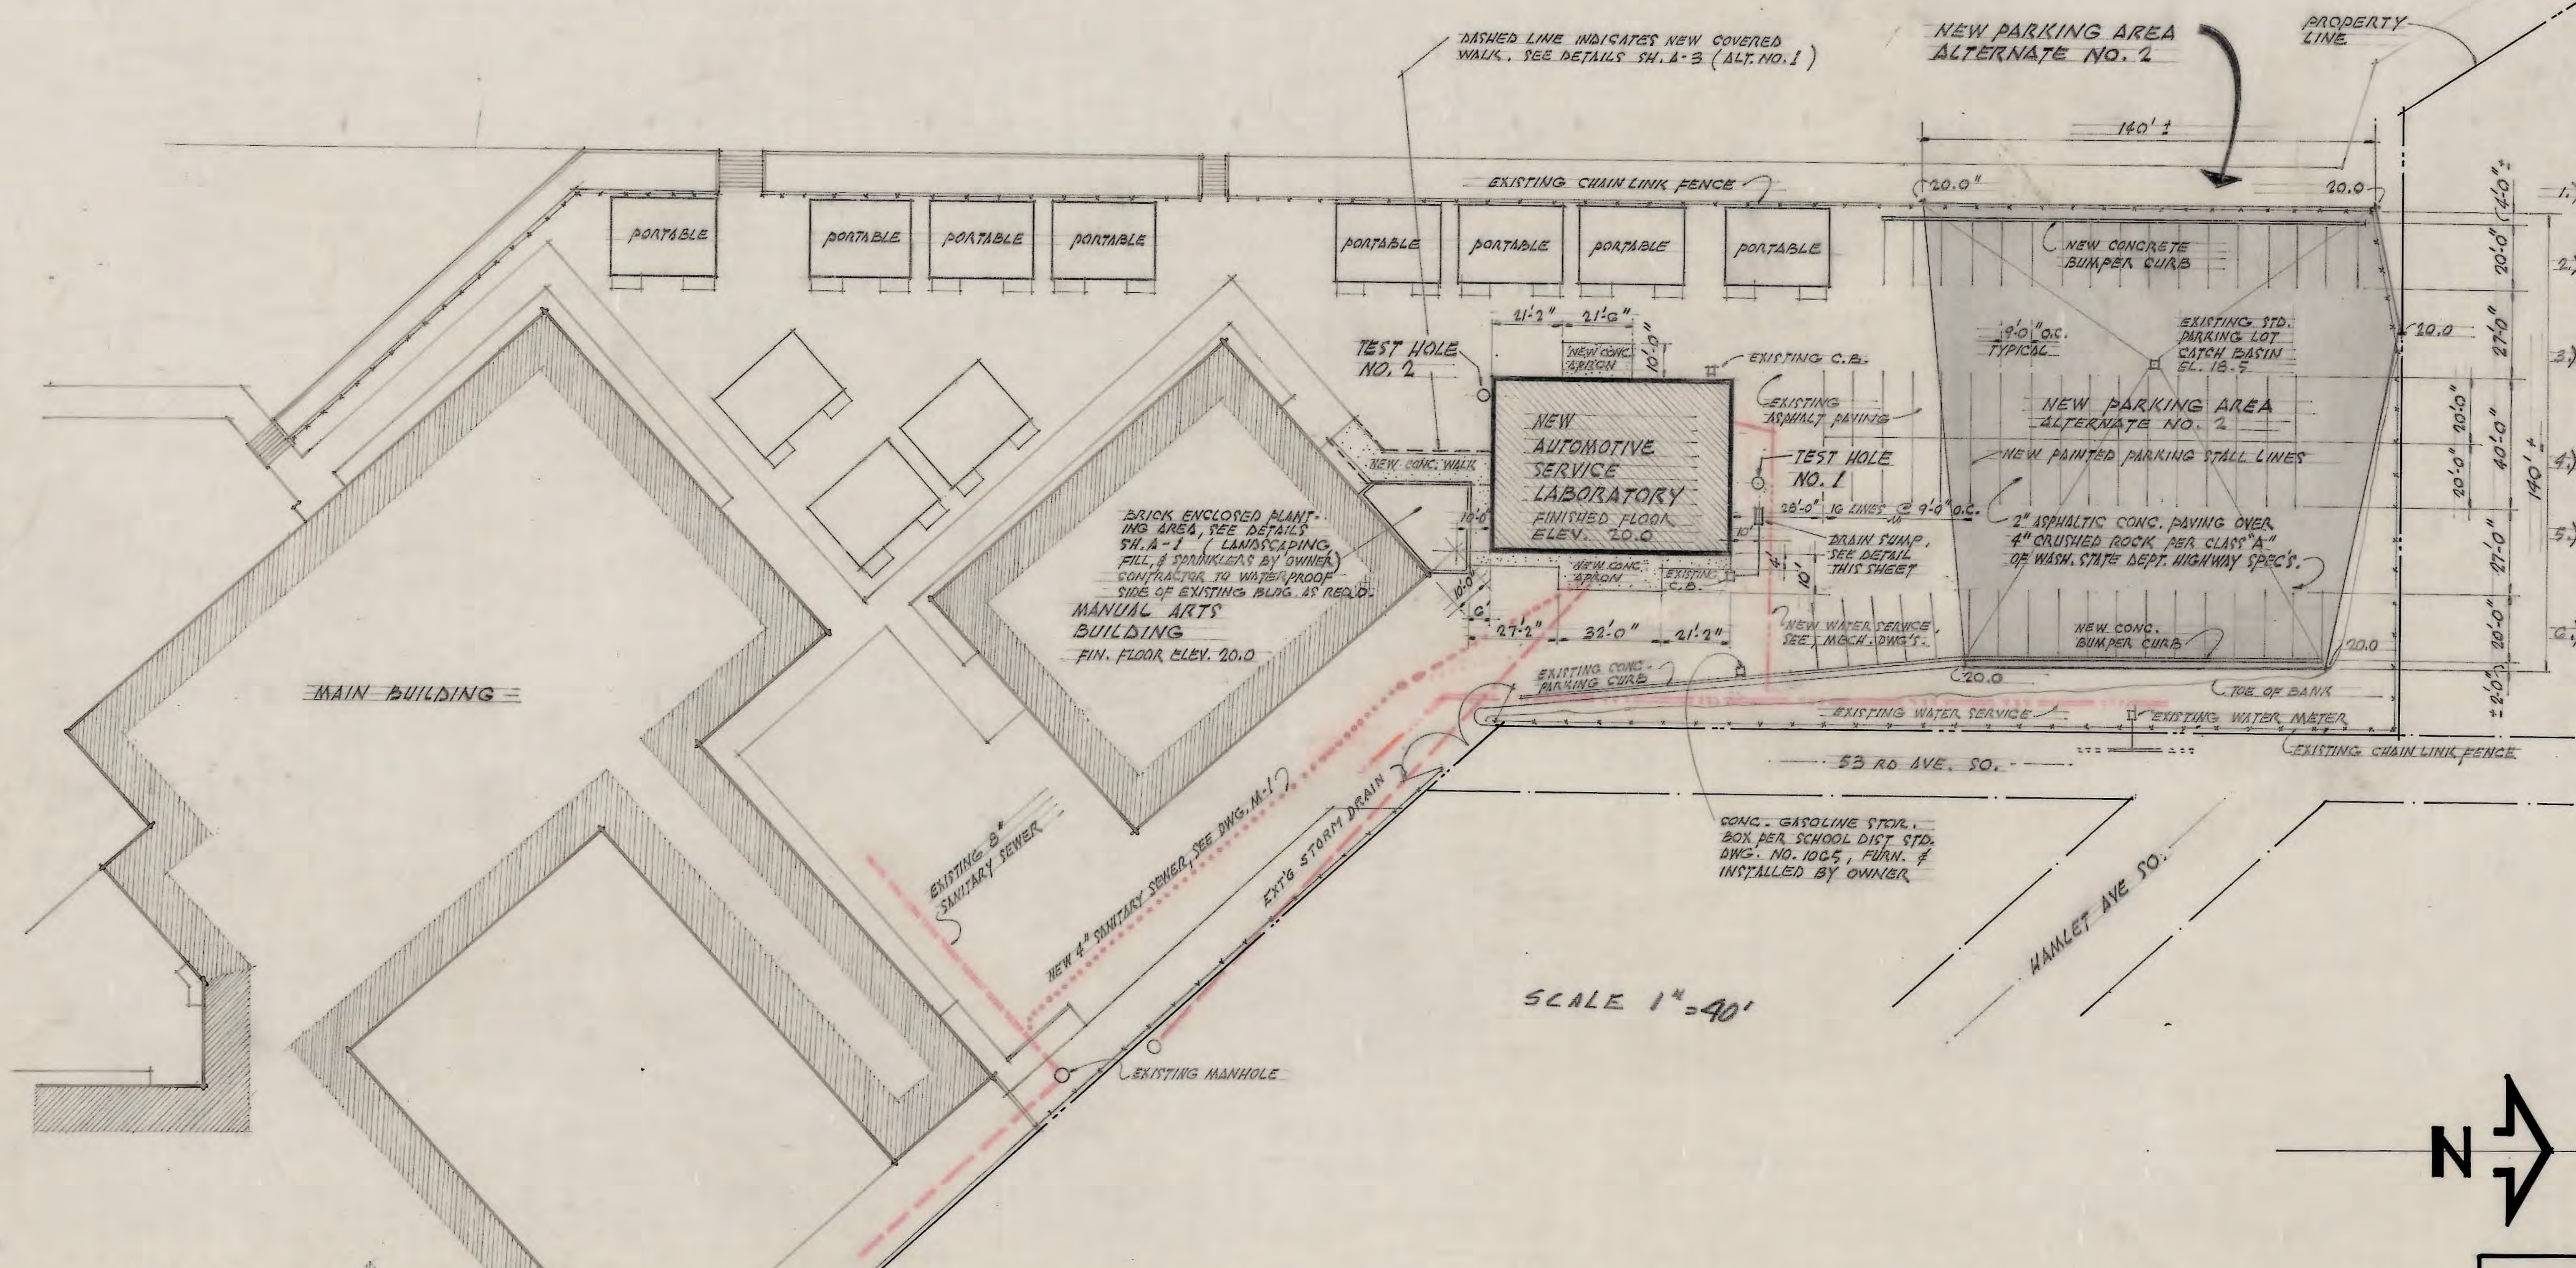

PARKING AREA NOTES

1.) ALL WORK AND MATERIAL PERTAINING TO NEW PARKING AREA SHALL CONSTITUTE ALTERNATE NO. 2
2.) PROVIDE NEW PRE-CAST CONC. TRAFFIC BUMPER CURBS AS MFG. BY OLYMPIAN STONE CO. OR EQUAL.
3.) CONTRACTOR SHALL PAINT OUT ALL EXISTING PARKING STALL LINES AND PAINT NEW 6" WIDE WHITE LINES AS INDICATED ON PLAN.
4.) PROVIDE UNIFORM SLOPE OF NEW ASPHALT PAVING TO EXISTING C.B.
5.) ADJUST EXISTING TOE OF BANK AS NECESSARY TO PROVIDE PARKING AREA AS SHOWN.
6.) PROVIDE 2" x 6" CEDAR RIBBON STRIP AROUND PERIMETER OF NEW PARKING AREA.

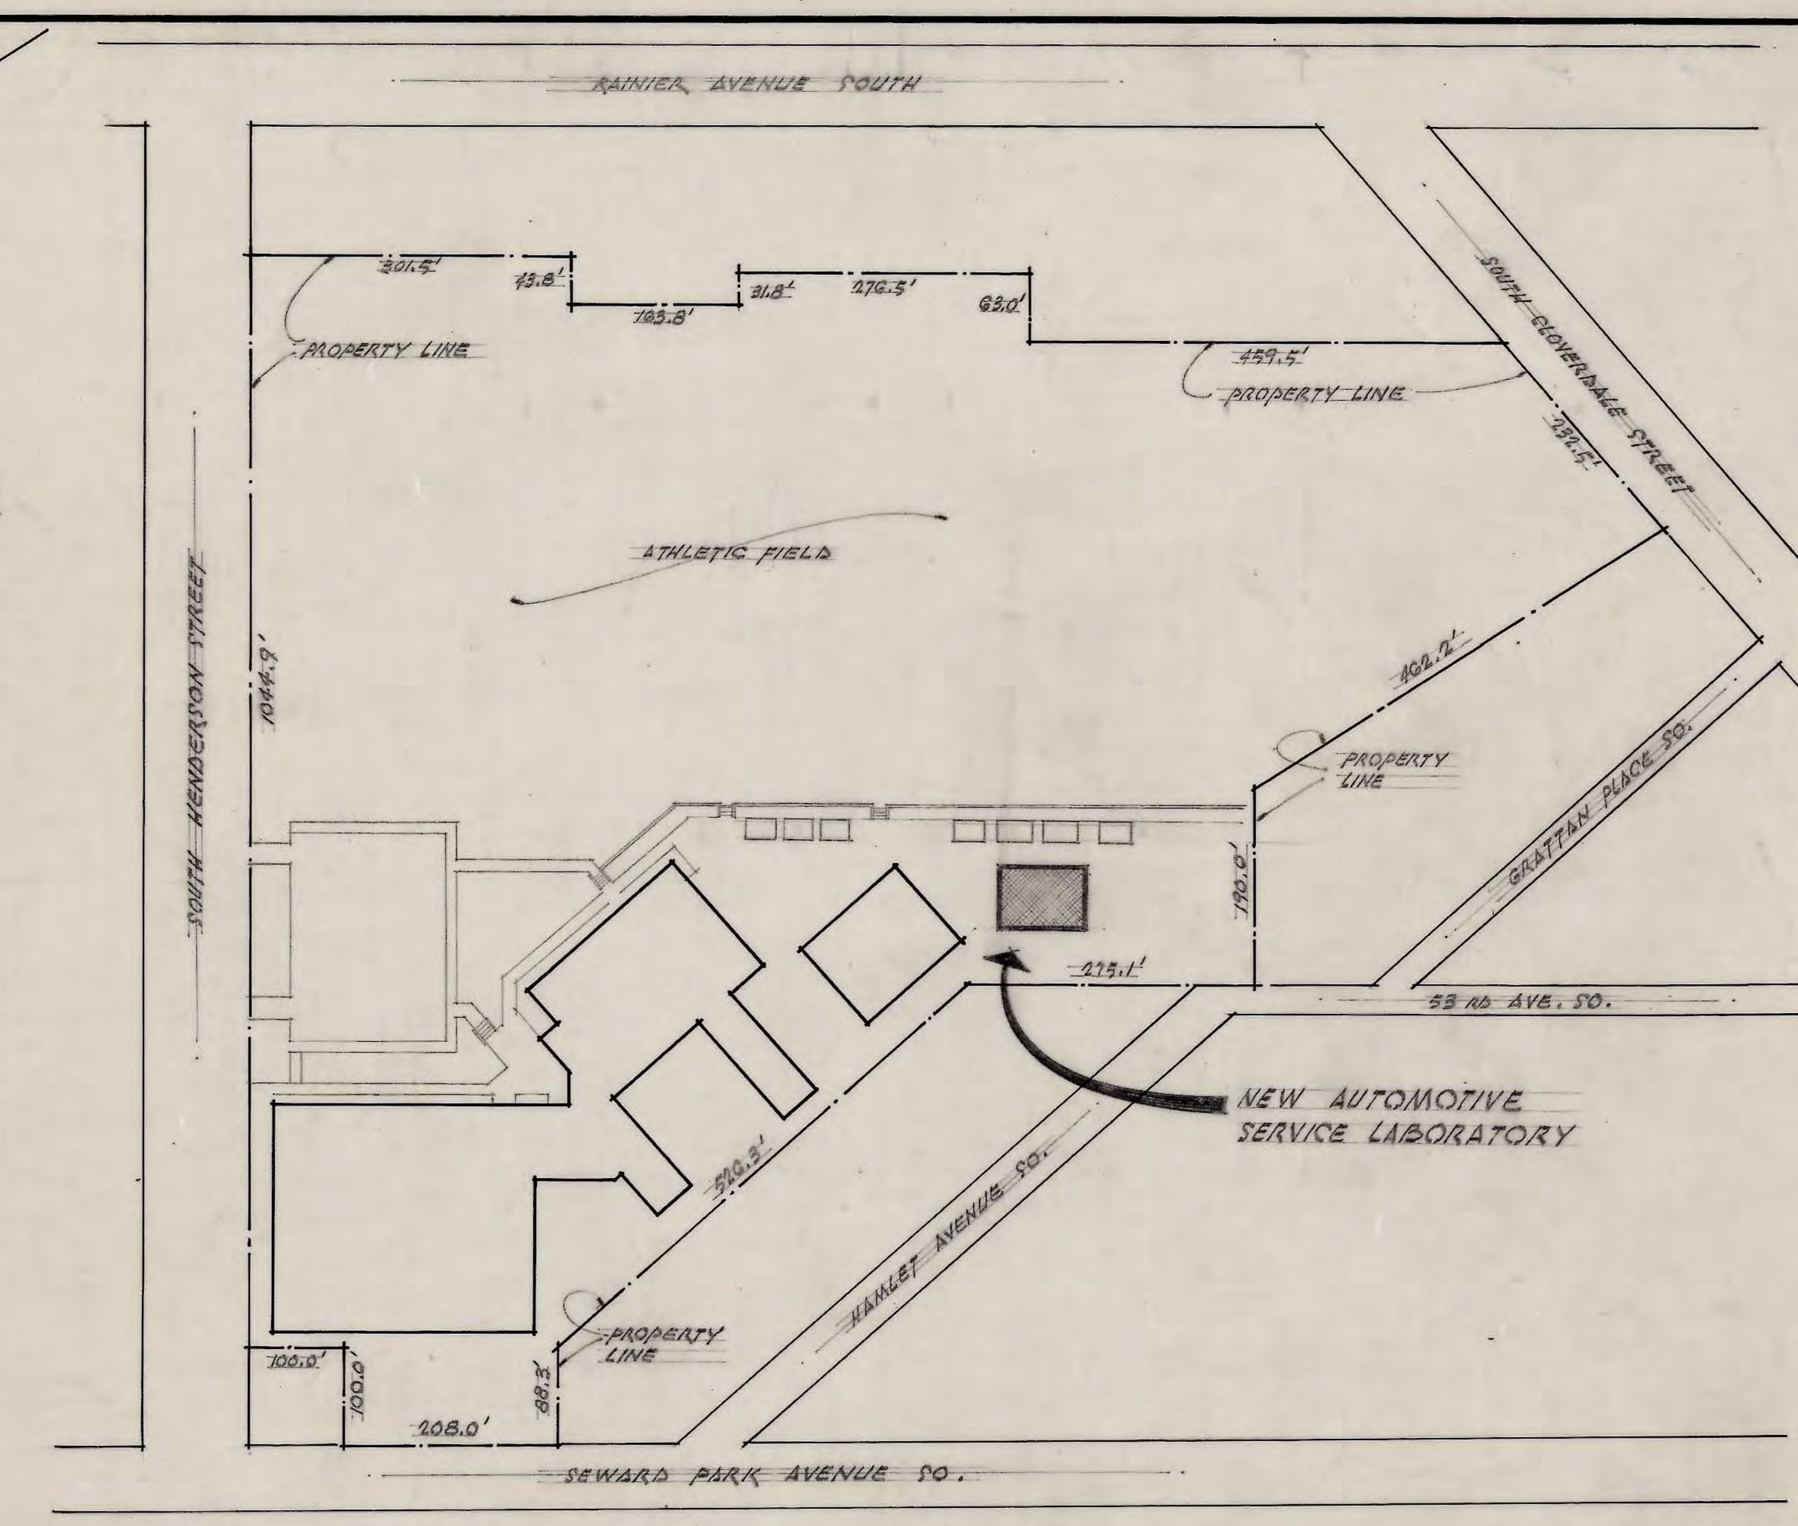

SITE PLAN NO SCALE

DESCRIPTION OF ALTERNATES (ALTERNATES NOT TO BE INCLUDED IN BASIC BID).

THE GENERAL CONTRACTOR SHALL SUBMIT A SEPARATE BID FIGURE FOR EACH OF THE FOLLOWING ALTERNATES:

ALTERNATE NO. 1
METAL MARQUEE CONNECTING NEW BUILDING WITH EXISTING MANUAL ARTS BUILDING AS DETAILED ON DRAWING A-3.

ALTERNATE NO. 2
CONSTRUCTION OF NEW PARKING AREA AS SHOWN AND DESCRIBED ON THIS DRAWING.

ALTERNATE NO. 3
COMPLETION OF TOILET ROOMS NO. 07 & 10 AS SHOWN ON DRAWING NO. A-2 & M-1 AND WITH EQUIPMENT LISTED IN SPECIFICATIONS.

LEGAL DESCRIPTION

THAT PORTITION OF GOVERNMENT LOTS 2 & 3 IN SEC. 35, TWP 24N, R 4 E. W.M.; IN KING COUNTY WASH. BEGINNING AT A POINT ON SOUTH LINE OF SAID GVMT. LOT 2 WHICH IS SOUTH 89°-54'-13" E 208.75' FROM SW CORNER THEREOF; THENCE N. 0°-07'-22" W PARALLEL WITH W. LINE OF GOV. LOT 2, A DISTANCE OF 163.75'. THENCE N. 89°-54'-13" E 63.00' THENCE N. 0°-07'-22" W. 459.47' TO THE SOUTHERLY MARGIN OF CLOVERDALE ST. AS ESTABLISHED BY ORD. NO. 35610. THENCE N. 47°-54'-48" E. ALONG THE MARGIN OF CLOVERDALE ST. AS ESTABLISHED BY ORD. NO. 35610. THENCE N. 47°-54'-48" E. ALONG THE MARGIN OF CLOVERDALE ST. 232.49' TO THE WESTERLY LINE OF BLOCK 9, C.D. HILLMANS ATLANTIC CITY ADD'N. THENCE SOUTH 33°-05'-1[illegible] E. 462.20' TO THE S.W. CORNER OF SAID BLOCK 9. THENCE N. 89°54'00" E. 189.98' ALONG THE SOUTH LINE OF BLOCK 9 TO WEST LINE OF 53RD AVE. SO. THENCE S. 0°06'00" E. ALONG SAID AVE. LINE 699.66' TO THE LINE OF GOV. LOTS 2 & 3; THENCE S. 89°54'13" E ALONG THE N LINE OF GOV. LOT 3 TO THE WESTERLY LINE OF SEWARD PARK AVE. AS ESTABLISHED BY ORDINANCE NO. 65076; THENCE S. 2°40'40" E. 202.9[illegible] ALONG SAID WESTERLY LINE; THENCE N. 89°50'52" W. 100.00'; THENCE S. 2°40'40" E 100.00' TO A POINT ON THE NORTH LINE OF HENDERSON ST. AS ESTABLISHED BY ORDINANCE NO. 39385; THENCE N. 89°50'52" W. ALONG THE N. LINE OF HENDERSON ST. 1044.93' TO A POINT 125.00' FROM THE E. LINE OF RAINIER AVE. AS ESTABLISHED BY ORDINANCE NO. 29364; THENCE N. 0°09'08" E 301.47' TO N. LINE OF GOV. LOT 3, THENCE S. 89°54'13" E 43.75' ALONG LINE OF GOV. LOTS 2 & 3 TO THE POINT OF BEGINNING. ALSO LOTS 1 TO 5 INCLUSIVE BLOCK 10 & LOTS 21 TO 34 INCLUSIVE BLOCK 11, C.D. HILLMAN'S ATLANTIC CITY ADD'N. AS RECORDED IN VOLUME 12 OF PLATS, PAGE 45 RECORDS OF KING COUNTY, WASH. TOGETHER WITH VACATED GIBBS PLACE AND VACATED 53RD AVE SO., SOUTH OF HAMLET AVE. AS VACATED BY ORDINANCE NO. 87920. TOGETHER WITH PORTITION OF GOV. LOT 2, IF ANY, SECTION 35, TWP 24 N RANGE 4 E WM., LYING SOUTH OF SOUTH LINE OF C.D. HILLMAN'S ATLANTIC CITY ADD'N. AND BETWEEN 53RD AVE SO. AND 54TH SO. (SEWARD PARK AVENUE).

DRAIN SUMP DETAIL

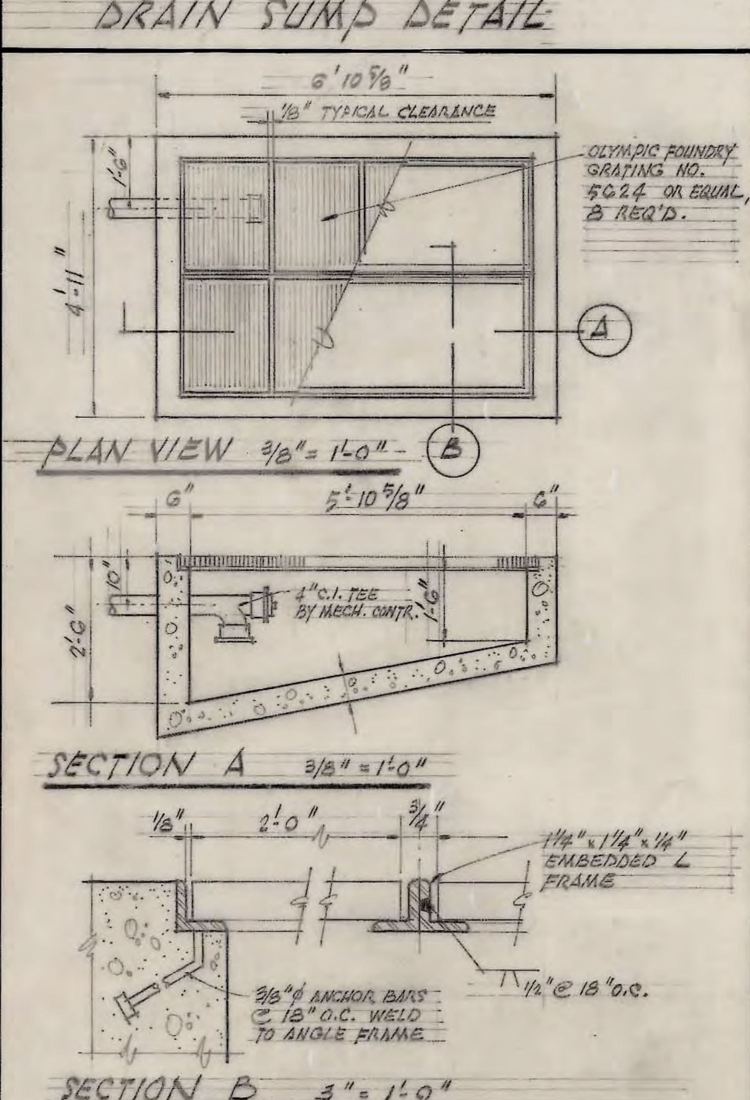

NOTE: CONNECT TO EXISTING CATCH BASIN WITH CONCRETE PIPE OR CLAY TILE. SEE PLAN.

PLANTER BOX DETAIL

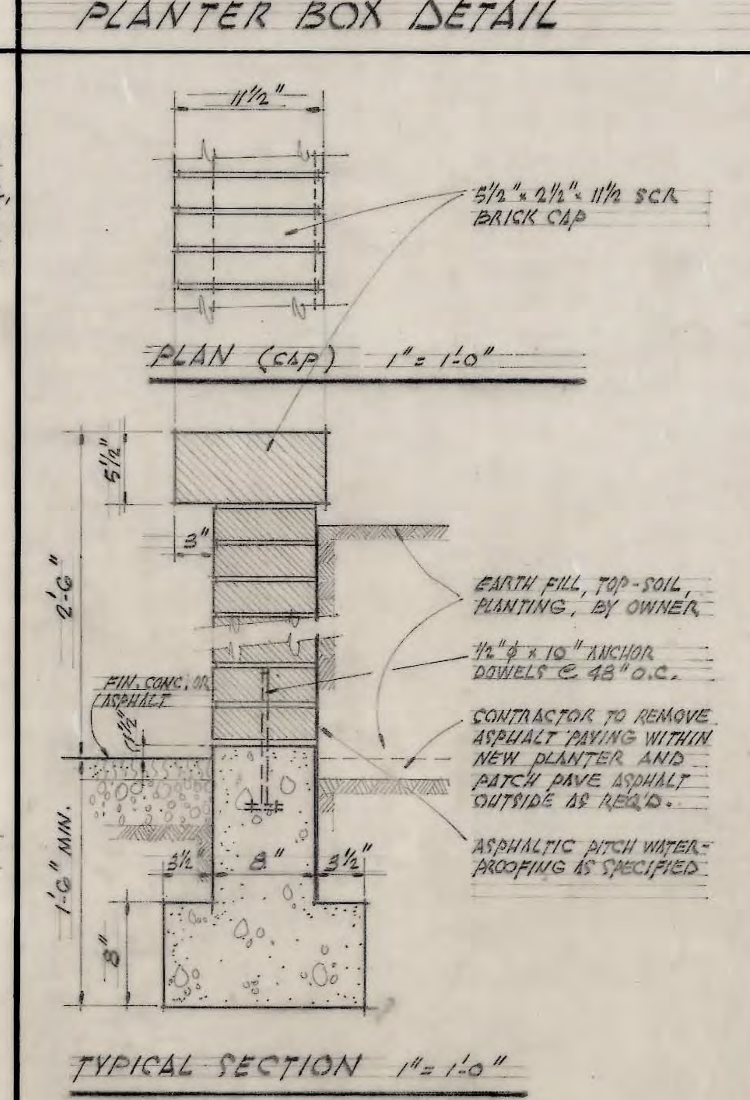

BUILDING DEPT. NOTES

1.) ZONING : RD 5000
2.) TYPE OF CONSTRUCTION : V N
3.) FIRE ZONE : 3
4.) OCCUPANCY AND GROUP : SCHOOL - C
5.) GROUND COVERAGE

EXISTING PERMANENT BLDGS. :	104,682 □'
NEW PERMANENT BUILDING	2,859 □'
EXISTING PORTABLE	16,128 □'
TOTAL BUILDING COVERAGE	123,669 □'
TOTAL PROPERTY AREA	992,912 □'
ALLOWABLE COVERAGE (35 %)	347,519 □'

GENERAL NOTES

1.) ROOM FINISH SCHEDULE AND DOOR SCHEDULE SHOW MATERIAL AND FINISHES WHICH SHALL BE PROVIDED. SEE SPECIFICATIONS FOR MATERIALS AND FINISHES NOT COVERED IN THESE SCHEDULES. IF MATERIALS AND THEIR FINISHES ARE NOT COVERED BY THE SCHEDULES OR SPECIFICATIONS, THEY SHALL BE OF FIRST GRADE QUALITY AND WORKMANSHIP AND APPROVED BY THE ARCHITECT.
2.) CONTRACTOR SHALL VERIFY ALL GRADES, DIMENSIONS, AND CONDITIONS ON SITE.
3.) CONSULT MECHANICAL AND ELECTRICAL DRAWINGS FOR LOCATION OF DUCTS, PIPING, CONDUIT, ETC.
4.) ROOM NUMBERS SHOWN ON DRAWINGS ARE FOR CONSTRUCTION PURPOSES ONLY. CONSULT WITH ARCHITECT FOR NAMES AND NUMBERS TO BE PAINTED ON DOORS OR AS REQUIRED ELSEWHERE.
5.) CONTRACTOR SHALL VERIFY ALL ROUGH IN DIMENSIONS AND CONDITIONS REQUIRED FOR INSTALLATION OF EQUIPMENT FURNISHED BY OTHERS OR BY HIMSELF.
6.) CONTRACTOR SHALL BE RESPONSIBLE FOR ALL MECHANICAL AND / OR ELECTRICAL SERVICES REQUIRED TO OPERATE ALL EQUIPMENT AS INTENDED.
7.) CONSULT STRUCTURAL, MECHANICAL, AND ELECTRICAL DRAWINGS FOR ADDITIONAL NOTES.
8.) ALL WORK SHALL COMPLY WITH ALL APPLICABLE CODES AND ORDINANCES.
9.) CONTRACTOR SHALL PATCH PAVE EXISTING ASPHALT PAVING DAMAGED DUE TO NEW CONSTRUCTION, MAINTAINING SMOOTH TRANSITION AND UNIFORM SLOPE.
10.) ALL CABINETS, WORK BENCHES, AND SHELVING AS SHOWN ON DRAWINGS AND AS CALLED FOR IN THE SPECIFICATIONS ARE NOT TO BE A PART OF THIS CONTRACT.

TEST HOLE DATA

TEST BORE NO. 1 — ELEV. OF WATER TABLE DRY HOLE (FEET BELOW GRADE 1–20)
- 3" ASPHALTIC CONC.
- GRAVEL, SAND, AND CLAY FILL
- GRAYISH BROWN CLAYEY SILT WITH SCATTERED GRAVEL
- BROWN CLAYEY SILTY SAND, BEDDED 4"-6" WITH GRAY MEDIUM TO COARSE SAND & 5 TO 10 % GRAVEL
- BLUISH-GRAY CLAYEY SILT WITH SCATTERED GRAVEL

TEST BORE NO. 2 — ELEV. OF WATER TABLE 12.0' BELOW GRADE (FEET BELOW GRADE 1–20)
- 3" ASPHALTIC CONC.
- BROWN, CLAYEY, SILTY SAND WITH 15-20% GRAVEL TO 2".
- INTERMIXED CLAY, SAND, GRAVEL, WITH MUCH PEAT AND ORGANIC DEBRIS
- MOLTED GRAY & BROWN CLAYEY SILT
- BROWN, CLAYEY, SILTY SAND WITH 5-10 % GRAVEL WITH LOCAL 4"-6" BEDS COARSE WATER BEARING SAND
- BLUISH-GRAY CLAYEY SILT BEDDED 1"-2" WITH SILTY CLAYEY SAND

INDEX TO DRAWINGS

NO.	TITLE
ARCHITECTURAL	
A-1	SITE PLAN, PLOT PLAN, LEGAL DESCRIPTION
A-2	FLOOR PLAN, ROOM FINISH & DOOR SCHEDULE
A-3	EXTERIOR ELEVATIONS & DETAILS
A-4	TYPICAL WALL SECTIONS, DOOR & WINDOW DETAILS
A-5	INTERIOR ELEVATIONS & DETAILS
STRUCTURAL	
S-1	FOUNDATION PLAN & STRUCTURAL DETAILS
S-2	ROOF FRAMING PLAN & STRUCTURAL DETAILS
S-3	STRUCTURAL NOTES & TYPICAL MASONRY DETAILS
MECHANICAL	
M-1	MECHANICAL PLAN & DETAILS
ELECTRICAL	
E-1	ELECTRICAL PLAN
E-2	PANELBOARD & LOAD SCHEDULE

RAINIER BEACH JUNIOR - SENIOR HIGH SCHO[OL]
AUTOMOTIVE SERVICE LABORATORY ADDITION
8815 - SEWARD PARK AVENUE SOUTH

SITE PLAN, PLOT PLAN, LEGAL DESCRIPTION
GENERAL NOTE & INDEX TO DRAWINGS

DATE: DEC. 1, 1967
DRAWN BY: E. TAZIOLI
CHECKED BY: T.A. SMITH

SEATTLE SCHOOL DISTRICT No. 1
MAINTENANCE & OPERATIONS
WALTER E. LARSEN, DIRECTOR
810 DEXTER AVENUE NORTH
SEATTLE, WASHINGTON

SHEET A-1

021-F-0125

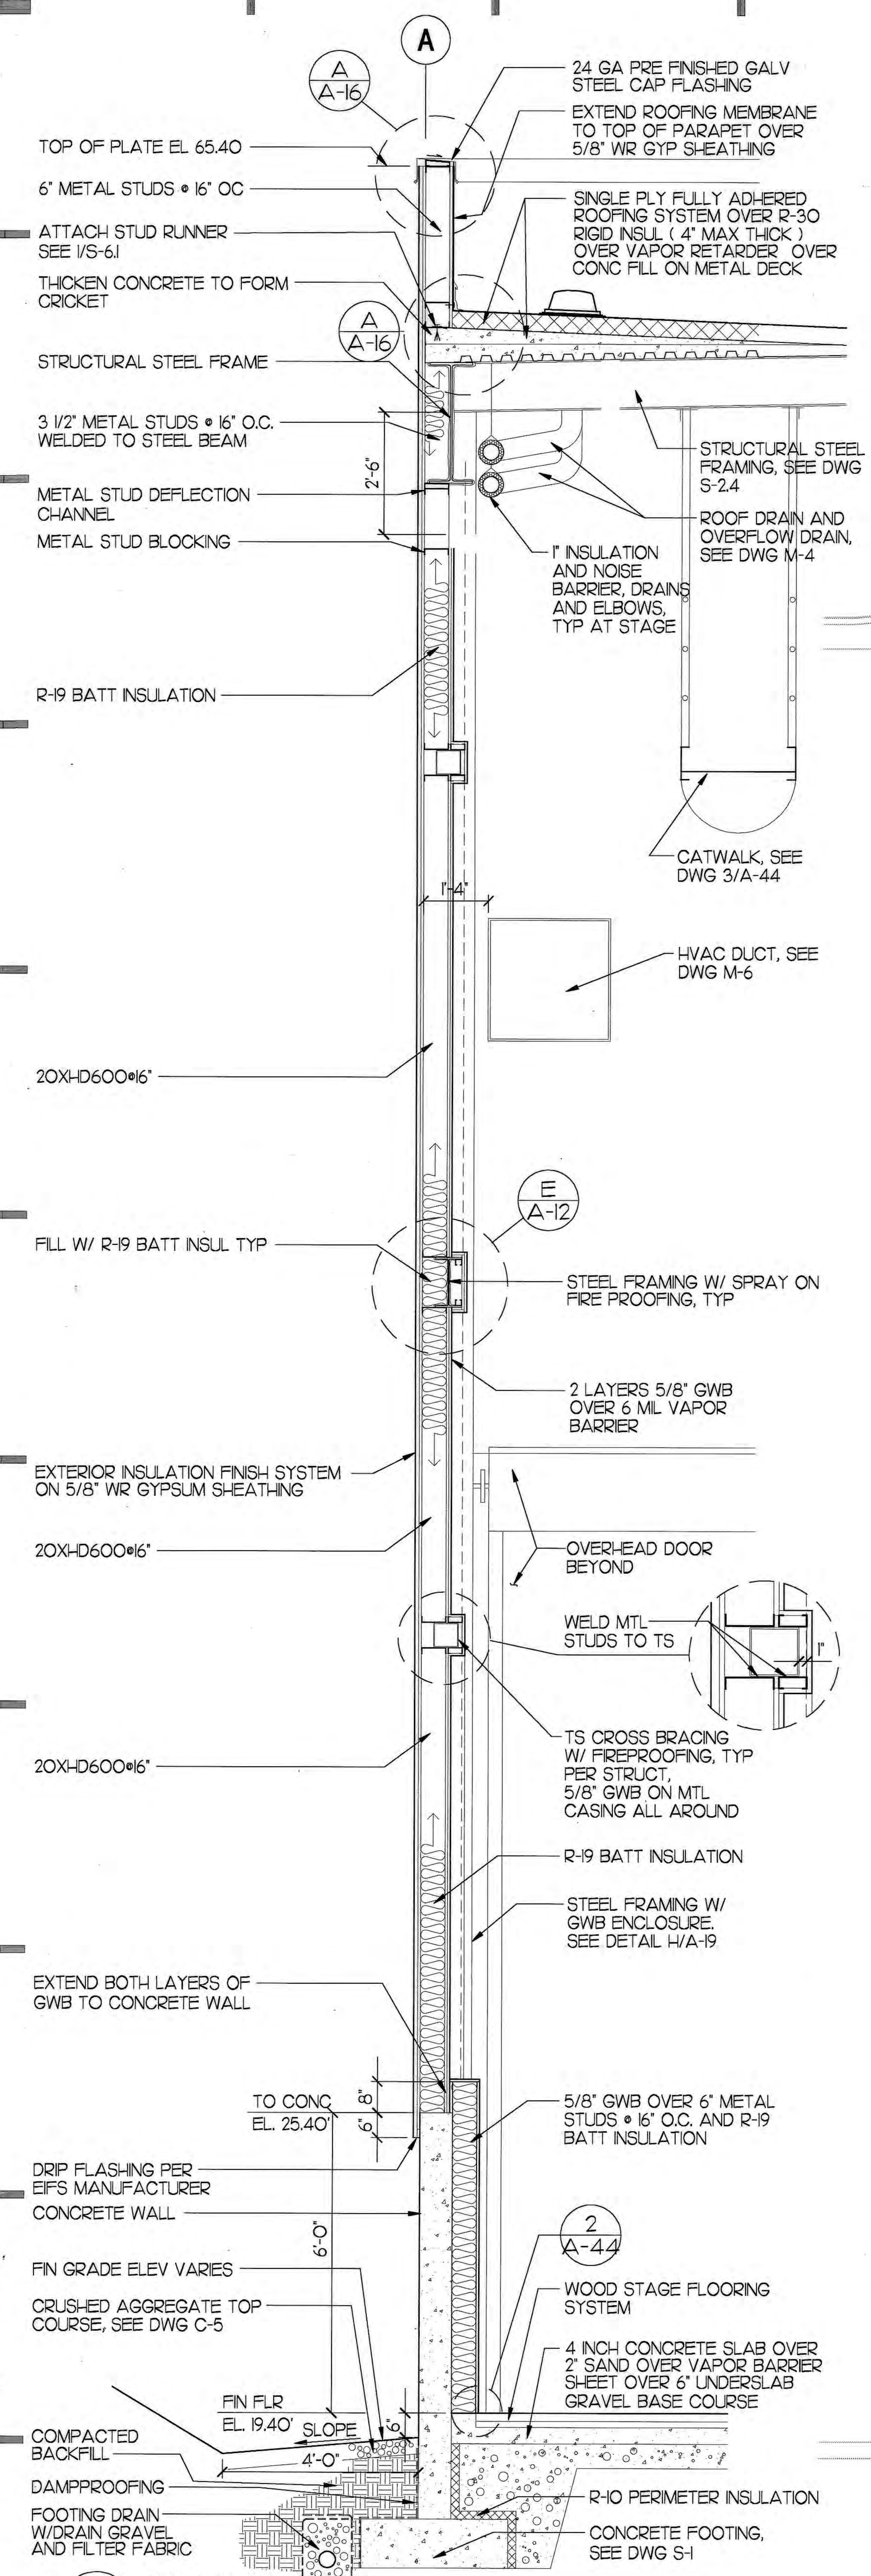

A
A-9
WALL SECTION
SCALE: 1/2 = 1'-0"

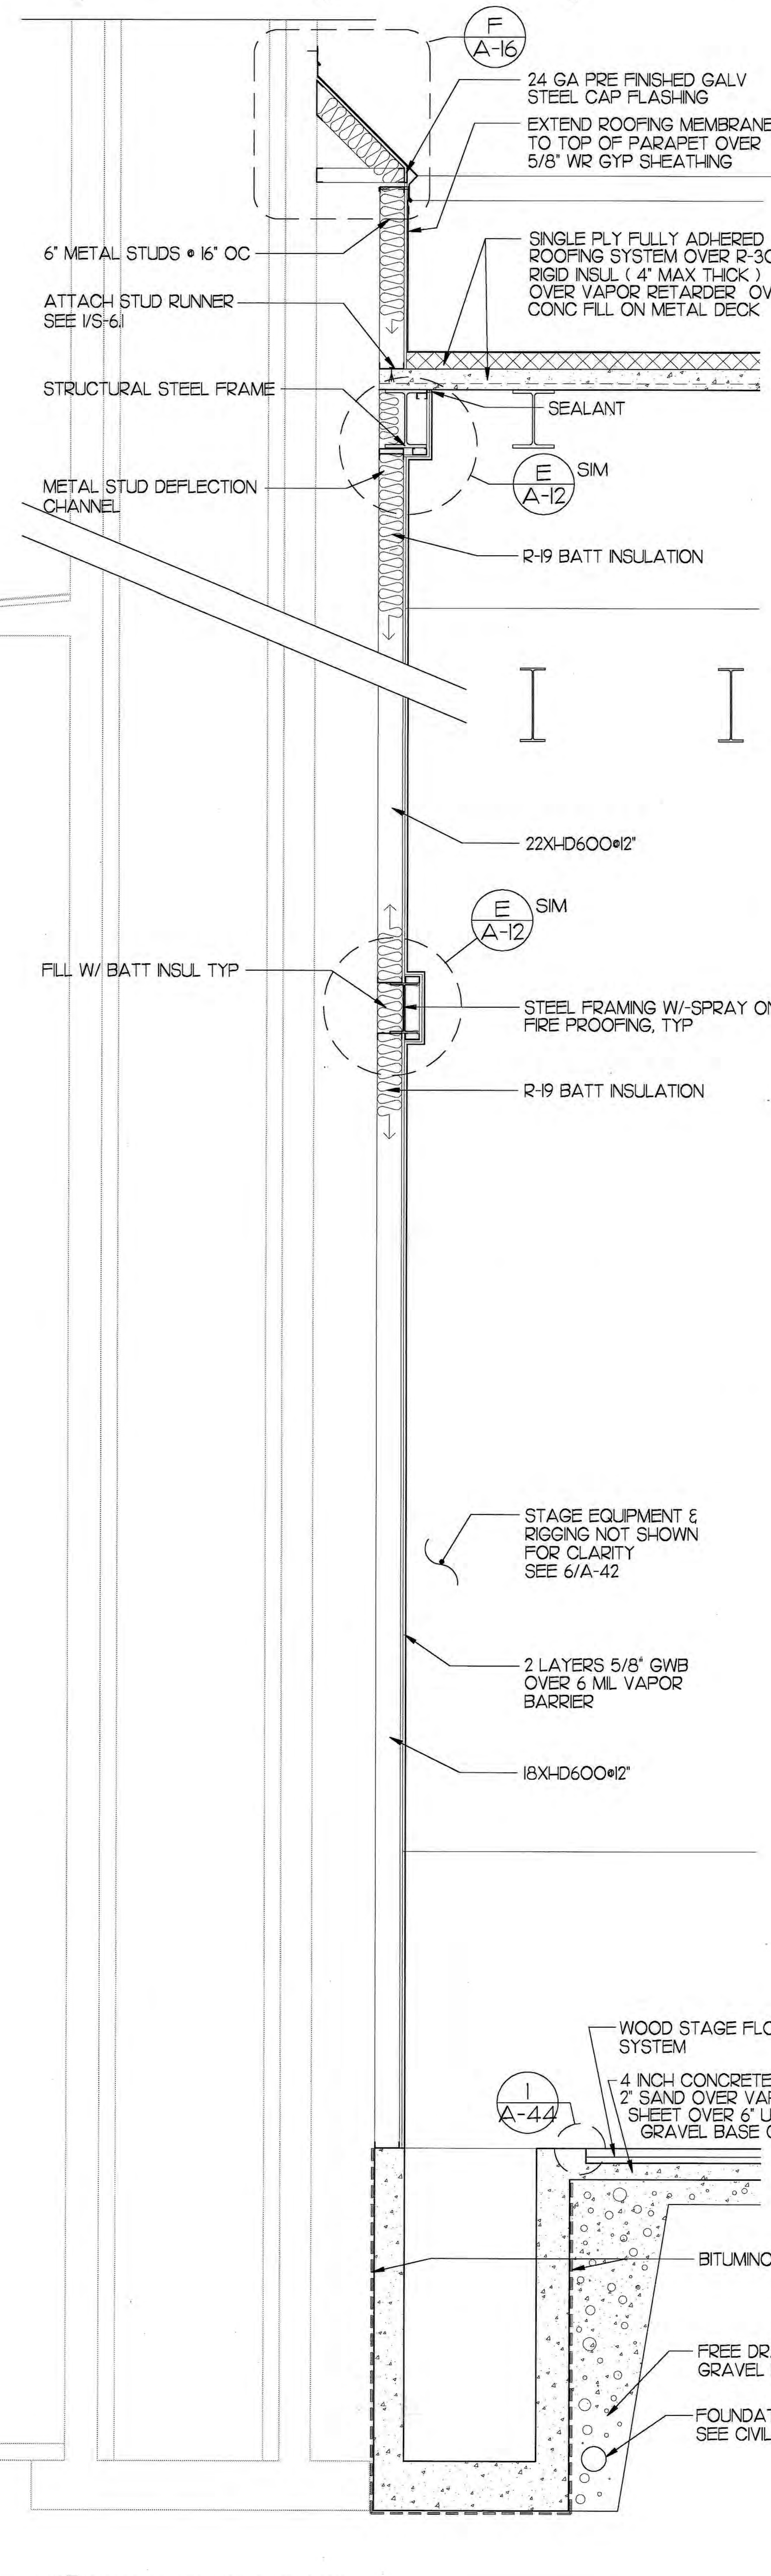

B
A-10
WALL SECTION
SCALE: 1/2 = 1'-0"

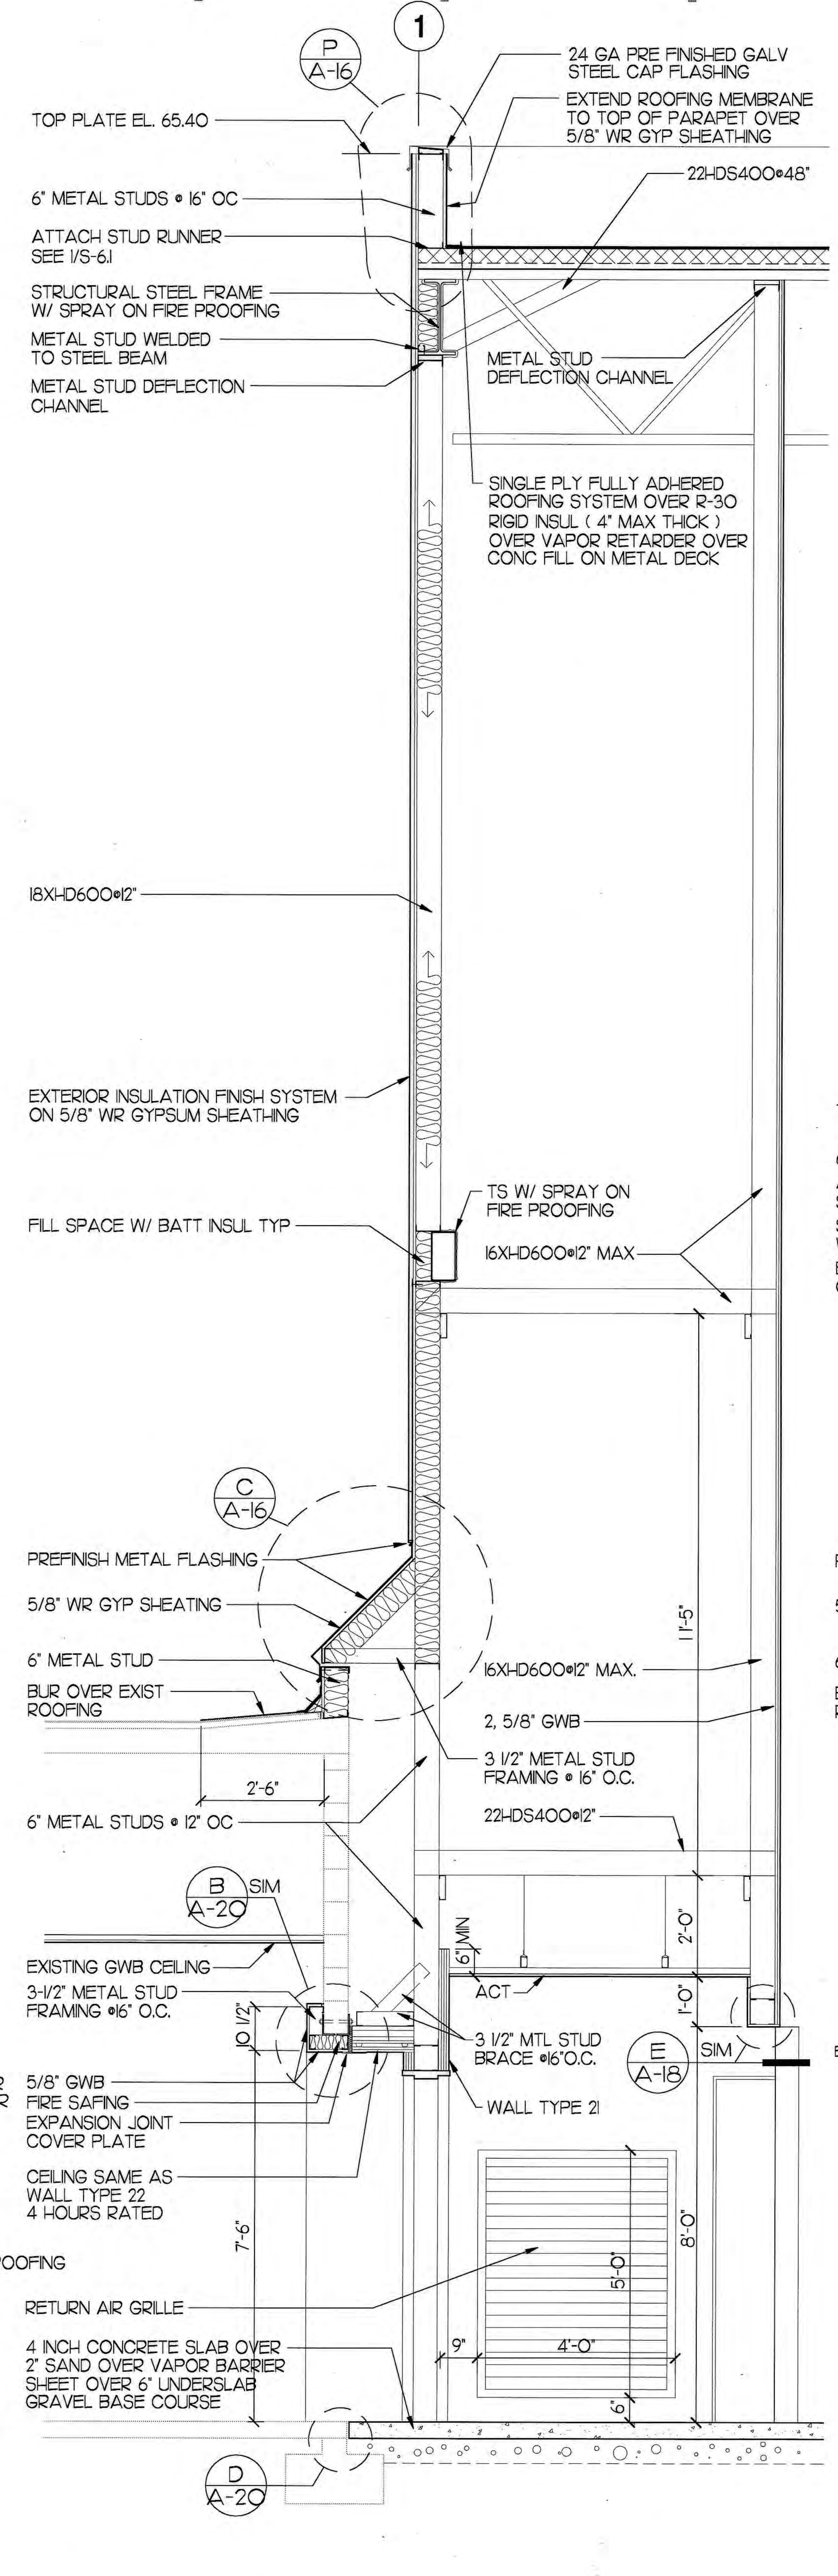

C
A-11
WALL SECTION
SCALE: 1/2 = 1'-0"

NOTES:

SEE S-6.1 FOR METAL STUD CONNECTION DETAILS

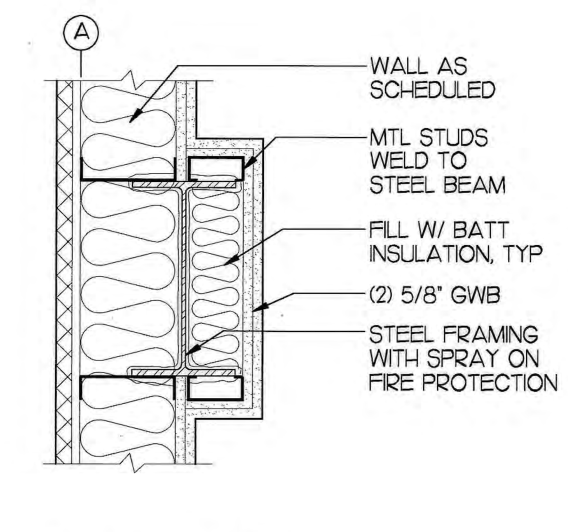

E
A-12
BEAM FRAMING DETAIL
SCALE: 1-1/2" = 1'-0"

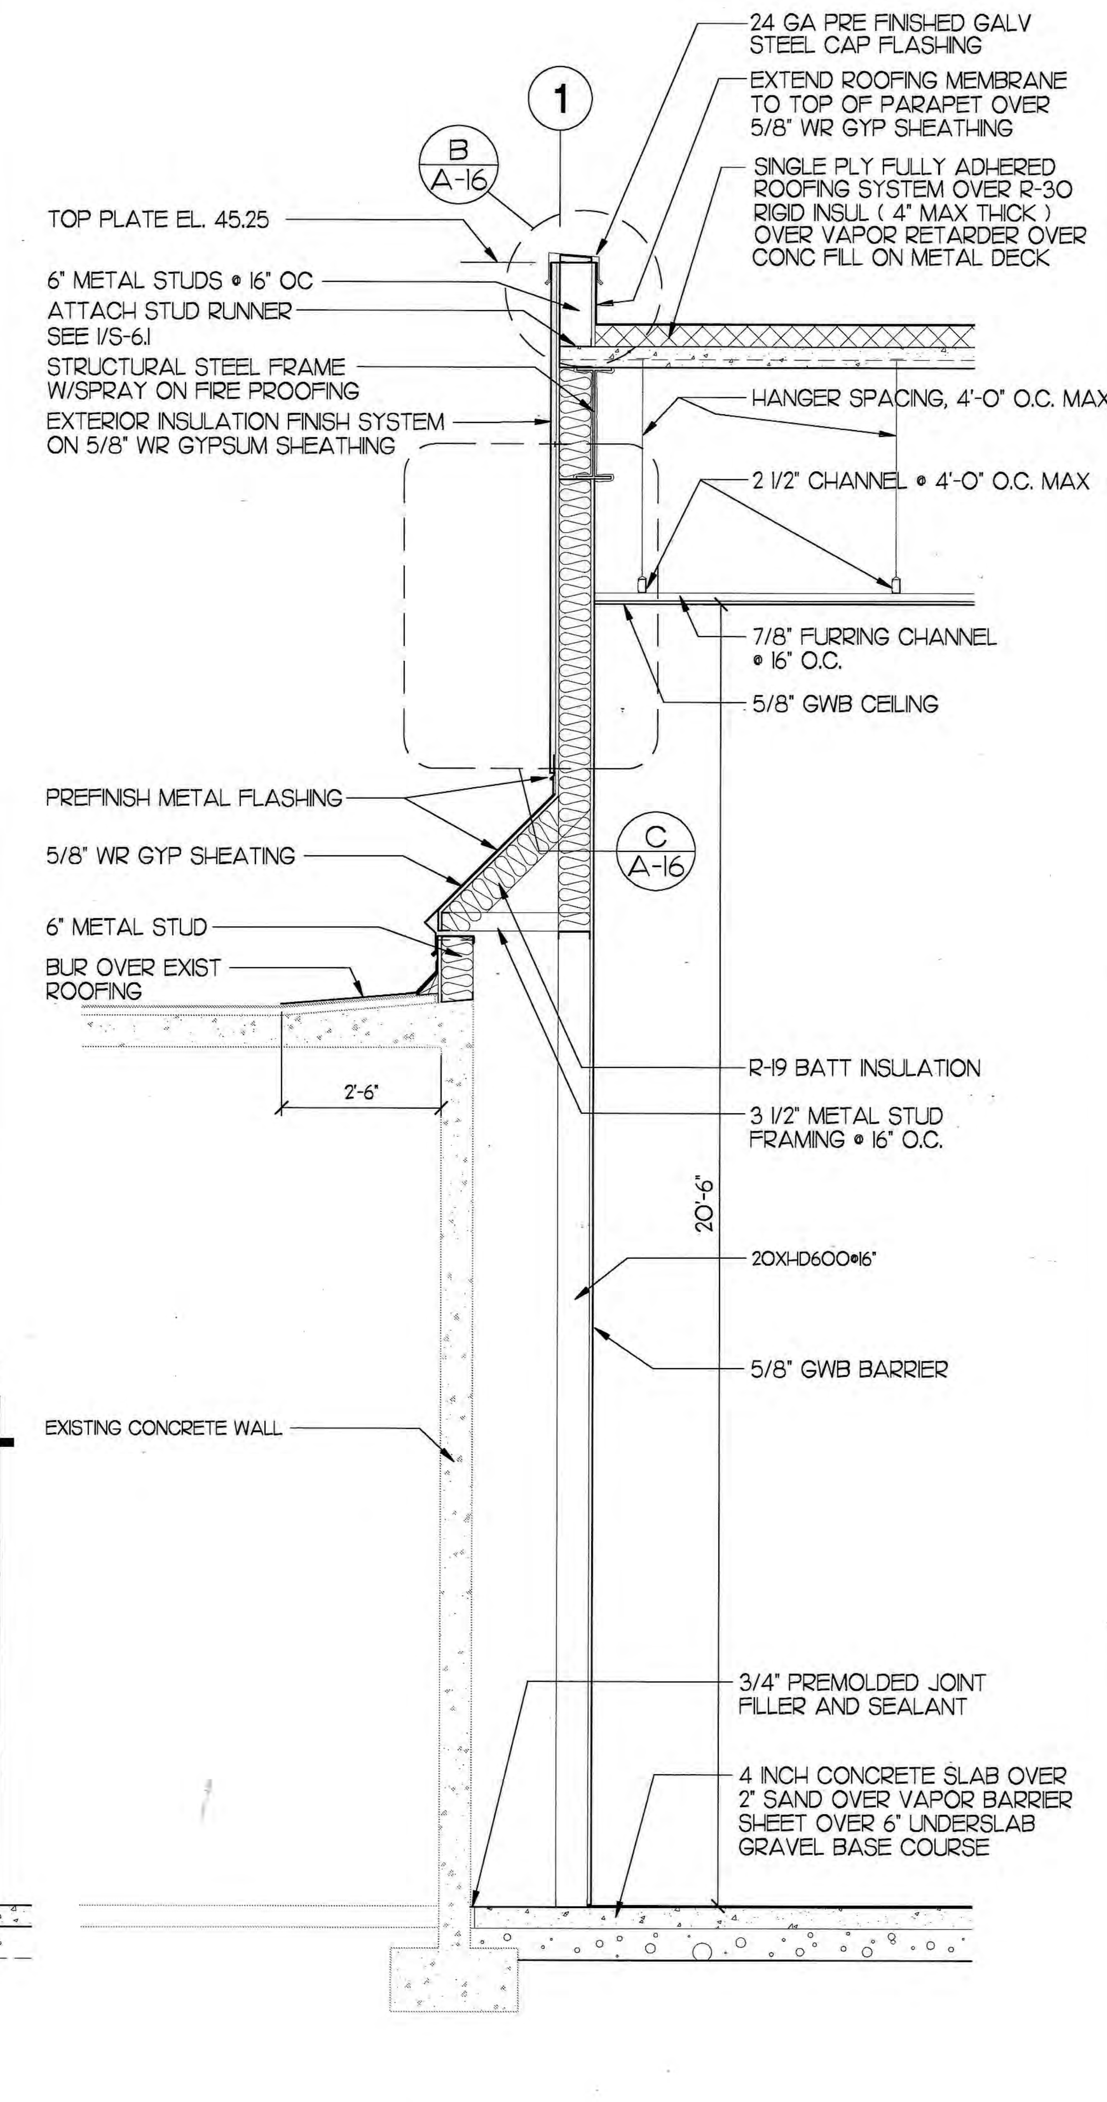

D
A-11
WALL SECTION
SCALE: 1/2 = 1'-0"

PLOT FILE: 541A310.DWG
DATE PLOTTED: 02/25/99

STREETER & ASSOCIATES ARCHITECTS AIA

185 UNIVERSITY STREET SEATTLE WA. 98101-2901
206.621.9270 F.206.621.7715 www.streeterarchitects.com

CONSULTANT

SEATTLE SCHOOL DISTRICT

DATE: MARCH, 1999

AS-BUILT

RAINIER BEACH HIGH SCHOOL PERFORMING ARTS CENTER

WALL SECTIONS - SECTIONS A, B, C & D

PRINCIPAL ARCH:	M STREETER	DATE: 10/01/99
PROJECT MNGR:	S CAMERON	
PROJECT ARCH:	I JAIN	A-12
JOB CAPTAIN:	J MOORE	
DRAWN BY:	JM/KAW	
REVIEWED BY:	JAIN	SHEET NO:

NO.	REVISION	DATE	DRAWING NO.

276
021-0

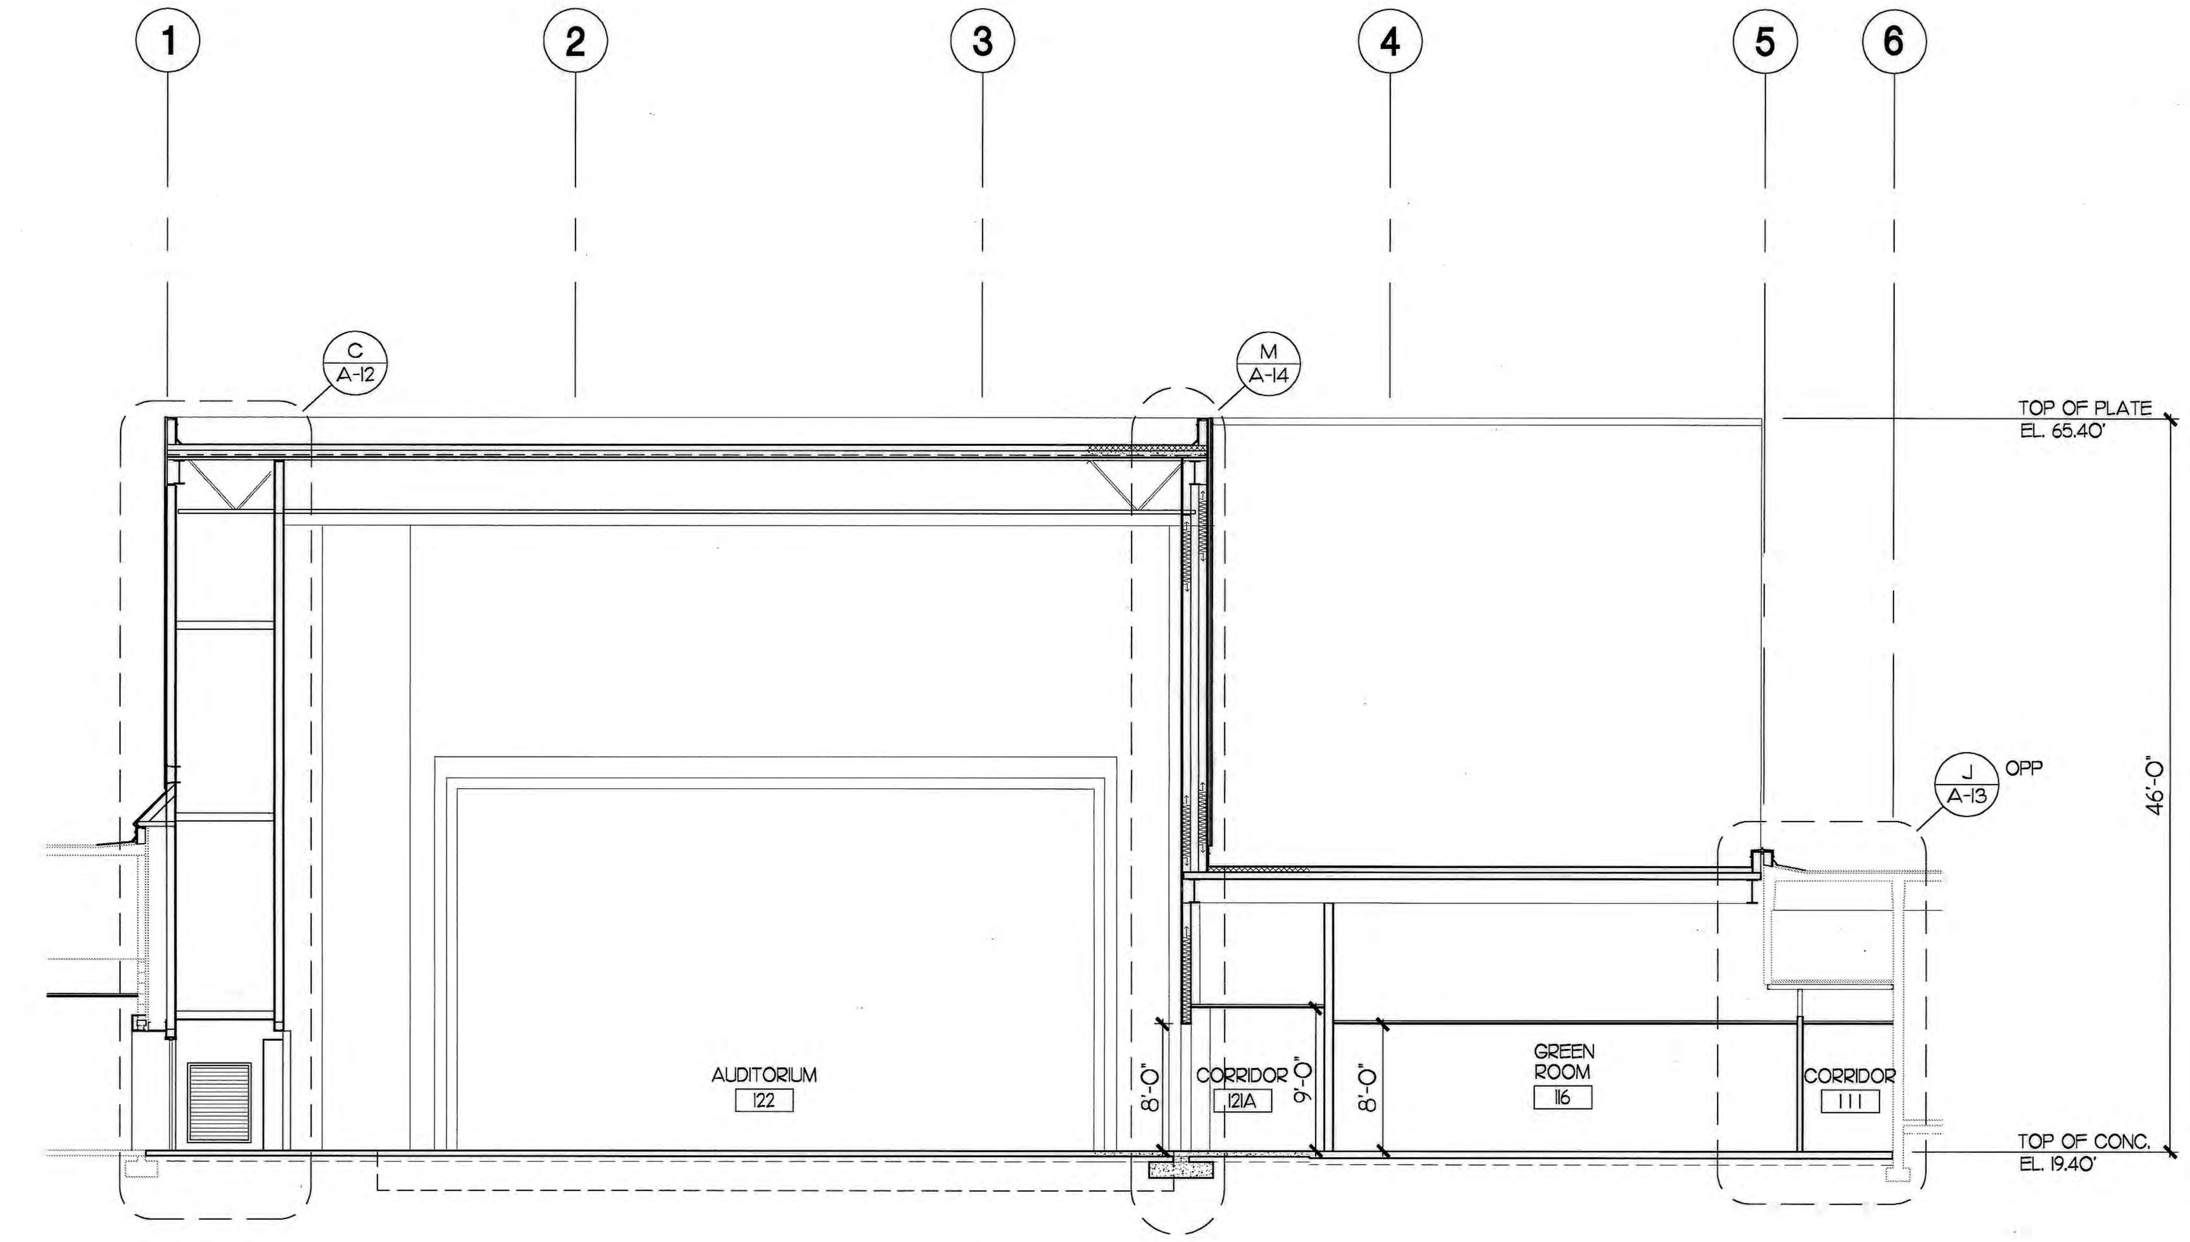

E
A-2
BUILDING SECTION
SCALE: 1/8" = 1'-0"

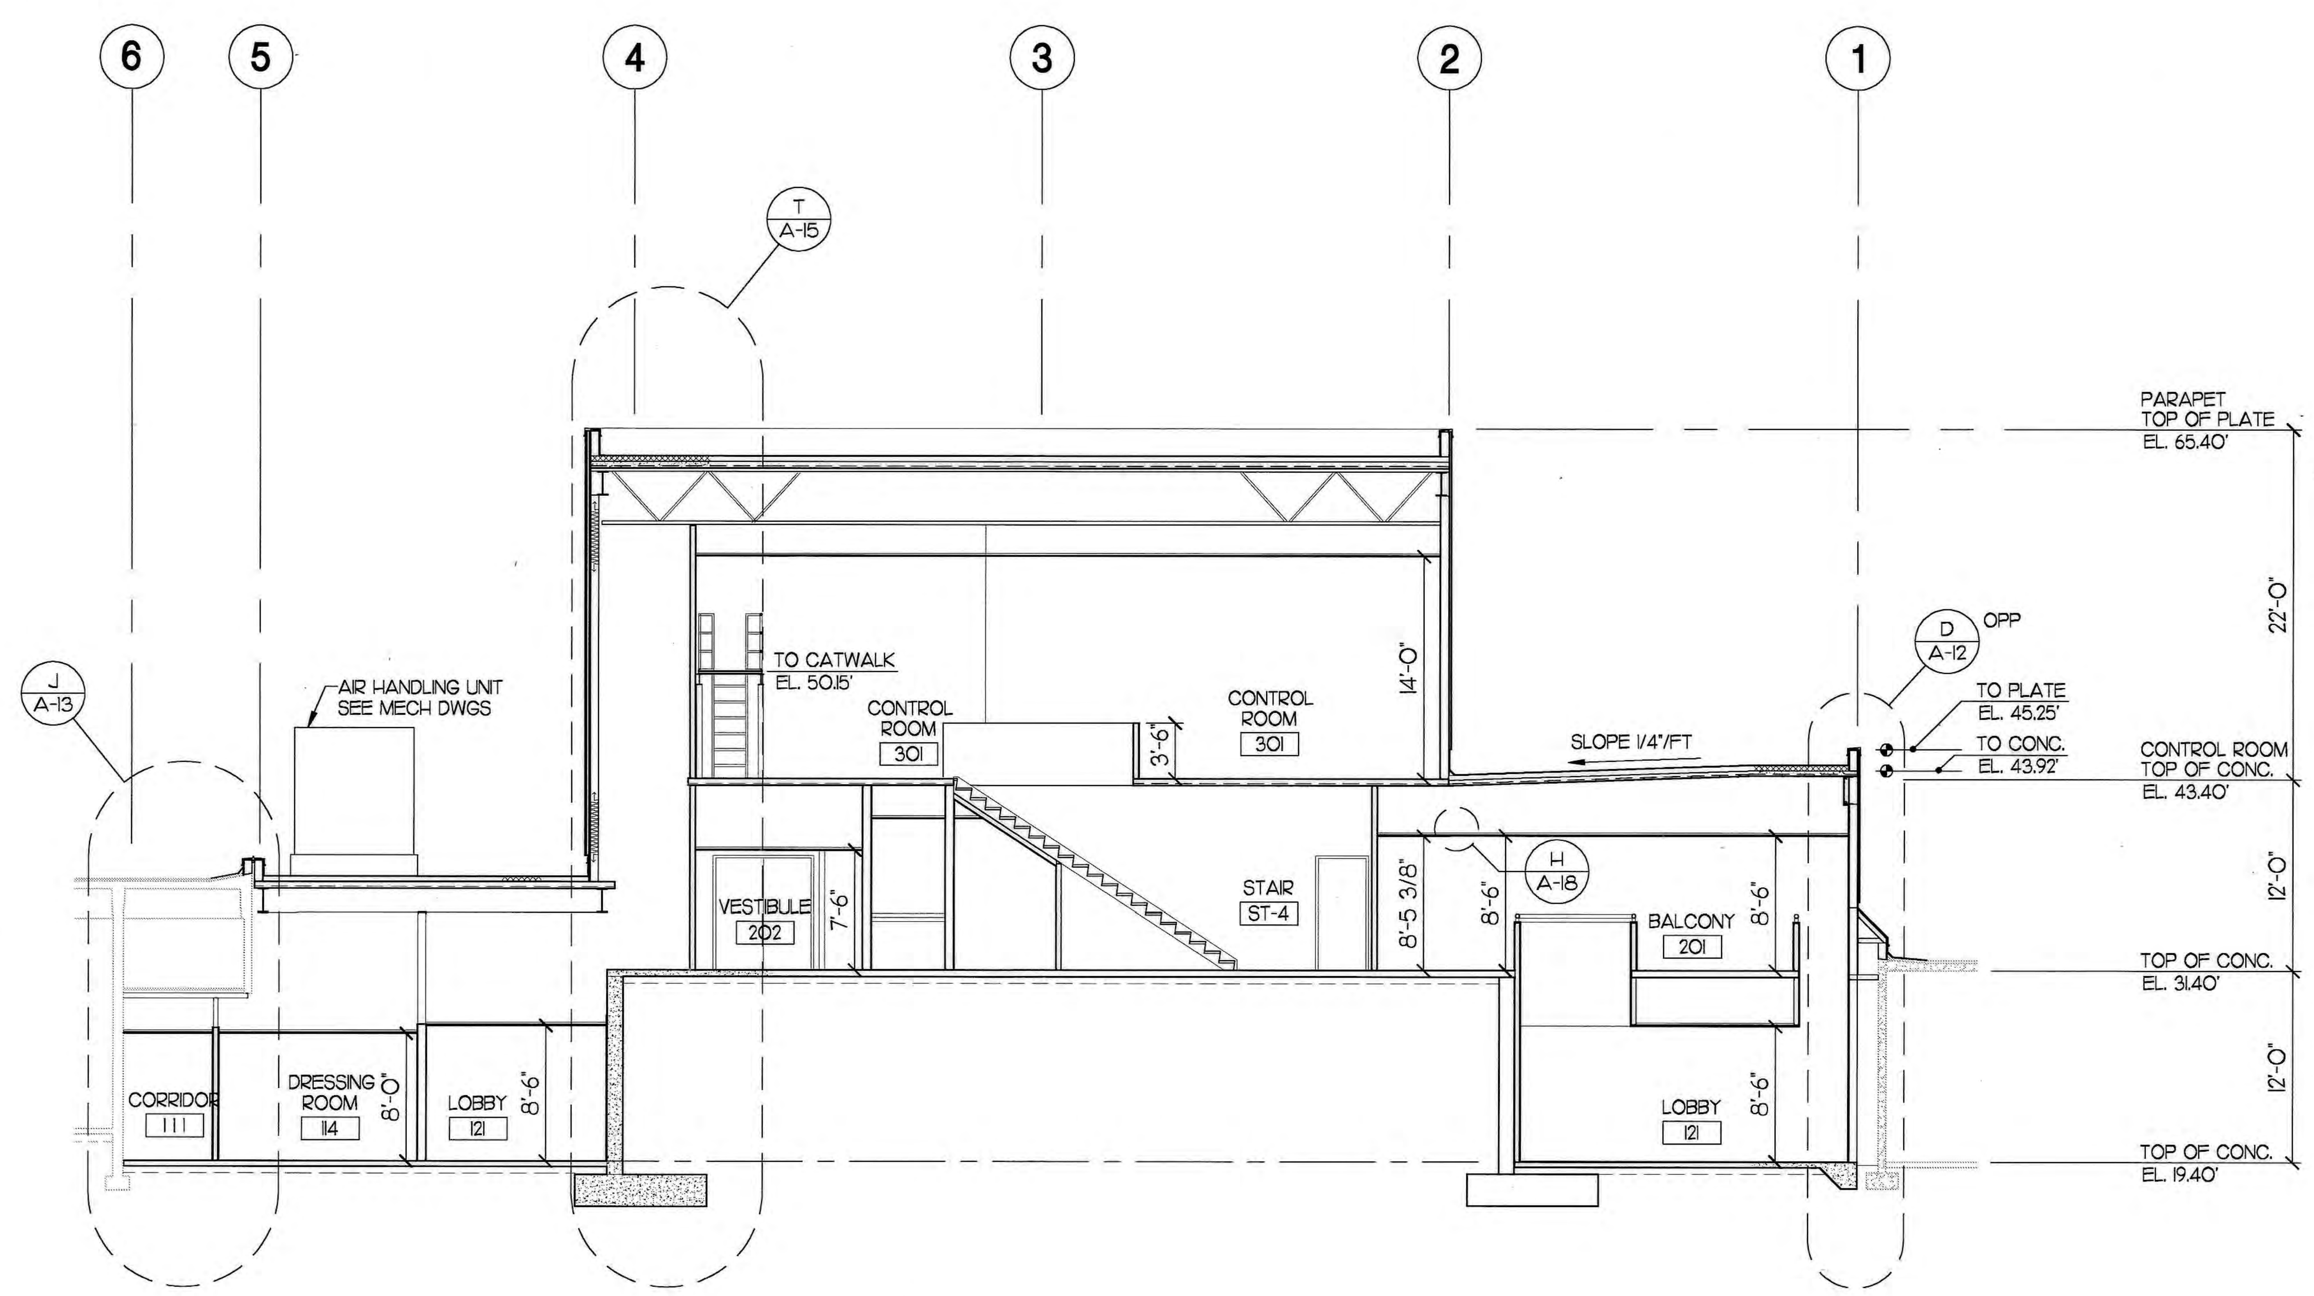

F
A-2
BUILDING SECTION
SCALE: 1/8" = 1'-0"

PLOT FILE: 541A306.DWG
DATE PLOTTED: 02/25/99

STREETER & ASSOCIATES
ARCHITECTS AIA

185 UNIVERSITY STREET SEATTLE WA. 98101-2901
206.621.9270 F.206.621.7715 www.streeterarchitects.com

CONSULTANT

SEATTLE SCHOOL DISTRICT

DATE: MARCH, 1999

AS-BUILT

RAINIER BEACH HIGH SCHOOL
PERFORMING ARTS CENTER

BUILDING SECTIONS
& DETAILS -
SECTIONS E & F

PRINCIPAL ARCH:	M STREETER	DATE: 10/01/99
PROJECT MNGR:	S CAMERON	
PROJECT ARCH:	I JAIN	
JOB CAPTAIN:	J MOORE	A-11
DRAWN BY:	JM	
REVIEWED BY:	JAIN	SHEET NO:

NO.	REVISION	DATE	DRAWING NO.

275
021.0

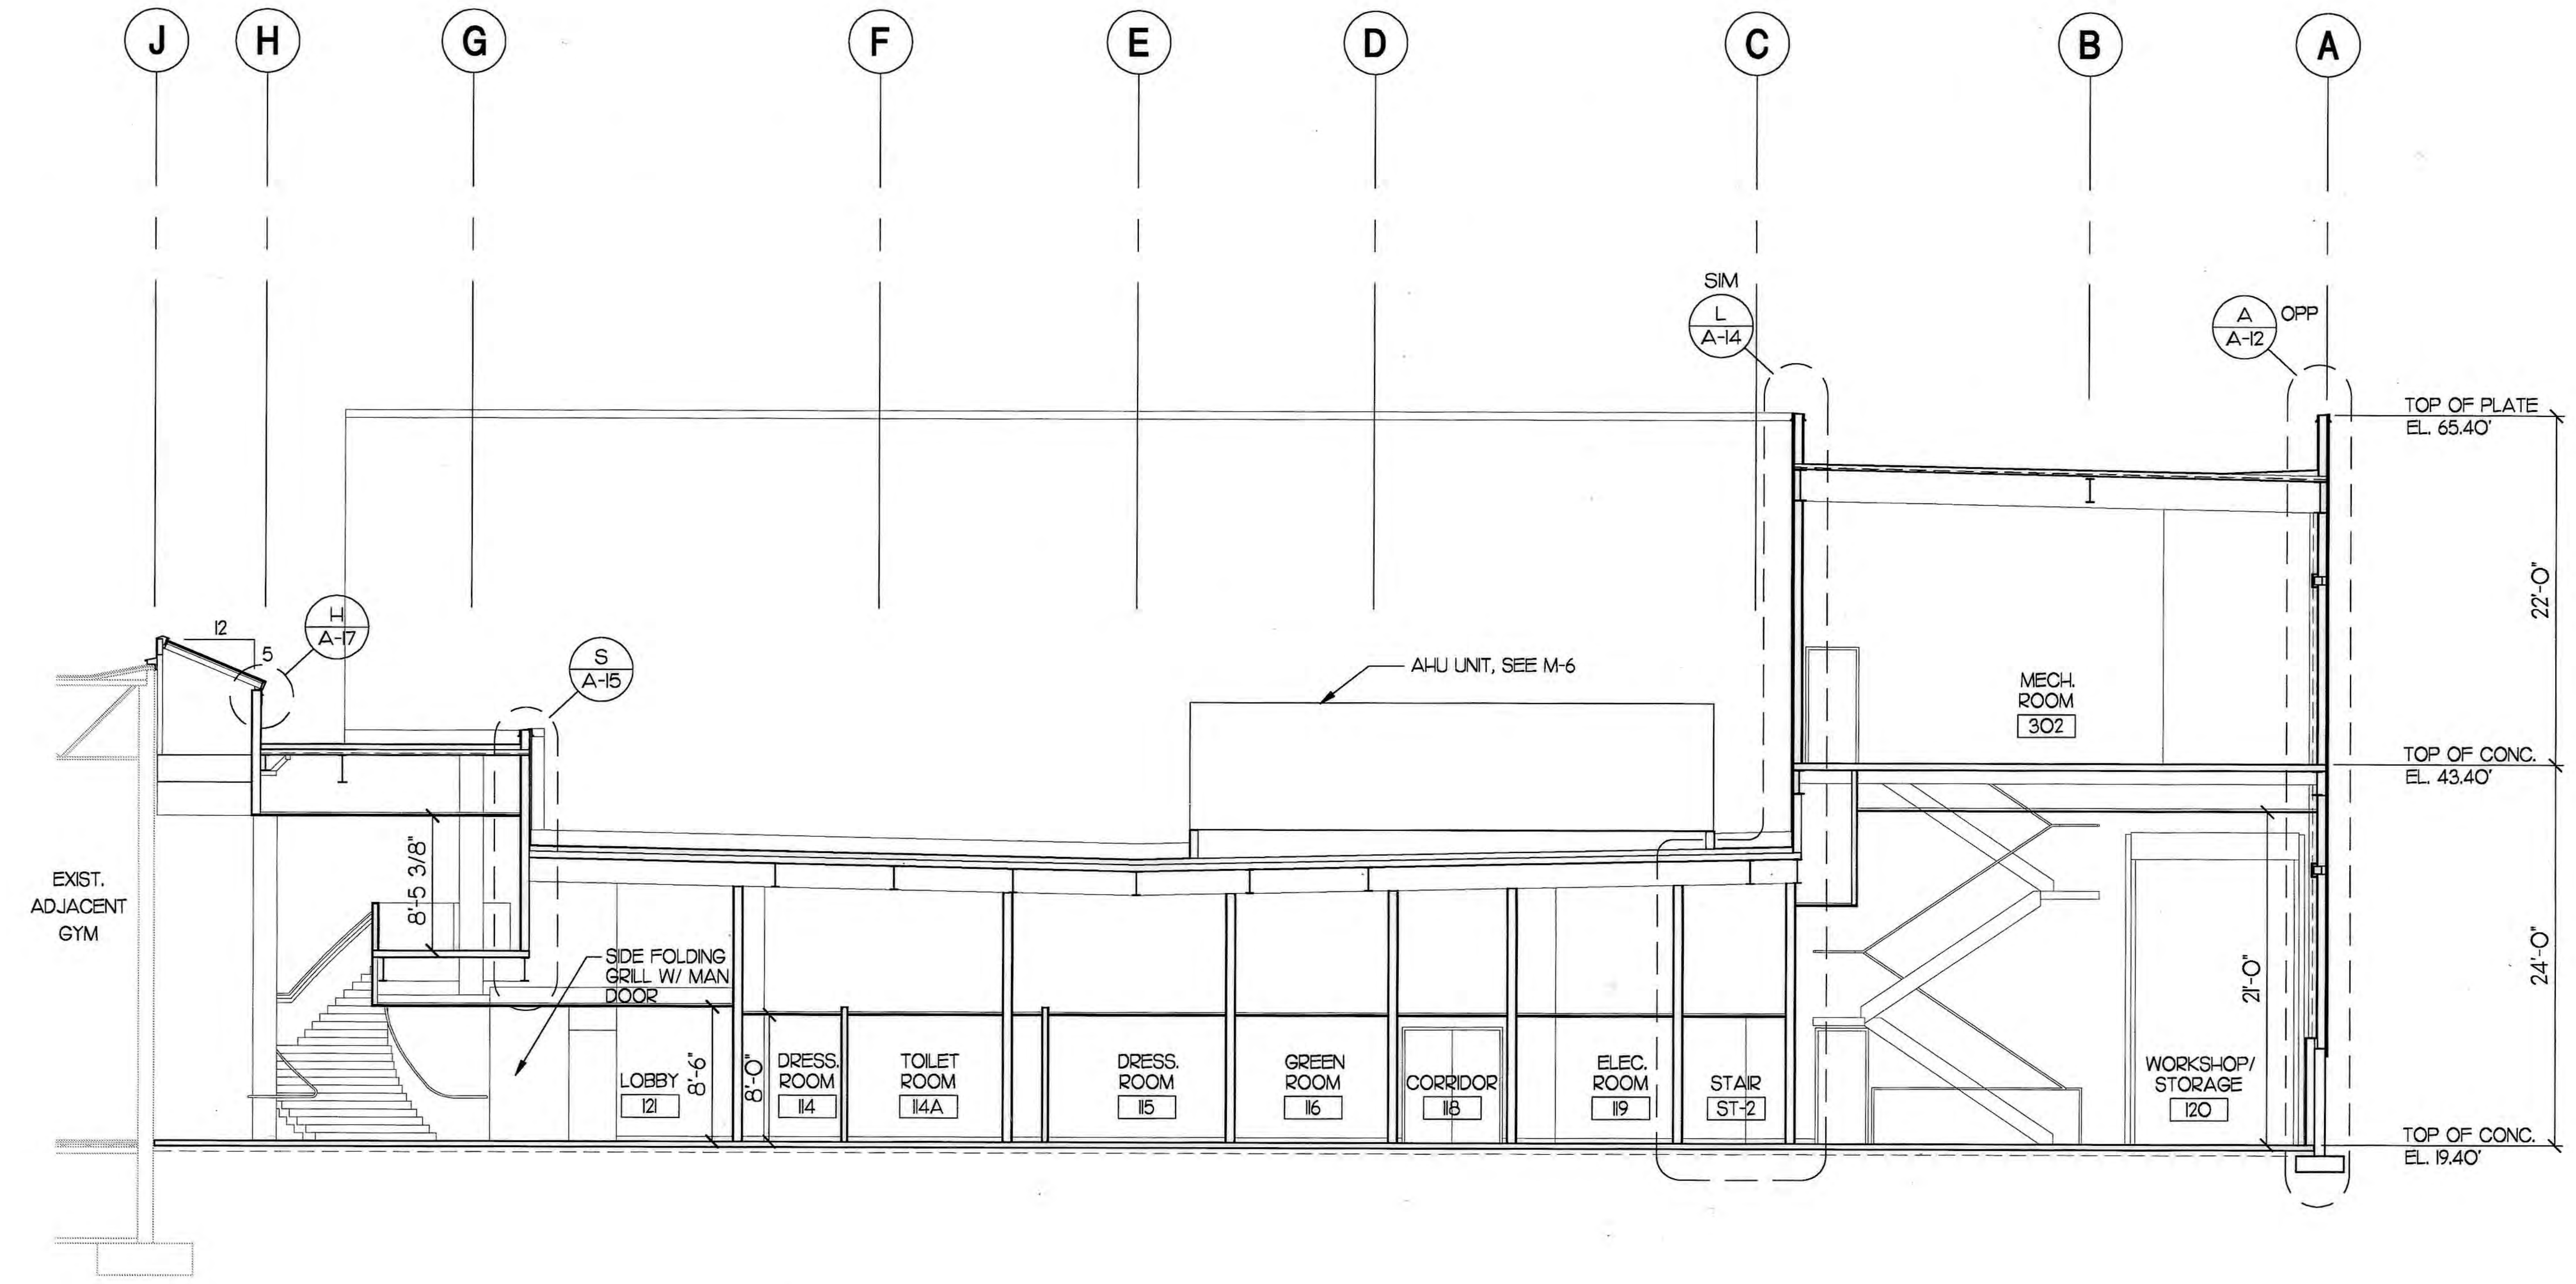

C A-2 BUILDING SECTION
SCALE: 1/8 = 1'-0"

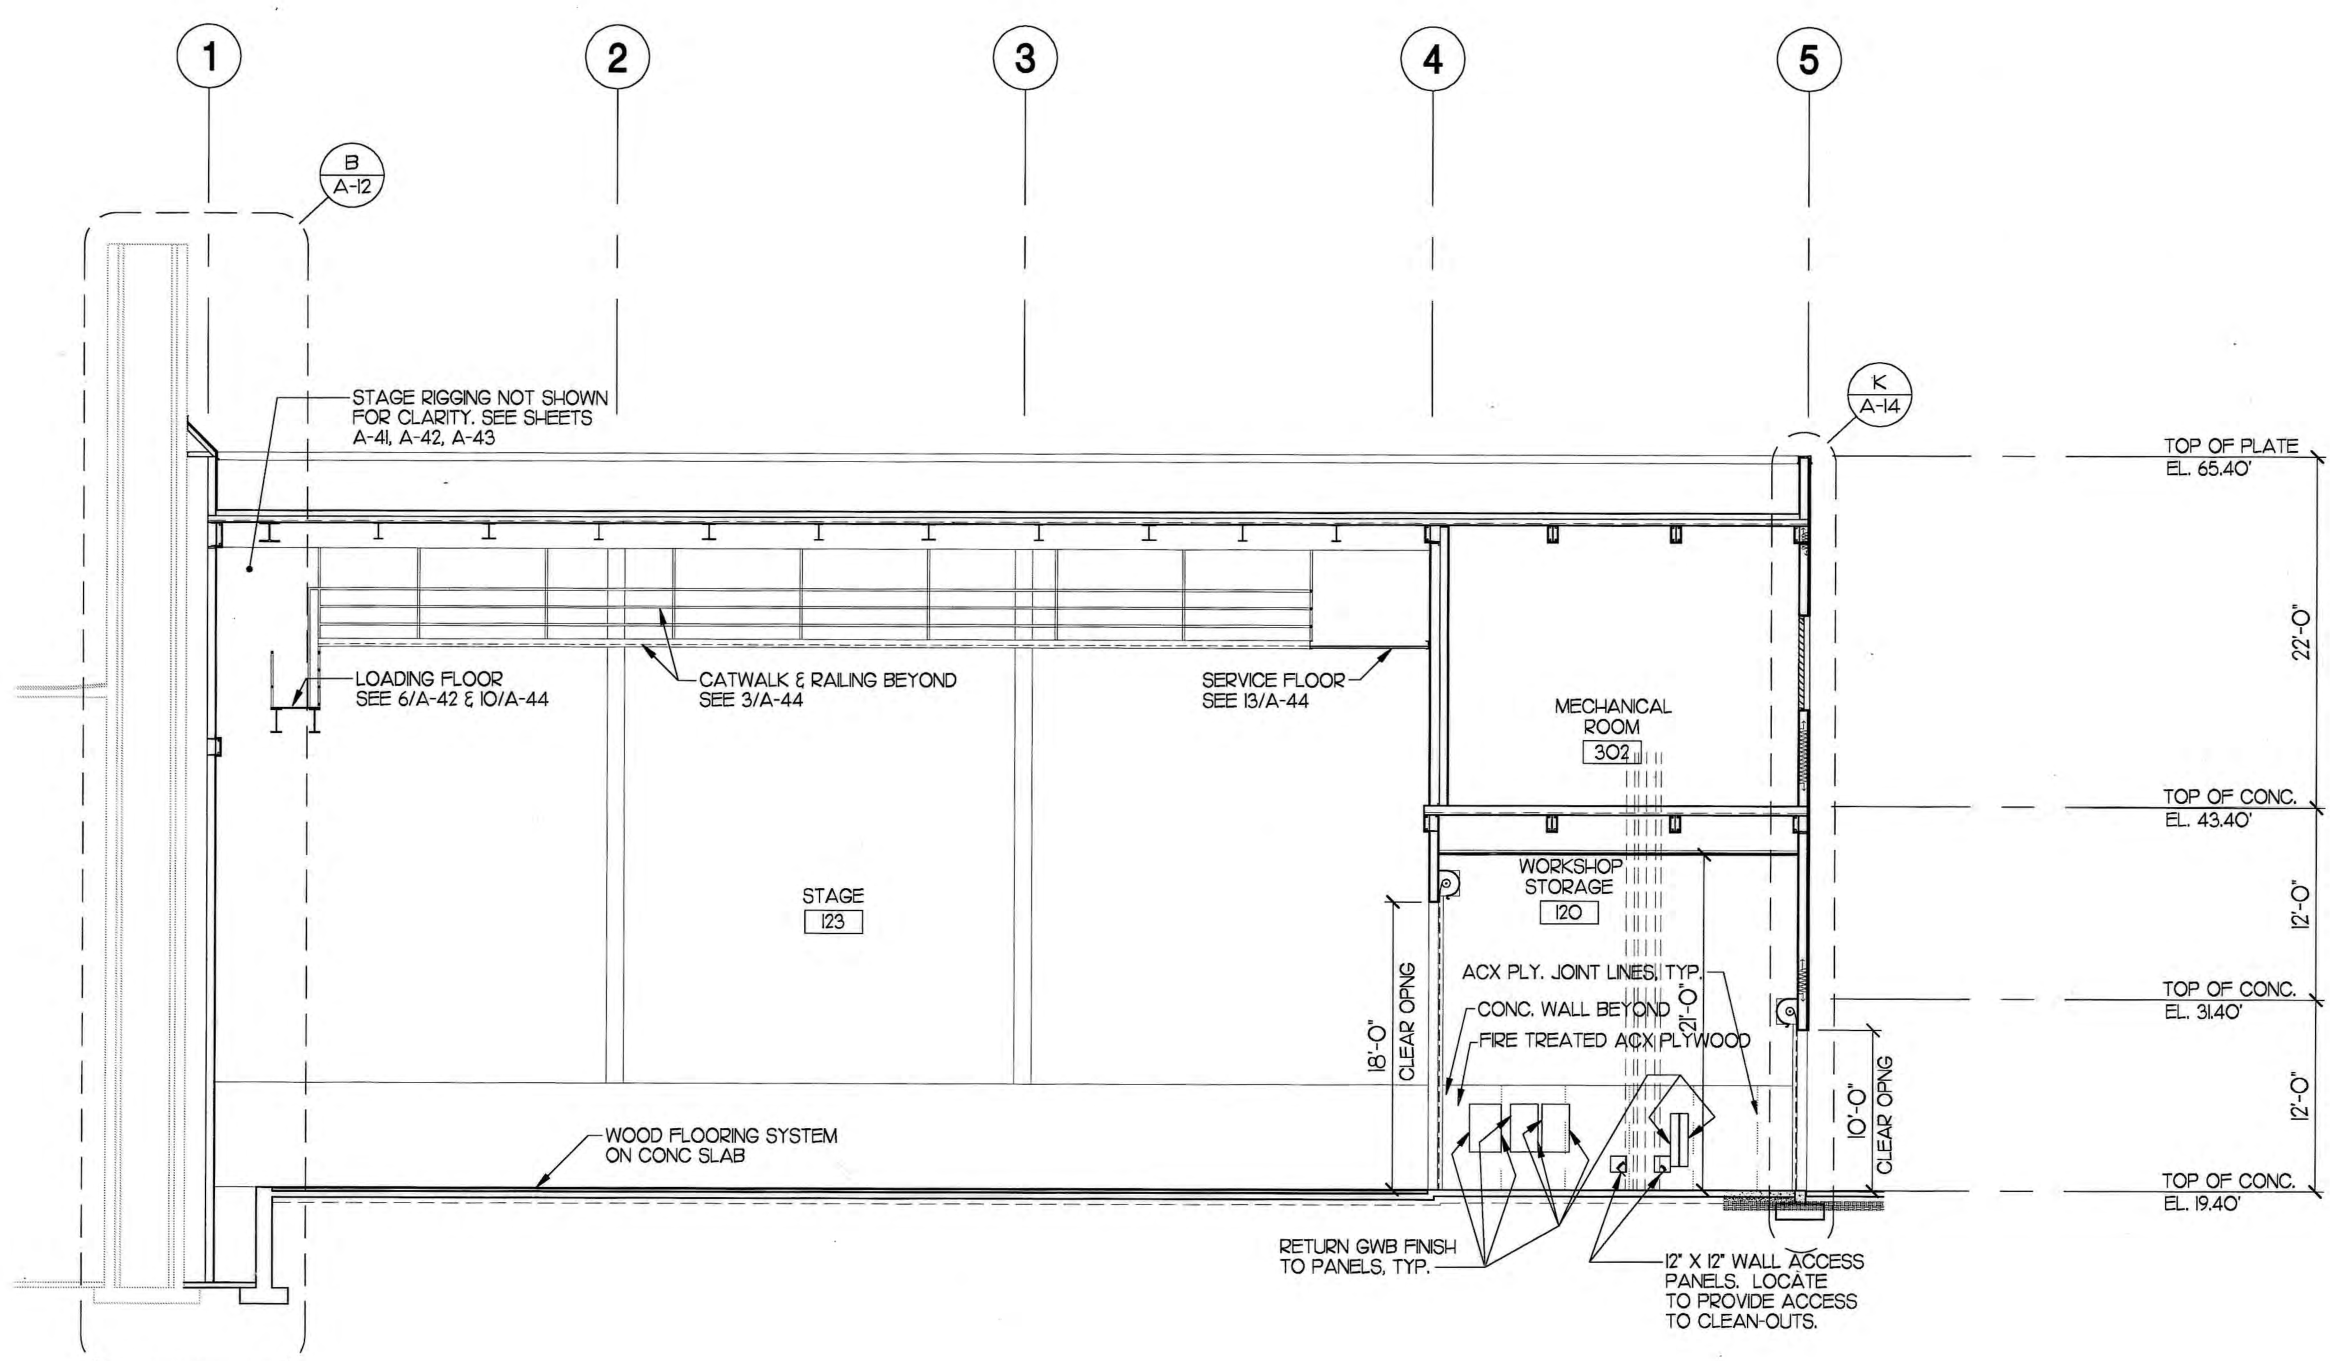

D A-2 BUILDING SECTION
SCALE: 1/8 = 1'-0"

PLOT FILE: 541A303.DWG
DATE PLOTTED: 02/25/99

STREETER & ASSOCIATES ARCHITECTS AIA

185 UNIVERSITY STREET SEATTLE WA. 98101-2901
206.621.9270 F.206.621.7715 www.streeterarchitects.com

CONSULTANT

SEATTLE SCHOOL DISTRICT

DATE: MARCH, 1999 | AS-BUILT

RAINIER BEACH HIGH SCHOOL PERFORMING ARTS CENTER

BUILDING SECTIONS & DETAILS - SECTIONS C & D

PRINCIPAL ARCH: M STREETER
PROJECT MNGR: S CAMERON
PROJECT ARCH: I JAIN
JOB CAPTAIN: J MOORE
DRAWN BY: JM
REVIEWED BY: JAIN

DATE: 10/01/99

A-10

SHEET NO:

NO.	REVISION	DATE	DRAWING NO.

274
021-0

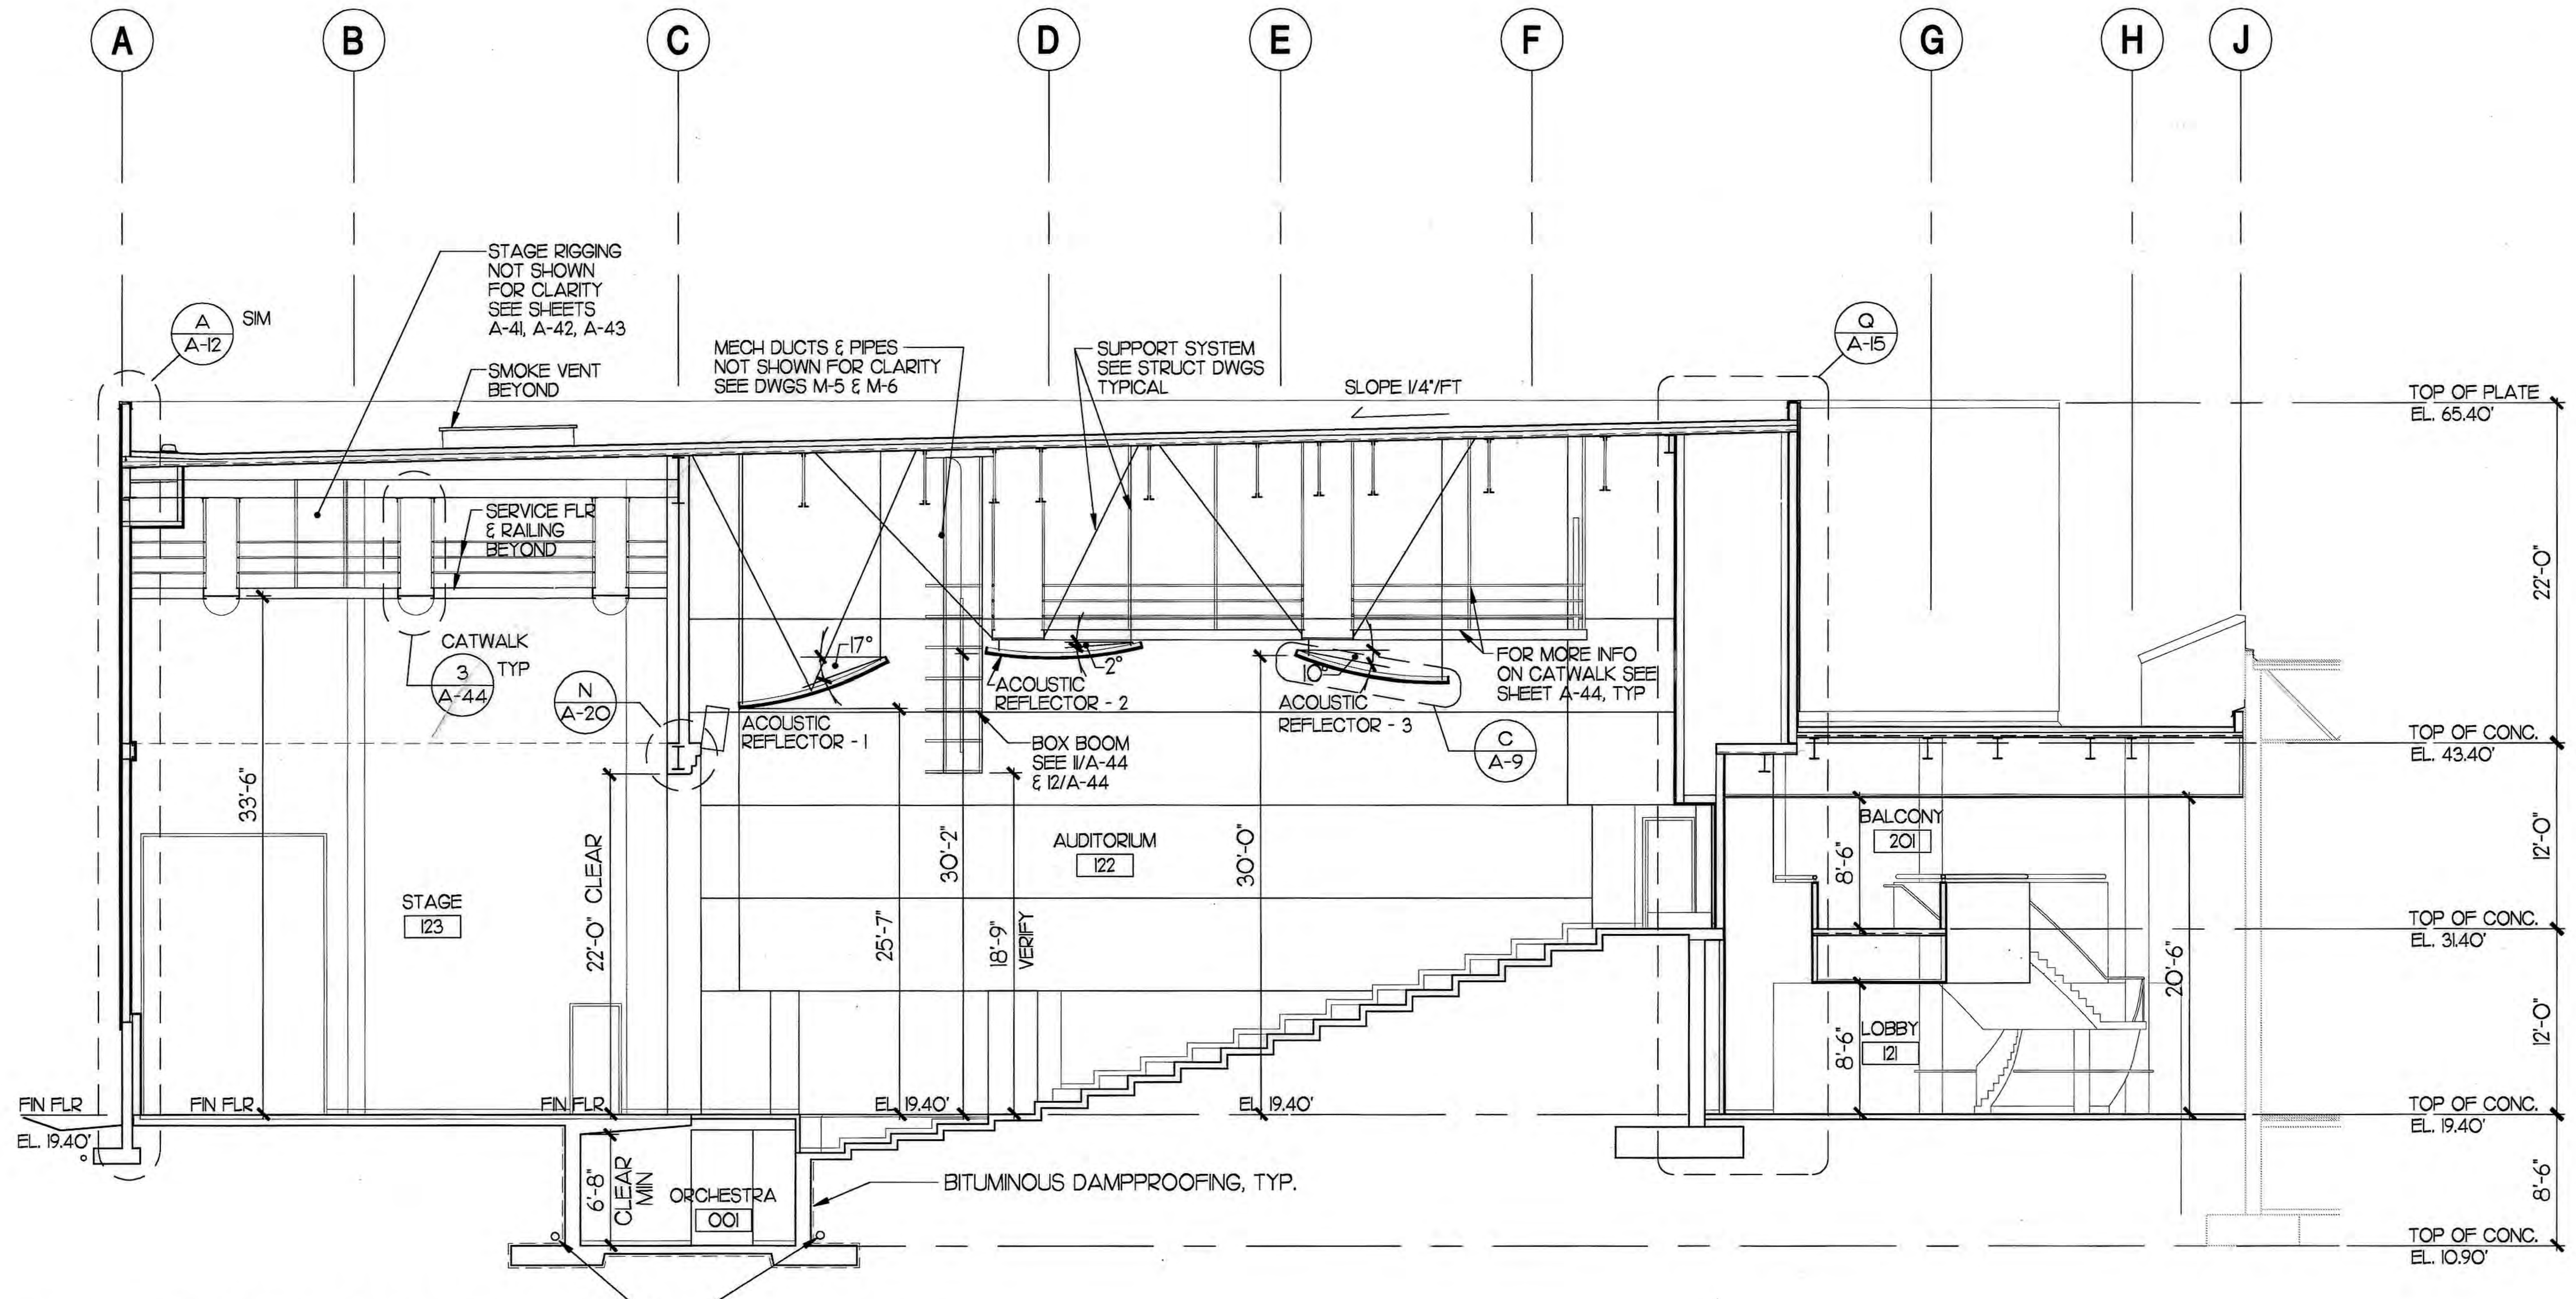

A
A-2
BUILDING SECTION
SCALE: 1/8 = 1'-0"

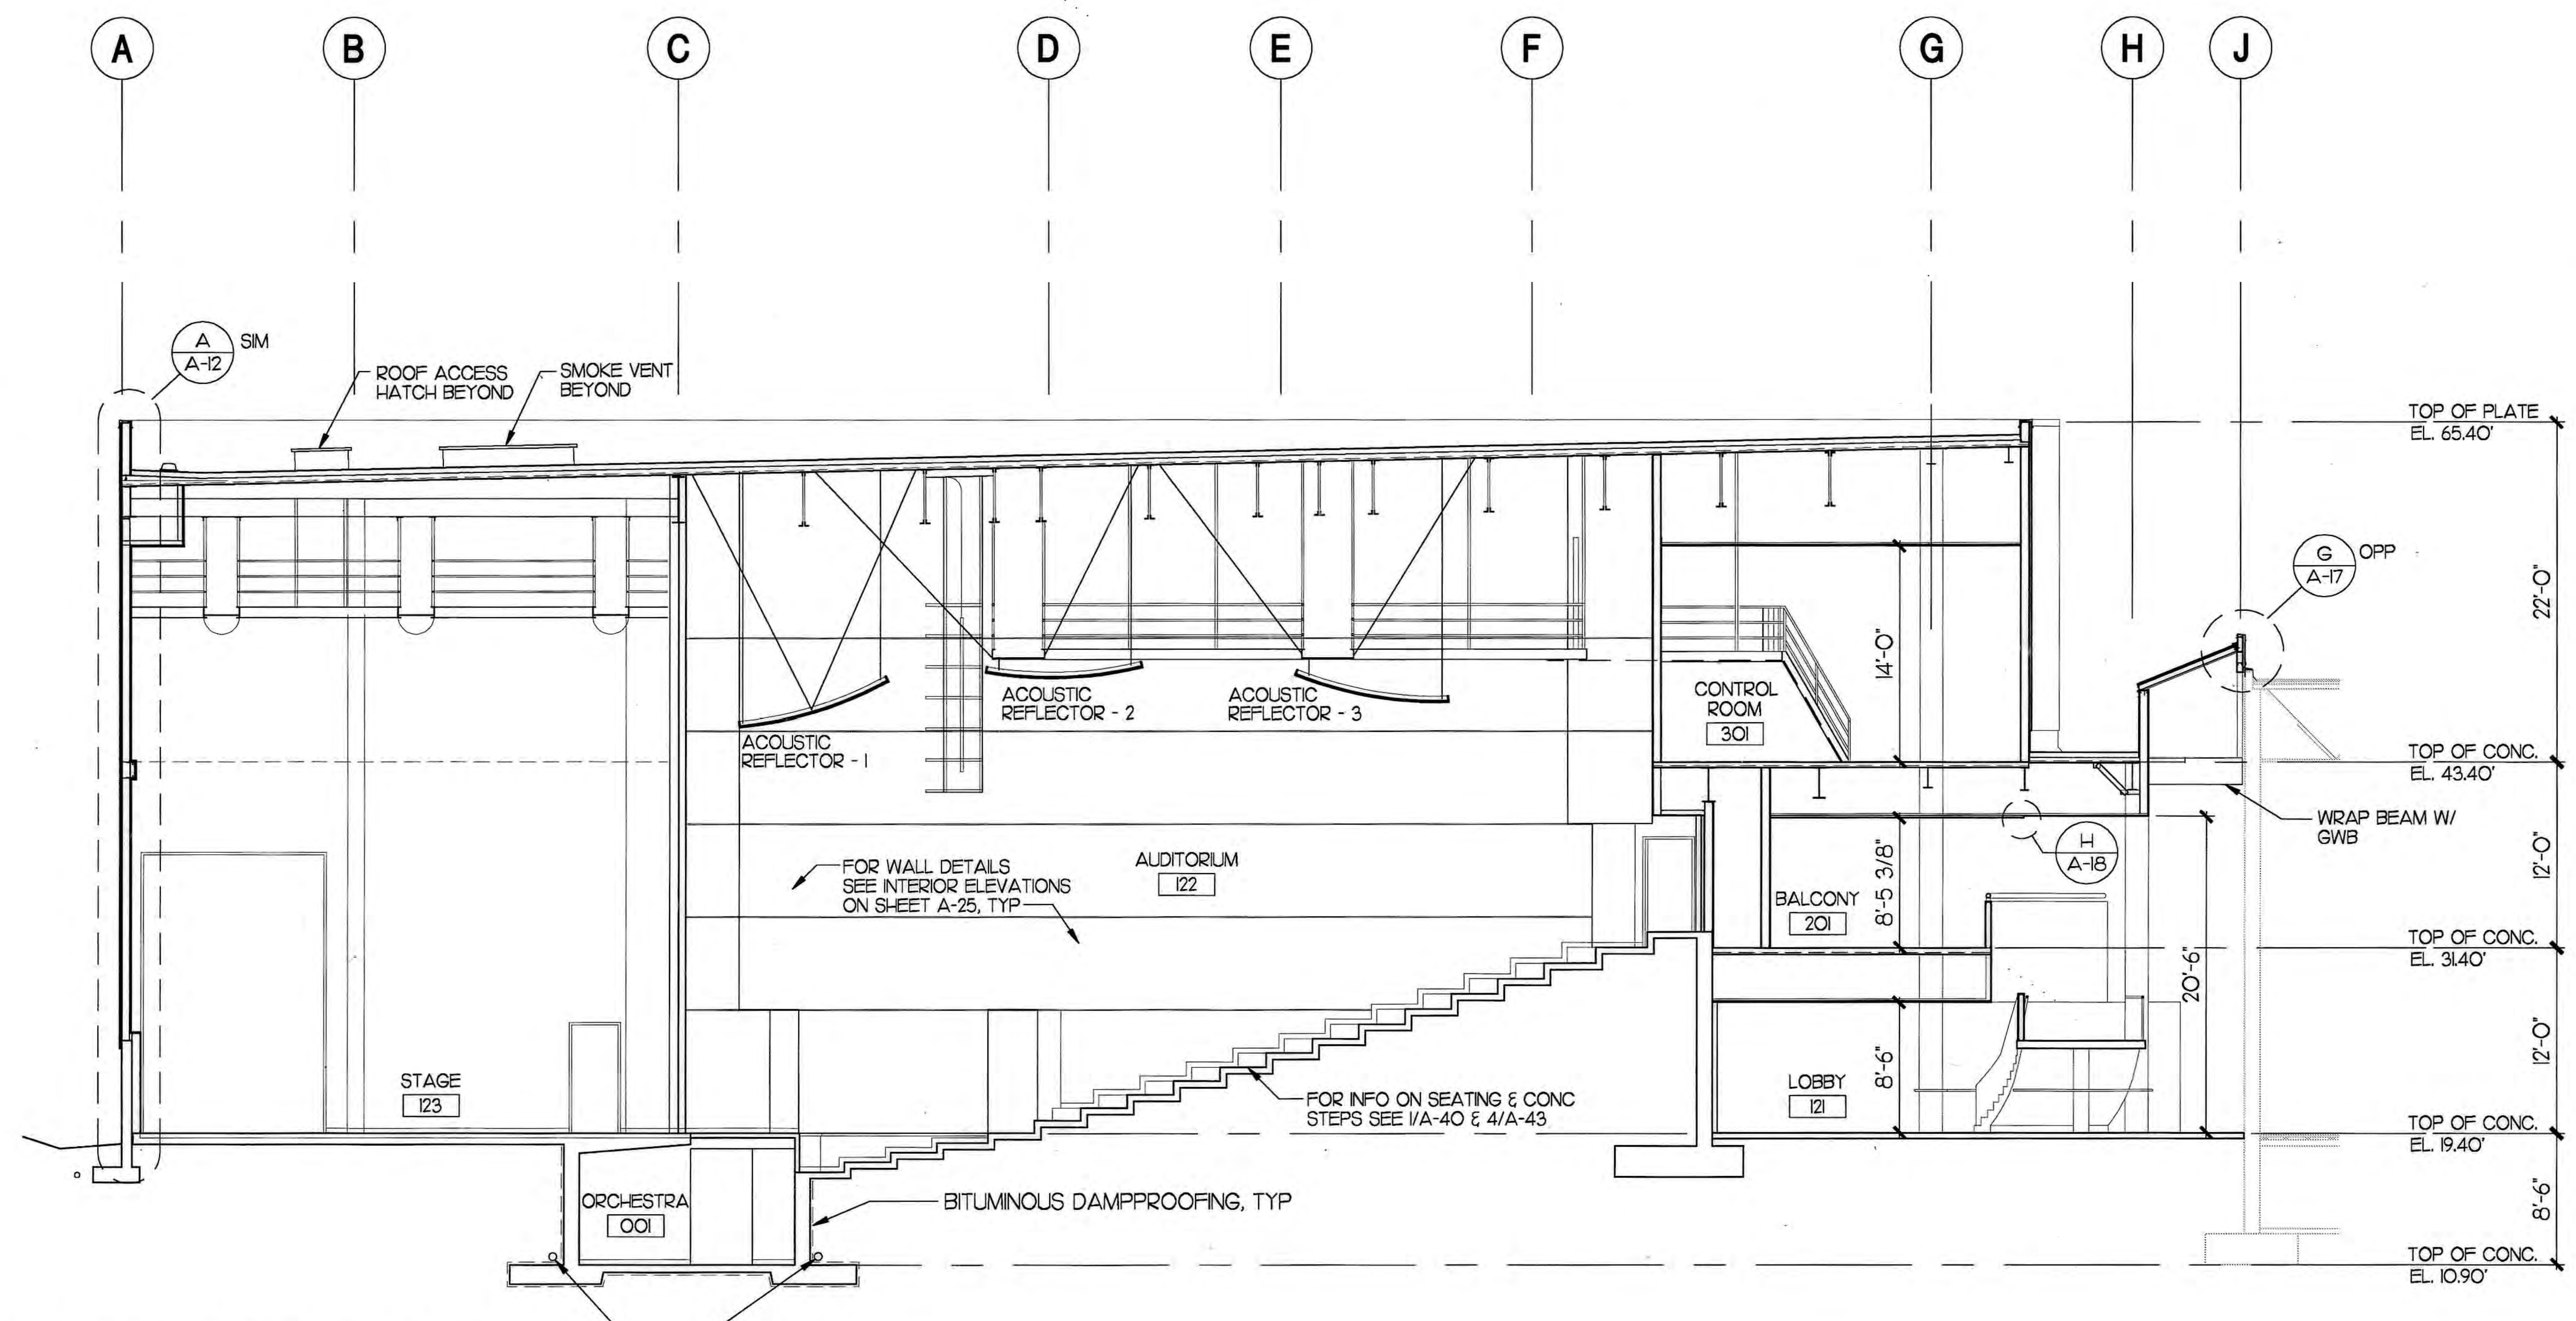

B
A-2
BUILDING SECTION
SCALE: 1/8 = 1'-0"

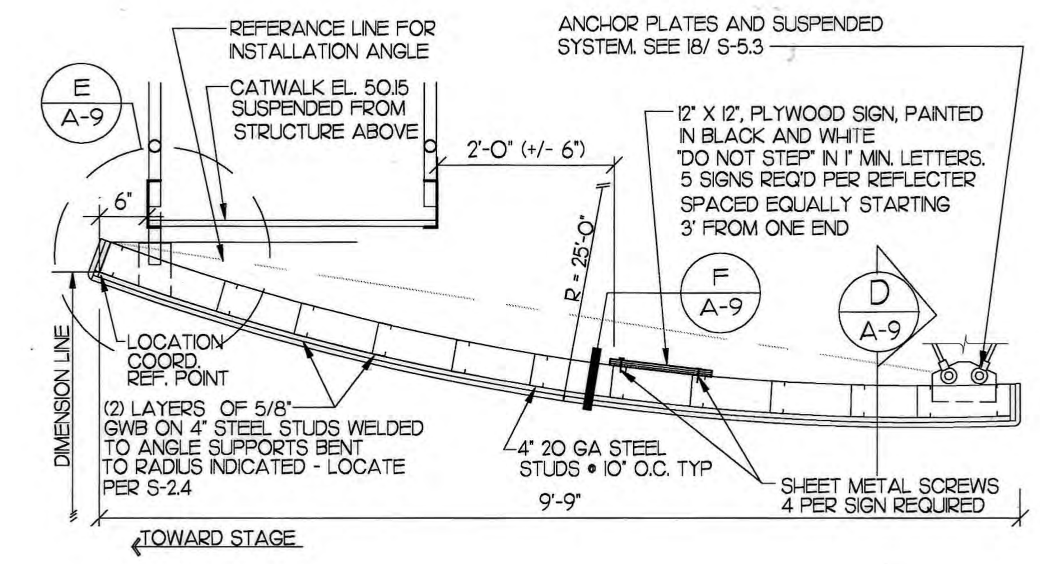

C
A-9
TYPICAL CEILING REFLECTOR SECTION
SCALE: 3/4" = 1'-0"

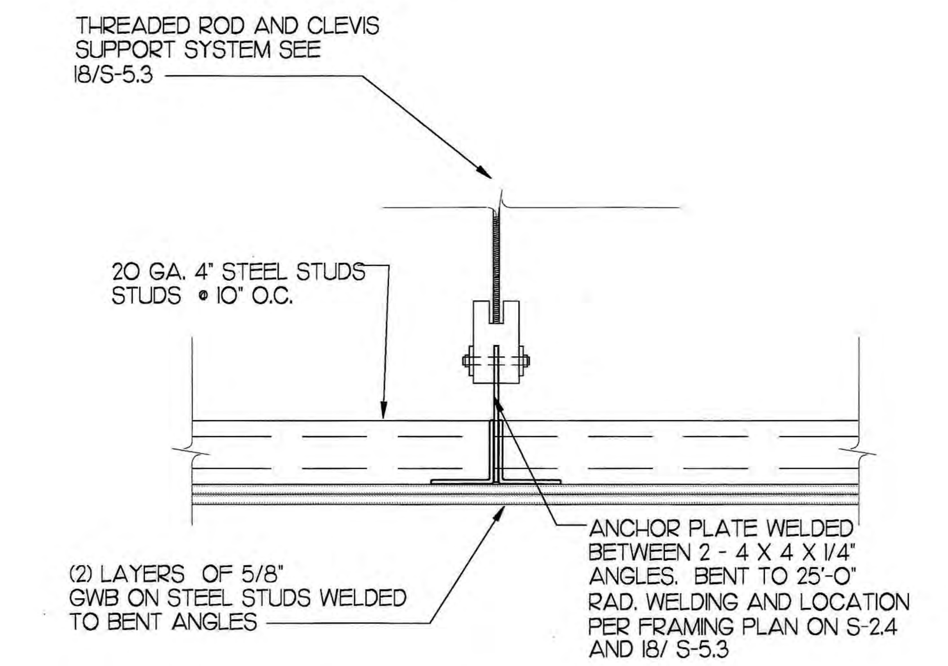

D
A-9
AUDITORIUM CEILING REFLECTOR
SCALE: 1 1/2 = 1'-0"

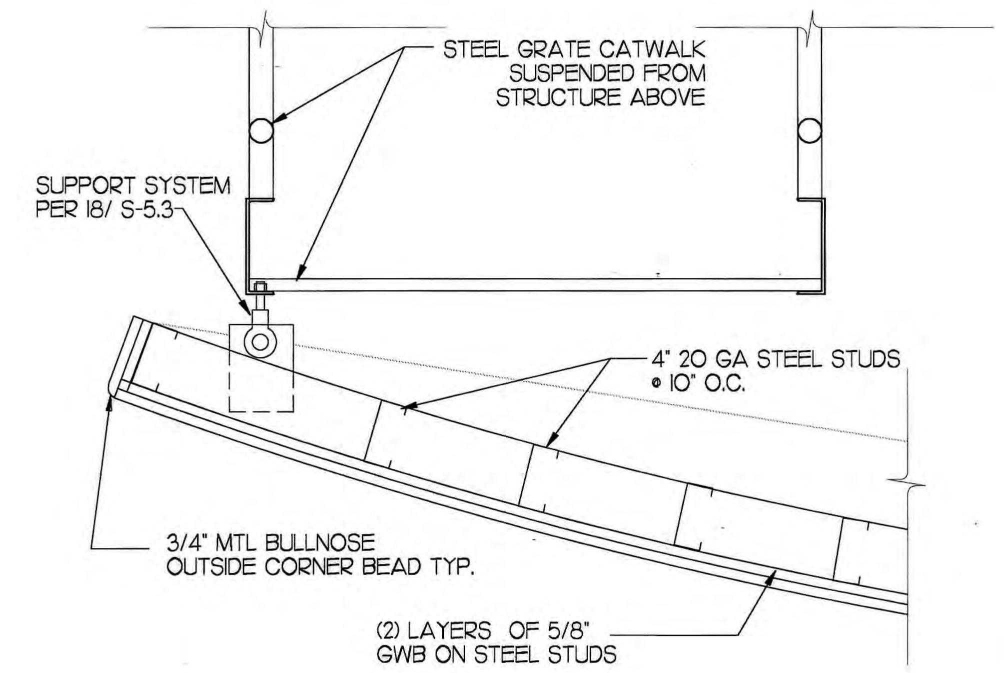

E
A-9
DETAIL
SCALE: 1 1/2 = 1'-0"

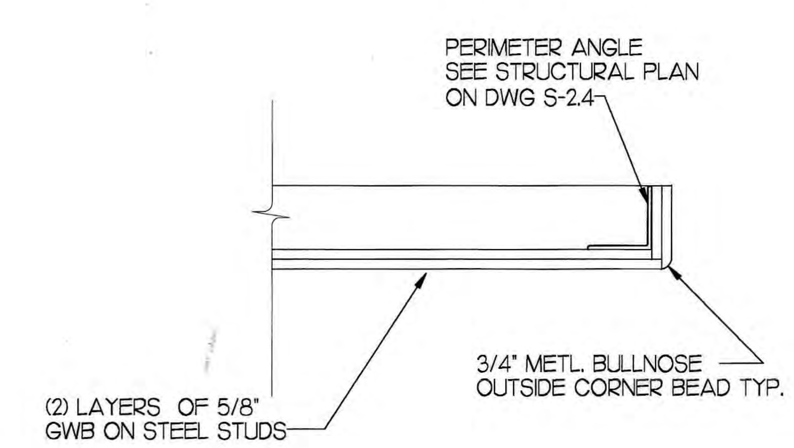

F
A-9
CEILING REFLECTOR EDGE
SCALE: 1 1/2 = 1'-0"

STREETER & ASSOCIATES ARCHITECTS AIA

185 UNIVERSITY STREET SEATTLE WA. 98101-2901
206.621.9270 F.206.621.7715 www.streeterarchitects.com

CONSULTANT

SEATTLE SCHOOL DISTRICT

DATE: MARCH, 1999

AS-BUILT

RAINIER BEACH HIGH SCHOOL PERFORMING ARTS CENTER

BUILDING SECTIONS & DETAILS - SECTIONS A & B

PRINCIPAL ARCH:	M STREETER	DATE:	10/01/99
PROJECT MNGR:	S CAMERON		
PROJECT ARCH:	I JAIN		A-9
JOB CAPTAIN:	J MOORE		
DRAWN BY:	JM		
REVIEWED BY:	JAIN	SHEET NO:	

NO.	REVISION	DATE	DRAWING NO.

PLOT FILE: 541A302.DWG
DATE PLOTTED: 02/25/99

273
021-0

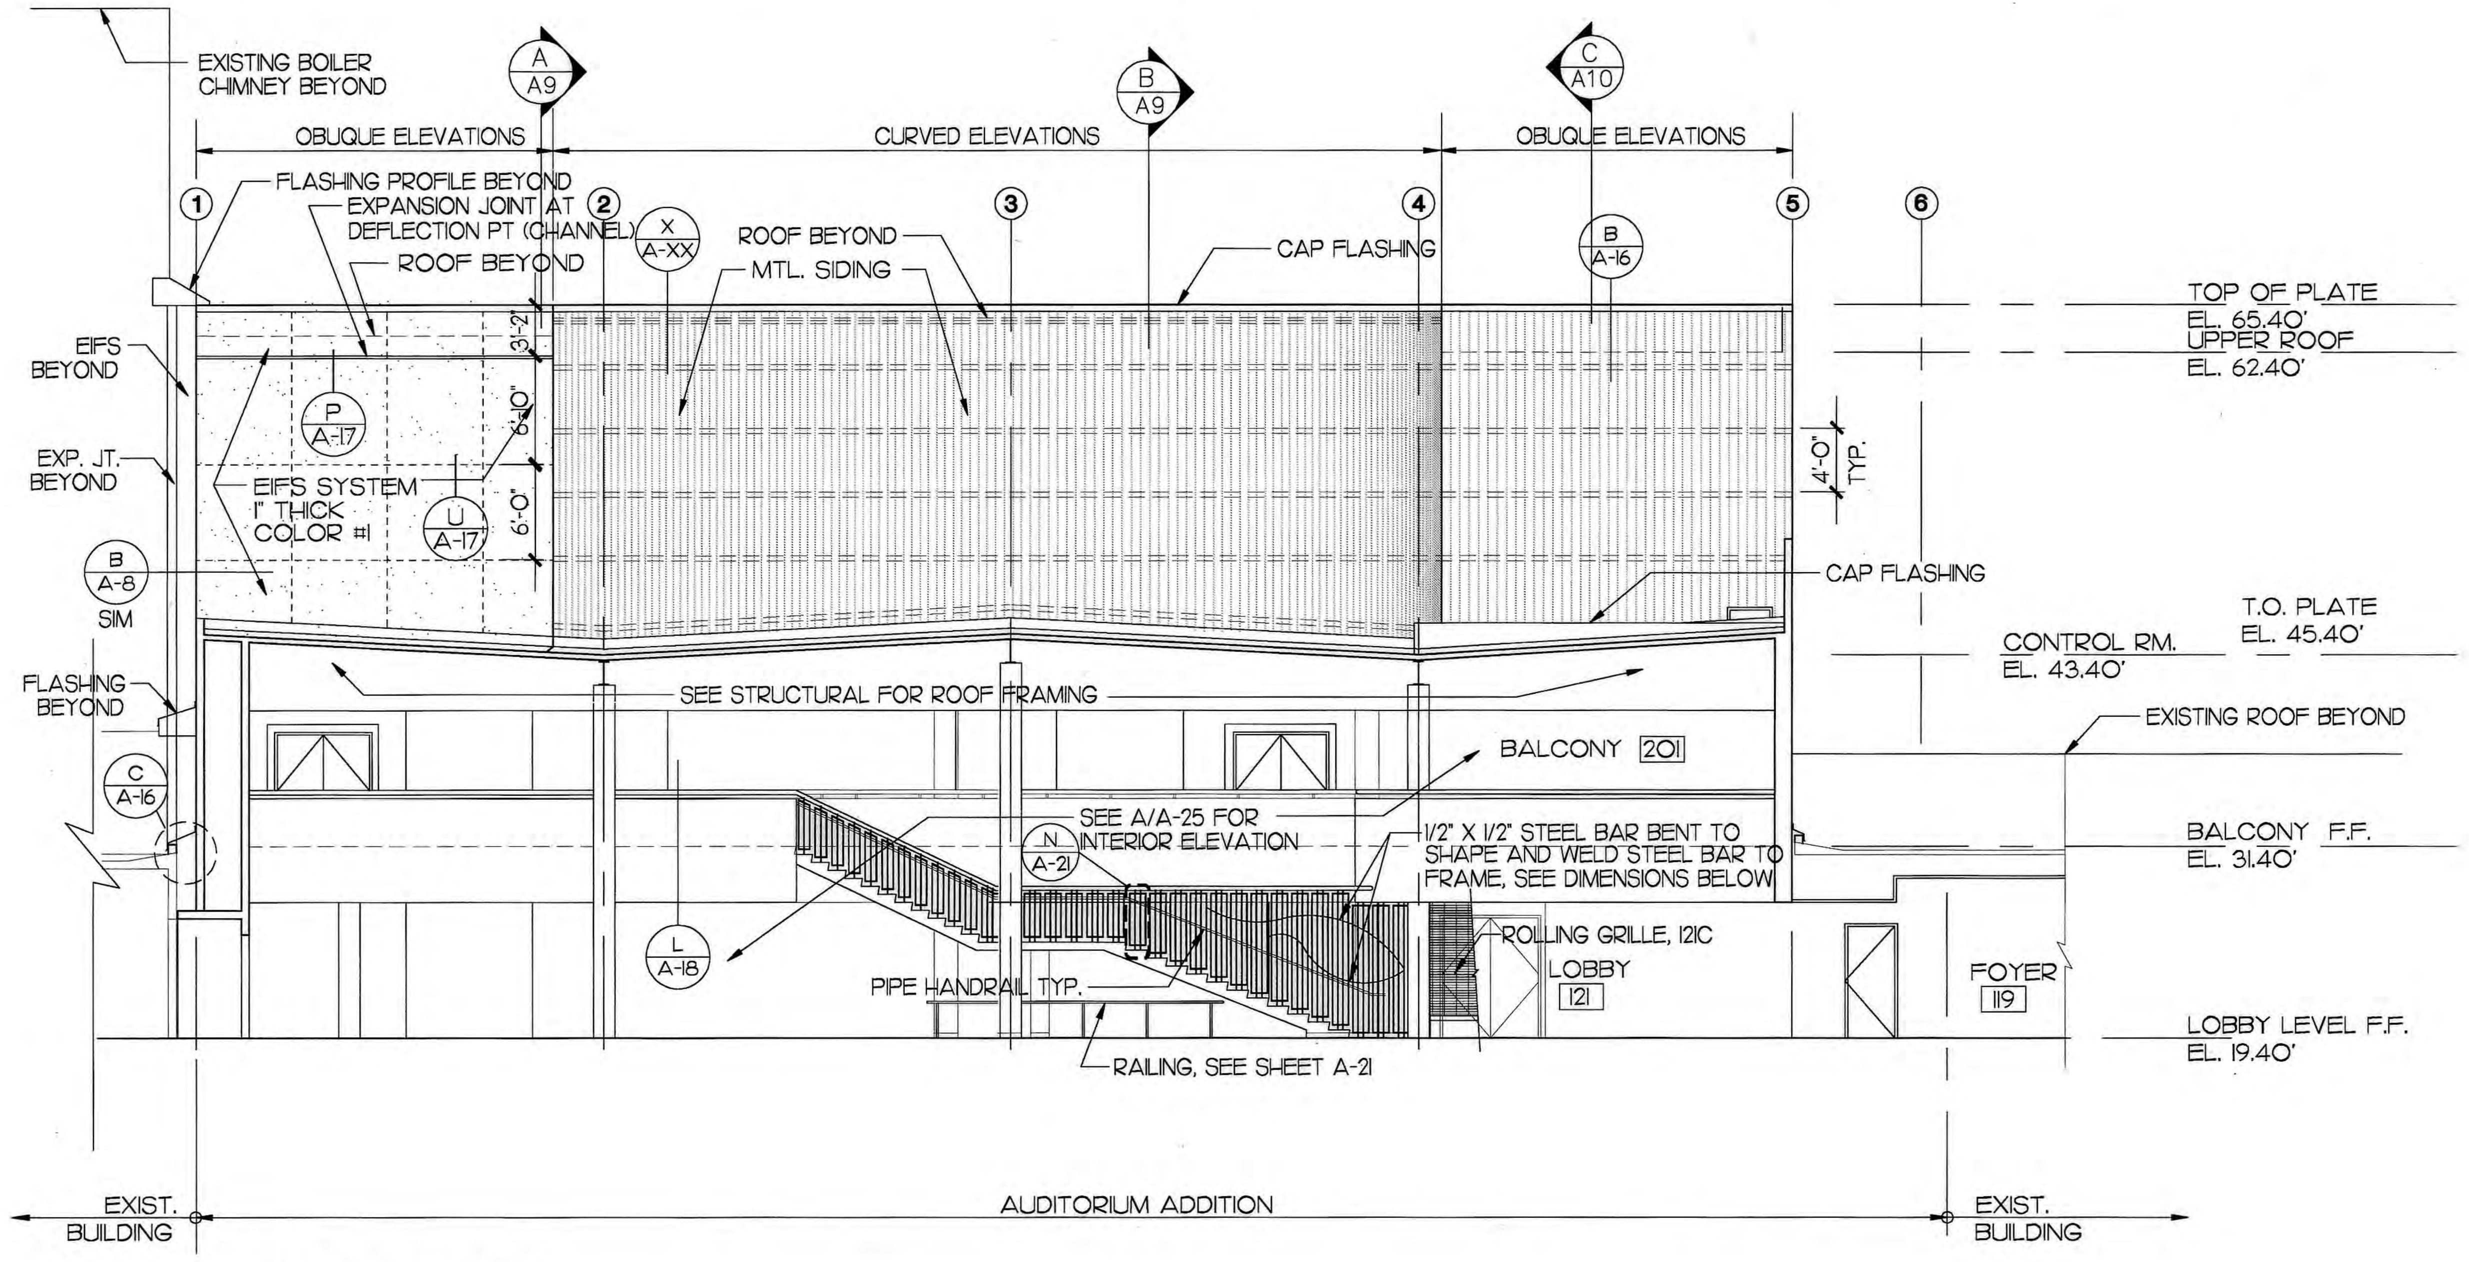

C A-2 **WEST ELEVATION**
SCALE: 1/8" = 1'-0"

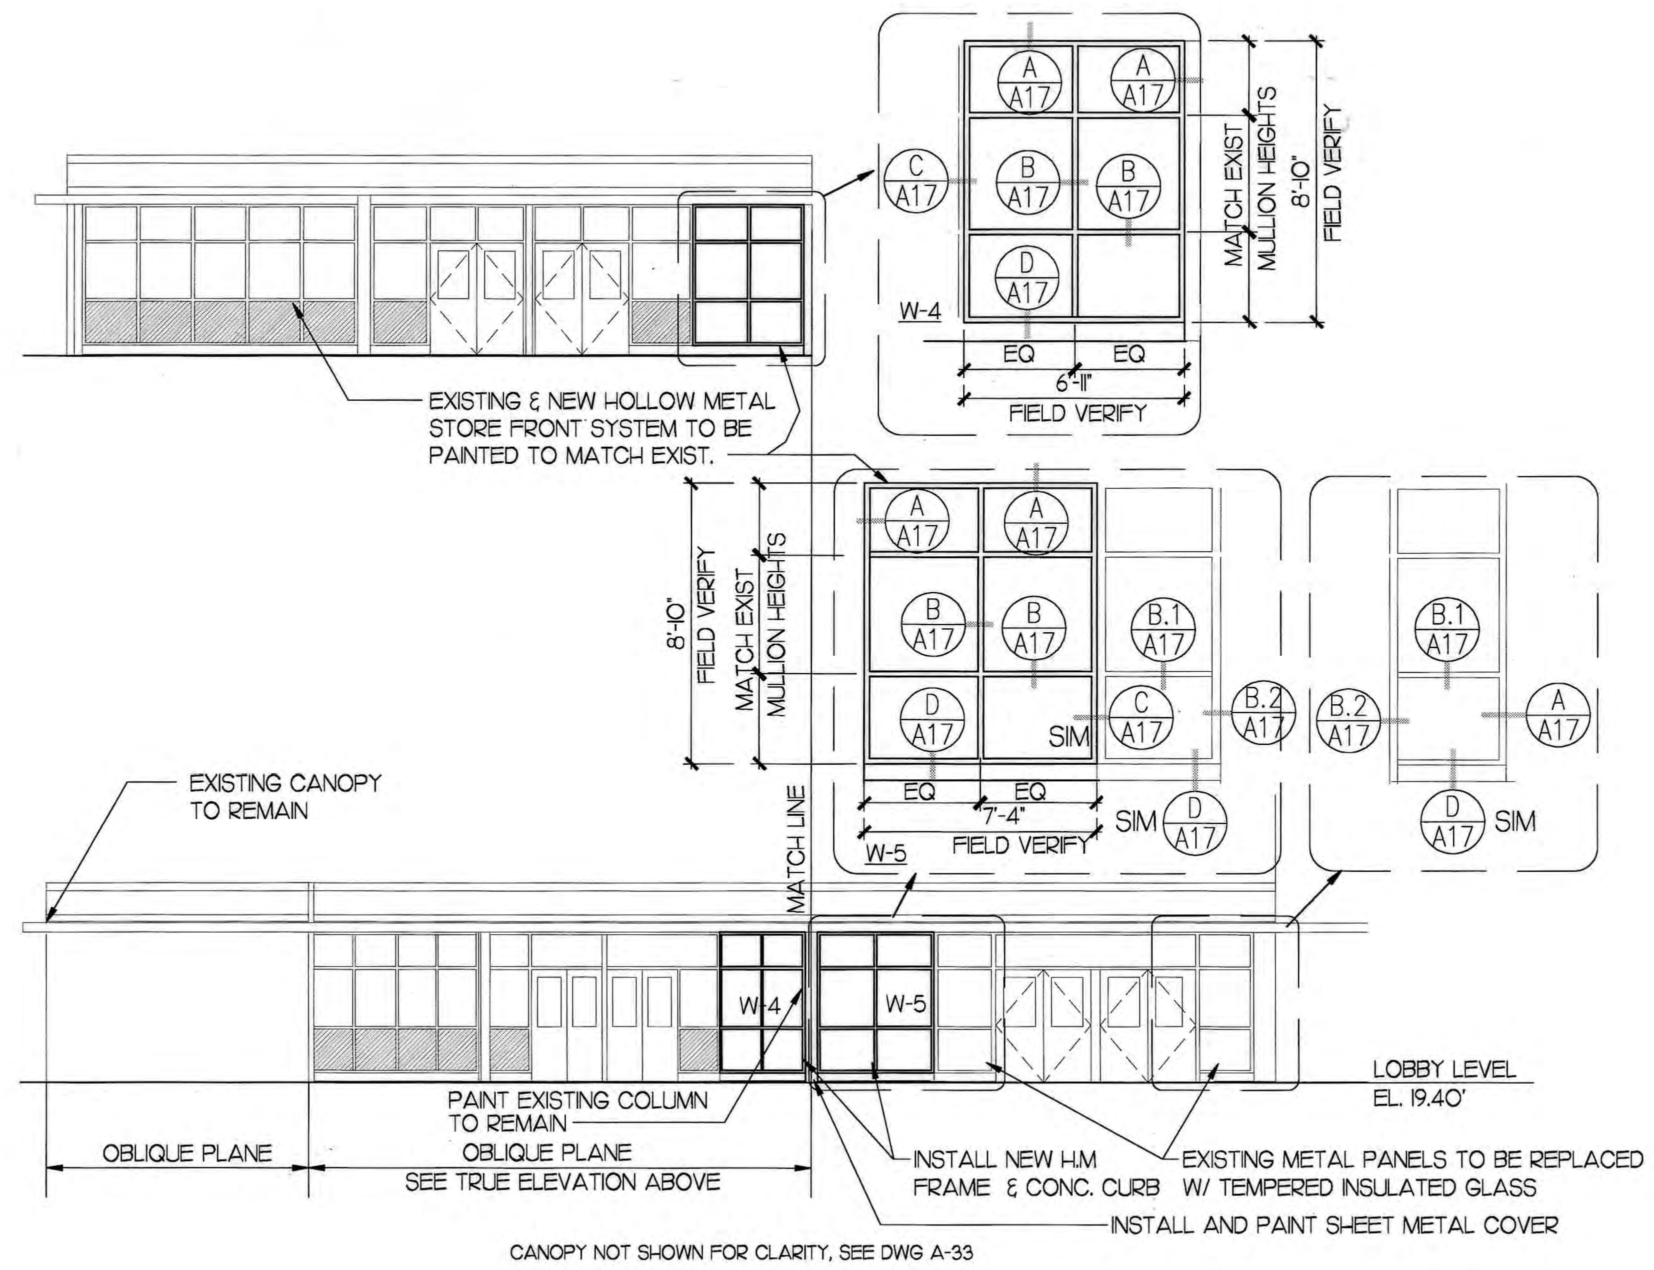

E A-33 **ENTRY ELEVATION**
SCALE: 1/8" = 1'-0"

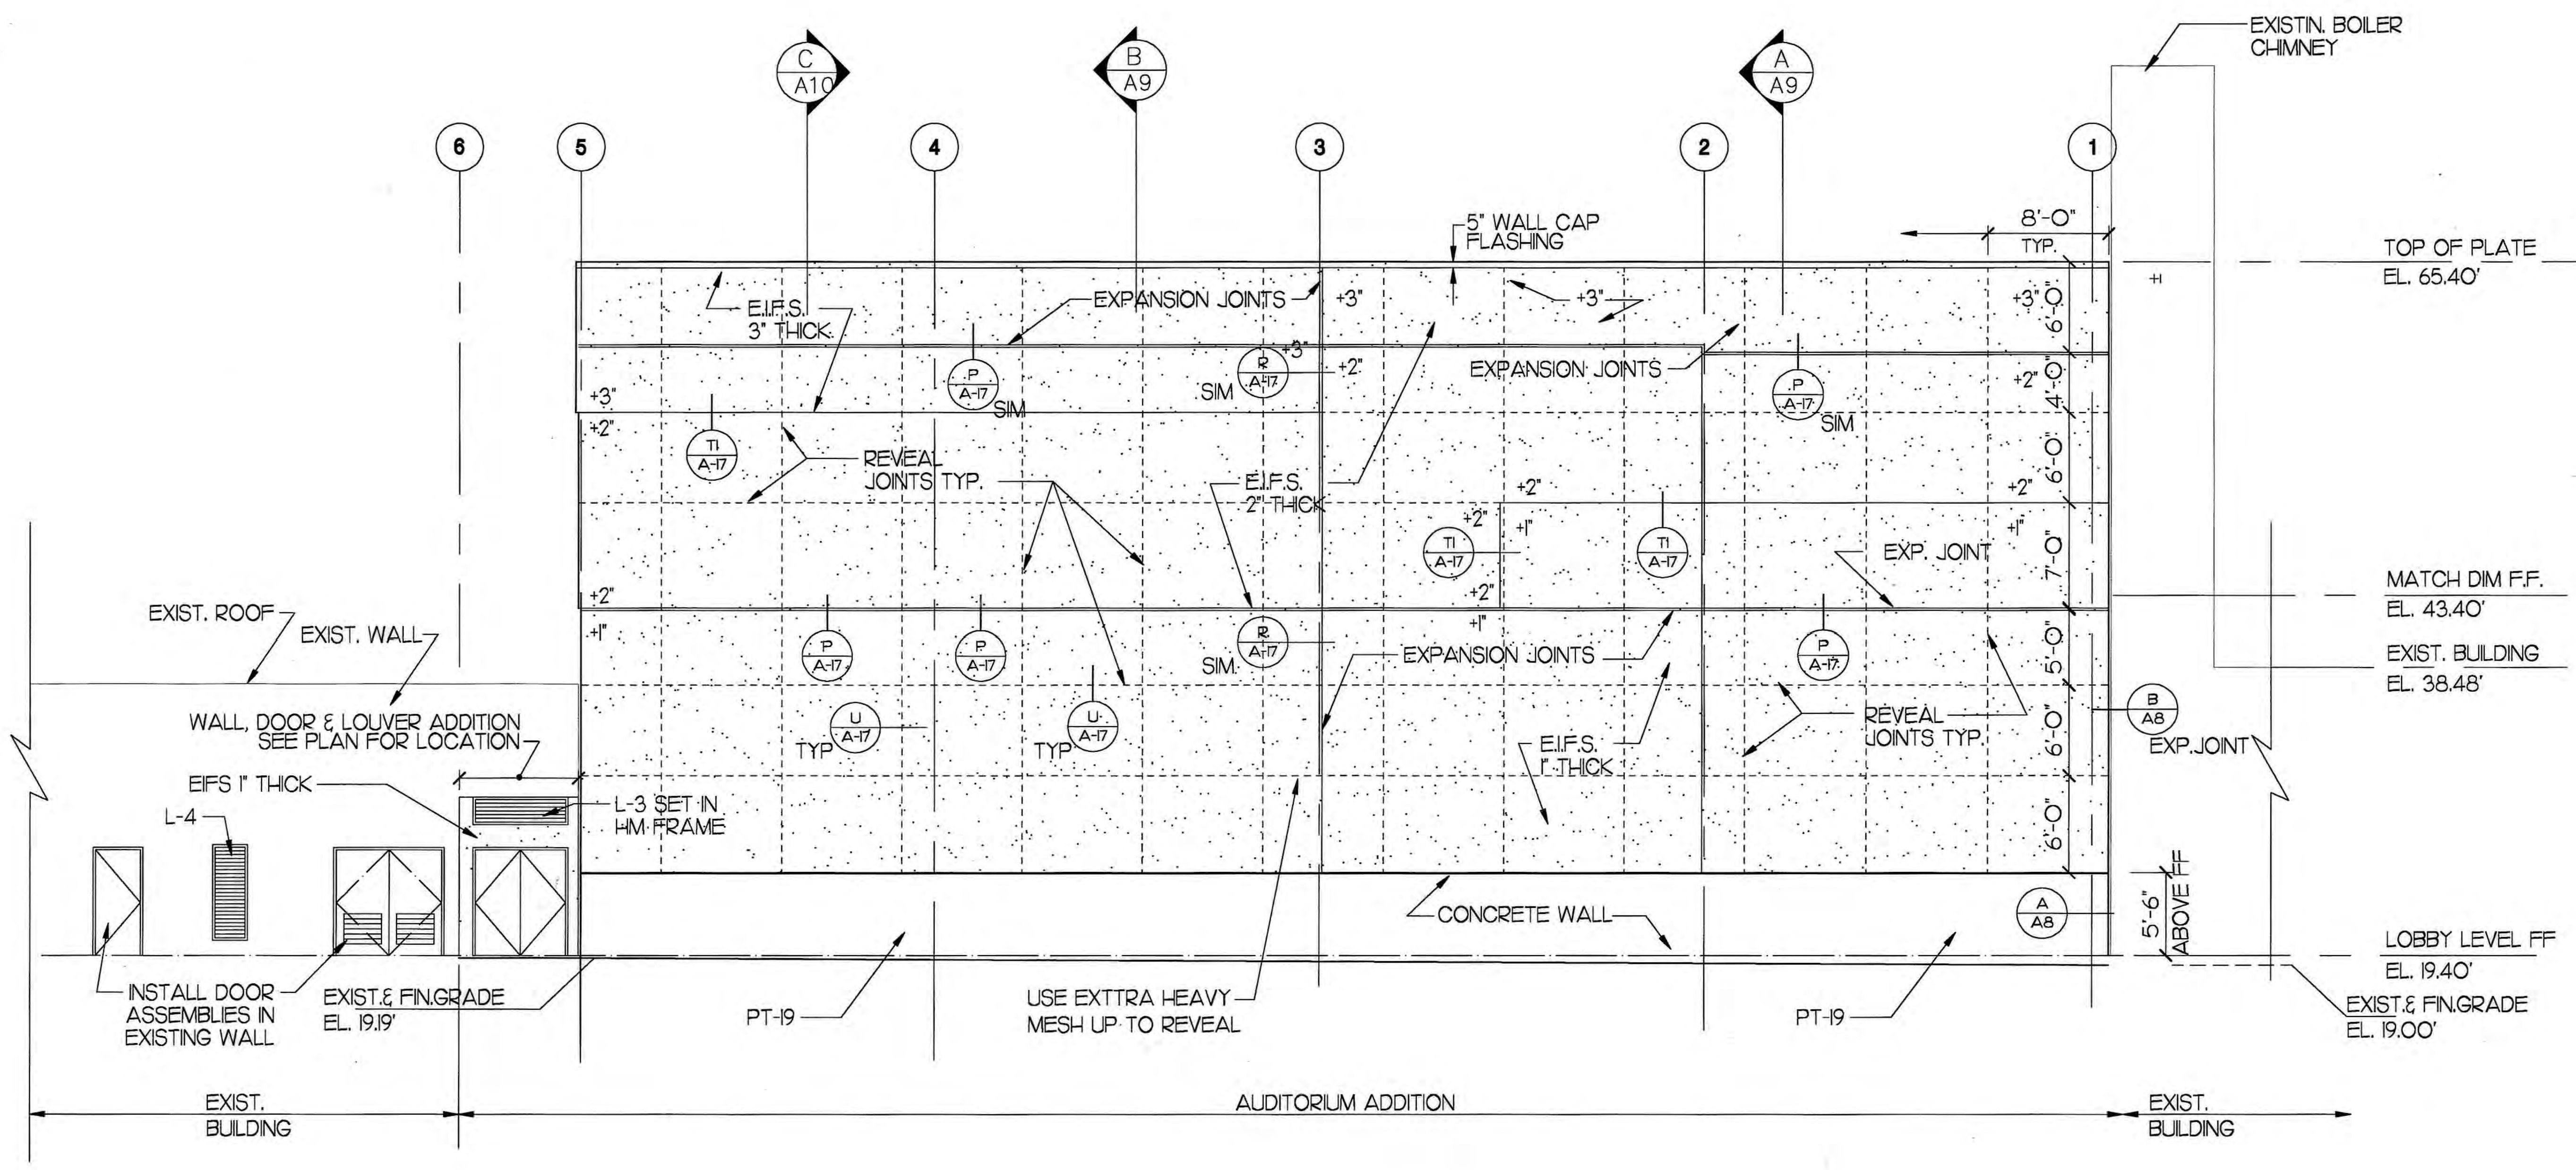

D A-2 **EAST ELEVATION**
SCALE: 1/8" = 1'-0"

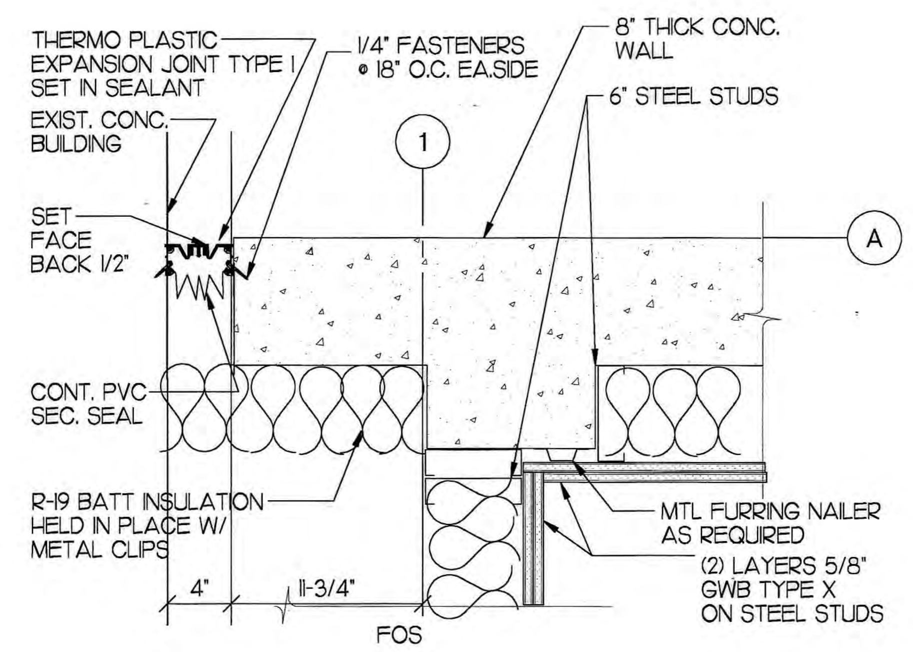

A A-8 **EXTERIOR EXPANSION JOINT**
SCALE: 1 1/2" = 1'-0"

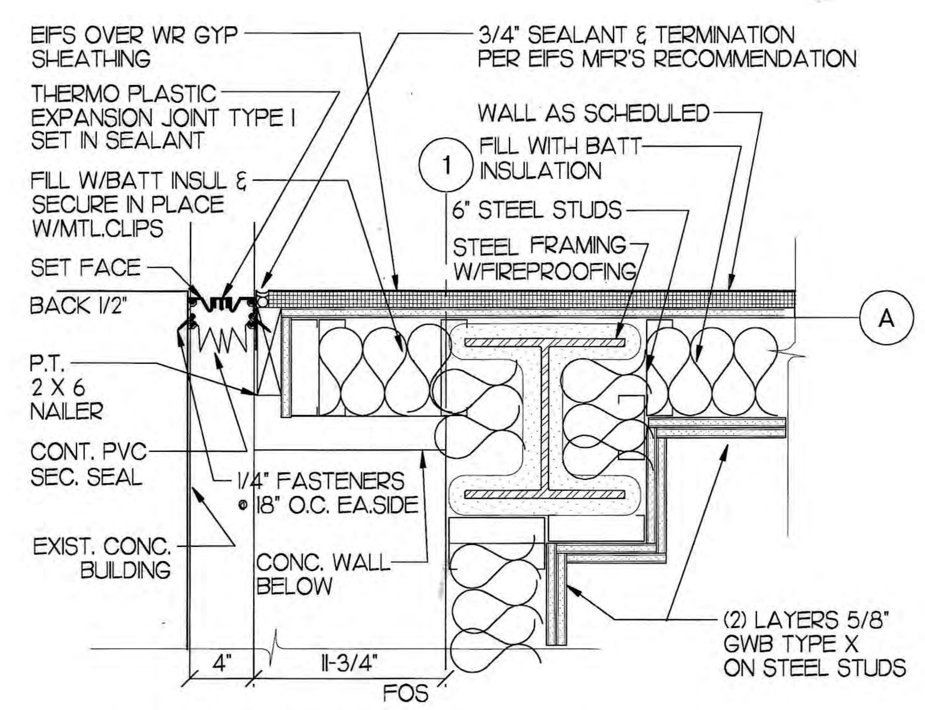

B A-8 **EXTERIOR EXPANSION JOINT**
SCALE: 1 1/2" = 1'-0"

PLOT FILE: 541A304.DWG
DATE PLOTTED: 02/25/99

STREETER & ASSOCIATES ARCHITECTS AIA

185 UNIVERSITY STREET SEATTLE WA. 98101-2901
206.621.9270 F.206.621.7715 www.streeterarchitects.com

CONSULTANT

SEATTLE SCHOOL DISTRICT

DATE: MARCH, 1999

AS-BUILT

RAINIER BEACH HIGH SCHOOL PERFORMING ARTS CENTER

ELEVATIONS & DETAILS - WEST, EAST & ENTRY

PRINCIPAL ARCH:	M STREETER
PROJECT MNGR:	S CAMERON
PROJECT ARCH:	I JAIN
JOB CAPTAIN:	J MOORE
DRAWN BY:	STAFF
REVIEWED BY:	JAIN

DATE: 10/01/99

A-8

SHEET NO:

NO.	REVISION	DATE	DRAWING NO.

272

021- 0

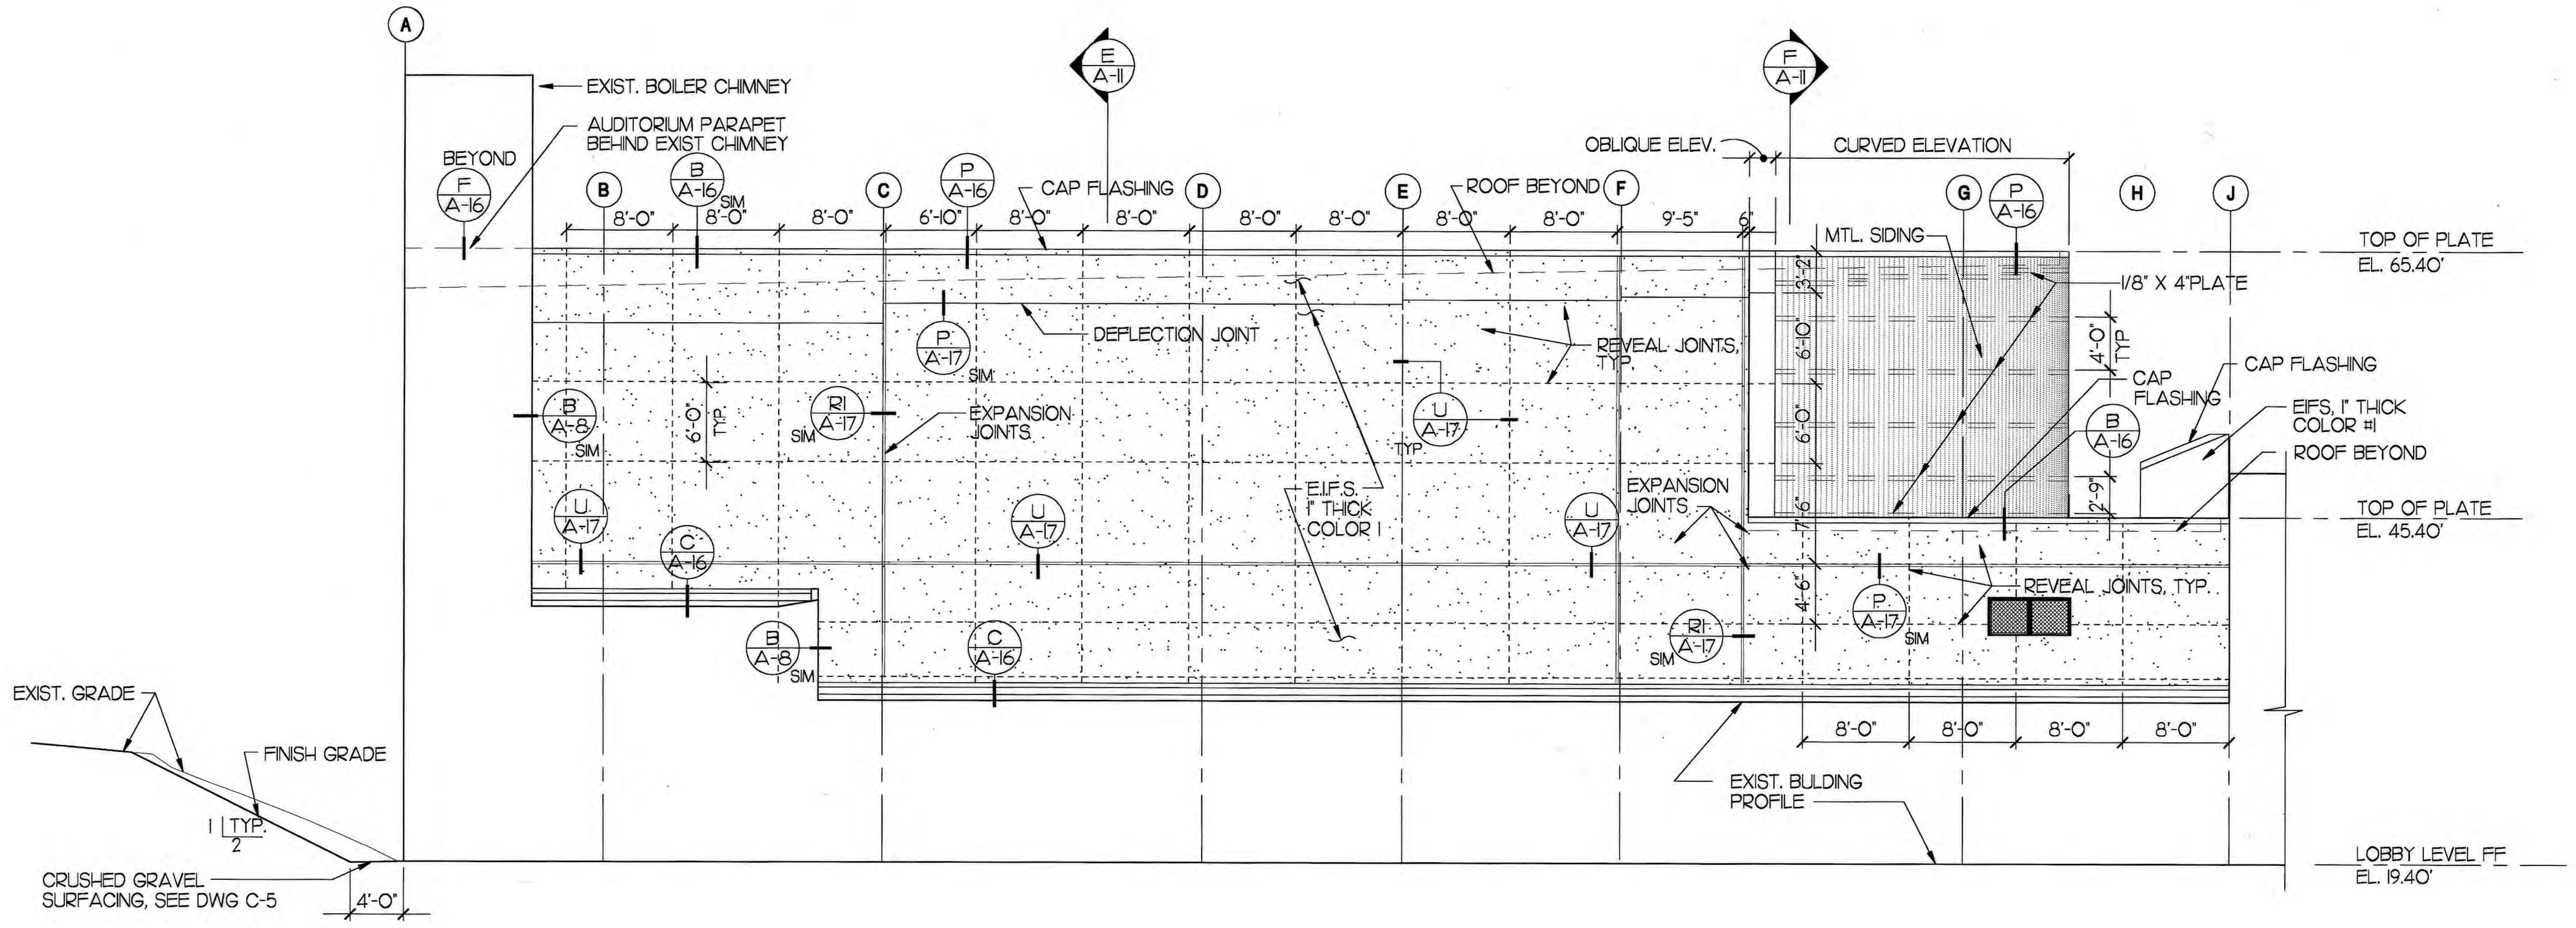

A A-2 NORTH ELEVATION
SCALE: 1/8 = 1'-0"

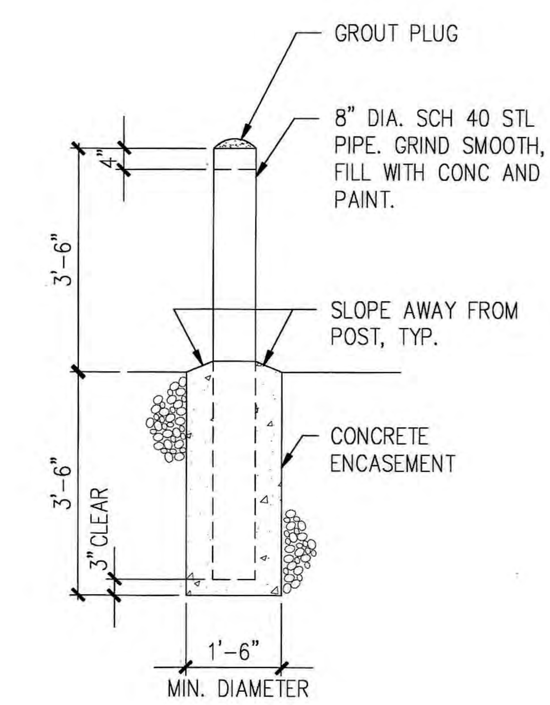

C A-2 BOLLARD
SCALE: 1/2 = 1'-0"

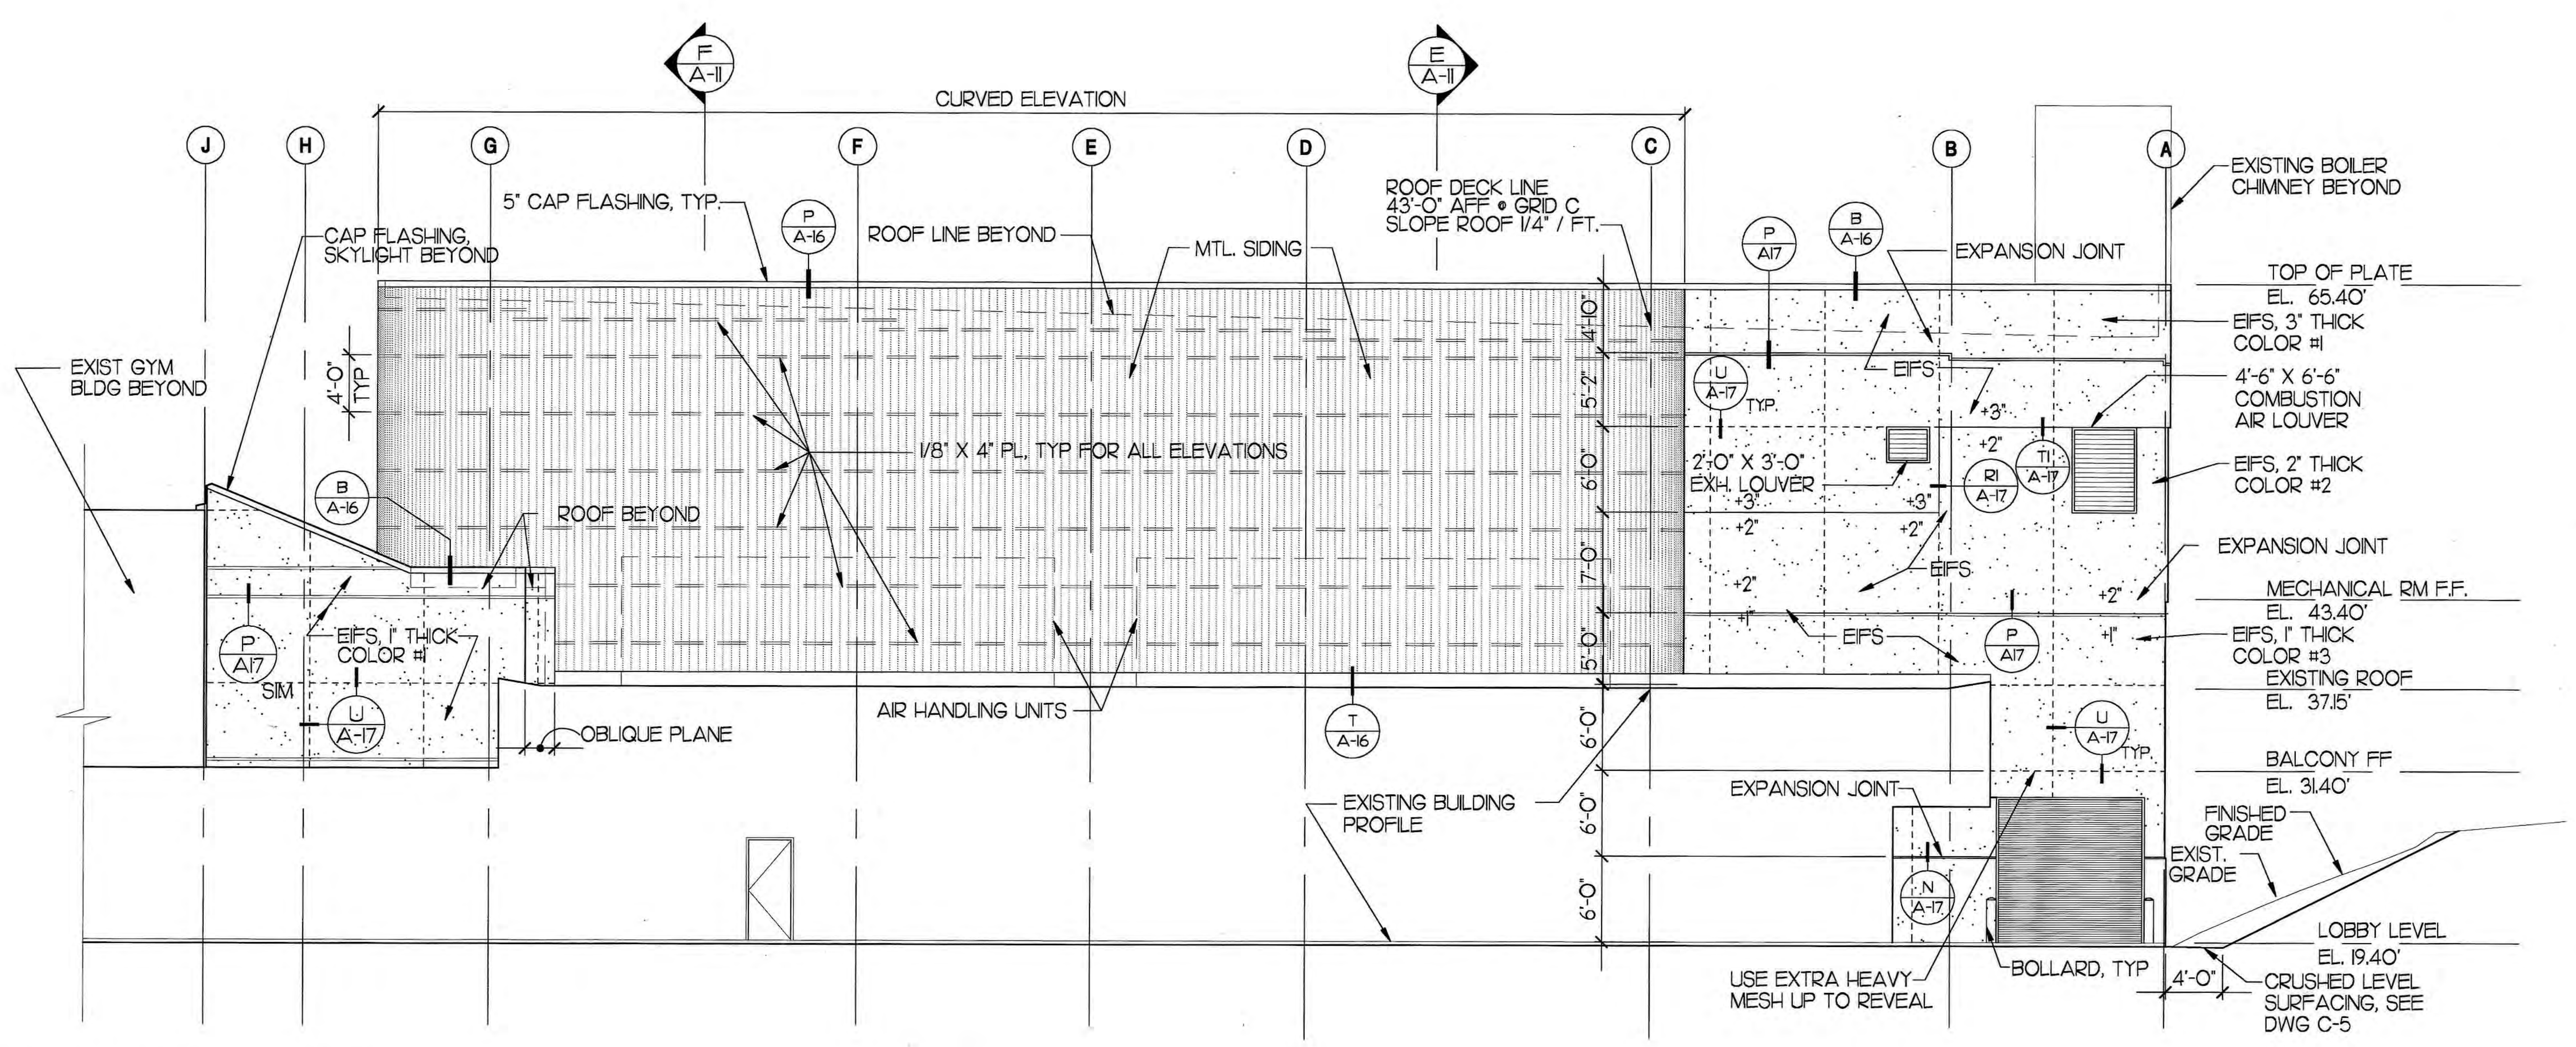

B A-2 SOUTH ELEVATION
SCALE: 1/8 = 1'-0"

PLOT FILE: 541A301.DWG
DATE PLOTTED: 02/25/99

STREETER & ASSOCIATES ARCHITECTS AIA

185 UNIVERSITY STREET SEATTLE WA. 98101-2901
206.621.9270 F.206.621.7715 www.streeterarchitects.com

CONSULTANT

SEATTLE SCHOOL DISTRICT

DATE: MARCH, 1999 **AS-BUILT**

RAINIER BEACH HIGH SCHOOL PERFORMING ARTS CENTER

ELEVATIONS & DETAILS - NORTH & SOUTH

PRINCIPAL ARCH:	M STREETER
PROJECT MNGR:	S CAMERON
PROJECT ARCH:	I JAIN
JOB CAPTAIN:	J MOORE
DRAWN BY:	STAFF
REVIEWED BY:	JAIN

DATE: 10/01/99

A-7

SHEET NO:

NO.	REVISION	DATE	DRAWING NO.

271
021-0

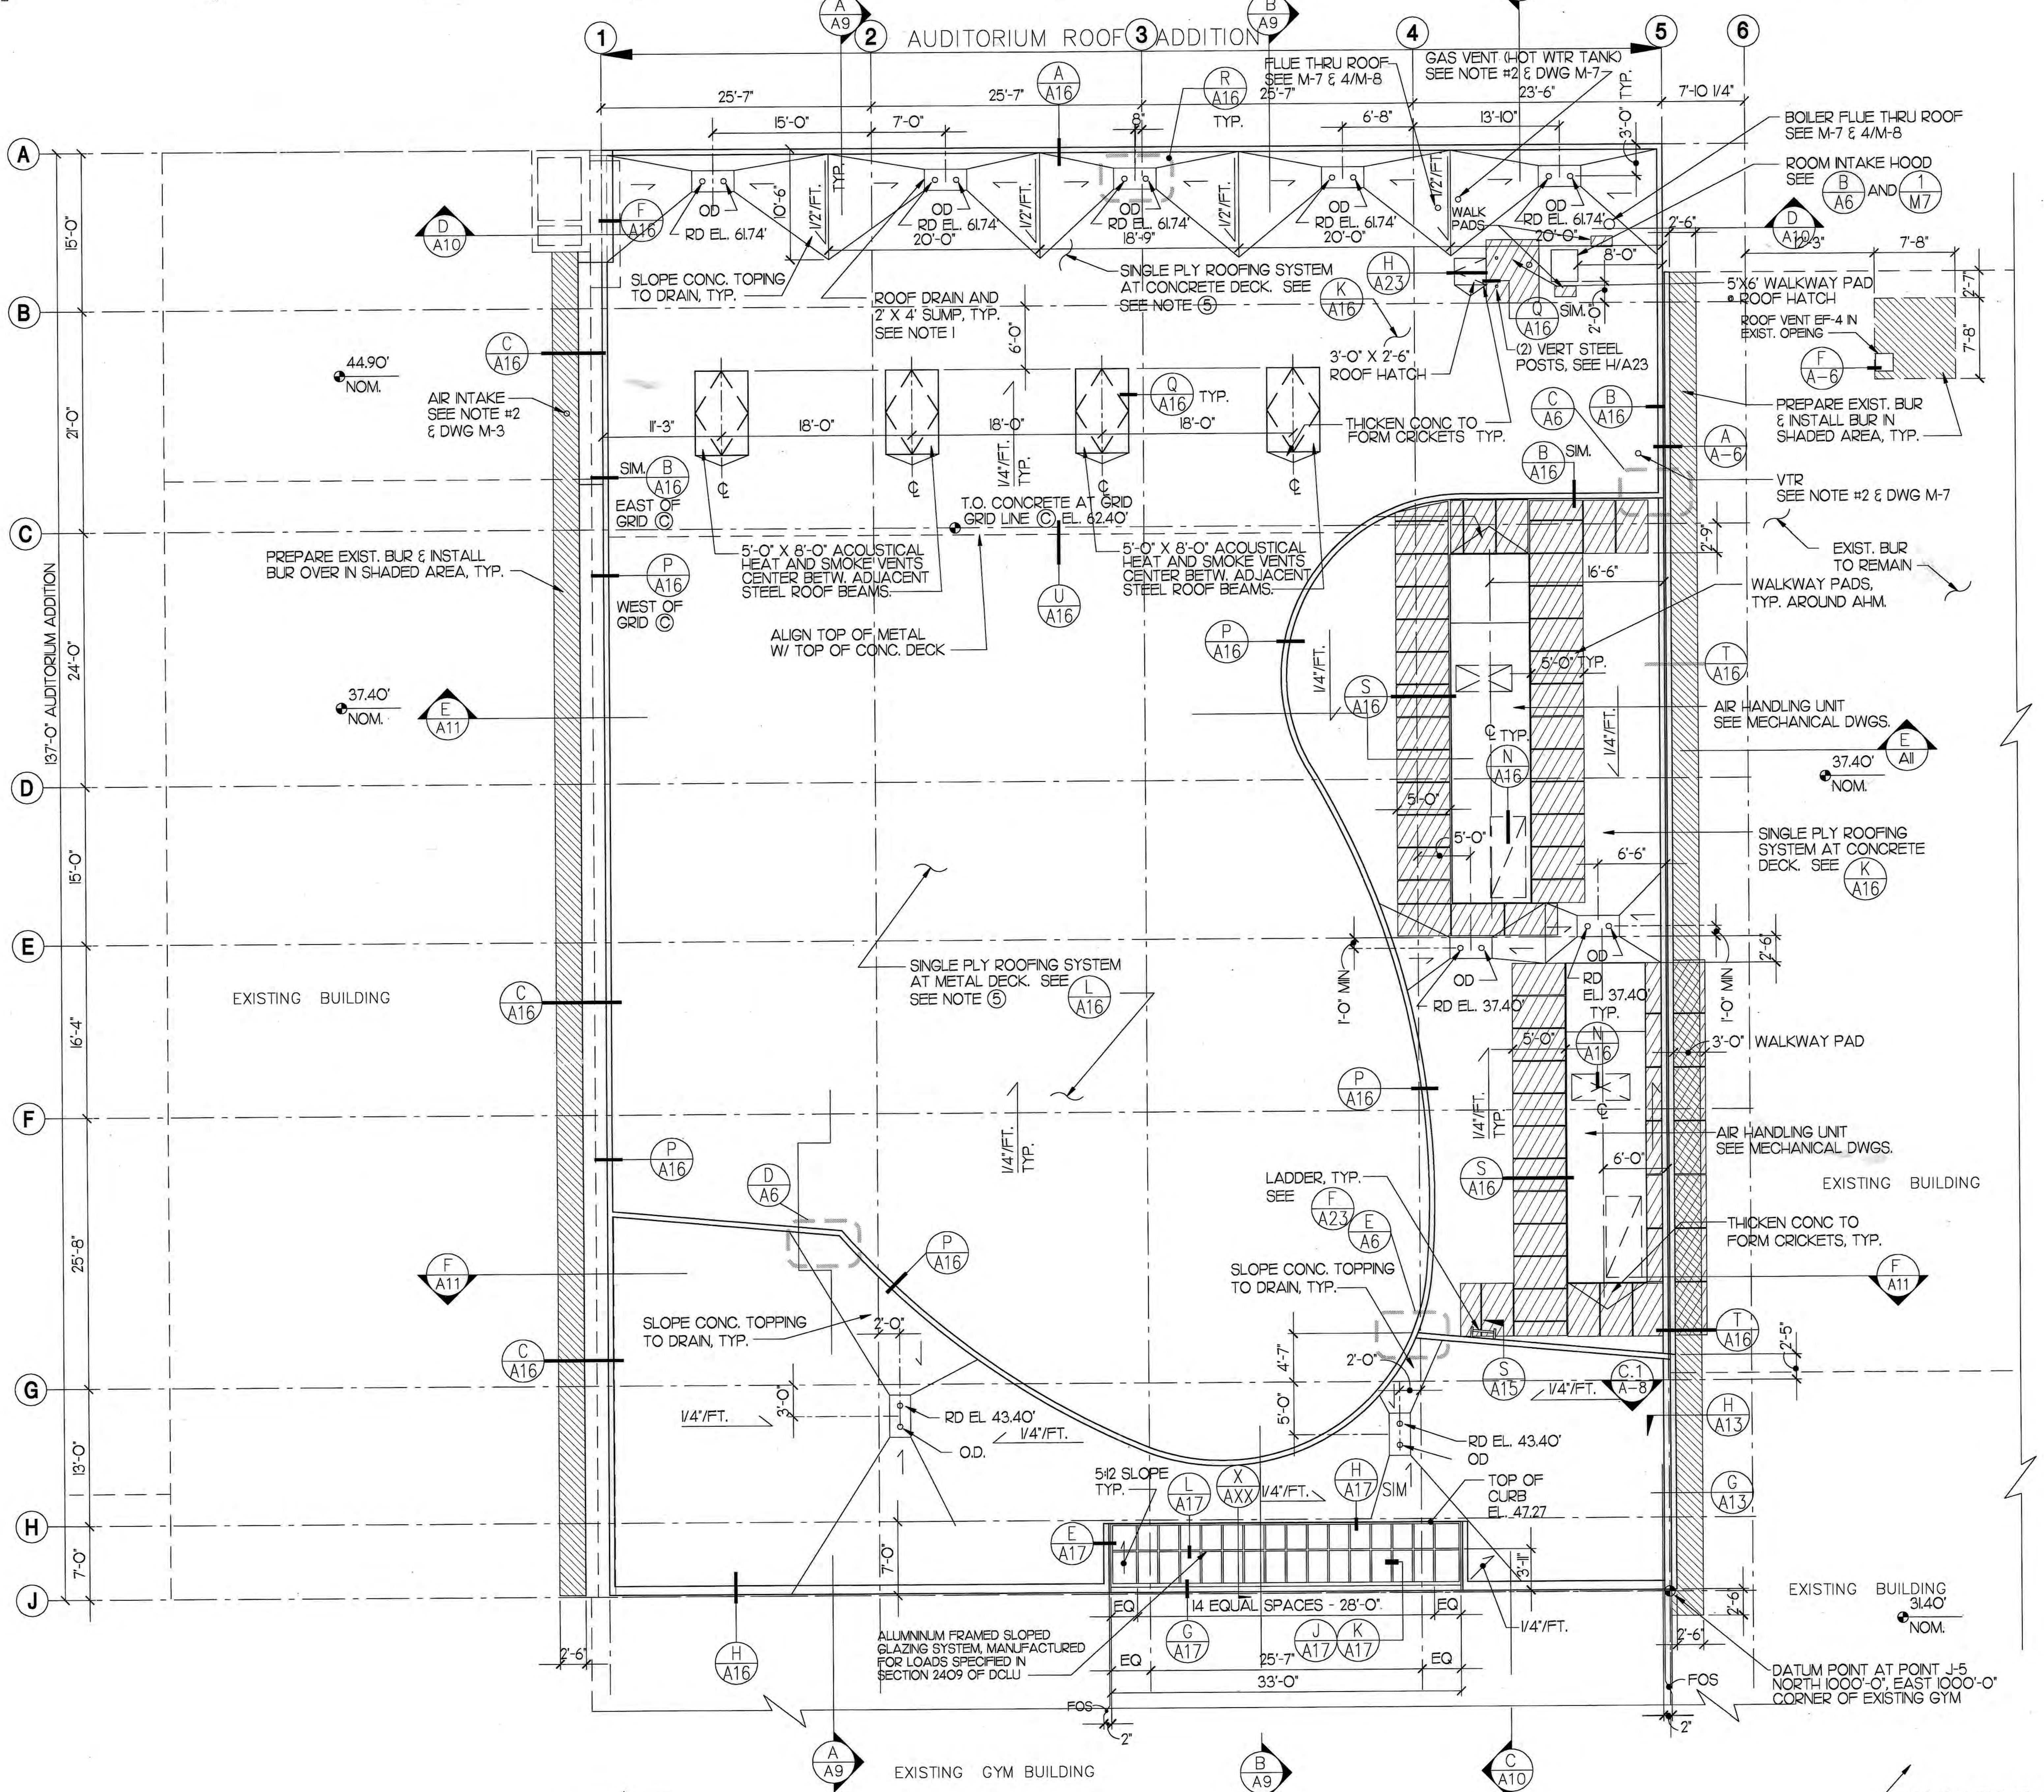

ROOF PLAN

SCALE: 1/8" = 1'-0"

NOTES:

1. ADJUST LOCATIONS OF ROOF DRAINS AND OVERFLOW DRAINS TO CLEAR STRUCTURAL STEEL FRAME AND FIREPROOFING.
2. FOR MISCELLANEOUS PLUMBING, MECHANICAL, OR ELECTRICAL ROOF PENETRATIONS 6" IN DIAMETER OR LESS AT SINGLE PLY ROOFING SYSTEM, SEE DETAIL V/A-16.
3. REFER TO MECHANICAL, PLUMBING AND ELECTRICAL DRAWINGS FOR SIZE AND LOCATION OF PIPES, VENTS, CONDUITS, ETC. WHICH PENETRATE THE ROOF.
4. ELEVATION AT ROOF DRAIN DENOTES TOP OF CONC. AT DRAIN
5. ROOF COVERING SHALL BE CLASS A
6. ROOF VENT. CENTER BETWEEN EXISTING JOISTS IN 20" PAN WIDTH. DO NOT DESTROY EXISTING JOISTS OR BRIDGING. DO NOT OVER CUT. SEE M-5 FOR SIZE.

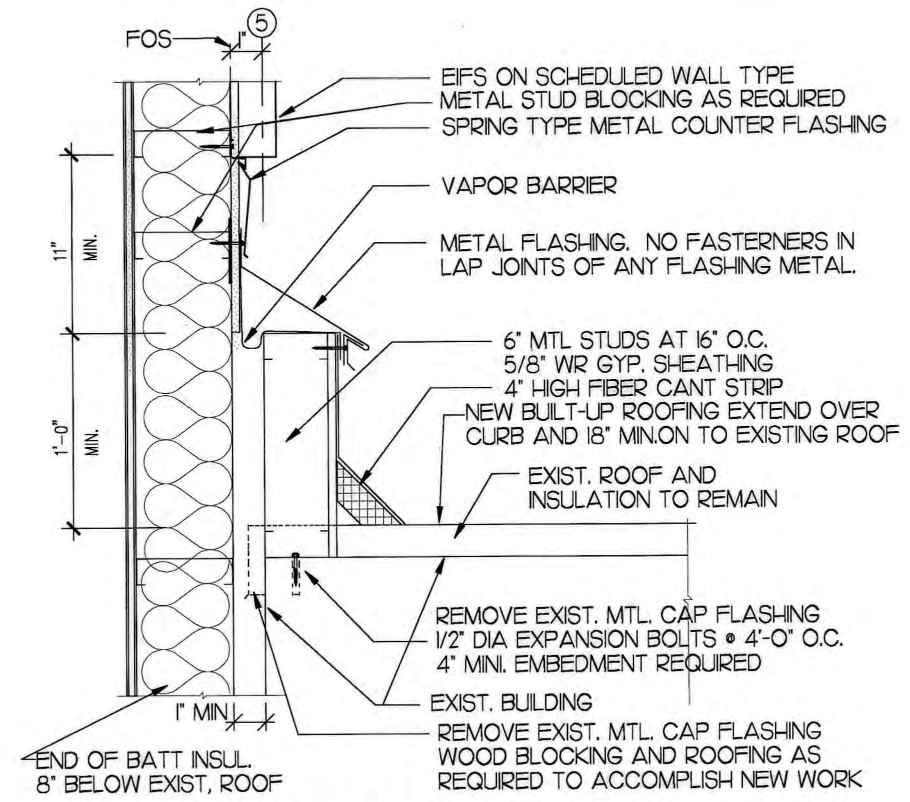

A / A-6 WALL ROOF EXP. JOINT
1 1/2" = 1'-0"

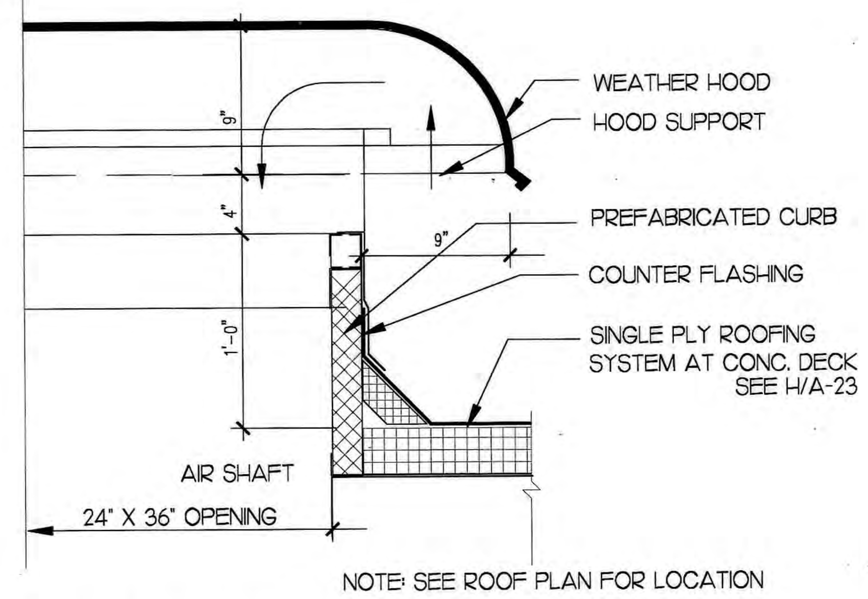

B / A-6 INTAKE HOOD CURB DETAIL
1 1/2" = 1'-0"

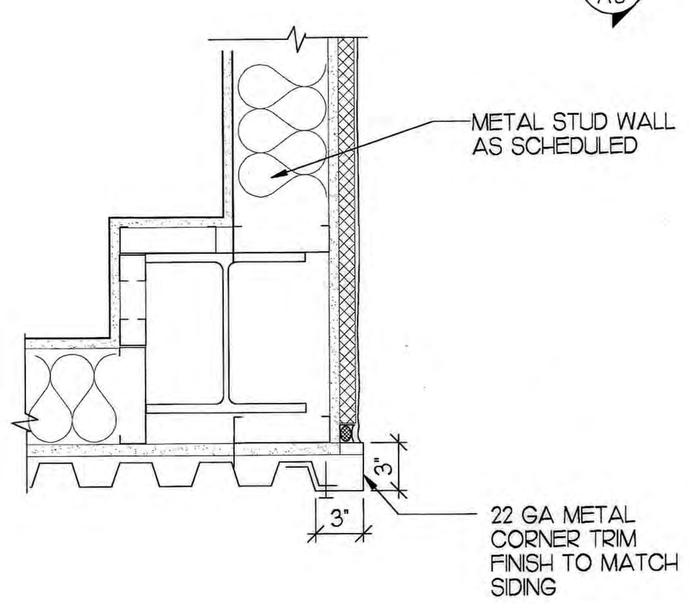

C / A-6 WALL DETAIL
1 1/2" = 1'-0"

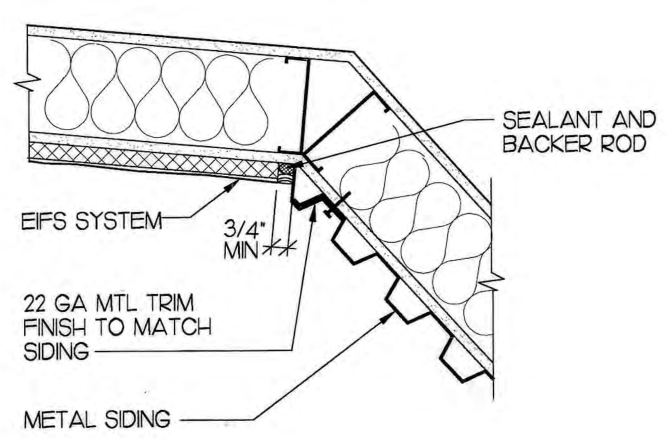

D / A-6 WALL DETAIL
1 1/2" = 1'-0"

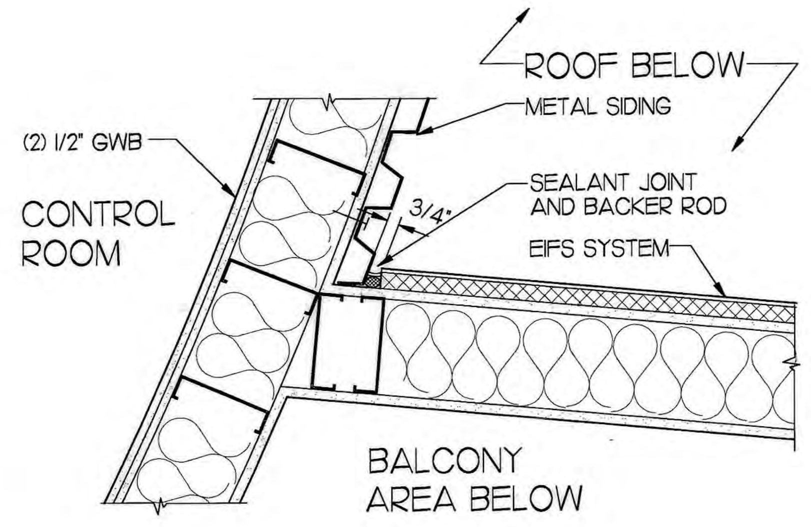

E / A-6 WALL DETAIL
1 1/2" = 1'-0"

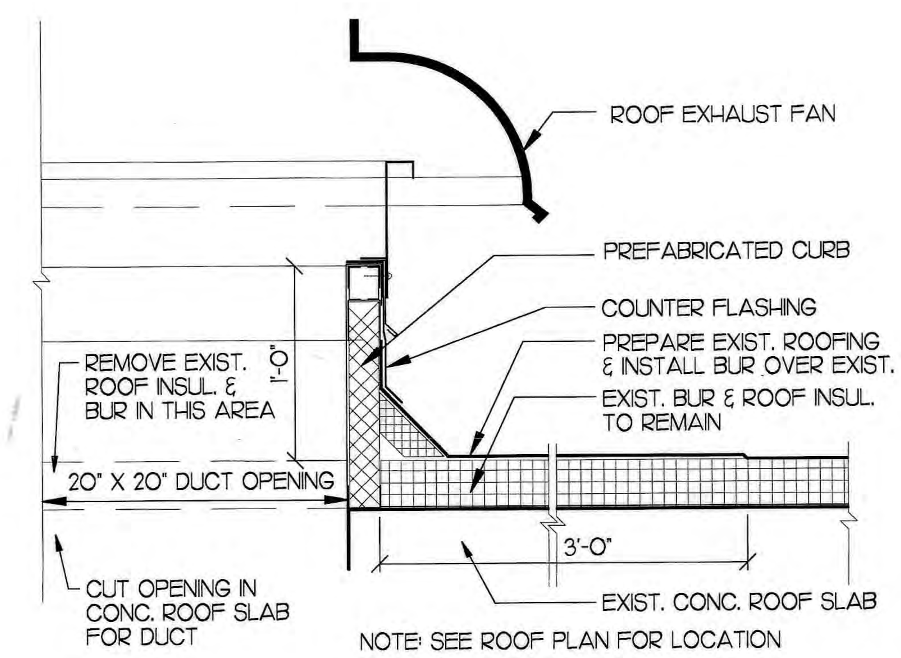

F / A-6 WALL DETAIL
1 1/2" = 1'-0"

STREETER & ASSOCIATES ARCHITECTS AIA

185 UNIVERSITY STREET SEATTLE WA. 98101-2901
206.621.9270 F.206.621.7715 www.streeterarchitects.com

CONSULTANT

SEATTLE SCHOOL DISTRICT

DATE: MARCH, 1999

AS-BUILT

RAINIER BEACH HIGH SCHOOL PERFORMING ARTS CENTER

ROOF PLAN & DETAILS

PRINCIPAL ARCH:	M STREETER	DATE: 10/01/99
PROJECT MNGR:	S CAMERON	
PROJECT ARCH:	J JAIN	A-6
JOB CAPTAIN:	J MOORE	
DRAWN BY:	MCW	
REVIEWED BY:	JAIN	SHEET NO:

NO.	REVISION	DATE	DRAWING NO.

PLOT FILE: 541A701.DWG
DATE PLOTTED: 02/24/99

021-0 270

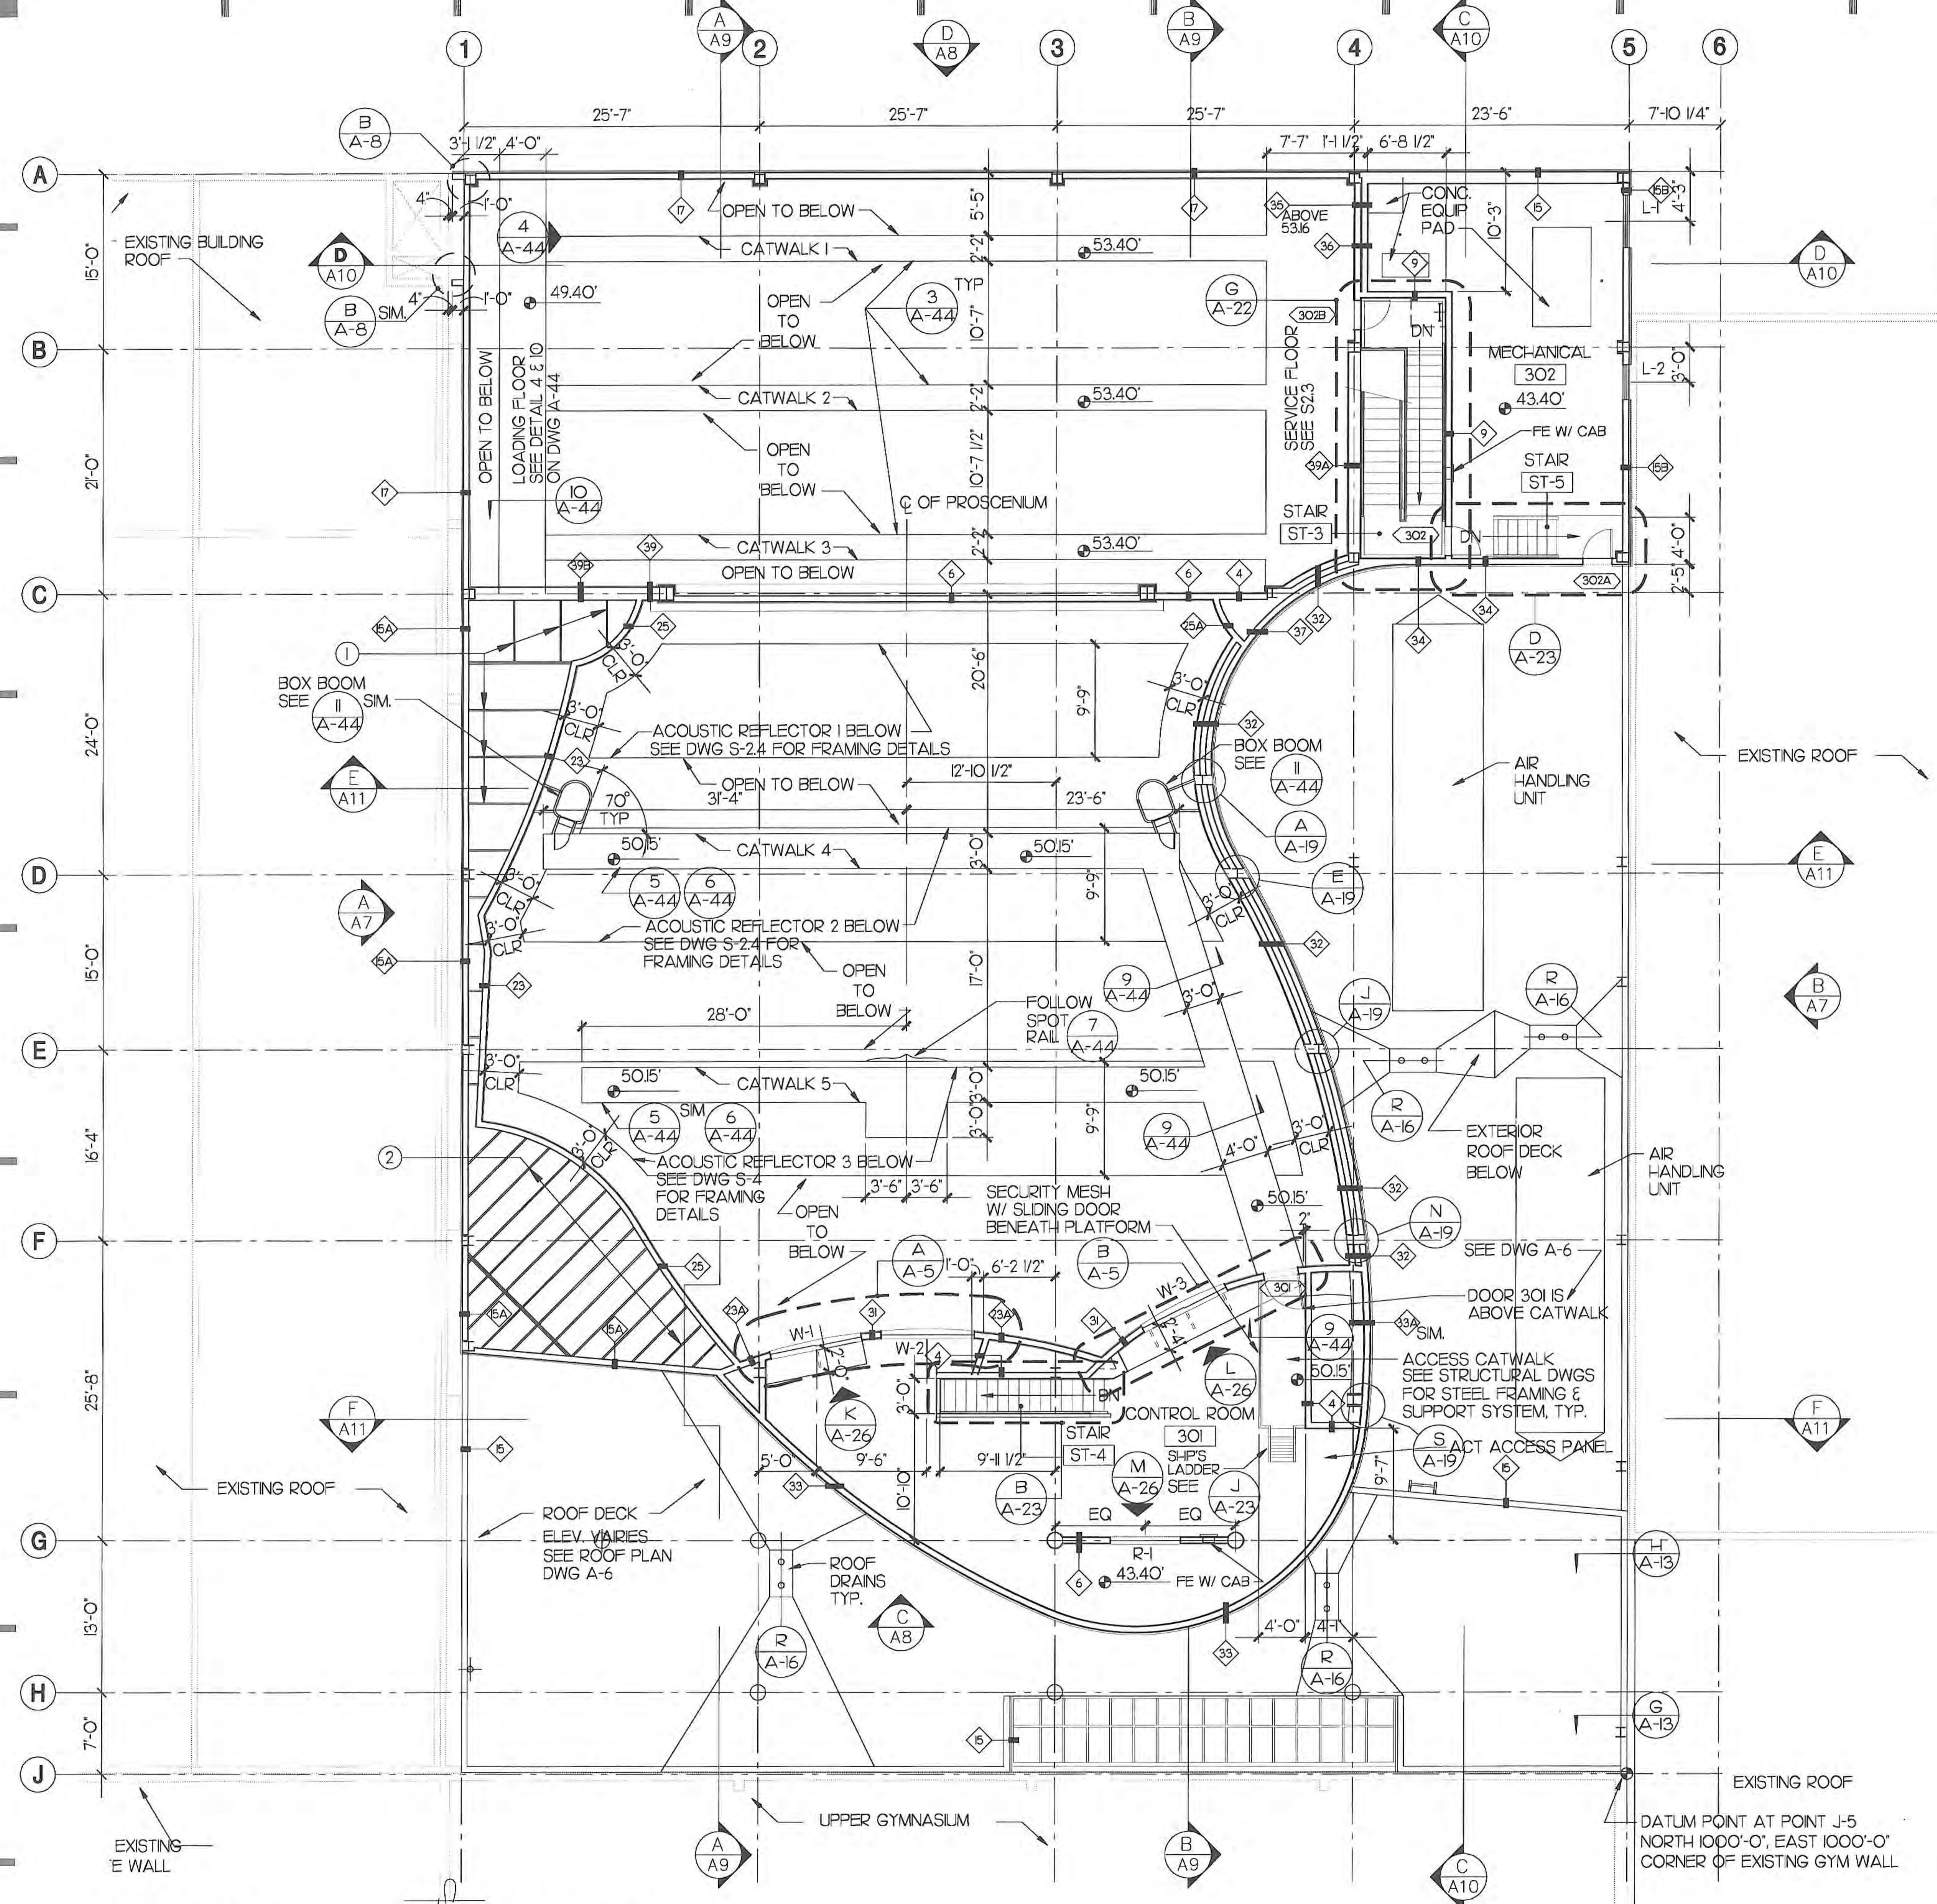

FLOOR PLAN - CONTROL ROOM LEVEL

SCALE: 1/8" = 1'-0"

0 2' 4' 8' 12' 16' 20'

PLAN NORTH

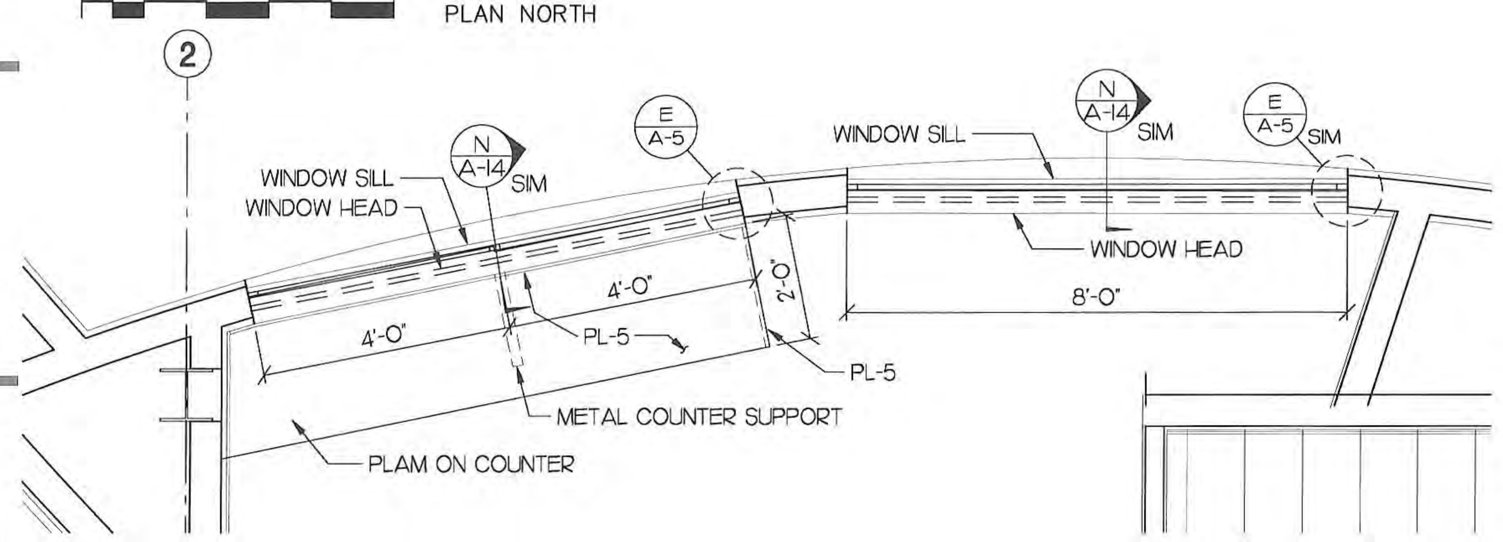

A / A-5 PLAN: CONTROL ROOM WINDOWS

SCALE: 1/2" = 1'-0"

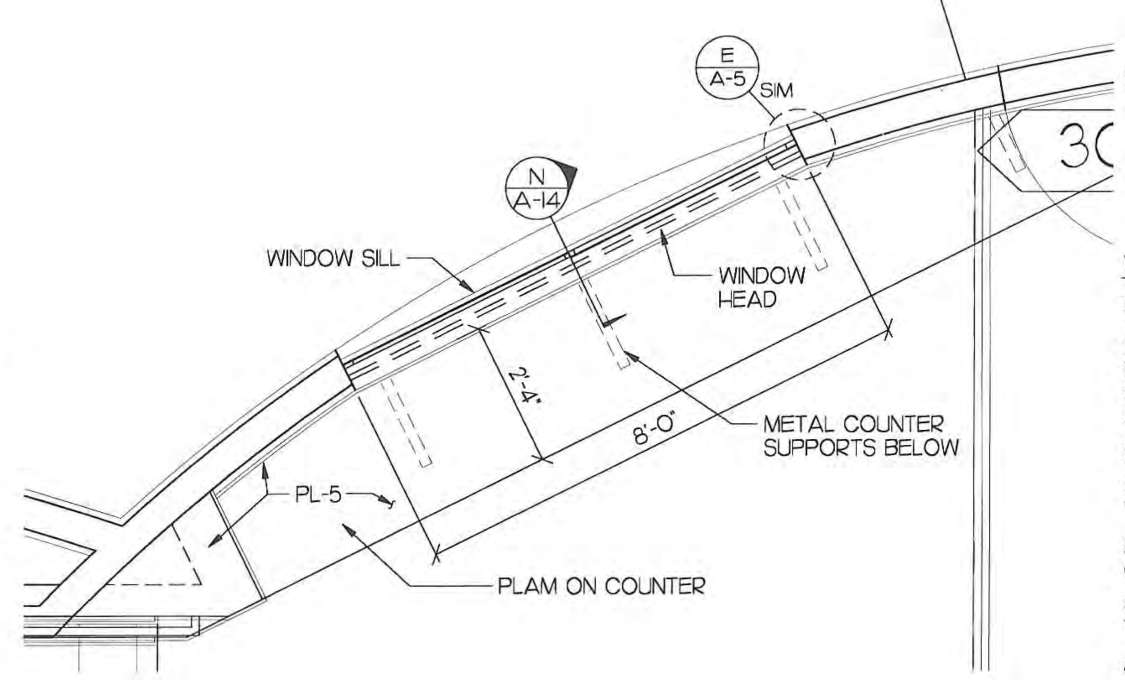

B / A-5 PLAN: CONTROL ROOM WINDOWS

SCALE: 1/2" = 1'-0"

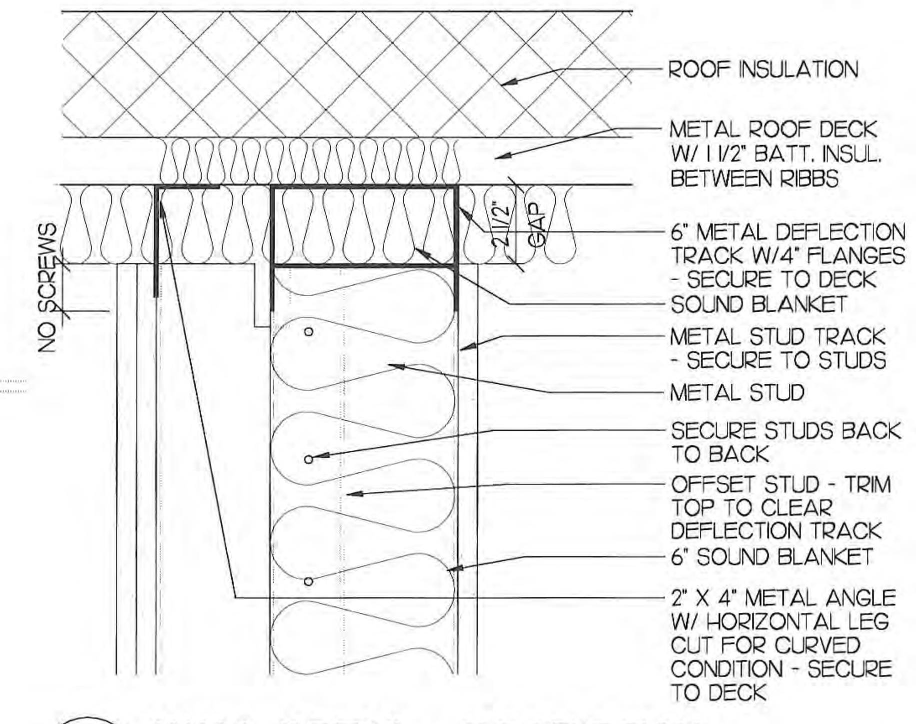

C / A-14 WALL DETAIL @ ROOF DECK

SCALE: 3" = 1'-0"

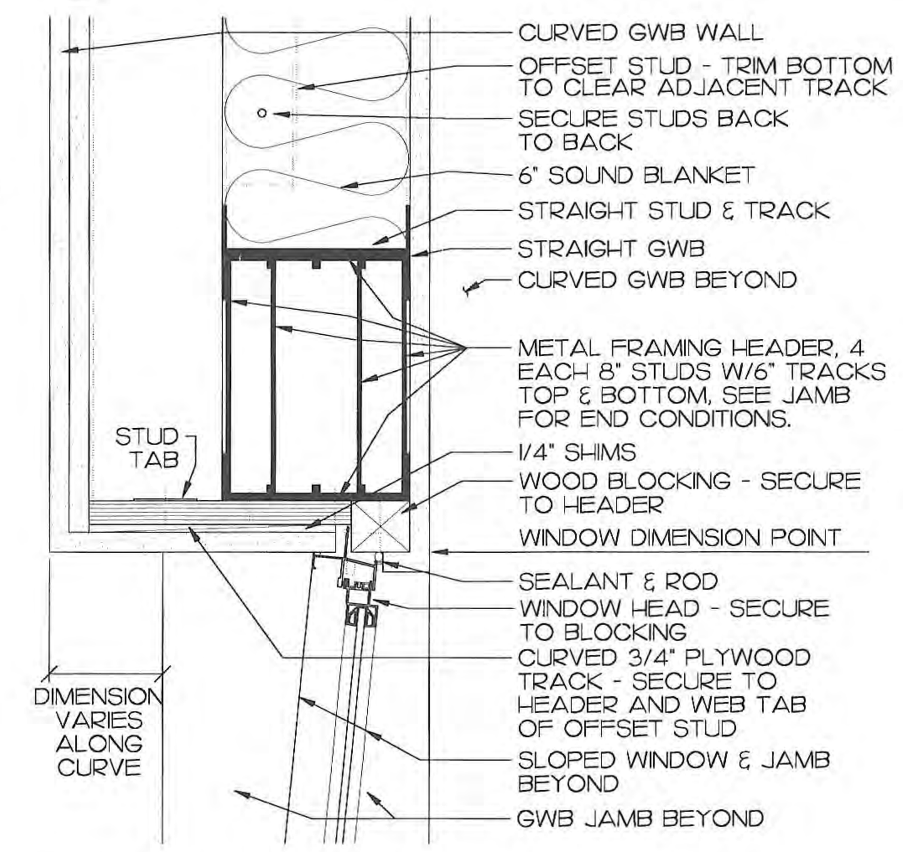

D / A-14 WINDOW HEAD DETAIL

SCALE: 3" = 1'-0"

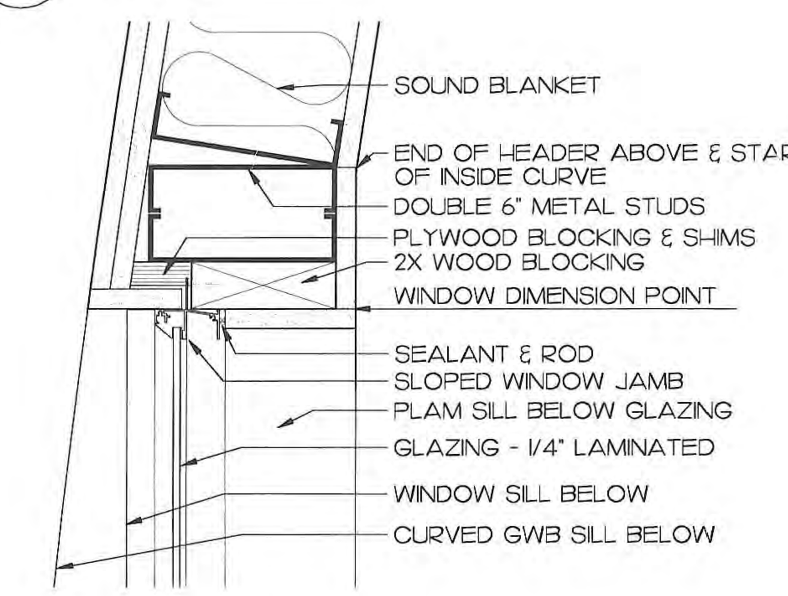

E / A-5 WINDOW JAMB DETAIL

SCALE: 3" = 1'-0"

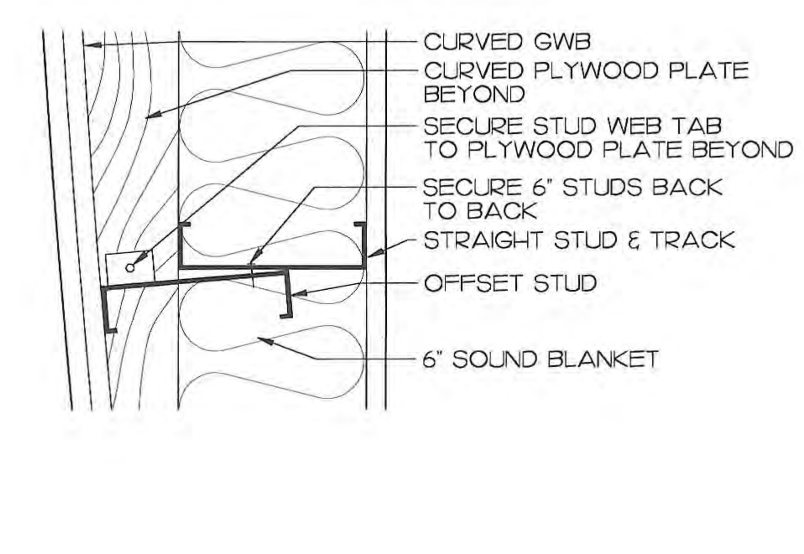

J / A-14 WALL DETAIL

SCALE: 3" = 1'-0"

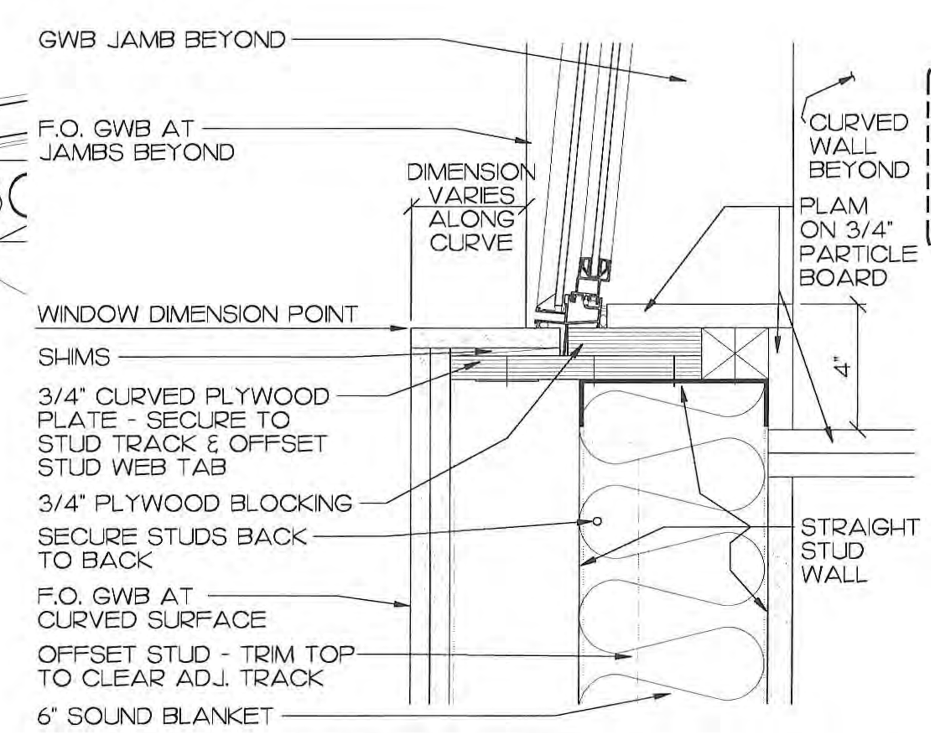

F / A-5 WINDOW SILL DETAIL

SCALE: 3" = 1'-0"

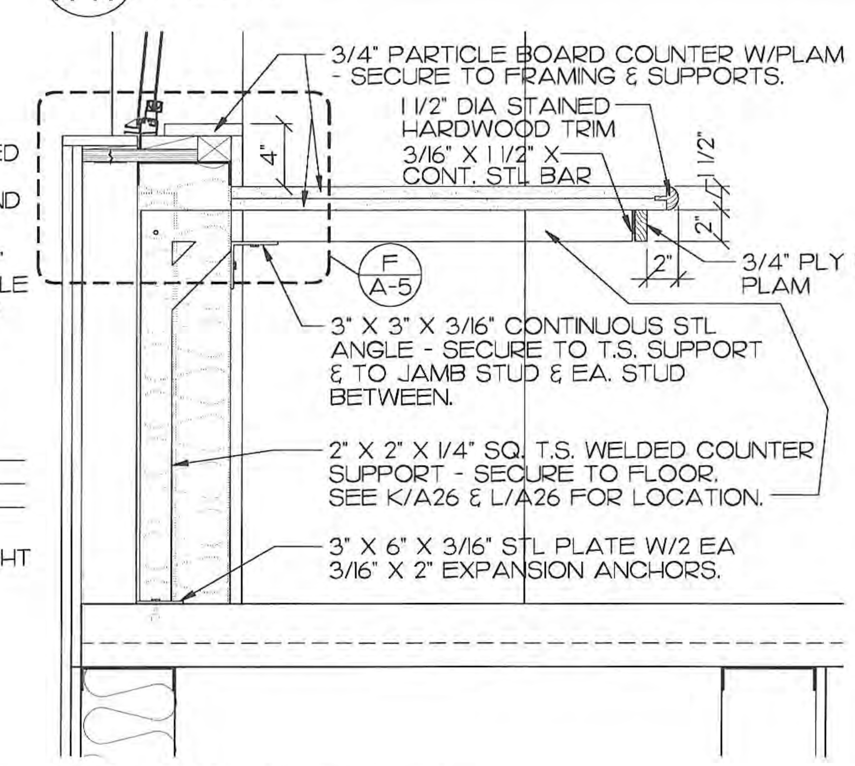

K / A-14 COUNTER DETAIL

SCALE: 1 1/2" = 1'-0"

KEYNOTES:

1. SEE NOTE 5 ON DWG A-4
2. HORIZONTAL WALL BRACING: 6 INCH METAL JOISTS AT 32 INCH SPACING. SEE SECTION Q/A15 FOR VERTICAL SPACING.
3. SEE NOTES 4 THROUGH 10 ON DRAWING A-2 FOR ADDITIONAL INFORMATION
4. FOR FINISH SCHEDULE, LOUVER SCHEDULE AND WINDOW & RELITE SCHEDULE, SEE A-28

STREETER & ASSOCIATES ARCHITECTS AIA

185 UNIVERSITY STREET SEATTLE WA. 98101-2901
206.621.9270 F.206.621.7715 www.streeterarchitects.com

CONSULTANT

SEATTLE SCHOOL DISTRICT

DATE: MARCH, 1999 | AS-BUILT

RAINIER BEACH HIGH SCHOOL PERFORMING ARTS CENTER

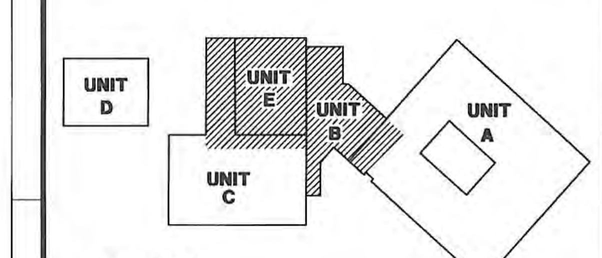

KEYPLAN

FLOOR PLAN - CONTROL ROOM LEVEL

PRINCIPAL ARCH:	M STREETER
PROJECT MNGR:	S CAMERON
PROJECT ARCH:	I JAIN
JOB CAPTAIN:	J MOORE
DRAWN BY:	STAFF
REVIEWED BY:	

DATE: 10/01/99

A-5

SHEET NO:

NO.	REVISION	DATE	DRAWING NO.

PLOT FILE: 541A203.DWG DATE PLOTTED: 10/01/99

021-0261

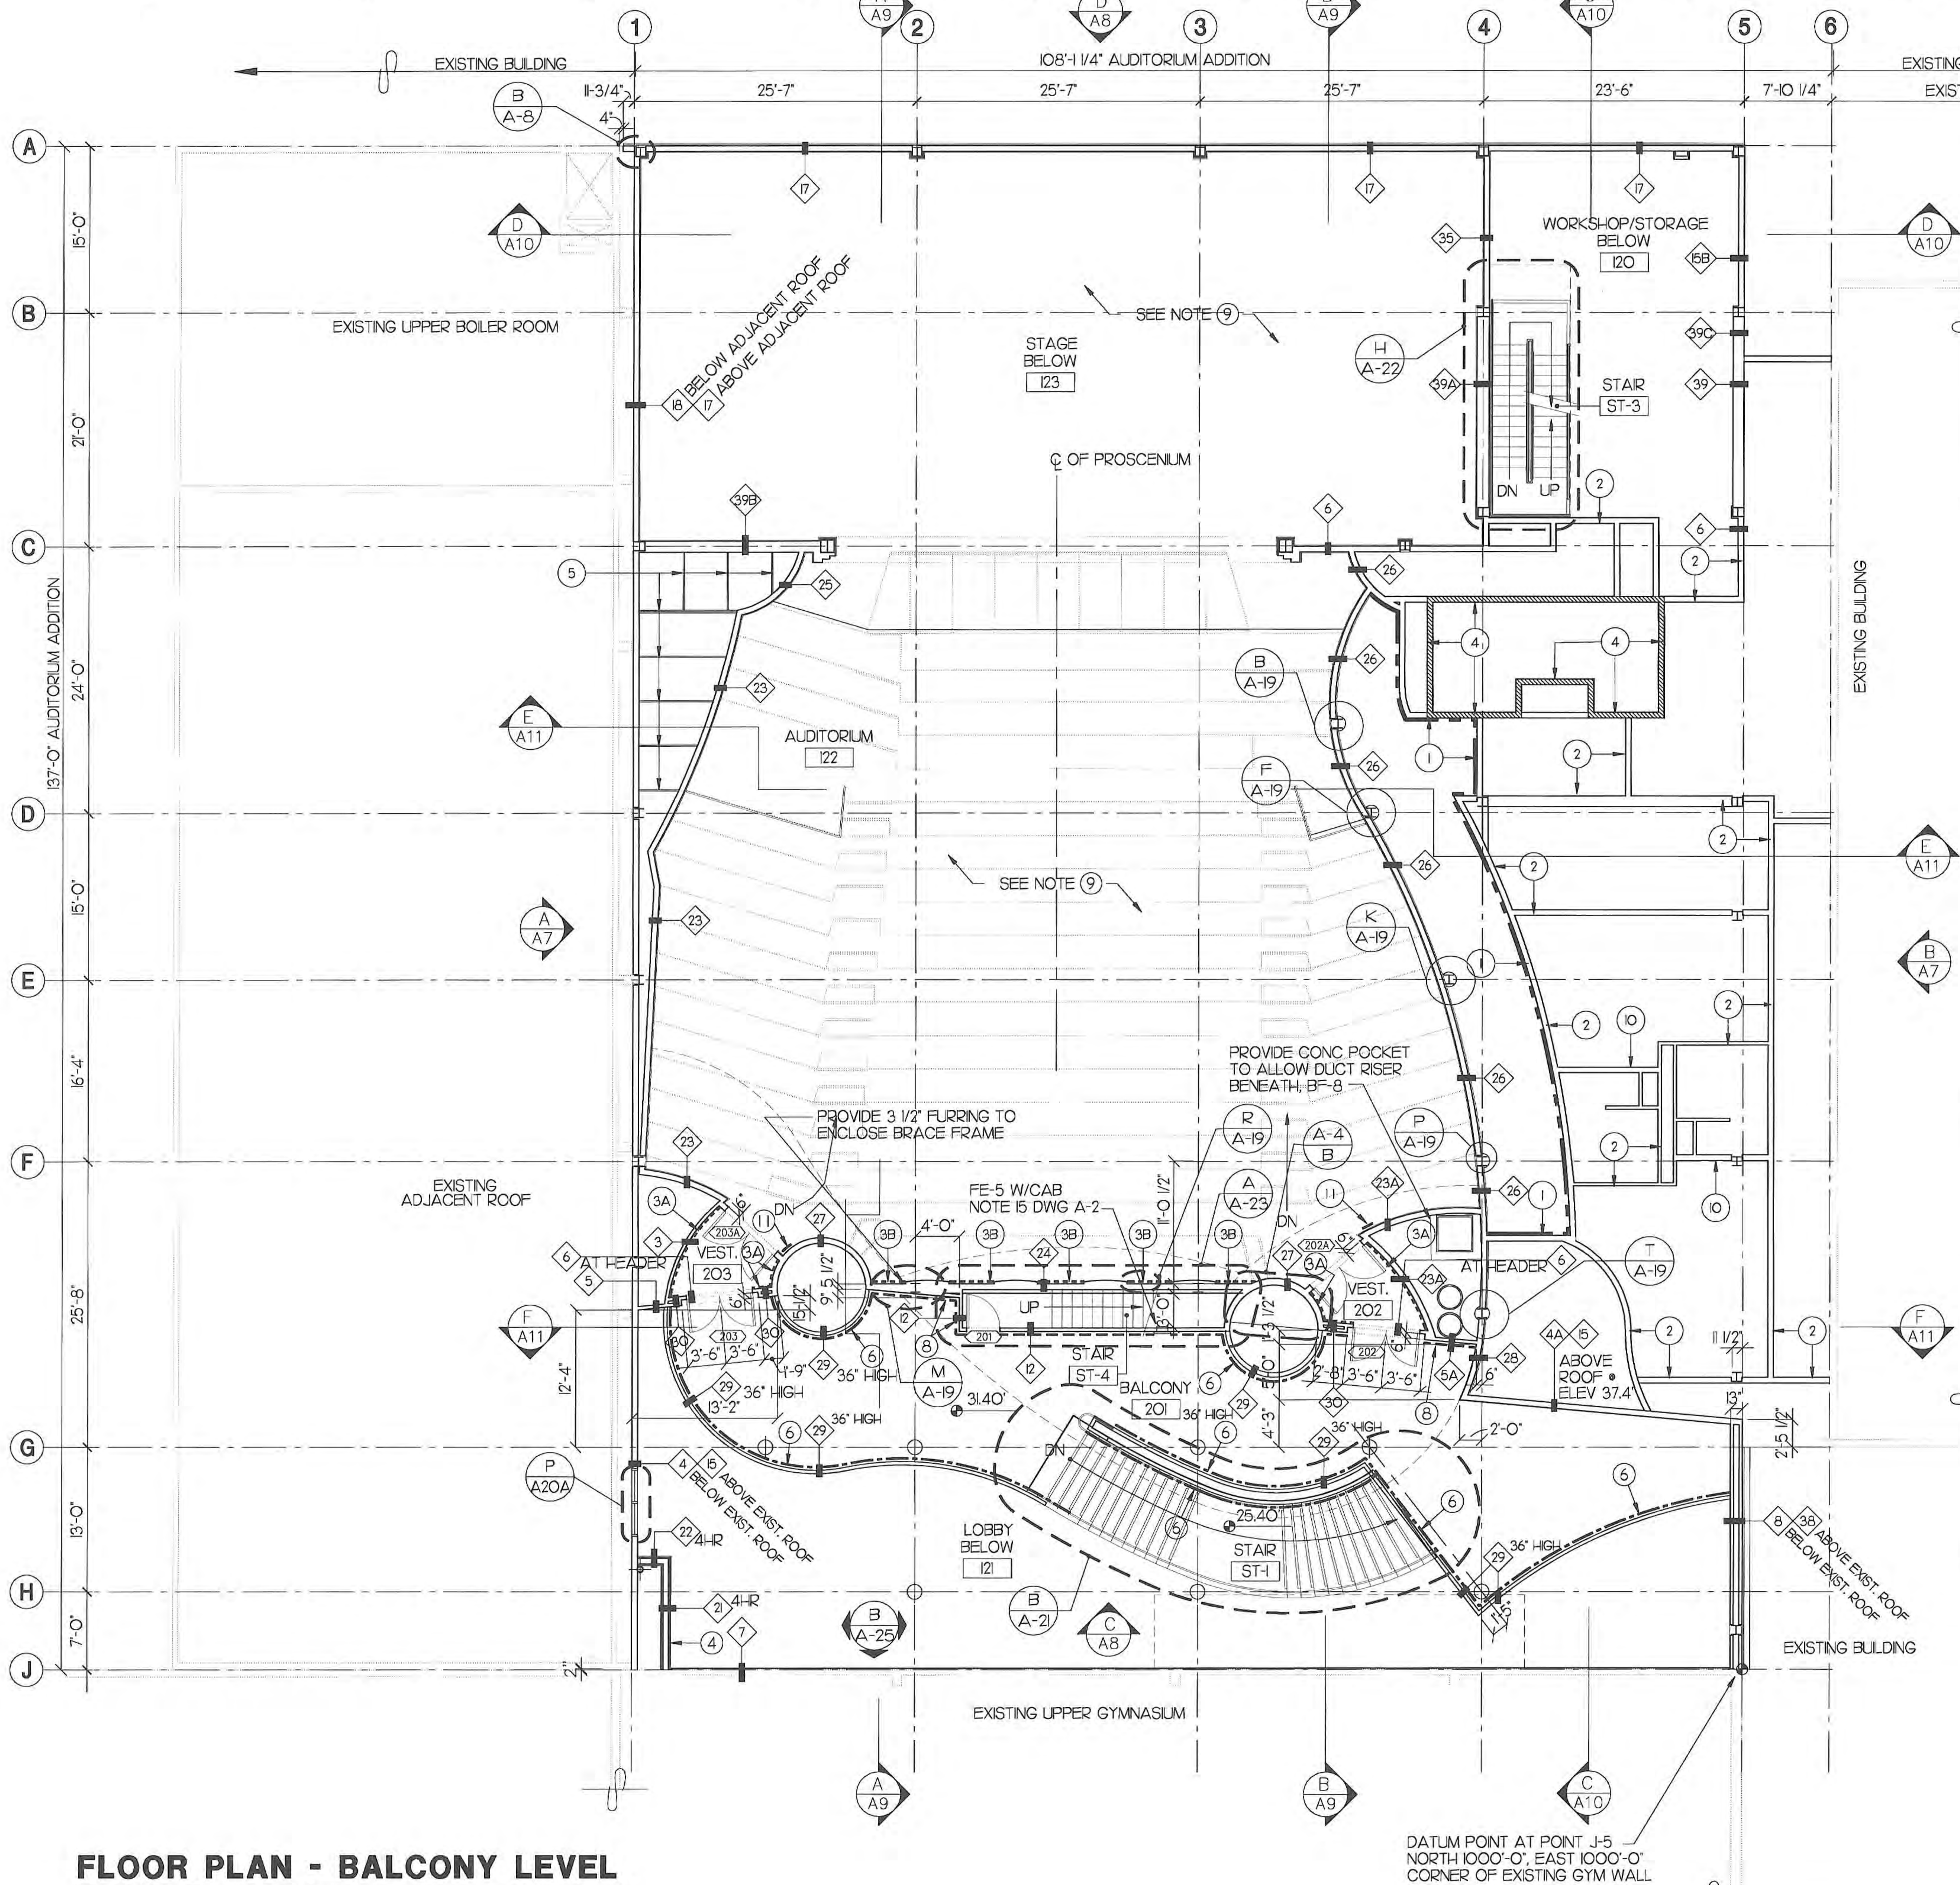

FLOOR PLAN - BALCONY LEVEL

SCALE: 1/8" = 1'-0"

0 2' 4' 8' 12' 16' 20'

PLAN NORTH

PLOT FILE: 541A202.DWG
DATE PLOTTED: 10/01/99

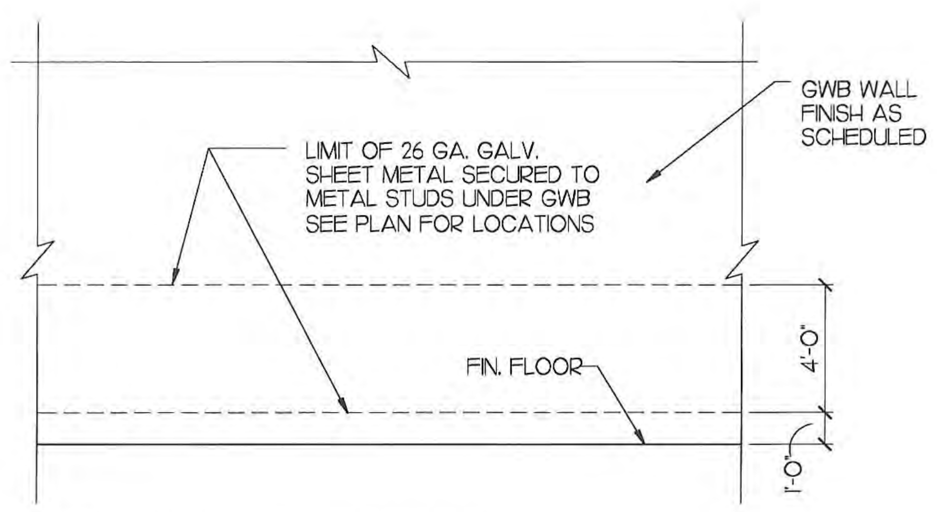

A / A-2 **WALL ELEVATION**

SCALE: 1/4 - 1'-0"

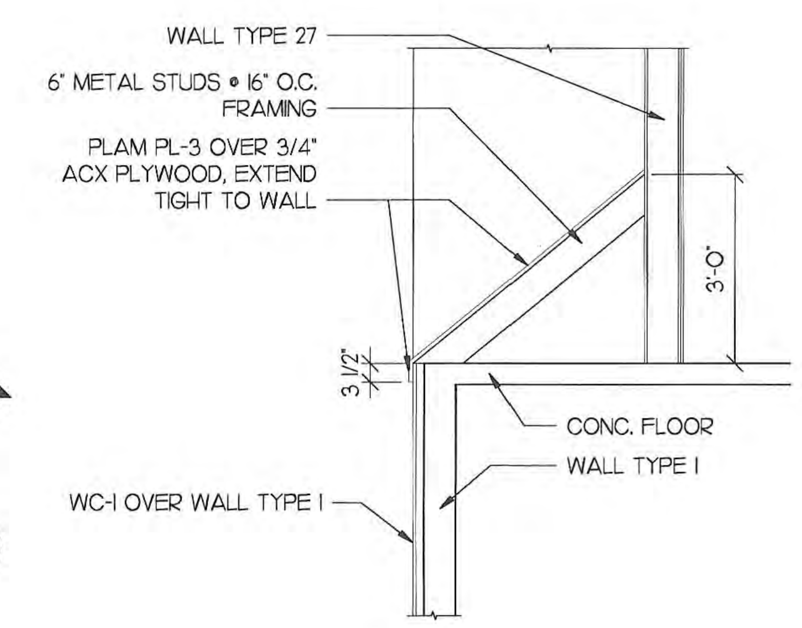

B / A-4 **SLOPING WALL SECTION**

SCALE: 1/2 - 1'-0"

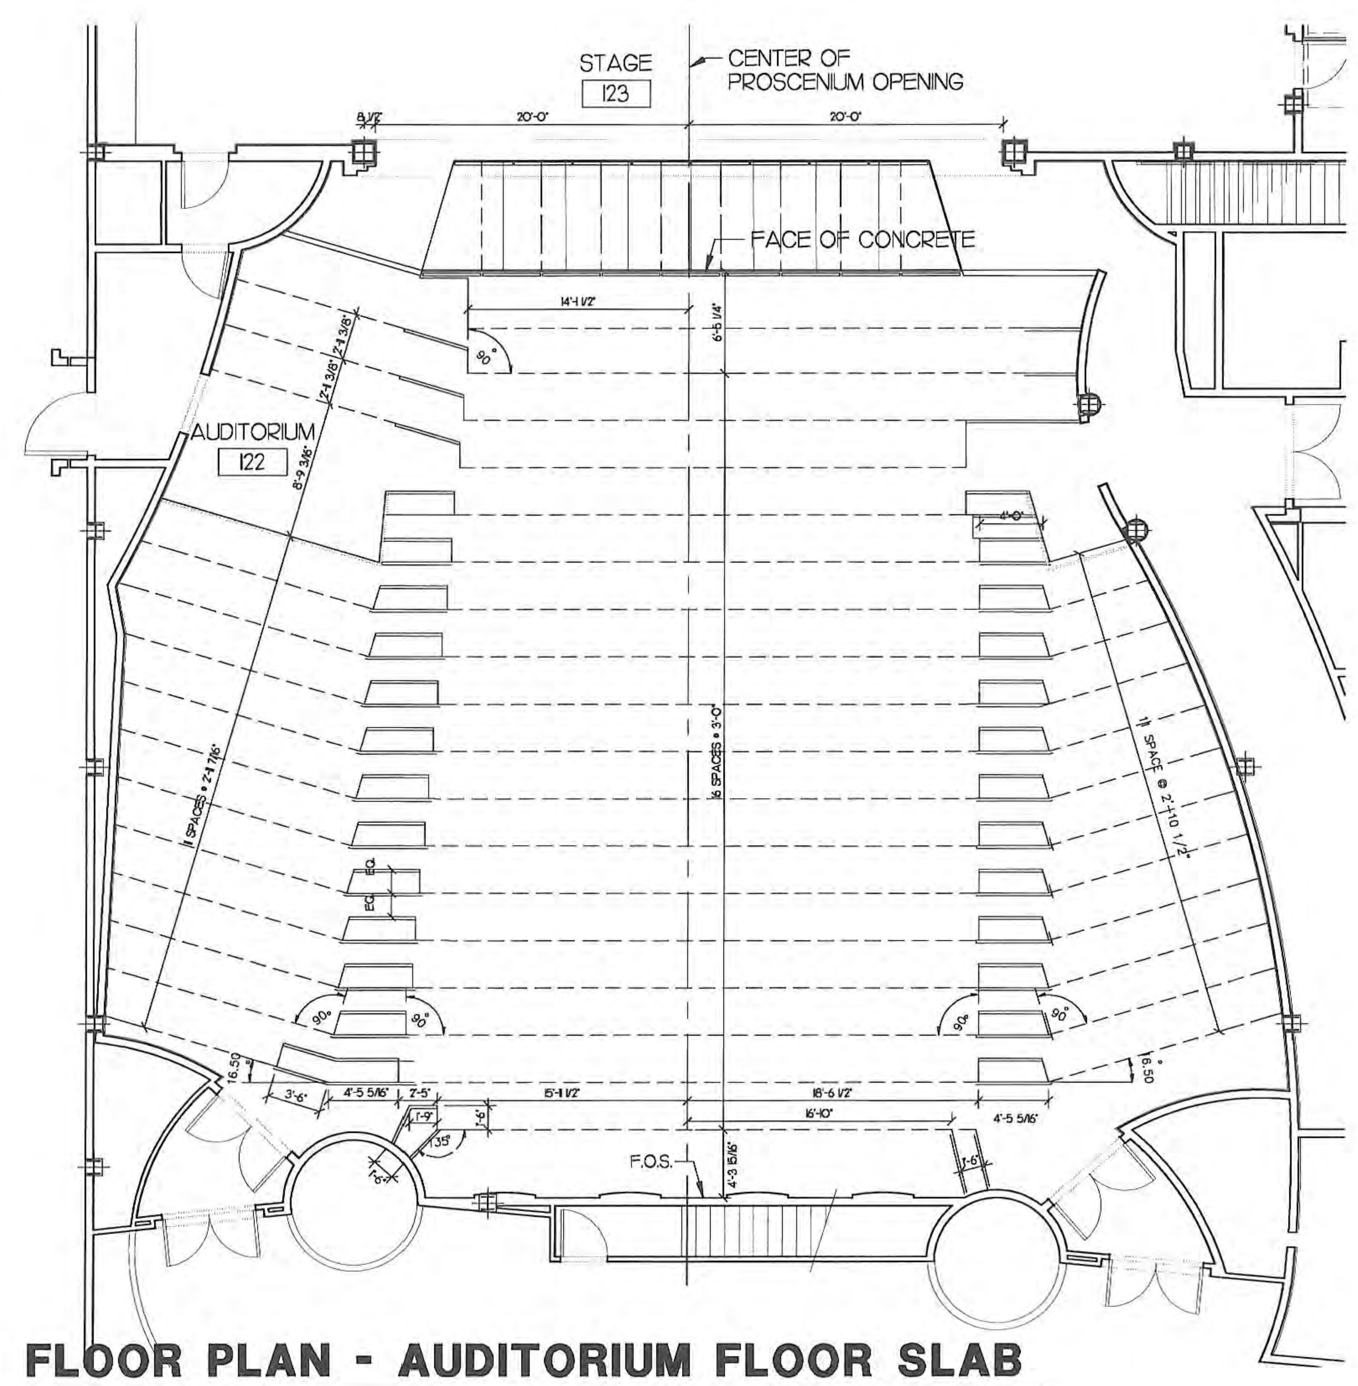

FLOOR PLAN - AUDITORIUM FLOOR SLAB

SCALE: 1/8" = 1'-0"

KEYNOTES:

1. EXTEND GWB UP TO THE STRUCTURAL SLAB ON THE CORRIDOR SIDE ONLY, AS INDICATED BY THIS LINETYPE:
2. EXTEND (1) MTL STUD UP TO THE STRUCTURAL SLAB 48 INCHES OC. EXTEND GWB TO 6 INCHES ABOVE THE CEILING HEIGHT. WALL TYPES FOR THESE WALLS ARE INDICATED ON SHEET A2.
3. INSTALL ACOUSTIC PANELS SECURING MECHANICALLY IN THE LOCATIONS INDICATED BY THIS LINETYPE:
   - A. 7'-0" HIGH, 1 INCH THICK PANELS IN VESTIBULES 202 AND 203.
   - B. 2 INCH THICK PANELS IN THE AUDITORIUM 122. SEE ELEVATION D / A-25.
4. EXTEND FIRE RATED WALL ASSEMBLY UP TO THE STRUCTURAL SLAB. SEAL ALL VOIDS WITH FIRE SAFING.
5. PROVIDE 8 INCH DEEP METAL JOISTS AT 48 INCHES OC. AS SUPPORTS FOR SUSPENDED CEILING SYSTEM. SEE WALL SECTION C / A-12.
6. FURNISH AND INSTALL 36" X 96", 26 GA GALV STEEL SHEET METAL UNDER GWB WALL BOARD FOR FULL HEIGHT OF RAIL WALL AS INDICATED BY THIS LINE TYPE.
7. SEE NOTES 4 THROUGH 10 ON DWG A-2.
8. FURNISH AND INSTALL 48 INCH 26 GA. GALV SHEETS UNDER GWB ON WALLS AS INDICATED BY THIS LINE TYPE: MOUNT BOTTOM OF SHEET METAL AT 12 INCHES ABOVE FINISH FLOOR, TYP. SEE ELEVATION A / A-4 TYP.
9. FOR AUDITORIUM SEATING, STAGE RIGGING AND RELATED ARCHITECTURAL DETAILS, SEE DRAWINGS A-40 THROUGH A-44.
10. EXTEND ONE LAYER OF GWB UP TO STRUCTURAL SLAB ON DRESSING ROOM SIDE.
11. 12" X 12" SIGN FOR MAX OCCUPANCY LOAD OF 600

STREETER & ASSOCIATES ARCHITECTS AIA

185 UNIVERSITY STREET SEATTLE WA. 98101-2901
206.621.9270 F.206.621.7715 www.streeterarchitects.com

CONSULTANT

SEATTLE SCHOOL DISTRICT

DATE: MARCH, 1999 **AS-BUILT**

RAINIER BEACH HIGH SCHOOL PERFORMING ARTS CENTER

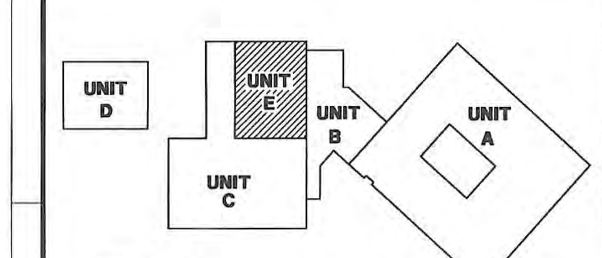

KEYPLAN

FLOOR PLAN - BALCONY LEVEL

PRINCIPAL ARCH: M STREETER	DATE: 10/01/99
PROJECT MNGR: S CAMERON	
PROJECT ARCH: I JAIN	**A-4**
JOB CAPTAIN: J MOORE	
DRAWN BY: STAFF	
REVIEWED BY:	SHEET NO:

NO.	REVISION	DATE	DRAWING NO.

021-0260

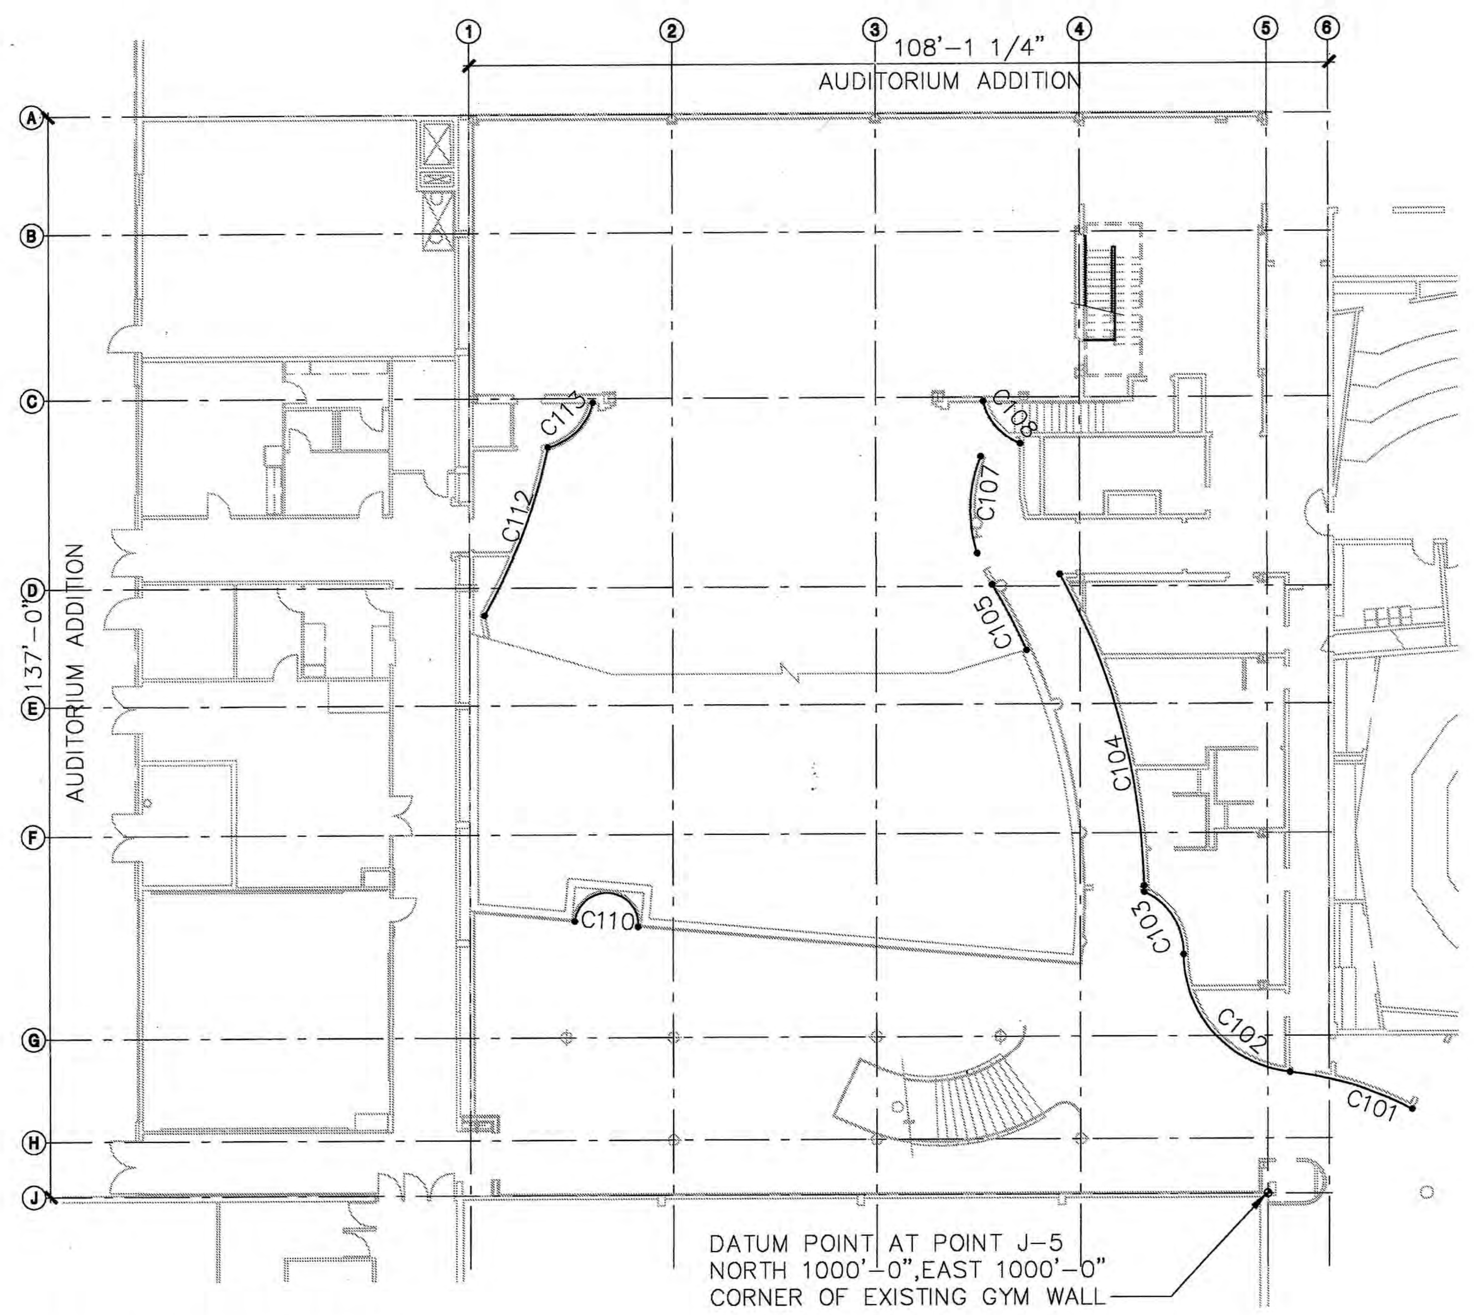

LOBBY LEVEL

SCALE: 1/16" = 1'-0"

0 4' 8' 16' 24' 32' 40'

PLAN NORTH

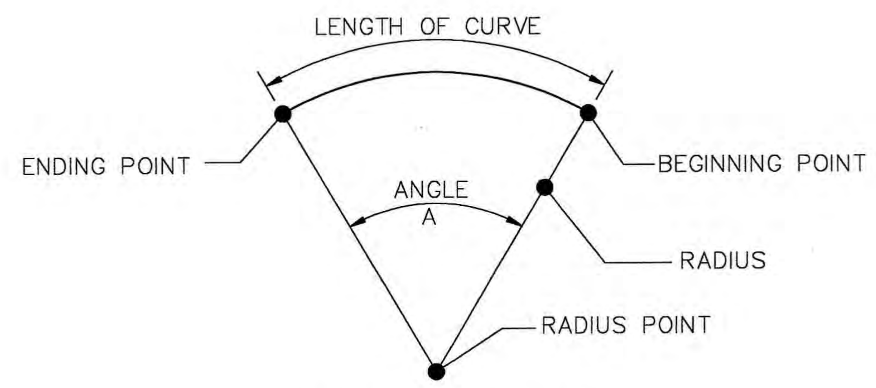

CURVE DATA KEY

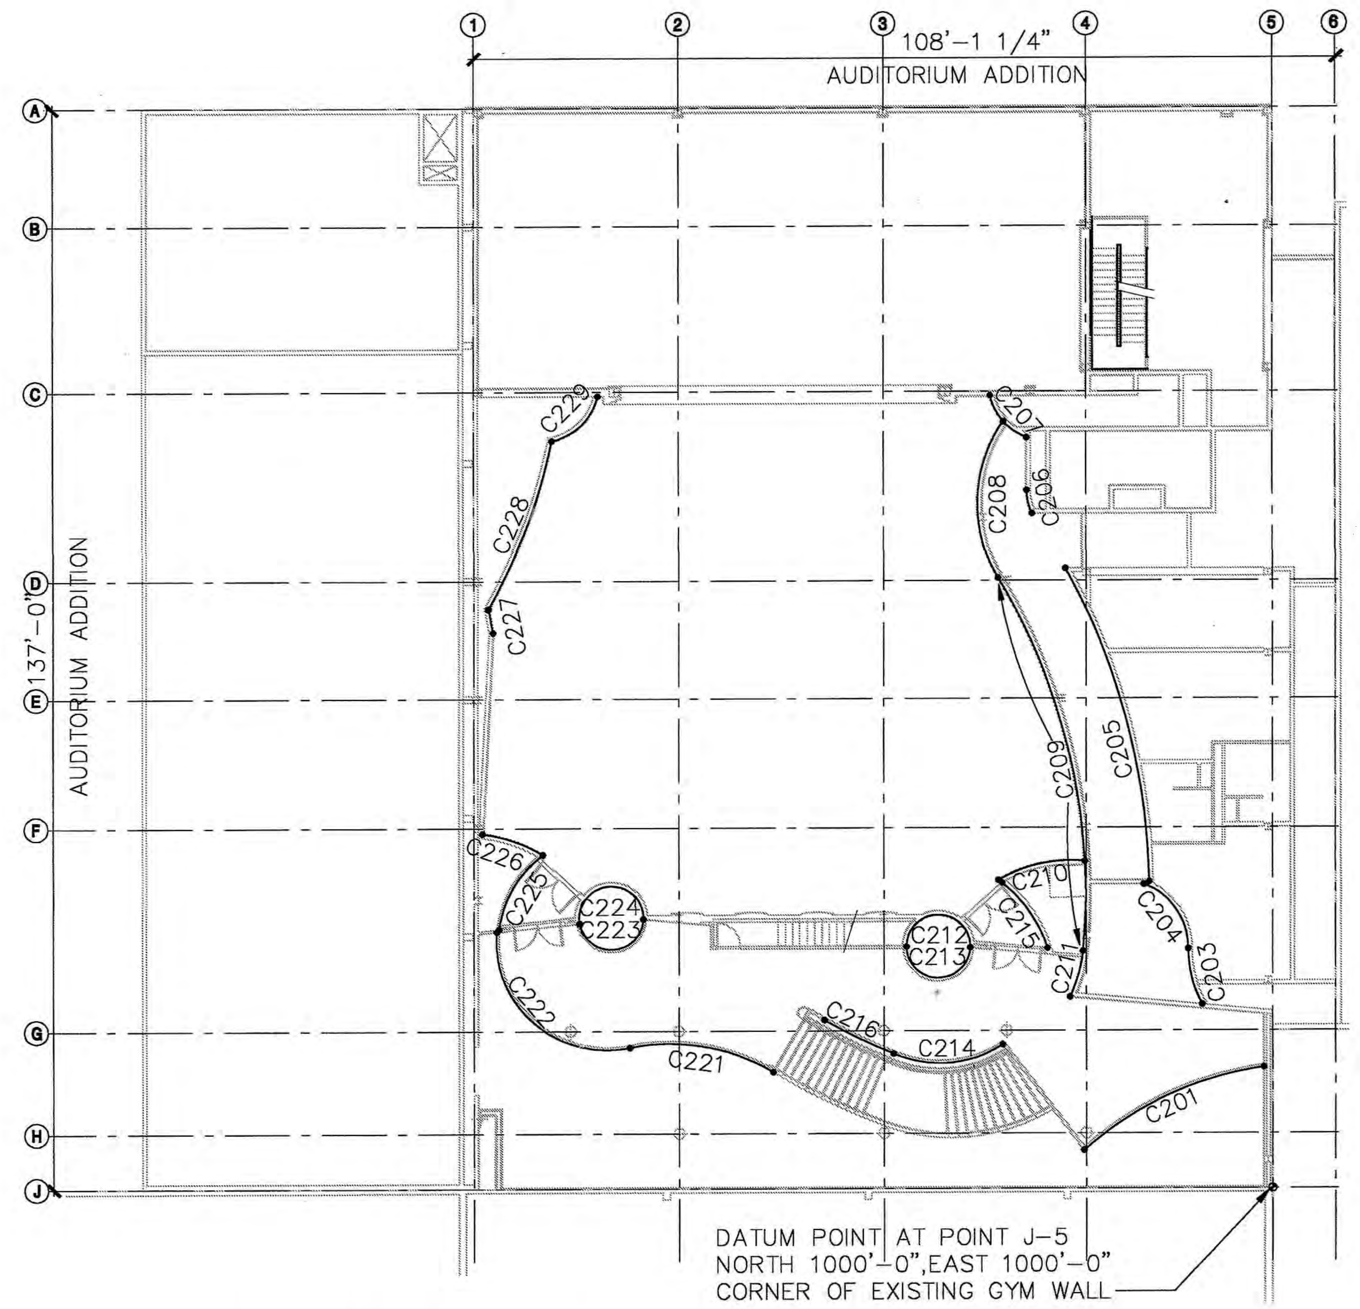

BALCONY LEVEL

SCALE: 1/16" = 1'-0"

0 4' 8' 16' 24' 32' 40'

PLAN NORTH

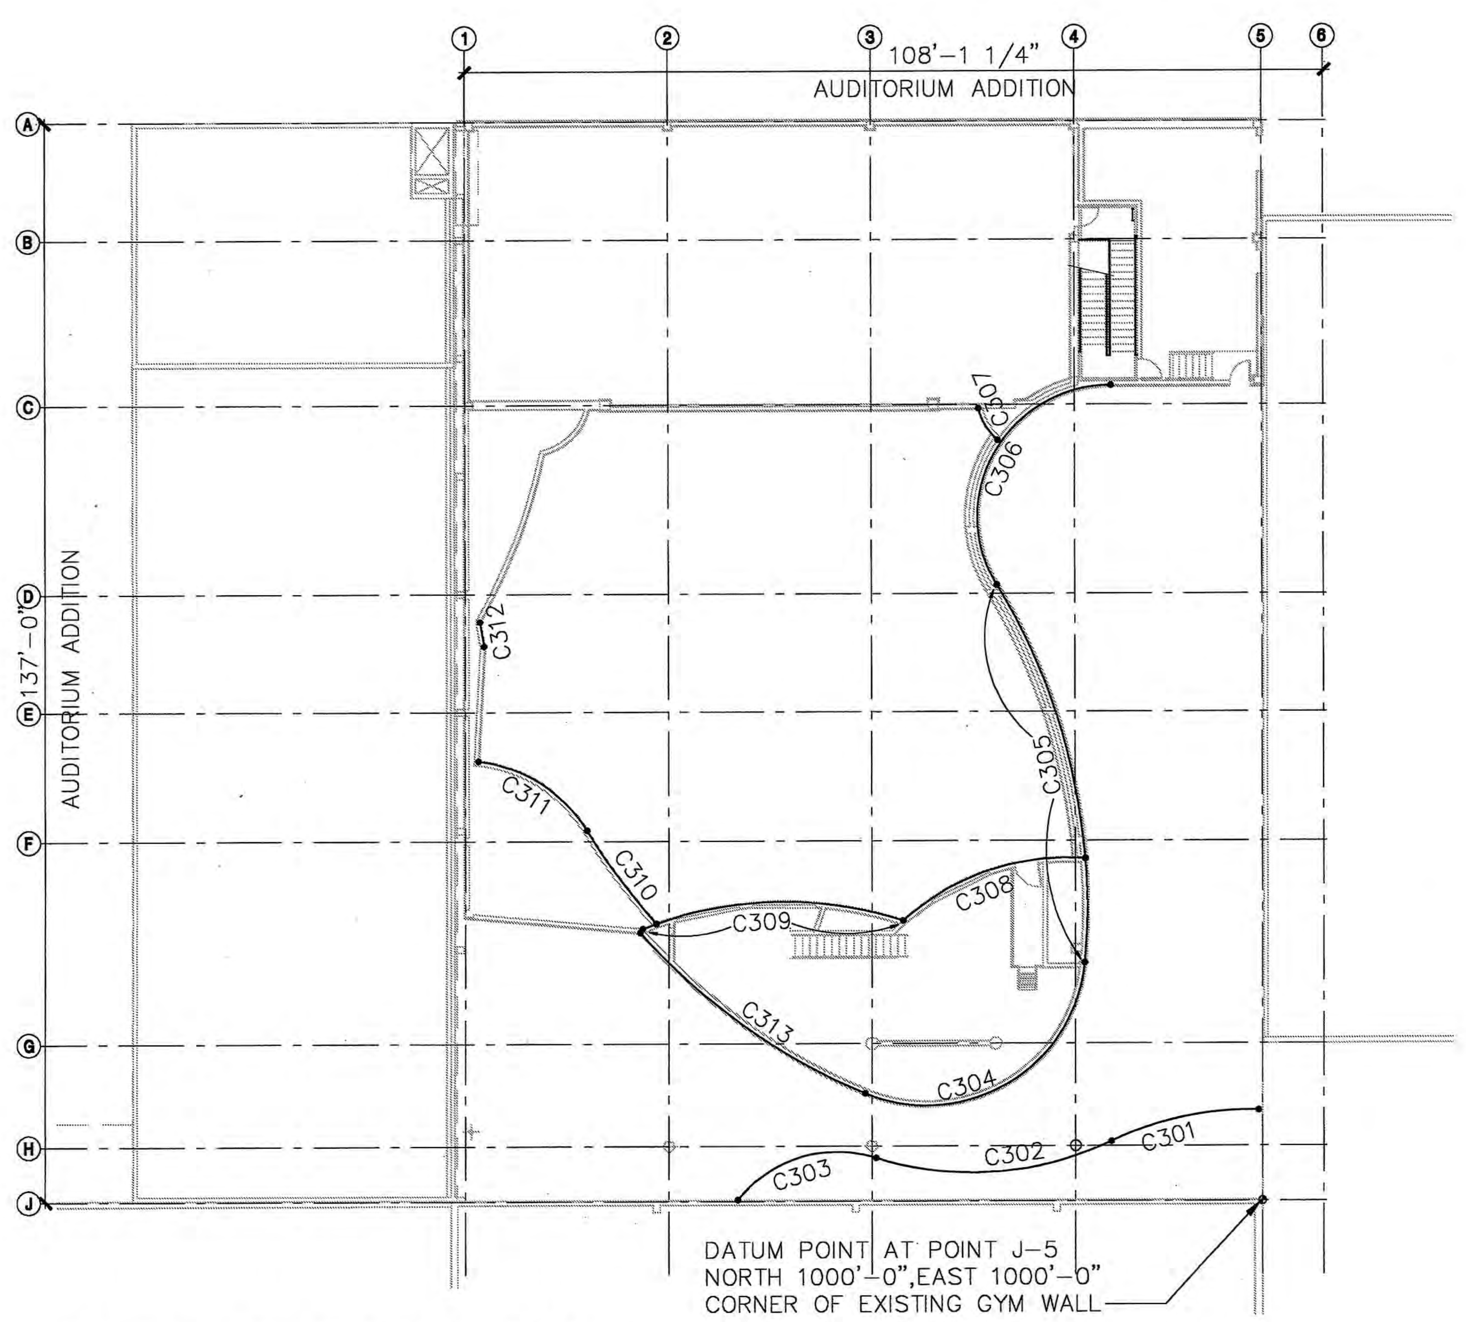

CONTROL ROOM LEVEL

SCALE: 1/16" = 1'-0"

0 4' 8' 16' 24' 32' 40'

PLAN NORTH

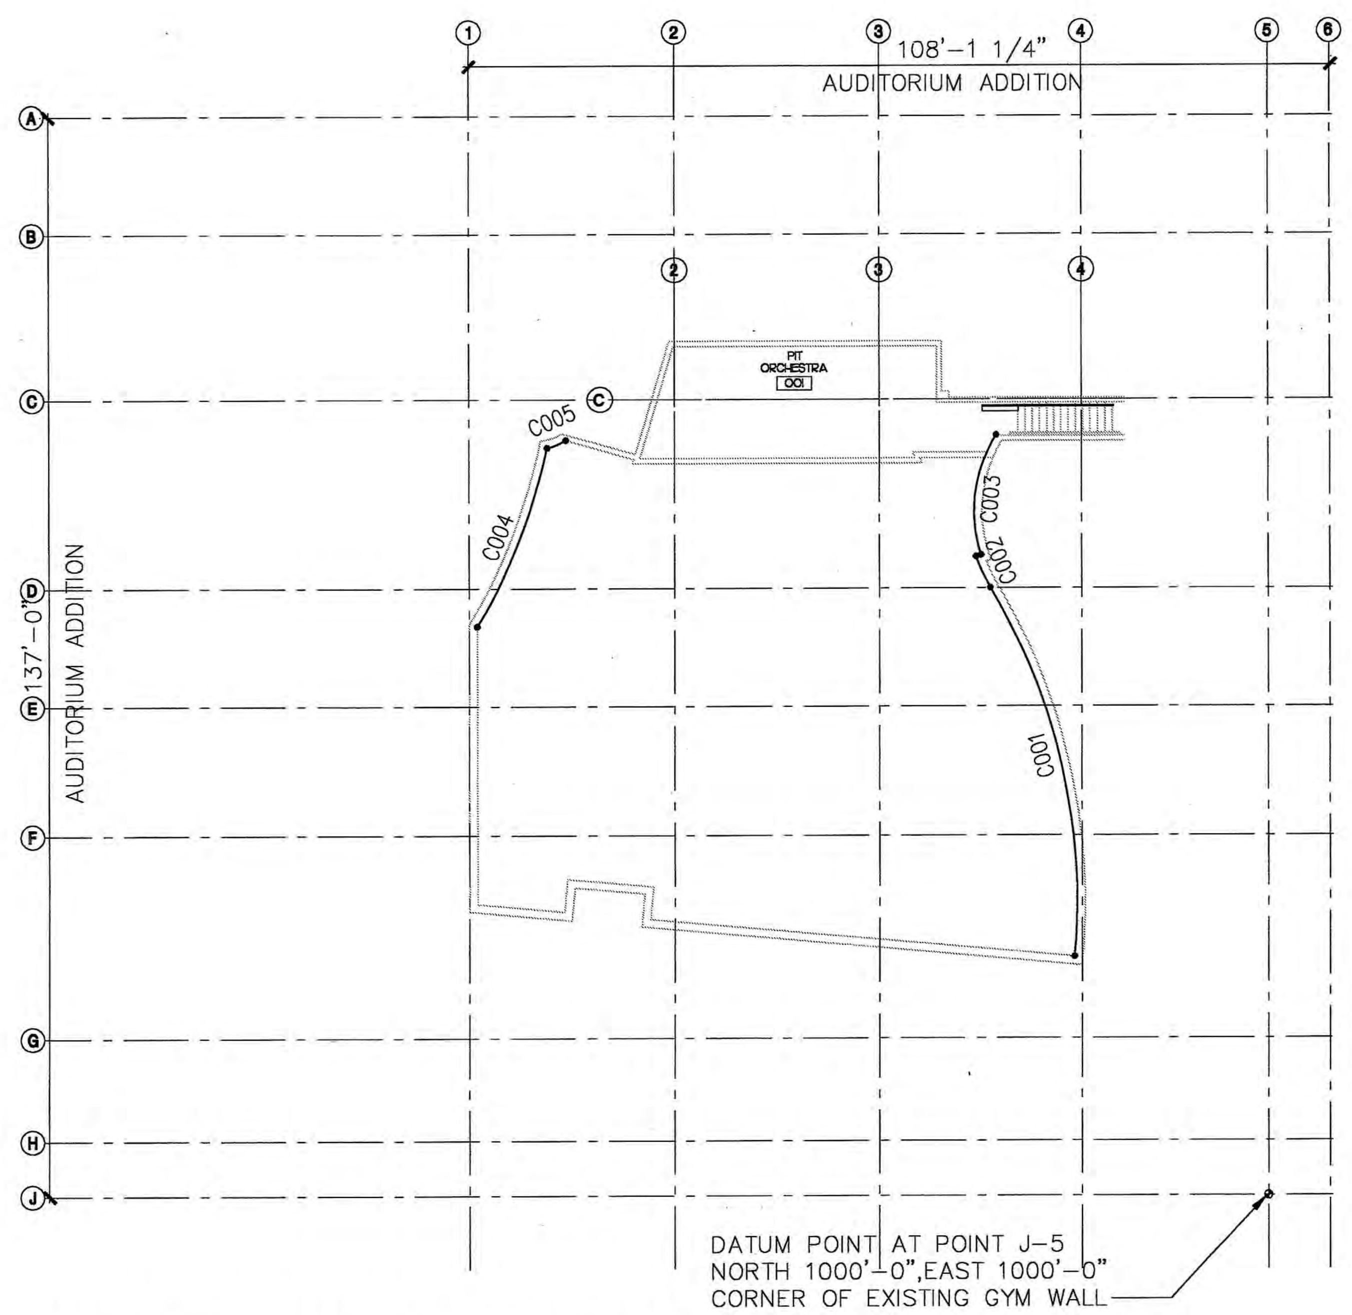

ORCHESTRA PIT LEVEL/FOUNDATION WALLS

SCALE: 1/16" = 1'-0"

4' 8' 16' 24' 32' 40'

PLAN NORTH

Orchestra Pit and Foundation Walls Curve Data

Curve	Radius Point				Curve	Beginning Point		Ending Point	
No.	North	East	Radius	Angle A	Length	North	East	North	East
C001	1101.32'	1037.30'	77.20'	36d10'31"	48.74'	1024.45'	1030.29'	1035.13'	1077.02'
C002	1019.00'	1086.70'	18.80'	13d20'33"	4.38'	1036.92'	1081.00'	1035.13'	1077.02'
C003	1019.00'	1086.70'	18.16'	49d59'29"	15.84'	1034.34'	1096.42'	1036.31'	1081.20'
C004	1162.79'	1109.79'	73.84'	18d57'46"	24.44'	1099.25'	1072.18'	1090.48'	1094.87'
C005	1092.06'	1102.13'	7.43'	19d47'49"	2.57'	1090.48'	1094.87'	1088.11'	1095.84'

NOTE: Curve data is based on reference point located at SE outside corner of gymnasium wall.

Lobby Level Curve Data

Curve	Radius Point				Curve	Beginning Point		Ending Point	
No.	North	East	Radius	Angle A	Length	North	East	North	East
C101	1001.64'	973.88'	41.73'	22d16'13"	16.22'	981.79'	1010.59'	997.18'	1015.37'
C102	995.57'	1030.30'	15.01'	83d51'26"	21.97'	1010.59'	1030.30'	997.18'	1015.37'
C103	1019.19'	1030.41'	8.60'	65d49'11"	9.88'	1010.59'	1030.30'	1015.56'	1038.21'
C104	1101.32'	1037.30'	85.77'	27d34'0"	41.27'	1015.57'	1039.01'	1026.09'	1078.50'
C105	1101.32'	1037.30'	77.77'	6d55'40"	9.40'	1030.25'	1068.87'	1034.58'	1077.22'
C107	1019.00'	1086.70'	18.23'	39d30'14"	12.57'	1035.92'	1093.49'	1036.38'	1081.18'
C108	1028.27'	1102.13'	7.50'	56d15'5"	7.36'	1035.59'	1100.50'	1030.97'	1095.14'
C110	1083.14'	1034.33'	4.00'	78d57'42'	12.49'	1079.15'	1034.01'	1087.12'	1034.73'
C112	1162.79'	1109.79'	73.91'	17d43'45"	22.87'	1098.41'	1073.48'	1090.42'	1094.81'
C113	1092.06'	1102.13'	7.50'	64d45'45"	8.48'	1090.42'	1094.81'	1084.74'	1100.50'

NOTE: Curve data is based on reference point located at SE outside corner of gymnasium wall.

Balcony Level Curve Data

Curve	Radius Point				Curve	Beginning Point		Ending Point	
No.	North	East	Radius	Angle A	Length	North	East	North	East
C201	995.23'	972.90'	42.83'	33d54'50"	25.35'	1001.09'	1015.33'	1023.77'	1004.84'
C203	995.57'	1030.30'	15.01'	27d57'26"	7.33'	1010.59'	1030.30'	1008.83'	1023.26'
C204	1019.19'	1030.41'	8.60'	70d55'52"	10.65'	1010.59'	1030.30'	1016.27'	1038.50'
C205	1101.32'	1037.30'	85.77'	27d41'45"	41.46'	1015.57'	1038.82'	1026.09'	1078.50'
C206	1024.52'	1088.36'	6.45'	27d9'40"	3.06'	1030.97'	1088.46'	1030.31'	1085.50'
C207	1028.27'	1102.13'	7.50'	56d15'27"	7.36'	1035.59'	1100.50'	1030.97'	1095.14'
C208	1019.00'	1086.69'	18.23'	66d6'58"	21.04'	1033.91'	1097.19'	1034.64'	1077.32'
C209	1101.33'	1037.30'	77.77'	36d19'59"	49.32'	1023.90'	1030.02'	1034.64'	1077.32'
C210	1025.50'	1023.50'	18.00'	36d9'30"	11.36'	1023.66'	1041.41'	1034.58'	1039.04'
C211	1042.16'	1032.00'	18.37'	18d46'7"	6.02'	1025.50'	1024.25'	1023.90'	1030.02'
C212	1042.23'	1030.67'	4.00'	182d39'1"	12.75'	1038.23'	1030.52'	1046.23'	1030.63'
C213	1042.23'	1030.67'	4.00'	177d20'59"	12.38'	1046.23'	1030.63'	1038.23'	1030.52'
C214	1042.03'	1030.77'	14.87'	55d29'6"	14.40'	1047.87'	1017.10'	1034.07'	1018.21'
C215	1045.42'	1024.67'	18.00'	32d32'27"	10.22'	1028.37'	1030.43'	1034.15'	1038.70'
C216	1019.00'	1086.69'	75.34'	7d20'34"	9.66'	1056.52'	1021.36'	1047.87'	1017.10'
C221	1075.84'	993.71'	24.71'	43d6'28"	18.59'	1062.96'	1014.79'	1080.84'	1017.91'
C222	1083.63'	1031.42'	13.79'	106d29'27"	25.63'	1097.37'	1032.58'	1080.84'	1017.91'
C223	1083.14'	1034.33'	4.00'	167d42'4"	11.71'	1087.08'	1033.62'	1079.14'	1034.19'
C224	1083.14'	1034.33'	4.00'	192d17'56"	13.43'	1079.14'	1034.19'	1087.08'	1033.62'
C225	1083.63'	1031.42'	13.50'	47d31'36"	11.20'	1091.59'	1042.32'	1097.05'	1032.90'
C226	1101.30'	1026.76'	18.33'	25d10'49"	8.06'	1091.59'	1042.32'	1099.13'	1044.97'
C227	1018.74'	1086.78'	80.77'	2d11'13"	3.08'	1098.41'	1073.48'	1097.85'	1070.45'
C228	1163.67'	1110.11'	74.83'	17d30'32"	22.87'	1098.41'	1073.48'	1090.42'	1094.81'
C229	1092.06'	1102.13'	7.50'	64d26'10"	8.43'	1090.42'	1094.81'	1084.75'	1100.46'

NOTE: Curve data is based on reference point located at SE outside corner of gymnasium wall.

Control Room Level Curve Data

Curve	Radius Point				Curve	Beginning Point		Ending Point	
No.	North	East	Radius	Angle A	Length	North	East	North	East
C301	1001.73'	971.52'	40.00'	27d28'6"	19.18'	1000.50'	1011.50'	1019.08'	1007.56'
C302	1036.42'	1043.60'	40.00'	43d23'22"	30.29'	1048.58'	1005.49'	1019.08'	1007.56'
C303	1053.44'	990.25'	16.00'	69d23'29"	19.38'	1048.58'	1005.49'	1066.00'	1000.17'
C304	1042.16'	1032.00'	19.87'	107d49'32"	37.40'	1049.91'	1013.70'	1022.37'	1030.22'
C305	1101.32'	1037.30'	79.27'	36d5'14"	49.93'	1022.37'	1030.22'	1033.35'	1078.09'
C306	1019.00'	1086.69'	16.73'	120d57'50"	35.32'	1019.00'	1103.42'	1033.35'	1078.09'
C307	1028.27'	1102.13'	7.50'	36d24'19"	4.77'	1035.59'	1100.50'	1033.19'	1096.47'
C308	1024.64'	1013.00'	30.50'	46d37'10"	24.82'	1022.29'	1043.41'	1045.13'	1035.60'
C309	1060.16'	989.49'	48.50'	39d38'34"	33.56'	1045.13'	1035.60'	1078.00'	1034.59'
C310	1019.00'	1086.69'	77.00'	10d58'33"	14.75'	1085.03'	1047.08'	1076.28'	1035.23'
C311	1100.75'	1037.65'	18.33'	52d14'57"	16.72'	1085.03'	1047.08'	1098.58'	1055.85'
C312	1018.74'	1086.78'	80.77'	2d11'13"	3.08'	1098.41'	1073.48'	1097.85'	1070.45'
C313	1019.00'	1086.69'	79.27'	25d29'58"	35.28'	1078.33'	1034.12'	1049.91'	1013.70'

NOTE: Curve data is based on reference point located at SE outside corner of gymnasium wall.

STREETER & ASSOCIATES
ARCHITECTS AIA

185 UNIVERSITY STREET SEATTLE WA. 98101-2901
206.621.9270 F.206.621.7715 www.streeterarchitects.com

CONSULTANT

SEATTLE SCHOOL DISTRICT

DATE: MARCH, 1999

AS-BUILT

RAINIER BEACH HIGH SCHOOL PERFORMING ARTS CENTER

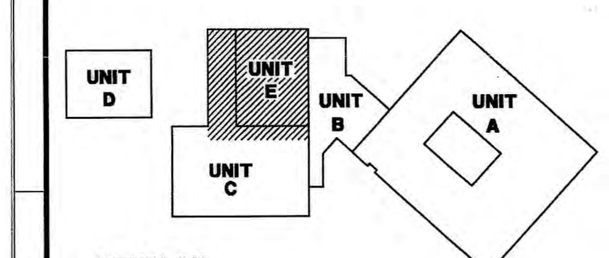

KEYPLAN

WALL ALIGNMENT PLAN

PRINCIPAL ARCH:	M STREETER	DATE: 10/01/99
PROJECT MNGR:	S CAMERON	
PROJECT ARCH:	I JAIN	
JOB CAPTAIN:	J MOORE	A-3
DRAWN BY:	MCW	
REVIEWED BY:	JAIN	SHEET NO:

NO.	REVISION	DATE	DRAWING NO.

PLOT FILE: 541A205.DWG
DATE PLOTTED: 10/01/99

02-0267

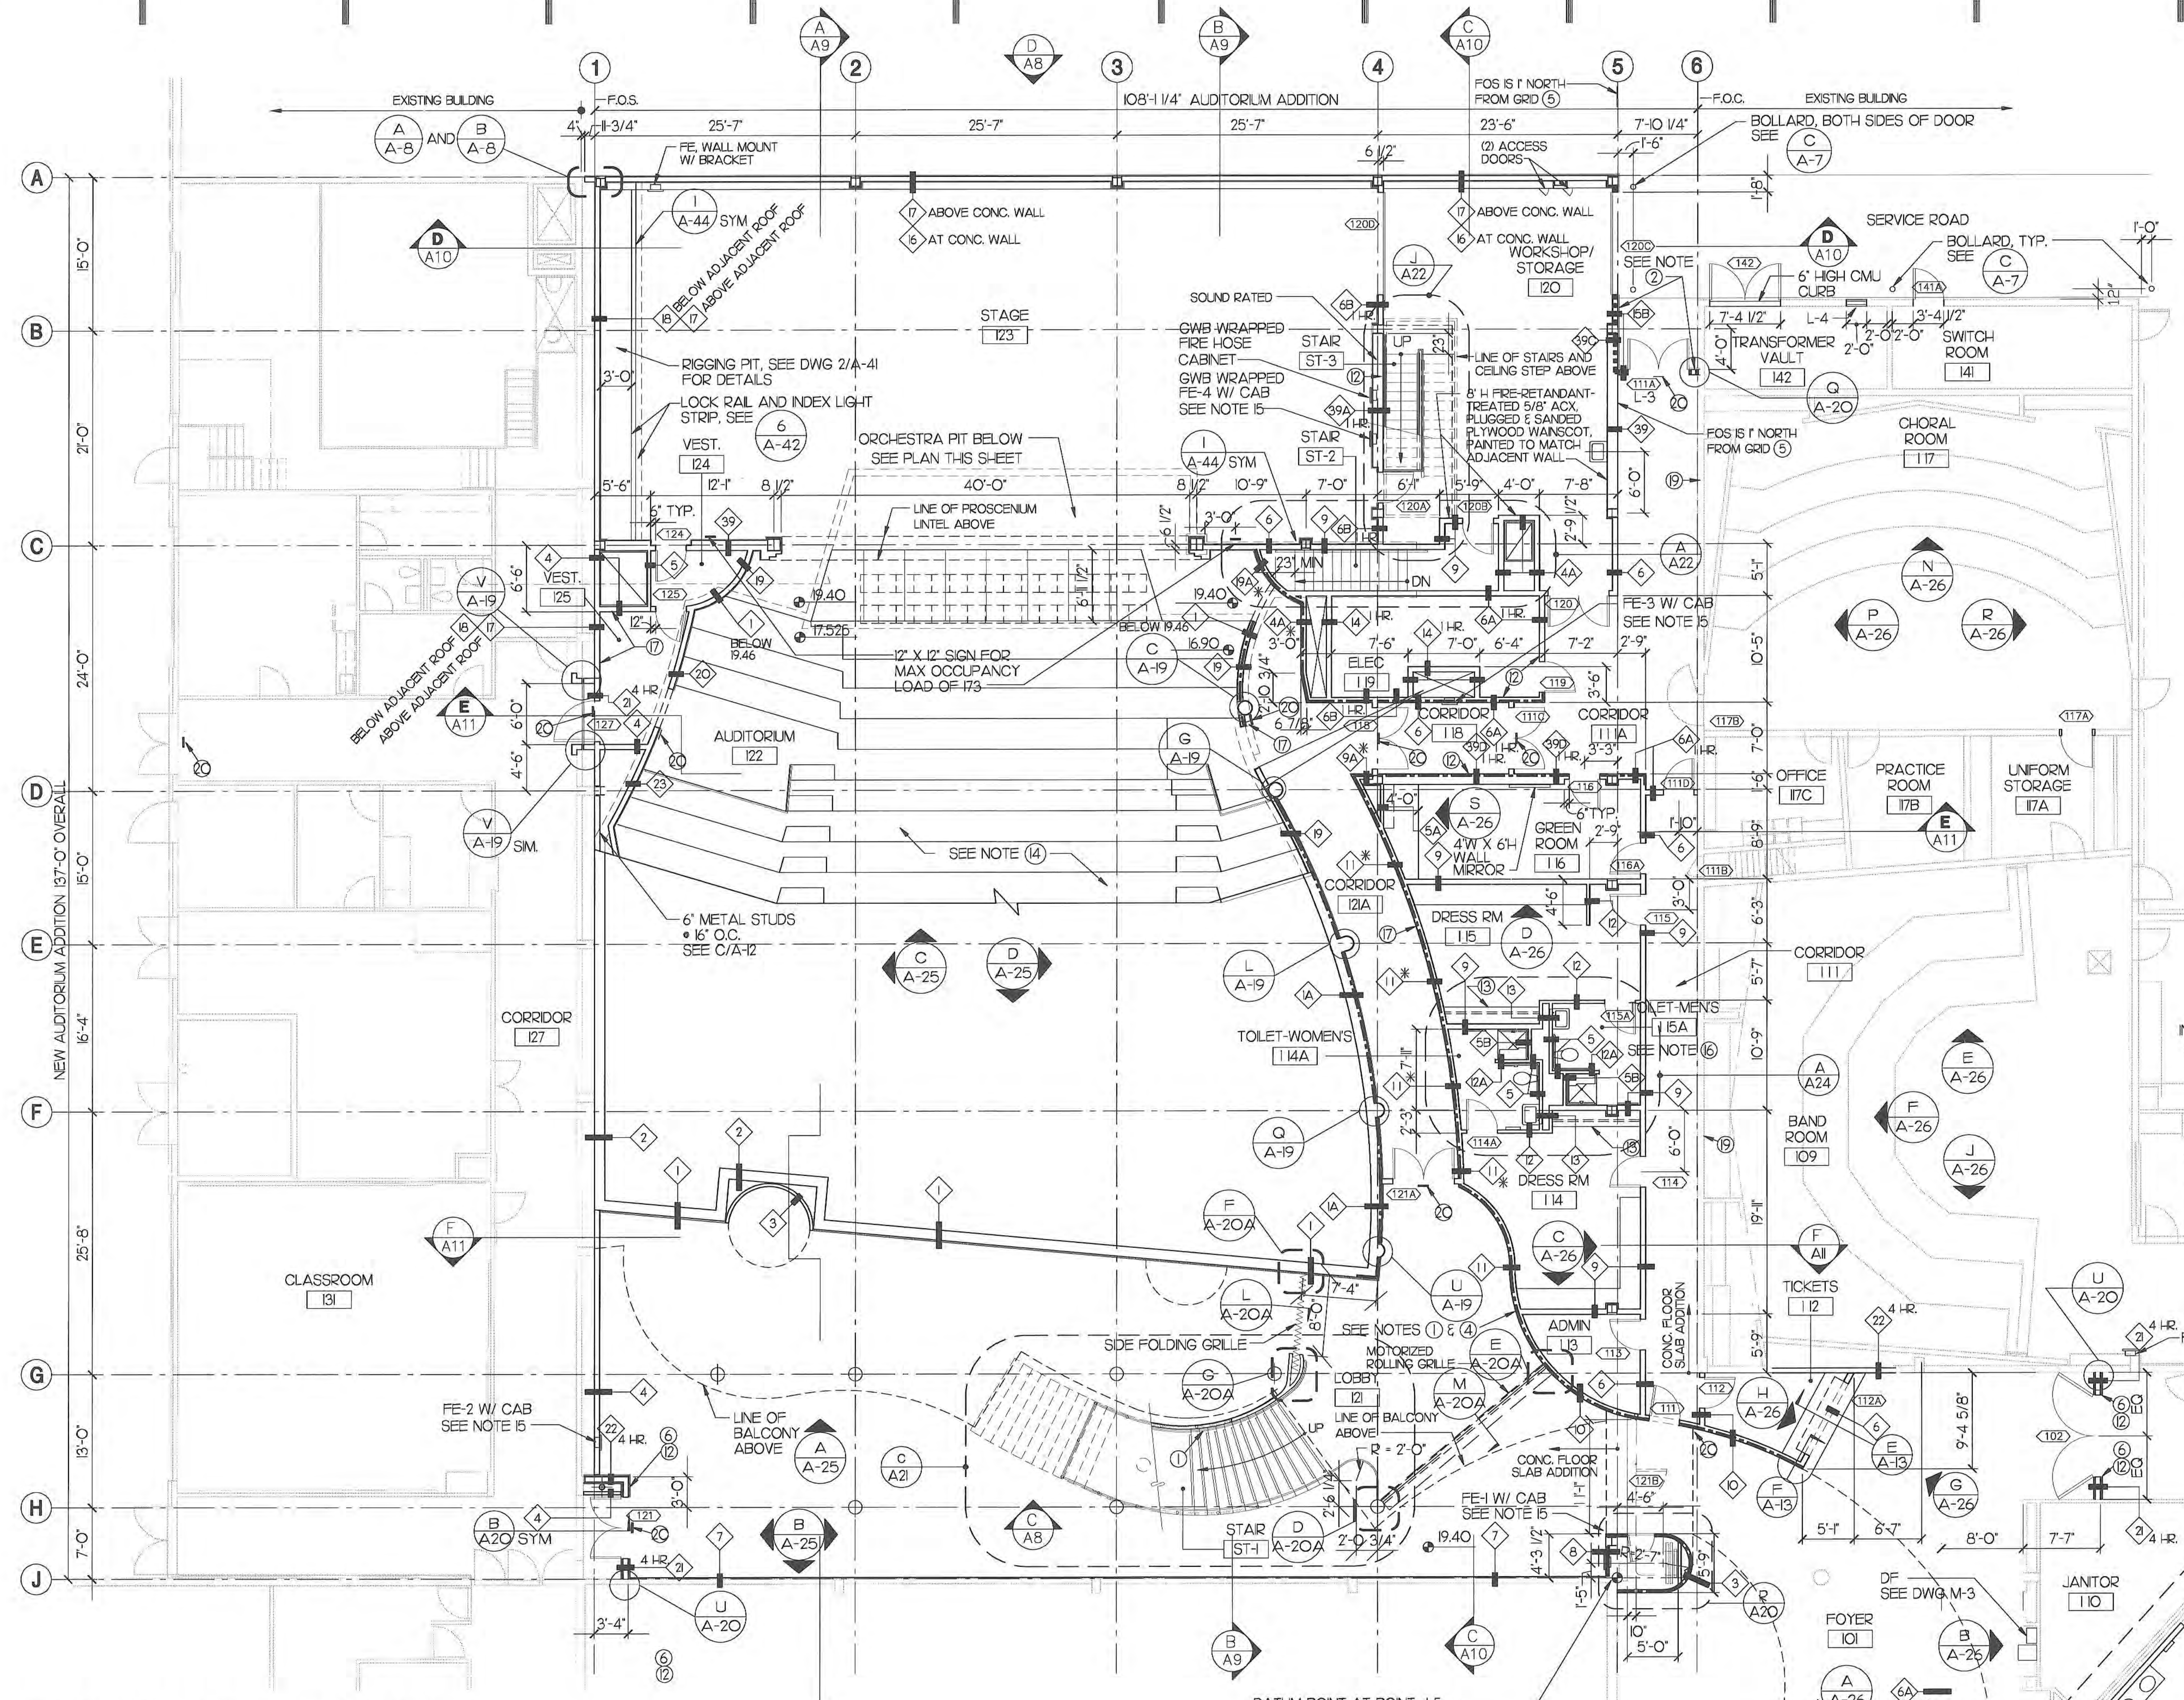

FLOOR PLAN - LOBBY LEVEL

SCALE: 1/8" = 1'-0"

0 2' 4' 8' 12' 16' 20'

PLAN NORTH

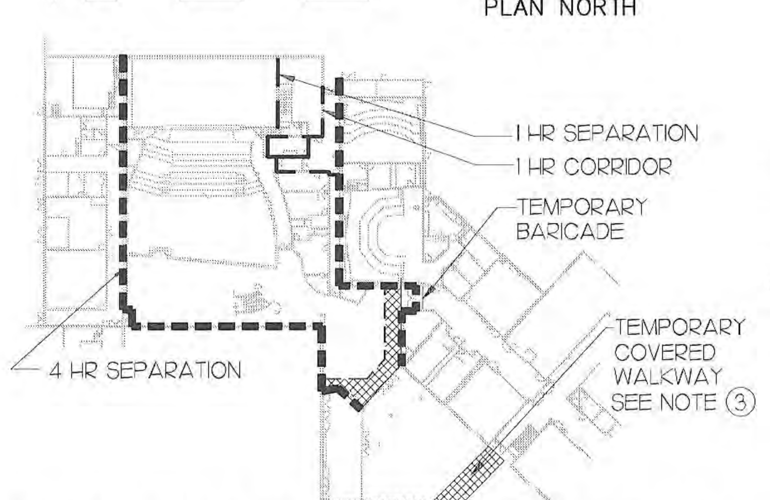

FIRE SEP/SAFETY PASSAGE

SCALE: NTS

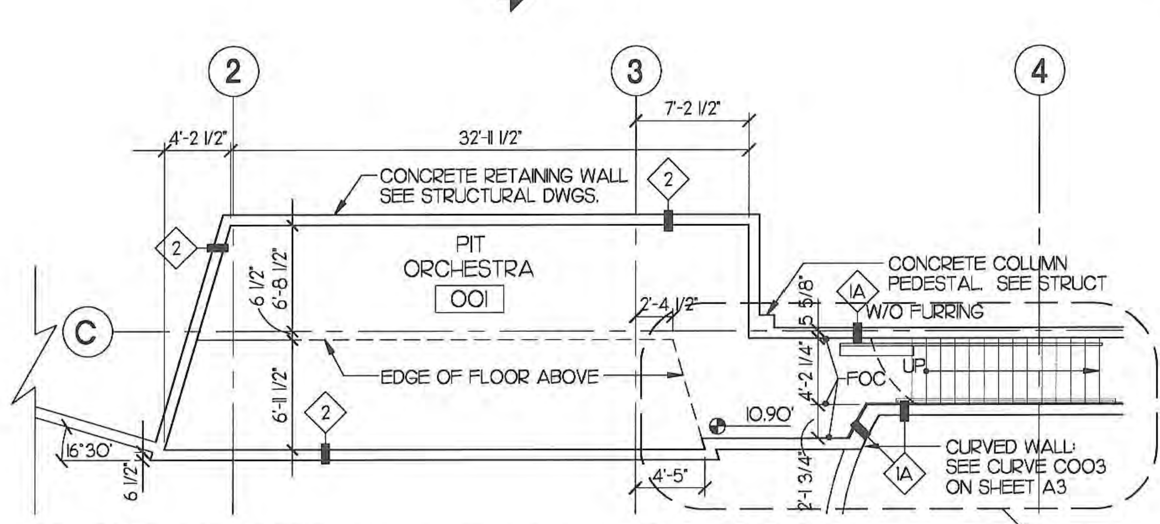

FLOOR PLAN - ORCHESTRA PIT

SCALE: 1/8" = 1'-0"

0 2' 4' 8' 12' 16' 20'

PLAN NORTH

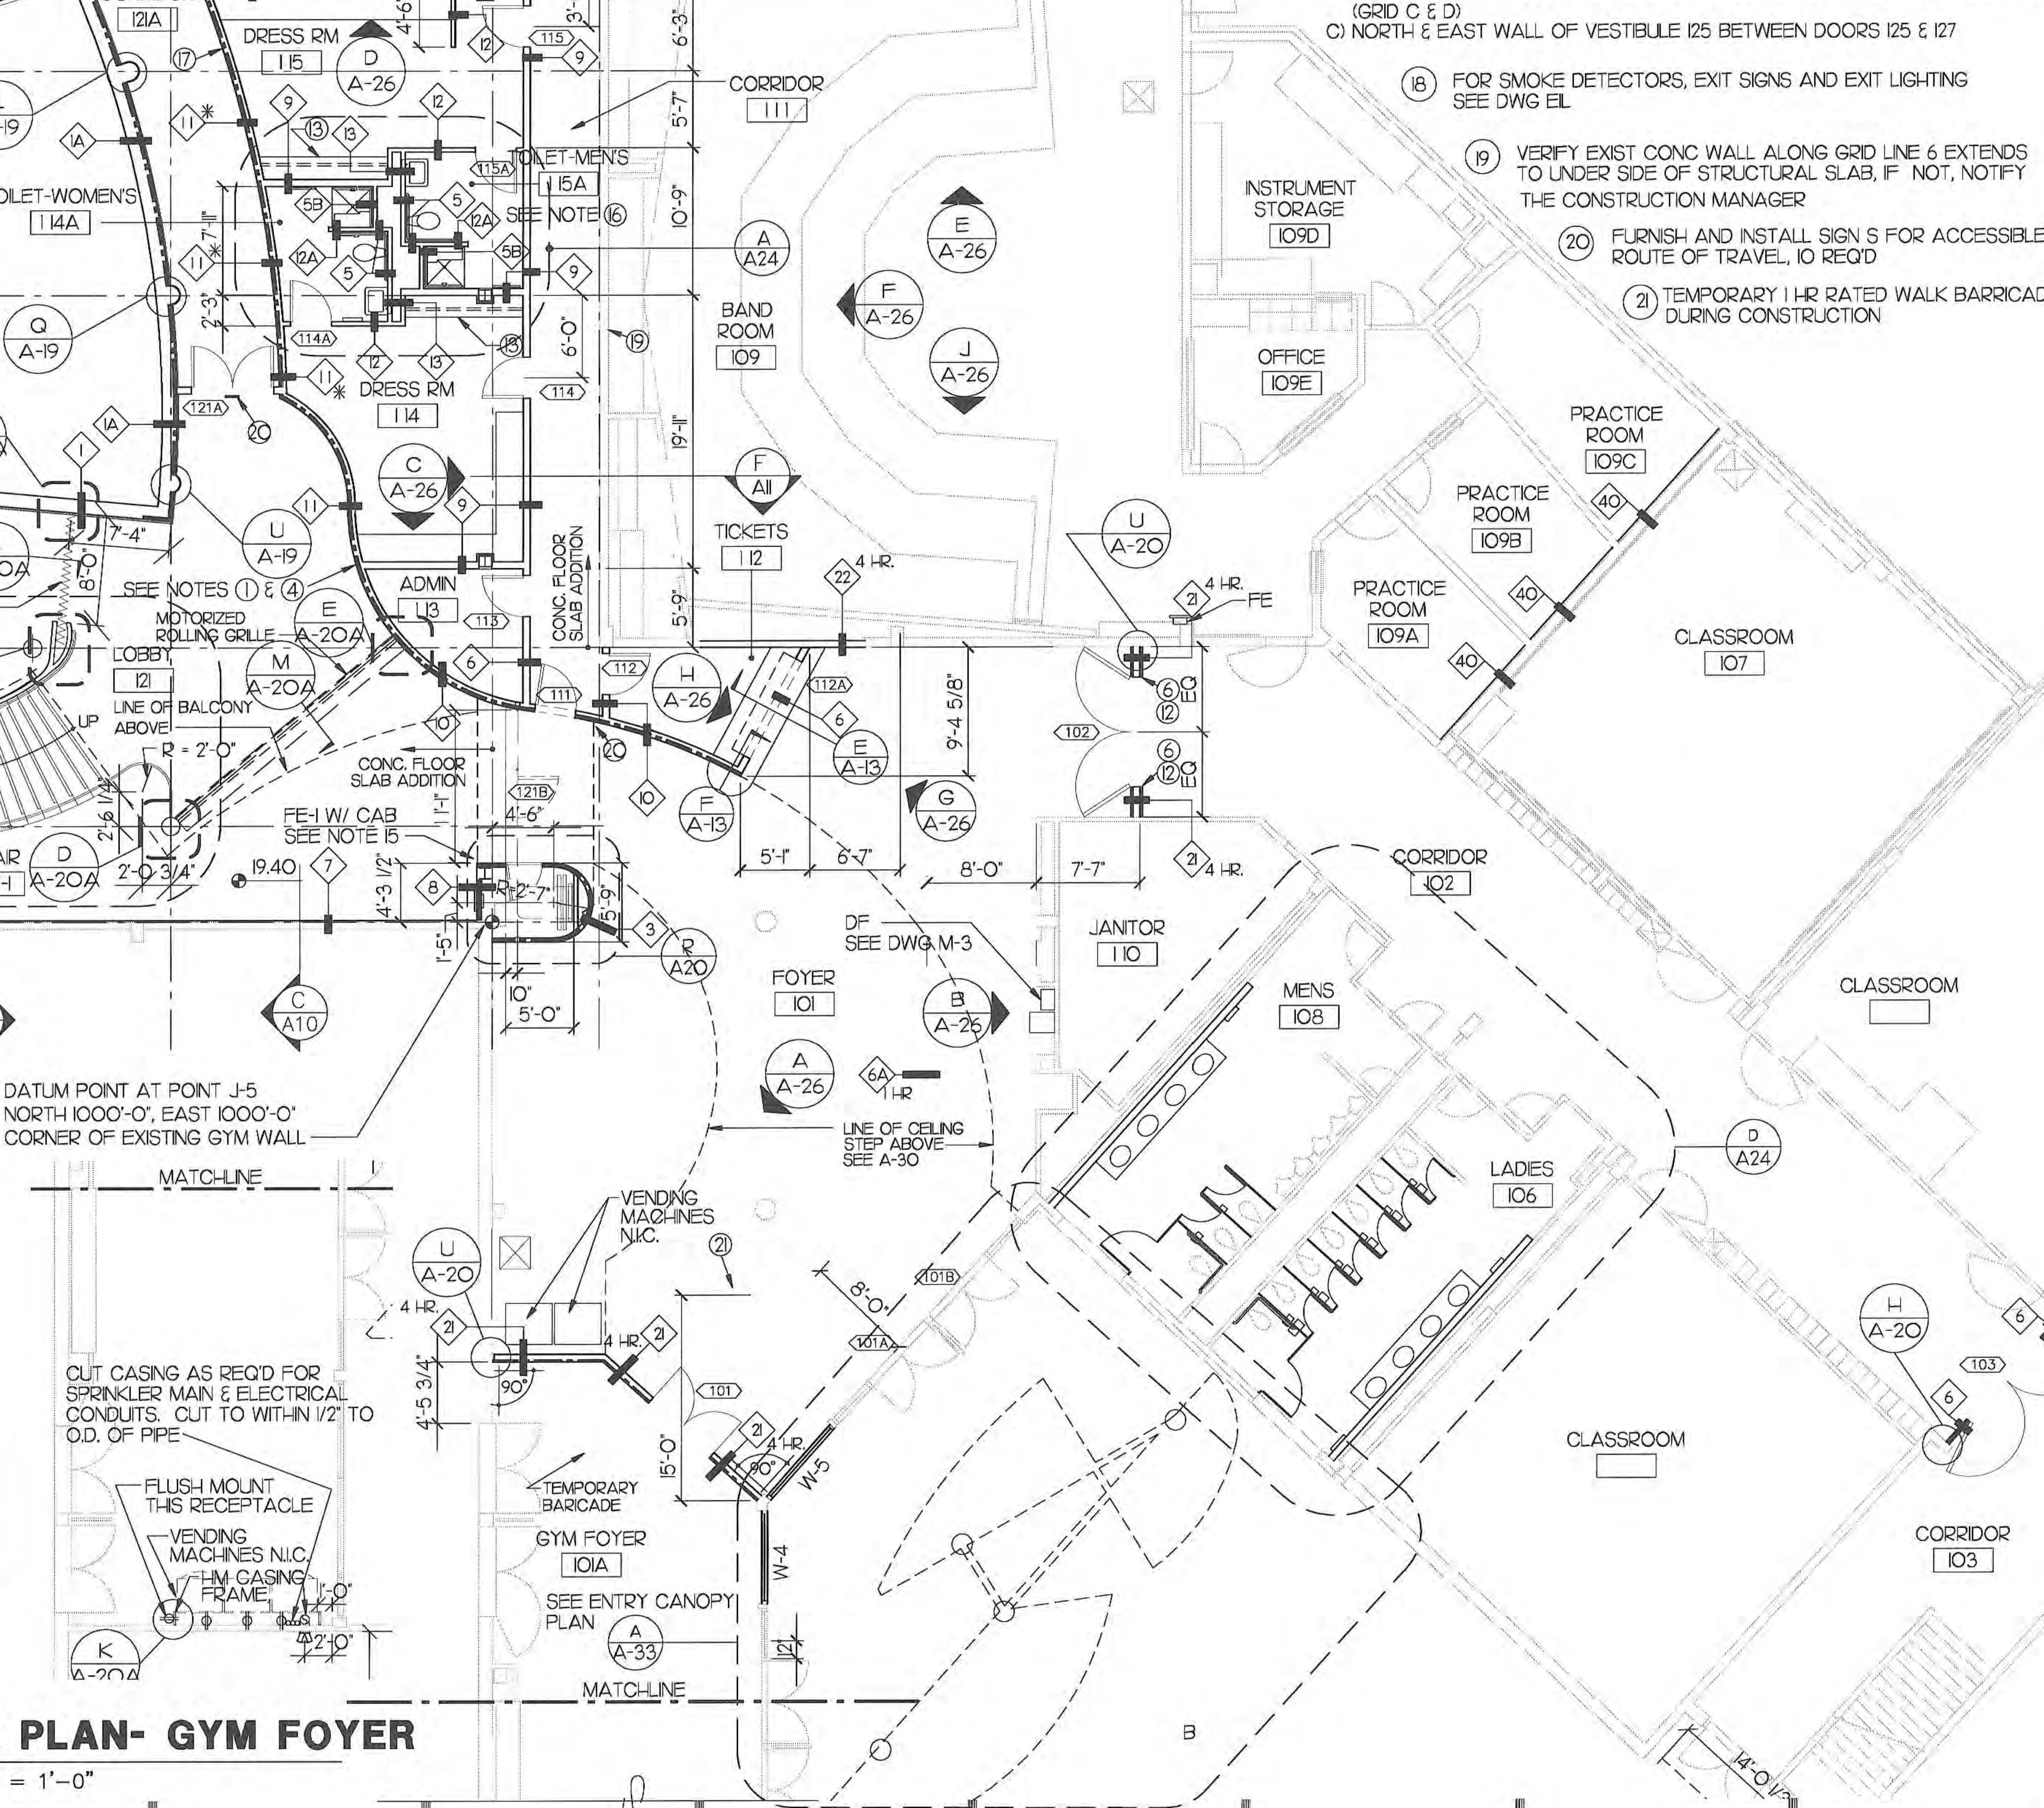

FLOOR PLAN- GYM FOYER

SCALE: 1/8" = 1'-0"

NOTES:

1. FURNISH AND INSTALL 48 INCH BY 96 INCH 26 GA. GALV SHEETS UNDER GWB ON WALLS AS INDICATED BY THIS LINE TYPE: — · — · — MOUNT BOTTOM OF SHEET METAL AT 12 INCHES ABOVE FINISH FLOOR, TYP. SEE ELEVATION A/A-4 TYP.
2. SET WALL FRAMING ON A 6 INCH HIGH BY 6 INCH CONC. CURB IN LOCATIONS INDICATED BY THIS LINETYPE: - - - - - - - -
3. CONTRACTOR SHALL PROVIDE SAFETY PASSAGE DURING CONSTRUCTION.
4. FOR LOCATION AND RADIUS OF CURVED WALLS, SEE CURVE DATA ON DRAWING A-3.
5. UNLESS OTHERWISE INDICATED, INTERIOR DOORS SHALL BE LOCATED 6" FROM FINISH FACE OF ADJACENT WALL TO INSIDE FACE OF DOOR OPENING.
6. FOR WALL TYPE DETAILS, SEE DRAWING A-29.
7. FOR DOOR SCHEDULE, SEE DRAWING A-27.
8. FOR FINISH SCHEDULE, LOUVER SCHEDULE, WINDOW & RELITE SCHEDULE, SEE DRAWING A-28.
9. INTERIOR ARCHITECTURAL WALL DIMENSIONS SHOWN ARE TO FACE OF METAL STUDS UNLESS OTHERWISE INDICATED.
10. AUDITORIUM ADDITION IS EQUIPPED THROUGHOUT WITH AN AUTOMATIC SPRINKLER SYSTEM. SEE DWG M-3.
11. SUFFIX * TO THE WALL TYPE INDICATES THAT SCHEDULED WALL TYPE INCLUDING FINISH ON ONE SIDE EXTENDS TO UNDER SIDE OF STRUCTURAL FLOOR/ROOF.
12. ALL FIRE RATED WALLS EXTEND TO THE UNDER SIDE OF STRUCTURAL SLAB. SEAL ALL VOIDS WITH FIRE SAFING AND STOPPING.
13. FURNISH AND INSTALL 1 1/2"Ø POLE AND SHELF.
14. FOR AUDITORIUM SEATING, STAGE RIGGING AND RELATED ARCHITECTURAL DETAILS, SEE DRAWINGS A-40 THROUGH A-44.
15. PROVIDE CLASS 2A FIRE EXTINGUISHERS AND FULLY RECESSED CABINET. INSTALL CABINET WITH TOP AT 54" ABOVE FINISH FLOOR.
16. IN WET AREAS, USE W.R. GWB
17. INSTALL 1" THICK 8' HIGH ACOUSTICAL WALL PANELS AT FOLLOWING LOCATIONS. KEEP PANELS 2" FROM WALL ENDS AND WALL BASE.
    A) SOUTH WALL OF CORRIDOR 121A FROM DOOR 121A TO NE CORNER OF GREEN RM 116.
    B) NORTH WALL OF CORRIDOR 121A BETWEEN ACCESSES TO AUDITORIUM 122 (GRID C & D)
    C) NORTH & EAST WALL OF VESTIBULE 125 BETWEEN DOORS 125 & 127
18. FOR SMOKE DETECTORS, EXIT SIGNS AND EXIT LIGHTING SEE DWG E1.
19. VERIFY EXIST CONC WALL ALONG GRID LINE 6 EXTENDS TO UNDER SIDE OF STRUCTURAL SLAB. IF NOT, NOTIFY THE CONSTRUCTION MANAGER
20. FURNISH AND INSTALL SIGN S FOR ACCESSIBLE ROUTE OF TRAVEL, 10 REQ'D
21. TEMPORARY 1 HR RATED WALK BARRICADE DURING CONSTRUCTION

STREETER & ASSOCIATES ARCHITECTS AIA

185 UNIVERSITY STREET SEATTLE WA. 98101-2901
206.621.9270 F.206.621.7715 www.streeterarchitects.com

CONSULTANT

SEATTLE SCHOOL DISTRICT

DATE: MARCH, 1999

AS-BUILT

RAINIER BEACH HIGH SCHOOL PERFORMING ARTS CENTER

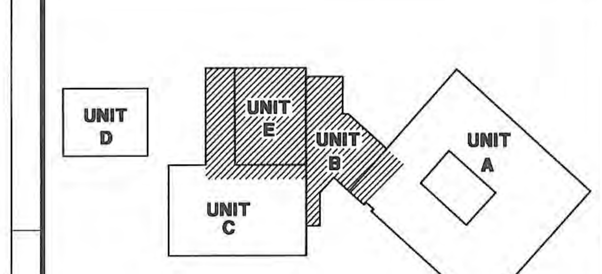

KEYPLAN

FLOOR PLAN - LOBBY LEVEL & ORCHESTRA PIT

PRINCIPAL ARCH:	M STREETER
PROJECT MNGR:	S CAMERON
PROJECT ARCH:	I JAIN
JOB CAPTAIN:	J MOORE
DRAWN BY:	STAFF
REVIEWED BY:	

DATE: 10/01/99

A-2

SHEET NO:

NO.	REVISION	DATE	DRAWING NO.

PLOT FILE: 541A201.DWG DATE PLOTTED: 10/01/99

021-0258

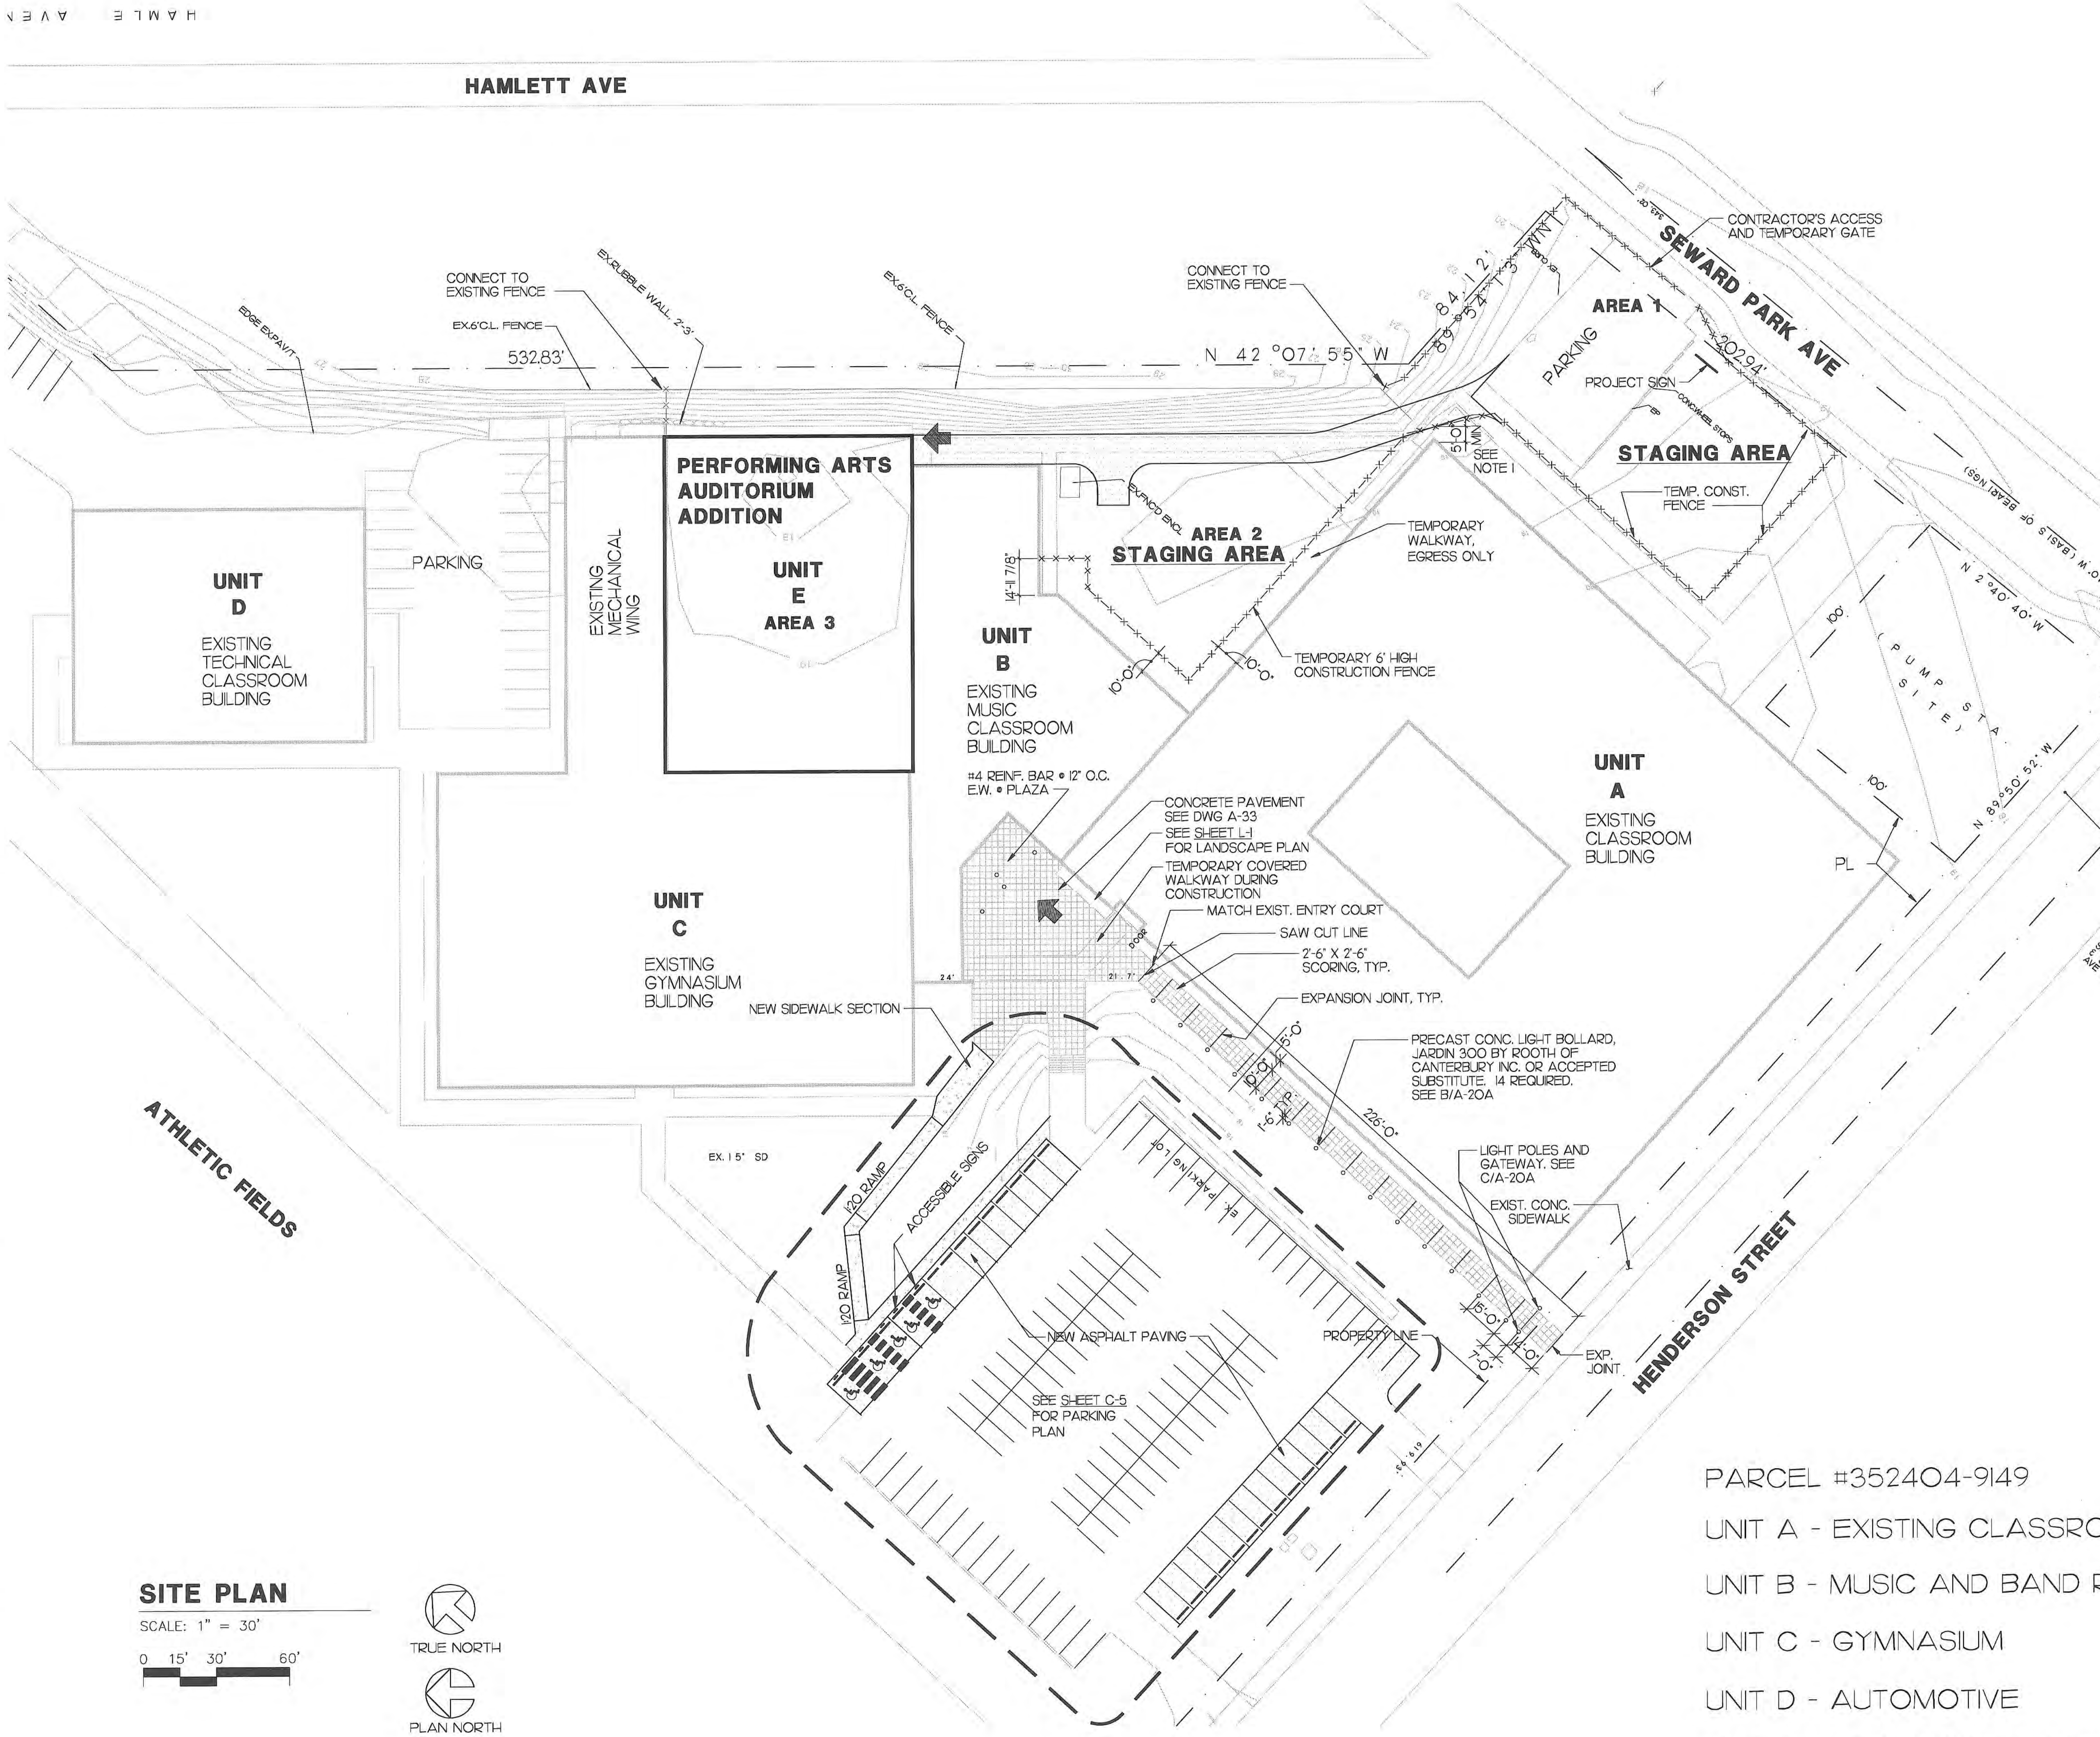

SITE PLAN

SCALE: 1" = 30'

0 15' 30' 60'

RAINIER BEACH PERFORMING ARTS CENTER

NOTE:

1. CONTRACTOR TO PROVIDE EMERGENCY PATHWAY FOR EGRESS DURING CONSTRUCTION. PATHWAY SHALL BE SURFACED W/ CRUSHED GRAVEL AS APPROVED BY CONSTRUCTION MANAGER. REMOVE VEGETATION AS REQUIRED DURING CONSTRUCTION AND REPLACE W/ SIMILAR SIZE AND TYPE OF PLANTS AT THE END OF THE PROJECT.

PARCEL #352404-9149

UNIT A - EXISTING CLASSROOM

UNIT B - MUSIC AND BAND ROOMS

UNIT C - GYMNASIUM

UNIT D - AUTOMOTIVE

UNIT E - PERFORMING ARTS CENTER ADDITION

AREA 1, 2, 3 - CONSTRUCTION STAGING AREAS

STREETER & ASSOCIATES ARCHITECTS AIA

185 UNIVERSITY STREET SEATTLE WA. 98101-2901
206.621.9270 F.206.621.7715 www.streeterarchitects.com

CONSULTANT

SEATTLE SCHOOL DISTRICT

DATE: MARCH, 1999

AS-BUILT

RAINIER BEACH HIGH SCHOOL PERFORMING ARTS CENTER

SITE PLAN

PRINCIPAL ARCH: M STREETER
PROJECT MNGR: S CAMERON
PROJECT ARCH: I JAIN
JOB CAPTAIN: J MOORE
DRAWN BY: STAFF
REVIEWED BY:

DATE: 10/01/99

A-1

SHEET NO:

NO.	REVISION	DATE	DRAWING NO.

PLOT FILE: 541A101.DWG DATE PLOTTED: 10/01/99

021-0257

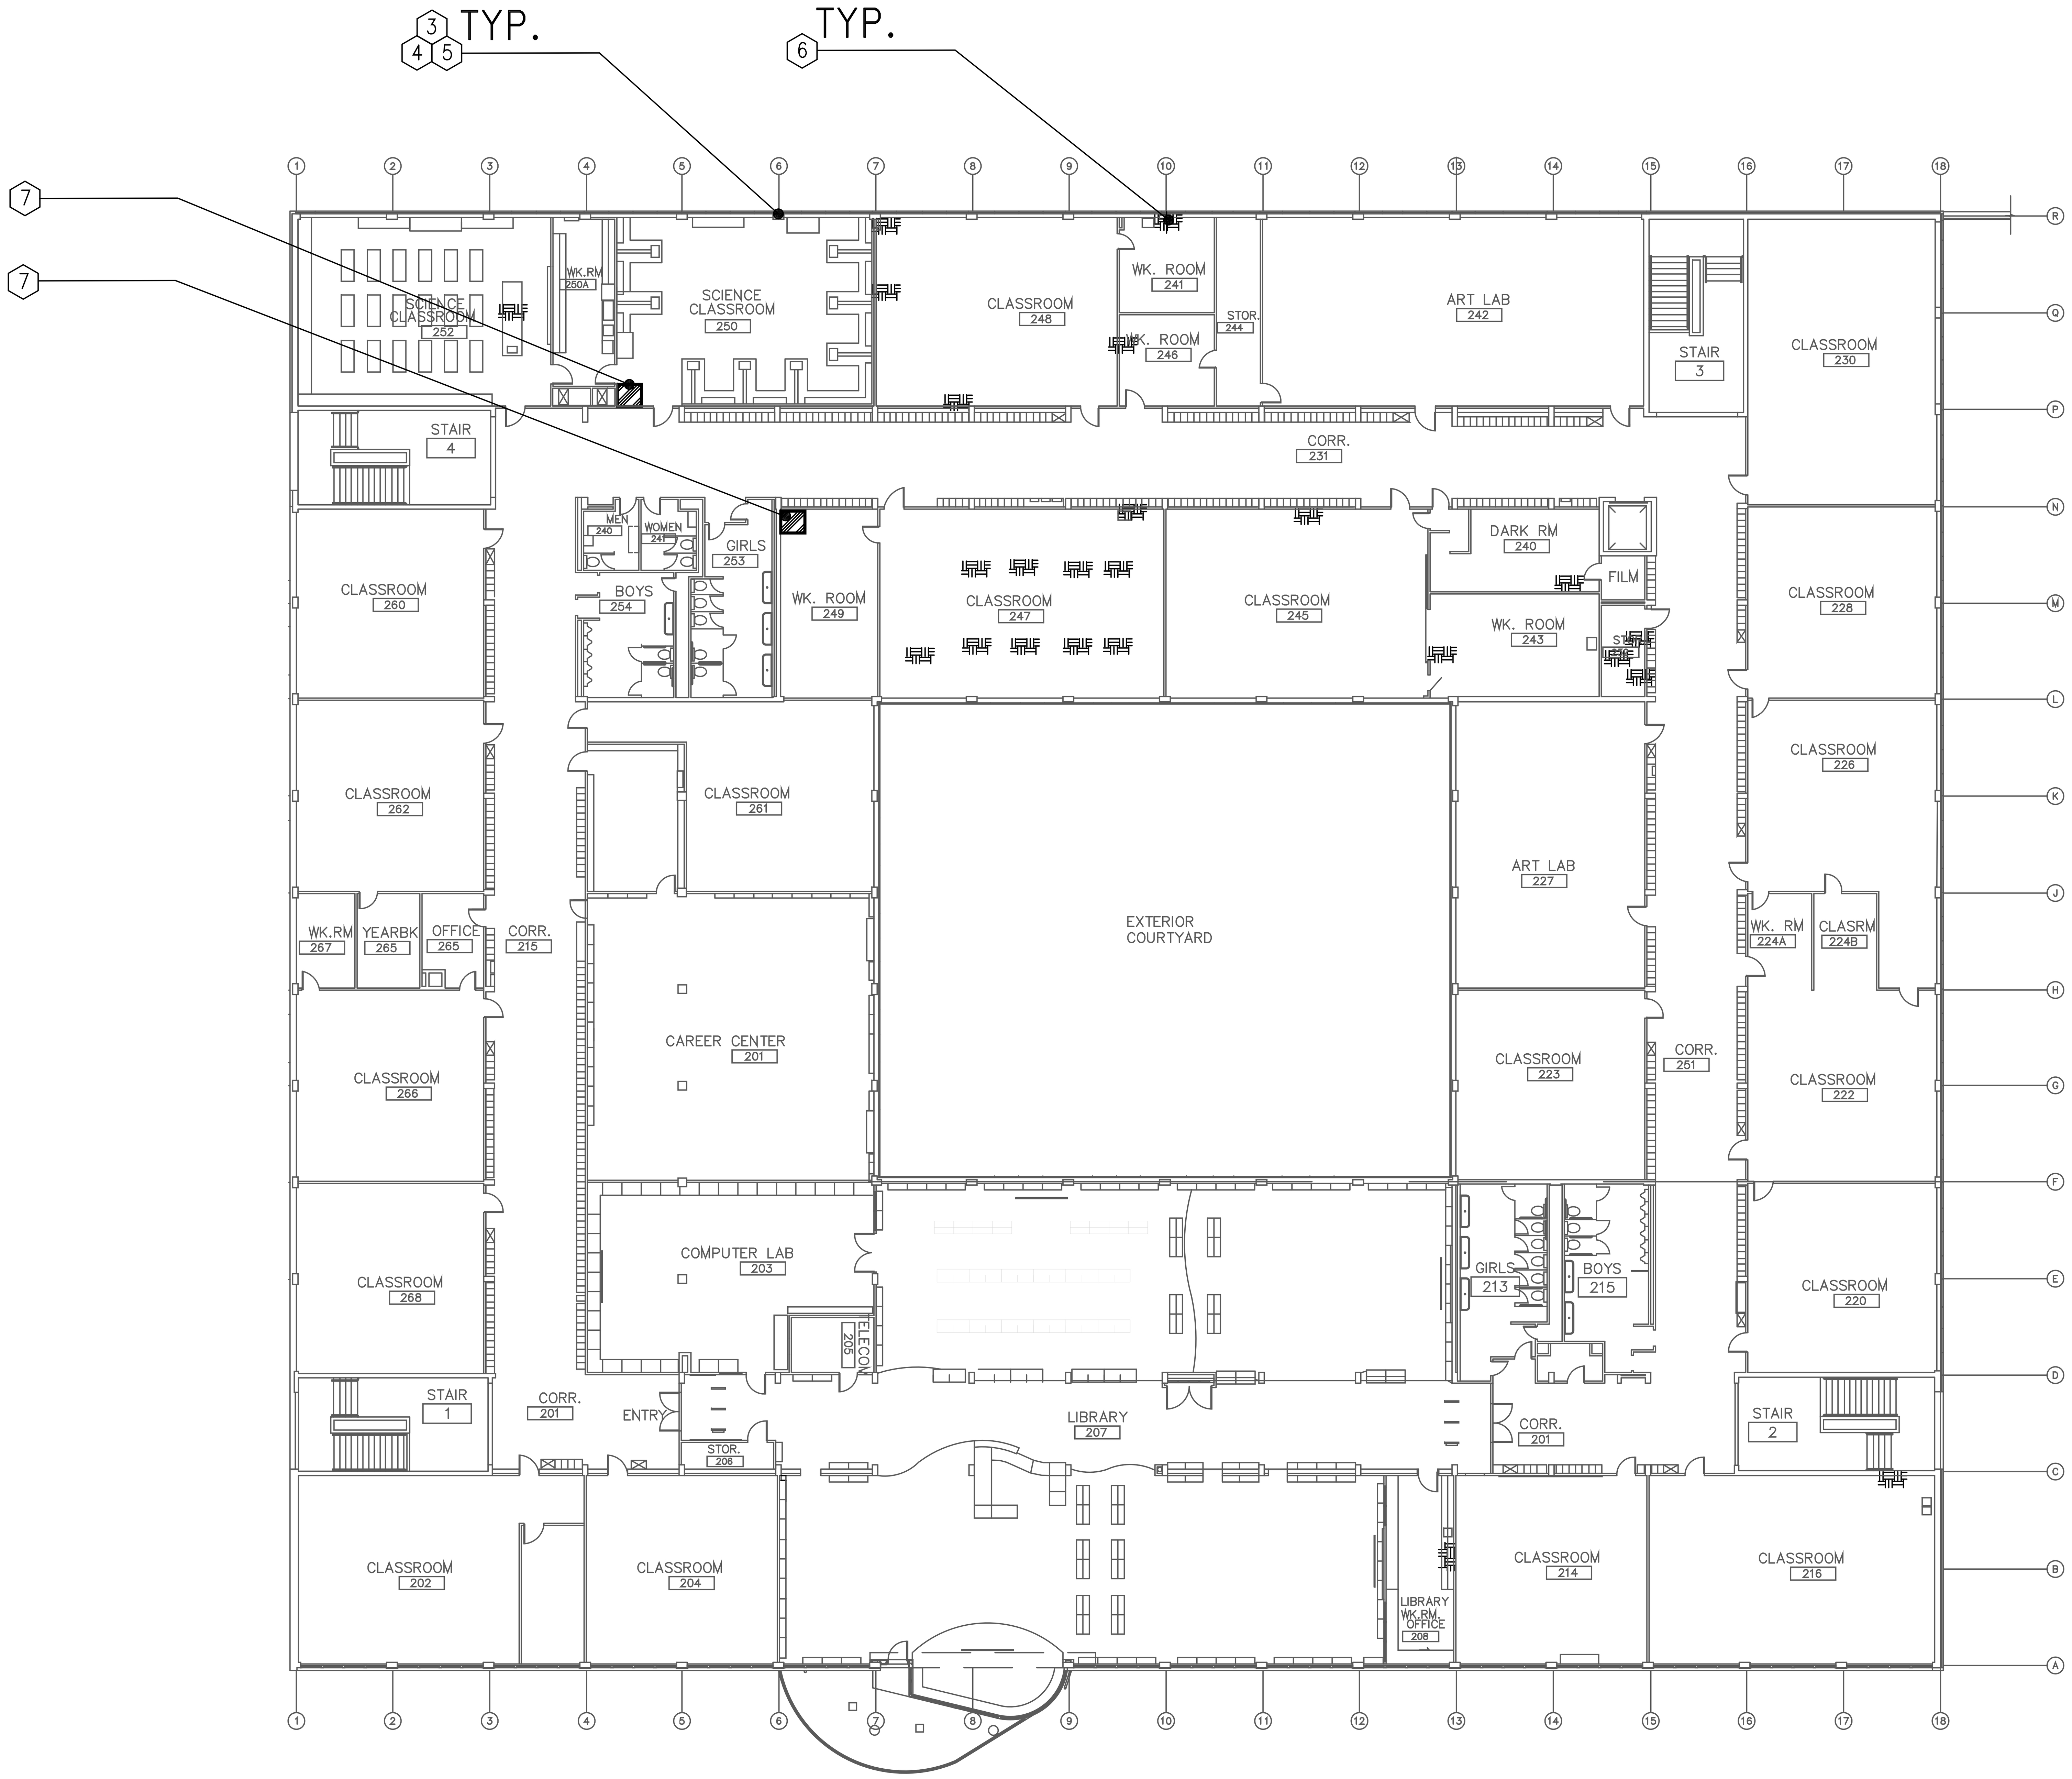

RAINIER BEACH HIGH SCHOOL
1 SECOND FLOOR PLAN-UNIT A
SCALE: NOT TO SCALE

NORTH

GENERAL NOTES

(SEE DRAWING HA 0.1)

SHEET NOTES

1. NONE
2. REPAIR DAMAGED LARGE & SMALL BORE STEAM/CONDENSATE LINE ACM TSI IN PROXIMITY TO WATERLINES IN CRAWLSPACE & TUNNELS
3. REMOVE AND DISPOSE OF SMALL BORE ACM TSI ON WATERLINE PIPE (INCLUDES FITTINGS)
4. REMOVE AND DISPOSE OF SMALL BORE ACM TSI MUDDED JOINTS AND FITTINGS ON FIBERGLASS INSULATED WATERLINE PIPE RUNS
5. REMOVE AND DISPOSE OF SMALL BORE ACM TSI MUDDED FITTINGS ON FIBERGLASS INSULATED WATERLINE PIPES CONCEALED IN WALLS, CASEWORK AND ABOVE SUSPENDED CEILING
6. REMOVE AND DISPOSE OF APPROXIMATELY 2 SF OF 9"X9" VAT AND ASSOCIATED ASSUMED ACM BLACK TILE MASTIC AT EACH PROPOSED CORE DRILL LOCATION WHERE 9"X9" VAT IS PRESENT. COORDINATE WITH MECHANICAL CONTRACTOR FOR EXACT LOCATIONS.
7. REMOVE AND DISPOSE OF APPROXIMATELY 2 SF OF 9"X9" VAT AND ASSOCIATED ASSUMED ACM BLACK TILE MASTIC AT PROPOSED SAFETY SHOWER INSTALLATION LOCATION WHERE 9"X9" VAT IS PRESENT.

LEGEND

ACCESS HATCH TO CRAWL SPACES & TUNNELS

TYP. TYPICAL OF BUILDING

APPROXIMATE LOCATIONS OF CORE DRILLING

APPROXIMATE LOCATION OF SAFETY SHOWER INSTALLATION

APPROXIMATE LOCATIONS OF ACM DEBRIS ON TUNNEL AND CRAWL SPACE FLOORS

DRAWING NOTES

DRAWING IS SCHEMATIC AND MATERIAL LOCATIONS FOR ASBESTOS ARE APPROXIMATE. REFER TO ABATEMENT SPECIFICATIONS 02080 AND 02081 FOR DETAILS

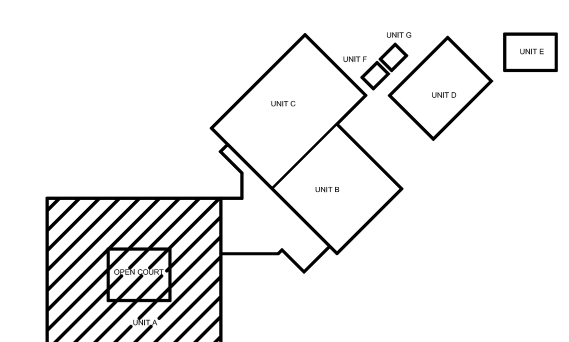

KEY PLAN

ehsi
EHS-International, Inc.
13228 NE 20th Street, Suite 100
Bellevue, Washington 98005
Ph: (425) 455-2959
Fax: (425) 646-7247

AHERA PROJECT DESIGNER
HERB BROD
CERT. NO. 104348
09/17/2010

SEATTLE PUBLIC SCHOOLS

JOHN STANFORD CENTER FOR EDUCATIONAL EXCELLENCE
2445 THIRD AVE. SOUTH
SEATTLE, WA 98134

BID NO. B01909
WATERLINE REPLACEMENT AT
RAINIER BEACH HIGH SCHOOL
8815 SEWARD PARK AVE. S.
SEATTLE, WASHINGTON 98118

1" AT FULL SCALE
If not 1 inch, this drawing has been reproduced, and is not to scale

Project No.	9645-03
Drawn	BFM
Checked	HB
Date	11/18/2009

Revisions

RECORD DRAWING
BID NO. B01909

SECOND FLOOR PLAN - UNIT A

Sheet HA2.2

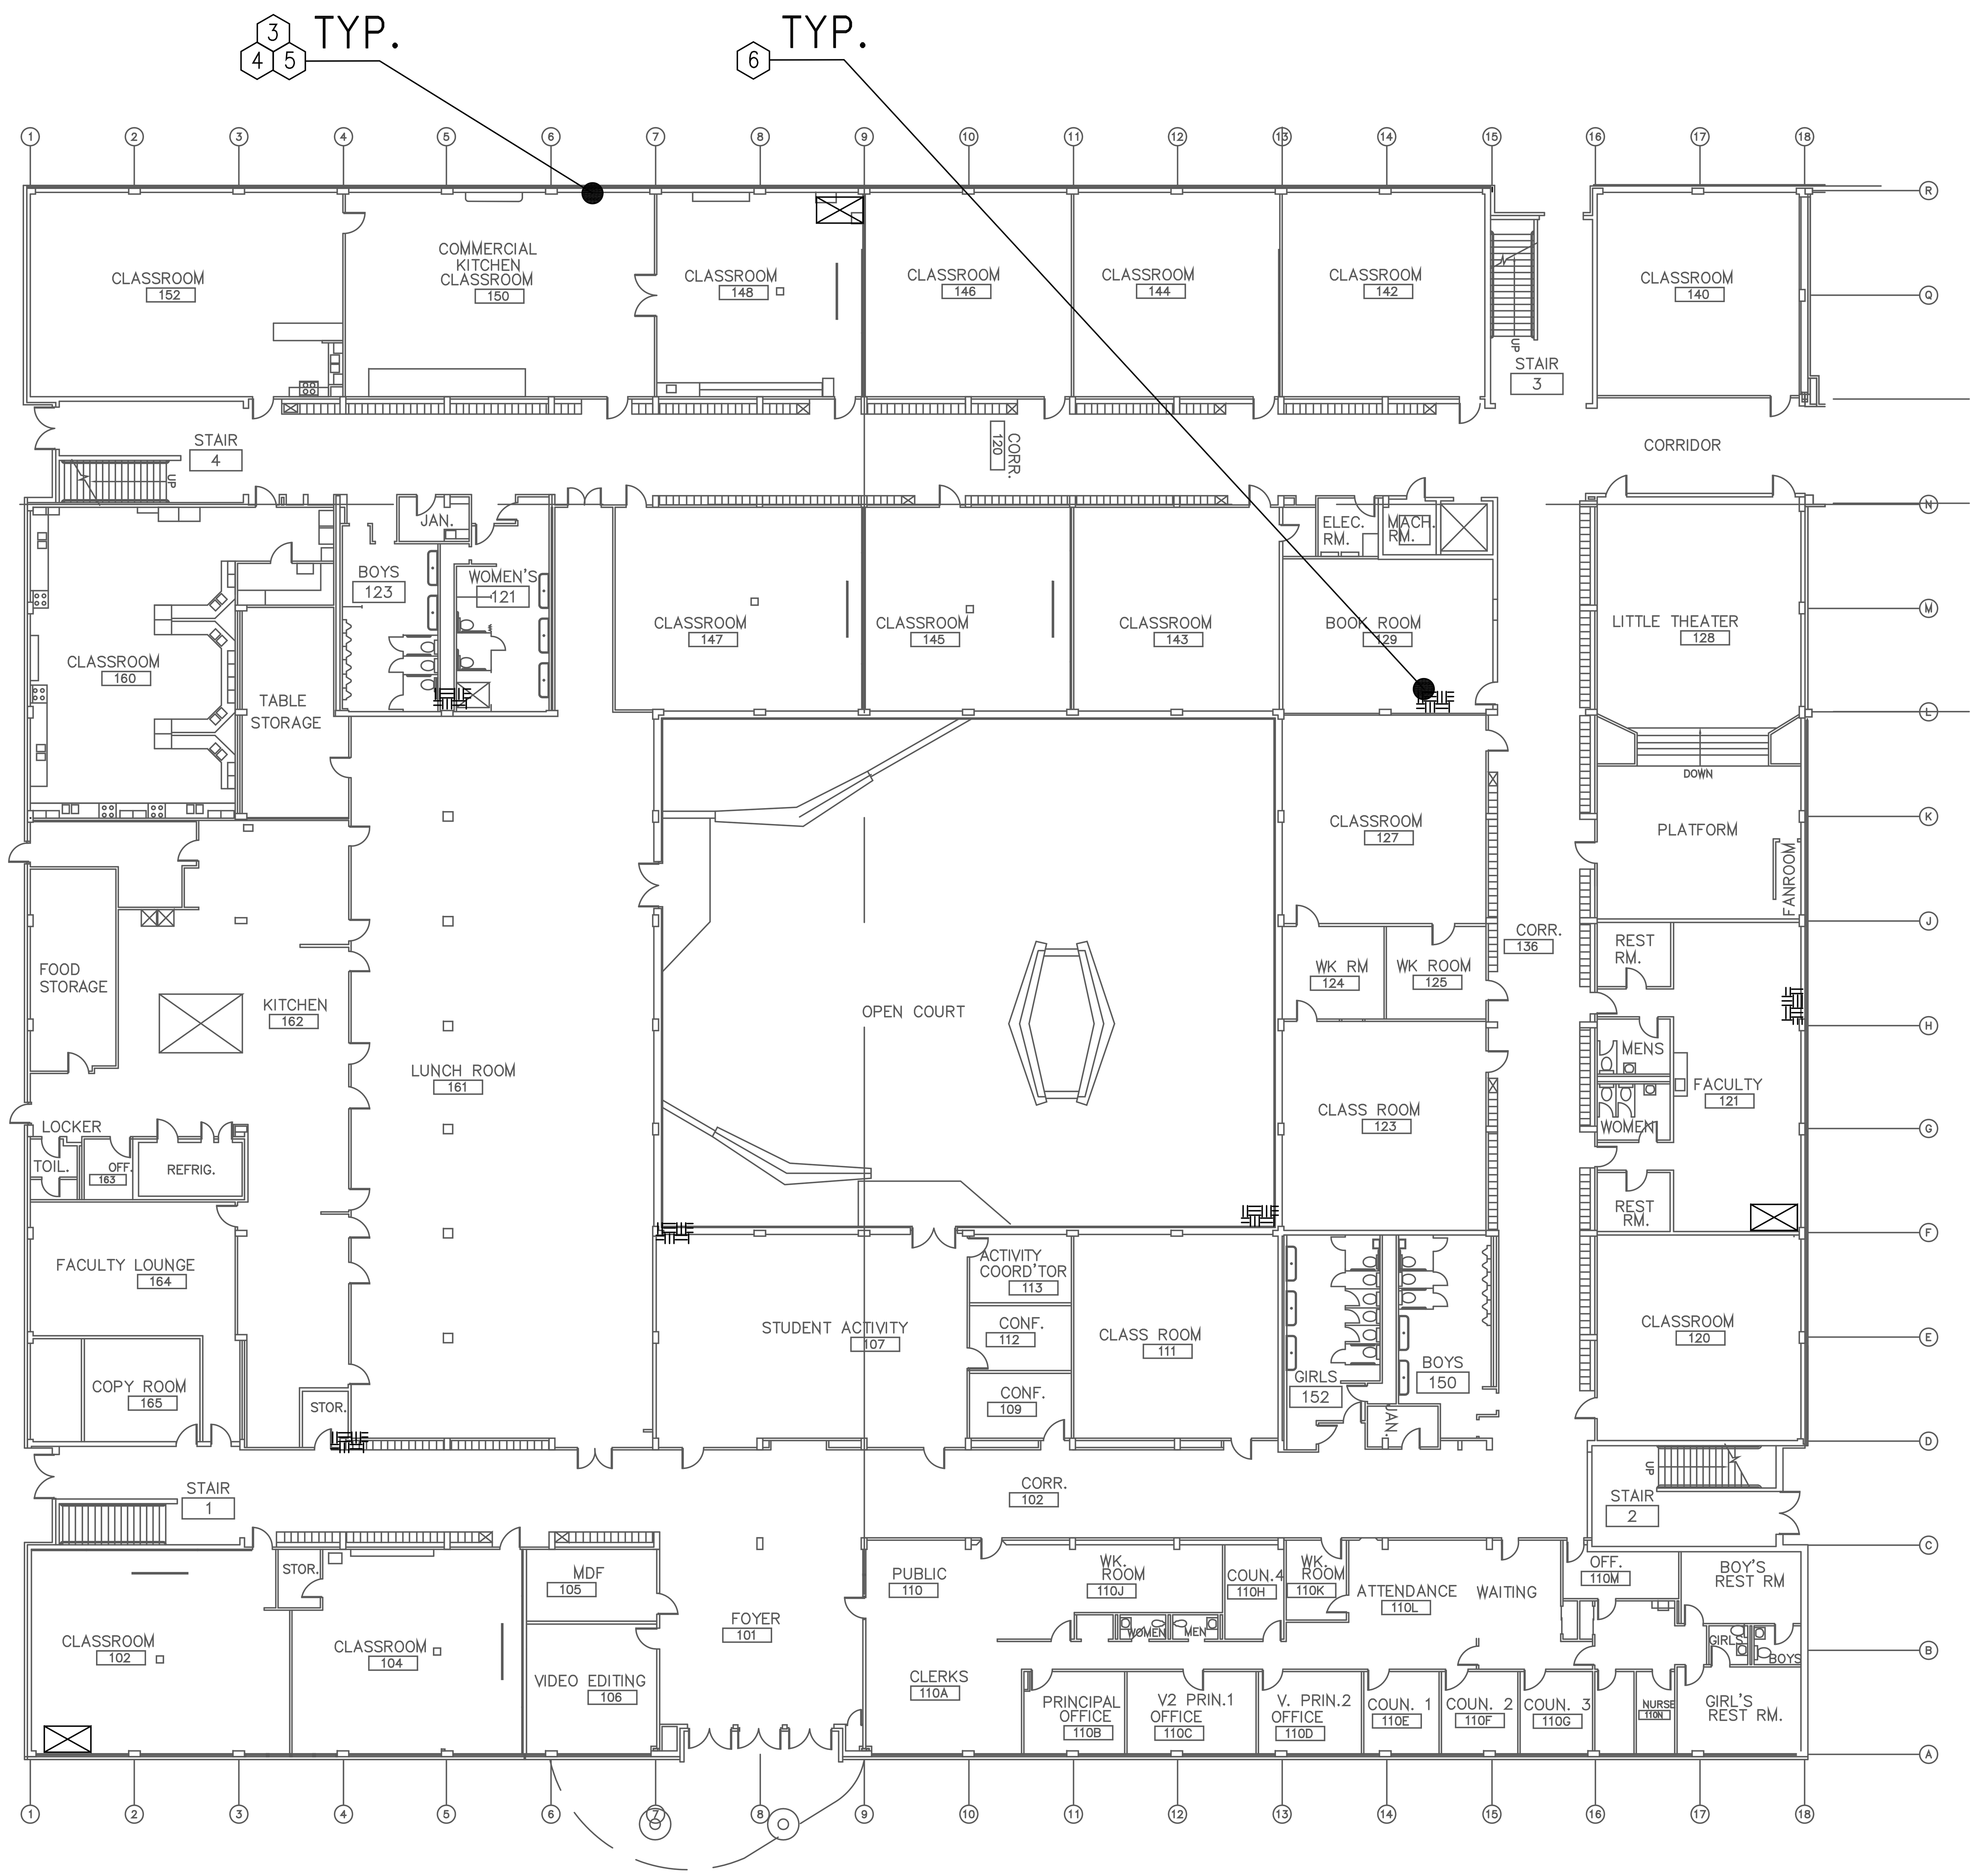

RAINIER BEACH HIGH SCHOOL
1 FIRST FLOOR PLAN
SCALE: NOT TO SCALE

NORTH

GENERAL NOTES

(SEE DRAWING HA 0.1)

SHEET NOTES

1. NONE
2. REPAIR DAMAGED LARGE & SMALL BORE STEAM/CONDENSATE LINE ACM TSI IN PROXIMITY TO WATERLINES IN CRAWLSPACE & TUNNELS
3. REMOVE AND DISPOSE OF SMALL BORE ACM TSI ON WATERLINE PIPE (INCLUDES FITTINGS)
4. REMOVE AND DISPOSE OF SMALL BORE ACM TSI MUDDED JOINTS AND FITTINGS ON FIBERGLASS INSULATED WATERLINE PIPE RUNS
5. REMOVE AND DISPOSE OF SMALL BORE ACM TSI MUDDED FITTINGS ON FIBERGLASS INSULATED WATERLINE PIPES CONCEALED IN WALLS, CASEWORK AND ABOVE SUSPENDED CEILING
6. REMOVE AND DISPOSE OF APPROXIMATELY 2 SF OF 9"X9" VAT AND ASSOCIATED ASSUMED ACM BLACK TILE MASTIC AT EACH PROPOSED CORE DRILL LOCATION WHERE 9"X9" VAT IS PRESENT. COORDINATE WITH MECHANICAL CONTRACTOR FOR EXACT LOCATIONS.

LEGEND

ACCESS HATCH TO CRAWL SPACES & TUNNELS

TYP. TYPICAL OF BUILDING

APPROXIMATE LOCATIONS OF CORE DRILLING EITHER UP FROM FOUNDATION OR DOWN TO FOUNDATION

APPROXIMATE LOCATIONS OF ACM DEBRIS ON TUNNEL AND CRAWL SPACE FLOORS

DRAWING NOTES

DRAWING IS SCHEMATIC AND MATERIAL LOCATIONS FOR ASBESTOS ARE APPROXIMATE. REFER TO ABATEMENT SPECIFICATIONS 02080 AND 02081 FOR DETAILS

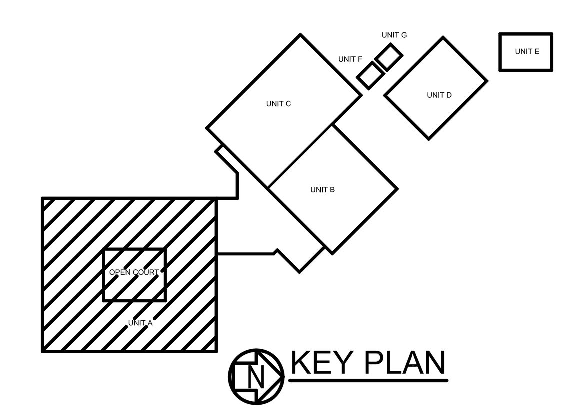

KEY PLAN

ehsi
EHS-International, Inc.
13228 NE 20th Street, Suite 100
Bellevue, Washington 98005
Ph: (425) 455-2959
Fax: (425) 646-7247

AHERA PROJECT DESIGNER
HERB BROD
CERT. NO. 104348
09/17/2010

SEATTLE PUBLIC SCHOOLS
JOHN STANFORD CENTER FOR EDUCATIONAL EXCELLENCE
2445 THIRD AVE. SOUTH
SEATTLE, WA 98134

BID NO. B01909
WATERLINE REPLACEMENT AT
RAINIER BEACH HIGH SCHOOL
8815 SEWARD PARK AVE. S.
SEATTLE, WASHINGTON 98118

1" AT FULL SCALE
If not 1 inch, this drawing has been reproduced, and is not to scale

Project No.	9645-03
Drawn	BFM
Checked	HB
Date	11/18/2009

Revisions

RECORD DRAWING
BID NO. B01909

FIRST FLOOR
PLAN - UNIT A

Sheet HA2.1