FIRST FLOOR PLAN

SCALE 1/8" = 1'-0"

NOTE: ALL PARTITIONS NOTED "INSULATED PARTITION" SHALL HAVE 7/8" LATH & PLASTER BOTH SIDES FLOOR TO CEILING. ALL OTHER PARTITIONS SHALL HAVE 7/8" LATH & PLASTER WAINSCOT TO 6'-10½" & ½" PLASTER BOARD ABOVE UNLESS NOTED OTHERWISE. SEE ROOM FINISH SCHEDULE & ROOM DETAIL SHEETS.

OUTSIDE CONCRETE WALLS SHALL BE FURRED WITH 2"x2" STRIPS WHERE PLASTERED.

NEW BUILDING FINISH FLOOR, NOTED AS ELEV. 350'-9⅝", SHALL LINE WITH EXISTING CORRIDOR FLOOR AT CONNECTION TO EXISTING BUILDING.

4, 3, 2, 1 REVISED TO AS-BUILT STATUS : DRAWN - REKEVICS CHECKED - MAY 1-29-57

DOOR HARDWARE LEGEND

P.B.	PANIC BOLT (HORIZONTAL BAR TYPE)
N.K.	NO KEY LOCK HARDWARE FROM INSIDE IN DIRECTION OF EXIT TRAVEL (KNOB HARDWARE)
N.L.	NO LOCKING OR LATCHING HARDWARE (NO FLUSH BOLTS) DOOR SWINGS FREE
S.C.	SELF CLOSING DOOR
C.R.	CREMONE TYPE OF EXIT BOLT AND OPEN STRIKE ON INACTIVE LEAF OF DOOR

FIRST FLOOR PLAN UNIT A

JOHN W. MALONEY
RENEWED TO JUNE 1, 1955
72, 369
L-10
STATE OF WASHINGTON
LICENSED ARCHITECT

EDMOND MEANY JUNIOR HIGH - RECREATION PROJECT
FOR THE
SEATTLE PUBLIC SCHOOL DISTRICT No. 1
AND THE
SEATTLE DEPARTMENT OF PARKS
20TH AVENUE NORTH AT EAST REPUBLICAN STREET – SEATTLE, WASHINGTON

DATE 6-21-54	JOHN W. MALONEY A. I. A. ARCHITECT	DRAWN PUGH
DWG. NO. **A6**	754 CENTRAL BUILDING 1117 LARSON BLDG. SEATTLE WASHINGTON YAKIMA	CHECKED MAY

139-0045

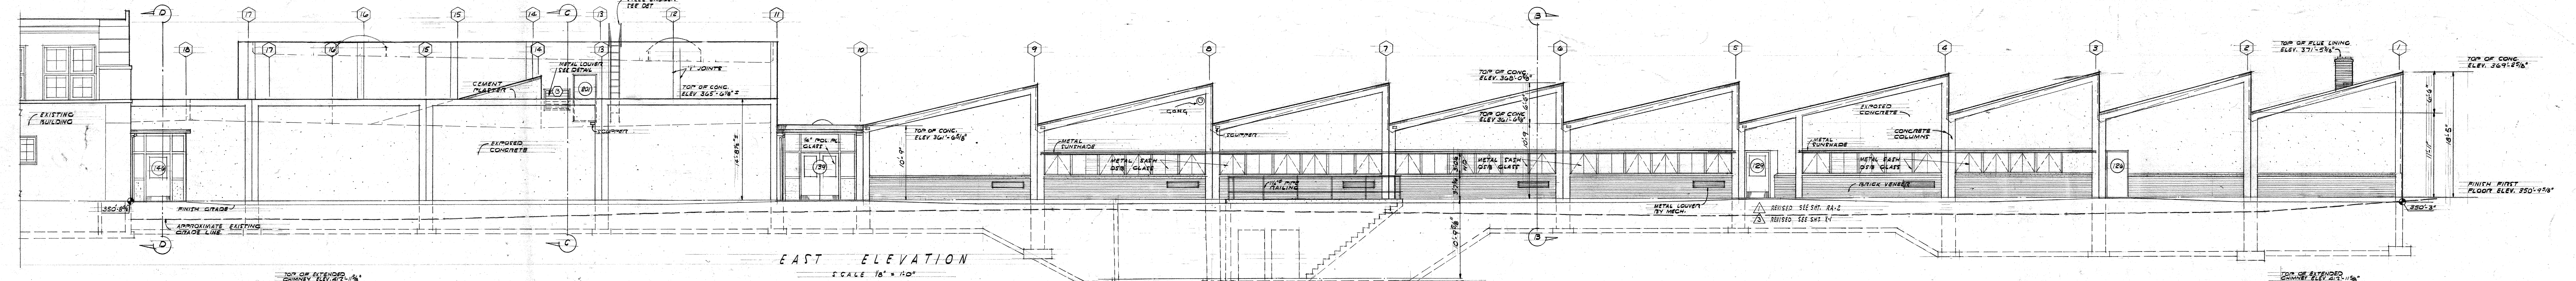

EAST ELEVATION
SCALE 1/8" = 1'-0"

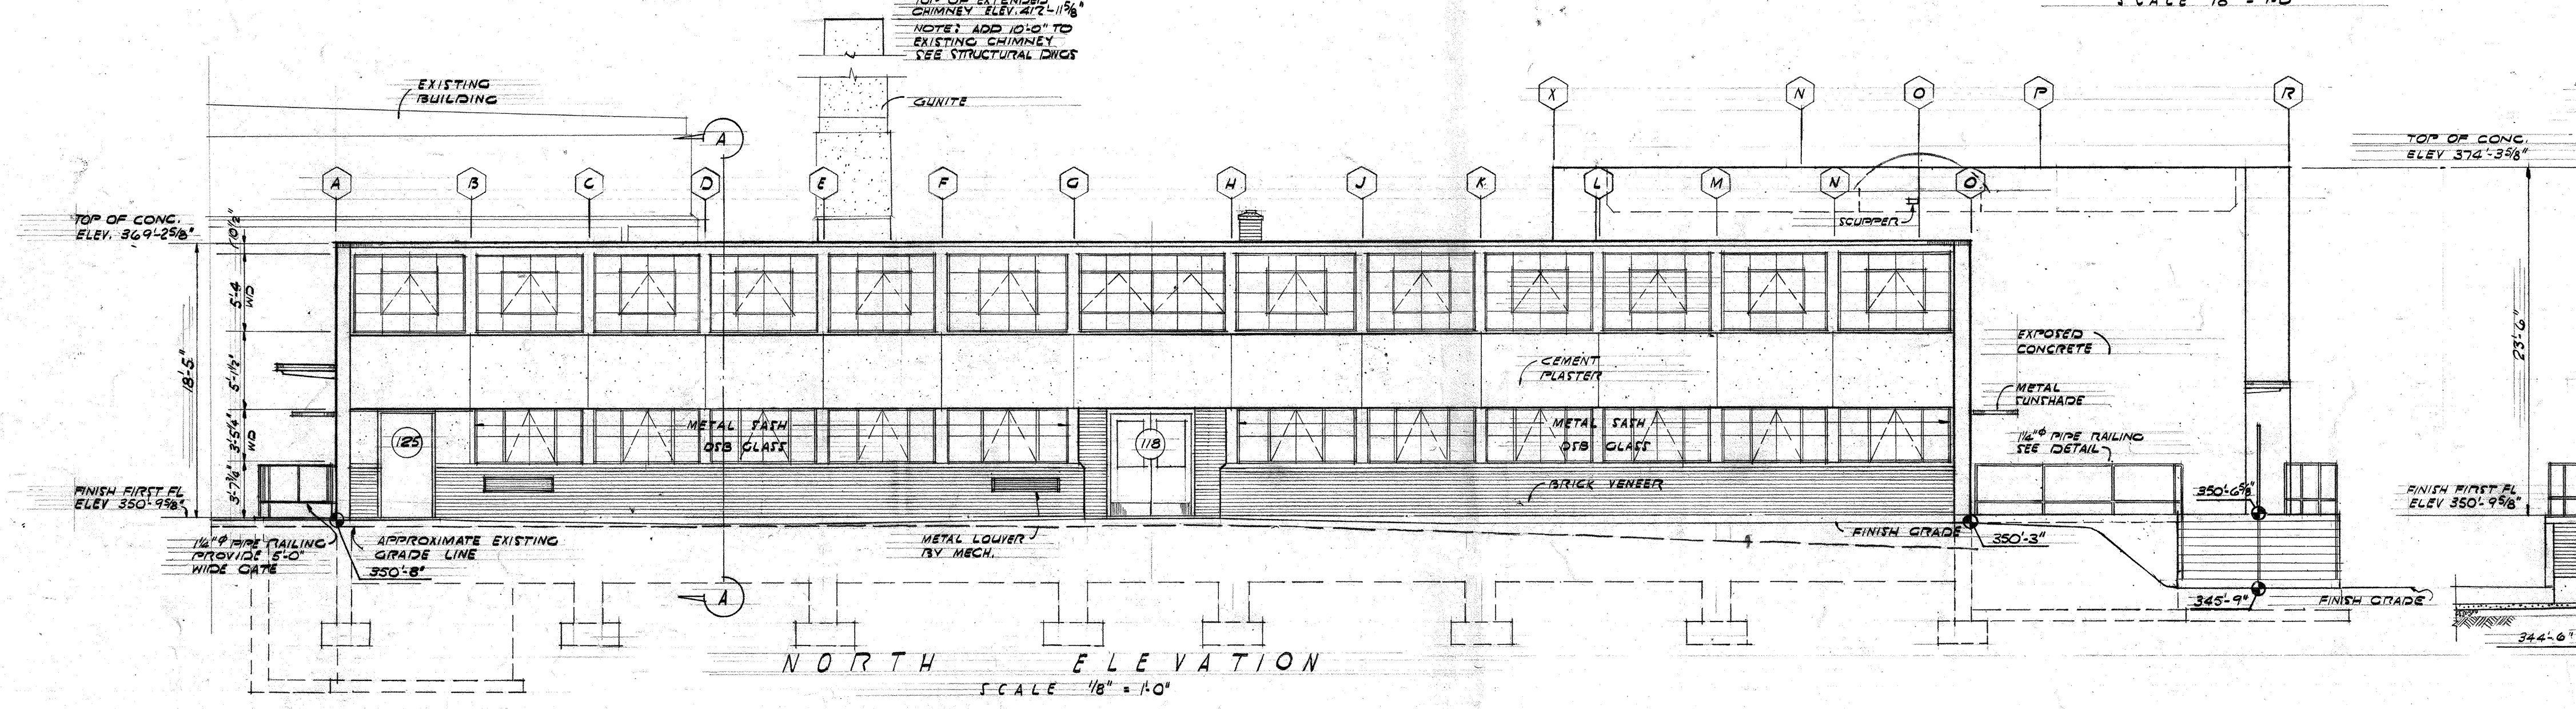

NORTH ELEVATION
SCALE 1/8" = 1'-0"

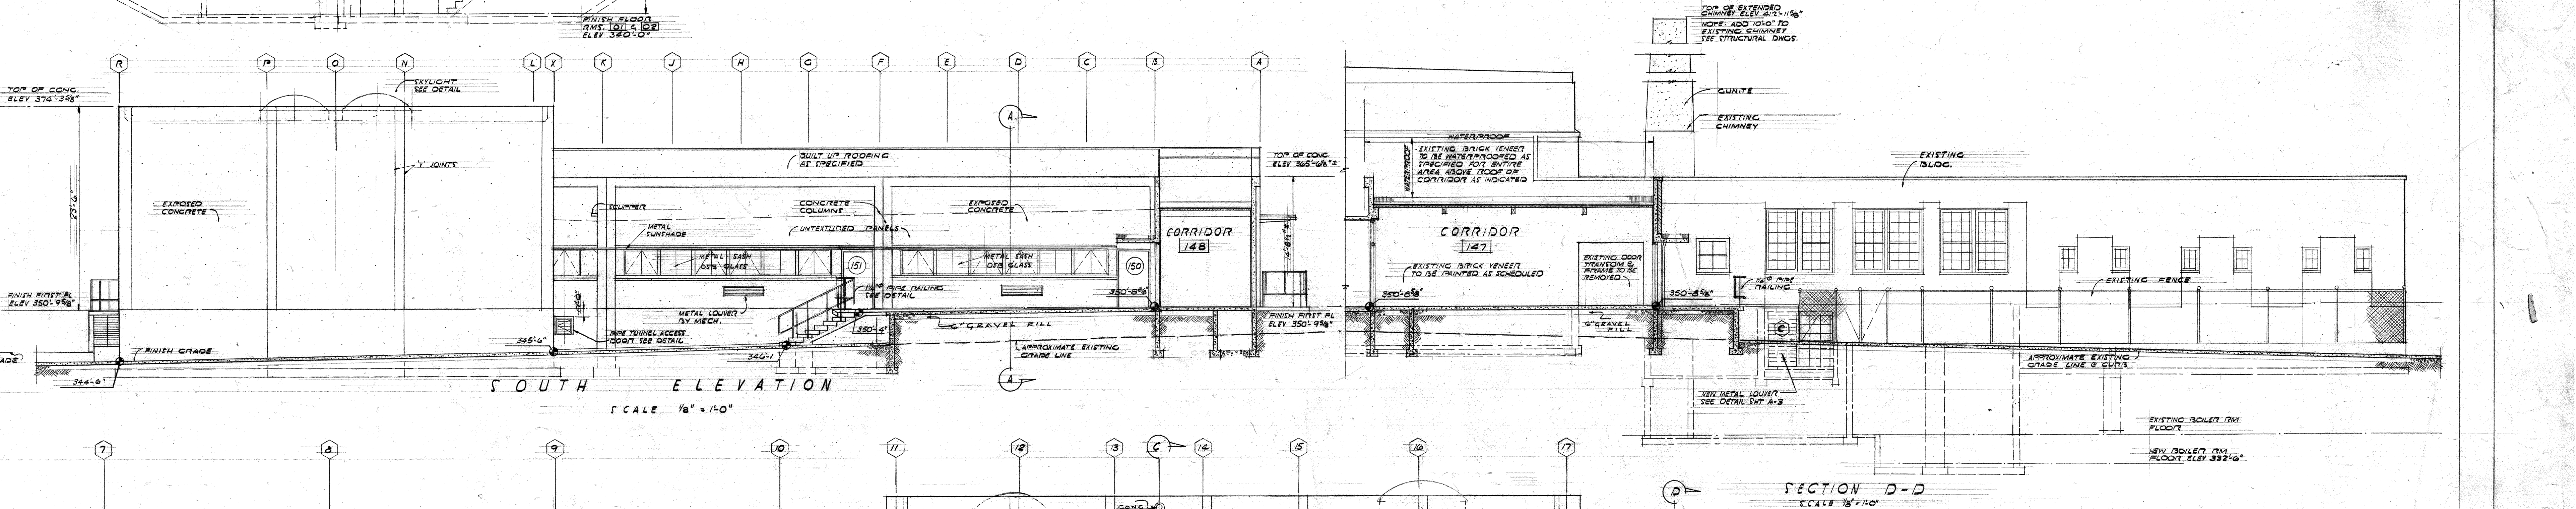

SOUTH ELEVATION
SCALE 1/8" = 1'-0"

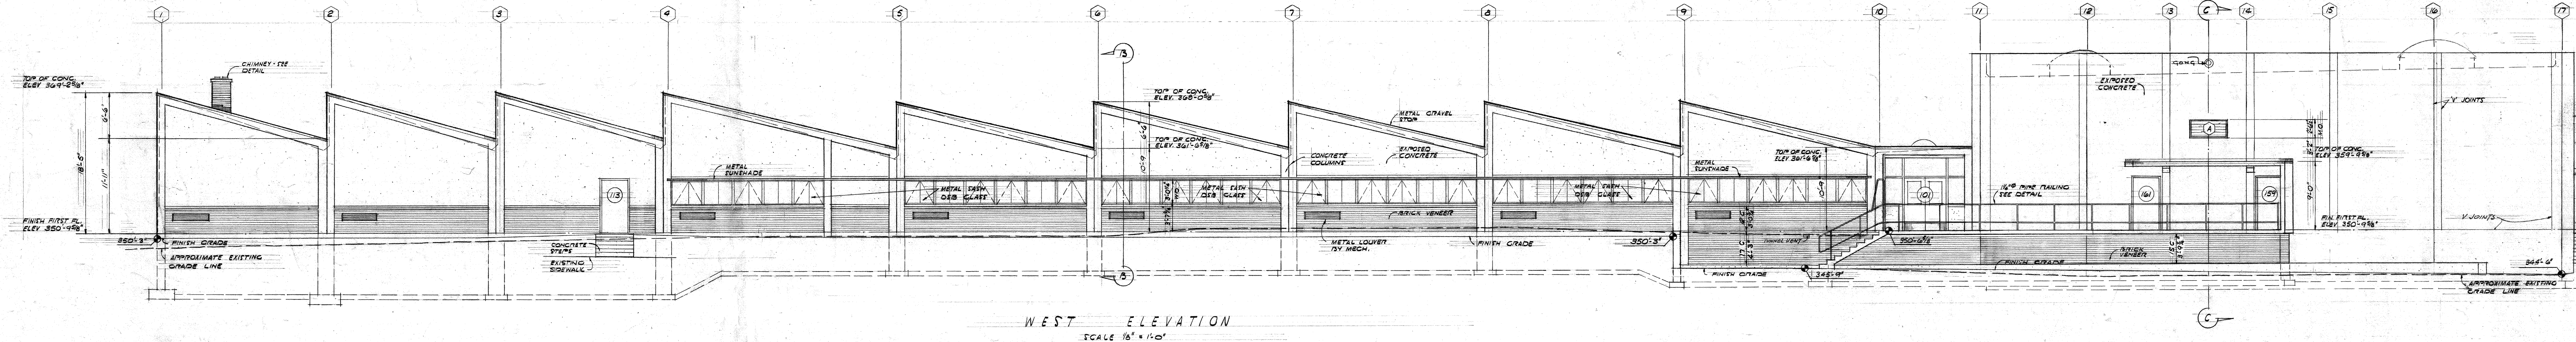

WEST ELEVATION
SCALE 1/8" = 1'-0"

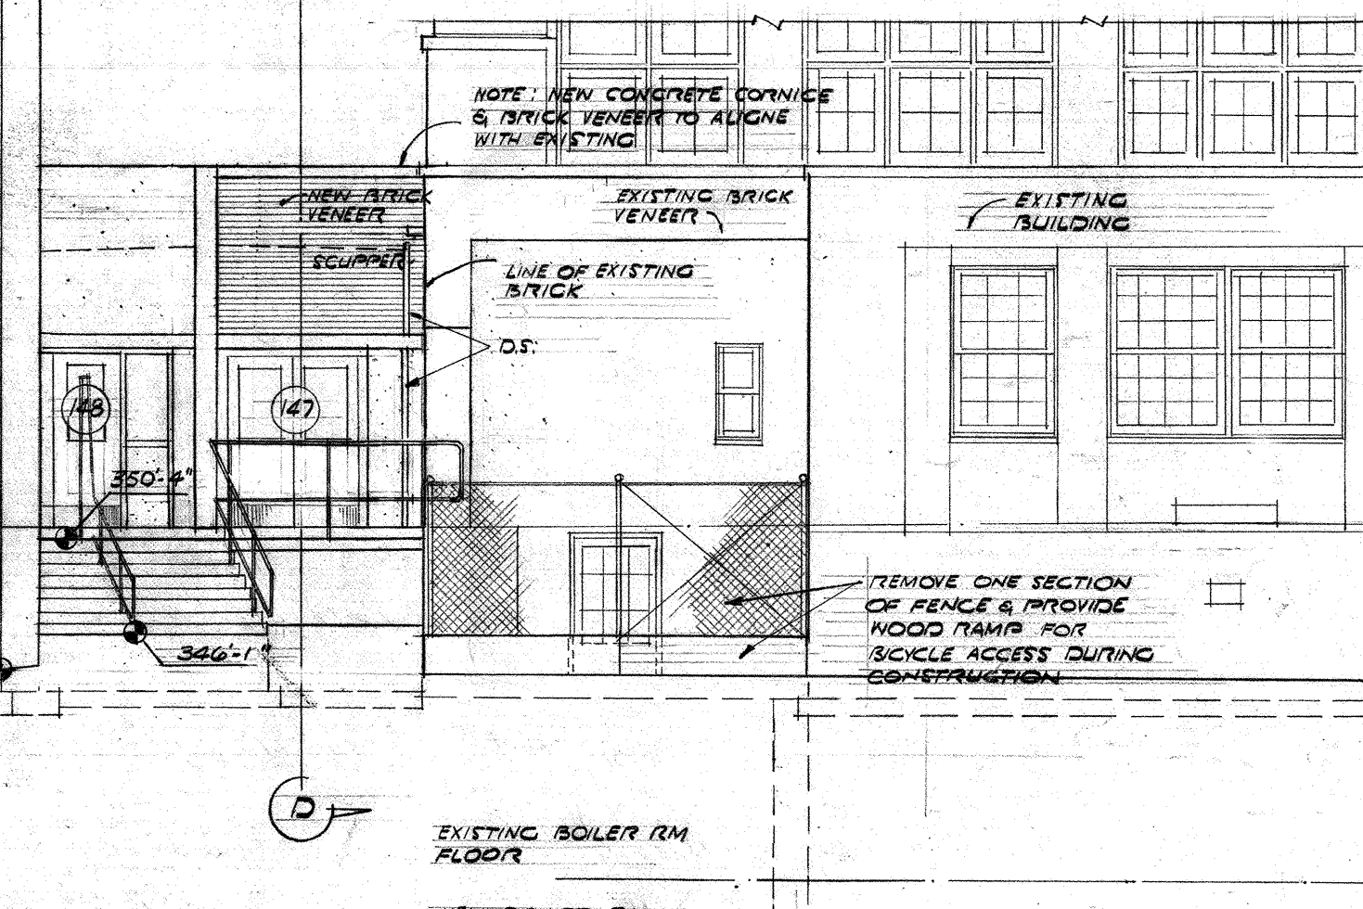

SECTION D-D
SCALE 1/8" = 1'-0"

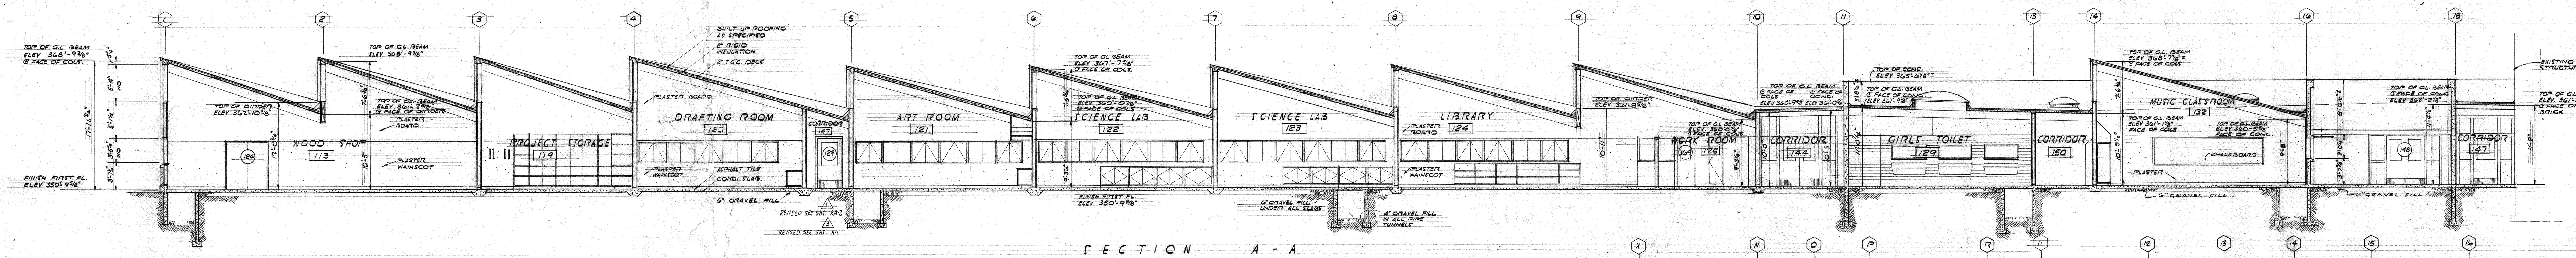

SECTION A-A
SCALE 1/8" = 1'-0"

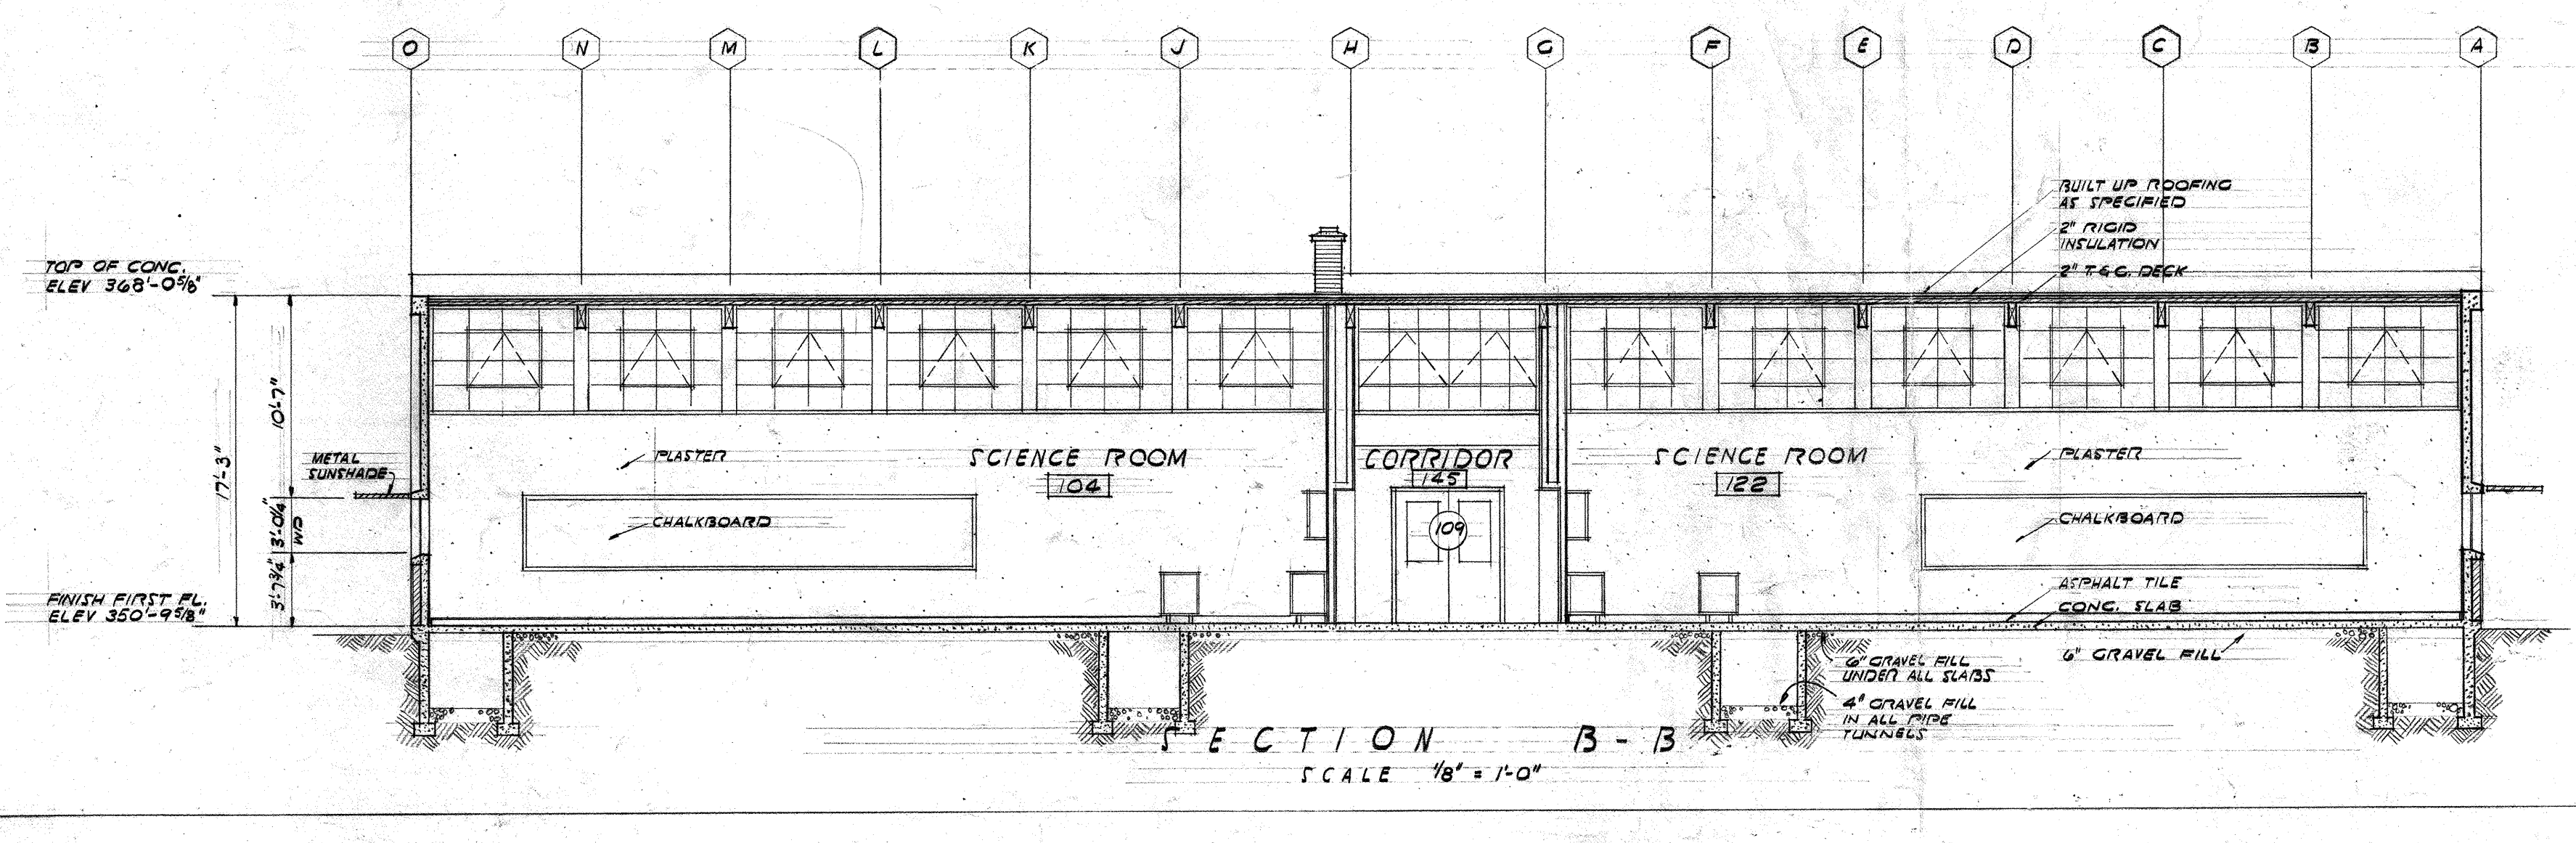

SECTION B-B
SCALE 1/8" = 1'-0"

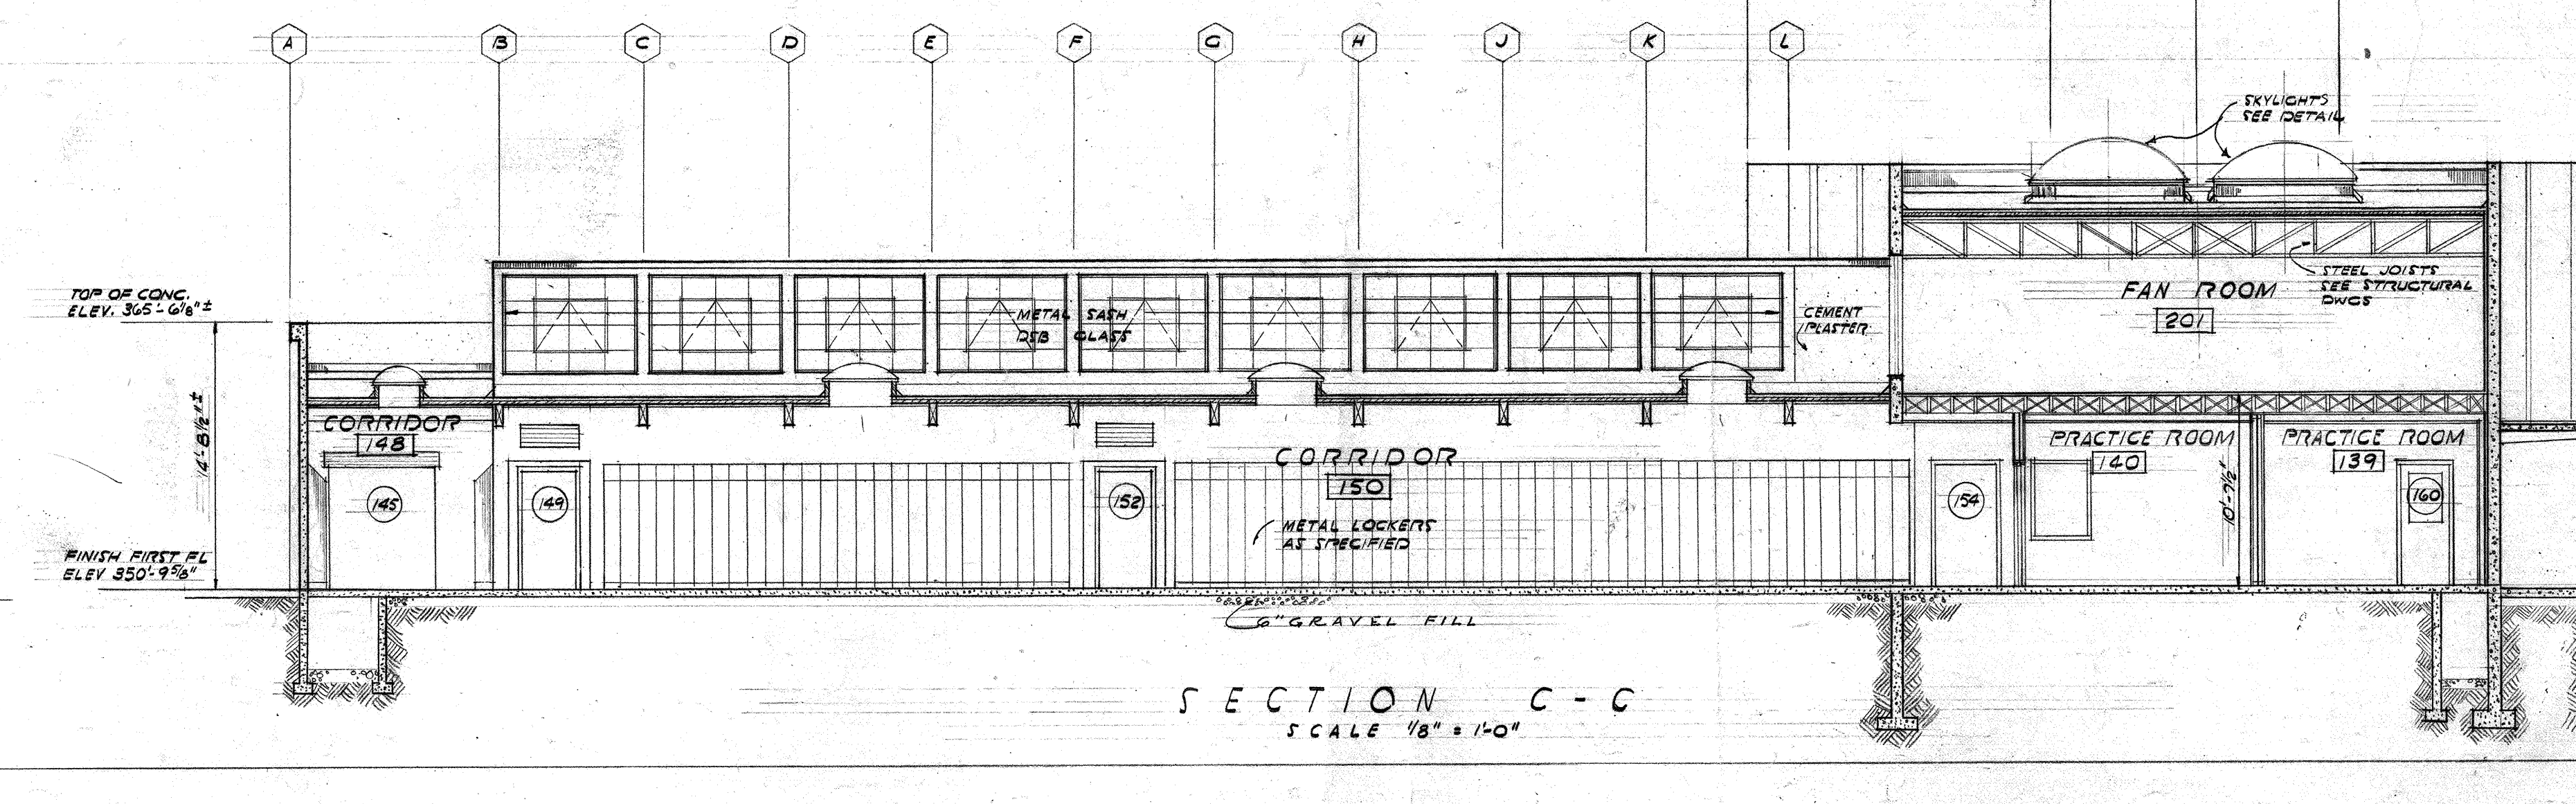

SECTION C-C
SCALE 1/8" = 1'-0"

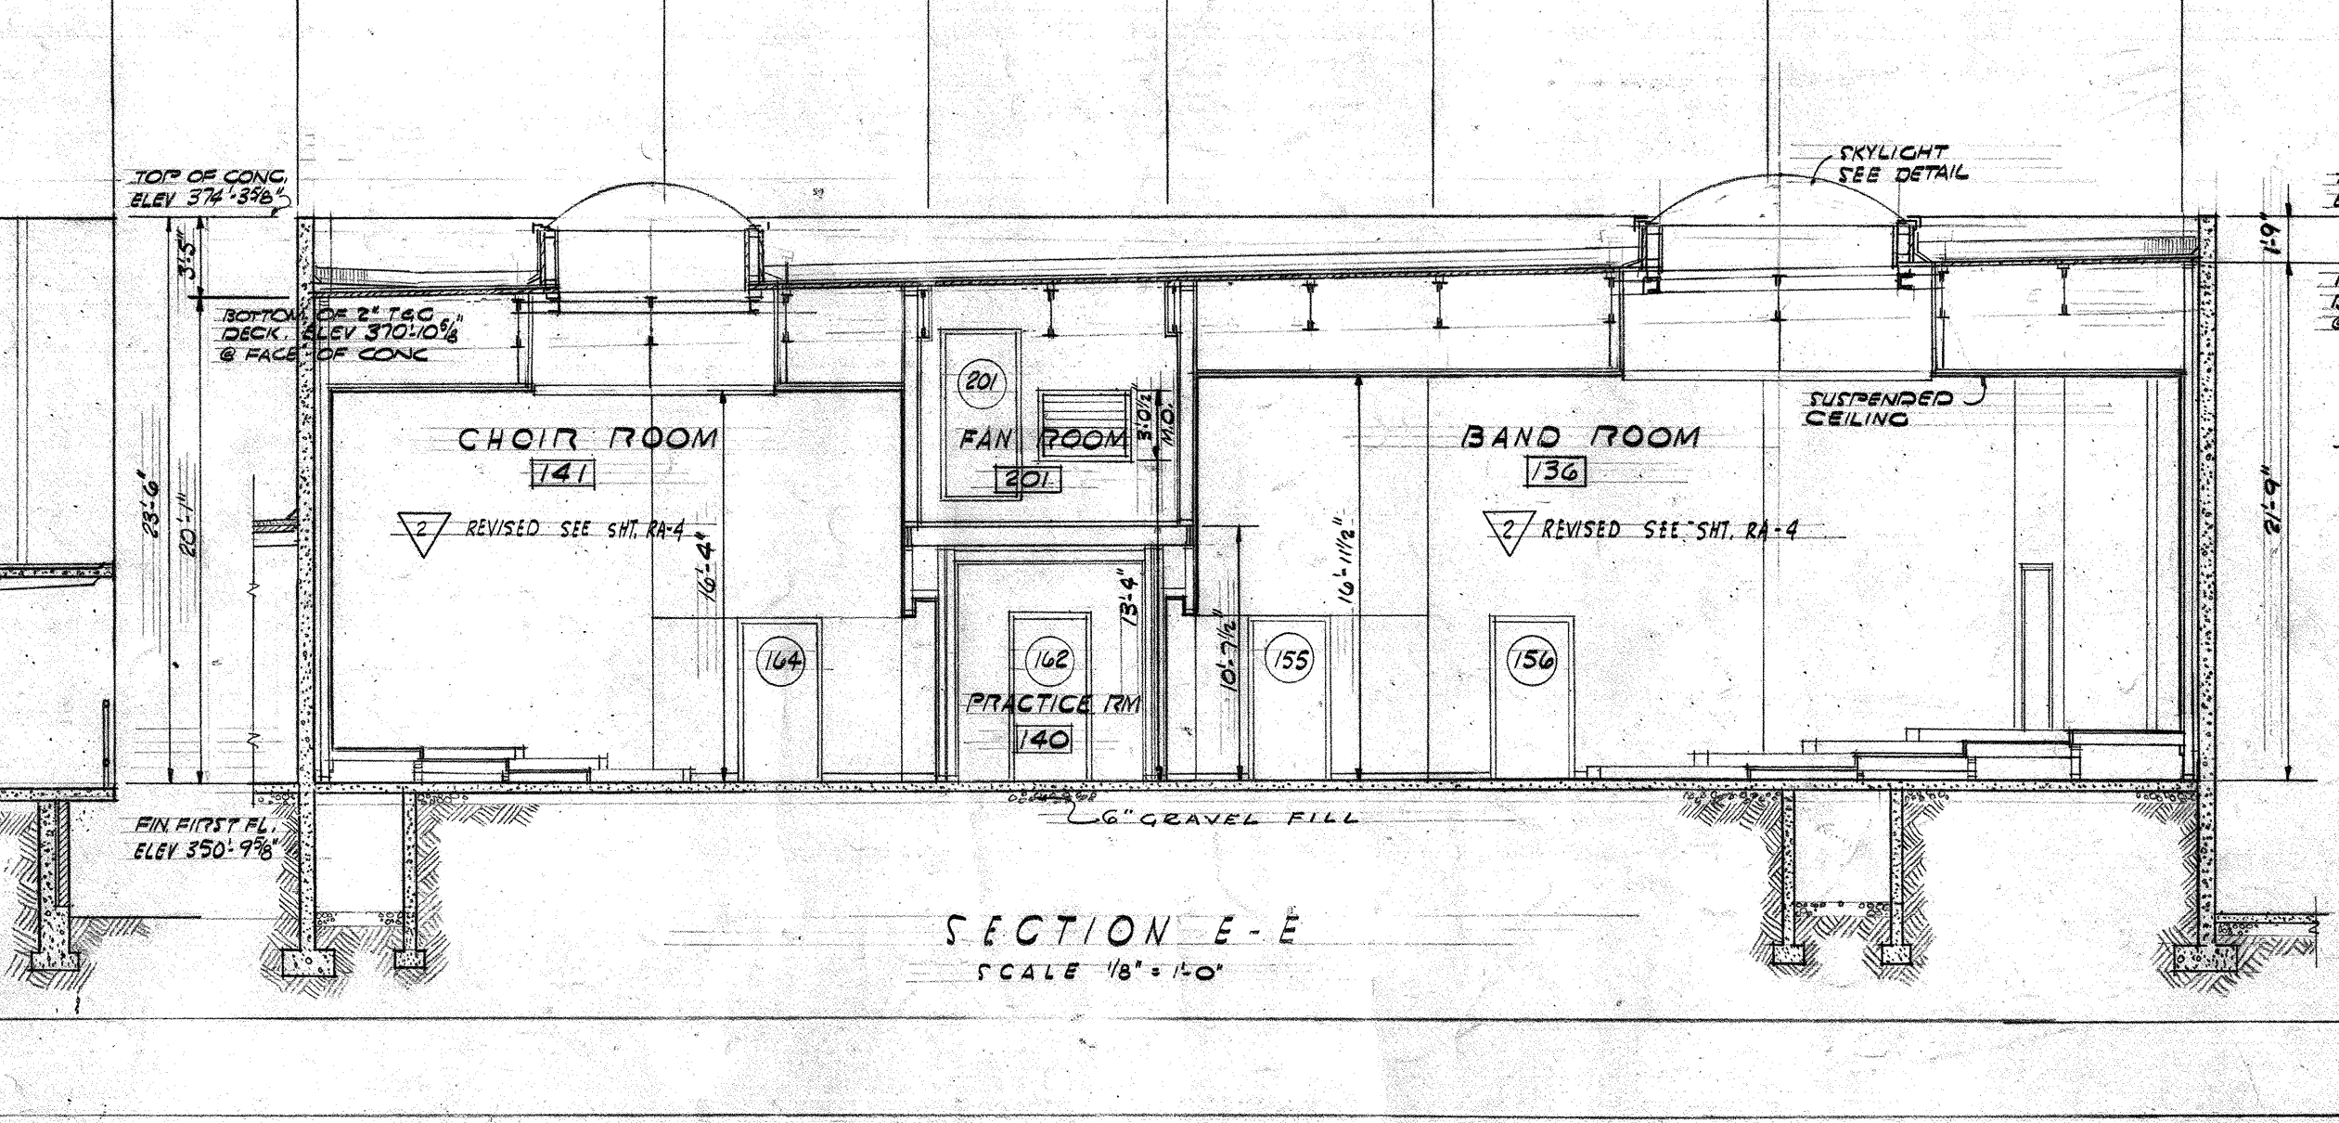

SECTION E-E
SCALE 1/8" = 1'-0"

NOTES
1. ALL TILT UP CONCRETE WALLS, EXCEPT THOSE INDICATED AS "UNTEXTURED PANELS", SHALL BE TEXTURED AS SPECIFIED. ALL COLUMNS & BEAMS, BOTH TILT UP & POURED IN PLACE, SHALL BE UNTEXTURED.

3, 2, 1 REVISED TO AS-BUILT STATUS — DRAWN - REKEVICS ; CHECKED - MAY 1-24-57

ELEVATIONS AND SECTIONS UNIT A

JOHN W. MALONEY
RENEWED TO JUNE 1, 1956
L-10
STATE OF WASHINGTON
LICENSED ARCHITECT

EDMOND MEANY JUNIOR HIGH - RECREATION PROJECT
FOR THE
SEATTLE PUBLIC SCHOOL DISTRICT No. 1
AND THE
SEATTLE DEPARTMENT OF PARKS
20TH AVENUE NORTH AT EAST REPUBLICAN STREET – SEATTLE, WASHINGTON

DATE		DRAWN
6-21-54	JOHN W. MALONEY A. I. A. ARCHITECT	JACOBSON
DWG. NO.	754 CENTRAL BUILDING 1117 LARSON BLDG. SEATTLE WASHINGTON YAKIMA	CHECKED
A8		MAY

139-0043

EDMOND MEANY JR. HIGH
W. O. 21 DATE
JOHN W. MALONEY, ARCHITECT

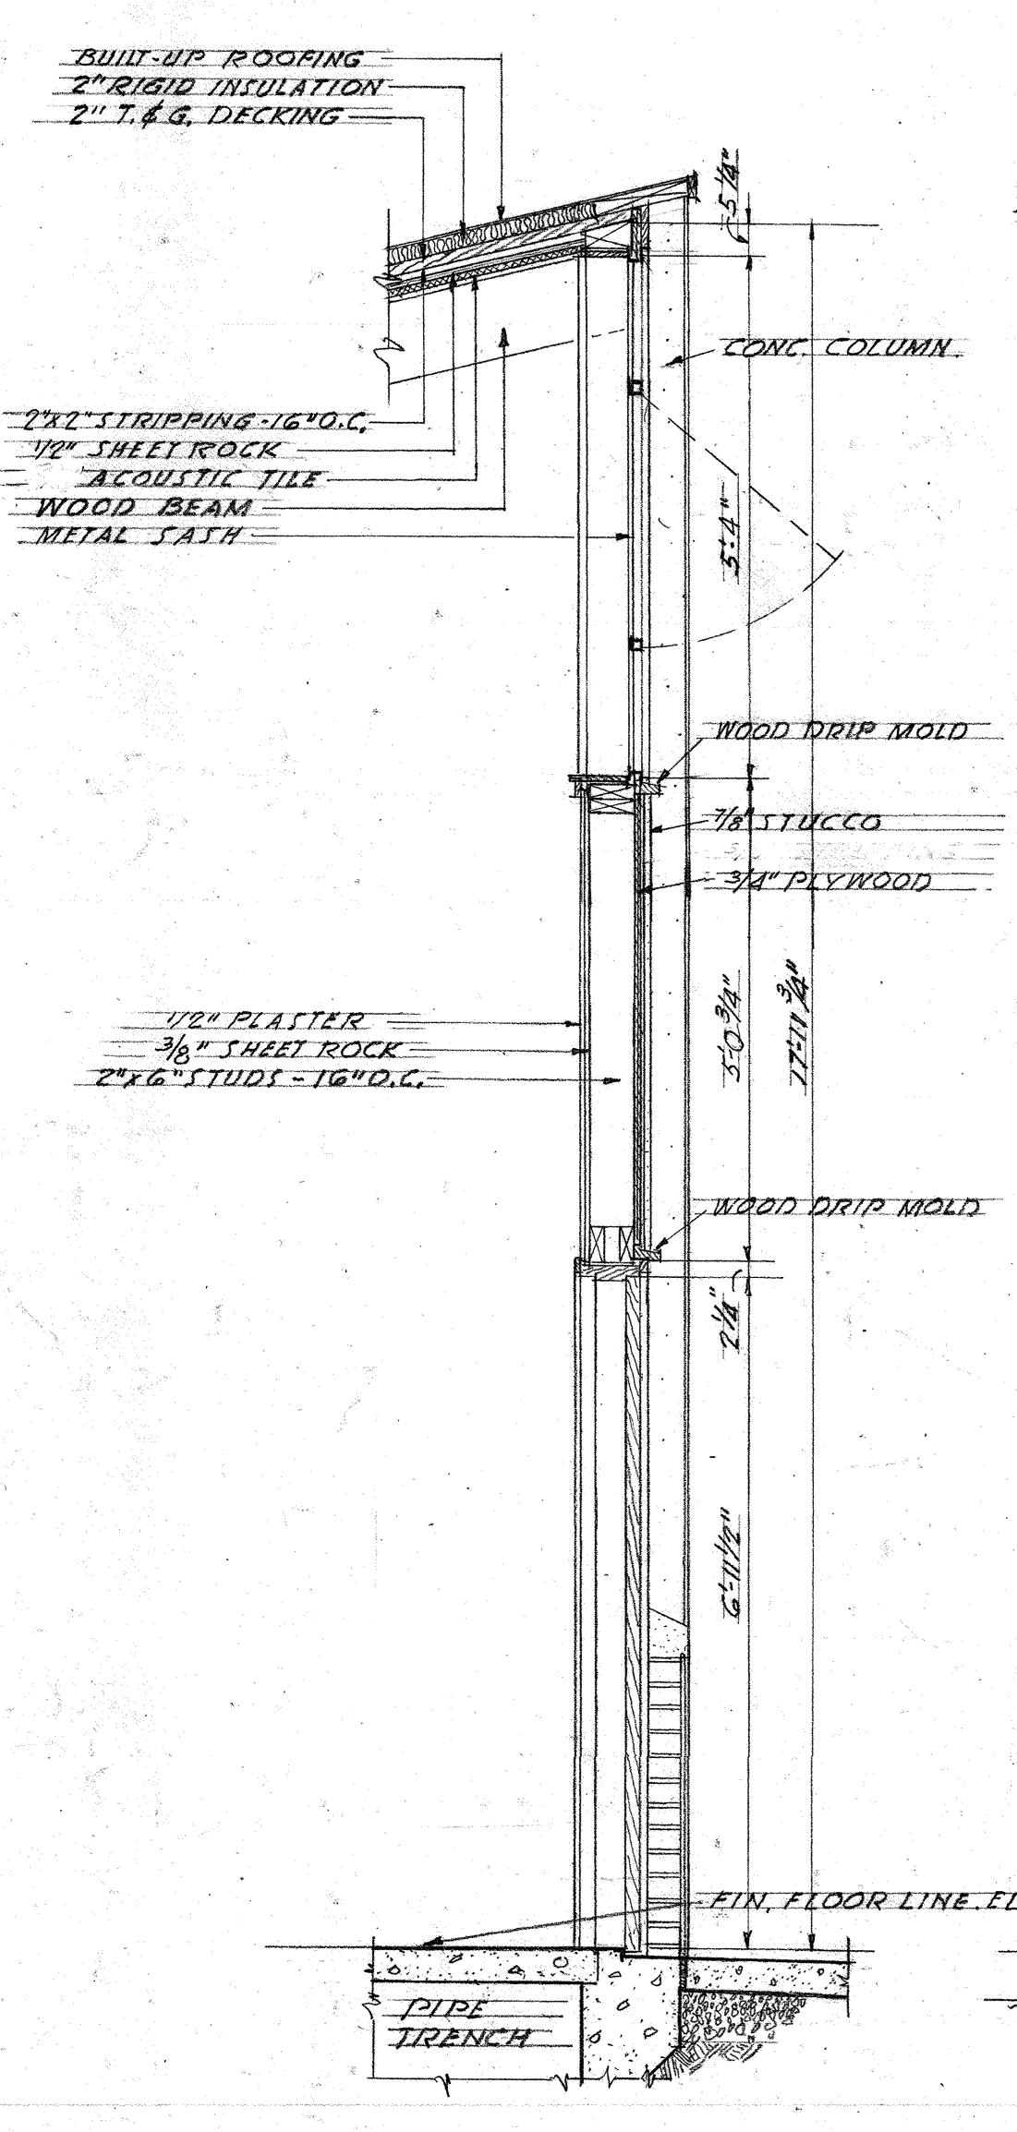

SECTION "A-A"
SCALE: 1/2"=1'-0"

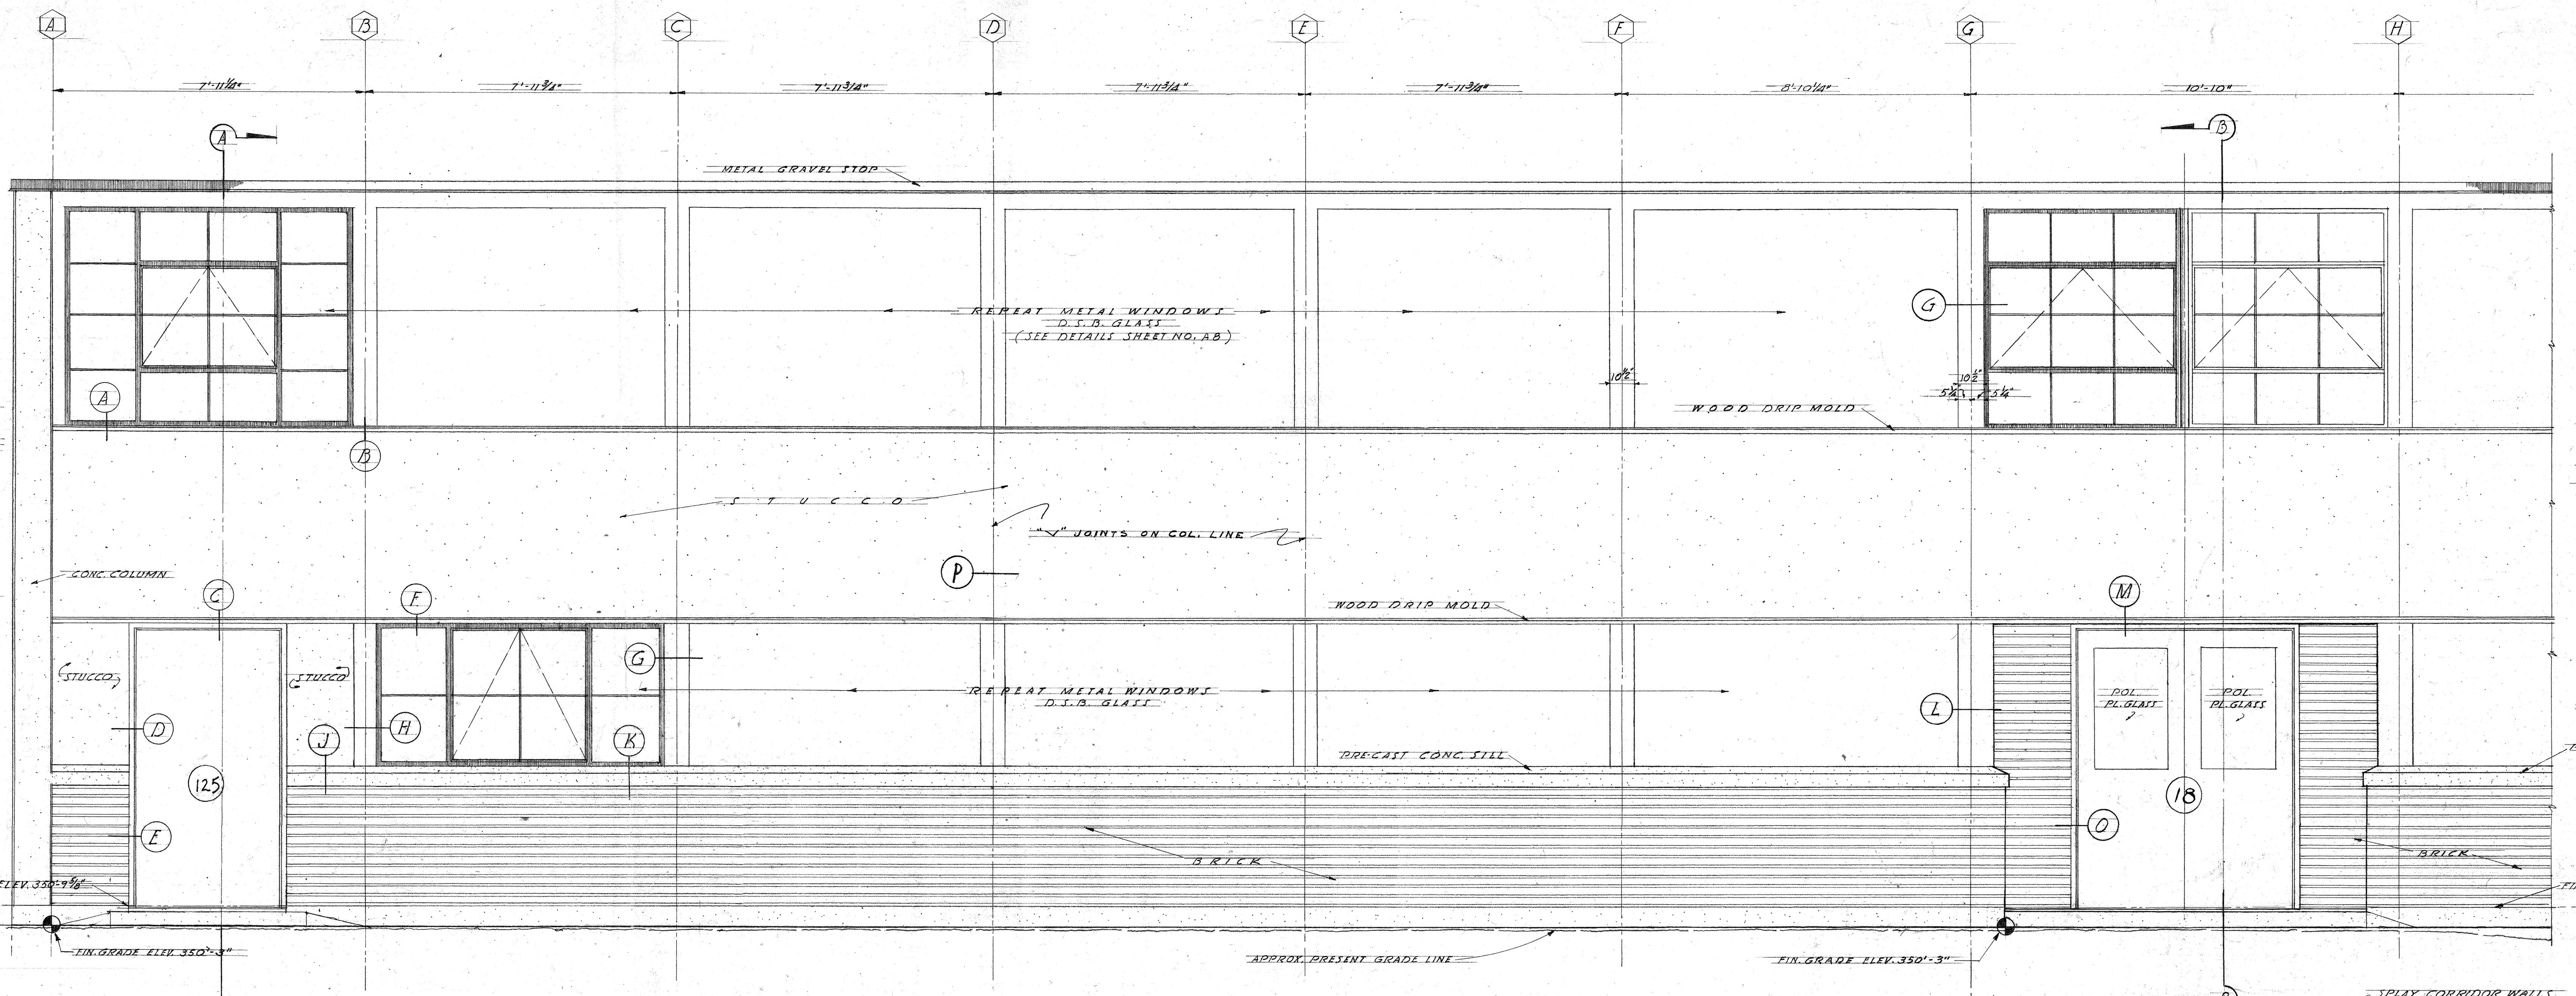

PART NORTH ELEVATION
SCALE: 1/2"=1'-0"

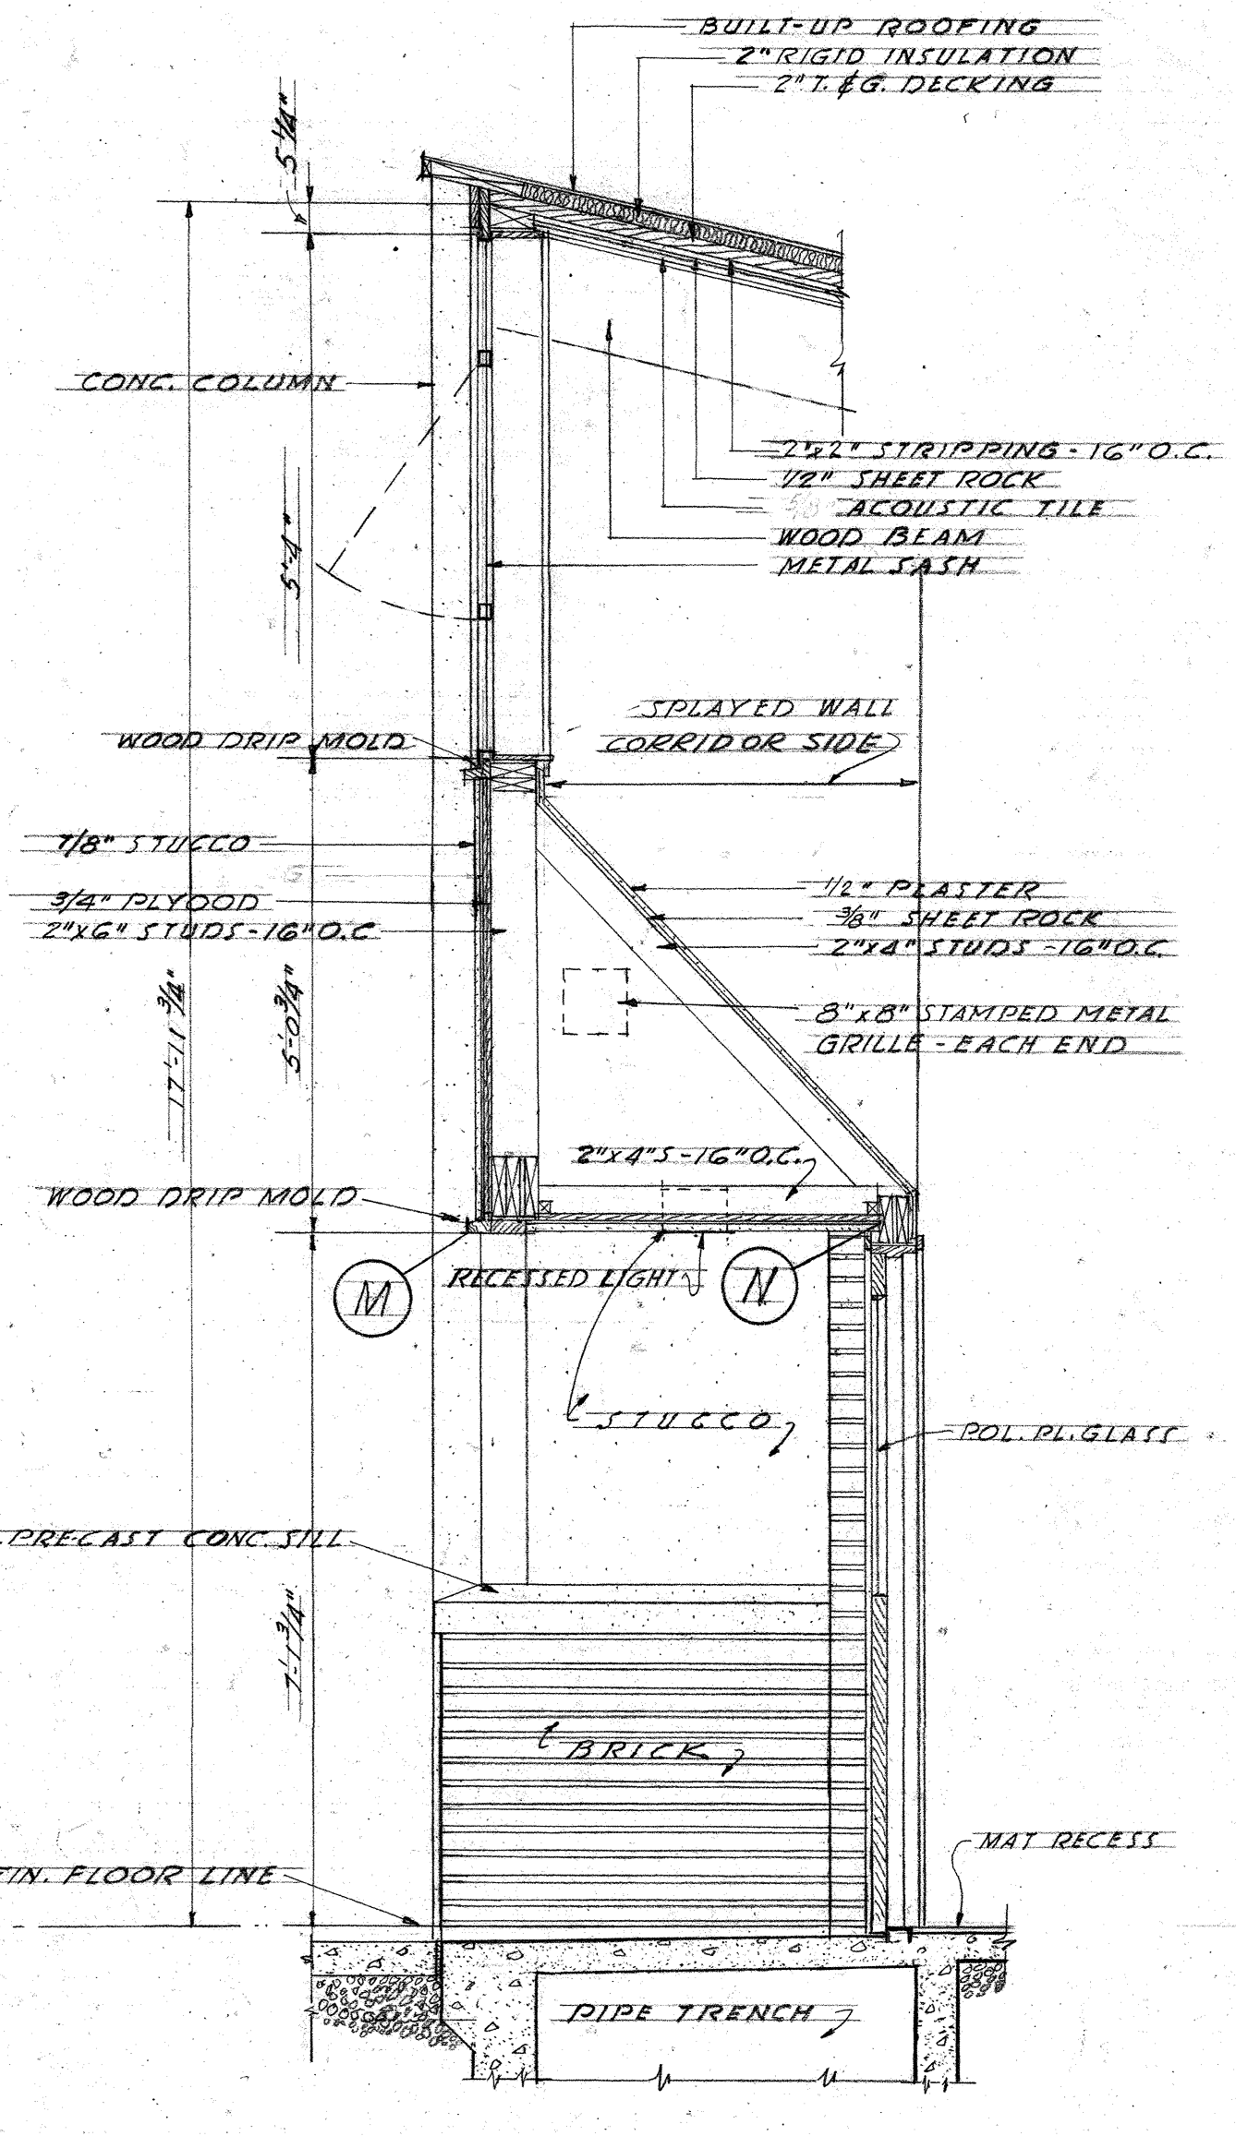

SECTION "B-B"
SCALE: 1/2"=1'-0"

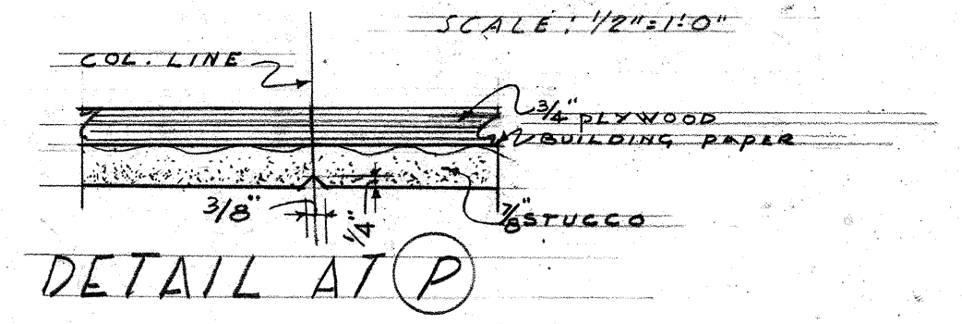

DETAIL AT (P)

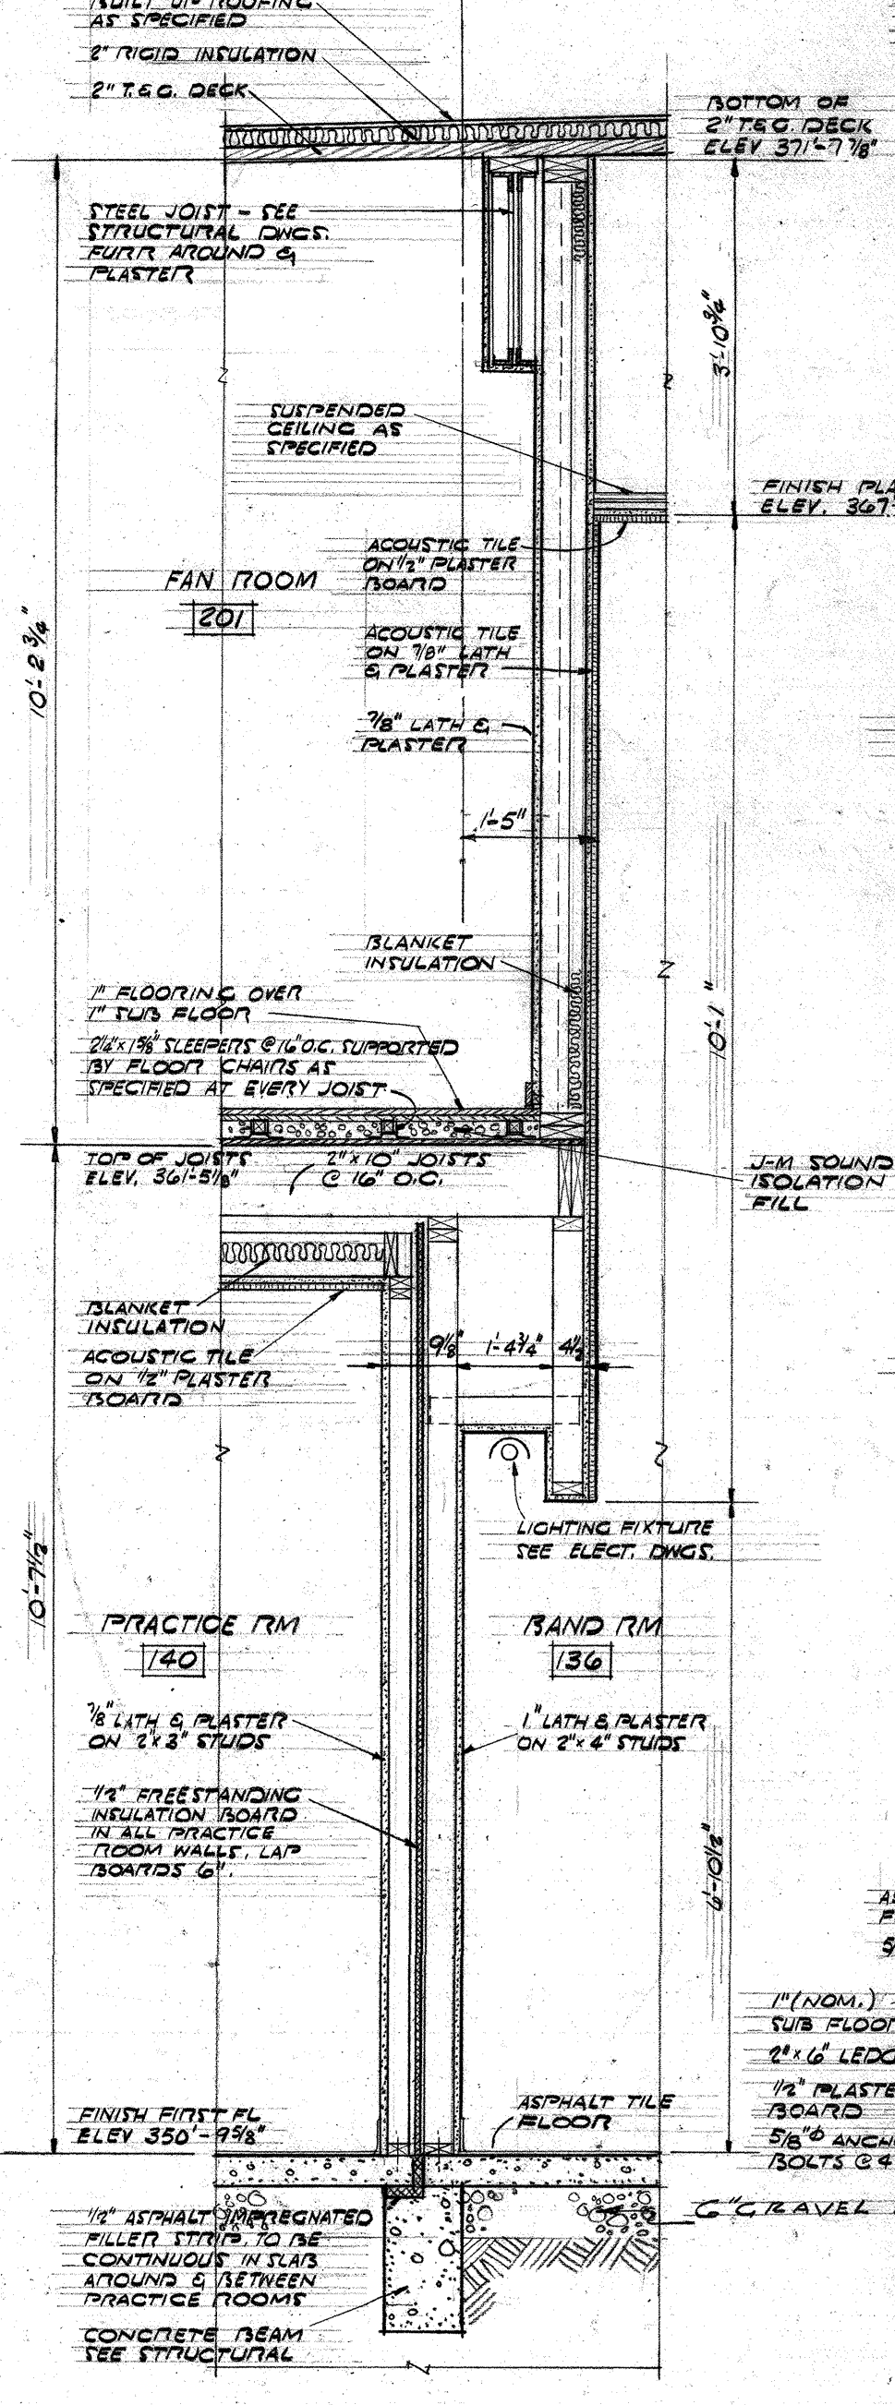
14
BUILT UP ROOFING AS SPECIFIED
2" RIGID INSULATION
2" T.&G. DECK
BOTTOM OF 2" T.&G. DECK ELEV 371'-7 7/8"
STEEL JOIST - SEE STRUCTURAL DWGS. FURR AROUND & PLASTER
SUSPENDED CEILING AS SPECIFIED
FINISH PLAS ELEV. 367'-9 1/8"
FAN ROOM
201
ACOUSTIC TILE ON 1/2" PLASTER BOARD
ACOUSTIC TILE ON 7/8" LATH & PLASTER
7/8" LATH & PLASTER
BLANKET INSULATION
1" FLOORING OVER 1" SUB FLOOR
2 1/4"x1 5/8" SLEEPERS @ 16" O.C. SUPPORTED BY FLOOR CHAIRS AS SPECIFIED AT EVERY JOIST
TOP OF JOISTS ELEV. 361'-5 1/8"
2"x10" JOISTS @ 16" O.C.
J-M SOUND ISOLATION FILL
BLANKET INSULATION
ACOUSTIC TILE ON 1/2" PLASTER BOARD
LIGHTING FIXTURE SEE ELECT. DWGS.
PRACTICE RM
140
BAND RM
136
7/8" LATH & PLASTER ON 2"x3" STUDS
1" LATH & PLASTER ON 2"x4" STUDS
1/2" FREESTANDING INSULATION BOARD IN ALL PRACTICE ROOM WALLS, LAP BOARDS 6".
FINISH FIRST FL ELEV 350'-9 5/8"
ASPHALT TILE FLOOR
1/2" ASPHALT IMPREGNATED FILLER STRIP, TO BE CONTINUOUS IN SLABS AROUND & BETWEEN PRACTICE ROOMS
CONCRETE BEAM SEE STRUCTURAL
10'-2 3/4"
10'-7 1/2"
3'-10 3/4"
1'-5"
10'-1"
9 1/8"
1'-4 3/4"
4 1/2"
6'-10 1/2"

SECTION
THRU NORTH WALL BAND
ROOM 136
SIMILAR @ SOUTH WALL CHOIR RM 147

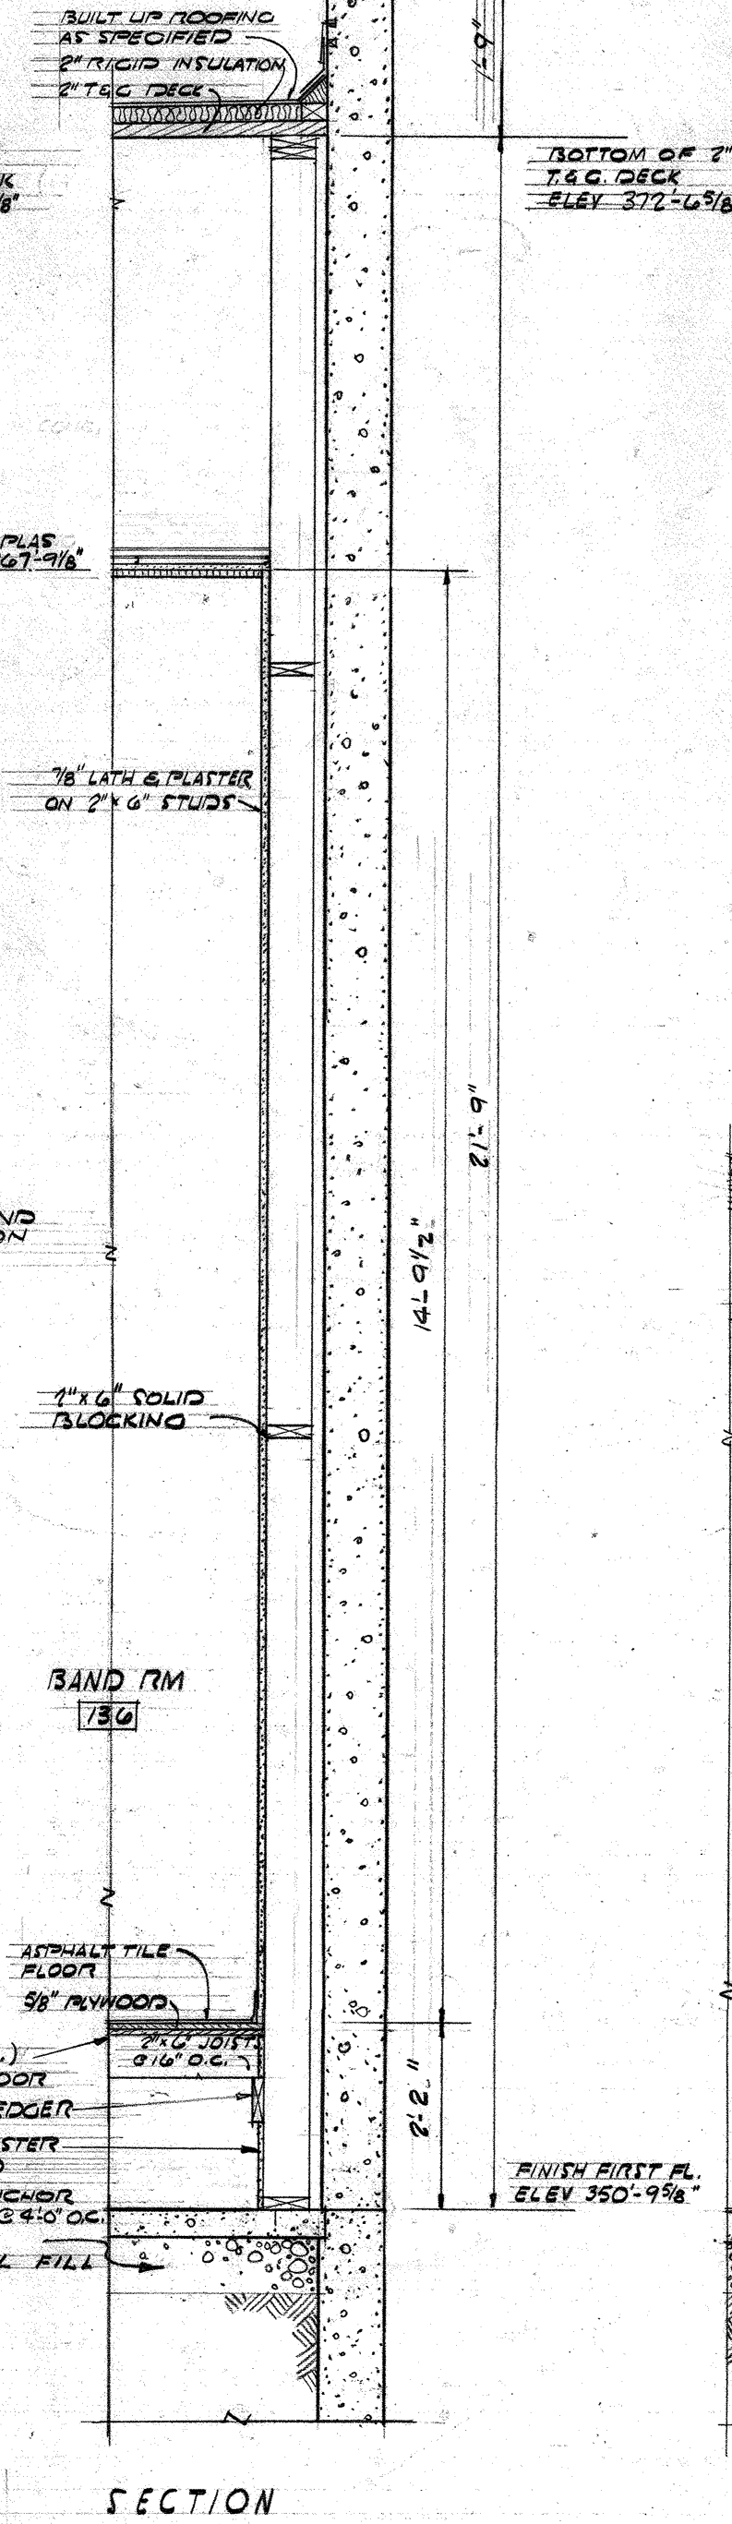

SECTION
THRU SOUTH WALL BAND
ROOM 136
SIMILAR @ NORTH WALL CHOIR RM 147

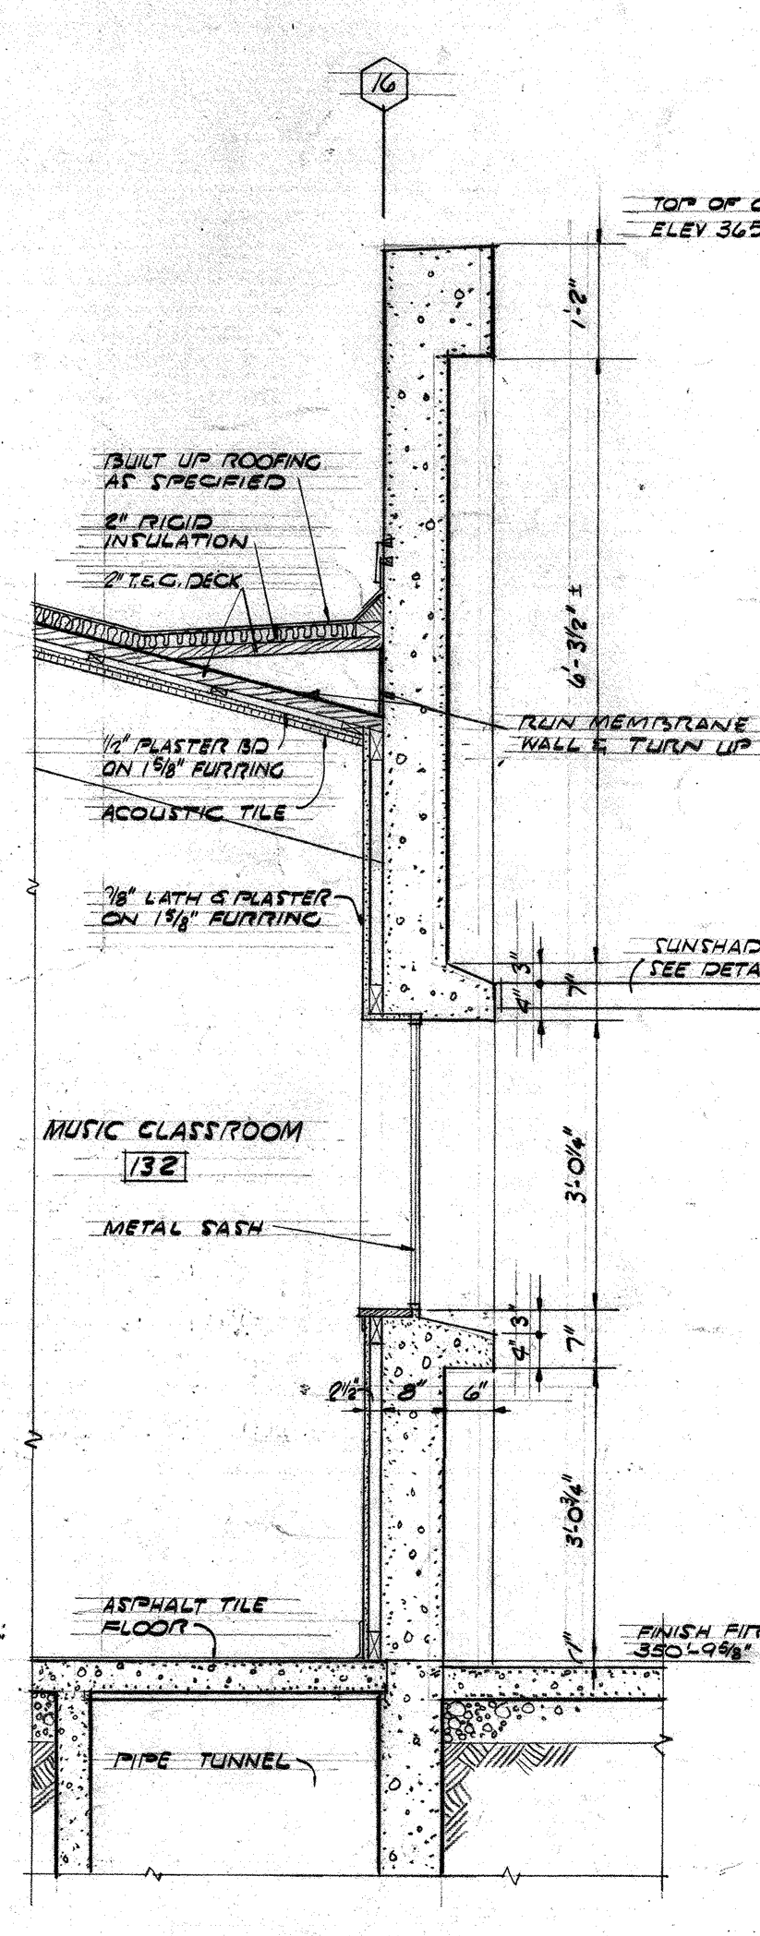
16
TOP OF CONC. ELEV 365'-6 1/8"
BUILT UP ROOFING AS SPECIFIED
2" RIGID INSULATION
2" T.&G. DECK
RUN MEMBRANE TO WALL & TURN UP 8"
1/2" PLASTER BD ON 1 5/8" FURRING
ACOUSTIC TILE
7/8" LATH & PLASTER ON 1 5/8" FURRING
SUNSHADE SEE DETAIL
MUSIC CLASSROOM
132
METAL SASH
ASPHALT TILE FLOOR
FINISH FIRST FL. 350'-9 5/8"
PIPE TUNNEL
1'-2"
6'-3 1/2" ±
3'-0 1/4"
3'-0 3/4"
7"
8"
6"

SECTION
THRU SOUTH WALL MUSIC
CLASSROOM 132

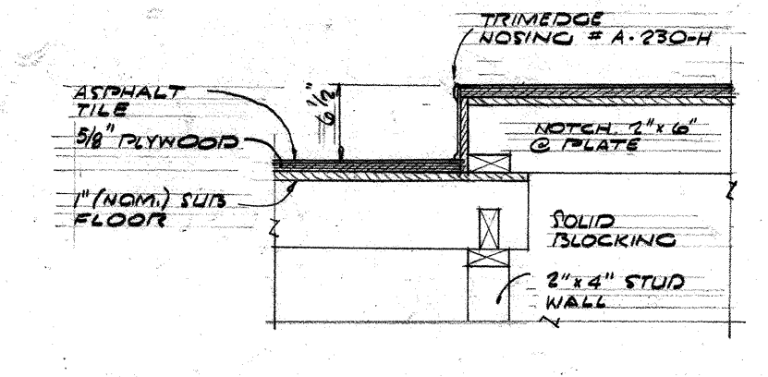

PLATFORM DETAIL BAND RM 136 & CHOIR ROOM 141
SCALE 3/4"=1'-0"

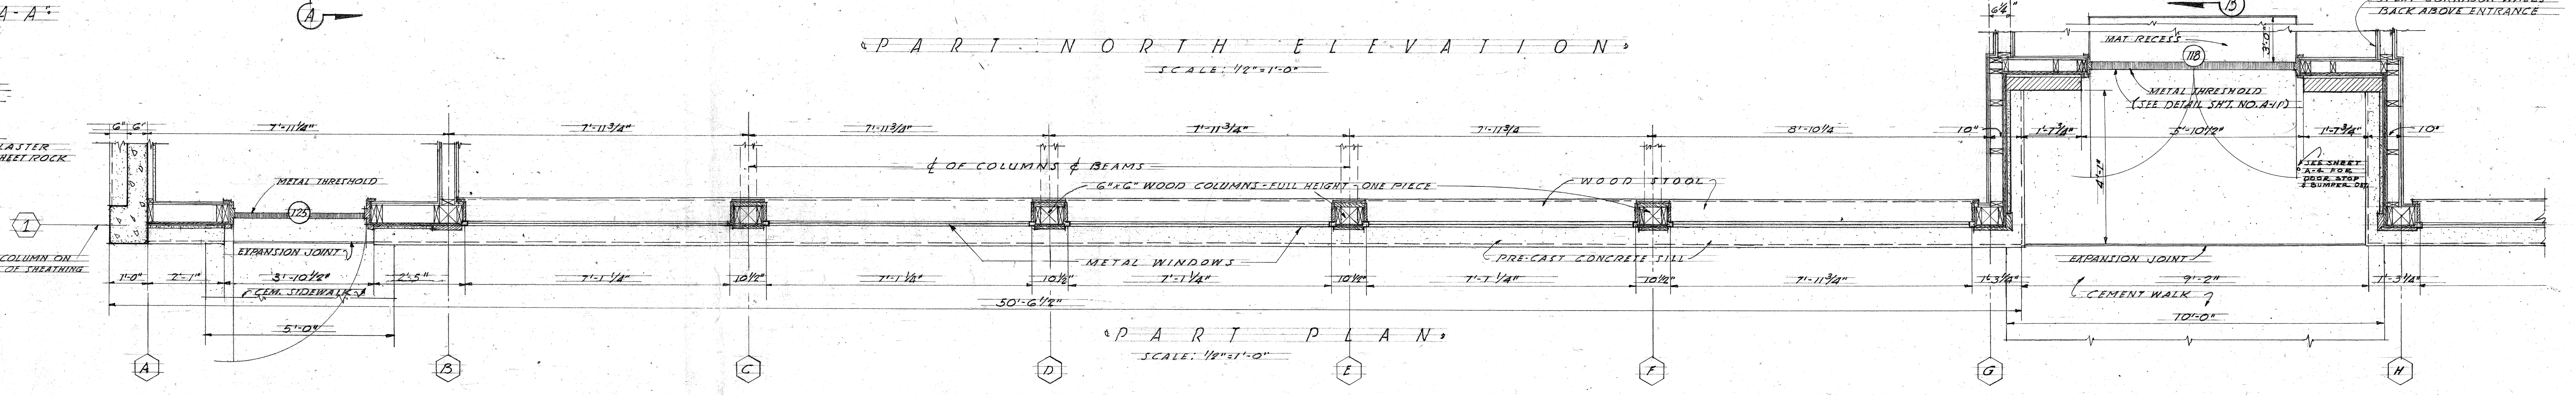

PART PLAN
SCALE: 1/2"=1'-0"

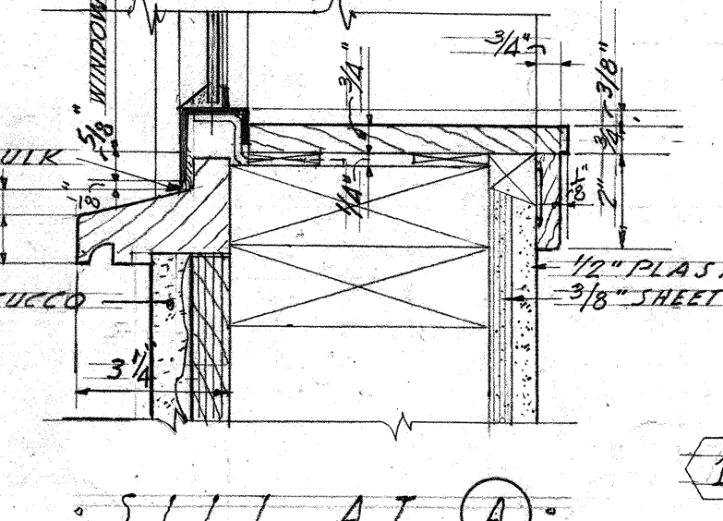

SILL AT (A)

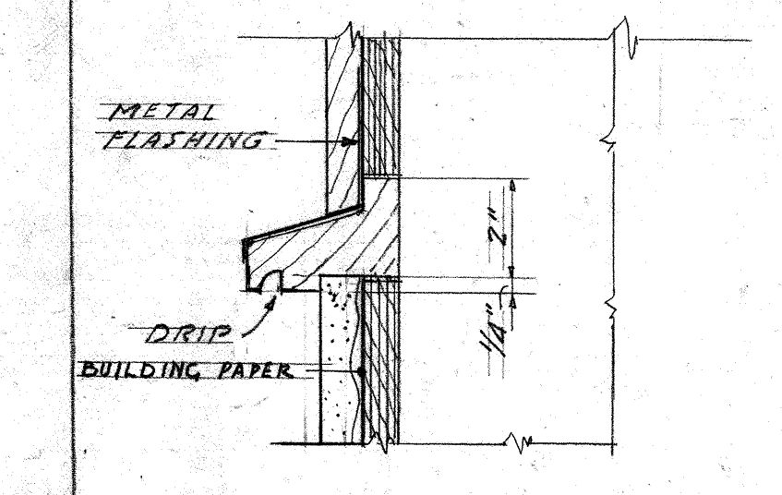

DETAIL AT (B)

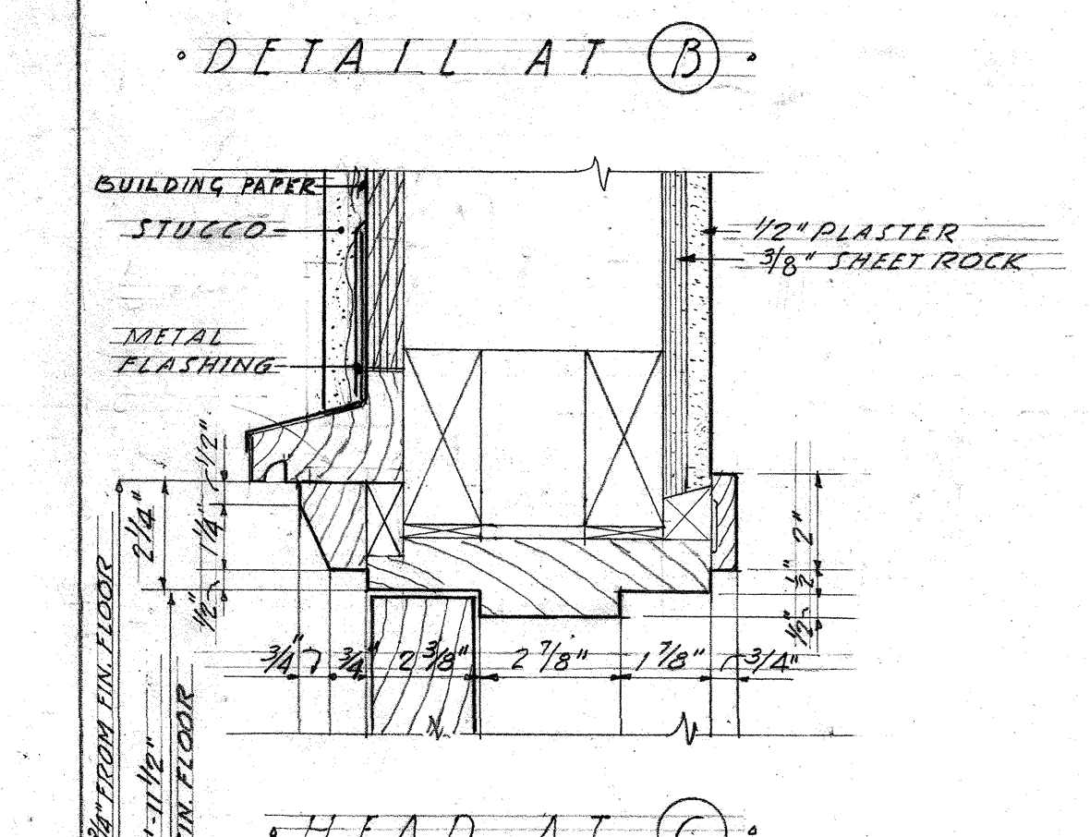

HEAD AT (C)

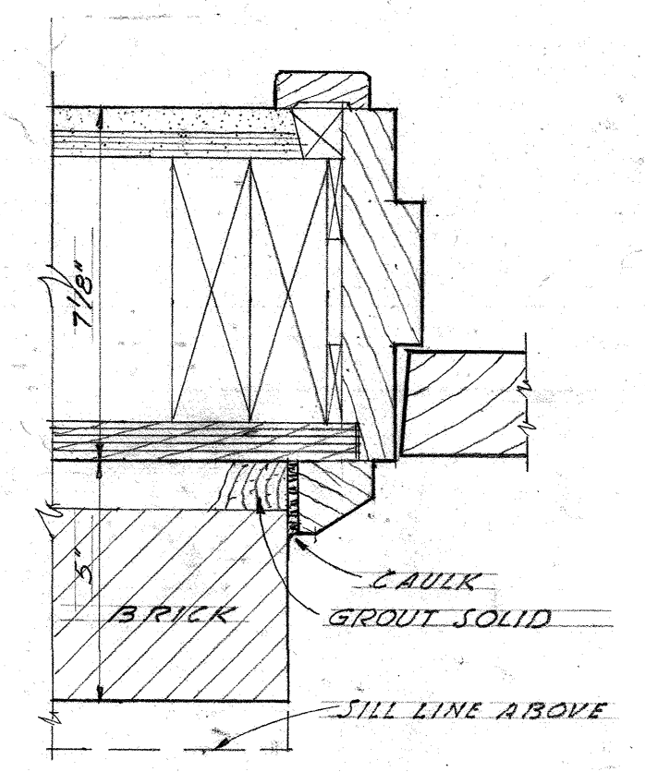

JAMB AT (E)

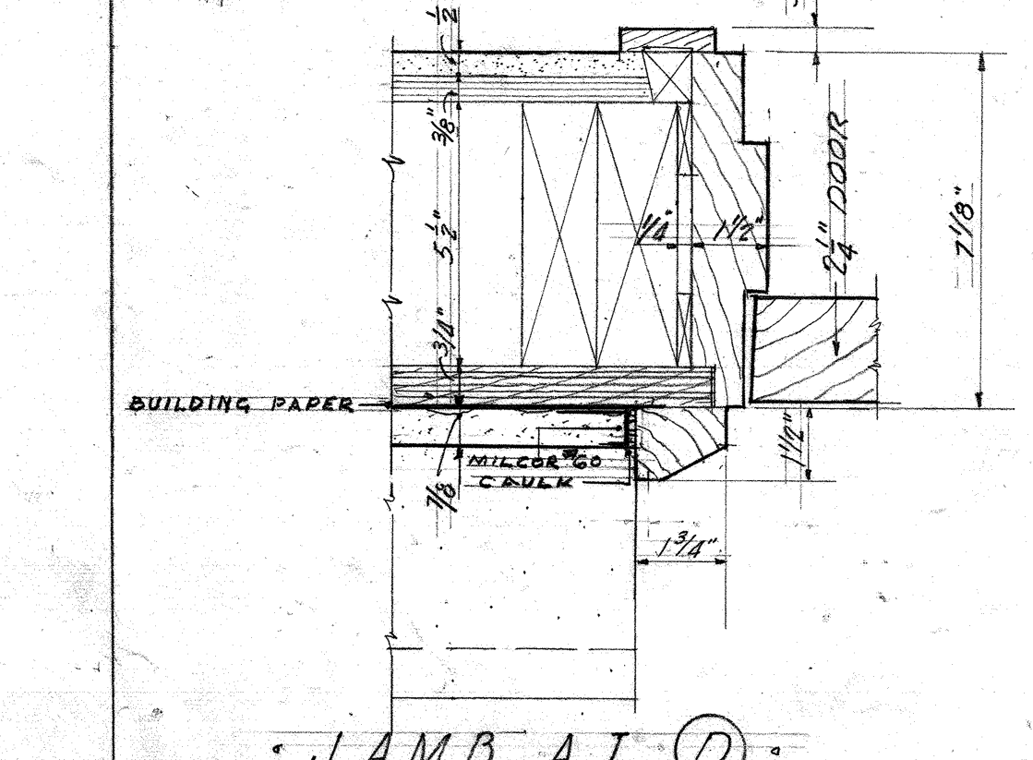

JAMB AT (D)

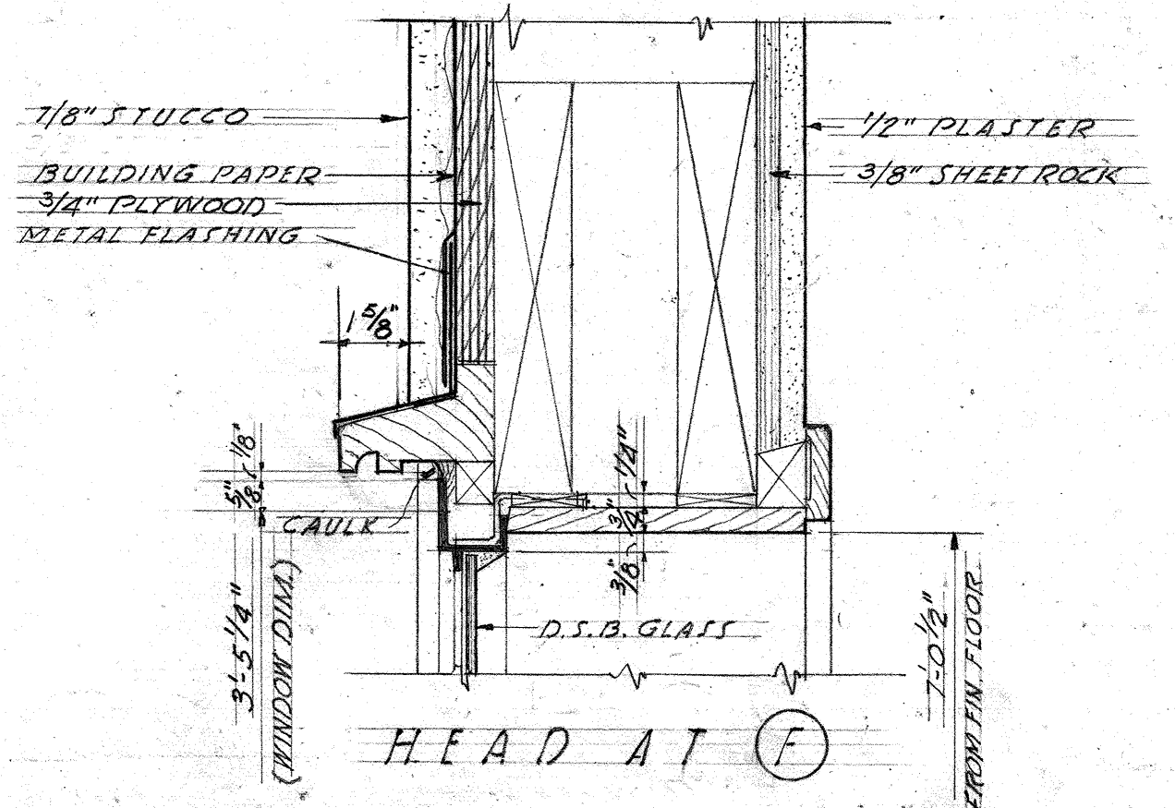

HEAD AT (F)

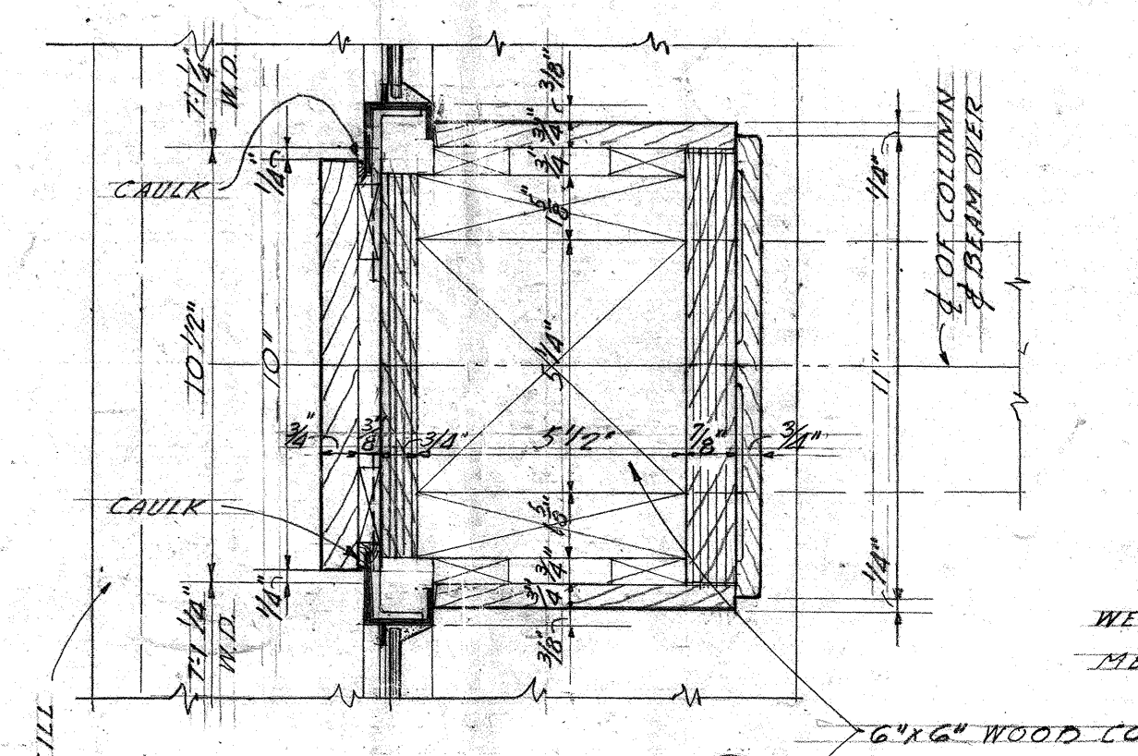

MULLION AT (G)

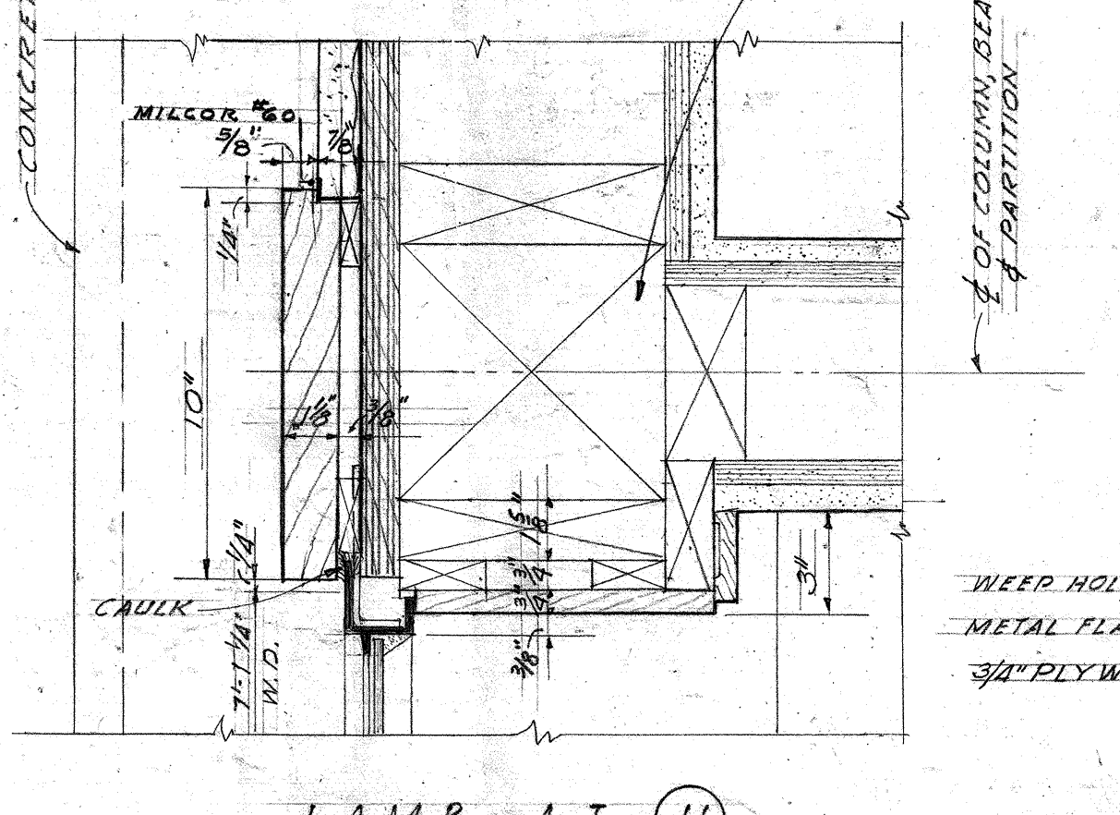

JAMB AT (H)

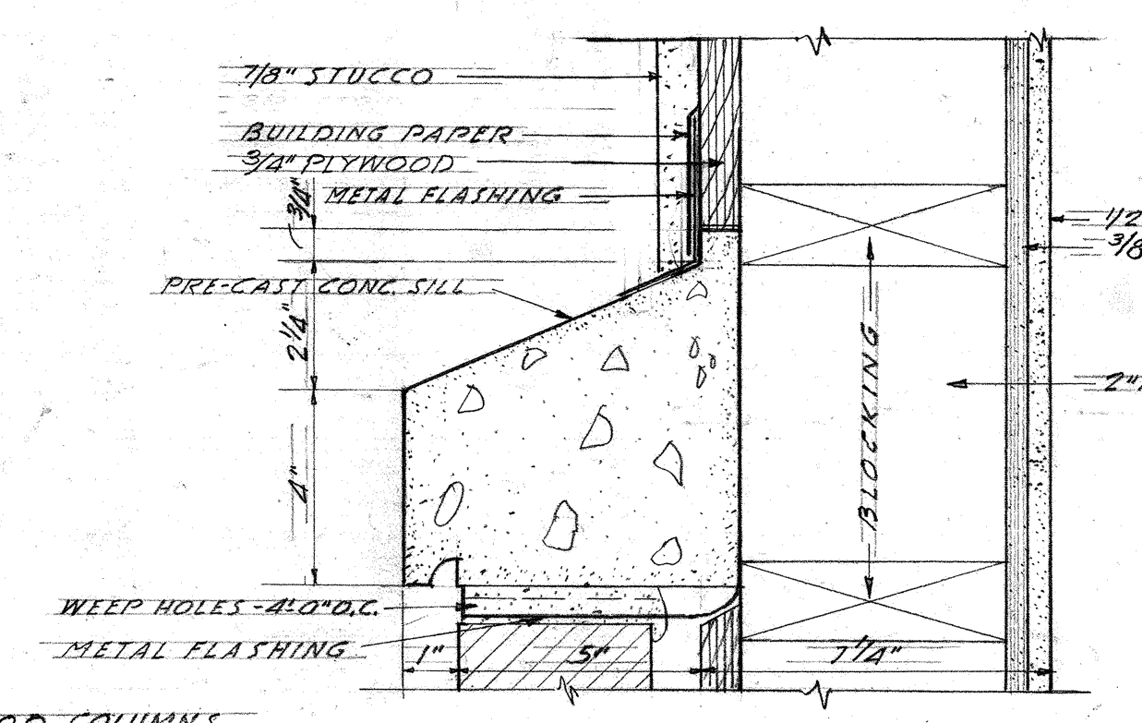

SILL AT (J)

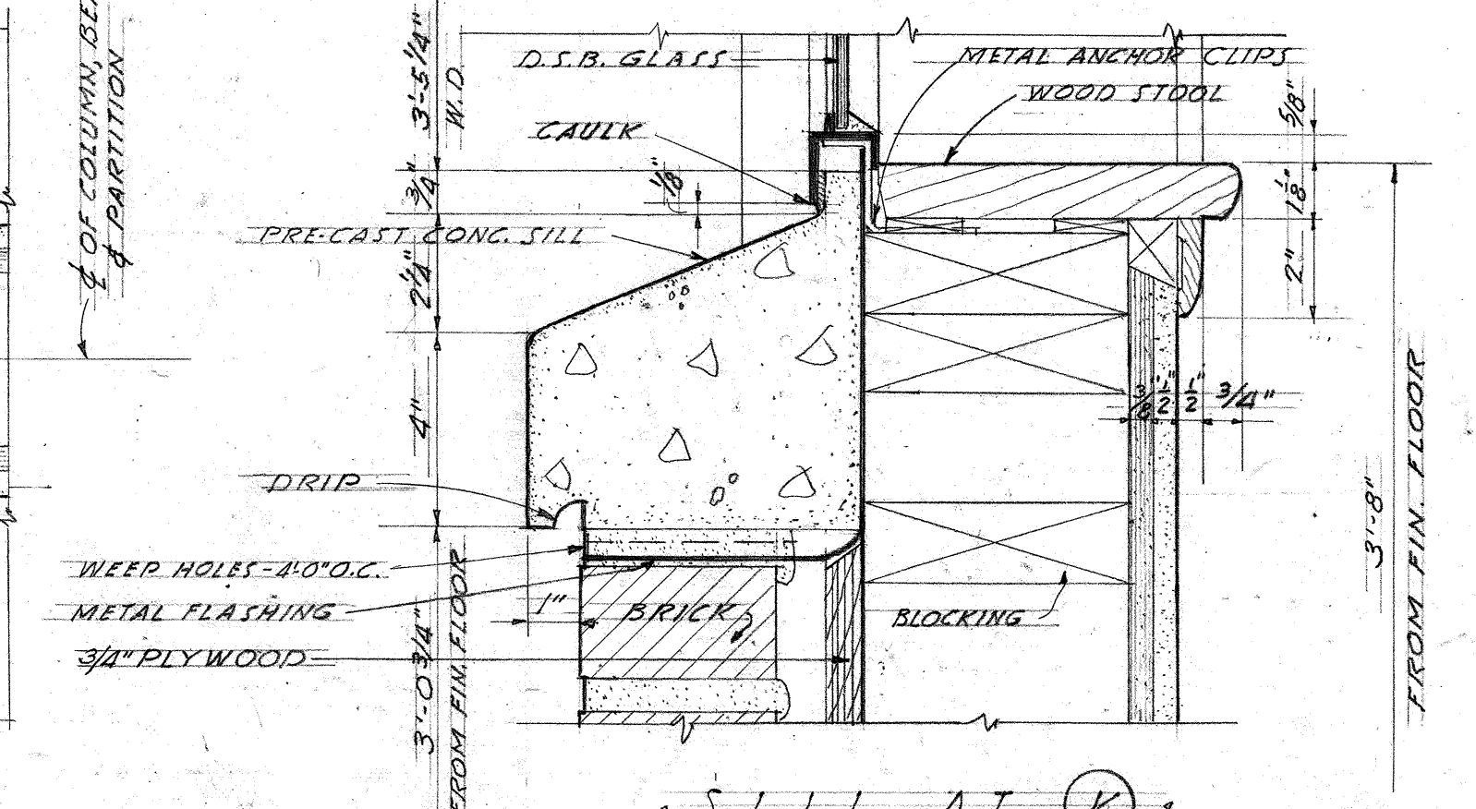

SILL AT (K)

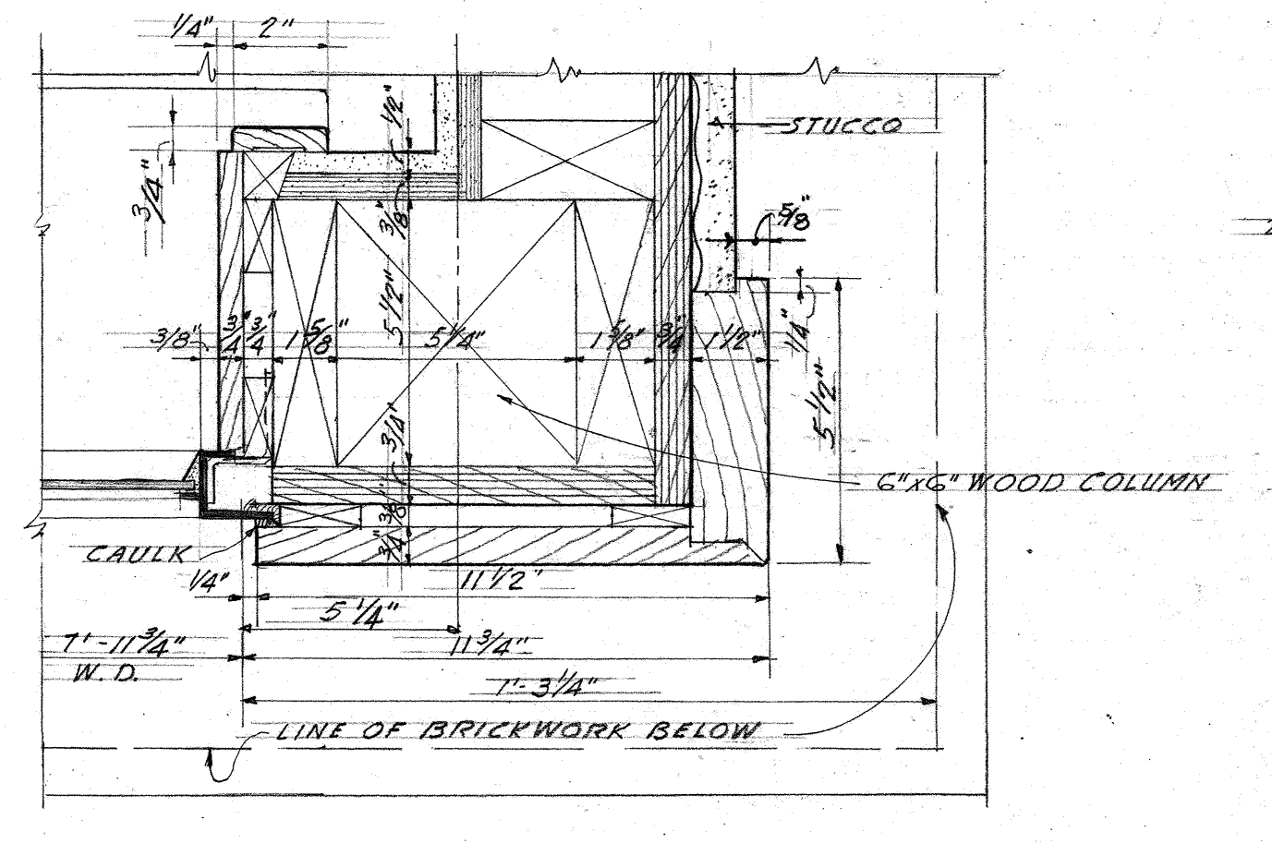

JAMB AT (L)

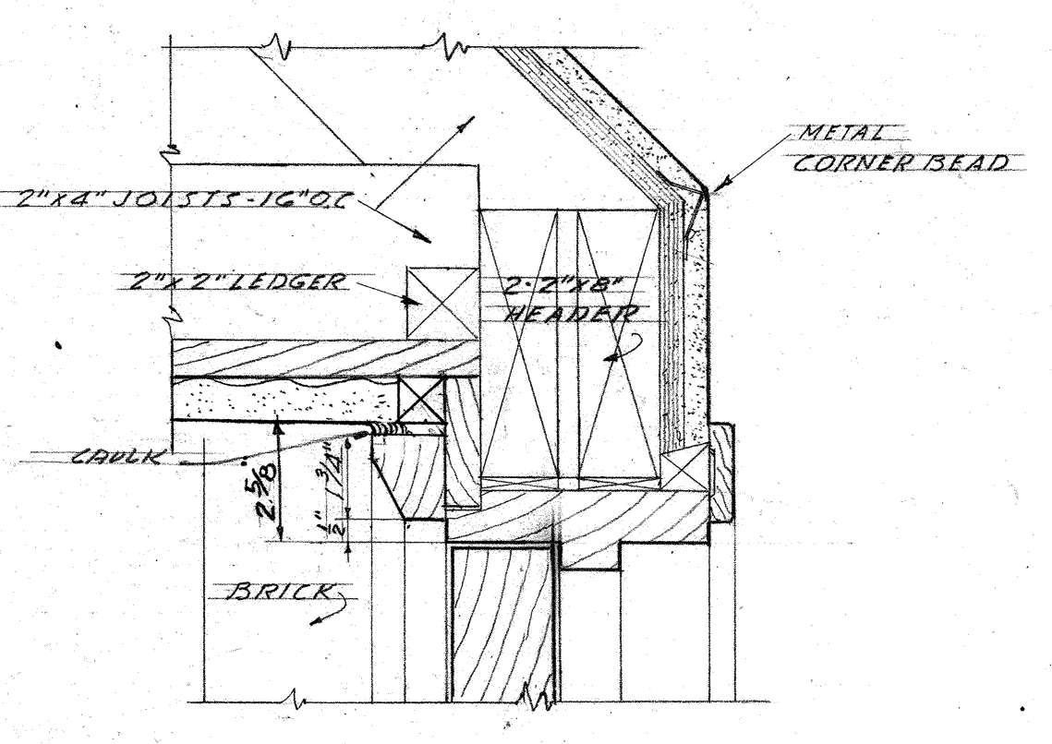

HEAD AT (N)

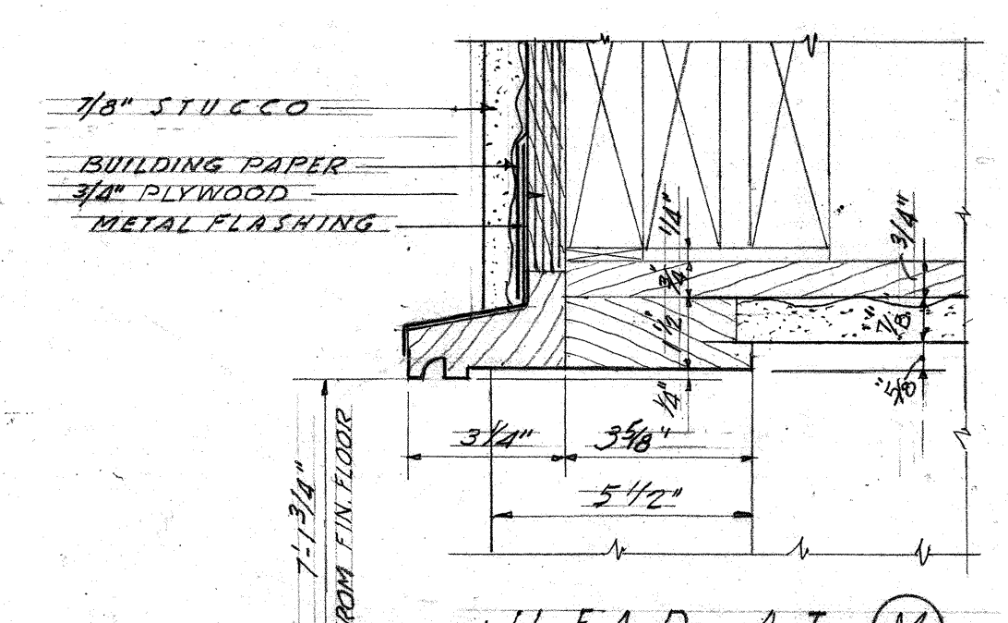

HEAD AT (M)

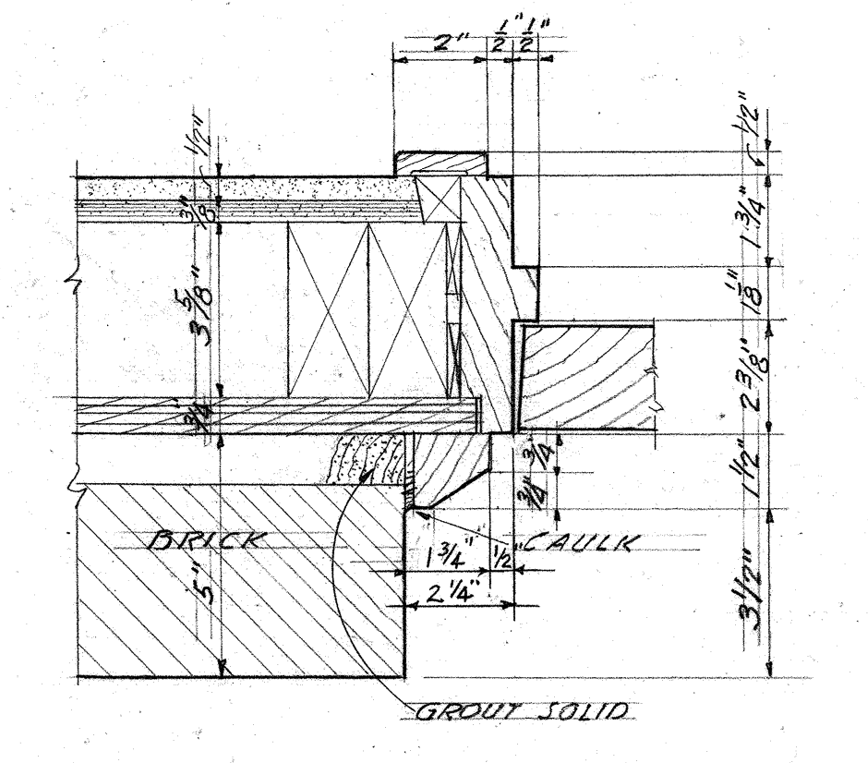

JAMB AT (O)

SCALE OF DETAILS - 3"=1'-0"

REVISED TO AS-BUILT STATUS BY: REKEVICS CHECKED: MAY. 1-24-57

NORTH ELEVATION DETAILS AND SECTIONS UNIT A

JOHN W. MALONEY
RENEWED TO JUNE 1, 1955
L-10
STATE OF WASHINGTON
LICENSED ARCHITECT

EDMOND MEANY JUNIOR HIGH - RECREATION PROJECT
FOR THE
SEATTLE PUBLIC SCHOOL DISTRICT No. 1
AND THE
SEATTLE DEPARTMENT OF PARKS
20TH AVENUE NORTH AT EAST REPUBLICAN STREET – SEATTLE, WASHINGTON

DATE		DRAWN
6-21-54	JOHN W. MALONEY A. I. A. ARCHITECT	ECKERT JACOBSON
DWG. NO.	754 CENTRAL BUILDING 1117 LARSON BLDG.	CHECKED
A9	SEATTLE WASHINGTON YAKIMA	MAY

139-0042

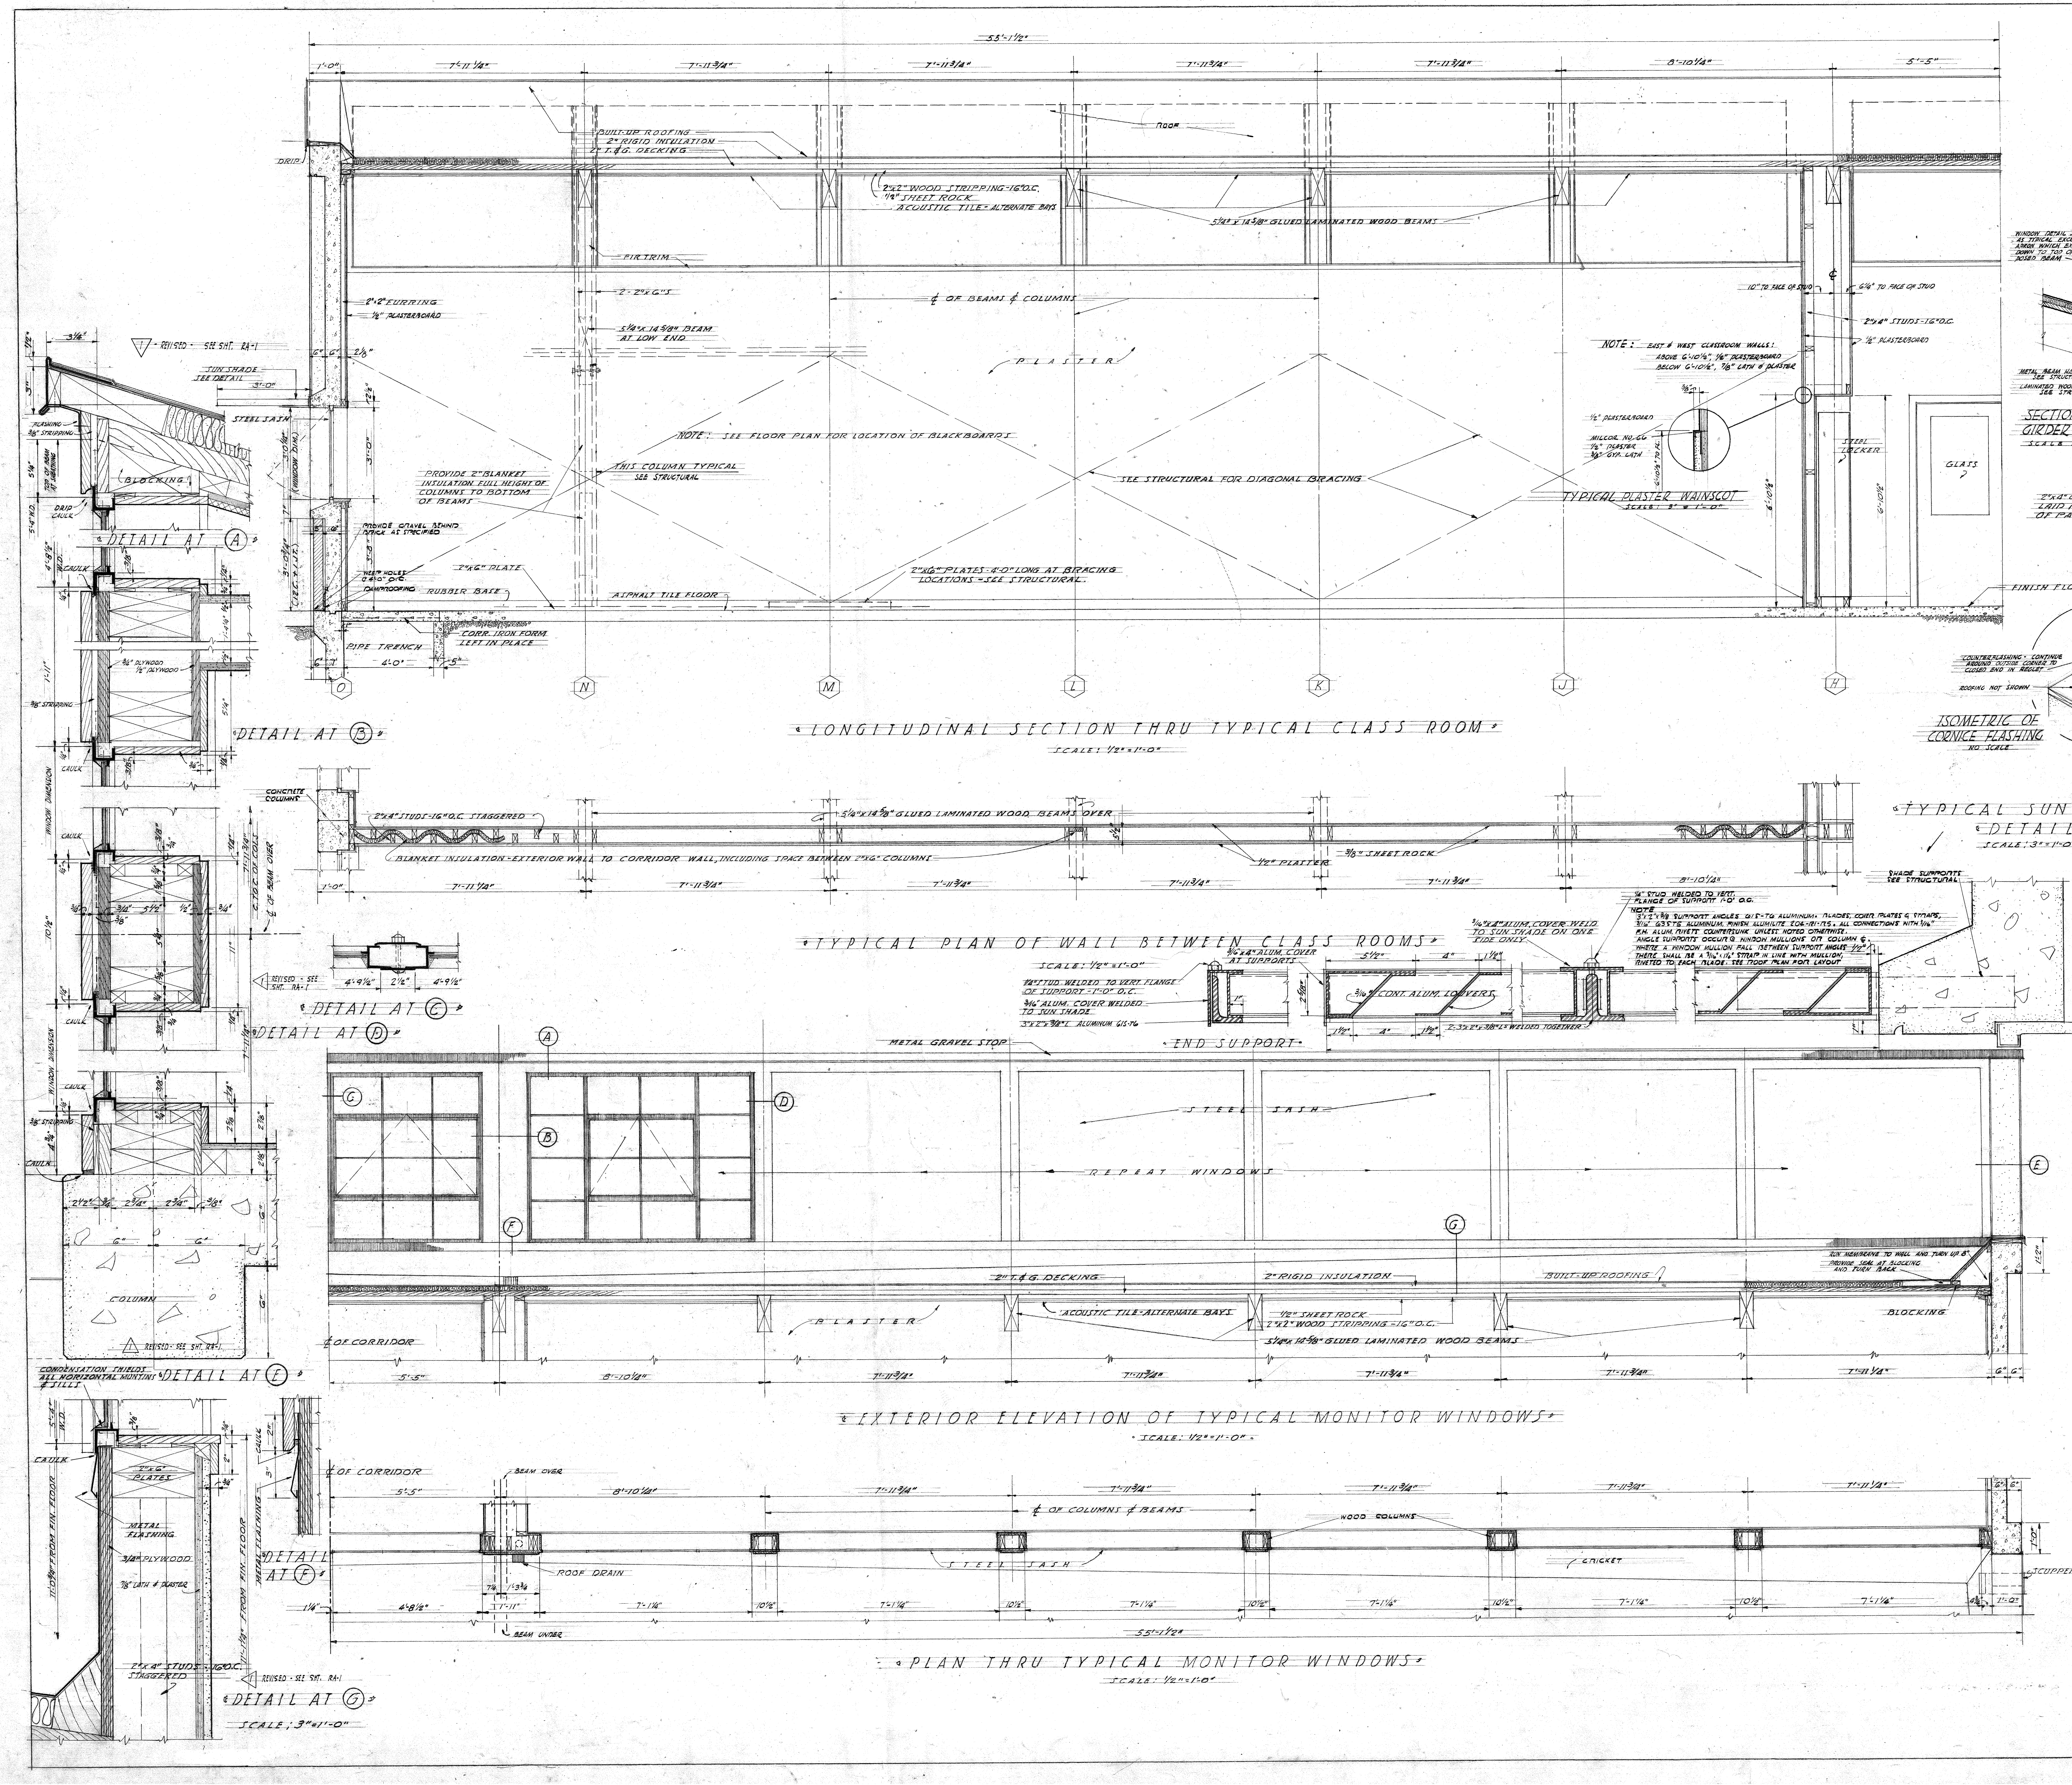
55'-1½"
1'-0"
7'-11¼"
7'-11¾"
8'-10¼"
5'-5"
BUILT-UP ROOFING
2" RIGID INSULATION
2" T.&G. DECKING
DRIP
ROOF
2"x2" WOOD STRIPPING-16"O.C.
½" SHEET ROCK
ACOUSTIC TILE-ALTERNATE BAYS
5¼" x 14⅝" GLUED LAMINATED WOOD BEAMS
FIR TRIM
2"x2" FURRING
½" PLASTERBOARD
2-2"x6"S
℄ OF BEAMS & COLUMNS
5¼"x14⅝" BEAM AT LOW END
PLASTER
NOTE: SEE FLOOR PLAN FOR LOCATION OF BLACKBOARDS
THIS COLUMN TYPICAL SEE STRUCTURAL
PROVIDE 2" BLANKET INSULATION FULL HEIGHT OF COLUMNS TO BOTTOM OF BEAMS
SEE STRUCTURAL FOR DIAGONAL BRACING
PROVIDE GRAVEL BEHIND BRICK AS SPECIFIED
WEEP HOLES @ 4'-0" O.C.
DAMPROOFING
RUBBER BASE
2"x6" PLATE
ASPHALT TILE FLOOR
2"x6" PLATES-4'-0" LONG AT BRACING LOCATIONS-SEE STRUCTURAL.
CORR. IRON FORM LEFT IN PLACE
PIPE TRENCH
4'-0"
10" TO FACE OF STUD
6¼" TO FACE OF STUD
2"x4" STUDS-16"O.C.
NOTE: EAST & WEST CLASSROOM WALLS: ABOVE 6'-10½", ½" PLASTERBOARD BELOW 6'-10½", ⅞" LATH & PLASTER
½" PLASTERBOARD
MILCOR NO. 66
½" PLASTER
⅜" GYP. LATH
6'-10½" TO FL.
TYPICAL PLASTER WAINSCOT
SCALE: 3" = 1'-0"
STEEL LOCKER
GLASS
6'-10½"
O
N
M
L
K
J
H
LONGITUDINAL SECTION THRU TYPICAL CLASS ROOM
SCALE: ½"=1'-0"
REVISED - SEE SHT. RA-1
SUN SHADE SEE DETAIL
3'-0"
STEEL SASH
FLASHING
⅜" STRIPPING
BLOCKING
DRIP
CAULK
TOP OF BEAM AT SHEATHING
(WINDOW DIM.)
DETAIL AT (A)
¾" PLYWOOD
½" PLYWOOD
DETAIL AT (B)
CONCRETE COLUMNS
2"x4" STUDS-16"O.C. STAGGERED
5¼"x14⅝" GLUED LAMINATED WOOD BEAMS OVER
BLANKET INSULATION-EXTERIOR WALL TO CORRIDOR WALL, INCLUDING SPACE BETWEEN 2"x6" COLUMNS
½" PLASTER
⅜" SHEET ROCK
TYPICAL PLAN OF WALL BETWEEN CLASS ROOMS
SCALE: ½"=1'-0"
4'-9½"
2½"
DETAIL AT (C)
DETAIL AT (D)
TYPICAL SUN SHADE DETAIL
SCALE: 3"=1'-0"
SHADE SUPPORTS SEE STRUCTURAL
¼" STUD WELDED TO VERT. FLANGE OF SUPPORT-1'-0" O.C.
3/16" ALUM. COVER WELDED TO SUN SHADE
3"x2"x⅜"L ALUMINUM 61S-T6
3/16"x4" ALUM. COVER AT SUPPORTS
3/16"x4" ALUM. COVER WELD TO SUN SHADE ON ONE SIDE ONLY
3/16" CONT. ALUM. LOUVERS
2-3"x2"x⅜"L's WELDED TOGETHER
END SUPPORT
¼" STUD WELDED TO VERT. FLANGE OF SUPPORT 1'-0" O.C.
NOTE
3"x2"x⅜ SUPPORT ANGLES 61S-T6 ALUMINUM. BLADES, COVER PLATES & STRAPS, 3/16" 63S-T5 ALUMINUM. FINISH ALUMILITE 204-R1-R5. ALL CONNECTIONS WITH 3/16" F.H. ALUM. RIVETS COUNTERSUNK UNLESS NOTED OTHERWISE. ANGLE SUPPORTS OCCUR @ WINDOW MULLIONS OR COLUMN ℄. WHERE A WINDOW MULLION FALL BETWEEN SUPPORT ANGLES THERE SHALL BE A 3/16"x1½" STRAP IN LINE WITH MULLION, RIVETED TO EACH BLADE. SEE ROOF PLAN FOR LAYOUT
METAL GRAVEL STOP
STEEL SASH
REPEAT WINDOWS
2" T.&G. DECKING
2" RIGID INSULATION
BUILT-UP ROOFING
RUN MEMBRANE TO WALL AND TURN UP 8" PROVIDE SEAL AT BLOCKING AND TURN BACK
BLOCKING
PLASTER
ACOUSTIC TILE-ALTERNATE BAYS
½" SHEET ROCK
2"x2" WOOD STRIPPING-16"O.C.
5¼"x14⅝" GLUED LAMINATED WOOD BEAMS
℄ OF CORRIDOR
EXTERIOR ELEVATION OF TYPICAL MONITOR WINDOWS
SCALE: ½"=1'-0"
COLUMN
DETAIL AT (E)
CONDENSATION SHIELDS ALL HORIZONTAL MONTINS & SILLS
CAULK
2"x6" PLATES
METAL FLASHING
¾" PLYWOOD
⅞" LATH & PLASTER
FROM FIN. FLOOR
2"x4" STUDS-16"O.C. STAGGERED
DETAIL AT (F)
DETAIL AT (G)
SCALE: 3"=1'-0"
BEAM OVER
℄ OF COLUMNS & BEAMS
WOOD COLUMNS
ROOF DRAIN
STEEL SASH
CRICKET
SCUPPER
BEAM UNDER
PLAN THRU TYPICAL MONITOR WINDOWS
SCALE: ½"=1'-0"

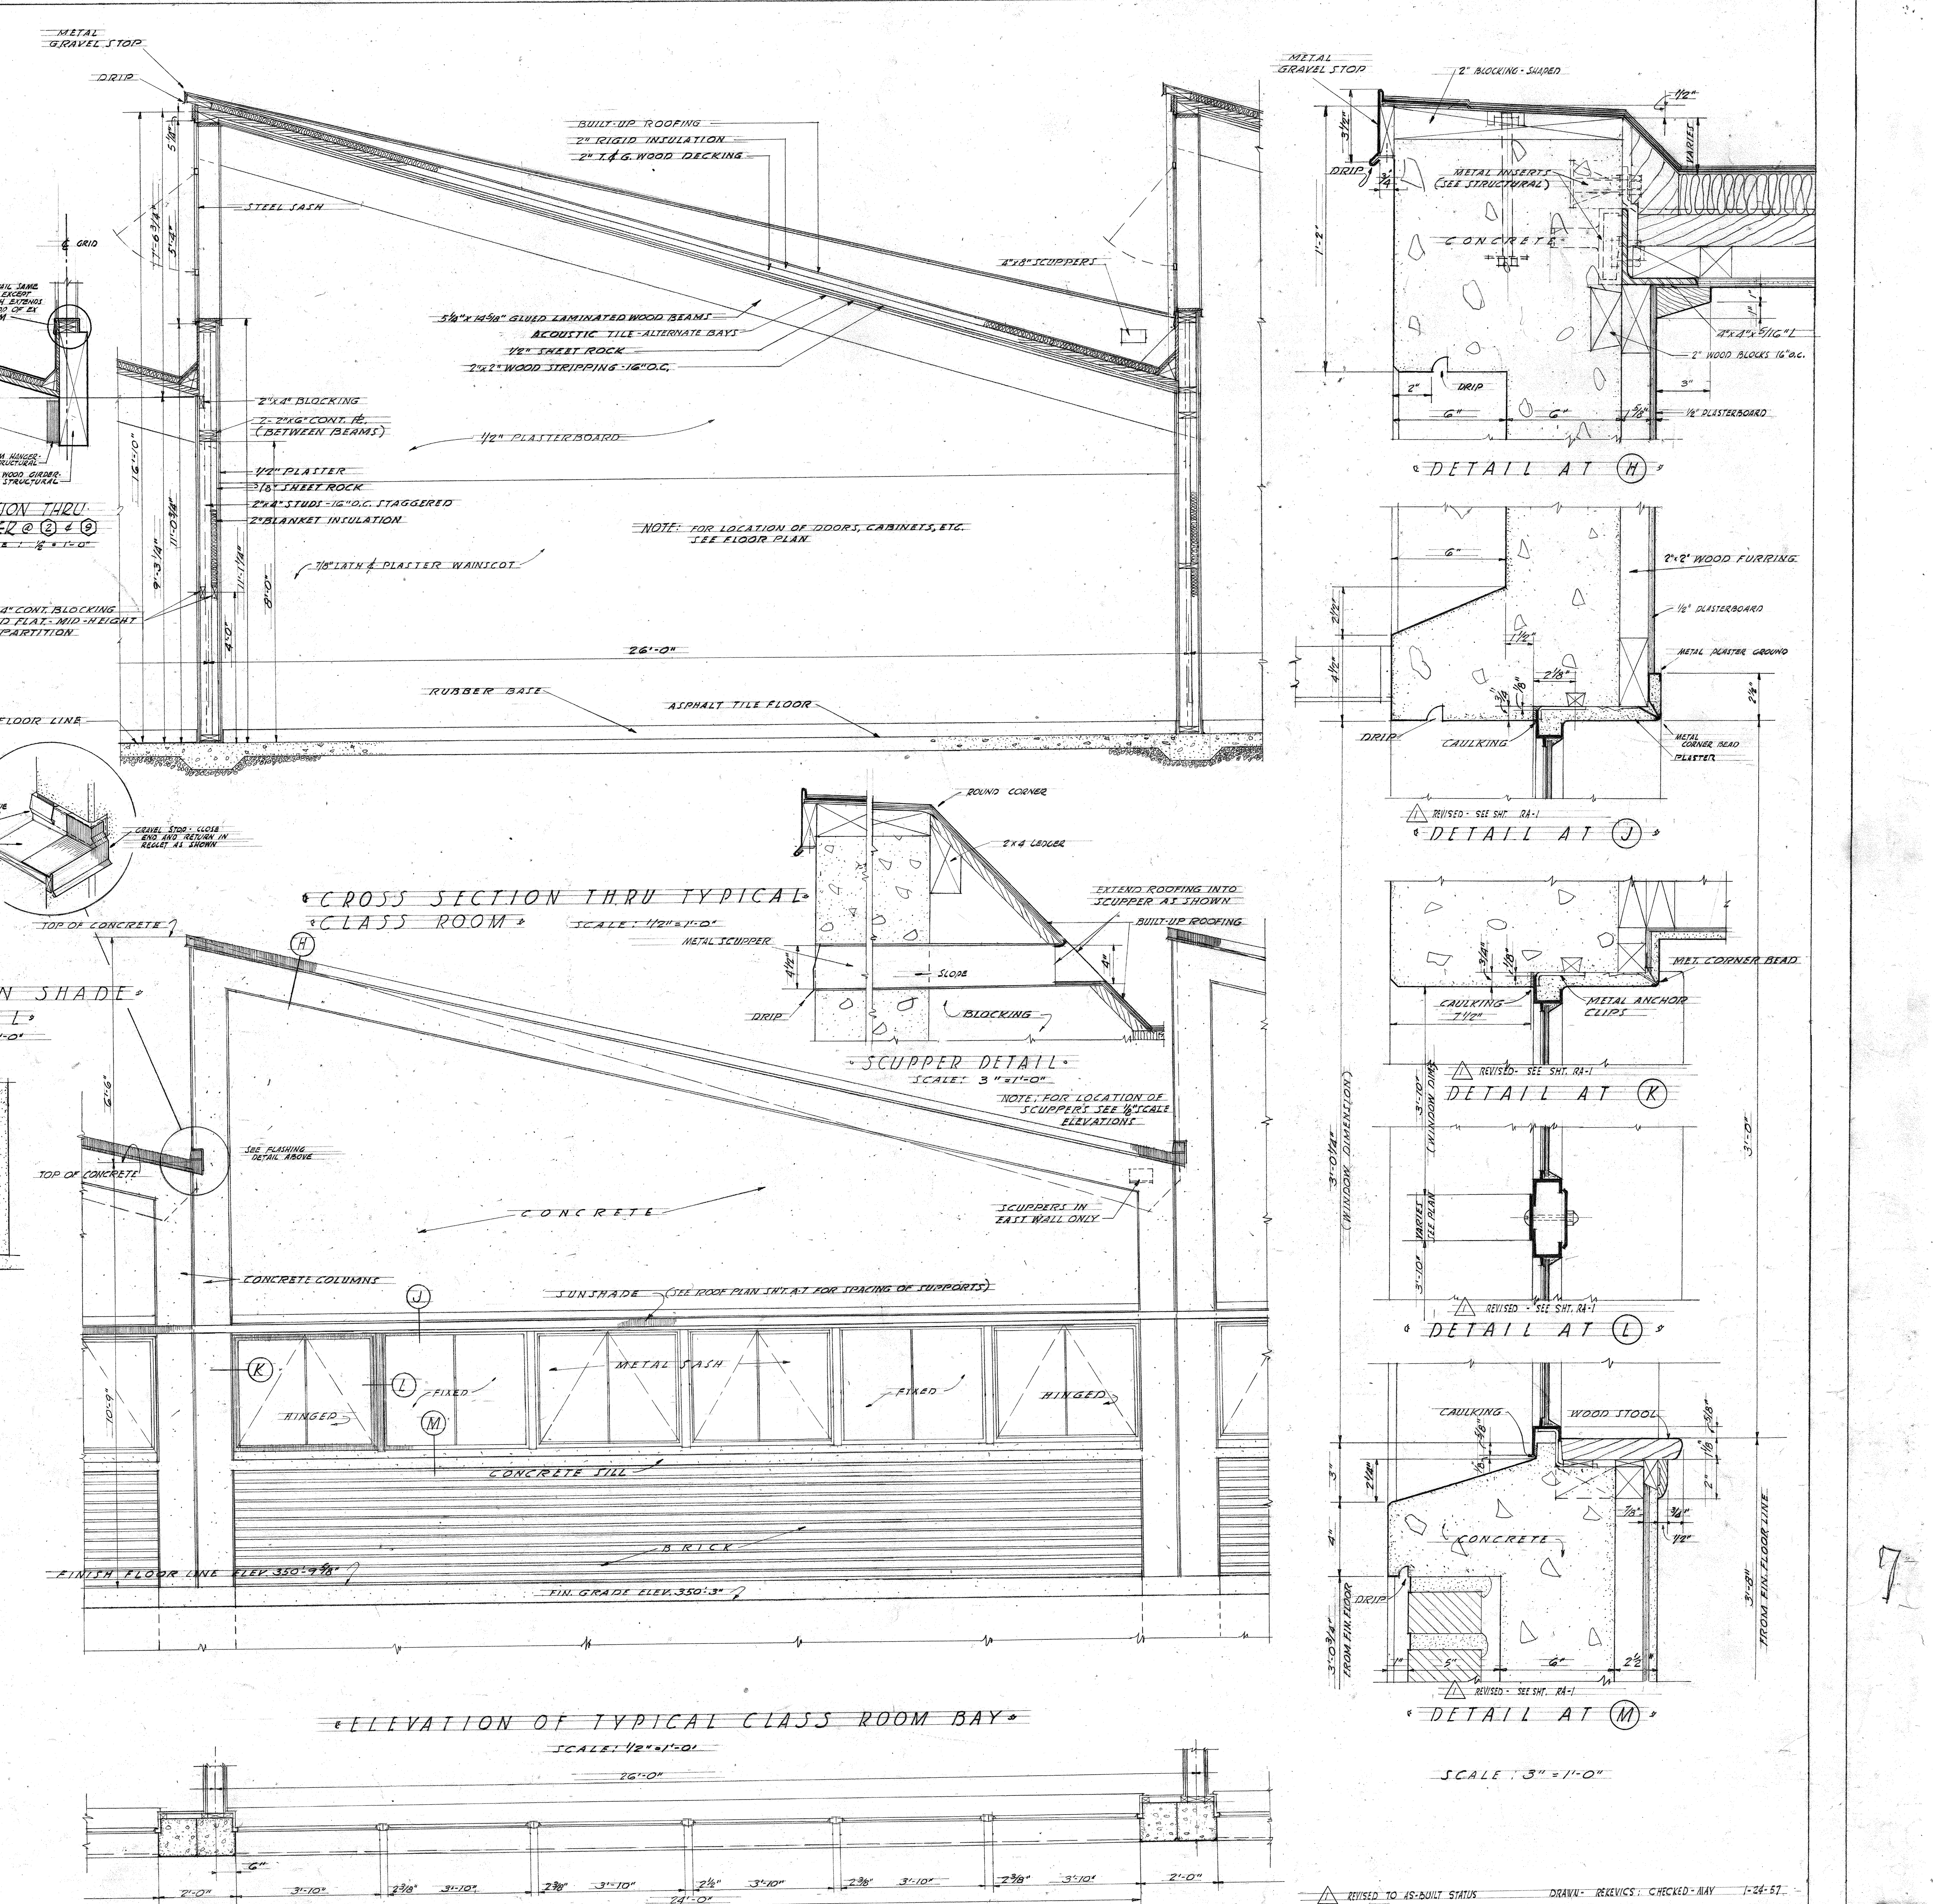
METAL GRAVEL STOP
DRIP
℄ GRID
WINDOW DETAIL SAME AS TYPICAL EXCEPT APRON WHICH EXTENDS DOWN TO TOP OF EXPOSED BEAM
METAL BEAM HANGER-SEE STRUCTURAL
LAMINATED WOOD GIRDER-SEE STRUCTURAL
SECTION THRU GIRDER @ (2) & (9)
SCALE: ½" = 1'-0"
2"x4" CONT. BLOCKING LAID FLAT-MID-HEIGHT OF PARTITION
FINISH FLOOR LINE
COUNTERFLASHING - CONTINUE AROUND OUTSIDE CORNER TO CLOSED END IN REGLET
ROOFING NOT SHOWN
GRAVEL STOP - CLOSE END AND RETURN IN REGLET AS SHOWN
ISOMETRIC OF CORNICE FLASHING
NO SCALE
STEEL SASH
BUILT-UP ROOFING
2" RIGID INSULATION
2" T.&G. WOOD DECKING
4"x8" SCUPPERS
5¼"x14⅝" GLUED LAMINATED WOOD BEAMS
ACOUSTIC TILE-ALTERNATE BAYS
½" SHEET ROCK
2"x2" WOOD STRIPPING-16"O.C.
2"x4" BLOCKING
2-2"x6" CONT. PL. (BETWEEN BEAMS)
½" PLASTERBOARD
½" PLASTER
⅜" SHEET ROCK
2"x4" STUDS-16"O.C. STAGGERED
2" BLANKET INSULATION
NOTE: FOR LOCATION OF DOORS, CABINETS, ETC. SEE FLOOR PLAN
⅞" LATH & PLASTER WAINSCOT
26'-0"
RUBBER BASE
ASPHALT TILE FLOOR
16'-0"
11'-0¾"
9'-3¼"
11'-1¼"
8'-0"
4'-0"
CROSS SECTION THRU TYPICAL CLASS ROOM
SCALE: ½"=1'-0"
TOP OF CONCRETE
SEE FLASHING DETAIL ABOVE
ROUND CORNER
2x4 LEDGER
EXTEND ROOFING INTO SCUPPER AS SHOWN
BUILT-UP ROOFING
METAL SCUPPER
SLOPE
BLOCKING
SCUPPER DETAIL
SCALE: 3"=1'-0"
NOTE: FOR LOCATION OF SCUPPERS SEE ⅛" SCALE ELEVATIONS
CONCRETE
SCUPPERS IN EAST WALL ONLY
CONCRETE COLUMNS
SUNSHADE (SEE ROOF PLAN SHT. A-7 FOR SPACING OF SUPPORTS)
METAL SASH
HINGED
FIXED
CONCRETE SILL
BRICK
FINISH FLOOR LINE ELEV. 350'-9⅝"
FIN. GRADE ELEV. 350'-3"
10'-9"
6'-6"
ELEVATION OF TYPICAL CLASS ROOM BAY
SCALE: ½"=1'-0"
26'-0"
2'-0"
3'-10"
2⅜"
2½"
24'-0"
PLAN OF TYPICAL CLASS ROOM BAY
SCALE: ½"=1'-0"
SCUPPER
PLAN BELOW WINDOWS
CONCRETE LINE ABOVE
PLAN BELOW GRADE
2" BLOCKING - SHAPED
METAL INSERTS (SEE STRUCTURAL)
CONCRETE
4"x4"x5/16"L
2" WOOD BLOCKS 16"O.C.
½" PLASTERBOARD
DETAIL AT (H)
2"x2" WOOD FURRING
½" PLASTERBOARD
METAL PLASTER GROUND
CAULKING
METAL CORNER BEAD
PLASTER
REVISED - SEE SHT. RA-1
DETAIL AT (J)
MET. CORNER BEAD
METAL ANCHOR CLIPS
DETAIL AT (K)
3'-0¼" (WINDOW DIMENSION)
3'-10" (WINDOW DIM.)
VARIES SEE PLAN
DETAIL AT (L)
WOOD STOOL
3'-0¾" FROM FIN. FLOOR
3'-8" FROM FIN. FLOOR LINE
DETAIL AT (M)
SCALE: 3"=1'-0"

△1 REVISED TO AS-BUILT STATUS DRAWN - REKEVICS; CHECKED - MAY 1-24-57

TYPICAL CLASSROOM DETAILS
AND SECTIONS UNIT A

JOHN W. MALONEY
RENEWED TO JUNE 1, 1965
TL 369
L-10
STATE OF WASHINGTON
LICENSED ARCHITECT

EDMOND MEANY JUNIOR HIGH - RECREATION PROJECT
FOR THE
SEATTLE PUBLIC SCHOOL DISTRICT No. 1
AND THE
SEATTLE DEPARTMENT OF PARKS
20TH AVENUE NORTH AT EAST REPUBLICAN STREET – SEATTLE, WASHINGTON

DATE 6-21-54	JOHN W. MALONEY A. I. A. ARCHITECT	DRAWN ECKERT YAVRICK
DWG. NO. A 10	754 CENTRAL BUILDING 1117 LARSON BLDG. SEATTLE WASHINGTON YAKIMA	CHECKED MAY

139-0041

EDMOND MEANY JR. HIGH
W. O. 21 DATE........
JOHN W. MALONEY, ARCHITECT

7

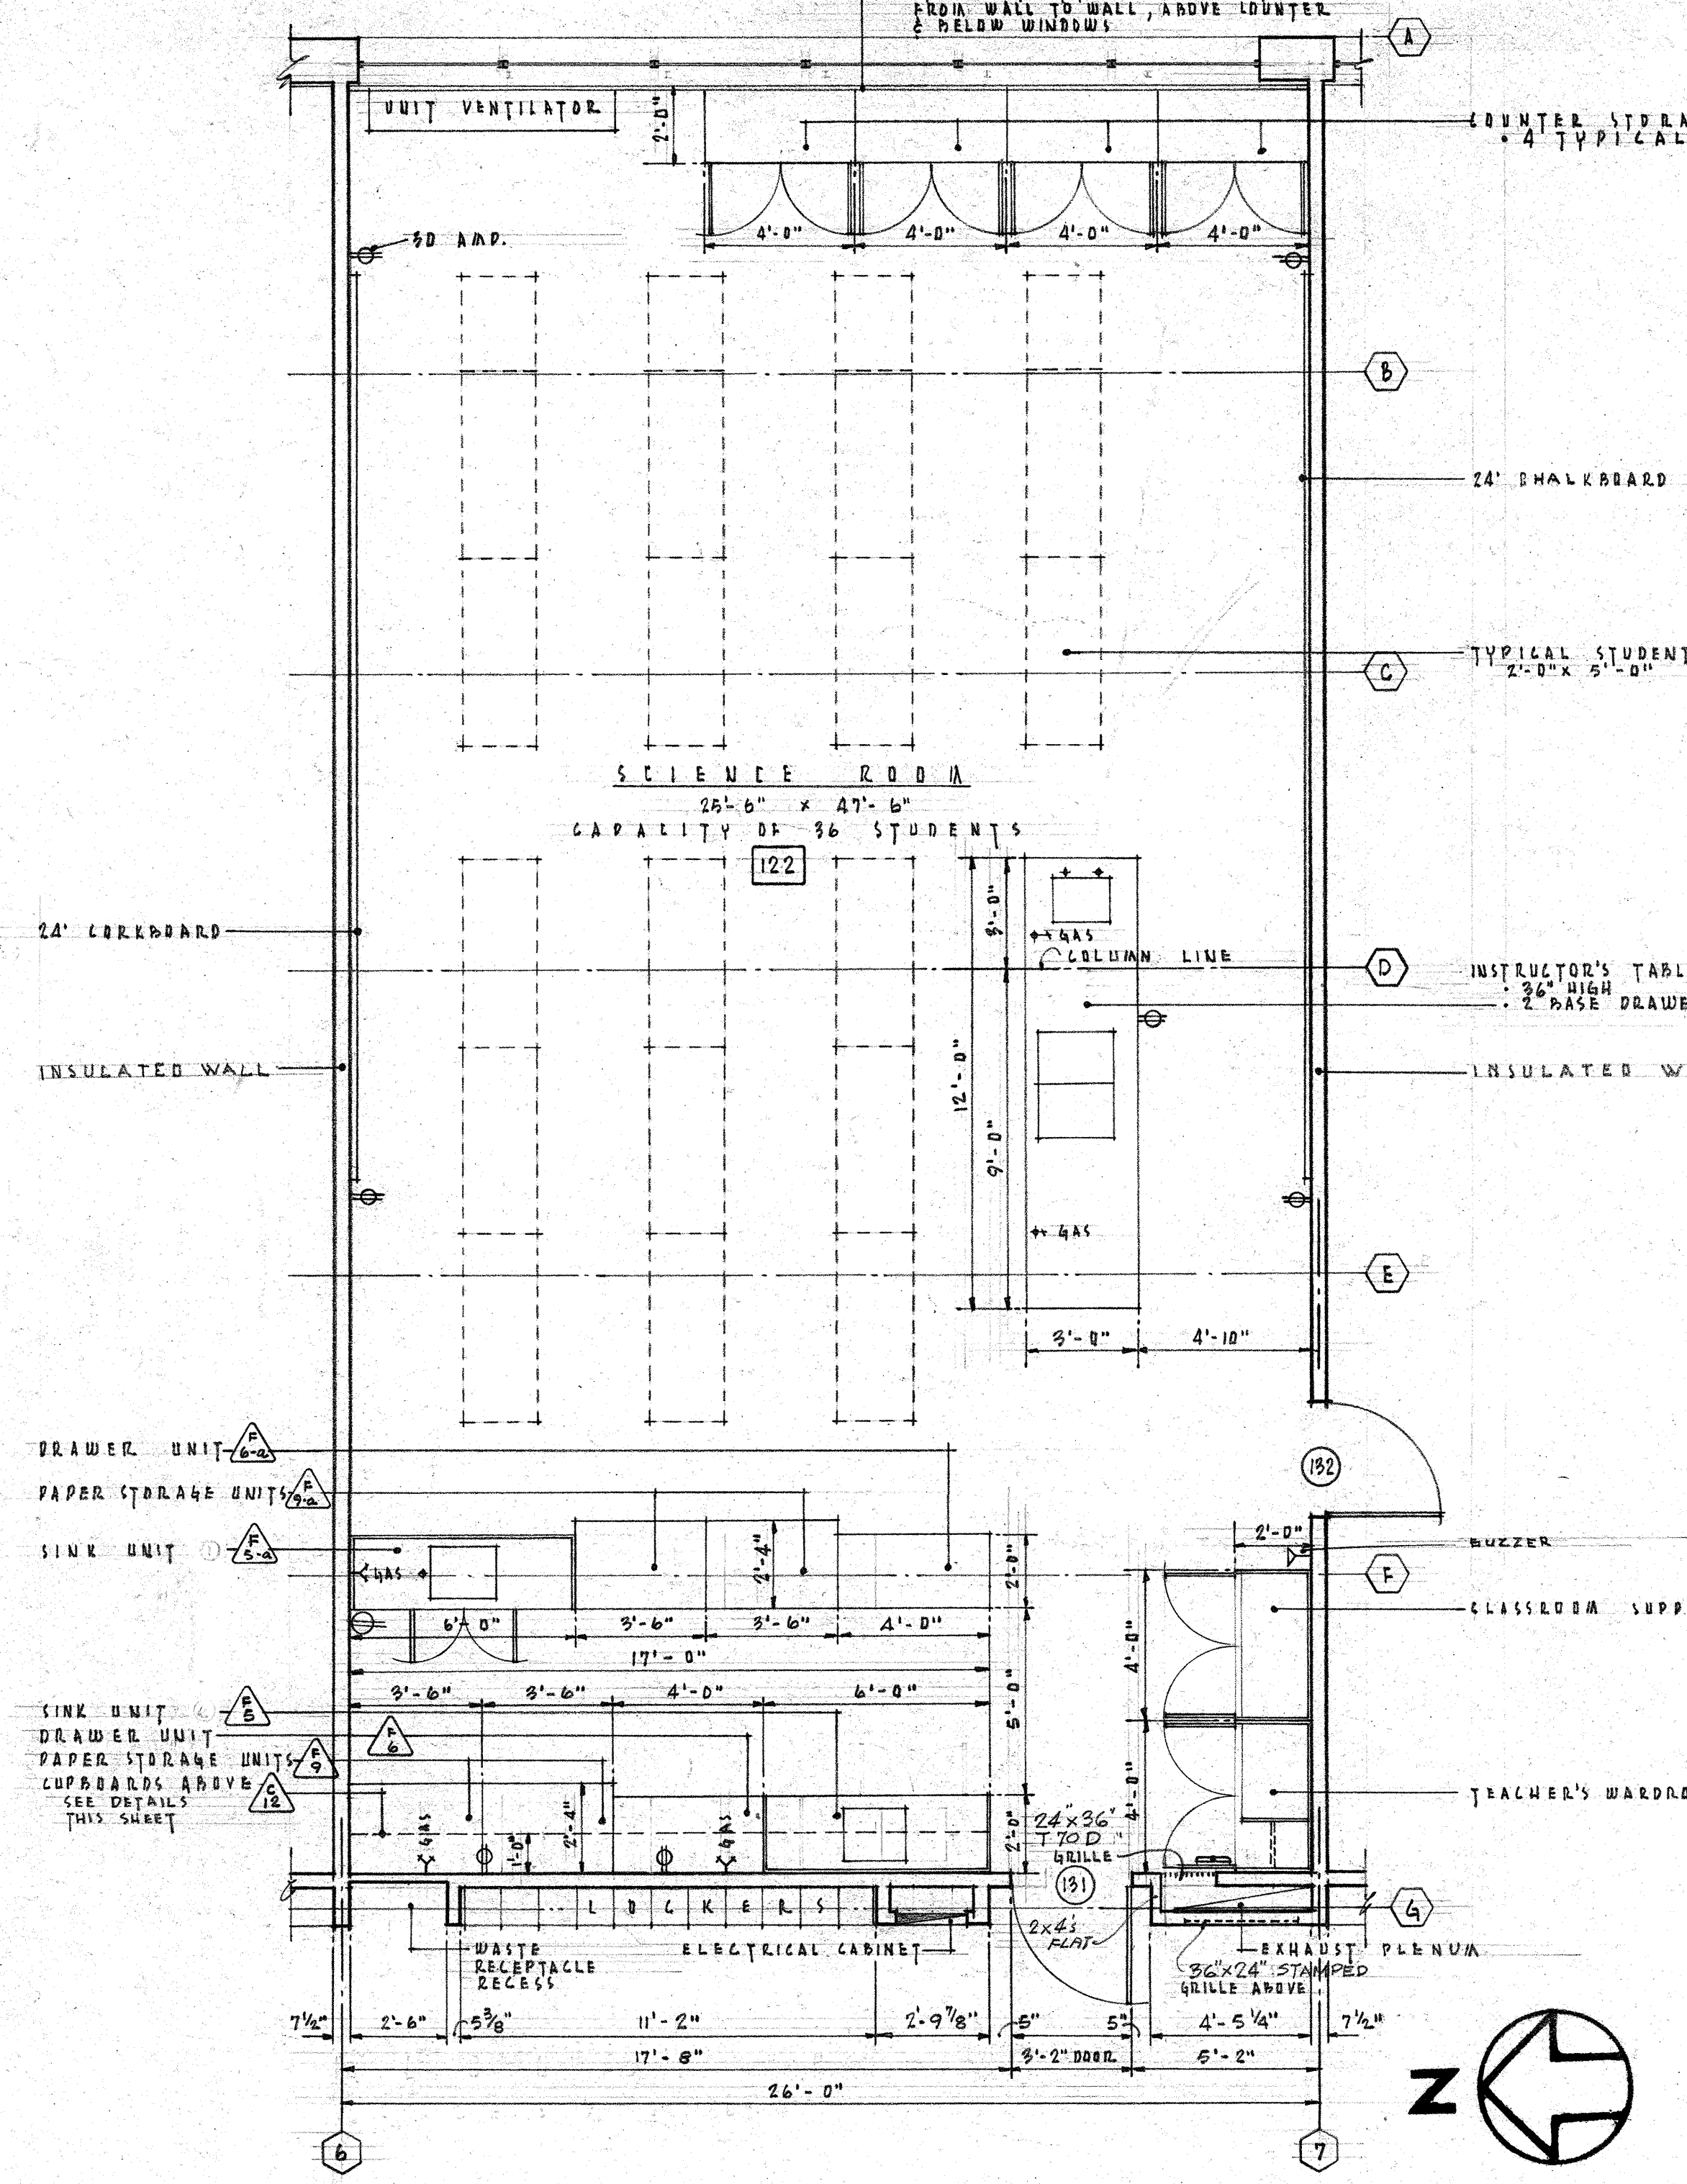

FLOOR PLAN

SCALE: 1/4" = 1'-0"

NOTE: ROOMS 103, 104, & 123 SIMILAR

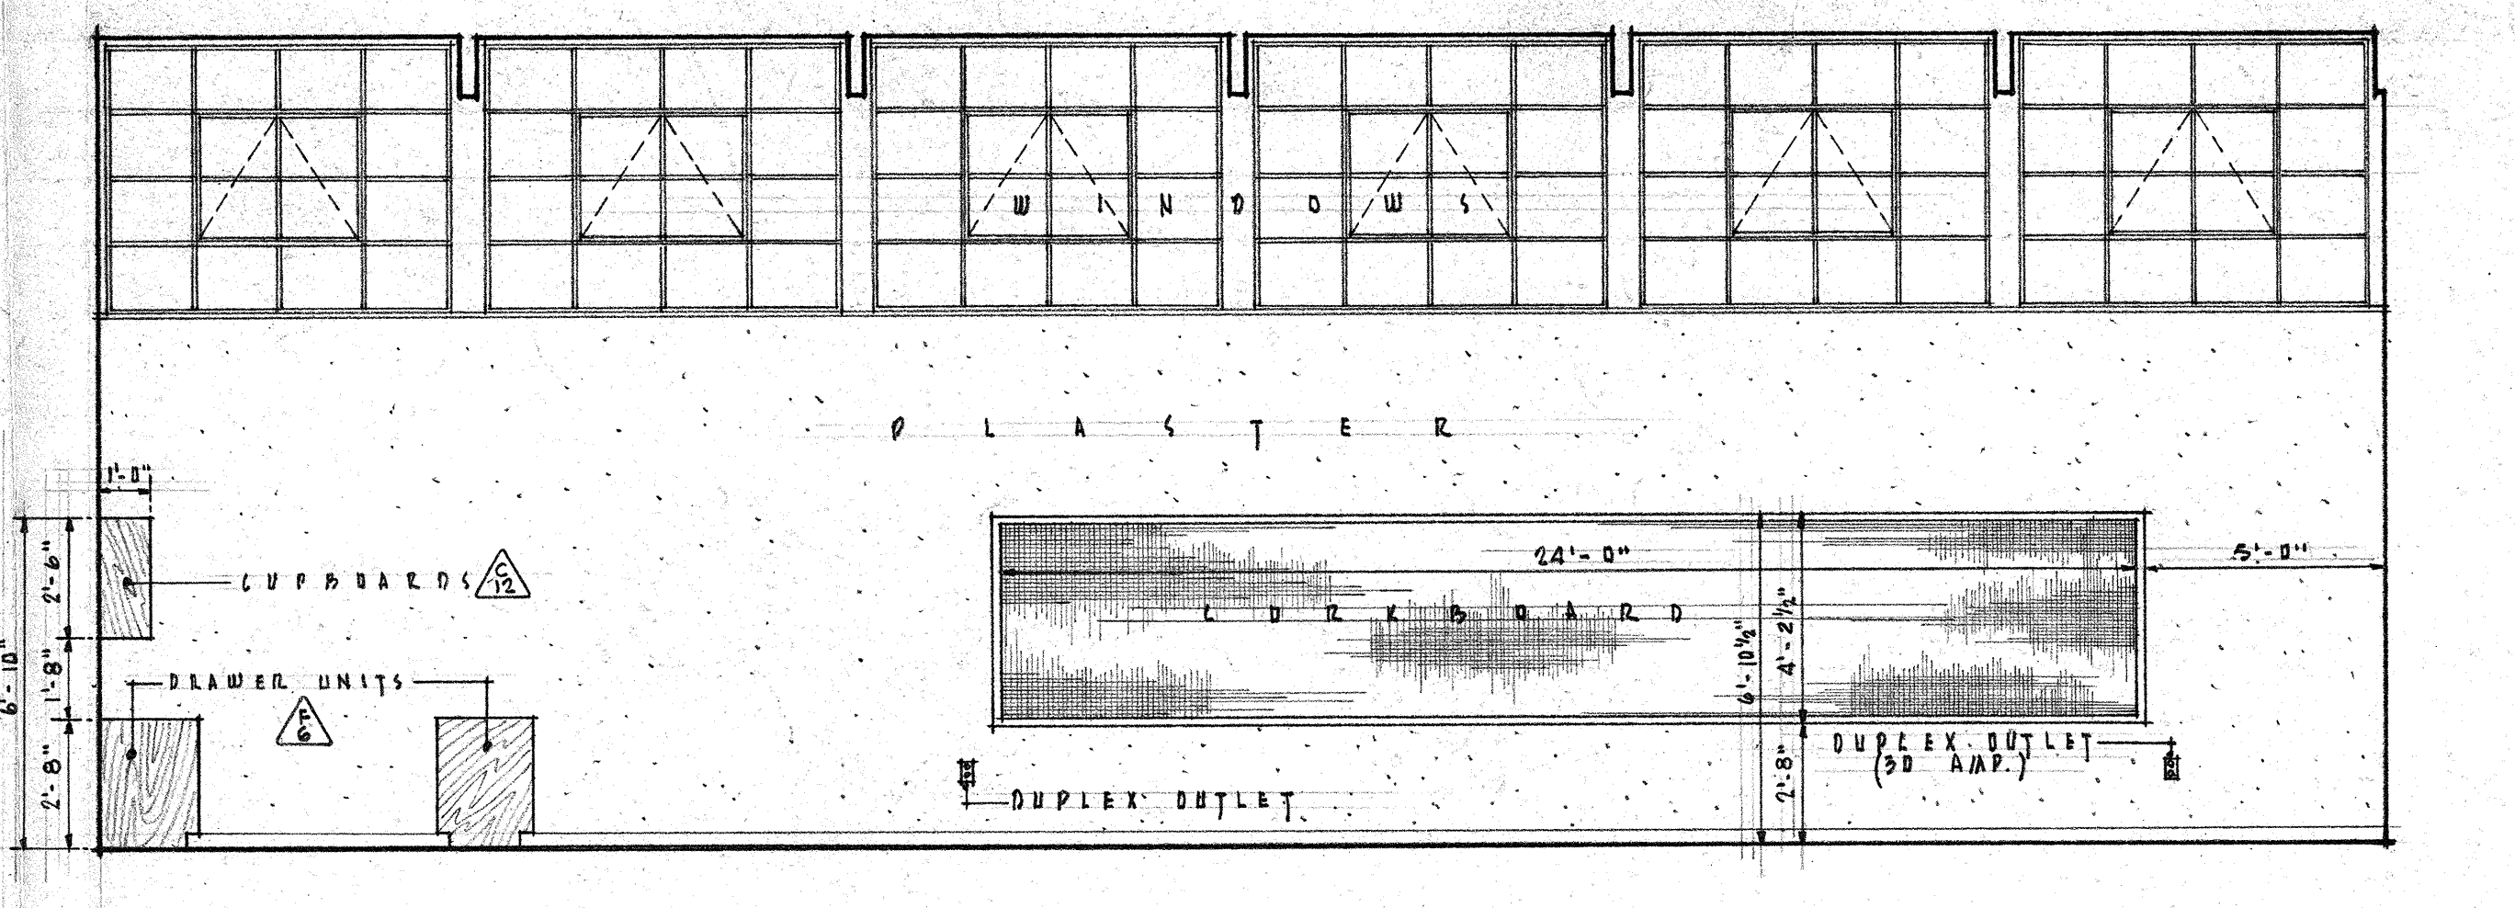

NORTH WALL

SCALE: 1/4" = 1'-0"

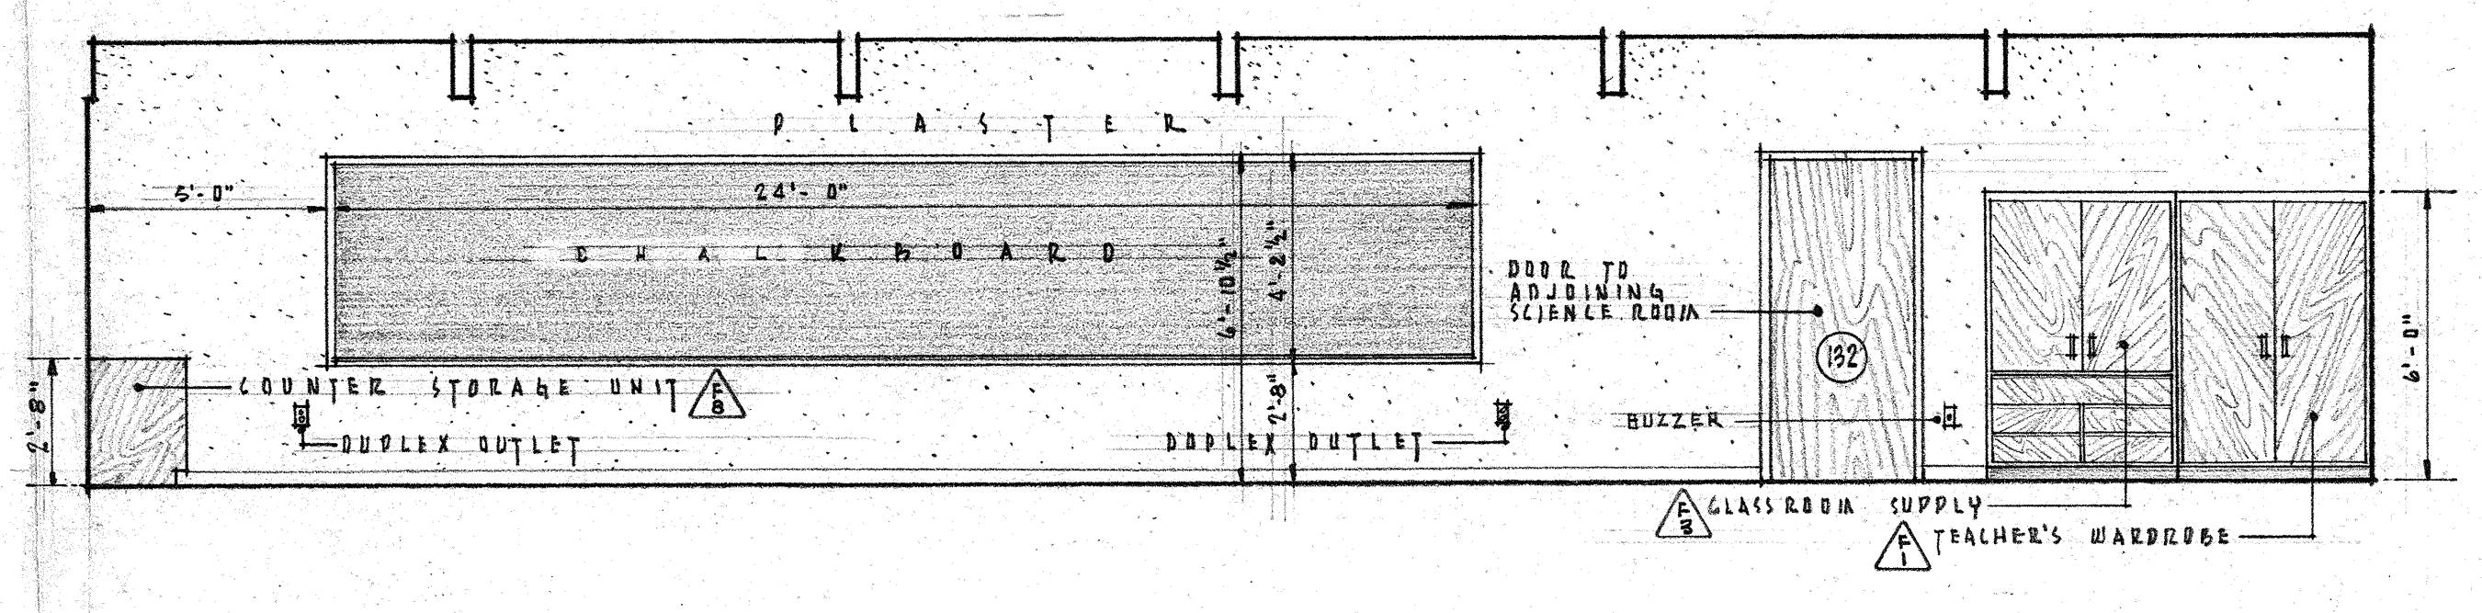

SOUTH WALL

SCALE: 1/4" = 1'-0"

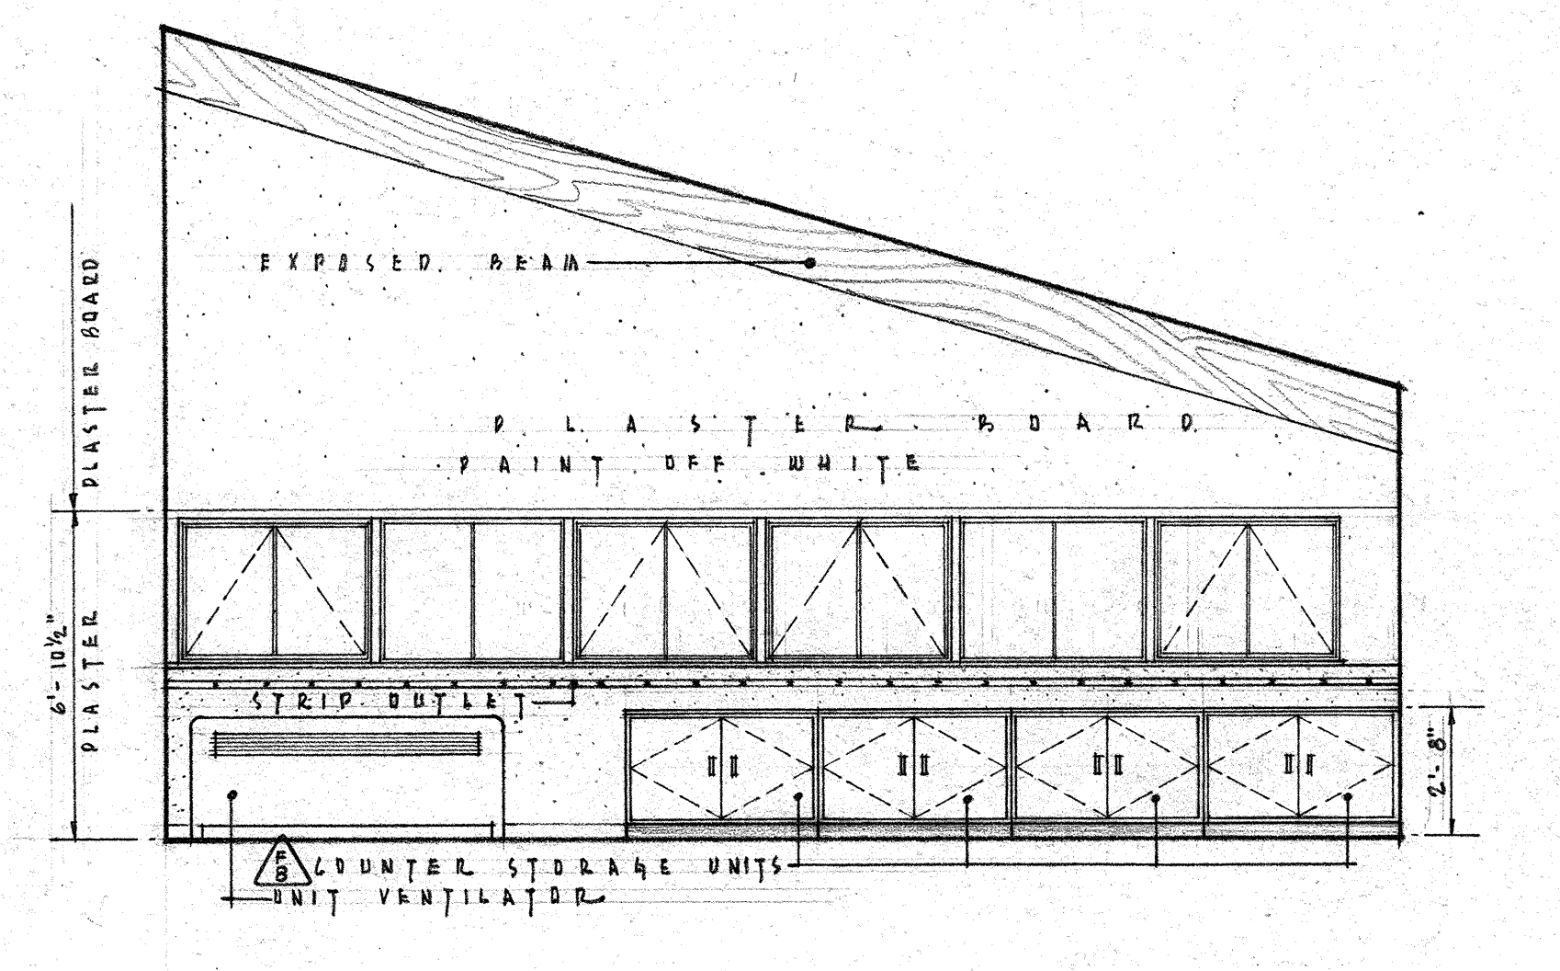

EAST WALL

SCALE: 1/4" = 1'-0"

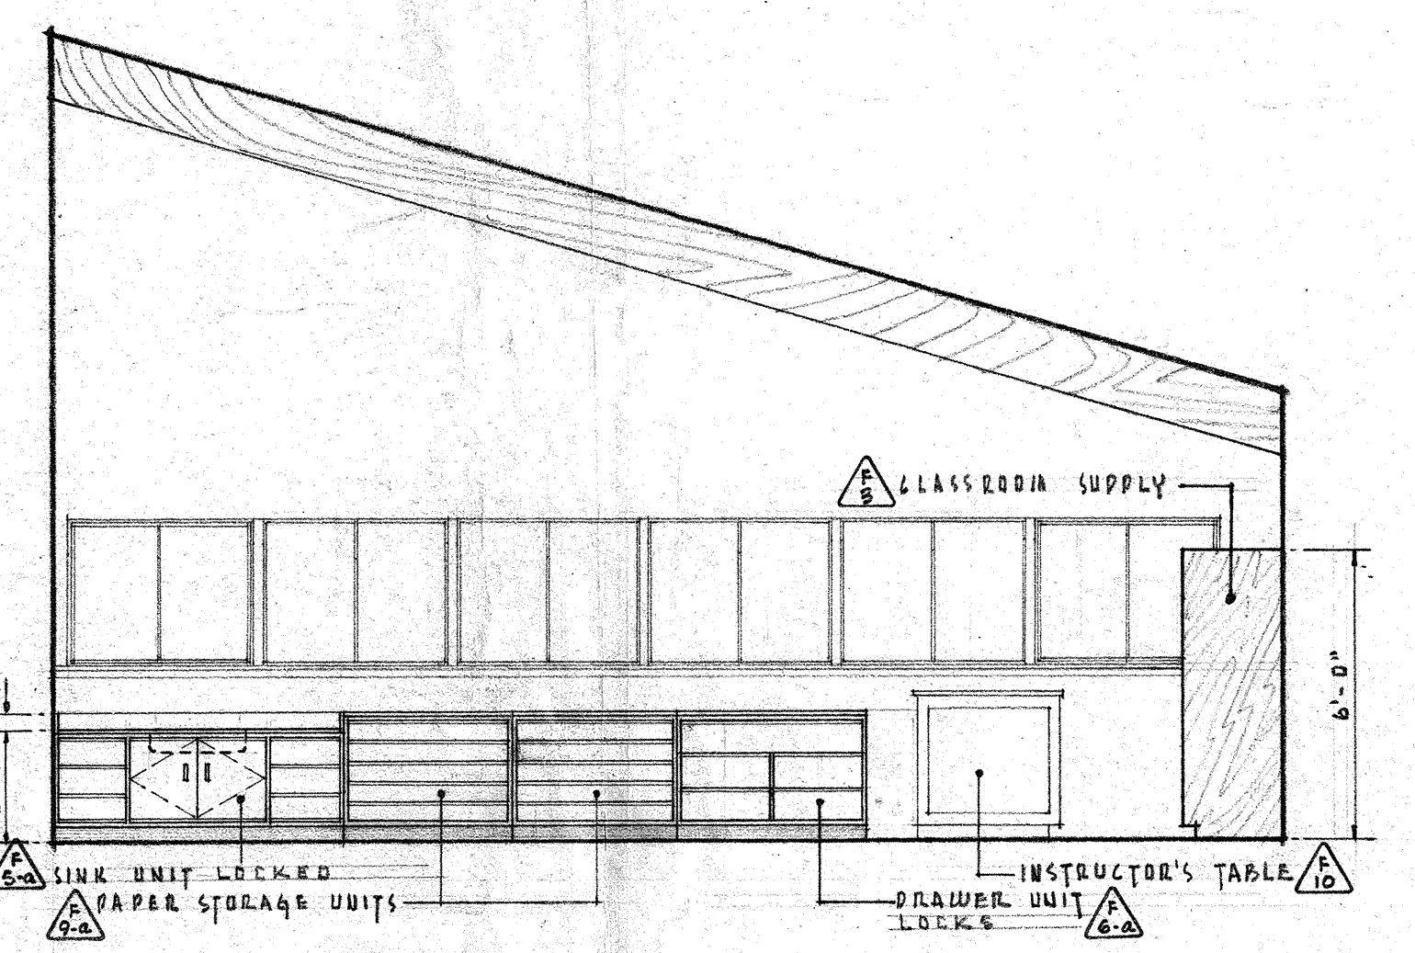

TYPICAL SECTION - EAST

SCALE: 1/4" = 1'-0"

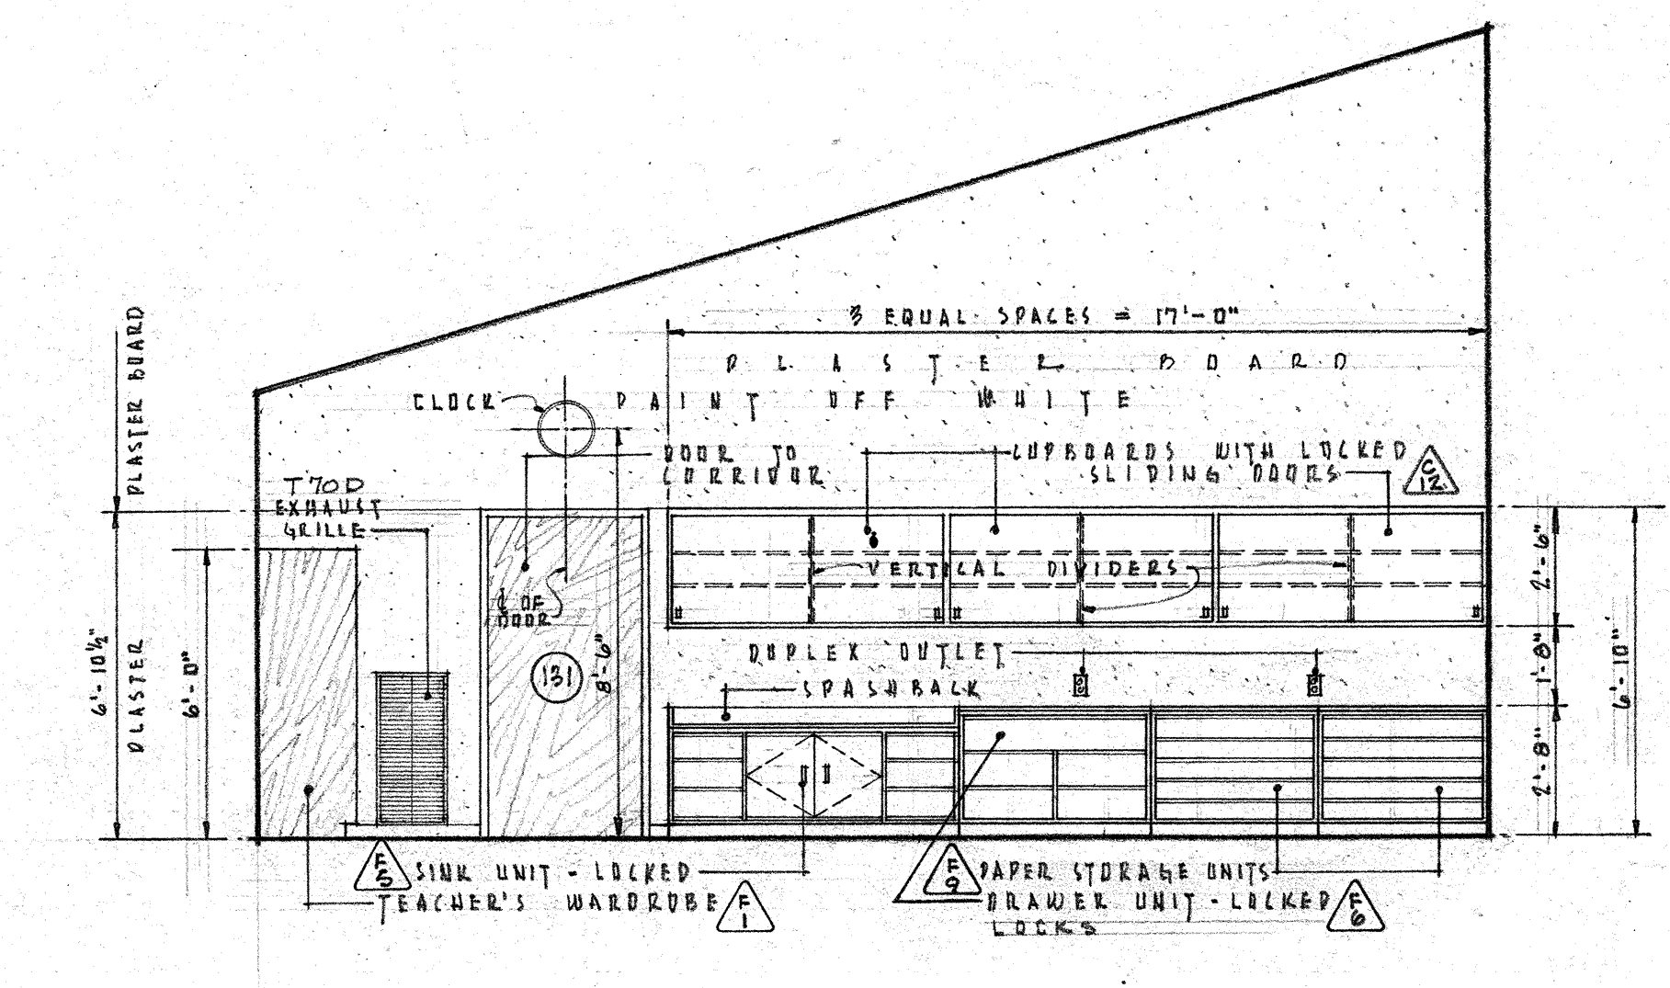

WEST WALL

SCALE: 1/4" = 1'-0"

TYPICAL SCIENCE ROOM

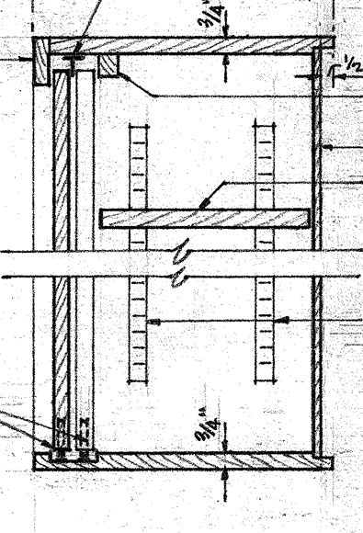
KNAPE & VOGT UPPER T GUIDE NO. 953
3/4" x 2" TRIM
3/4" x 3/4" HARDWOOD STOP
1/4" PLYWOOD BACK
3/4" ADJUSTABLE SHELF
KNAPE & VOGT ADJUSTABLE SHELF STDS & SUPPORTS
KNAPE & VOGT TRACK NO. 455 & SHEAVE NO. 402-A

SECTION "A-A"

SCALE: 1 1/2" = 1'-0"

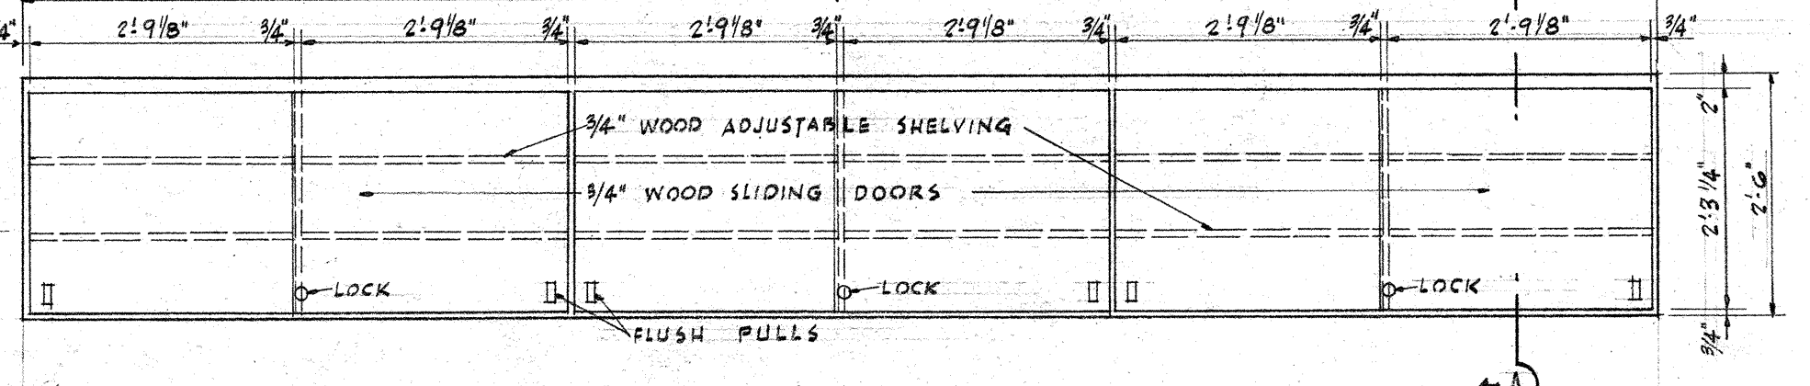

ELEVATION

SCALE: 1/2" = 1'-0"

WALL CUPBOARDS · SCIENCE ROOMS 103, 104, 122, & 123 C/12

4 REQUIRED

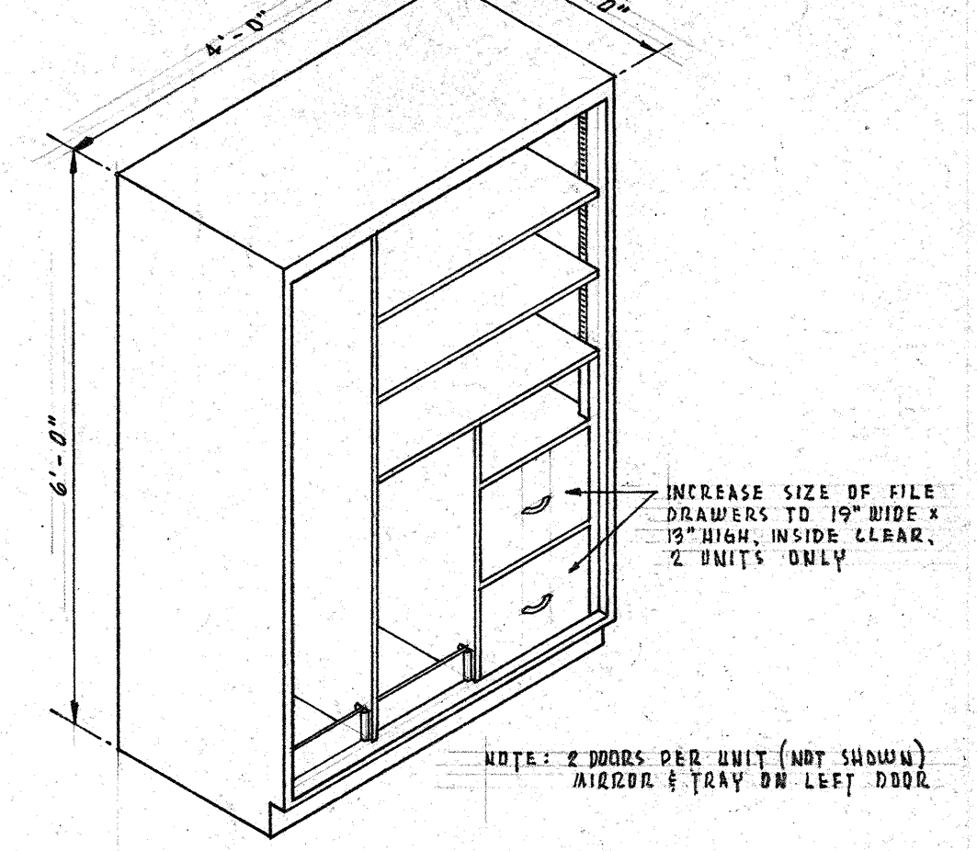
NOTE: 2 DOORS PER UNIT (NOT SHOWN) MIRROR & TRAY ON LEFT DOOR

TEACHERS WARDROBE UNIT

EDUCATORS NO. 8504

SCALE: 1/2" = 1'-0"

F/1 STOCK ARRANGEMENT - 13 REQUIRED

F/1-a STOCK WITH FINISHED BACK - 1 REQUIRED

F/1-b MODIFIED AS NOTED - 2 REQUIRED

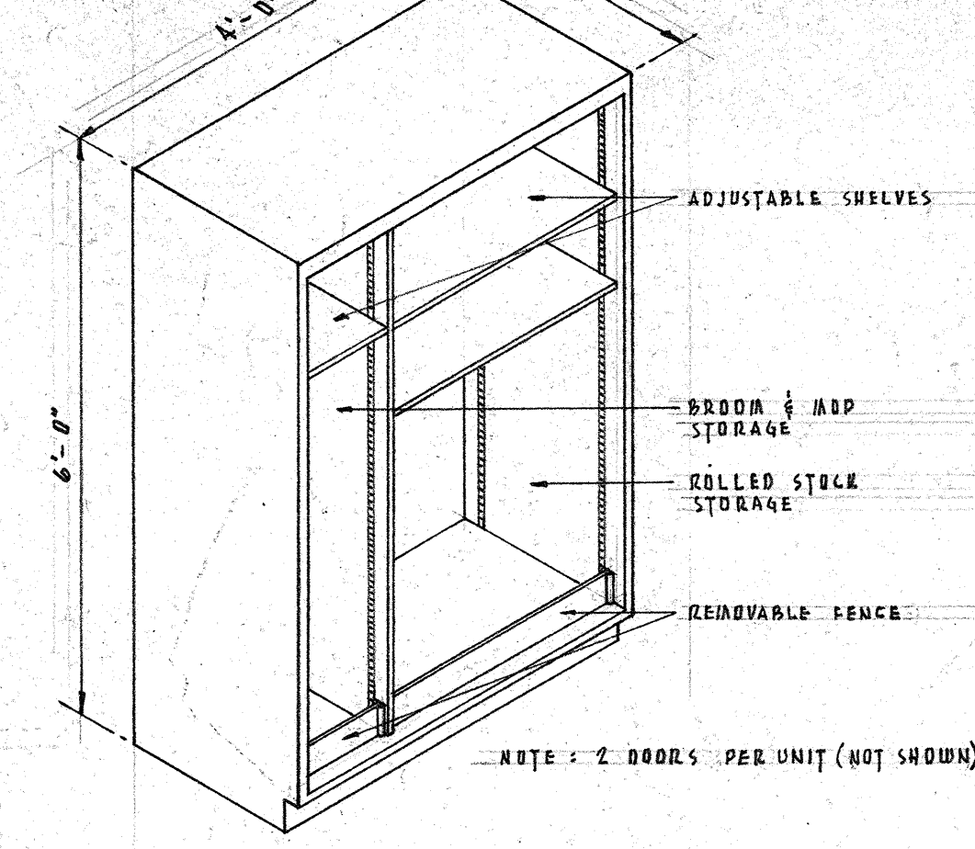

BROOM & ROLLED STOCK STORAGE

EDUCATORS NO. 8504 - MODIFIED

SCALE: 1/2" = 1'-0"

F/1-b MODIFIED AS SHOWN - 2 REQUIRED (ART ROOMS)

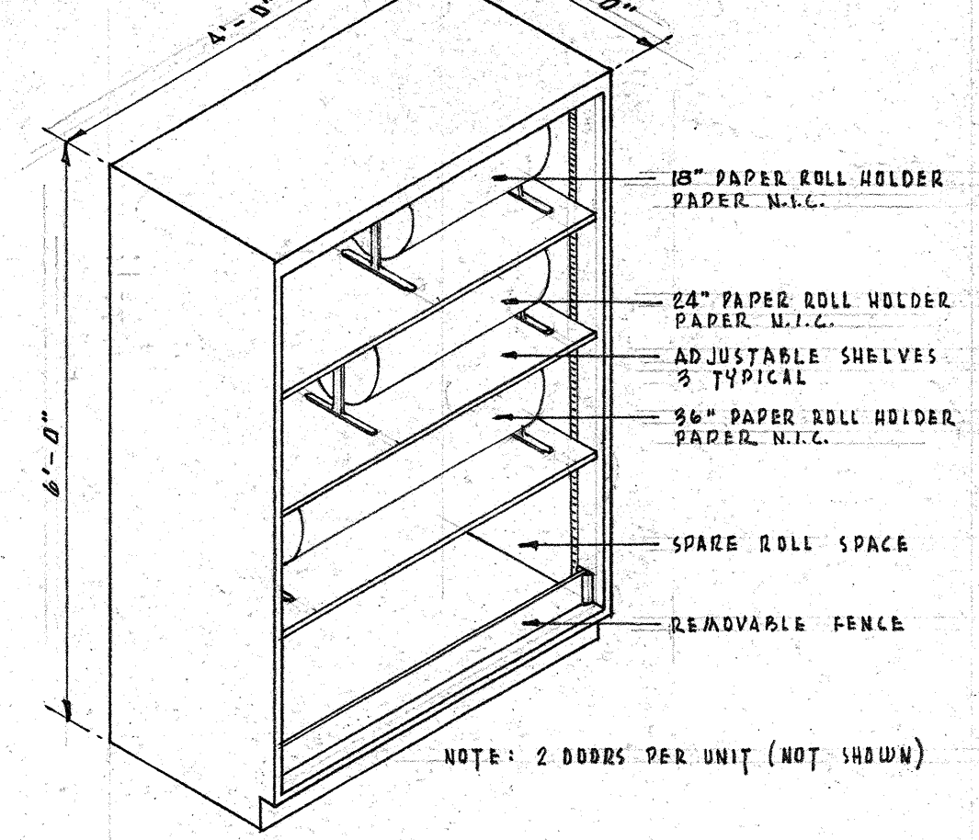

WRAPPING PAPER STORAGE

EDUCATORS NO. 8504 - MODIFIED

SCALE: 1/2" = 1'-0"

F/1-b MODIFIED AS SHOWN - 2 REQUIRED (ART ROOMS)

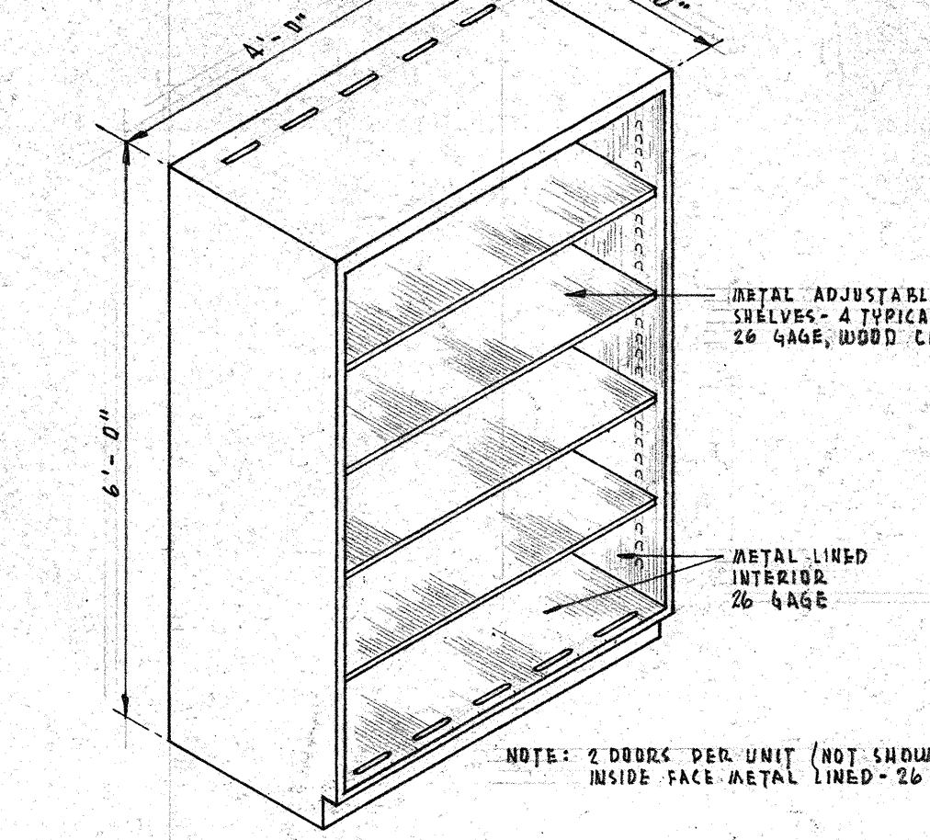
INTERIOR 26 GAGE
NOTE: 2 DOORS PER UNIT (NOT SHOWN) INSIDE FACE METAL LINED - 26 GAGE

METAL LINED CABINET

EDUCATORS NO. 8505 - MODIFIED

SCALE: 1/2" = 1'-0"

F/2-b MODIFIED AS SHOWN - 2 REQUIRED (ART ROOMS)

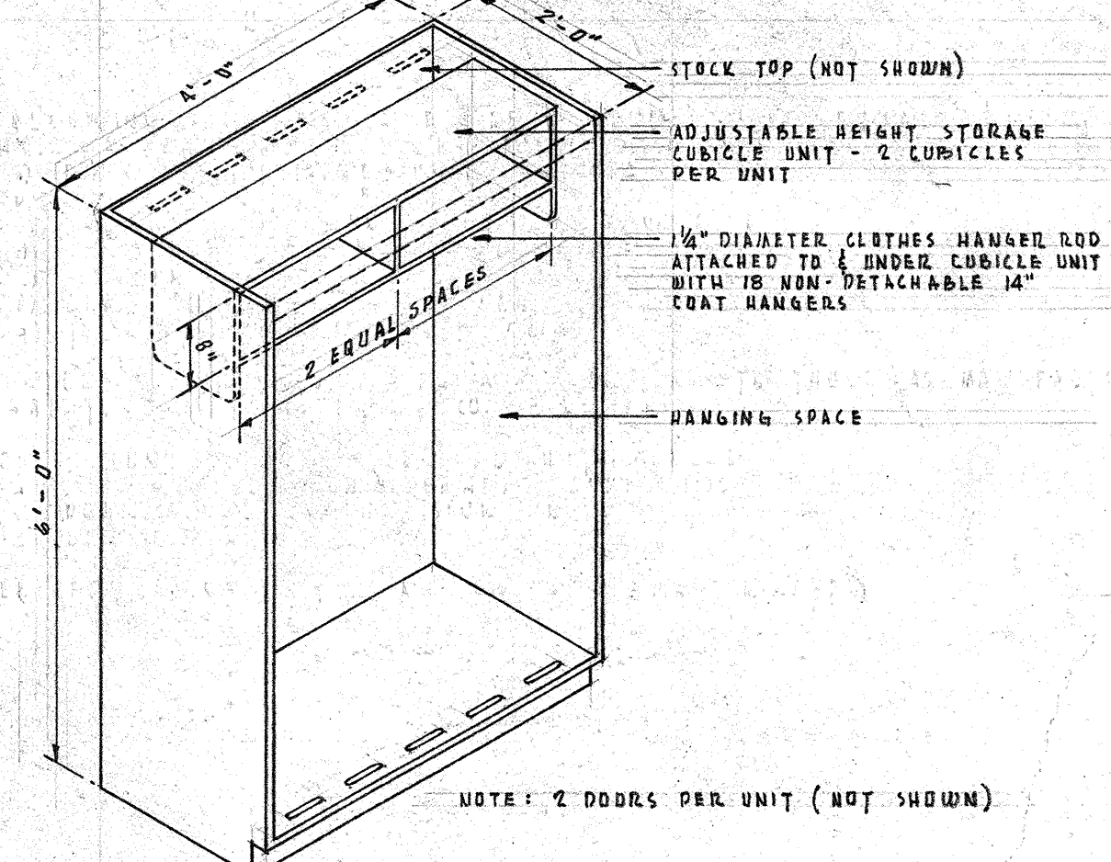

HANGING SPACE UNIT

EDUCATORS NO. 8505 - MODIFIED

SCALE: 1/2" = 1'-0"

F/2-c MODIFIED AS SHOWN WITH FINISHED BACK - 2 REQUIRED (CLOTHING LAB.)

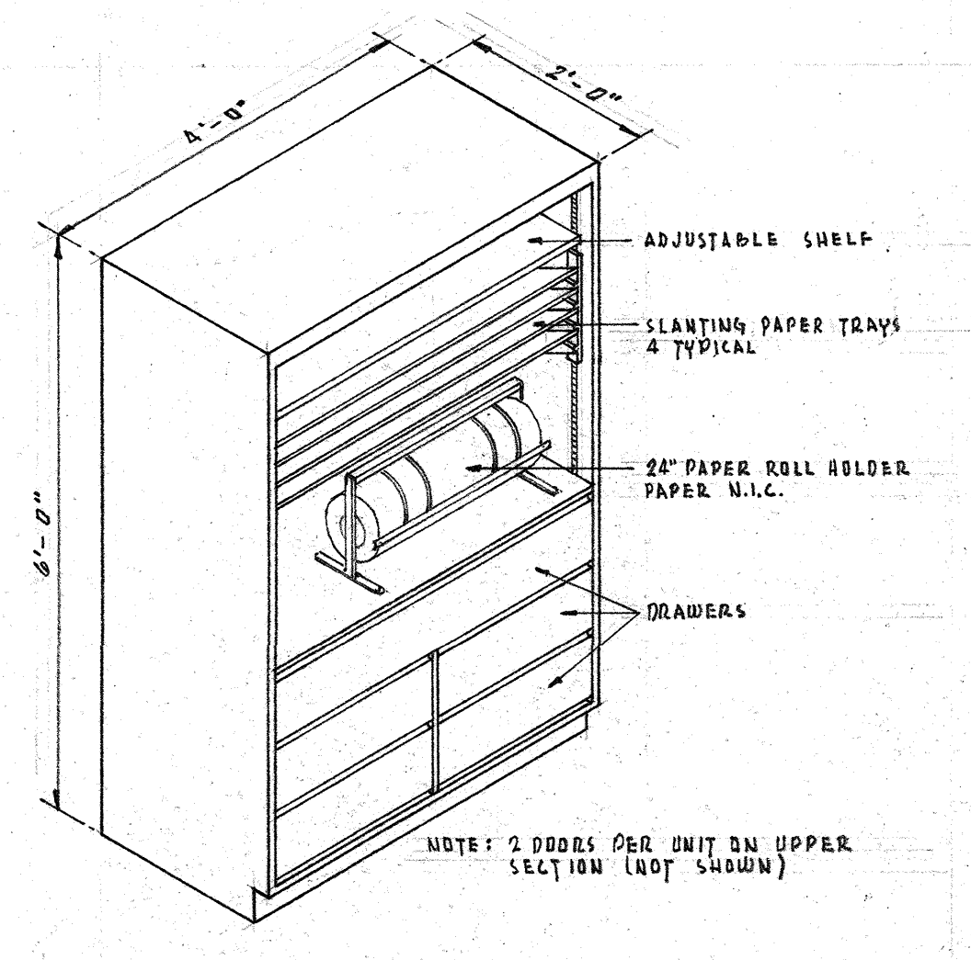

CLASSROOM SUPPLY UNIT

EDUCATORS NO. 8506-T

SCALE: 1/2" = 1'-0"

F/3 STOCK ARRANGEMENT - 7 REQUIRED

F/3-a STOCK WITH FINISHED BACK - 1 REQUIRED

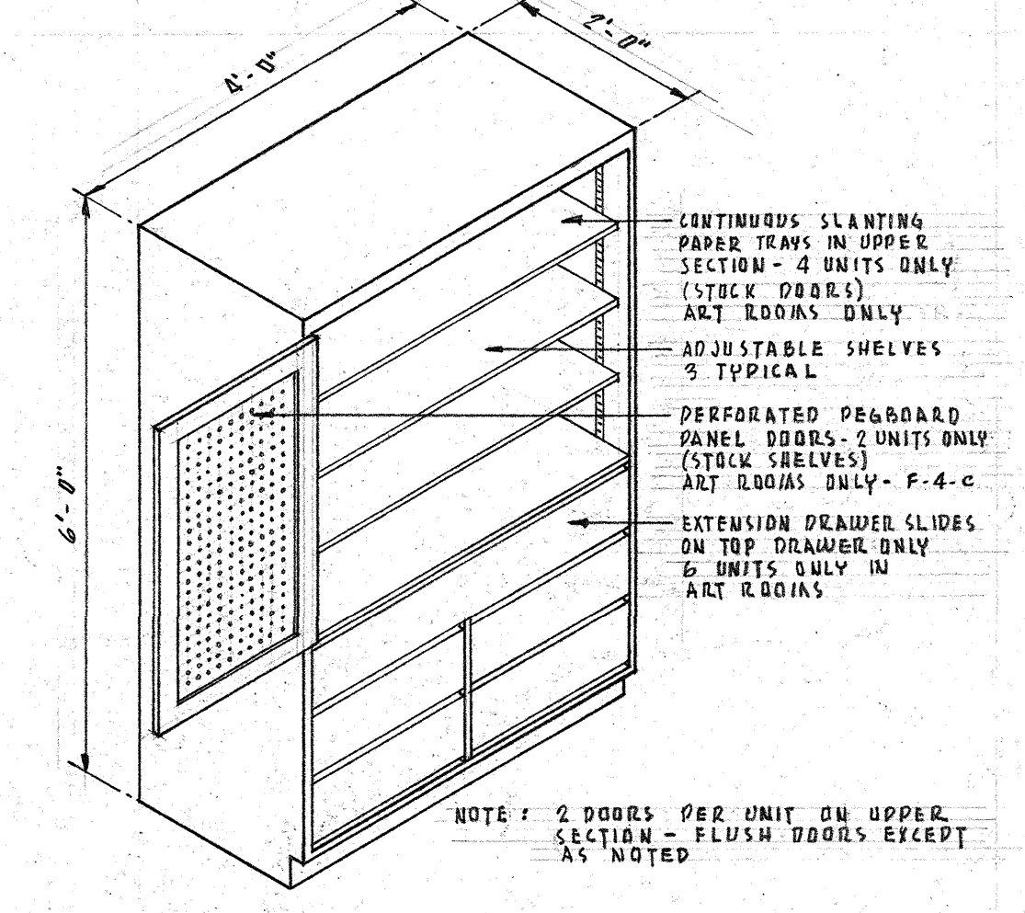
4'-0"
2'-0"
CONTINUOUS SLANTING
NOTE: 2 DOORS PER UNIT ON UPPER SECTION - FLUSH DOORS EXCEPT AS NOTED

CLASSROOM SUPPLY UNIT

EDUCATORS NO. 8506-S

SCALE: 1/2" = 1'-0"

F/4 STOCK ARRANGEMENT - 8 REQUIRED - 4 WITH LOCKS ON DOORS & DRAWERS

F/4-a STOCK WITH FINISHED BACK - 1 REQUIRED

F/4-b MODIFIED AS NOTED - 4 REQUIRED

F/4-c MODIFIED AS NOTED WITH FINISHED BACK - 2 REQUIRED

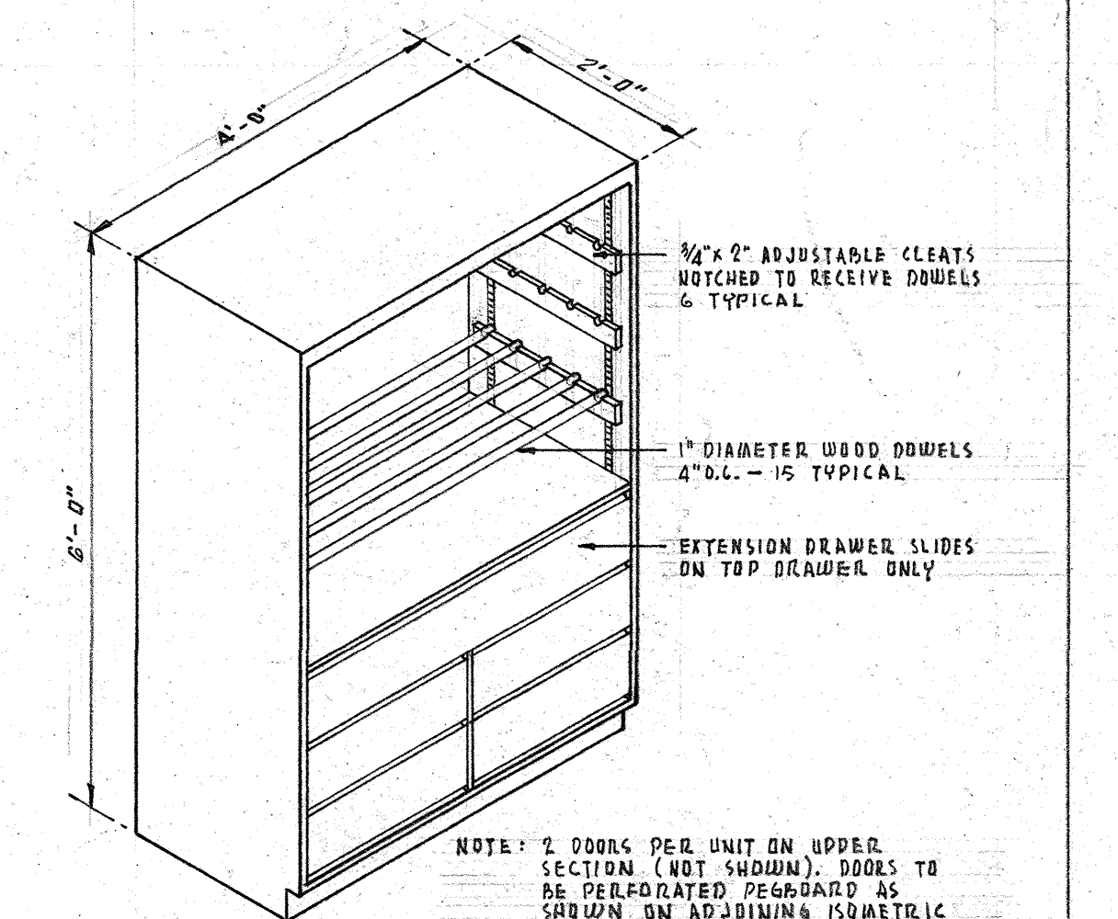
4'-0"
2'-0"
3/4" x 2" ADJUSTABLE CLEATS
NOTE: 2 DOORS PER UNIT ON UPPER SECTION (NOT SHOWN). DOORS TO BE PERFORATED PEGBOARD AS SHOWN ON ADJOINING ISOMETRIC

DRYING RACK UNIT

EDUCATORS NO. 8506-S - MODIFIED

SCALE: 1/2" = 1'-0"

F/4-c MODIFIED AS SHOWN WITH FINISHED BACK - 2 REQUIRED (ART ROOM)

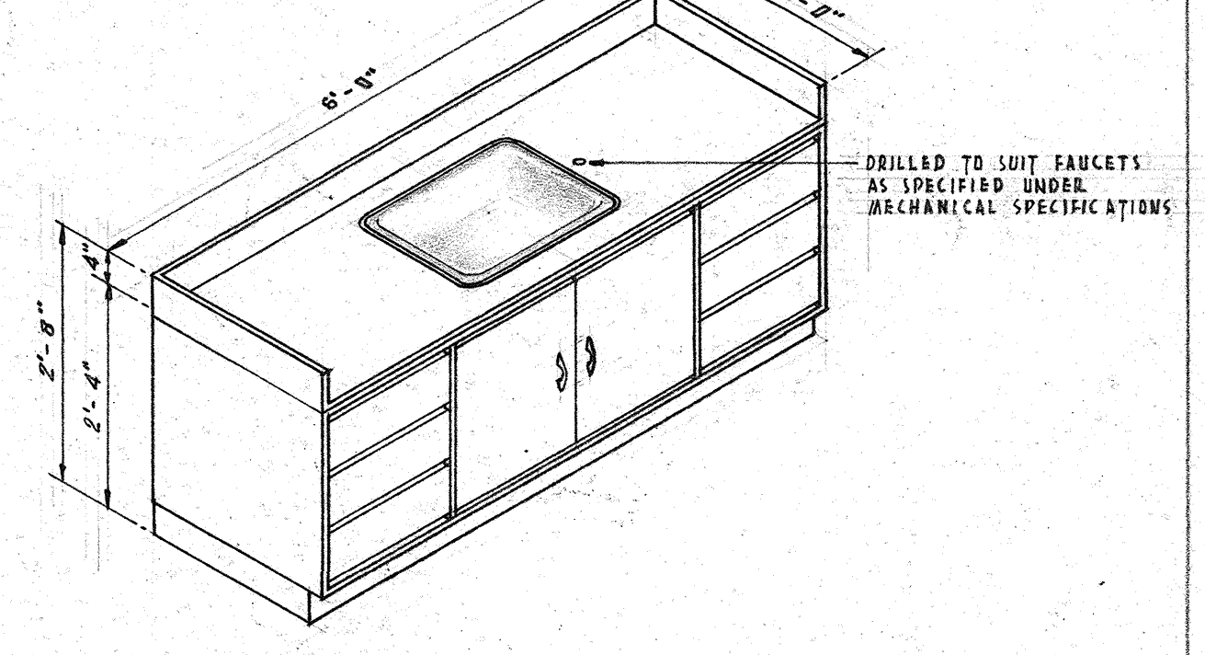

SINK UNIT

EDUCATORS NO. 8507

SCALE: 1/2" = 1'-0"

F/5 STOCK ARRANGEMENT - 8 REQUIRED - 4 LOCKED DOORS ONLY

F/5-a STOCK WITH FINISHED BACK - 4 REQUIRED - 4 LOCKED DOORS ONLY

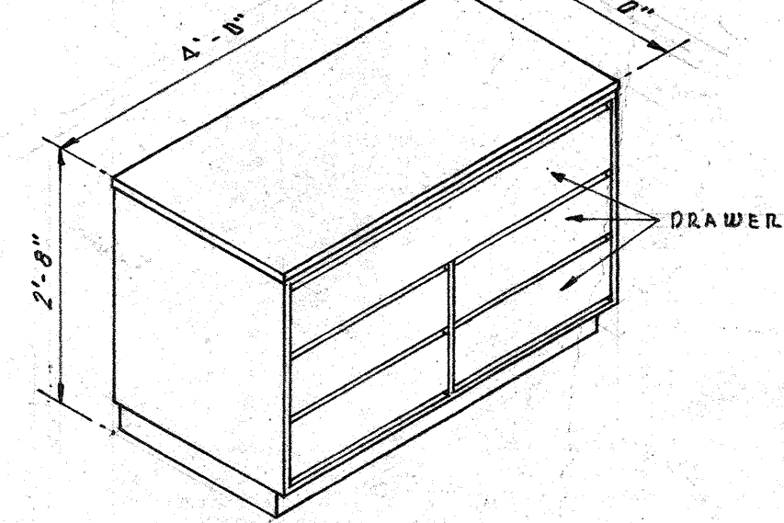

DRAWER UNIT

EDUCATORS NO. 8508

SCALE: 1/2" = 1'-0"

F/6 STOCK ARRANGEMENT - 6 REQUIRED - 4 WITH LOCKS

F/6-a STOCK WITH FINISHED BACK - 4 REQUIRED - 4 WITH LOCKS

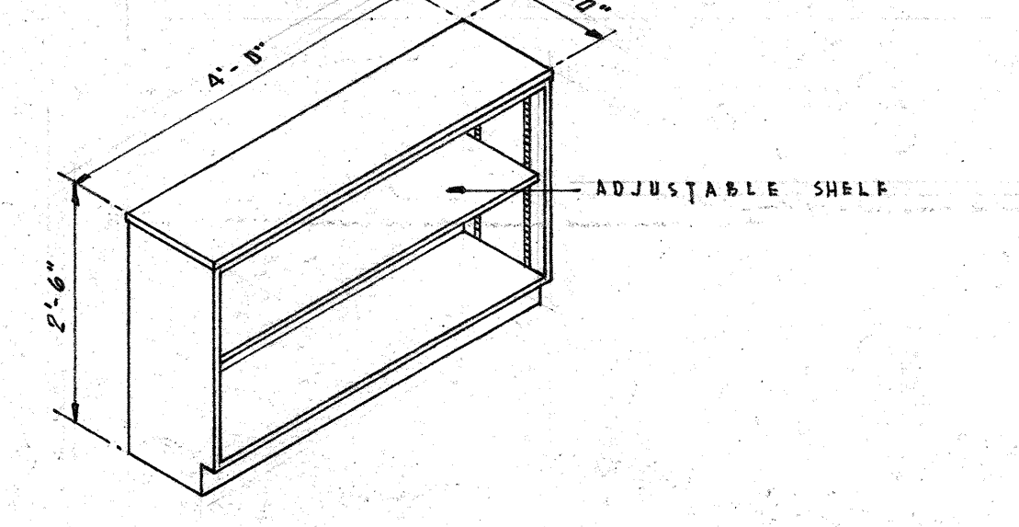

BOOK SHELF UNIT

EDUCATORS NO. 8611

SCALE: 1/2" = 1'-0"

F/7 STOCK ARRANGEMENT - 10 REQUIRED

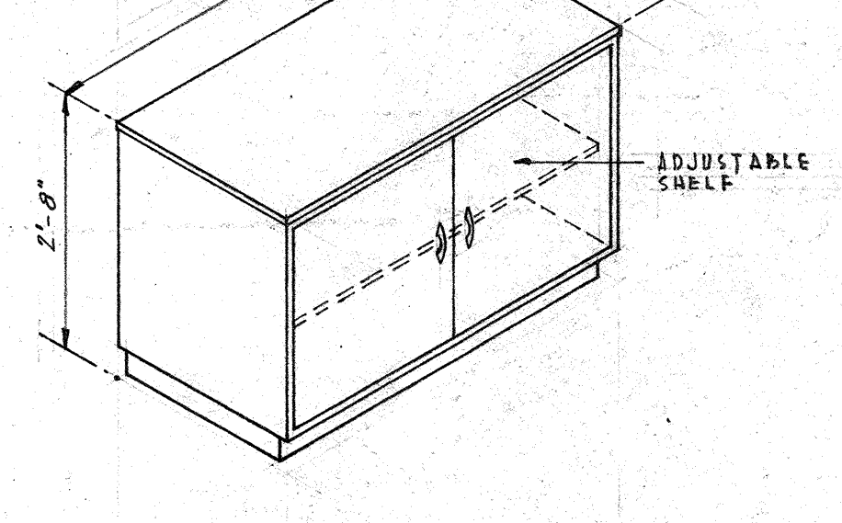

COUNTER STORAGE UNIT

EDUCATORS NO. 8614

SCALE: 1/2" = 1'-0"

F/8 STOCK ARRANGEMENT - 23 REQUIRED

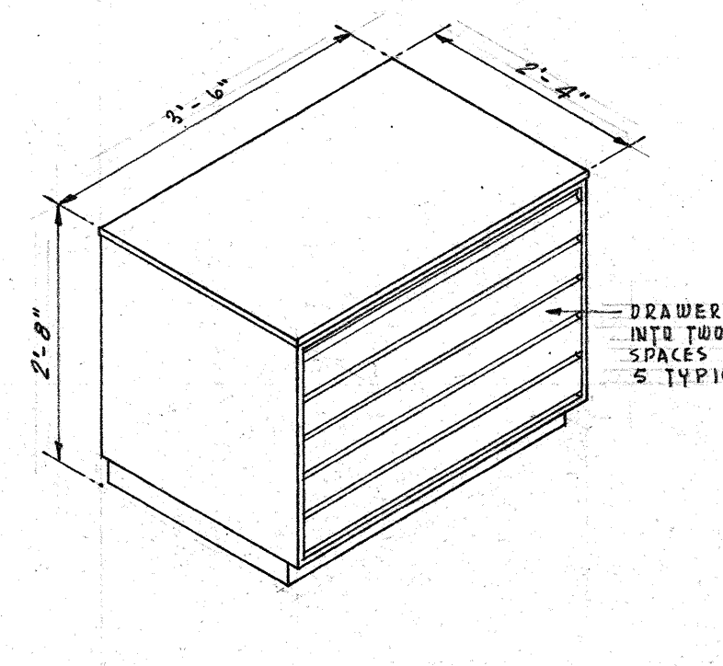

PAPER STORAGE UNIT

EDUCATORS NO. 8515

SCALE: 1/2" = 1'-0"

F/9 STOCK ARRANGEMENT - 9 REQUIRED

F/9-a STOCK WITH FINISHED BACK - 8 REQUIRED

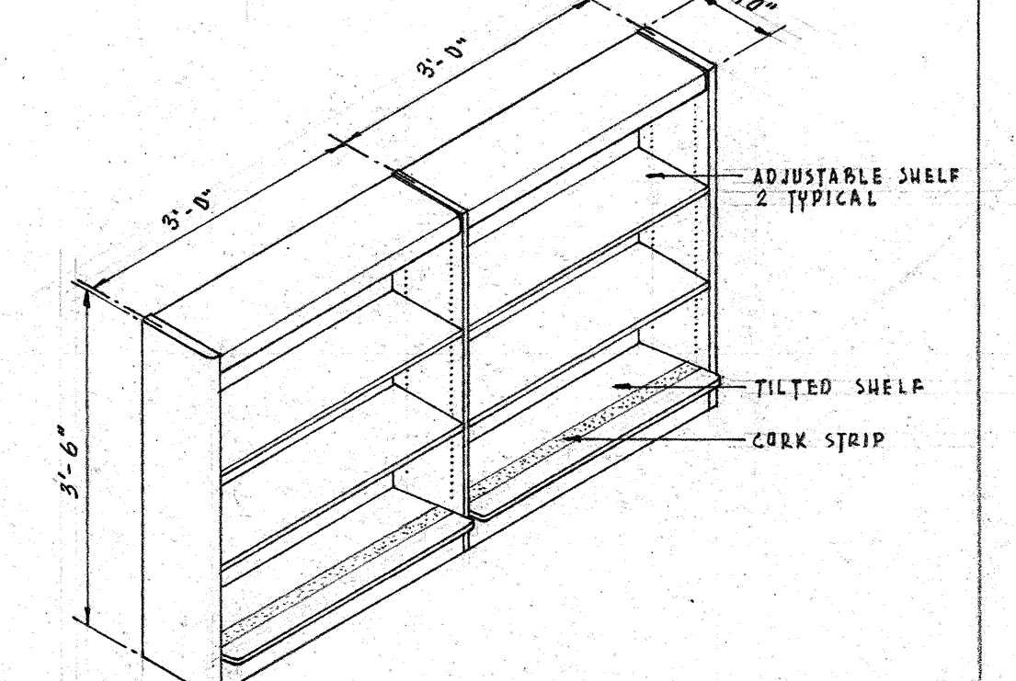

COUNTER-HEIGHT SHELVING

REMINGTON RAND "TREND" NO. 7721.1

SCALE: 1/2" = 1'-0"

F/14 STOCK ARRANGEMENT - 8 - 3' SECTIONS REQUIRED

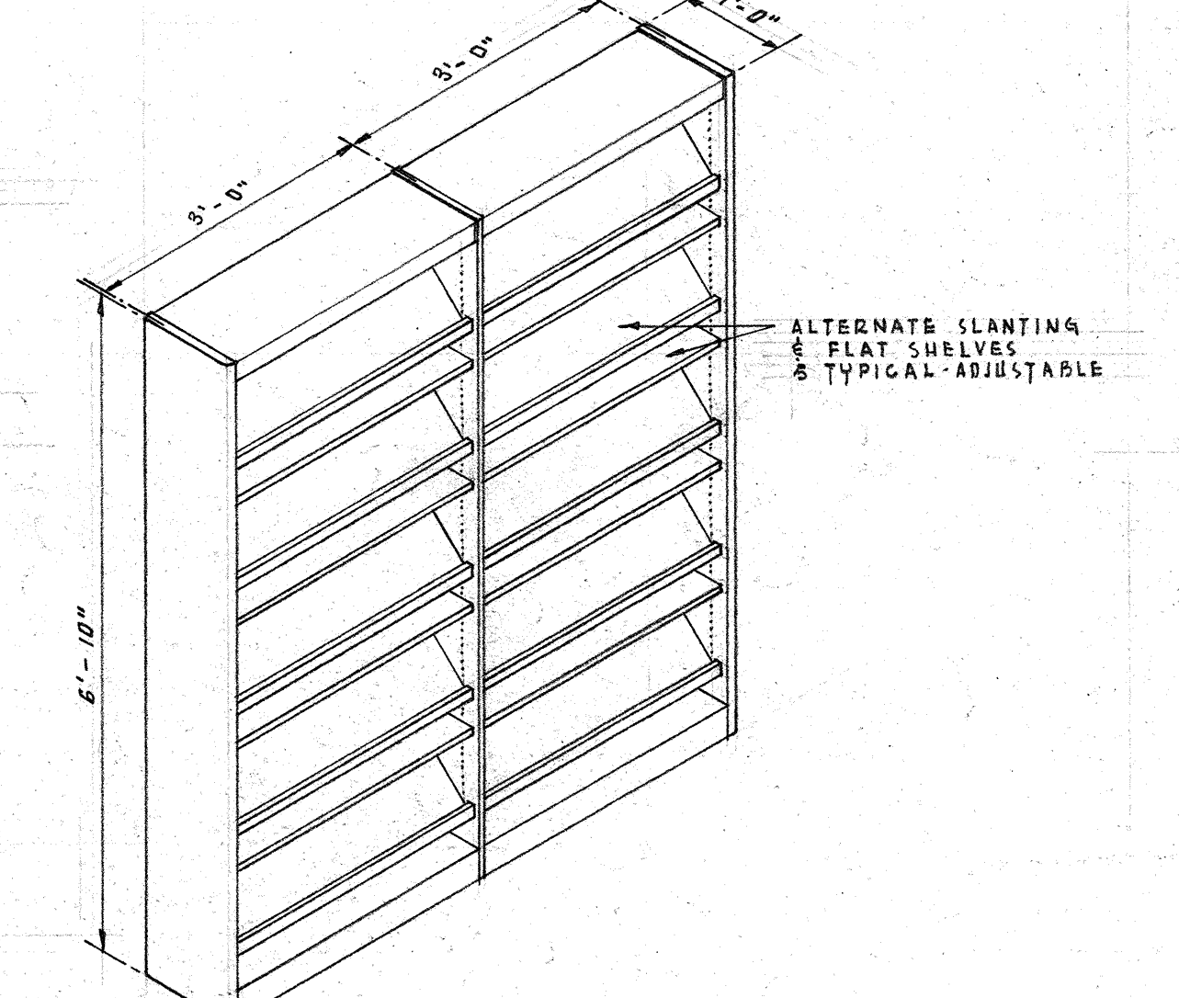

WALL MAGAZINE SHELVING

REMINGTON RAND NO. 7734

SCALE: 1/2" = 1'-0"

F/16 STOCK ARRANGEMENT - 2 - 3' SECTIONS REQUIRED

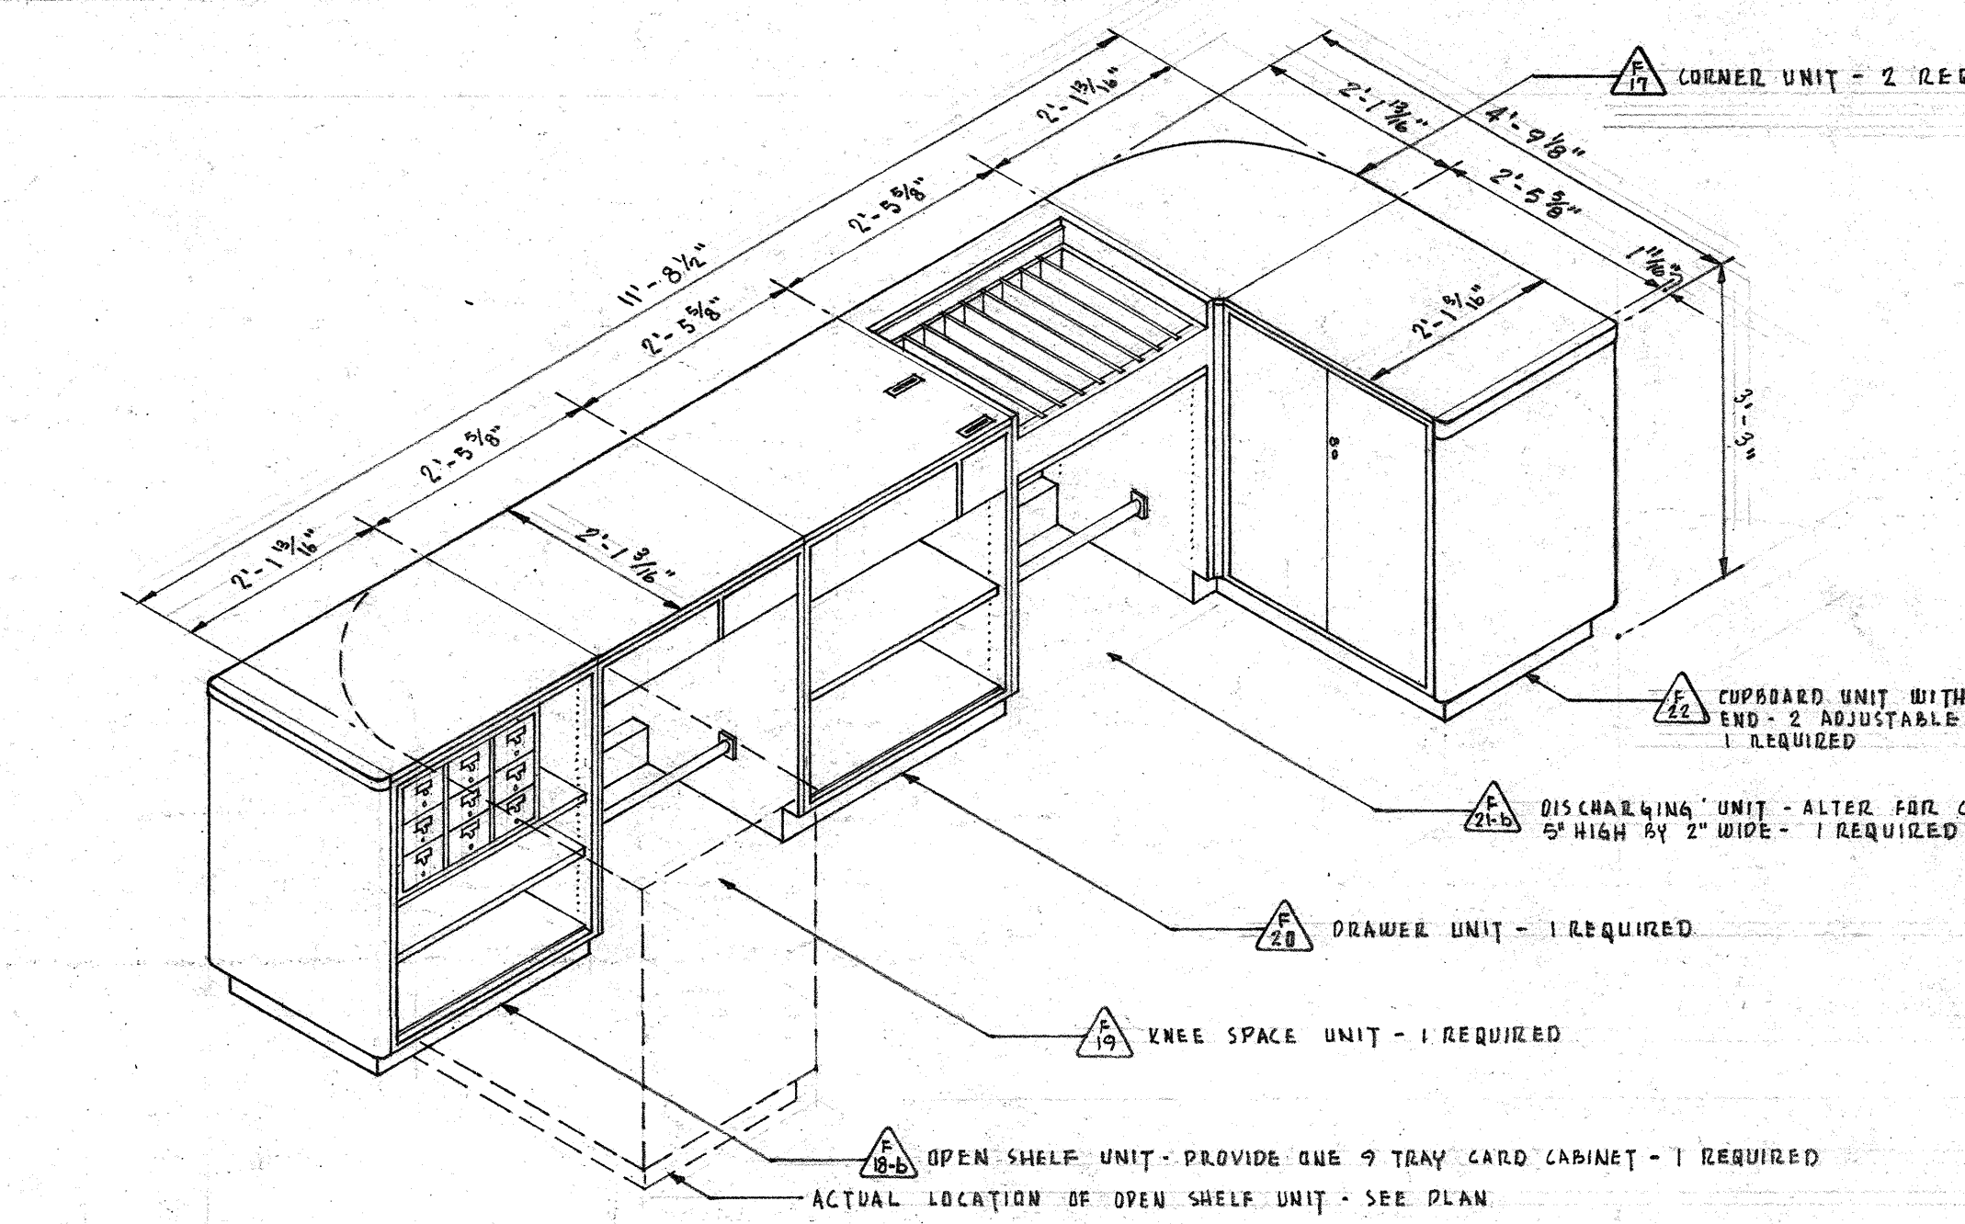
CORNER UNIT - 2 REQUIRED F/17
CUPBOARD UNIT WITH REMOVABLE END - 2 ADJUSTABLE SHELVES 1 REQUIRED F/22
DISCHARGING UNIT - ALTER FOR CARDS 5" HIGH BY 2" WIDE - 1 REQUIRED F/21-b
DRAWER UNIT - 1 REQUIRED F/20
KNEE SPACE UNIT - 1 REQUIRED F/19
OPEN SHELF UNIT - PROVIDE ONE 9 TRAY CARD CABINET - 1 REQUIRED F/18-b
ACTUAL LOCATION OF OPEN SHELF UNIT - SEE PLAN
11'-8 1/2"
4'-9 1/8"

LIBRARY CONTROL DESK

REMINGTON RAND NO. 7440 SERIES

SCALE: 1/2" = 1'-0"

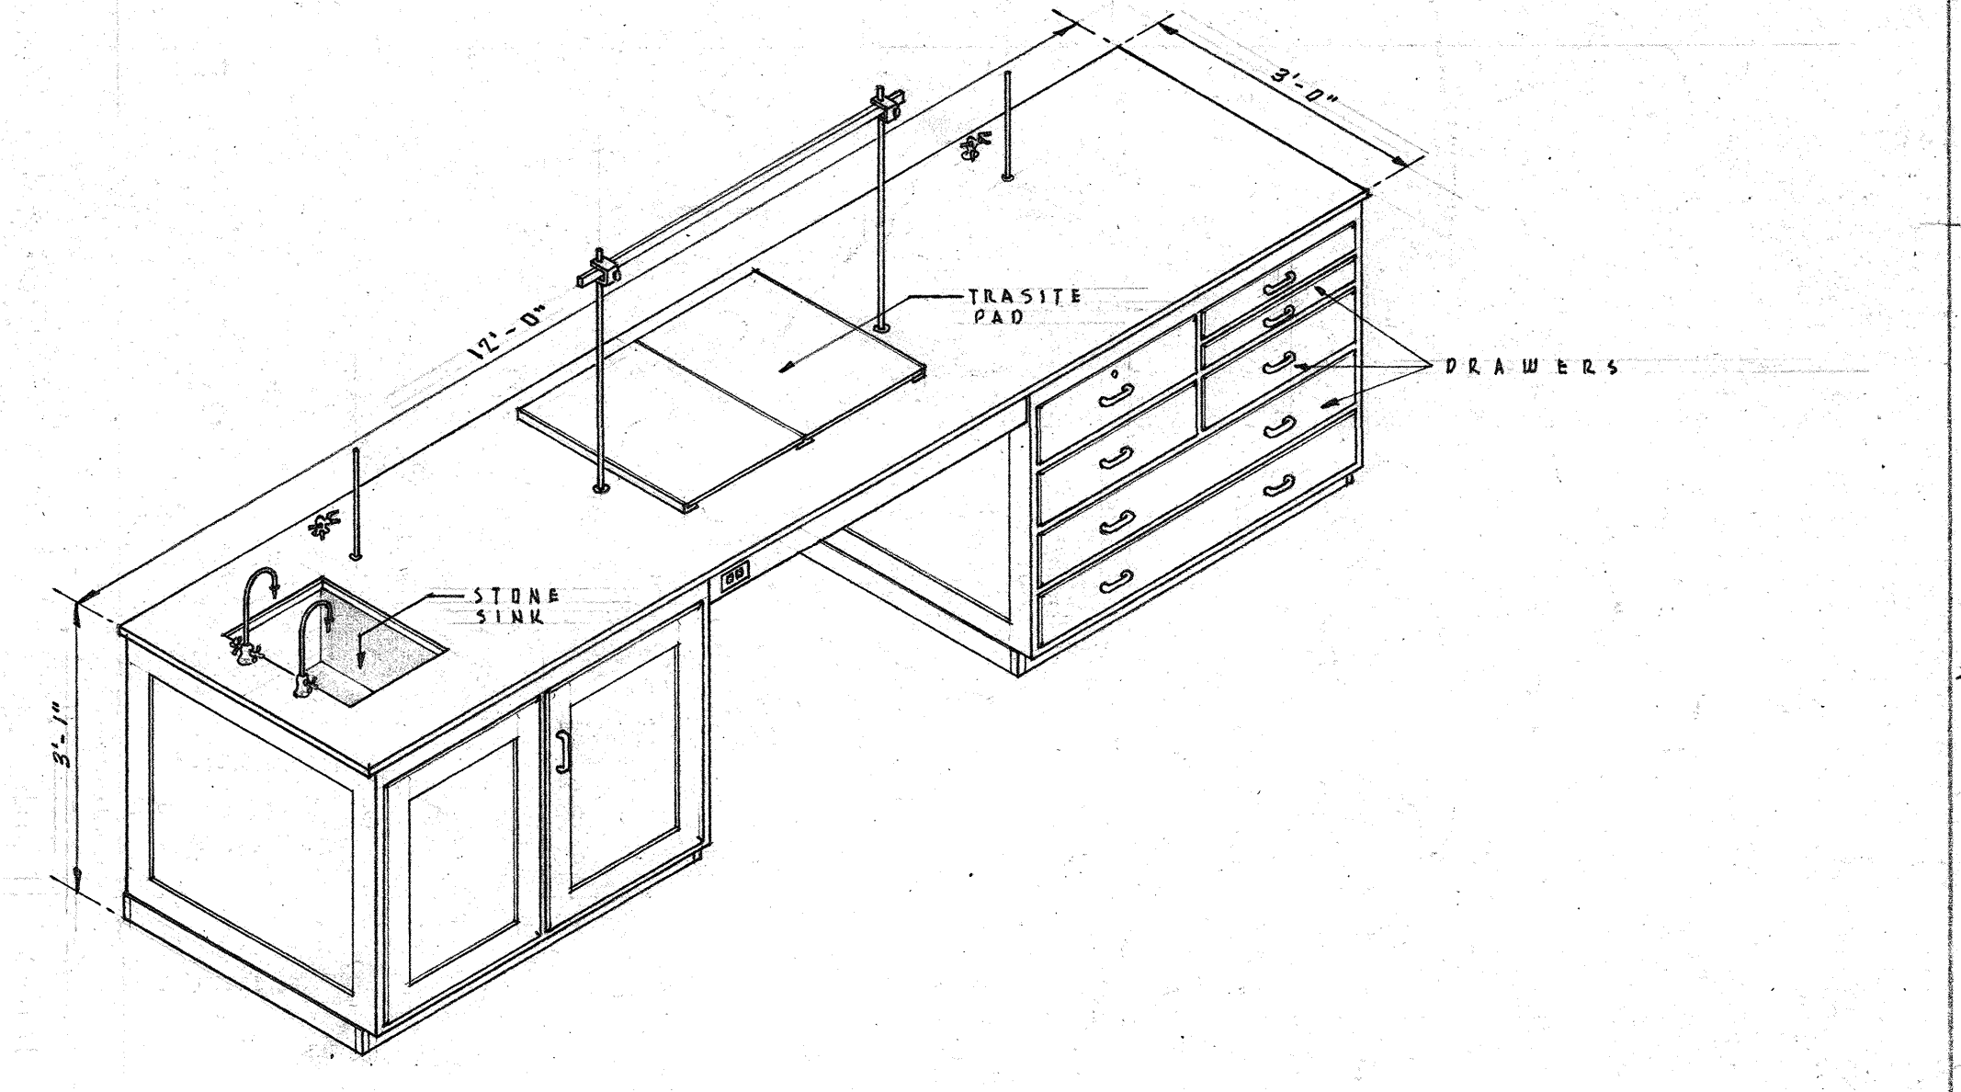

SCIENCE ROOM INSTRUCTOR'S TABLE

HAMILTON NO. L-2110

SCALE: 1/2" = 1'-0"

F/10 STOCK ARRANGEMENT - 4 REQUIRED

F/15 (NOT STANDARD) 2 - 3' SECTIONS REQUIRED

F/13 6 - 3' SECTIONS REQUIRED

F/12 2 - 3' SECT. REQ'D

F/11 37 REQ'D

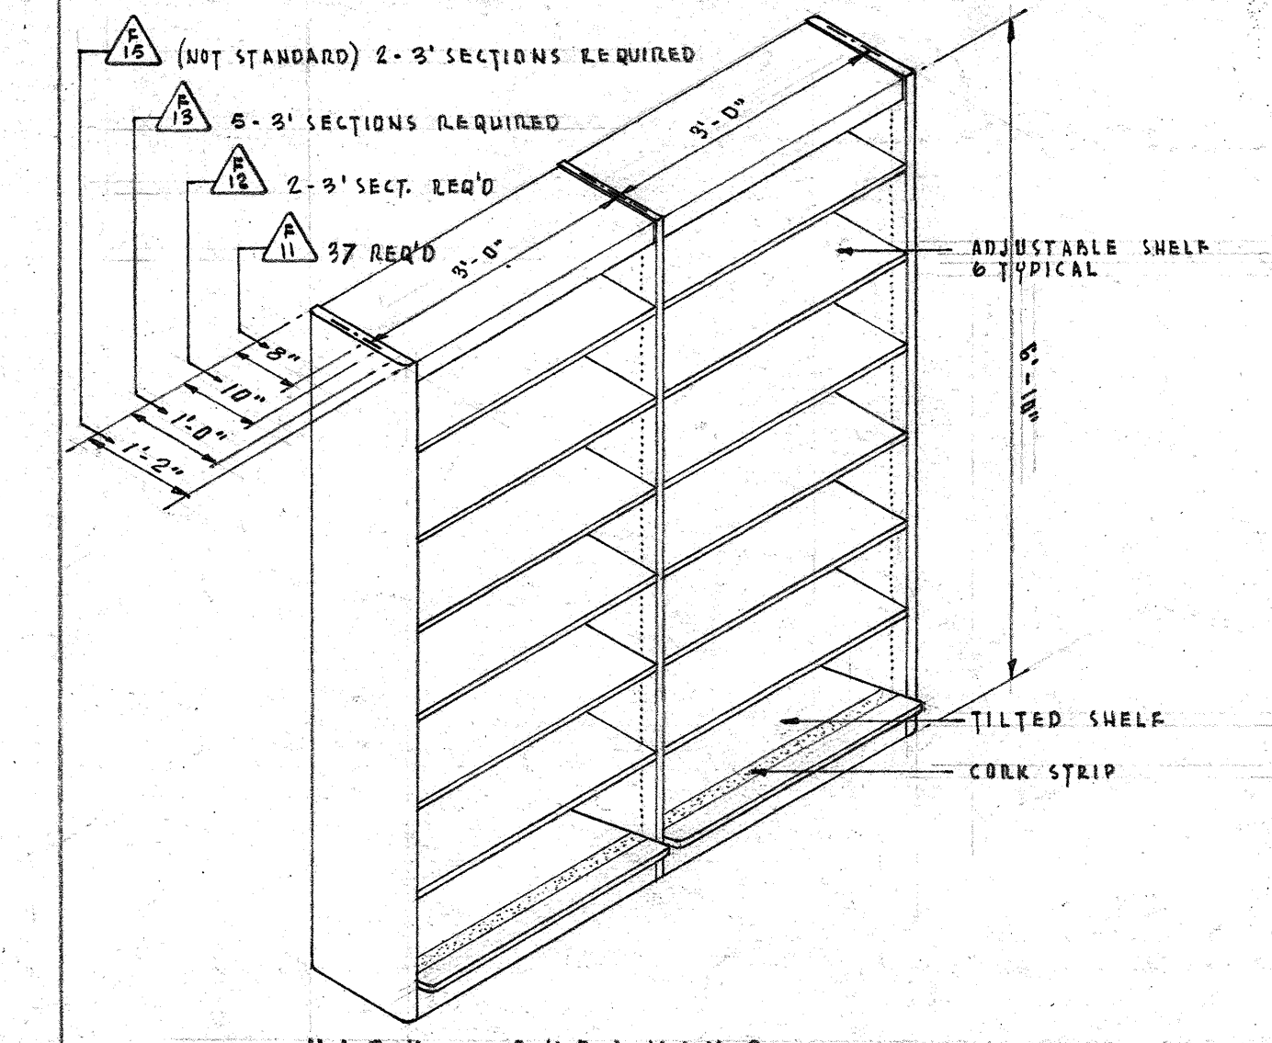

HIGH SHELVING

REMINGTON RAND "TREND" NO. 7730 SERIES

SCALE: 1/2" = 1'-0"

REVISED TO AS-BUILD STATUS BY: REKEVICS CHECKED: MAY 1-24-57

SCIENCE ROOM DETAILS AND
FIXTURE DETAILS UNIT A

JOHN W. MALONEY
RENEWED TO JUNE 1, 1954
72,369
L-10
STATE OF WASHINGTON
LICENSED ARCHITECT

EDMOND MEANY JUNIOR HIGH - RECREATION PROJECT
FOR THE
SEATTLE PUBLIC SCHOOL DISTRICT No. 1
AND THE
SEATTLE DEPARTMENT OF PARKS
20TH AVENUE NORTH AT EAST REPUBLICAN STREET — SEATTLE, WASHINGTON

DATE	JOHN W. MALONEY A. I. A. ARCHITECT 754 CENTRAL BUILDING 1117 LARSON BLDG. SEATTLE WASHINGTON YAKIMA	DRAWN
6-21-54		FOOTE
DWG. NO.		CHECKED
A 13		MAY

139-0038