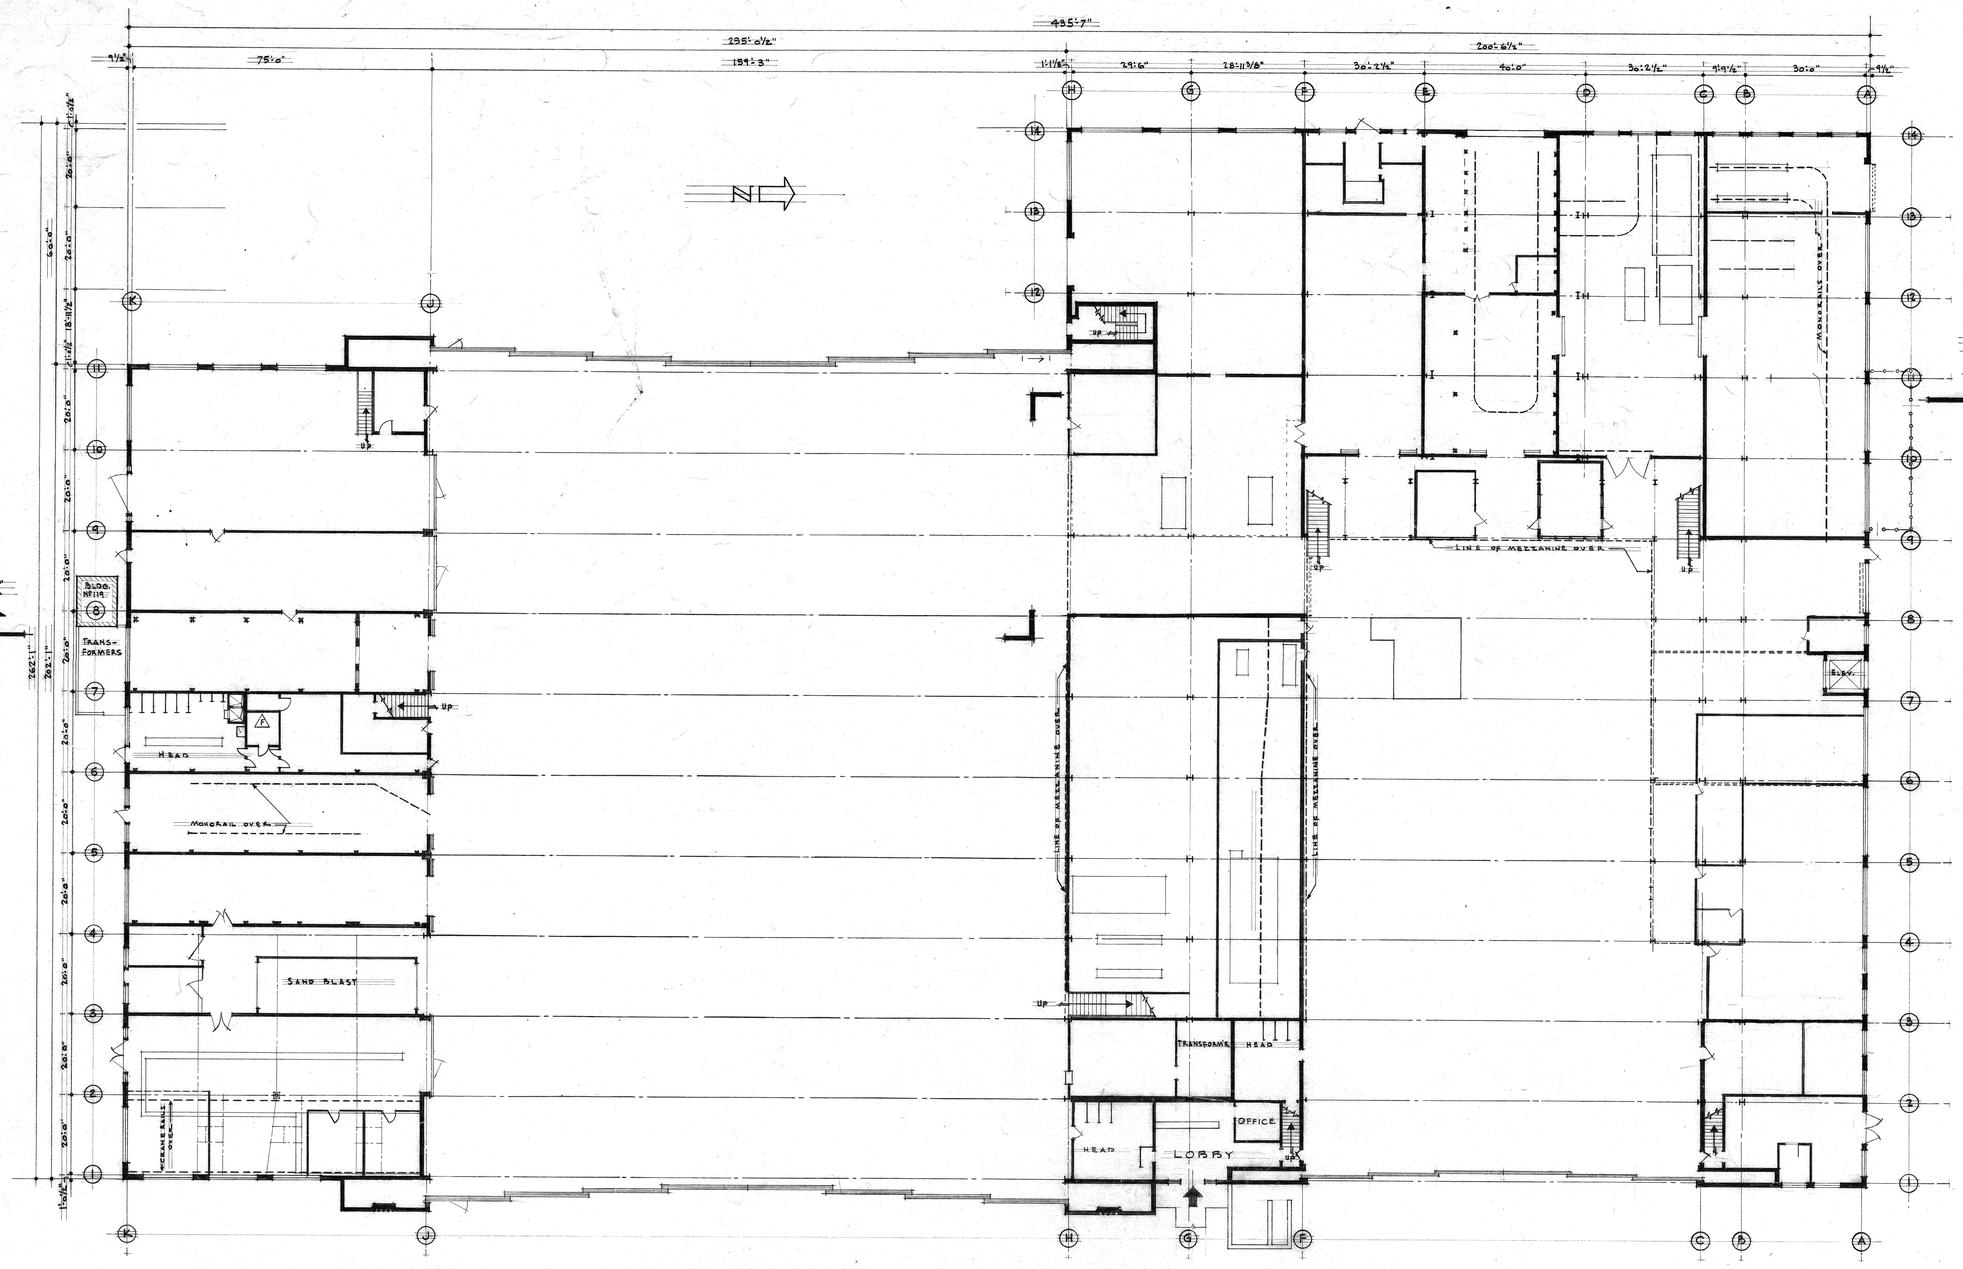


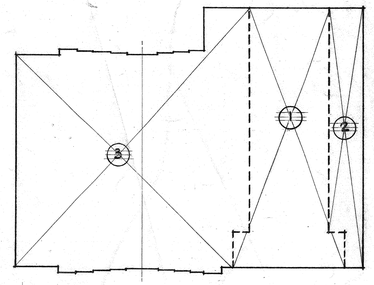

1 P.S.N.S. ORIGINAL BUILDING
2 P.S.N.S. ADDITION NORTH SIDE
3 AUSTIN CO. EXTENSION SOUTH SIDE

# GROUND FLOOR PLAN

SCALE: 1/16" = 1'-0"

NOTE:- SEE DWG # 2518 FOR LOAD DIAGRAM

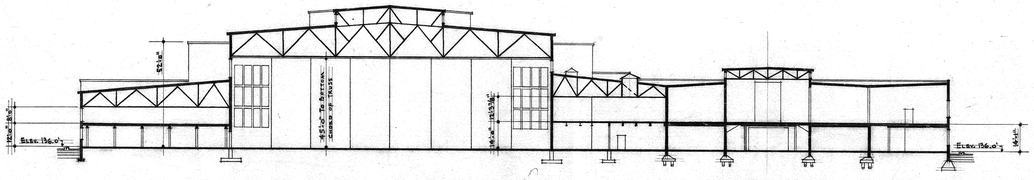


SECTION - "A" - "A"

SCALE: 1/32" = 1'-0"

| REVISION | DATE | APP'D. | DESCRIPTION | BY |
|---|---|---|---|---|
| F | 9-21-84 | | REVISED PER AS BUILTS & FIELD INSPECTION | JWG |
| E | 9-16-76 | | REVISED PER FIELD INSPECTION | JWG |
| D | 5-12-76 | | REVISED PER AS BUILT | J.W.G. |
| C | 6-21-72 | | PLAN BROUGHT UP TO DATE | H.E.G. |
| B | 5-23-60 | RGM. | PLAN BROUGHT UP TO DATE | R.L.M. |
| A | 4-17-53 | AO | PLAN BROUGHT UP TO DATE | DC |

P.W. DRAWING Nº 2517

DES.
DRWN. ACKD 1-30-50
CHK.
SUPV.
IN CHARGE JCD

NAVAL AIR STATION
SEATTLE, WASHINGTON

COMPREHENSIVE PLAN
O&R BLDG. Nº 2
GROUND FLOOR PLAN

APPROVED [signature] DATE 5-16-50
PUBLIC WORKS OFFICER

| Nº | ISSUED To | DATE |
|---|---|---|
| PRINTS | | |

SATISFACTORY To

DATE

SCALE: AS SHOWN | SPEC.
SHEET 1 of 2 | Nov
Y&D. DRWNG. Nº