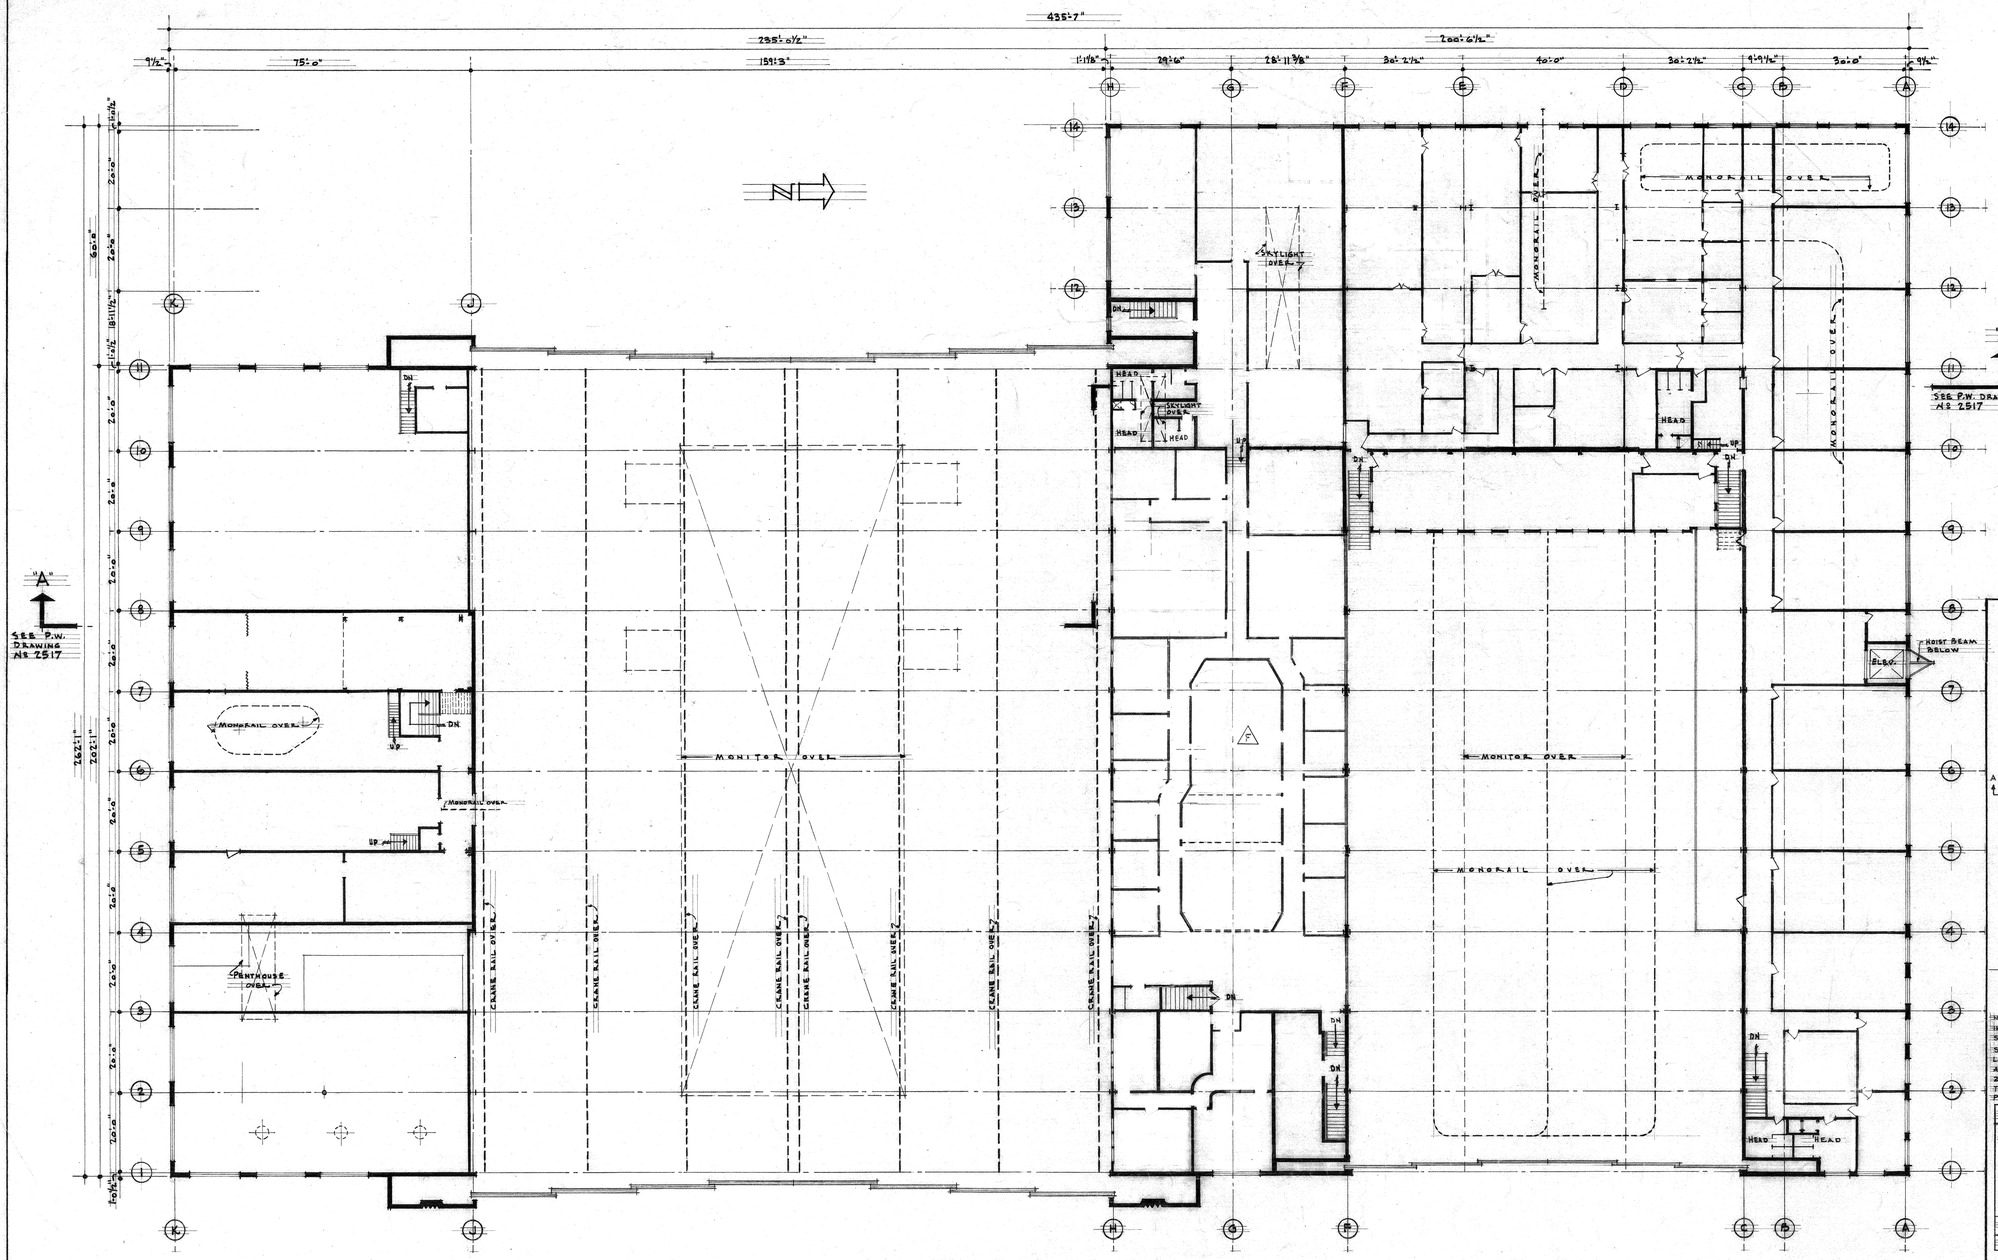

MEZZANINE FLOOR PLAN

SCALE: 1/16" = 1'-0"

SAFE LIVE LOADS

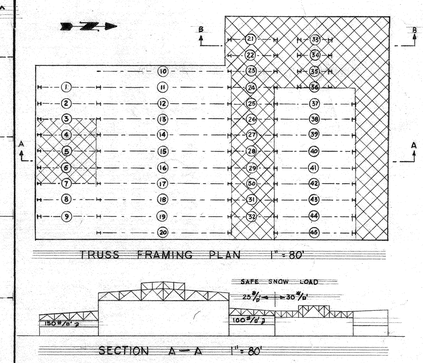

TRUSS FRAMING PLAN 1" = 80'

SECTION A — A 1" = 80'

NOTE: HATCHED AREAS IN PLAN INDICATE MEZZANINE DECKS.
SAFE LIVE LOADS FOR THESE DECKS SHOW IN SECTIONS "A-A" AND "B-B" LOADING: TRUSS #9, 0.50 K FROM ANY PANEL POINT; TRUSSES 10 TO 20, 25 K FROM ANY PANEL POINT; TRUSSES 37 TO 45, 3K FROM 5 PANEL POINTS OR 5K FROM ANY PANEL POINT.

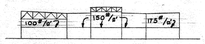

SECTION B — B 1" = 80'

ITEM	LOADS AND REMARKS
TRUSSES 1 to 20 and 33 to 36	NO HANGING LOADS ALLOWED IN EXCESS OF EXISTING LABELED HOISTS. TRUSSES 10 to 20; 2 TRAVELING MONORAILS WITH ONE 5 TON ELECT. HOIST EACH, 4 TRAVELING MONORAILS WITH TWO 2 TON CHAIN HOISTS EACH ON NORTH HALF OF TRUSSES, 3 TRAVELING MONORAILS WITH TWO 2 TON CHAIN HOISTS EACH ON SOUTH HALF OF TRUSSES. TRUSSES 33-36; 3000# ON MONORAIL IN LIEU OF SNOW LOAD.
TRUSSES 21 to 32	NO HANGING LOADS ALLOWED
TRUSSES 37 to 45	2½ TON FROM ANY PANEL POINT

REVISION	DATE	APP'D.	DESCRIPTION	BY
F	9-19-84		REVISED PER "AS BUILT" & FIELD INSPECTION	JWG
E	9-16-76		REVISED PER FIELD INSPECTION	J.W.G.
D	5-12-76		REVISED PER "AS BUILT"	J.W.G.
C	6-21-72		PLAN BROUGHT UP TO DATE	H.E.G.
B	4-22-60	RGM	ADDED NEW PARTITIONS - LIVE LOAD DIAGRAM - PLAN BROUGHT UP TO DATE	RLM
A	4-17-53	AO	PLAN BROUGHT UP TO DATE	DC

P.W. DRAWING No 2518

DES. A.O.I.O.N. 4-12-50
DRWN.
CHK.
SUPV.
IN CHARGE ACB

NAVAL AIR STATION
SEATTLE, WASHINGTON

COMPREHENSIVE PLAN
O.&R. BLDG. No 2
MEZZANINE FLOOR PLAN

APPROVED A.P. Gardiner DATE 5-16-50
PUBLIC WORKS OFFICER

No	ISSUED TO	DATE
PRINTS		

SATISFACTORY TO

DATE

SCALE: As Shown SPEC.
SHEET 2 of 2 Nov
Y&D DRWNG. No