REVISIONS				
SYM	DESCRIPTION	PREPD BY	DATE	APPROVED

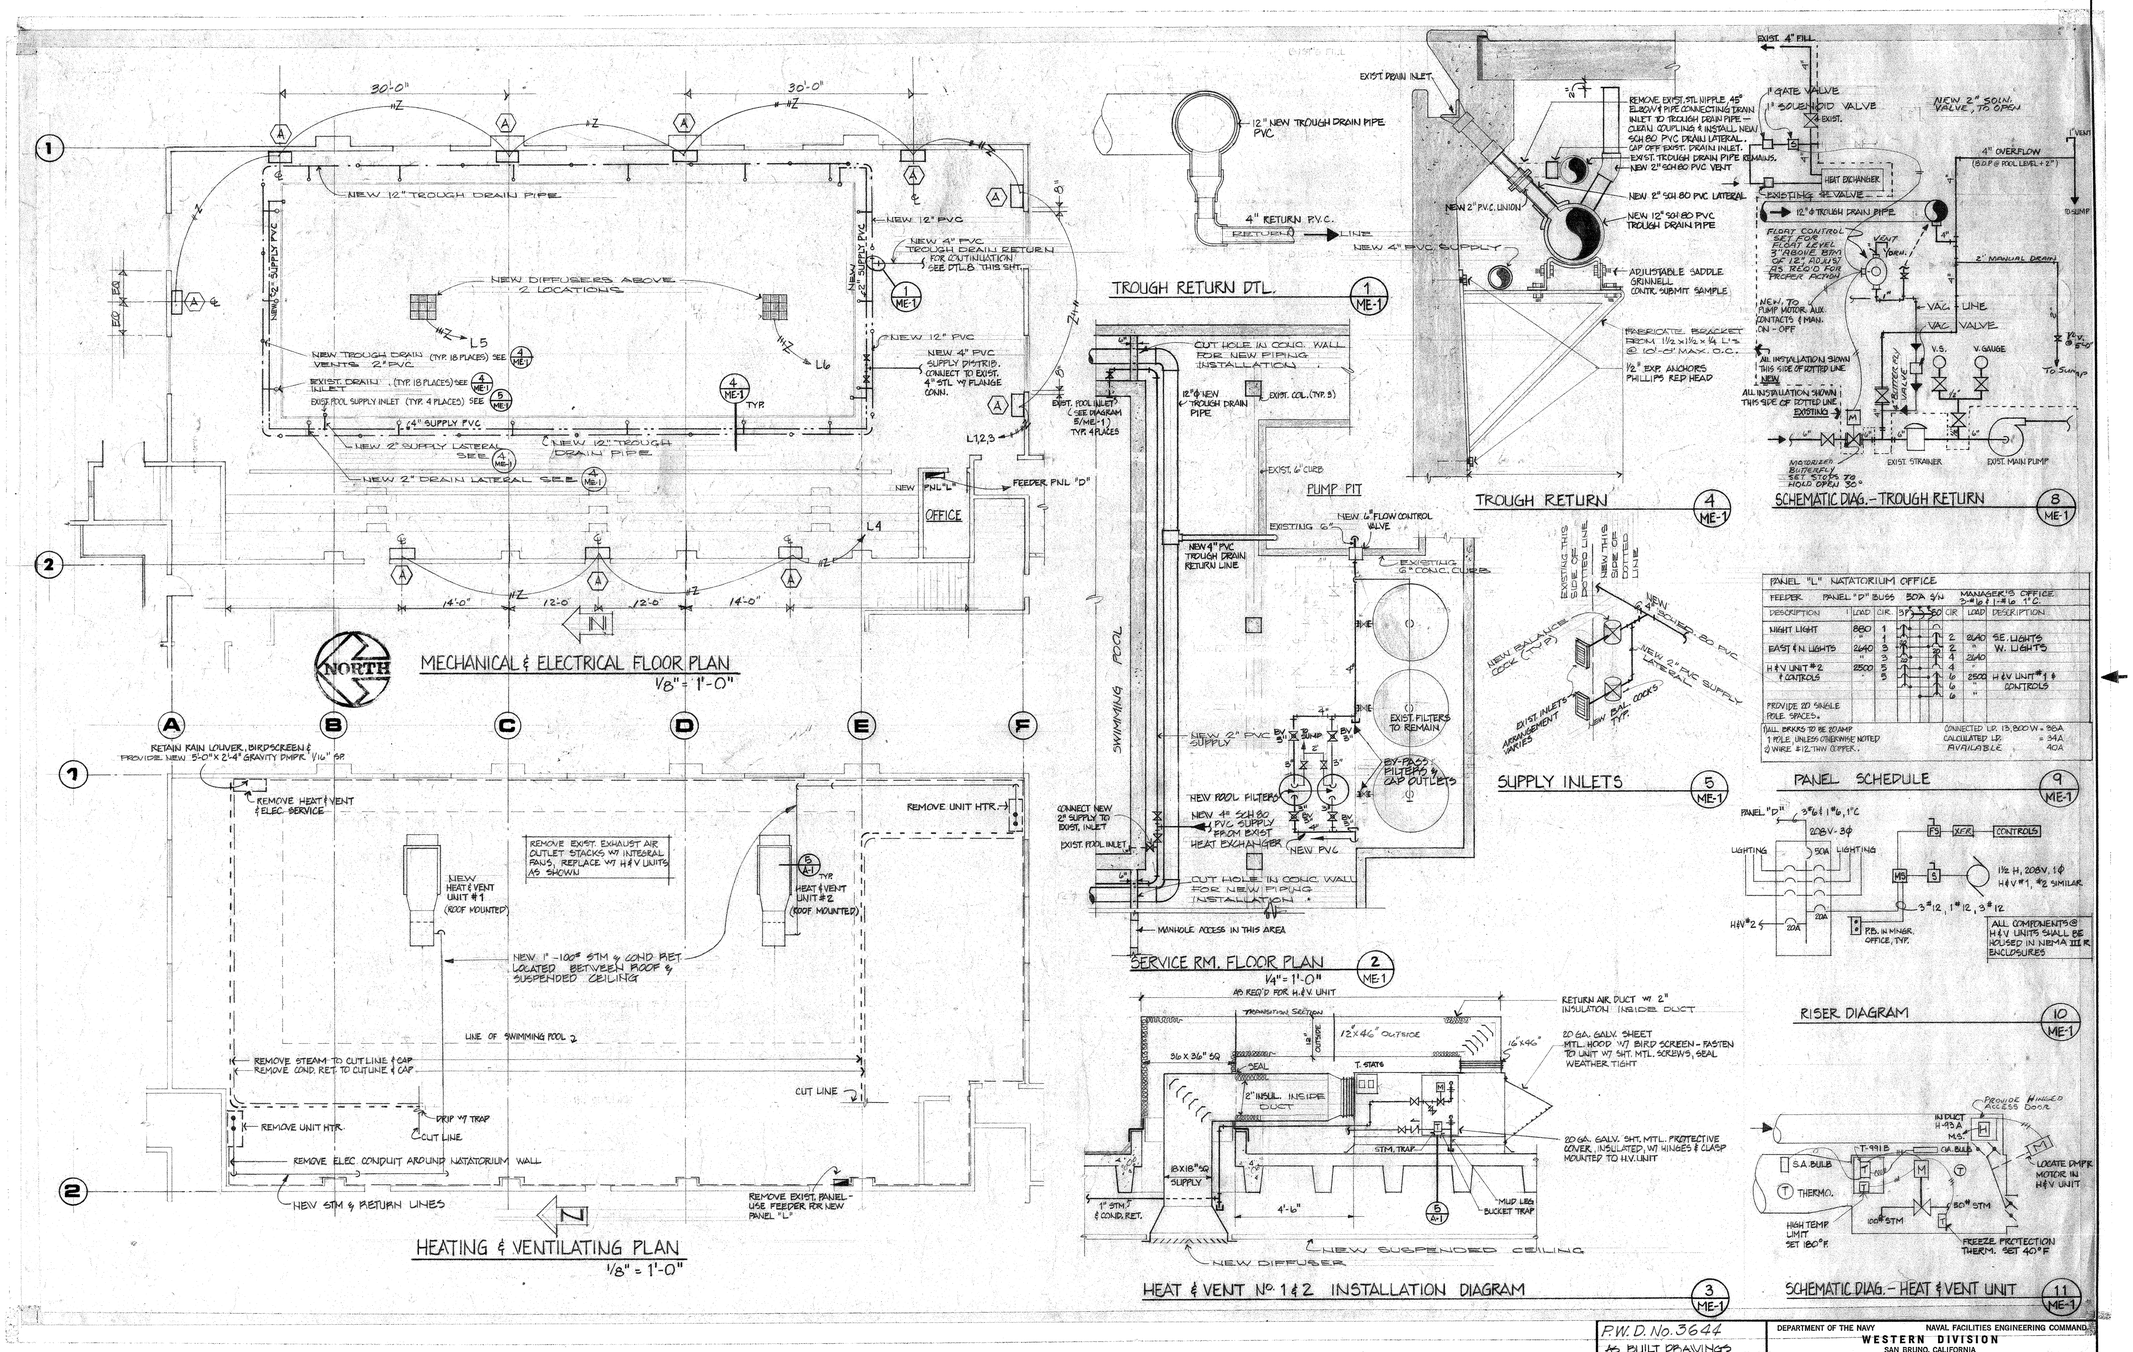

P.W.D. No. 3644
AS BUILT DRAWINGS

DSGN. RJ | DR. SM | CHK.
SURV. | CH. ENGR.
SUBMITTED BY | DATE
FIRE MEMBER (TITLE)
F.I.C. | FIRE PROT.
BR. HD. | DIR.
SATISFACTORY TO | DATE
TITLE
APPROVED | DATE
EFD FOR COMMANDER NAVFAC

RAYMOND T. JENSEN, III — STATE OF WASHINGTON — 11211 — REGISTERED PROFESSIONAL ENGINEER

BENJAMIN M. BIGGOLD — STATE OF WASHINGTON — 10807 — REGISTERED ARCHITECT

Olson-Richer-Biggold
ARCHITECTS - PLANNERS - ENGINEERS
Evergreen Building, Suite 310 - Renton, Washington 98055

DEPARTMENT OF THE NAVY — NAVAL FACILITIES ENGINEERING COMMAND
WESTERN DIVISION
SAN BRUNO, CALIFORNIA

REPAIRS & ALTERATIONS TO SWIMMING POOL - BLDG. 47
NAVAL SUPPORT ACTIVITY
SEATTLE, WASHINGTON 98115

SIZE	CODE IDENT. NO.	NAVFAC. DRAWING NO.
F	80091	6025756
		CONST. CONTR. NO. N62474— —C—
SCALE	SPEC.	SHEET ME-1 OF 1

55807

GPO 793-741