GENERAL SHEET NOTES:

1. NOT USED.

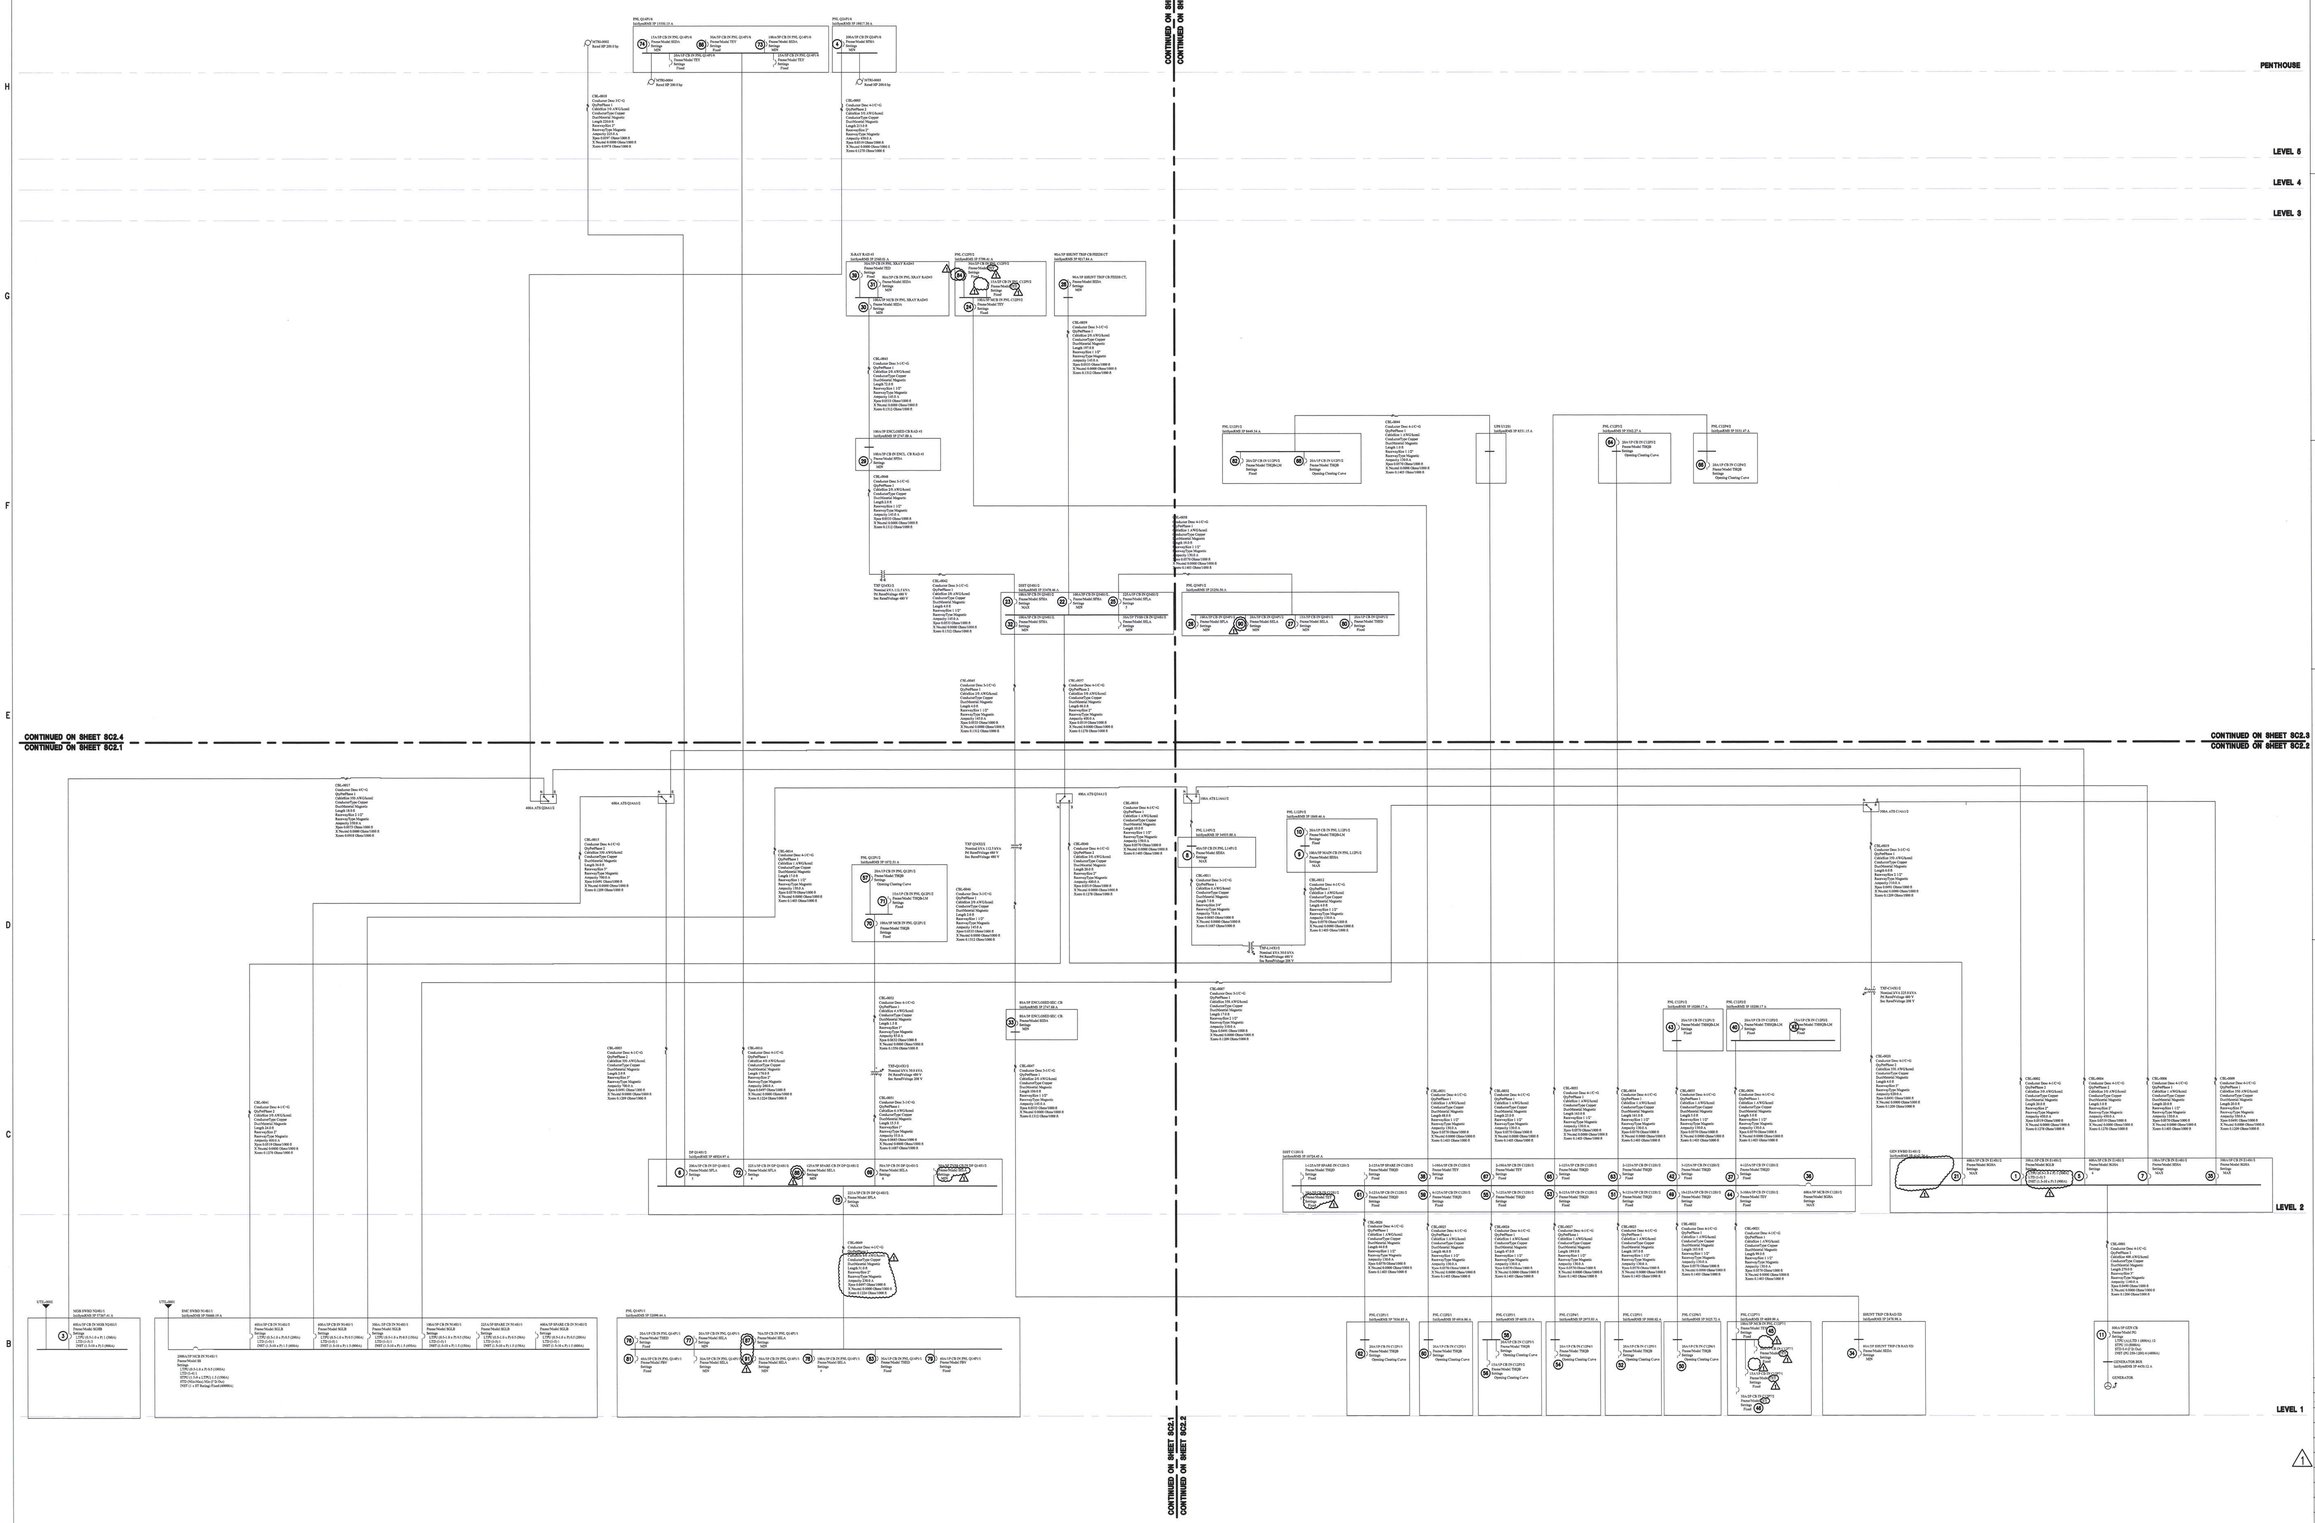

SELECTIVE COORDINATION ONE-LINE
FAULT CURRENT CALCULATIONS - OVERALL

1 / SC2 SCALE: NTS

SCALE: 1"=40'-0" FEET | SCALE: 1"=20'-0" FEET | SCALE: 1/2"=1'-0" FEET | SCALE: 1/4"=1'-0" FEET | SCALE: 1/8"=1'-0" FEET | SCALE: 1/16"=1'-0" FEET

OWNER:
SWEDISH HEALTH SYSTEMS
500 17th Ave
Seattle, WA 98122
T 206-320-2000
F 206-320-4567

SASCO
14400 WOODINVILLE REDMOND RD
WOODINVILLE, WA 98072
PHONE (425)806-9797
FAX (425)806-9797

THESE DOCUMENTS, INCLUDING ALL DESIGN, GEOLOGY, AND METHODOLOGY, ARE THE PROPERTY OF SASCO, AND MAY NOT BE USED IN WHOLE OR IN PART FOR ANY PURPOSE THE ONE ENTITLED HEREIN. SASCO'S DELIGENCE AS THE DESIGNER OF RECORD IS LIMITED TO THE PURPOSE STATED IN THIS DESIGN. THIS DESIGN IS NOT INTENDED BY SASCO AND ANY REPRODUCTION OR MODIFICATION OF THESE DOCUMENTS ARE WITHOUT AND SASCO DOES NOT RE-STAMP THESE DOCUMENTS TO REFLECT ANY MODIFICATION OR ALTERATION. ALL OTHER OBLIGATIONS, INCLUDING BUT NOT LIMITED TO, THE PROFESSIONAL DESIGN OF THIS DESIGN, ALL STAMPS WILL BE REMOVED.

DUANE A. CARLSON
STATE OF WASHINGTON
38446
REGISTERED PROFESSIONAL ENGINEER

EXPIRES: 05/19/11

SIGNED: 4/12/10

CALLISON
www.callison.com

5350 TALLMAN
BALLARD MEDICAL OFFICE BUILDING
Swedish Medical Center - Ballard Campus
5350 Tallman Ave NW
Seattle, WA 98107

PROJECT #209313.00

ISSUED / REVISED	DATE
~~SELECTIVE COORD. STUDY~~	~~01/15/10~~
SELECTIVE COORD. STUDY	02/05/10
HARGIS COMMENT	02/23/10
REISSUED TO DPD	03/25/10
1 DPD COMMENT #1	04/08/10

SELECTIVE COORDINATION STUDY - ONE-LINE

SC2

K:\ENGINEERS\E-SPKGB\JAPTER 09 05 20 CD SET\SKY1 - SELECTIVE COORDINATION\SHELL & CORE WITH T1\SC2.0.DWG, 4/8/2010 4:20:00 PM, CutePDF Writer, b1

$$$DESIGN$$$PECIFICATION$$$$$$$$$$$$$ $$$DATE$$$$ $TIME COPYRIGHT © 2008 CALLISON