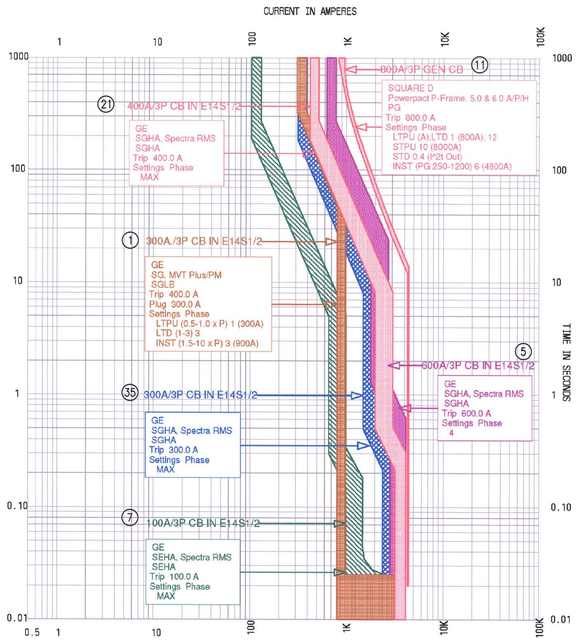

1 SC4

Project: 5350 TALLMAN - SWEDISH SHELL & CORE WITH SWEDISH T.I. APRIL 8, 2010
Plot Name: 800A GEN CB - E14S1/2
Ref. Voltage: 480
Current Scale: x 1

SASCO
16653 WOODINVILLE REDMOND RD
WOODINVILLE, WA 98072
PHONE (425)806-8400
FAX (425)806-9797

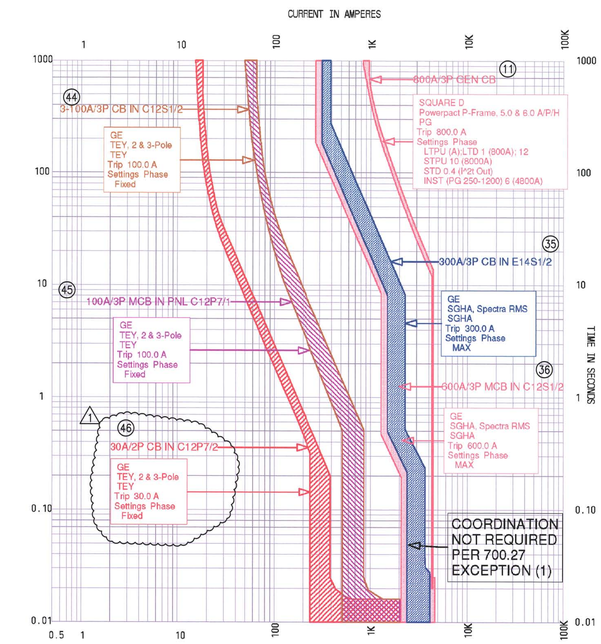

2 SC4

Project: 5350 TALLMAN - SWEDISH SHELL & CORE WITH SWEDISH T.I. APRIL 8, 2010
Plot Name: 800A GEN CB - 30/2P CB IN C12P7/1
Ref. Voltage: 480
Current Scale: x 1

SASCO
16653 WOODINVILLE REDMOND RD
WOODINVILLE, WA 98072
PHONE (425)806-8400
FAX (425)806-9797

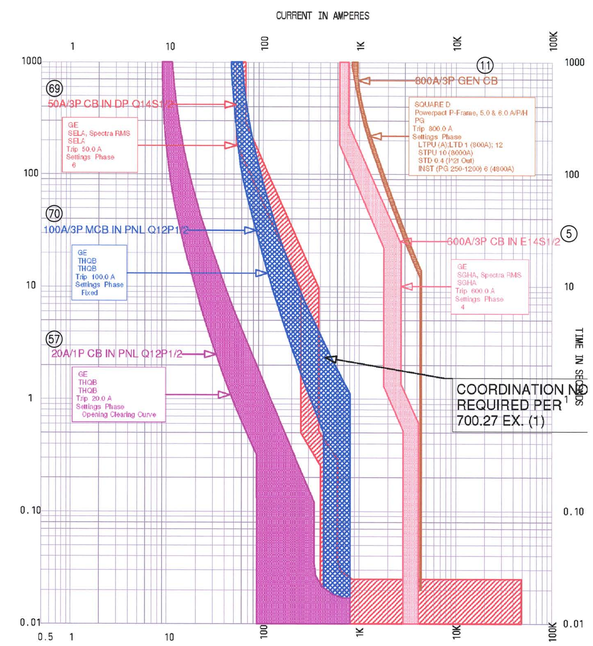

3 SC4

Project: 5350 TALLMAN - SWEDISH SHELL & CORE WITH SWEDISH T.I. APRIL 8, 2010
Plot Name: 800A GEN CB - 20A/1P CB IN Q12P1/2
Ref. Voltage: 480
Current Scale: x 1

SASCO
16653 WOODINVILLE REDMOND RD
WOODINVILLE, WA 98072
PHONE (425)806-8400
FAX (425)806-9797

REFERENCE NUMBER, TYPICAL, TO TIE DEVICE ON TIME-CURRENT CURVE TO DEVICE ON ONE-LINE

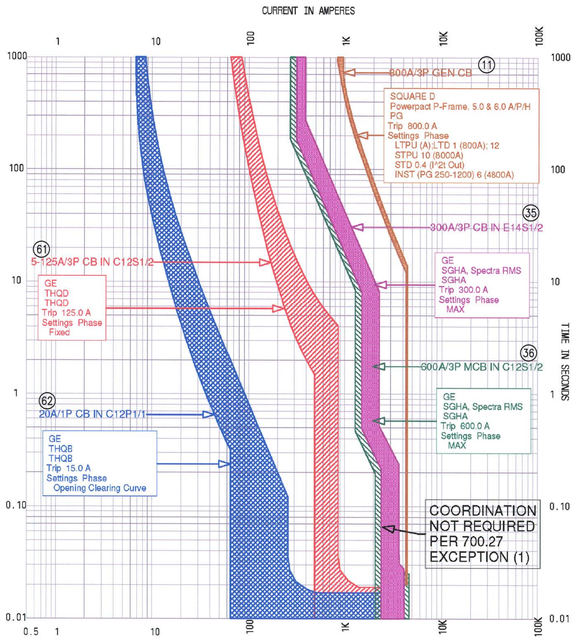

4 SC4

Project: 5350 TALLMAN - SWEDISH SHELL & CORE WITH SWEDISH T.I. APRIL 8, 2010
Plot Name: 800A GEN CB - 20/1P CB IN C12P1/1
Ref. Voltage: 480
Current Scale: x 1

SASCO
16653 WOODINVILLE REDMOND RD
WOODINVILLE, WA 98072
PHONE (425)806-8400
FAX (425)806-9797

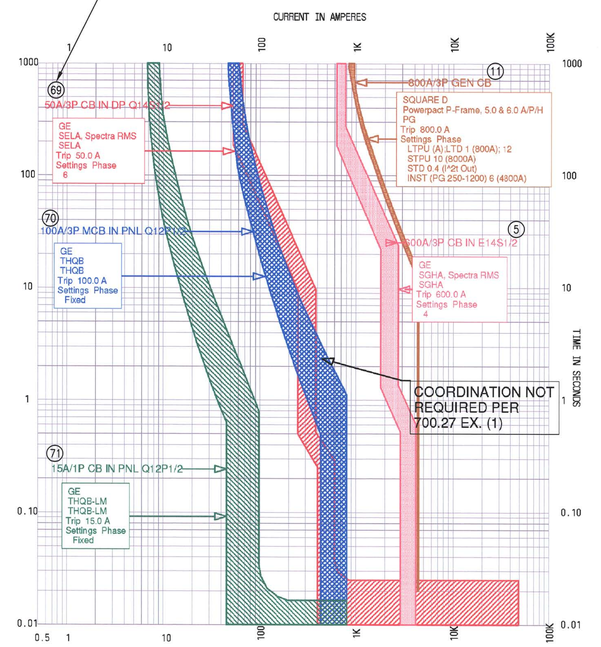

5 SC4

Project: 5350 TALLMAN - SWEDISH SHELL & CORE WITH SWEDISH T.I. APRIL 8, 2010
Plot Name: 800A GEN CB - 15A/1P CB IN Q12P1/2
Ref. Voltage: 480
Current Scale: x 1

SASCO
16653 WOODINVILLE REDMOND RD
WOODINVILLE, WA 98072
PHONE (425)806-8400
FAX (425)806-9797

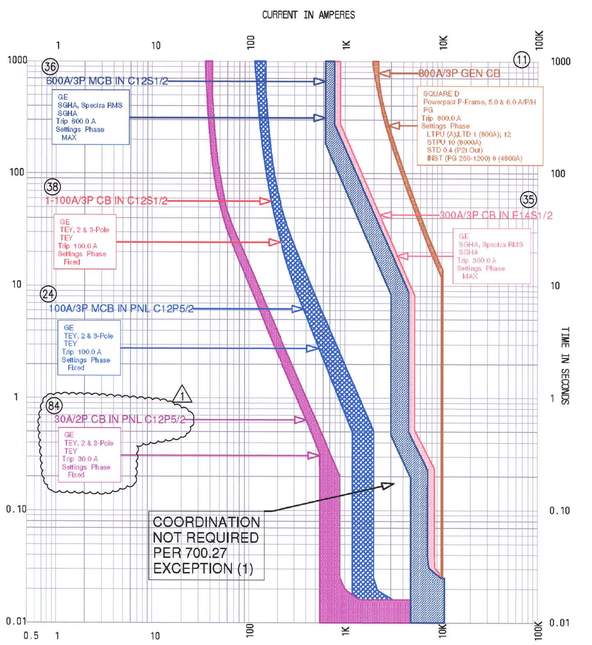

6 SC4

Project: 5350 TALLMAN - SWEDISH SHELL & CORE WITH SWEDISH T.I. APRIL 8, 2010
Plot Name: 800A GEN CB - 30A/2P CB IN C12P5/2
Ref. Voltage: 208
Current Scale: x 1

SASCO
16653 WOODINVILLE REDMOND RD
WOODINVILLE, WA 98072
PHONE (425)806-8400
FAX (425)806-9797

SCALE: 1"=40'-0" (0 20 40 80 120 FEET)
SCALE: 1"=20'-0" (0 10 20 40 60 FEET)
SCALE: 1/2"=1'-0" (0 1 2 4 6 FEET)
SCALE: 1/4"=1'-0" (0 1 2 3 4 8 12 FEET)
SCALE: 1/8"=1'-0" (0 2 4 6 8 12 16 24 FEET)
SCALE: 1/16"=1'-0" (0 4 8 12 16 24 32 48 FEET)

OWNER:
SWEDISH HEALTH SYSTEMS
500 17th Ave
Seattle, WA 98122
T 206-320-2000
F 206-320-4567

SASCO
16653 WOODINVILLE REDMOND RD
WOODINVILLE, WA 98072
PHONE (425)806-8400
FAX (425)806-9797

THESE DOCUMENTS, INCLUDING ALL DESIGN MODELS, ARE INSTRUMENTS OF PROFESSIONAL SERVICE AND SHALL NOT BE USED FOR ANY PROJECT OTHER THAN THE PROJECT FOR WHICH THEY WERE PREPARED. THEREFORE, OR EXCEPT AS SHALL BE INSTALLATION OF THE PROJECT FOR WHICH THEY WERE PREPARED, THEY ARE, WILL AND VOID, NOT TO STAMP THESE DOCUMENTS WITH THE WORD "CERTIFIED" OR ANY WORD OF SIMILAR OBLIGATION AND IN THE EVENT SASCO DOES NOT INSTALL THE DESIGN, ALL SHOP DWG WILL BE REMOVED.

DUANE A. CARLSON
STATE OF WASHINGTON
39446
REGISTERED PROFESSIONAL ENGINEER
EXPIRES: 05/19/11
SIGNED: 4/12/10

CALLISON
CALLISON
www.callison.com

5350 TALLMAN
BALLARD MEDICAL OFFICE BUILDING
Swedish Medical Center - Ballard Campus
5350 Tallman Ave NW
Seattle, WA 98107

PROJECT #209313.00

ISSUED / REVISED	DATE
~~SELECTIVE COORD. STUDY~~	~~01/15/10~~
SELECTIVE COORD. STUDY	02/05/10
HARGIS COMMENT	02/23/10
REISSUED TO DPD	03/25/10
1 DPD COMMENT #1	04/08/10

SELECTIVE COORDINATION STUDY - TIME-CURRENT CURVES

SC4

K:\ENGFILES\E-BKOB\AFTER 09 05 20 CD SET\SCH - SELECTIVE COORDINATION\SHELL & CORE WITH T.I\SC4.DWG, 4/8/2010 4:21:51 PM, CutePDF Writer, 1:1

$$$DESIGN$$$SPECIFICATION$$$$$$$$$$$$$$ $$$DATE$$$$ $TIME COPYRIGHT © 2008 CALLISON