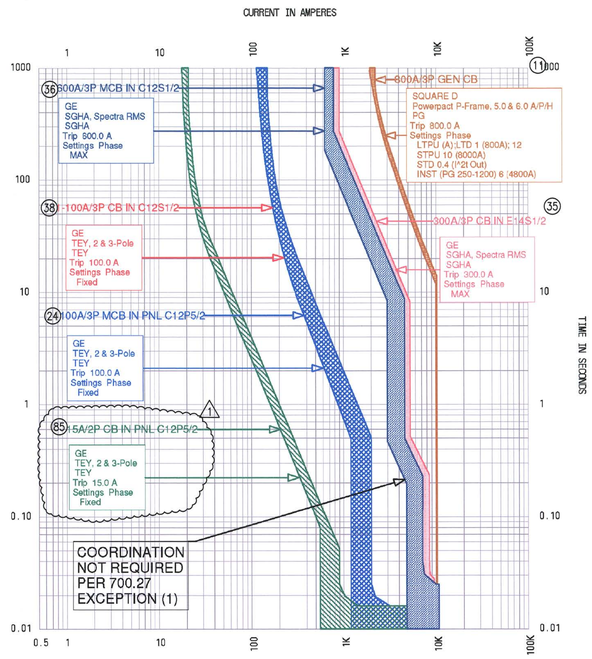

1 / SC5

Project: 5350 TALLMAN - SWEDISH SHELL & CORE WITH SWEDISH T.I. APRIL 8, 2010
Plot Name: 800A GEN CB - 15A/2P CB IN C12P5/2
Ref. Voltage: 208
Current Scale: x 1

SASCO
18653 WOODINVILLE REDMOND RD
WOODINVILLE, WA 98072
PHONE (425)806-8400
FAX (425)806-0797

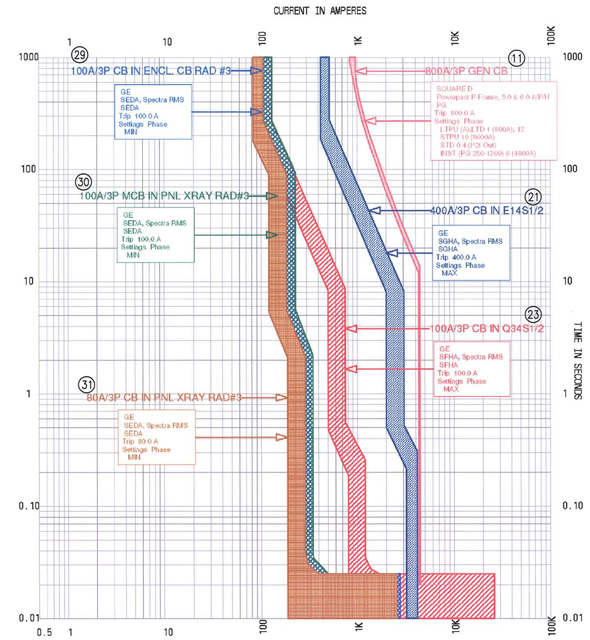

2 / SC5

Project: 5350 TALLMAN - SWEDISH SHELL & CORE WITH SWEDISH T.I. APRIL 8, 2010
Plot Name: 800A GEN CB - 80A/3P CB IN X-RAY RAD #3
Ref. Voltage: 480
Current Scale: x 1

SASCO
18653 WOODINVILLE REDMOND RD
WOODINVILLE, WA 98072
PHONE (425)806-8400
FAX (425)806-0797

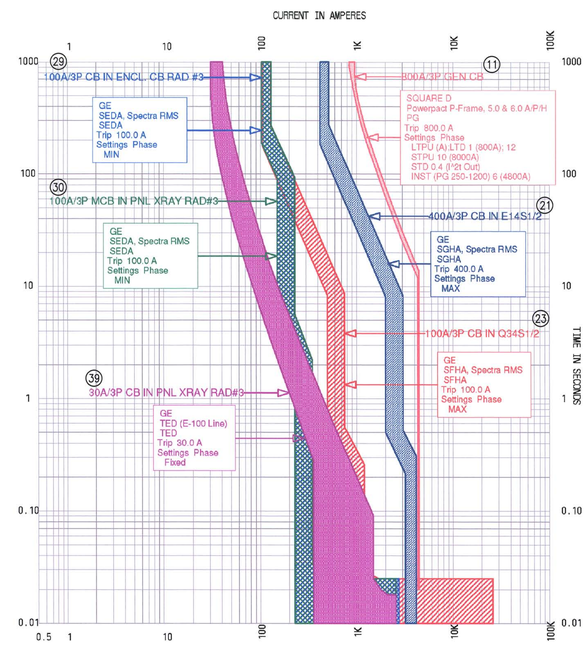

3 / SC5

Project: 5350 TALLMAN - SWEDISH SHELL & CORE WITH SWEDISH T.I. APRIL 8, 2010
Plot Name: 800A GEN CB - 30A/2P CB IN X-RAY RAD #3
Ref. Voltage: 480
Current Scale: x 1

SASCO
18653 WOODINVILLE REDMOND RD
WOODINVILLE, WA 98072
PHONE (425)806-8400
FAX (425)806-0797

REFERENCE NUMBER, TYPICAL, TO TIE DEVICE ON TIME-CURRENT CURVE TO DEVICE ON ONE-LINE

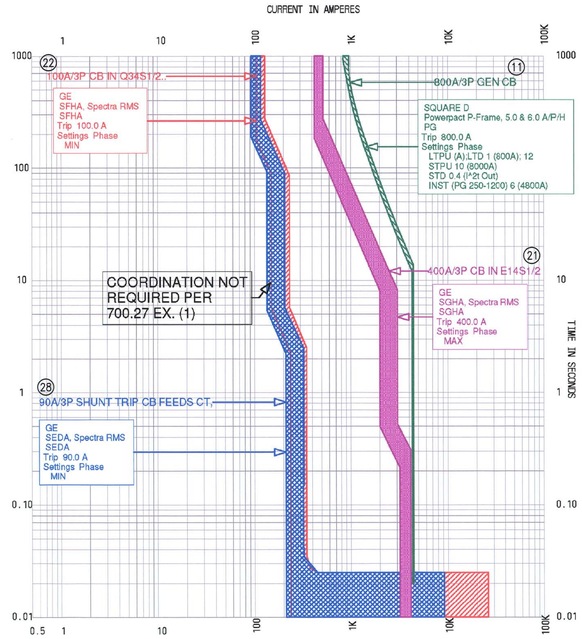

4 / SC5

Project: 5350 TALLMAN - SWEDISH SHELL & CORE WITH SWEDISH T.I. APRIL 8, 2010
Plot Name: 800A GEN CB - 90A/3P CB FEEDS CT
Ref. Voltage: 480
Current Scale: x 1

SASCO
18653 WOODINVILLE REDMOND RD
WOODINVILLE, WA 98072
PHONE (425)806-8400
FAX (425)806-0797

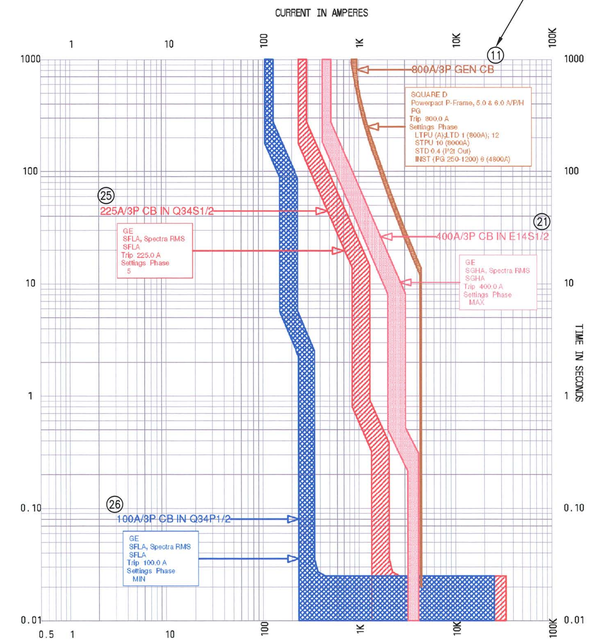

5 / SC5

Project: 5350 TALLMAN - SWEDISH SHELL & CORE WITH SWEDISH T.I. APRIL 8, 2010
Plot Name: 800A GEN CB - 100A/3P CB IN Q34P1/2
Ref. Voltage: 480
Current Scale: x 1

SASCO
18653 WOODINVILLE REDMOND RD
WOODINVILLE, WA 98072
PHONE (425)806-8400
FAX (425)806-0797

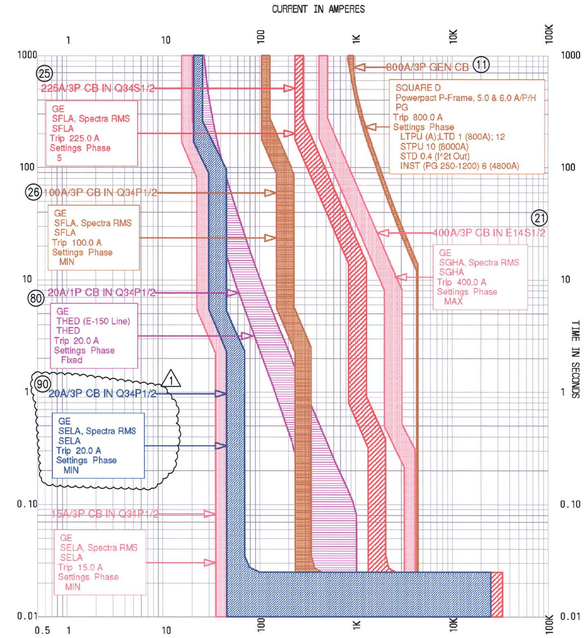

6 / SC5

Project: 5350 TALLMAN - SWEDISH SHELL & CORE WITH SWEDISH T.I. APRIL 8, 2010
Plot Name: 800A GEN CB - 15A/3P CB IN Q34P1/2
Ref. Voltage: 480
Current Scale: x 1

SASCO
18653 WOODINVILLE REDMOND RD
WOODINVILLE, WA 98072
PHONE (425)806-8400
FAX (425)806-0797

SCALE: 1"=40'-0" (0 20 40 80 120 FEET)
SCALE: 1"=20'-0" (0 10 20 40 60 FEET)
SCALE: 1/2"=1'-0" (0 1 2 4 6 FEET)
SCALE: 1/4"=1'-0" (0 1 2 3 4 8 12 FEET)
SCALE: 1/8"=1'-0" (0 2 4 6 8 12 16 24 FEET)
SCALE: 1/16"=1'-0" (0 4 8 12 16 24 32 48 FEET)

$$$DESIGN$$$PECIFICATION$$$$$$$$$$$$$$ $$$DATE$$$$ $TIME

COPYRIGHT © 2008 CALLISON

K:\ENGFILES\E-BMOB\AFTER 09 05 20 CD SET\SCM1 - SELECTIVE COORDINATION\SHELL & CORE WITH TI\SC5.dwg, 4/8/2010 4:22:19 PM, CutePDF Writer, bl

OWNER:
SWEDISH HEALTH SYSTEMS
500 17th Ave
Seattle, WA 98122
T 206-320-2000
F 206-320-4567

SASCO
18653 WOODINVILLE REDMOND RD
WOODINVILLE, WA 98072
PHONE (425)806-8400
FAX (425)806-0797



DUANE A. CARLSON
STATE OF WASHINGTON
39446
REGISTERED
PROFESSIONAL ENGINEER
EXPIRES: 05/19/11
SIGNED: 4/12/10

CALLISON
CALLISON
www.callison.com

5350 TALLMAN
BALLARD MEDICAL OFFICE BUILDING
Swedish Medical Center - Ballard Campus
5350 Tallman Ave NW
Seattle, WA 98107
PROJECT #209313.00

ISSUED / REVISED	DATE
~~SELECTIVE COORD. STUDY~~	~~01/15/10~~
SELECTIVE COORD. STUDY	02/05/10
HARGIS COMMENT	02/23/10
REISSUED TO DPD	03/25/10
1 DPD COMMENT #1	04/08/10

SELECTIVE COORDINATION STUDY - TIME-CURRENT CURVES

SC5