REGION NO.	STATE	FEDERAL AID PROJECT NO.	SHEET NO.
10	WA	####	

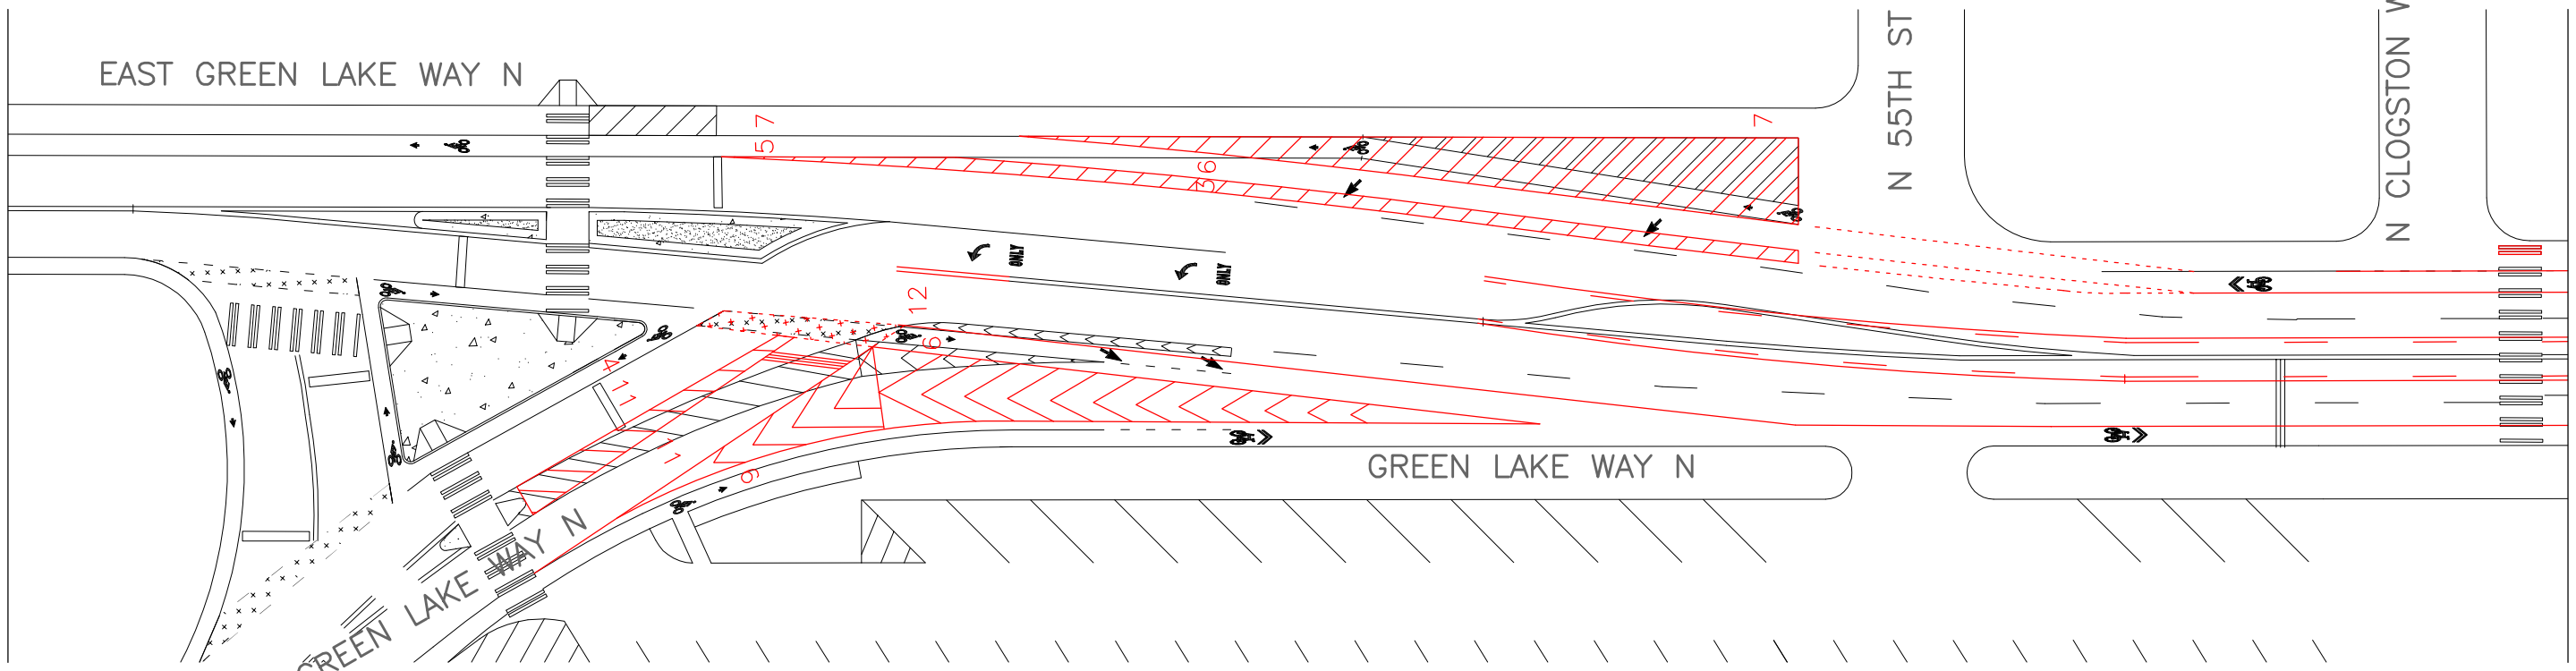

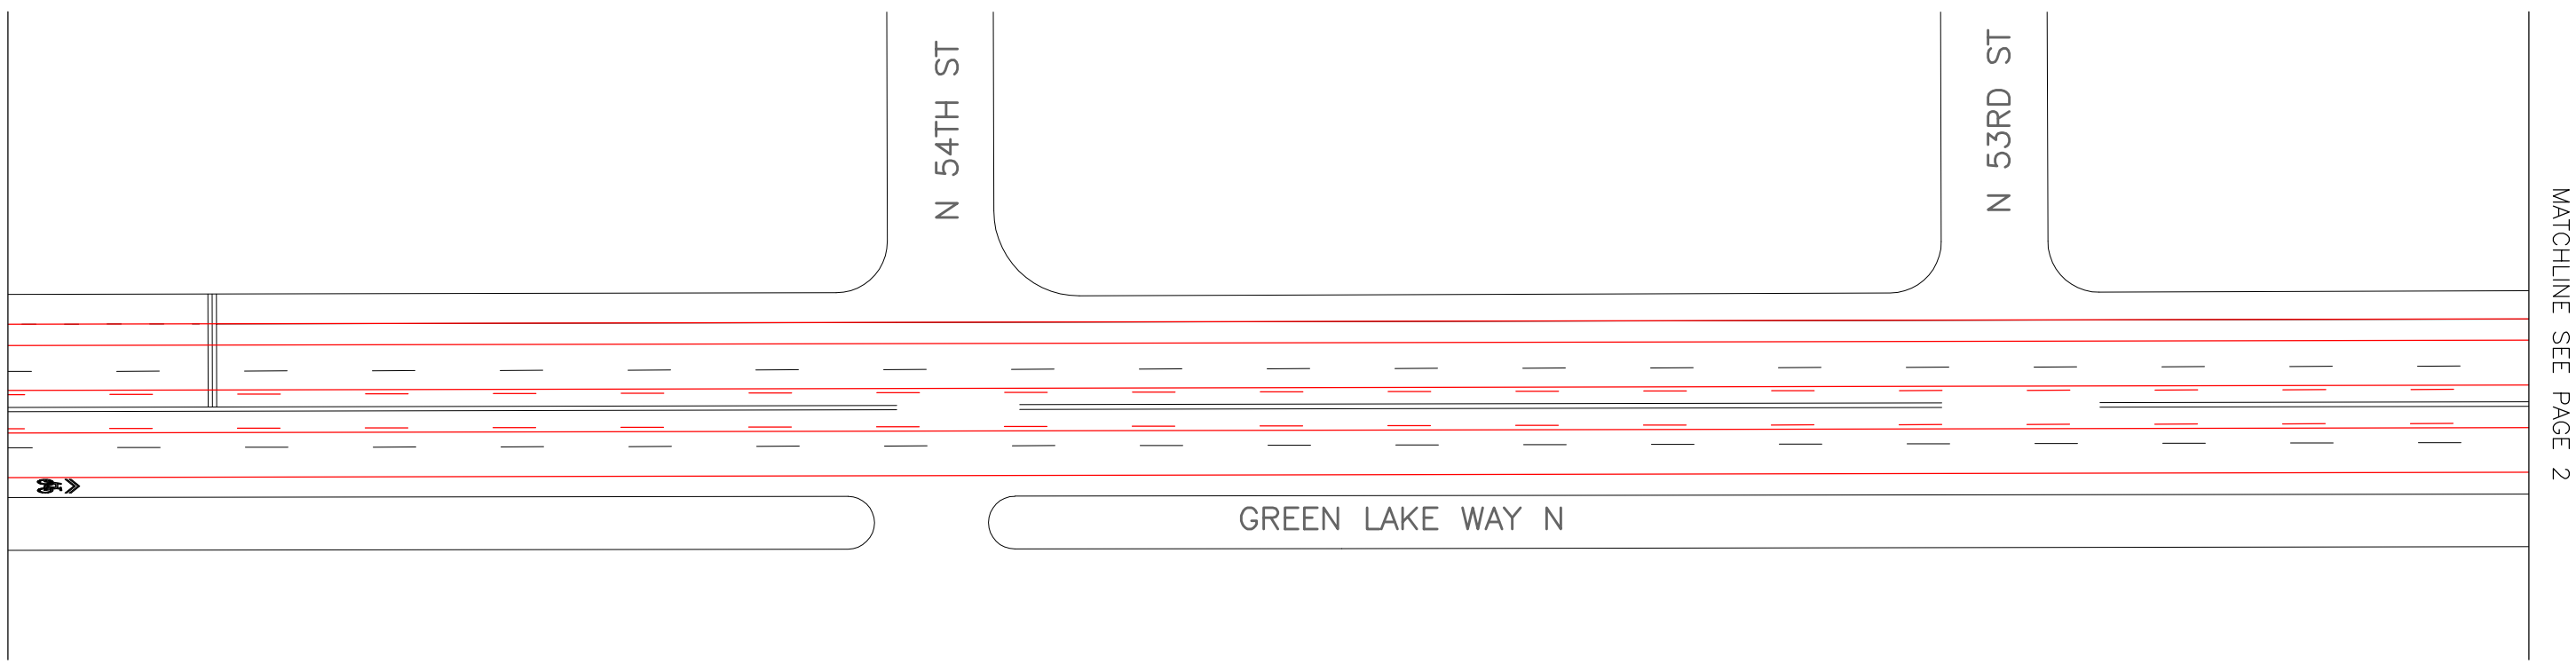

PROPOSED IMPROVEMENTS
CH 1

Q:\Traffic Management\Traffic Operations\Arterial Ops\ReCHANNels\2013\Green Lake Way N\Drawings\GLW N DRAFT_20130617.dwg
Aug/15/2013 11:26am

VAULT SERIAL NO.	REVISIONS			
	MARK	DATE	CHK'D	REV'D
	MADE			
	DESCRIPTION			

40 20 0 40 80
SCALE IN FEET

0 Ø 1
IF THIS BAR DOES NOT MEASURE 1" THEN DRAWING IS NOT PLOTTED TO ORIGINAL SCALE.

APPROVED FOR ADVERTISING
FRED PODESTA
DEPARTMENT OF EXECUTIVE ADMINISTRATION
SEATTLE, WASHINGTON . . . . . 20 . . .

BY: . . . . . .
DIRECTOR, CONTRACTING SERVICES

NAME OR INITIALS AND DATE	INITIALS AND DATE
DESIGNED ARV	REVIEWED:
CHECKED	DES. . . . . CONST. . . . .
	SDOT . . . . . PROJ. MGR. . . .
DRAWN	RECEIVED . . . . .
CHECKED	REVISED AS BUILT . . . . .

ALL WORK DONE IN ACCORDANCE WITH THE CITY OF SEATTLE STANDARD PLANS AND SPECIFI-CATIONS AND OTHER DOCUMENTS CALLED FOR IN SECTION 0-02.3 OF THE PROJECT MANUAL.

City of Seattle
Seattle Department of Transportation

ORDINANCE NO. . . . . APPROVED. . . . . .
FUND: . . . . . .
SCALE: 1"=40' INSPECTOR'S BOOK . . . . . .

GREEN LAKE WAY N

JOB NO.
PC .....
R/W
CO .....

VAULT PLAN NO.
.....

SHEET 1 OF 3

REGION NO.	STATE	FEDERAL AID PROJECT NO.	SHEET NO.
10	WA	####	

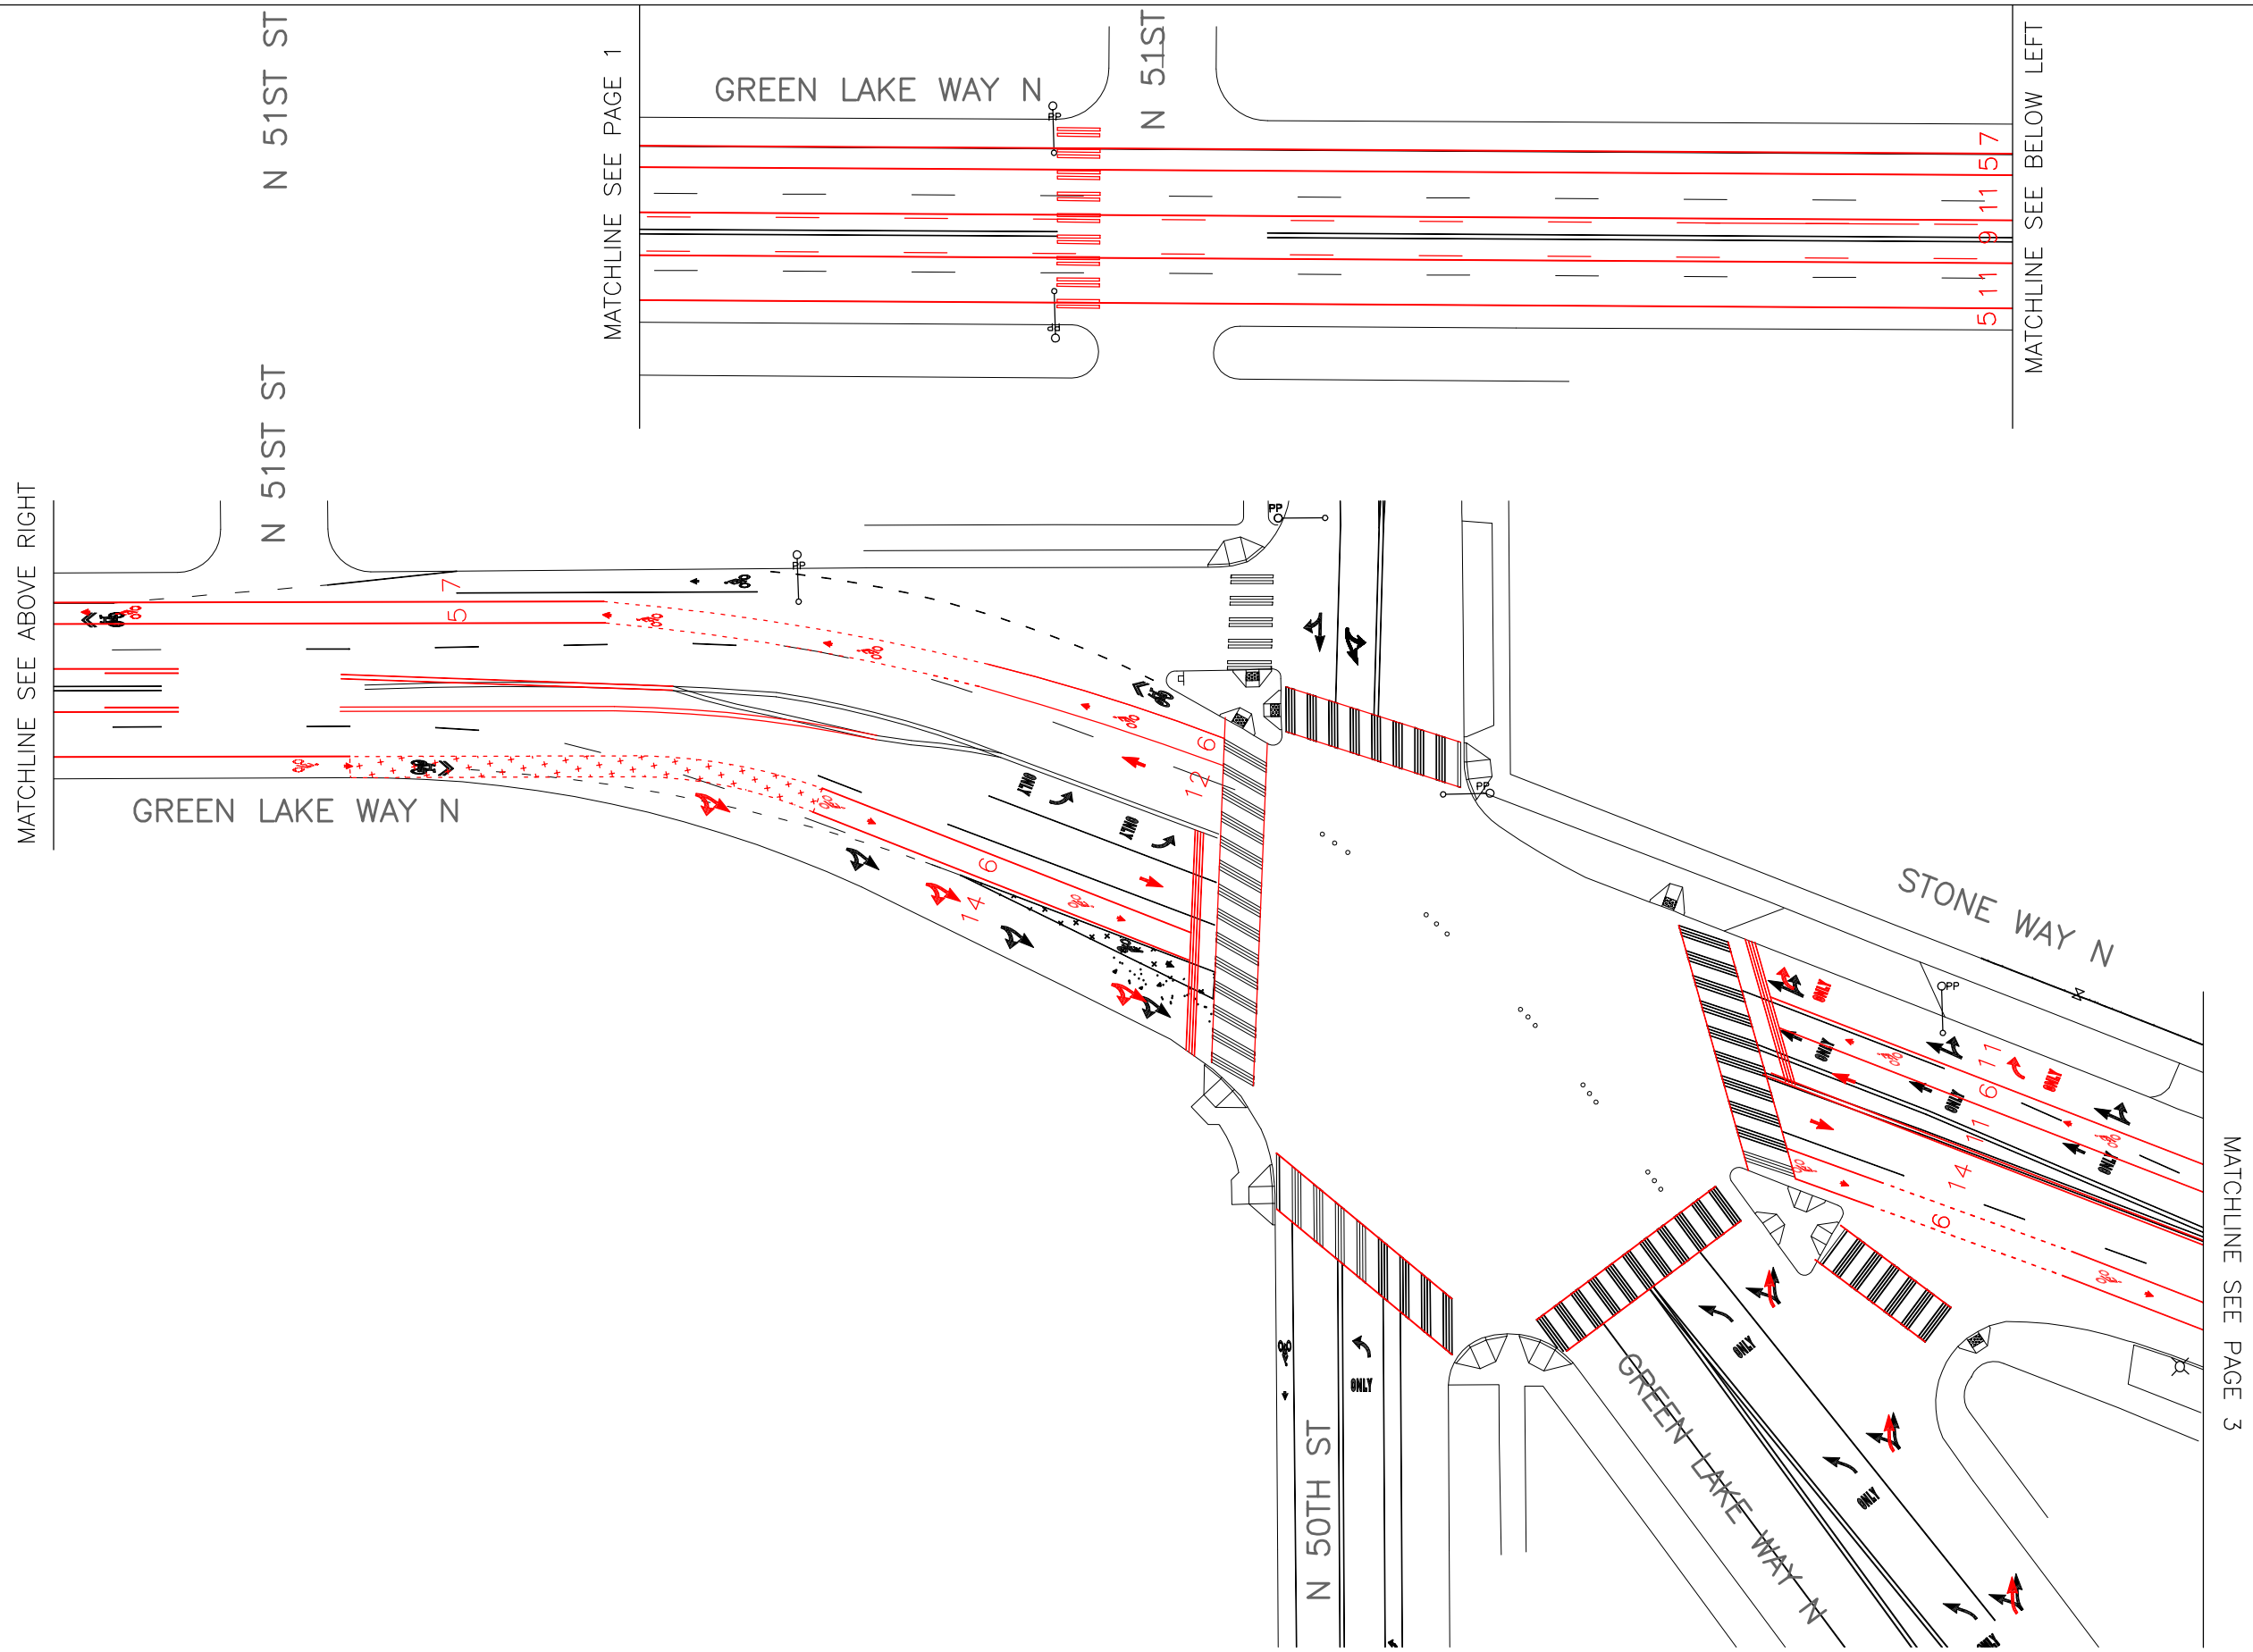

PROPOSED IMPROVEMENTS
CH 2

Q:\Traffic Management\Traffic Operations\Arterial Ops\ReCHANNels\2013\Green Lake Way N\Drawings\GLW N DRAFT_20130617.dwg
Aug/15/2013 11:26am

VAULT SERIAL NO.		
REVISIONS		
MARK	DATE	
MADE	CHK'D	REV'D
DESCRIPTION		

40 20 0 40 80
SCALE IN FEET

0 Ø 1
IF THIS BAR DOES NOT MEASURE 1" THEN DRAWING IS NOT PLOTTED TO ORIGINAL SCALE.

APPROVED FOR ADVERTISING
FRED PODESTA
DEPARTMENT OF EXECUTIVE ADMINISTRATION
SEATTLE, WASHINGTON . . . . . 20 . .

BY: . . . . . .
DIRECTOR, CONTRACTING SERVICES

NAME OR INITIALS AND DATE	INITIALS AND DATE
DESIGNED ARV	REVIEWED: DES. . . . . CONST. . . . . SDOT . . . . . PROJ. MGR. . . .
CHECKED	
DRAWN	RECEIVED
CHECKED	REVISED AS BUILT

ALL WORK DONE IN ACCORDANCE WITH THE CITY OF SEATTLE STANDARD PLANS AND SPECIFI-CATIONS AND OTHER DOCUMENTS CALLED FOR IN SECTION 0-02.3 OF THE PROJECT MANUAL.

City of Seattle
Seattle Department of Transportation

ORDINANCE NO. . . . . APPROVED. . . . . .
FUND: . . . . . .
SCALE: 1"=40' INSPECTOR'S BOOK . . . . . .

GREEN LAKE WAY N

JOB NO.
PC .....
R/W
CO .....

VAULT PLAN NO.
.....

SHEET 2 OF 3

REGION NO.	STATE	FEDERAL AID PROJECT NO.	SHEET NO.
10	WA	####	

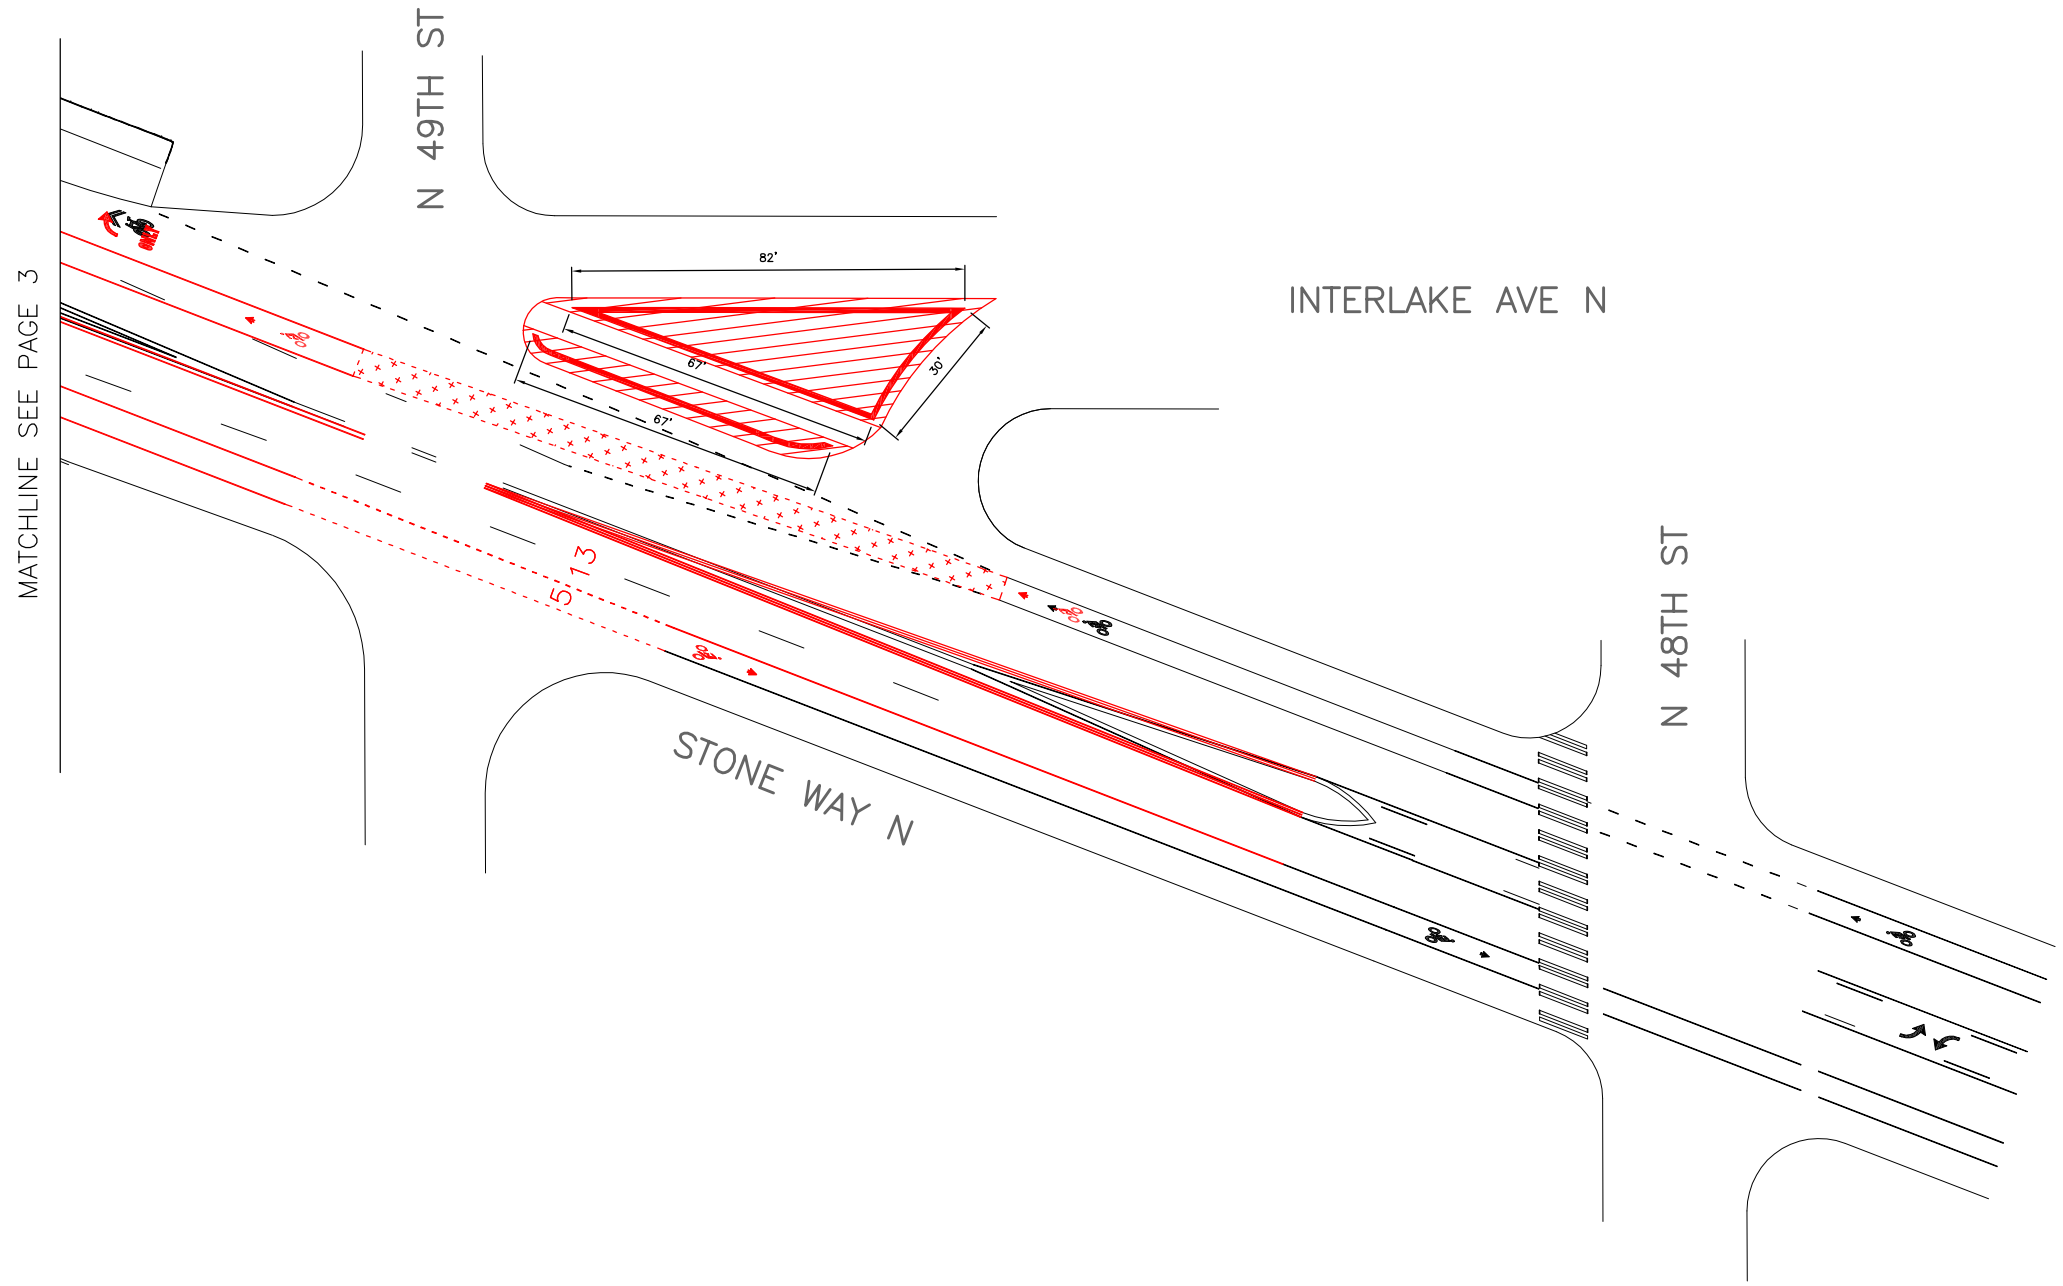

PROPOSED IMPROVEMENTS
CH 3

Q:\Traffic Management\Traffic Operations\Arterial Ops\ReCHANNels\2013\Green Lake Way N\Drawings\GLW N DRAFT_20130617.dwg
Aug/15/2013 11:26am

VAULT SERIAL NO.			
REVISIONS			
MARK	DATE	CHK'D	REV'D
MADE			
DESCRIPTION			

40 20 0 40 80
SCALE IN FEET

0 Ø 1
IF THIS BAR DOES NOT MEASURE 1" THEN DRAWING IS NOT PLOTTED TO ORIGINAL SCALE.

APPROVED FOR ADVERTISING
FRED PODESTA
DEPARTMENT OF EXECUTIVE ADMINISTRATION
SEATTLE, WASHINGTON . . . . . 20 . . .

BY: . . . . . .
DIRECTOR, CONTRACTING SERVICES

NAME OR INITIALS AND DATE	INITIALS AND DATE
DESIGNED ARV	REVIEWED: DES. CONST. SDOT PROJ. MGR.
CHECKED	
DRAWN	RECEIVED
CHECKED	REVISED AS BUILT
ALL WORK DONE IN ACCORDANCE WITH THE CITY OF SEATTLE STANDARD PLANS AND SPECIFICATIONS AND OTHER DOCUMENTS CALLED FOR IN SECTION 0-02.3 OF THE PROJECT MANUAL.	

City of Seattle
Seattle Department of Transportation

ORDINANCE NO. . . . . APPROVED. . . . . .
FUND: . . . . . .
SCALE: 1"=40' INSPECTOR'S BOOK . . . . . .

GREEN LAKE WAY N

JOB NO.
PC .....
R/W
CO .....

VAULT PLAN NO.
.....

SHEET 1 OF 3