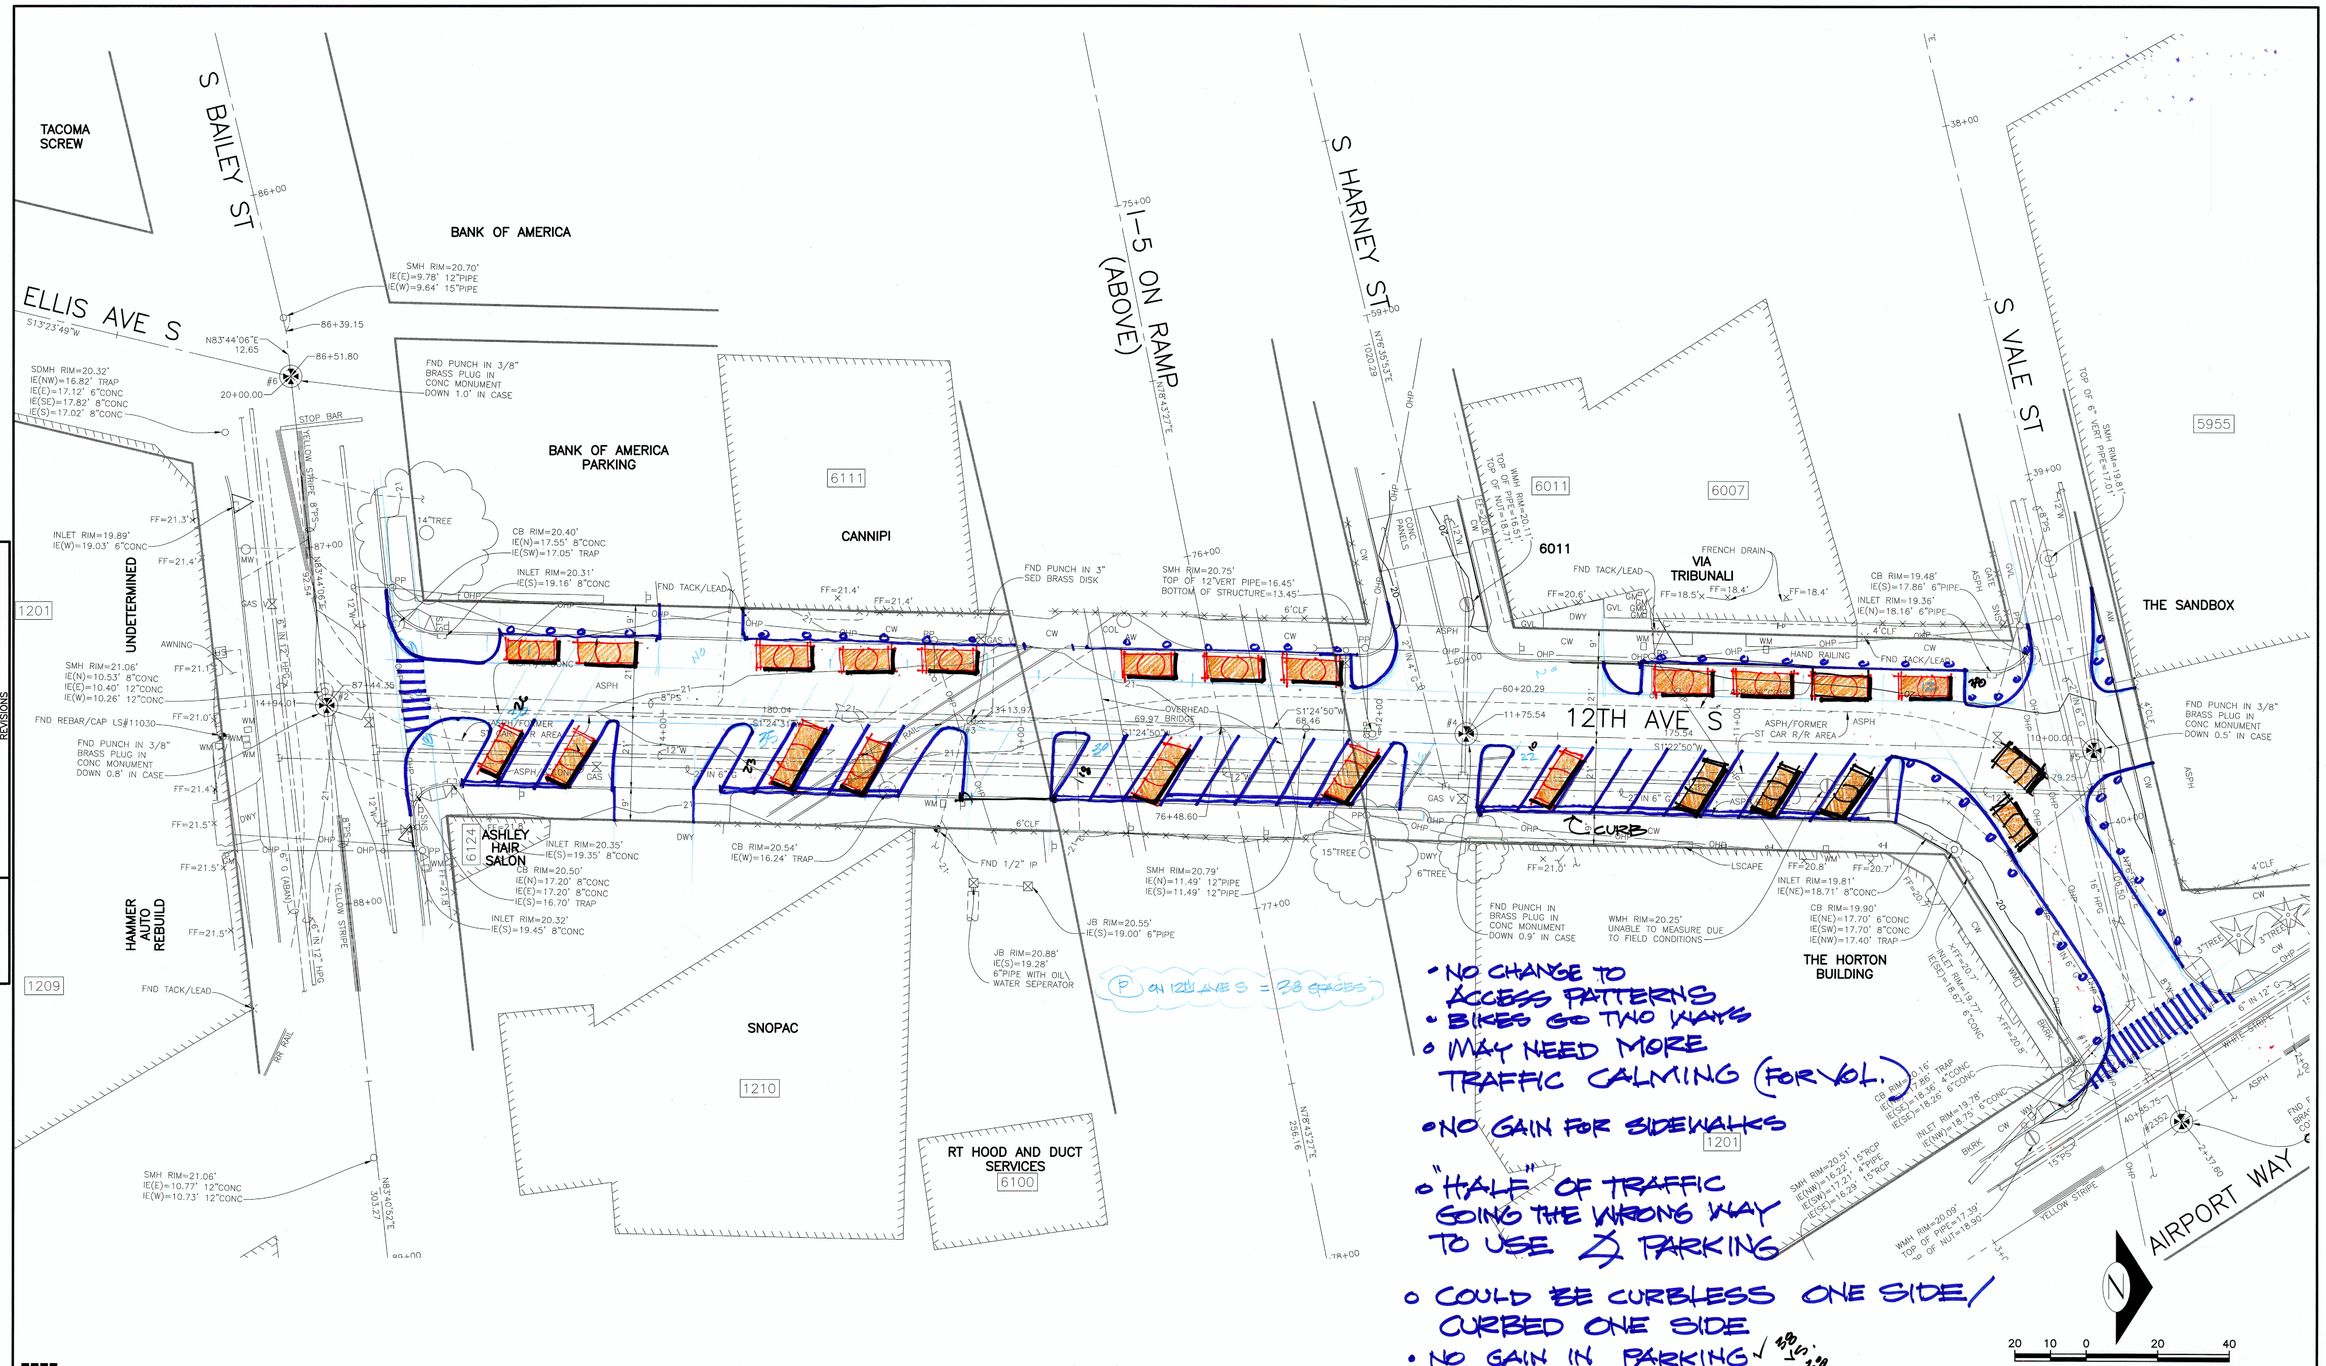

VAULT SERIAL NO.	DATE	MARK	NATURE REVISIONS	MADE	CHK'D	REV'D

K:\project\32300\32348\Dwg\SPU_Titleblock.dwg
charlinef Mar-27-14 11:59am

APPROVED FOR ADVERTISING
NANCY LOCKE
DEPARTMENT OF FINANCE & ADMINISTRATIVE SERVICES
SEATTLE, WASHINGTON 20

BY:
PURCHASING & CONTRACTING SERVICES DIRECTOR

NAME OR INITIALS AND DATE	INITIALS AND DATE
DESIGNED	REVIEWED: DES. CONST. SDOT PROJ. MGR.
CHECKED	
DRAWN DAH	RECEIVED
CHECKED	REVISED AS BUILT

ALL WORK SHALL BE DONE IN ACCORDANCE WITH THE CITY OF SEATTLE STANDARD PLANS AND SPECIFICATIONS AND OTHER DOCUMENTS CALLED FOR IN SECTION 0-02.3 OF THE PROJECT MANUAL.

Seattle Public Utilities
City of Seattle
Ray Hoffman, Director
ORDINANCE NO. APPROVED
FUND:
SCALE: H. 1"=20', V. 1"=10' INSPECTOR'S BOOK

Overall Layout

JOB NO. PC R/W CO
VAULT PLAN NO.
SHEET 1 OF 1

TWO-WAY (PARKING ALIKE ONE SIDE)

5