Property of City of Seattle
777-447-30

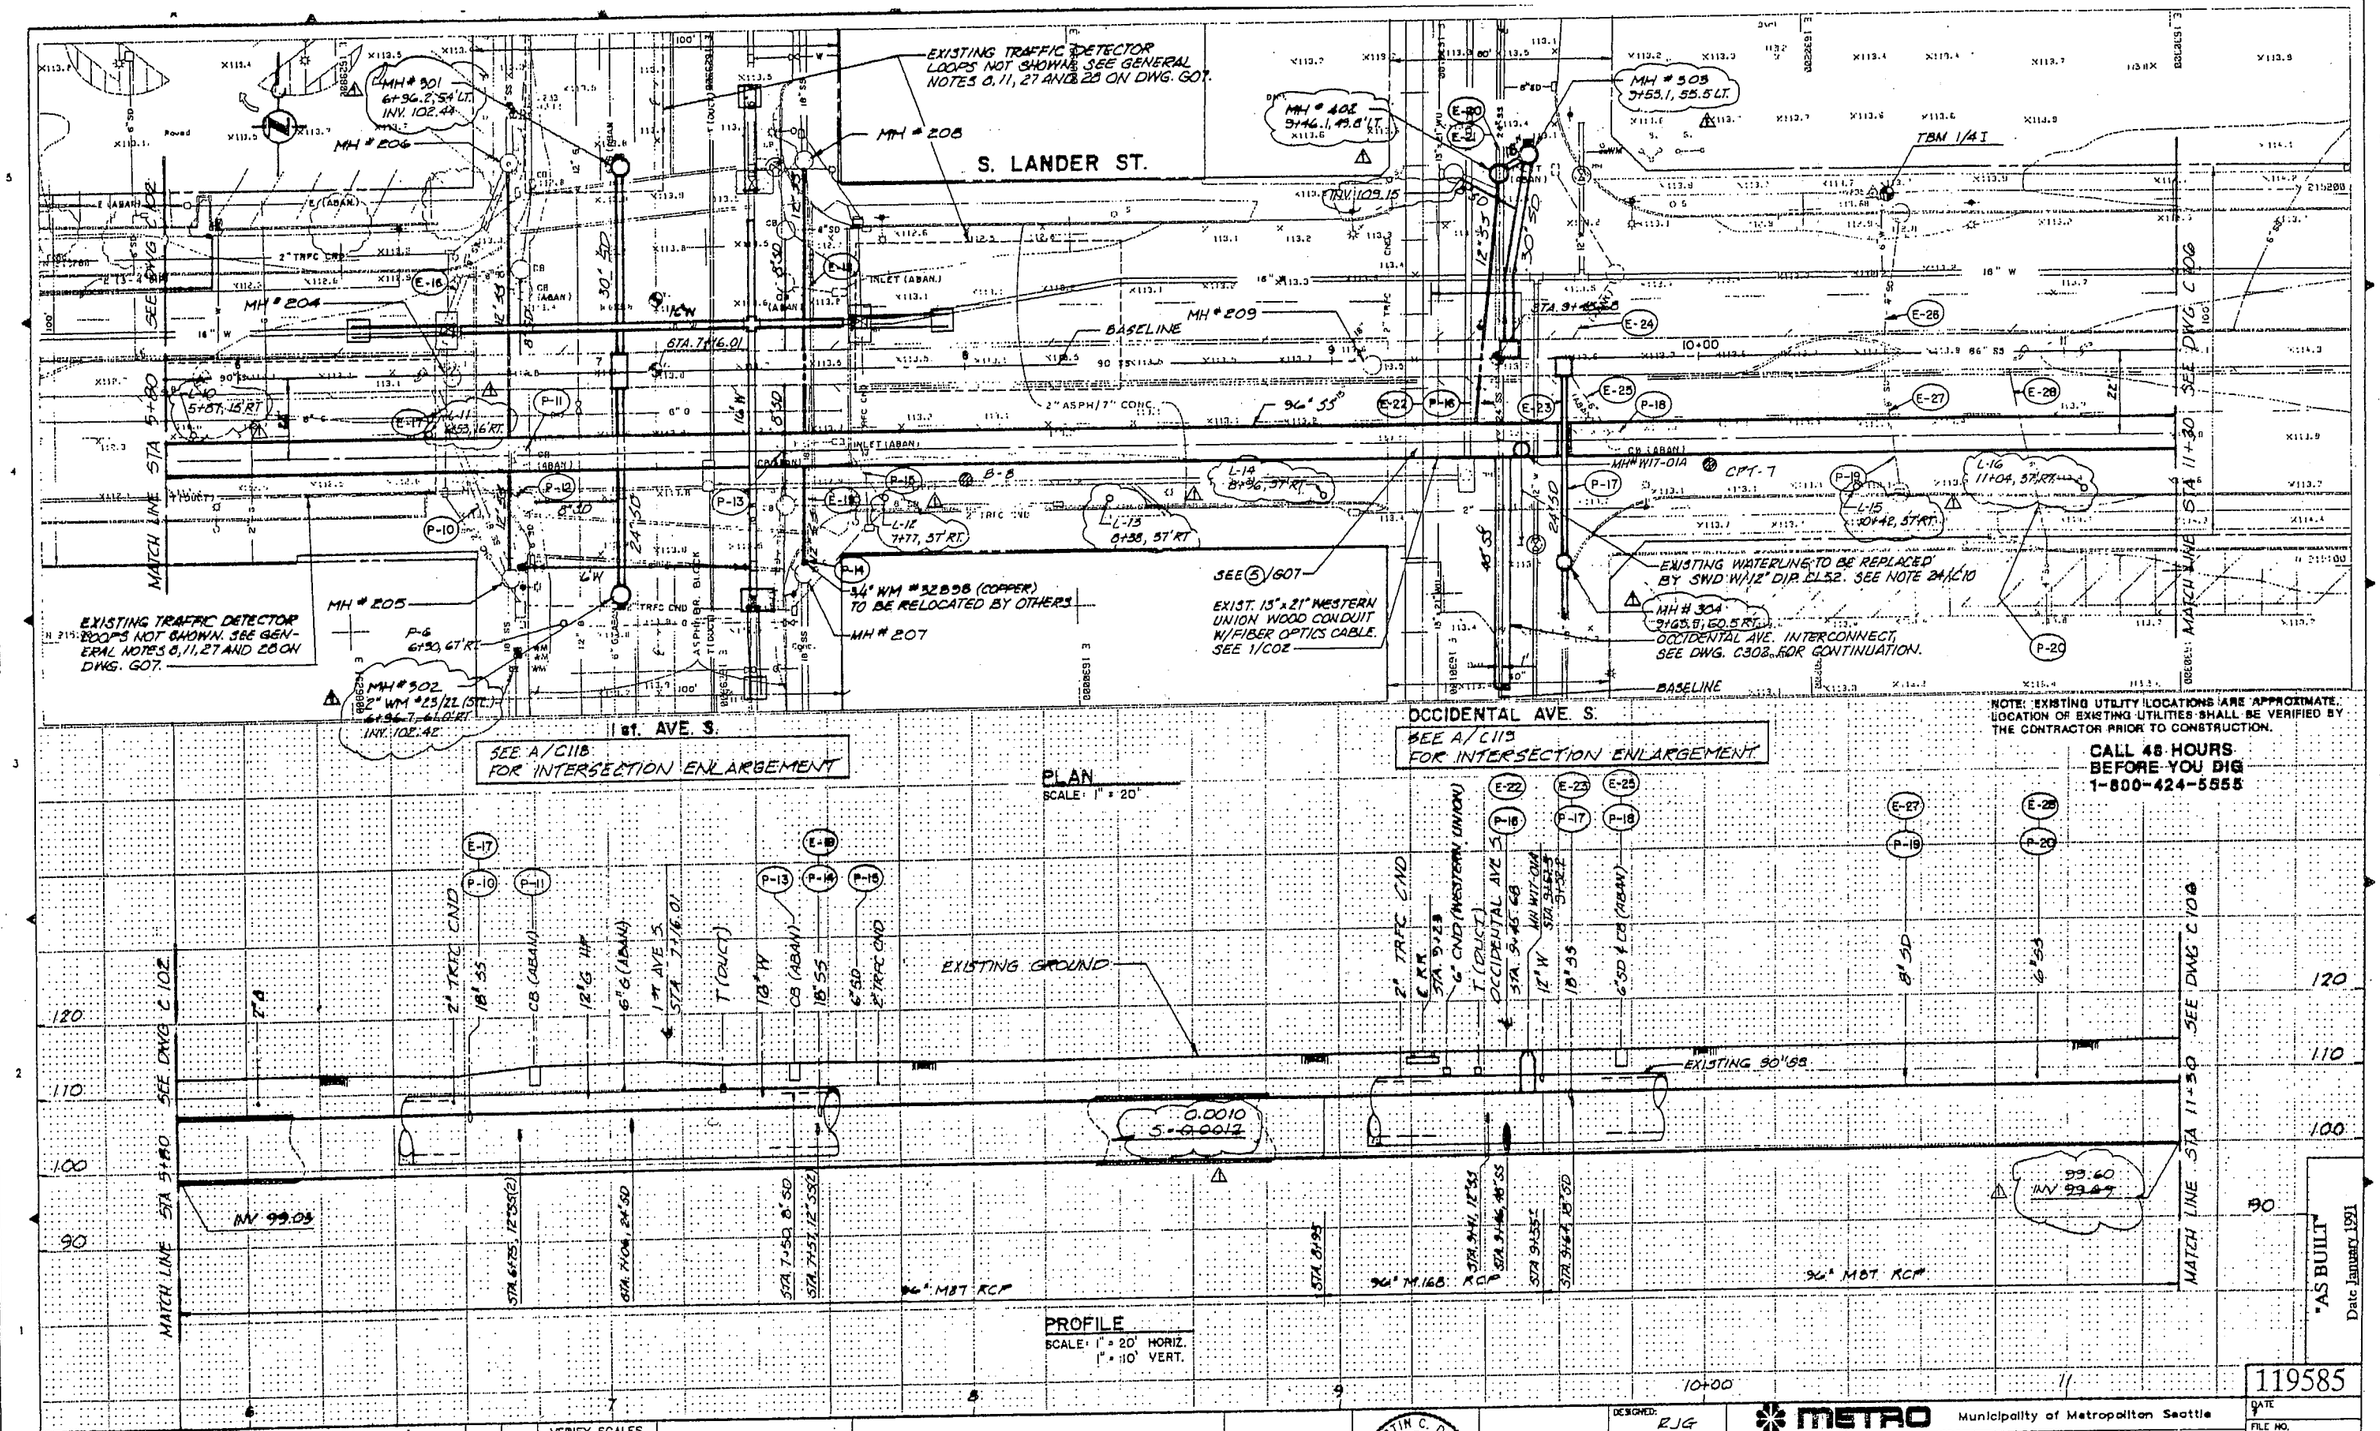

NOTE: EXISTING UTILITY LOCATIONS ARE APPROXIMATE. LOCATION OF EXISTING UTILITIES SHALL BE VERIFIED BY THE CONTRACTOR PRIOR TO CONSTRUCTION.

CALL 48 HOURS BEFORE YOU DIG 1-800-424-5555

"AS BUILT" Date January 1991

OVERLAY IDENTIFICATION				
PROJ NO	COMPOSITE	C104	104A	104B
CONTRACT	OVERLAY	C104	124A	124B
	SCREEN		3	5

NO.	REVISION	BY	DATE
1	AS BUILT - WELL LOCATIONS & MH STATIONING & INVERTS, SLOPE	WAB	11/24/91

VERIFY SCALES
BAR IS ONE INCH ON ORIGINAL DRAWING.
0 1
IF NOT ONE INCH ON THIS SHEET, ADJUST SCALES.

KCM and Associated Firms

MARTIN C. DIRKS — STATE OF WASHINGTON — REGISTERED PROFESSIONAL ENGINEER

DSGN: DRWN: CHKD: RECOMM: APPROVED:

DESIGNED: RJG
DRAWN: TJW CHECKED: BAS
RECOMMENDED:
APPROVED:
SCALE: AS SHOWN
CONTRACT NO: W/F3-89

METRO Municipality of Metropolitan Seattle

LANDER SEPARATION PROJECT PHASE I
PLAN AND PROFILE
STA 5+80 TO STA 11+30

119585
DATE
FILE NO.
777-447
DRAWING NO.
C 104
SHEET 30 OF 117

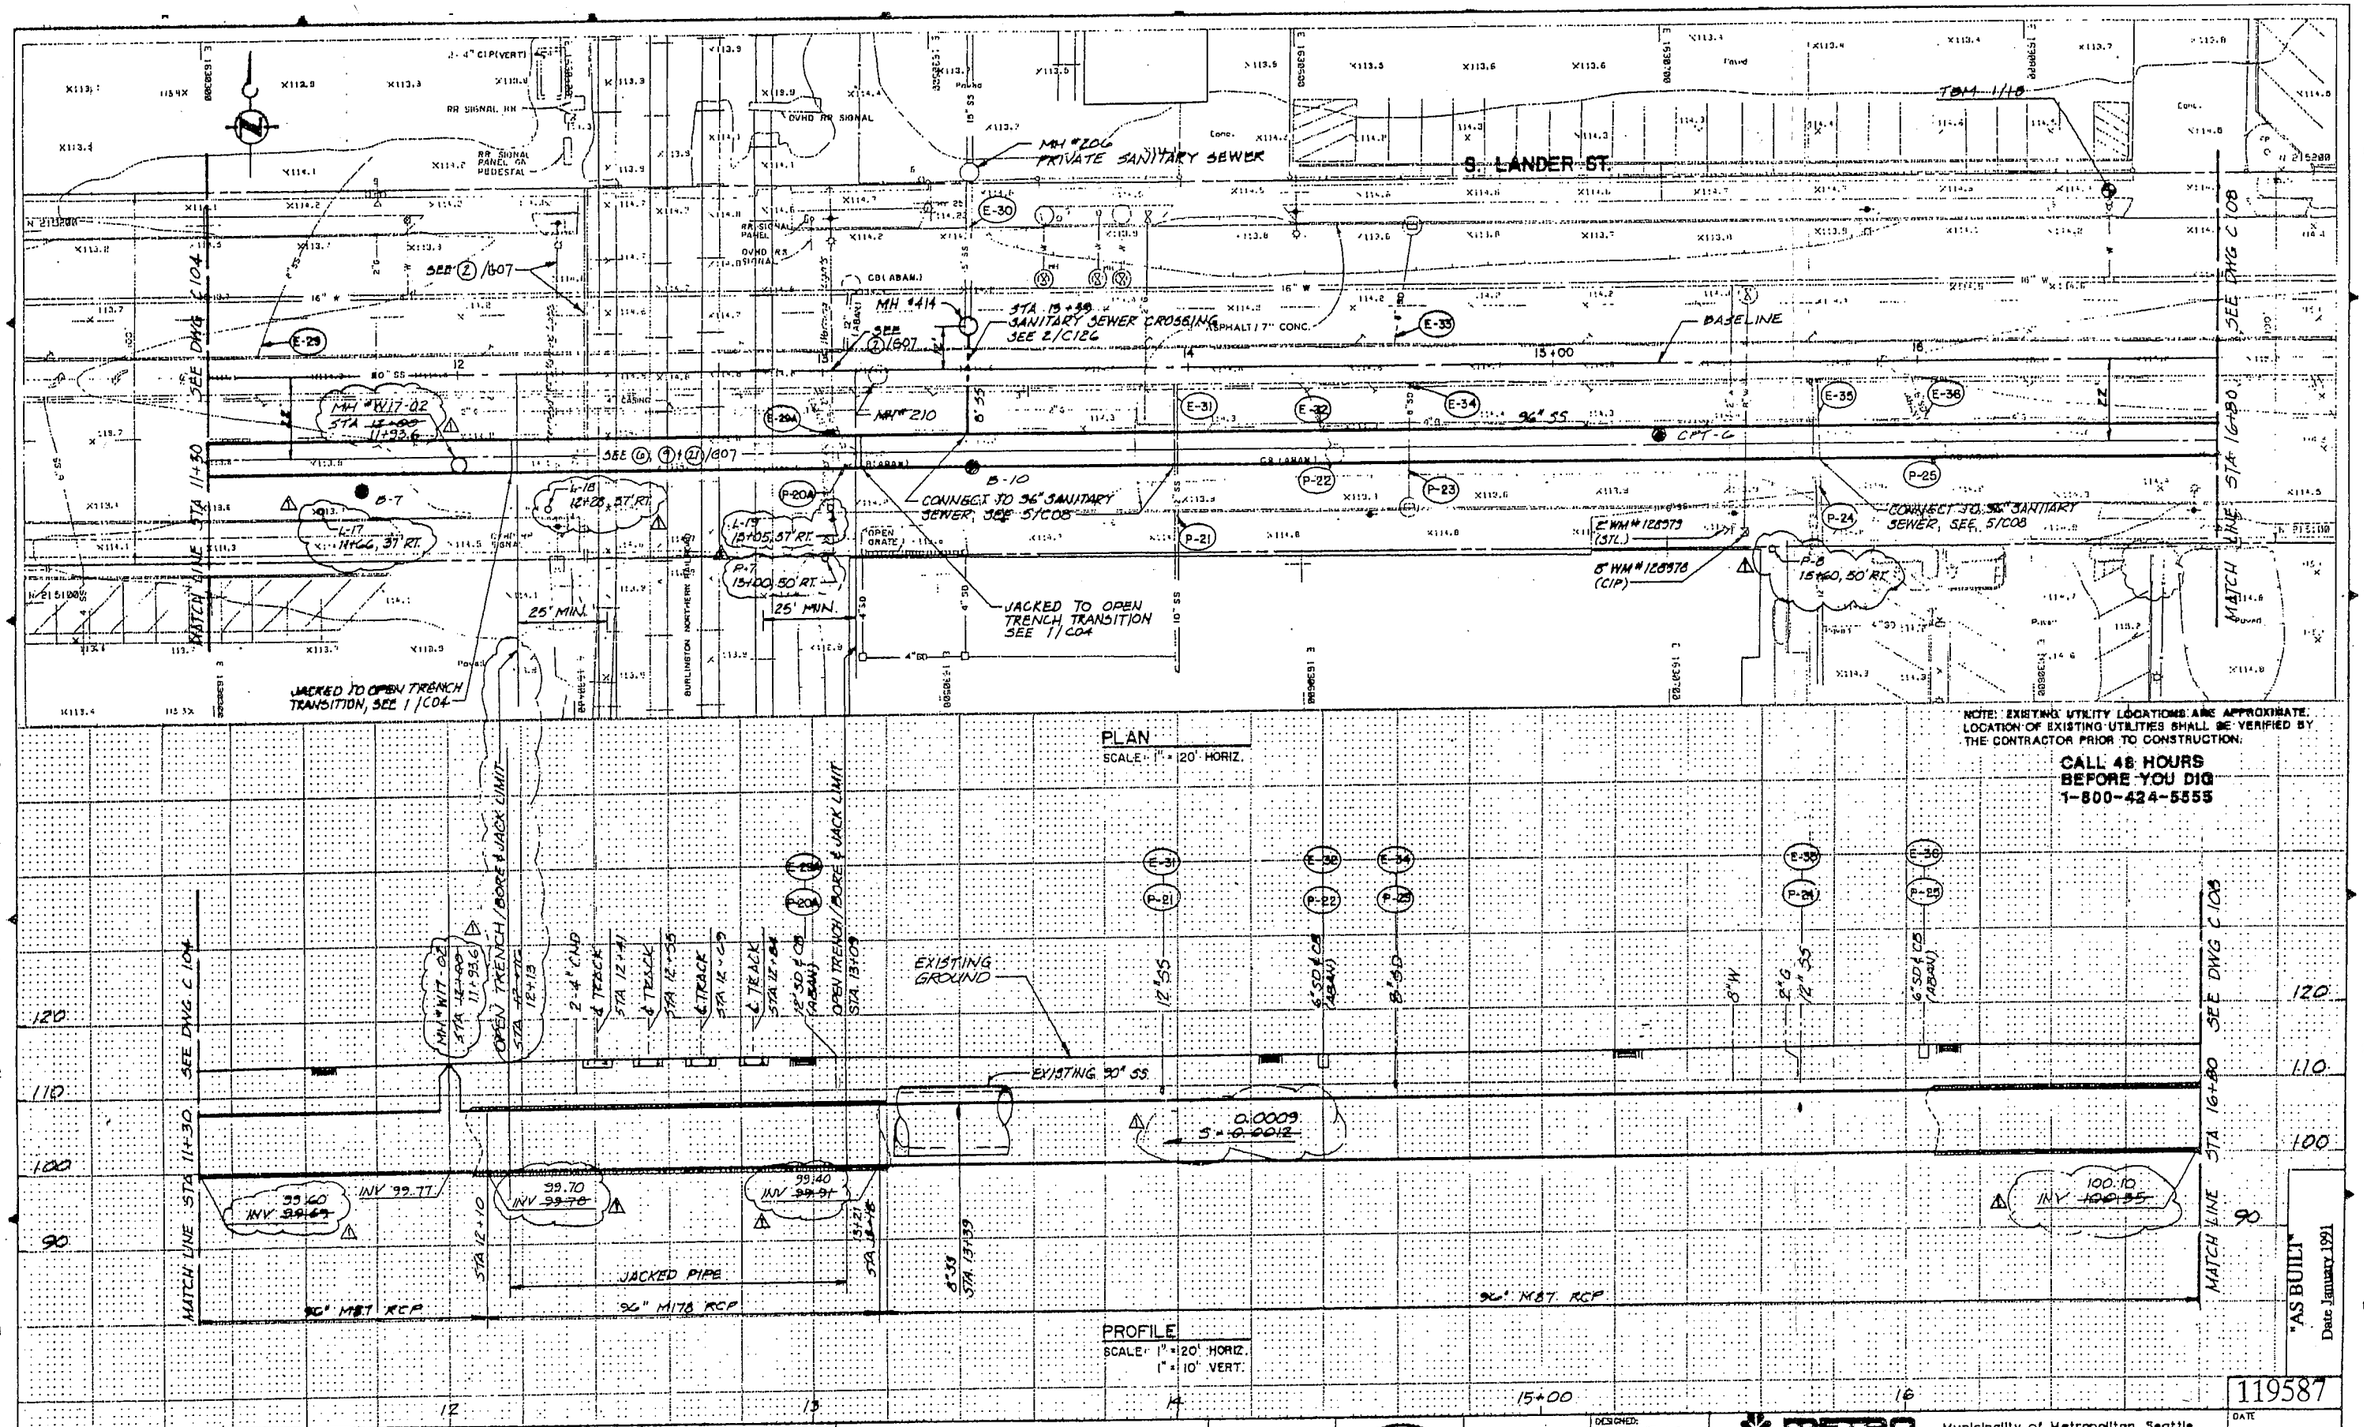

NOTE: EXISTING UTILITY LOCATIONS ARE APPROXIMATE. LOCATION OF EXISTING UTILITIES SHALL BE VERIFIED BY THE CONTRACTOR PRIOR TO CONSTRUCTION.

CALL 48 HOURS BEFORE YOU DIG 1-800-424-5555

"AS BUILT" Date January 1991

119587

Property of City of Seattle 777 447 32

OVERLAY IDENTIFICATION	COMPOSITE	C 106	106 A	106 B
PROJ NO.	OVERLAY	C 106	106 A	106 B
CONTRACT	DGN/M			

NO.	REVISION	BY	DATE
⚠	AS BUILT- JACKED PIPE, WELL LOCATIONS, MH INVERTS & STATIONING, SS CROSSING, SLOPE	WAB	1/24/91

VERIFY SCALES
BAR IS ONE INCH ON ORIGINAL DRAWING.
0 1
IF NOT ONE INCH ON THIS SHEET, ADJUST SCALES.

KCM and Associated Firms

MARTIN C. DIRKS — STATE OF WASHINGTON — REGISTERED PROFESSIONAL ENGINEER

ENGR: ENGR: DIR:

DESIGNED: RJG
DRAWN: THW CHECKED: BAS
RECOMMENDED:
APPROVED:

METRO Municipality of Metropolitan Seattle

SCALE: AS SHOWN
CONTRACT NO: W/F3-89

LANDER SEPARATION PROJECT PHASE I
PLAN AND PROFILE
STA 11+30 TO STA 16+80

DATE
FILE NO.
DRAWING NO. C 106
SHEET 32 OF 117

Property of City of Seattle
777-447-34

OVERLAY IDENTIFICATION				
COMPOSITE	C-108	108A	108B	
OVERLAY	C-108	108A	108B	
SCREEN	S	S	S	
PROJ NO.				
CONTRACT				

S. LANDER ST.

MH # 215

MH # 212

MH # 405
20+44.9, 64.2' LT.

CONNECT EXIST. SIDE SEWER TO NEW SIDE SEWER AND INSTALL 6" CLEANOUT SEE STD. PLAN #280.

ABANDON & FILL SEE 3/C107

MH # 211

STA. 17+56

MATCH LINE STA 16+80 SEE DWG C 108

MH # W17-03
STA 17+55
17+26.8

MH # 404
17+46.5, 50.0' RT.

MH # 305
17+56.4, 53.0' RT.

WATERLINE TO BE REPLACED BY SWD W/12" DIP CL52. SEE NOTE 24/C10

MH # 214

MH # 307
19+55.4, 56.0' RT.

MH # 404
20+31.5, 38.9' LT.

SWD TO KILL 3" SERVICE AND REMOVE EXISTING RING AND COVER.

MH # 306
19+52.7, 62.9' LT.

TEMPORARY THRUST BLOCK, SEE 3/C10

STA 19+86.24

BASELINE

STA 20+00

P-9
20+50, 46' RT.

MH # 216

CPT-10

CPT-9

CONNECT TO 96" SANITARY SEWER, SEE 5/C08

MATCH LINE STA 22+50 SEE DWG C 110

3rd AVE S.

4th AVE S.

SEE A/C120 FOR INTERSECTION ENLARGEMENT

SEE A/C121 FOR INTERSECTION ENLARGEMENT

PLAN
SCALE: 1" = 20' HORIZ.

NOTE: EXISTING UTILITY LOCATIONS ARE APPROXIMATE. LOCATION OF EXISTING UTILITIES SHALL BE VERIFIED BY THE CONTRACTOR PRIOR TO CONSTRUCTION.

CALL 48 HOURS BEFORE YOU DIG 1-800-424-5555

EXISTING GROUND

INV. 100.4

EXISTING 30" SS

INV. ~~100.35~~ 100.10

STA 17+30, 12"SS

STA 17+56, 24"SD

STA 17+56, 8"SD

STA 19+45, 12"SS(R)

STA 19+52, 24"SD

STA 20+30, 16"SS 12"SS

EXISTING 84" SS

0.0014 S=0.0012

INV. ~~101.03~~ 100.90

96" MBT RCP

PROFILE
SCALE: 1" = 20' HORIZ.
1" = 10' VERT.

NO.	REVISION	BY	DATE
⚠	AS BUILT- WELL LOCATIONS, MH # 406, MH STATIONING & PIPE INVERTS, SLOPE	WAB	12/4/91

VERIFY SCALES
BAR IS ONE INCH ON ORIGINAL DRAWING.
0 1
IF NOT ONE INCH ON THIS SHEET, ADJUST SCALES.

KCM and Associated Firms

MARTIN C. DIRKS — STATE OF WASHINGTON — REGISTERED PROFESSIONAL ENGINEER

DESIGNED: RJG
DRAWN: THW CHECKED: MRM
RECOMMENDED:
APPROVED:
SCALE: AS SHOWN
CONTRACT NO: W/F3-89

METRO Municipality of Metropolitan Seattle

LANDER SEPARATION PROJECT PHASE I
PLAN AND PROFILE
STA 16+80 TO STA 22+50

"AS BUILT" Date January 1991

DATE 119589
FILE NO.
DRAWING NO. C 108
SHEET 34 OF 117

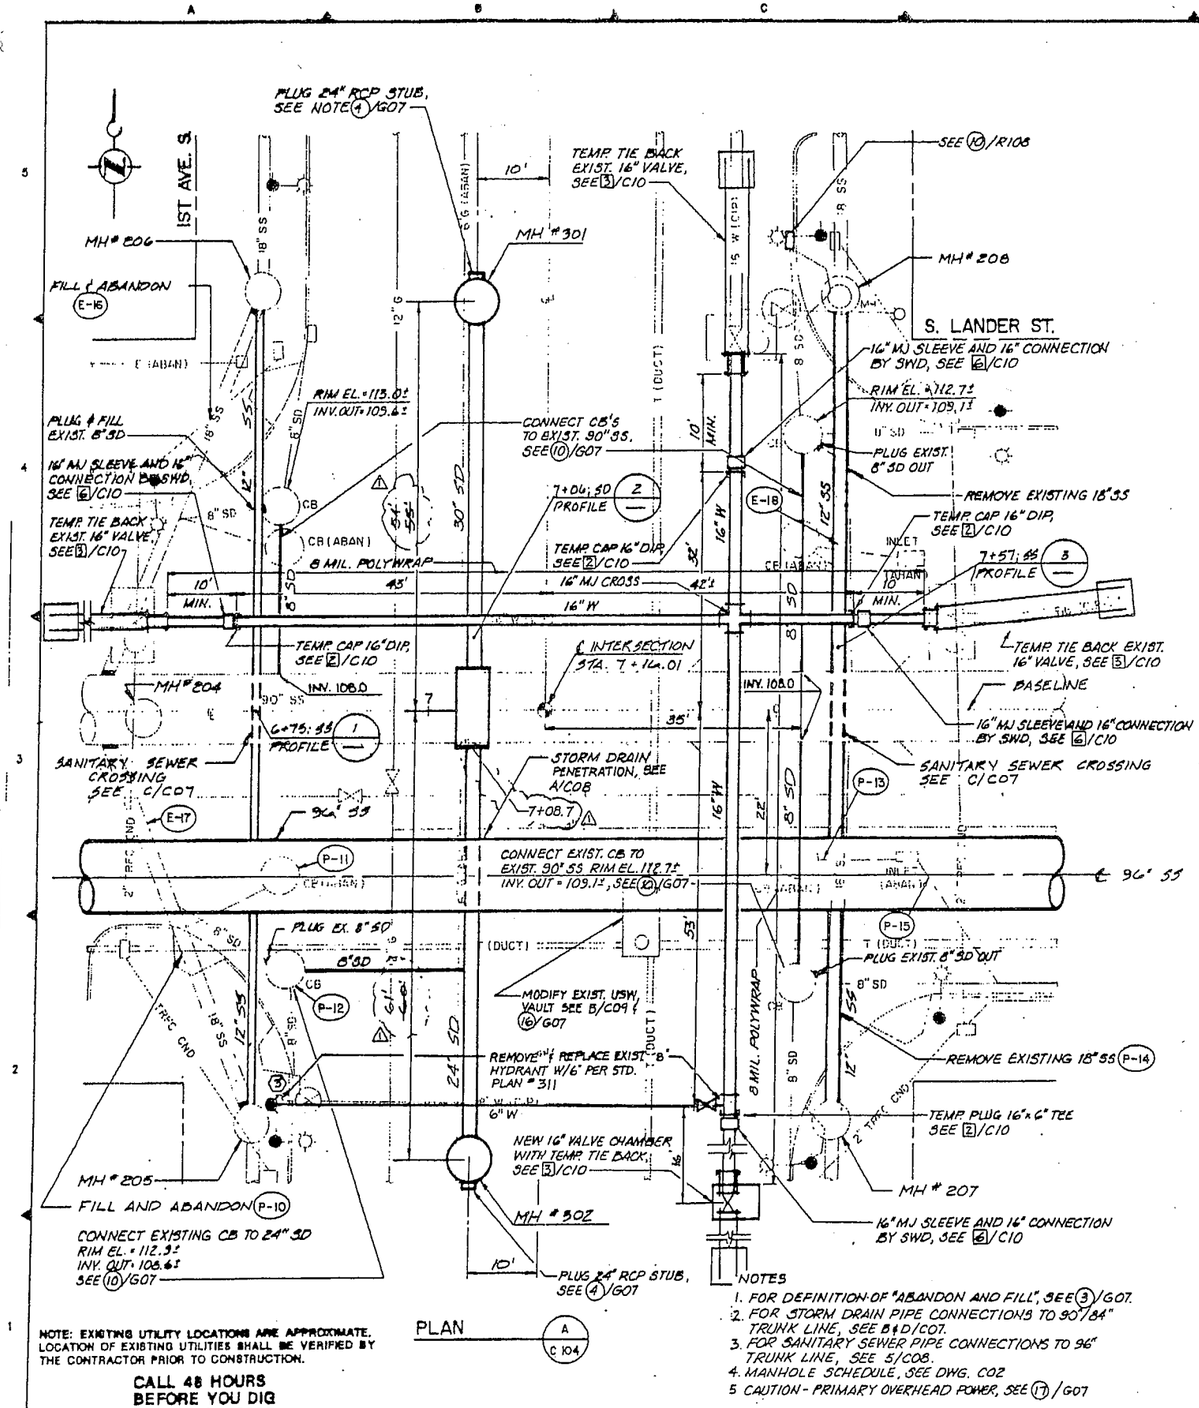

NOTES

1. FOR DEFINITION OF "ABANDON AND FILL", SEE 3/G07.
2. FOR STORM DRAIN PIPE CONNECTIONS TO 90"/84" TRUNK LINE, SEE B & D/C07.
3. FOR SANITARY SEWER PIPE CONNECTIONS TO 96" TRUNK LINE, SEE 5/C08.
4. MANHOLE SCHEDULE, SEE DWG. C02
5. CAUTION - PRIMARY OVERHEAD POWER, SEE 11/G07

NOTE: EXISTING UTILITY LOCATIONS ARE APPROXIMATE. LOCATION OF EXISTING UTILITIES SHALL BE VERIFIED BY THE CONTRACTOR PRIOR TO CONSTRUCTION.

CALL 48 HOURS BEFORE YOU DIG 1-800-424-5555

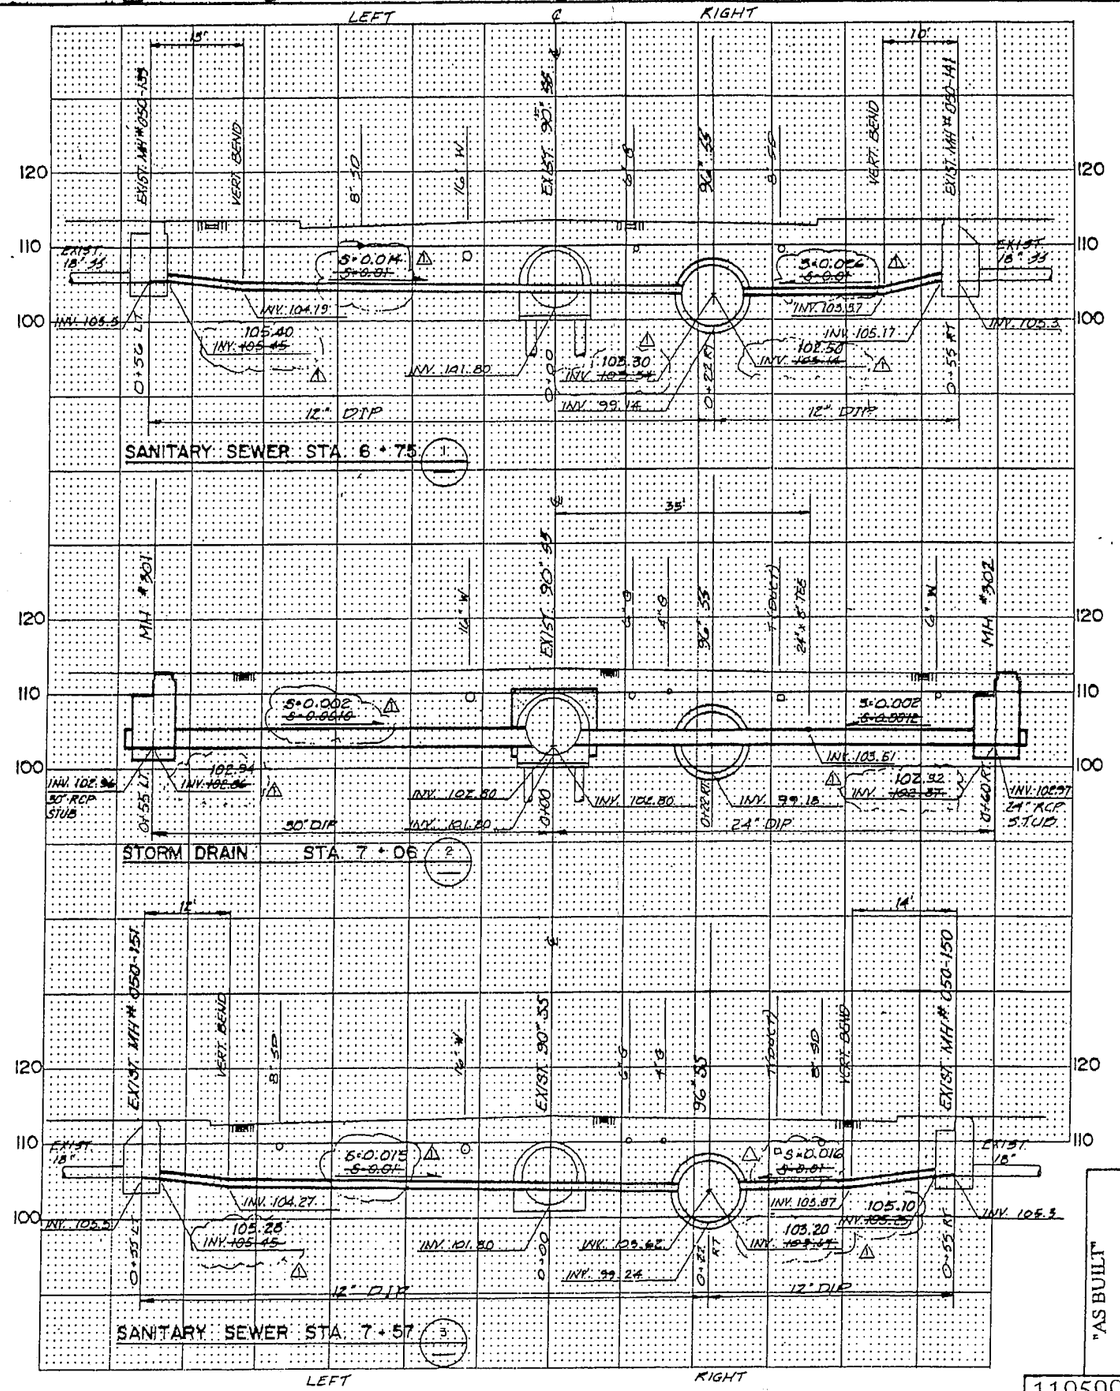

"AS BUILT" Date January 1991

NO.	REVISION	BY	DATE
1	AS BUILT- DIMENSIONS, STATIONS, INVERTS	WAB	1/24/91

VERIFY SCALES
BAR IS ONE INCH ON ORIGINAL DRAWING.
0 1
IF NOT ONE INCH ON THIS SHEET, ADJUST SCALES.

KCM and Associated Firms

MARTIN C. DINKS — REGISTERED PROFESSIONAL ENGINEER — STATE OF WASHINGTON

ENGR: DIR:

DESIGNED: RJG
DRAWN: TWP CHECKED: DDG
RECOMMENDED: R. Juarez
APPROVED: Mark Isham

METRO Municipality of Metropolitan Seattle

SCALE: 1"= 10' VERT. & HORIZ.
CONTRACT NO. W/F3-89

LANDER SEPARATION PROJECT PHASE I
1ST AVE. S. INTERSECTION
PLAN AND SECTIONS

119599
DATE
FILE NO.
DWG. NO. 17.7-447
DRAWING NO. C 118
SHEET 44 OF 117

OVERLAY IDENTIFICATION
PROJ NO. C-118 C-118-A
CONTRACT
COMPOSITE
OVERLAY
SCREEN

Property of City of Seattle 777-447.44

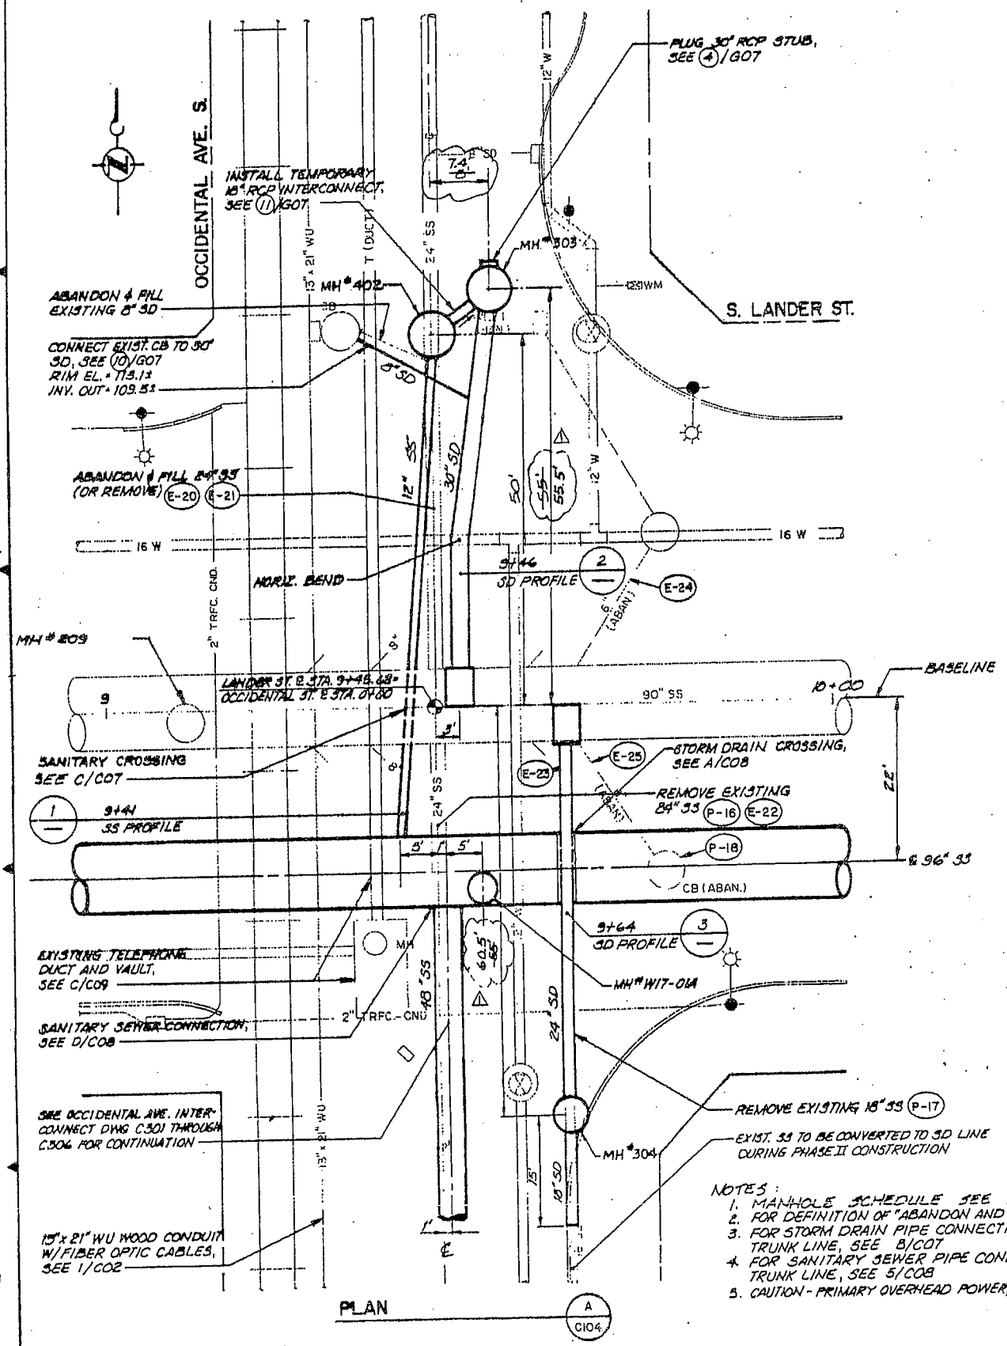

NOTES:
1. MANHOLE SCHEDULE SEE DRAWING C02.
2. FOR DEFINITION OF "ABANDON AND FILL, SEE (3)/G07.
3. FOR STORM DRAIN PIPE CONNECTIONS TO 90"/84" TRUNK LINE, SEE B/C07.
4. FOR SANITARY SEWER PIPE CONNECTIONS TO 96" TRUNK LINE, SEE 5/C08.
5. CAUTION - PRIMARY OVERHEAD POWER, SEE (7)/G07.

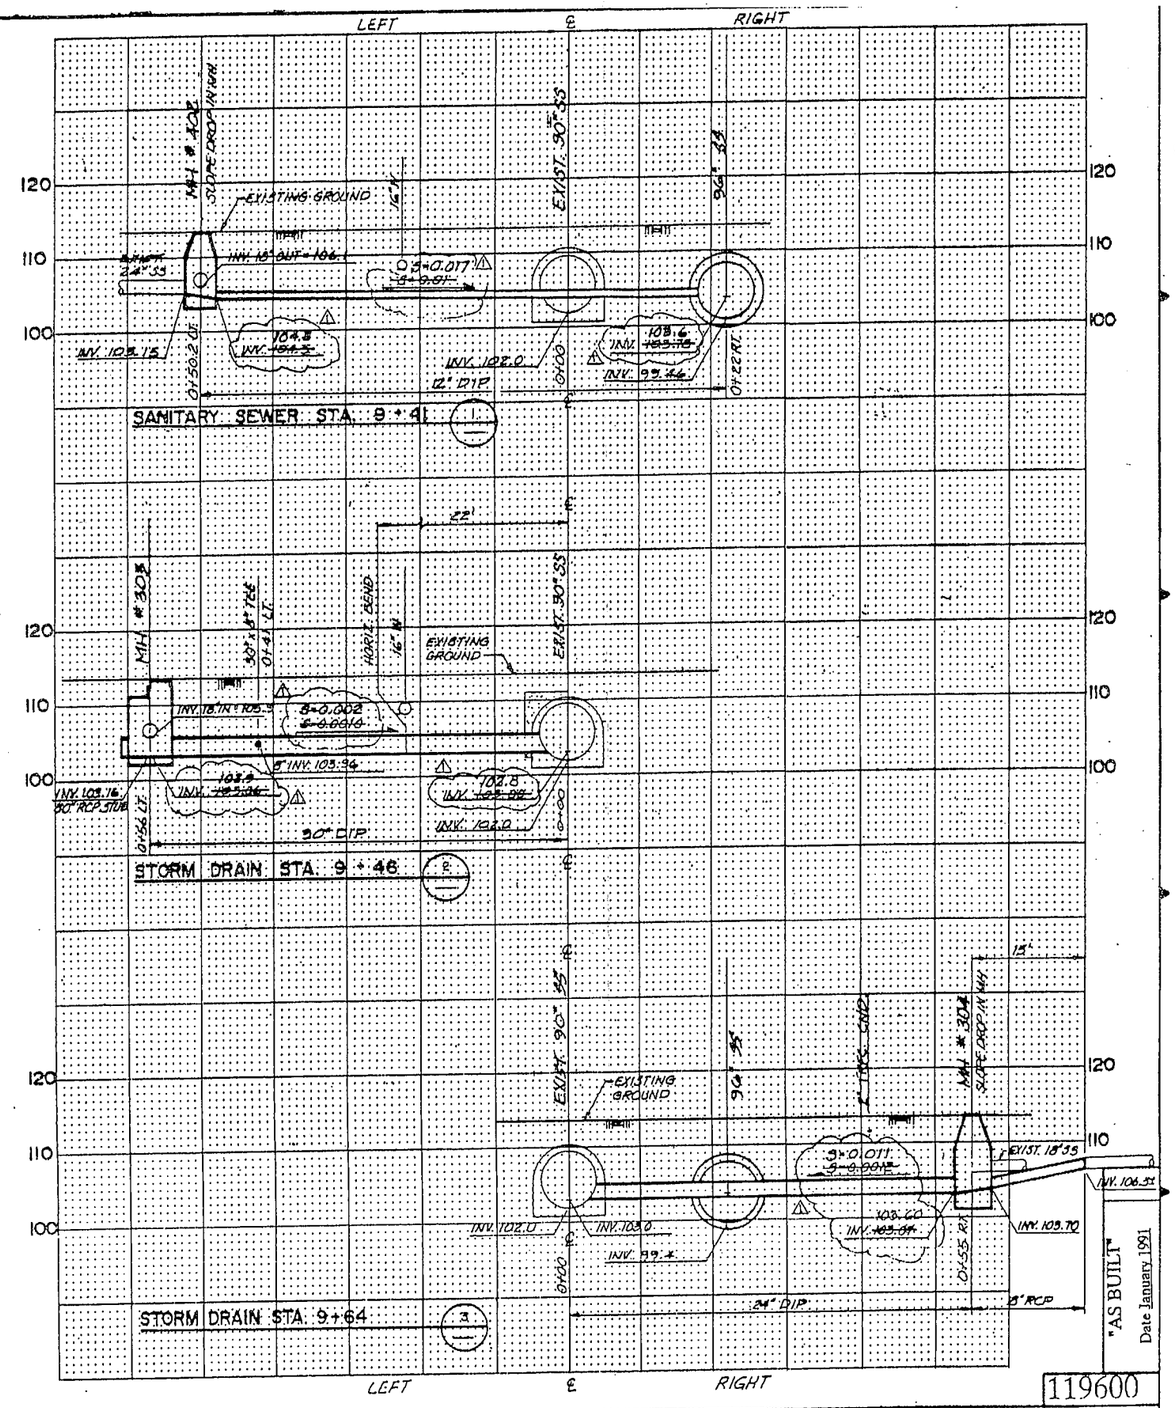

NO.	REVISION	BY	DATE
1	AS BUILT - DIMENSIONS, INVERTS, SLOPES	WAB	1/24/91

VERIFY SCALES
BAR IS ONE INCH ON ORIGINAL DRAWING.
0 1
IF NOT ONE INCH ON THIS SHEET, ADJUST SCALES.

KCM and Associated Firms

MARTIN C. DIRKS — STATE OF WASHINGTON — REGISTERED PROFESSIONAL ENGINEER

ENGR: ENGR: DIR:

DESIGNED: RJG
DRAWN: TWP CHECKED: DDG
RECOMMENDED:
APPROVED:

METRO — Municipality of Metropolitan Seattle

SCALE: 1" = 10' VERT & HORIZ.
CONTRACT NO: W/F3-89

LANDER SEPARATION PROJECT PHASE I
OCCIDENTAL AVE. S. INTERSECTION
PLAN AND SECTIONS

119600
DATE
FILE NO.
DRAWING NO. C 119
SHEET 45 OF 117

"AS BUILT" Date January 1991

DISPLAY IDENTIFICATION: PROJ NO. 119-A; CONTRACT 119-S
COMPOSITE C119; OVERLAY C119; SCREEN

Property of City of Seattle
777-447-45

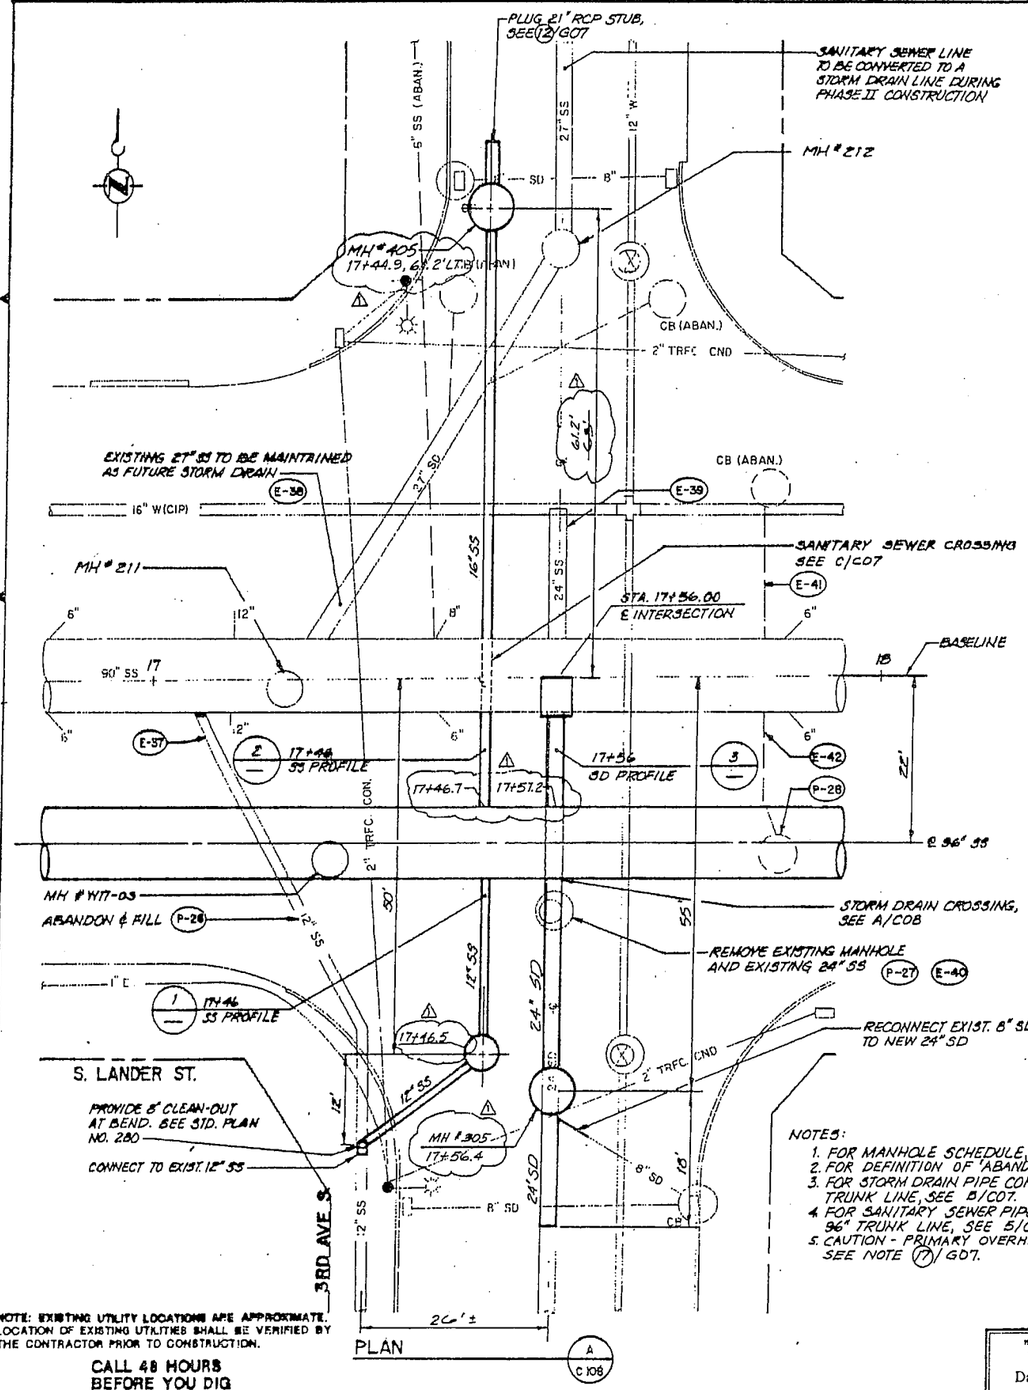

NOTES:
1. FOR MANHOLE SCHEDULE, SEE DRAWING C02.
2. FOR DEFINITION OF 'ABANDON & FILL' SEE (3)/G07
3. FOR STORM DRAIN PIPE CONNECTIONS TO 30"/24" TRUNK LINE, SEE B/C07.
4. FOR SANITARY SEWER PIPE CONNECTIONS TO 96" TRUNK LINE, SEE 5/C08.
5. CAUTION - PRIMARY OVERHEAD POWER LINES. SEE NOTE (7)/G07.

NOTE: EXISTING UTILITY LOCATIONS ARE APPROXIMATE. LOCATION OF EXISTING UTILITIES SHALL BE VERIFIED BY THE CONTRACTOR PRIOR TO CONSTRUCTION.

CALL 48 HOURS BEFORE YOU DIG 1-800-424-5555

"AS BUILT"
Date January 1991

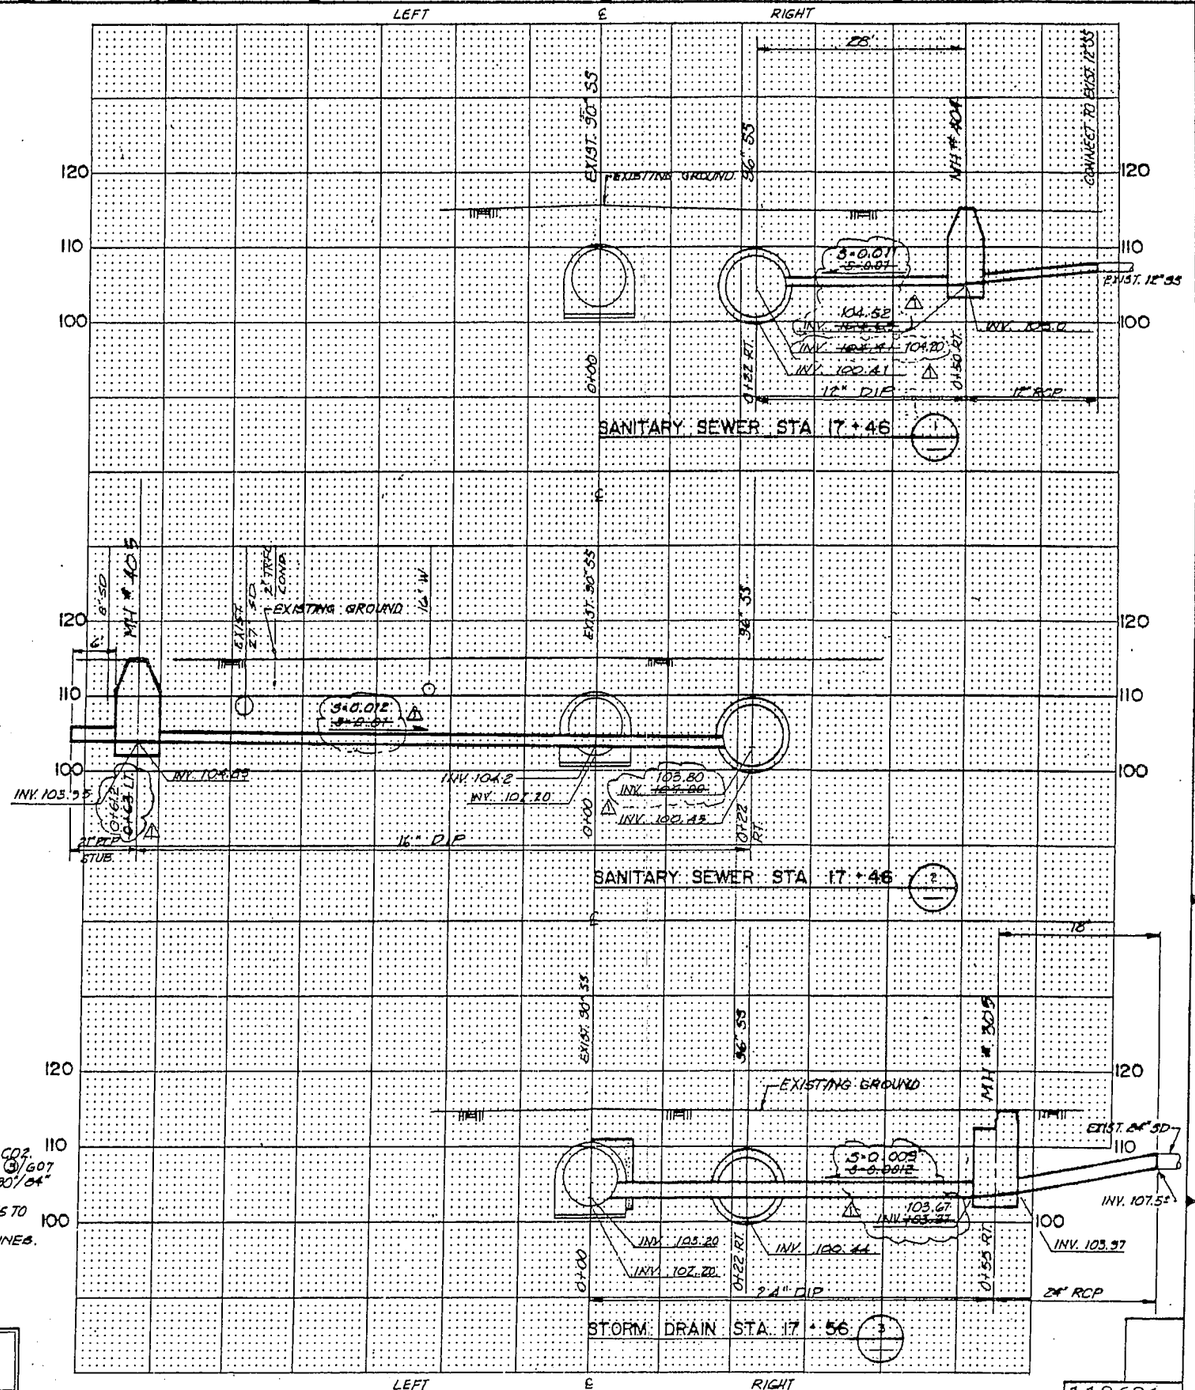

OVERLAY IDENTIFICATION	PROJ NO.	CONTRACT
COMPOSITE	C-120	
OVERLAY	C-120	
SCREEN		

NO.	REVISION	BY	DATE
⚠	AS BUILT-DIMENSIONS, STATIONING, INVERTS, SLOPES	WAB	1/31/91

VERIFY SCALES
BAR IS ONE INCH ON ORIGINAL DRAWING.
0 1
IF NOT ONE INCH ON THIS SHEET, ADJUST SCALES.

KCM and Associated Firms

MARTIN C. DIRKS REGISTERED PROFESSIONAL ENGINEER STATE OF WASHINGTON

DESIGNED: RJG
DRAWN: TWP CHECKED:
RECOMMENDED:
APPROVED:

METRO Municipality of Metropolitan Seattle

SCALE: 1"= 10' VERT. & HORIZ.
CONTRACT NO: W/F3-89

LANDER SEPARATION PROJECT PHASE I
3RD AVE. S. INTERSECTION PLAN AND SECTIONS

119601
DATE
FILE NO. FF7-447
DRAWING NO. C 120

Property of City of Seattle
777-447-46

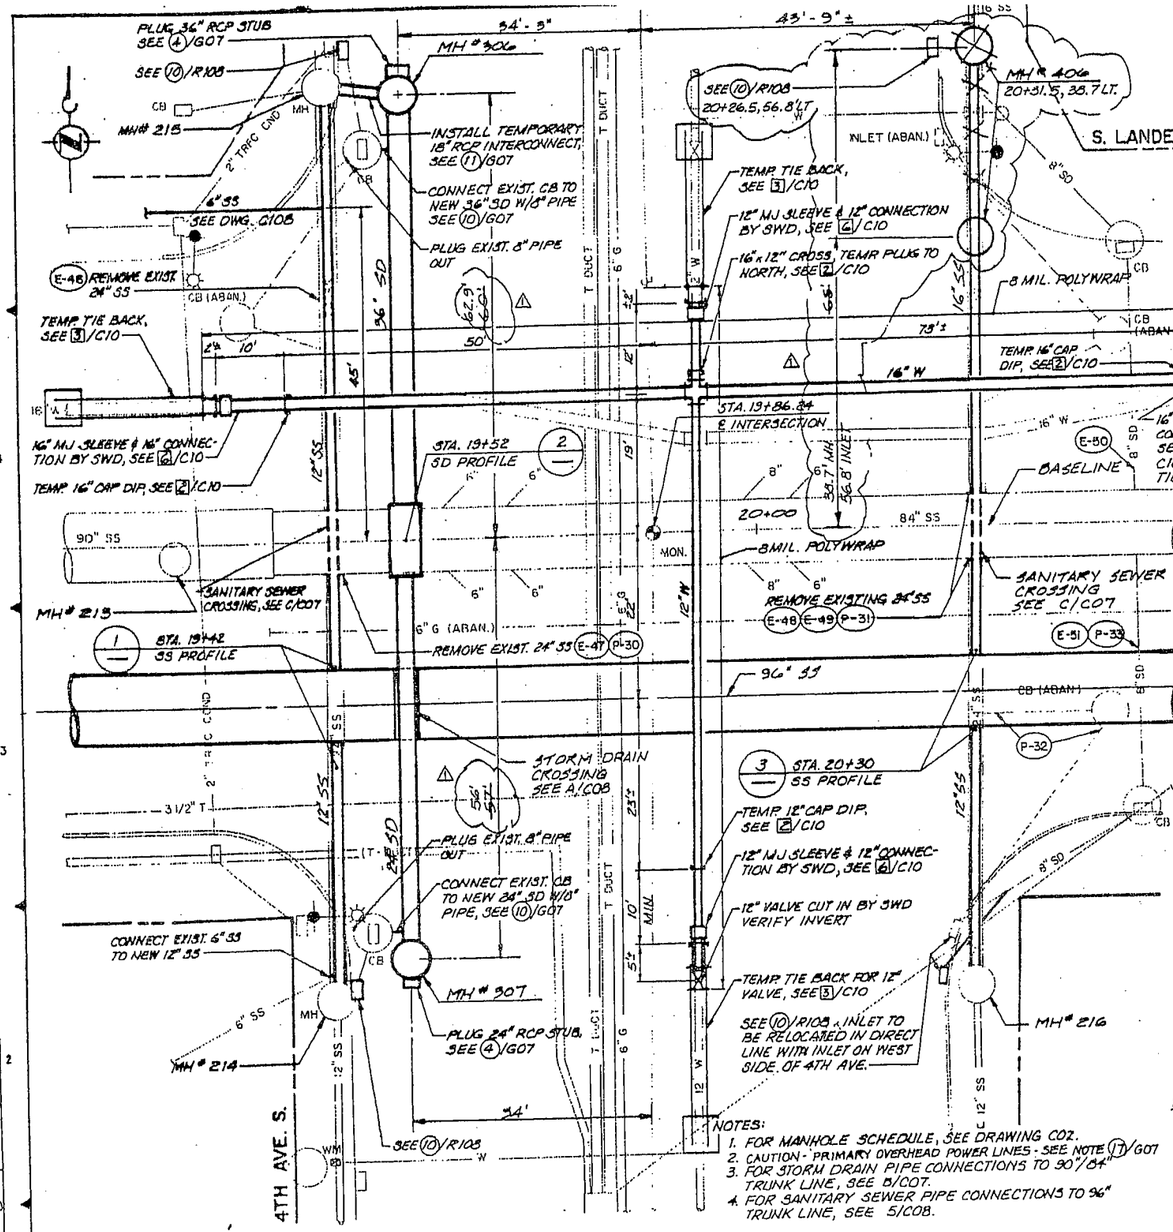

NOTE: EXISTING UTILITY LOCATIONS ARE APPROXIMATE. LOCATION OF EXISTING UTILITIES SHALL BE VERIFIED BY THE CONTRACTOR PRIOR TO CONSTRUCTION.

CALL 48 HOURS BEFORE YOU DIG 1-800-424-5555

PLAN A / C 108

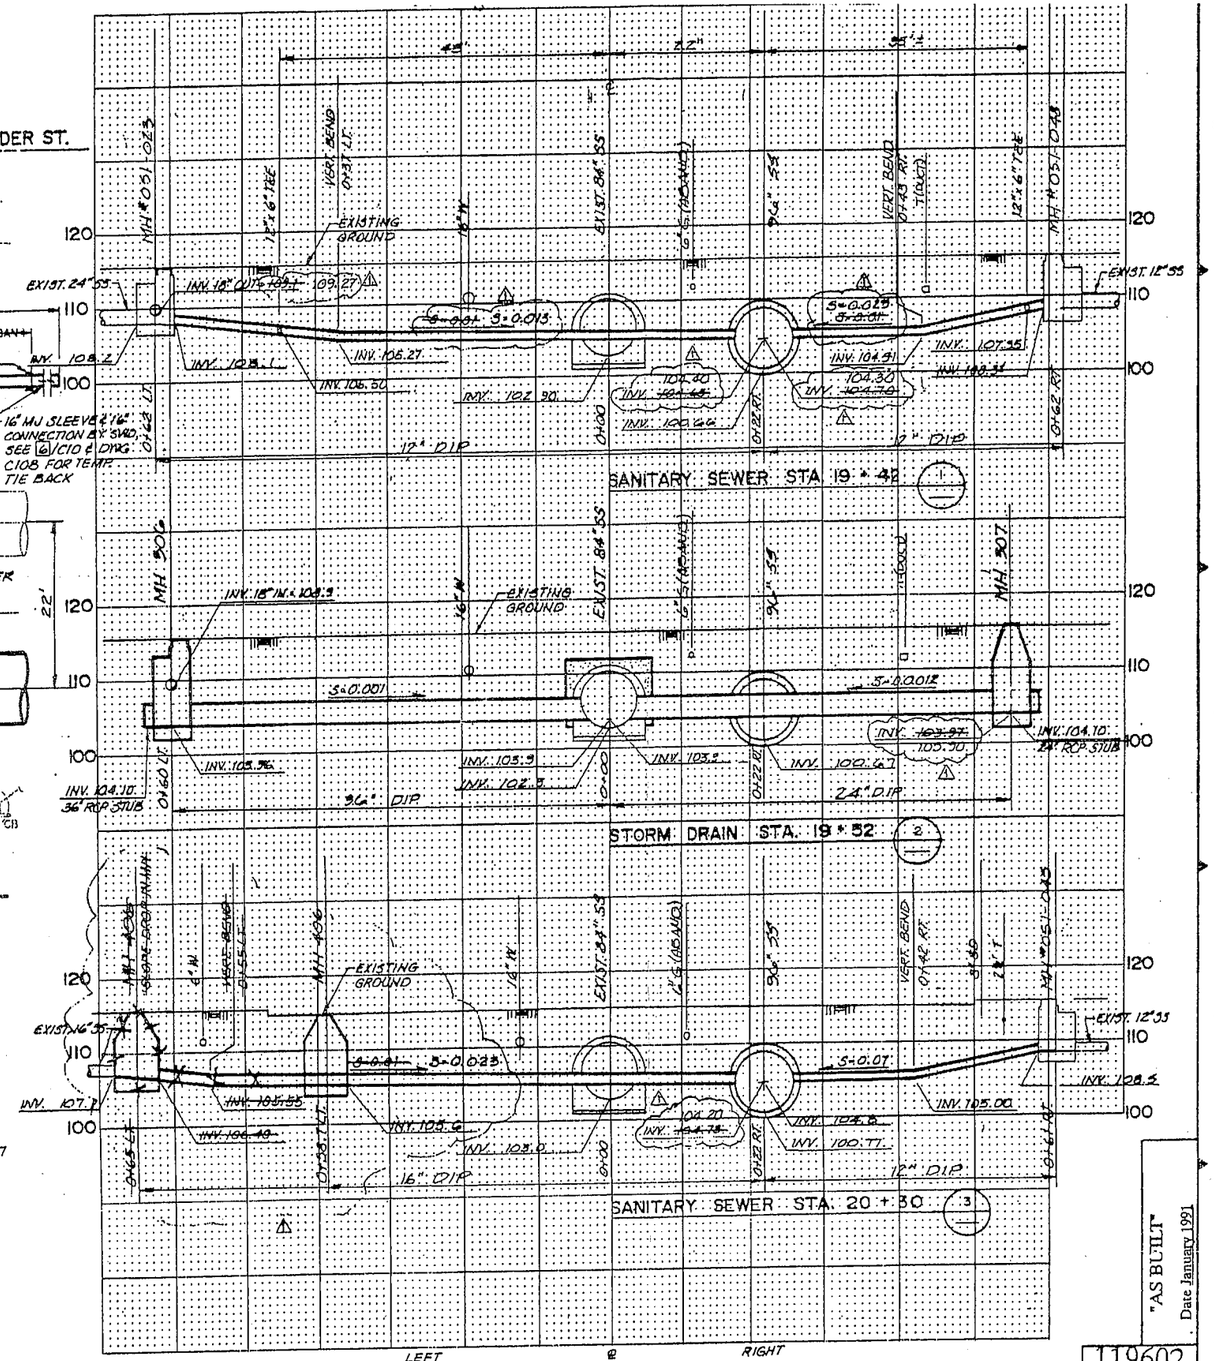

"AS BUILT" Date January 1991

NO.	REVISION	BY	DATE
1	AS BUILT- DIMENSIONS, MH RELOCATION, INVERTS, SLOPES	WAD	1/24/91

VERIFY SCALES
BAR IS ONE INCH ON ORIGINAL DRAWING.
IF NOT ONE INCH ON THIS SHEET, ADJUST SCALES.

KCM and Associated Firms

MARTIN C. DIRKS STATE OF WASHINGTON REGISTERED PROFESSIONAL ENGINEER

DESIGNED: RJG
DRAWN: TWP CHECKED: DDG
RECOMMENDED:
APPROVED:

METRO Municipality of Metropolitan Seattle

SCALE: 1"=10' VERT. & HORIZ.
CONTRACT NO: W/F3-89

LANDER SEPARATION PROJECT PHASE I
4TH AVE. S. INTERSECTION PLAN AND SECTIONS

119602
DATE
FILE NO. 777-447
DRAWING NO. C 121
SHEET 47 OF 117

COMPOSITE C 121 / C 122
OVERLAY SCHEDA 12.4 / 12.5
OVERLAY IDENTIFICATION PROJ NO / CONTRACT

Property of City of Seattle 777-447-47

(V) L-98

Section AB

Section of Outfall

Extra for Pile Foundation
152 ft. BM. per bent

Section showing construction of timber foundation to be used between 6th Ave S and Occidental Ave

Approximate Bill of Material

54	Concrete Sewer:	316 lin. ft.
54	(Heavy Section)	.07
72		301
84		1784
84	(Heavy Section)	106
90		1038
90	(Heavy Section)	1618
96		807
4 ft. Manholes		12
Reconstructed Manholes		80 cu yds
Extra Concrete in		200 cu yds
Steel		20000 lbs
Lumber in Foundation		4000 ft BM
Piles		1000 lin ft
Creosoted Lumber		1000 ft BM
Piles		1000 lin ft
8" Sewer pipe Subdrains		240 lin ft

Seattle Sewerage

Plan and Profile of

LANDER STREET

Trunk Sewer

Ordinance No 16700

Local Improvement District No 1842

Scale Inch = 20 feet

August 13, 1909

0841 B

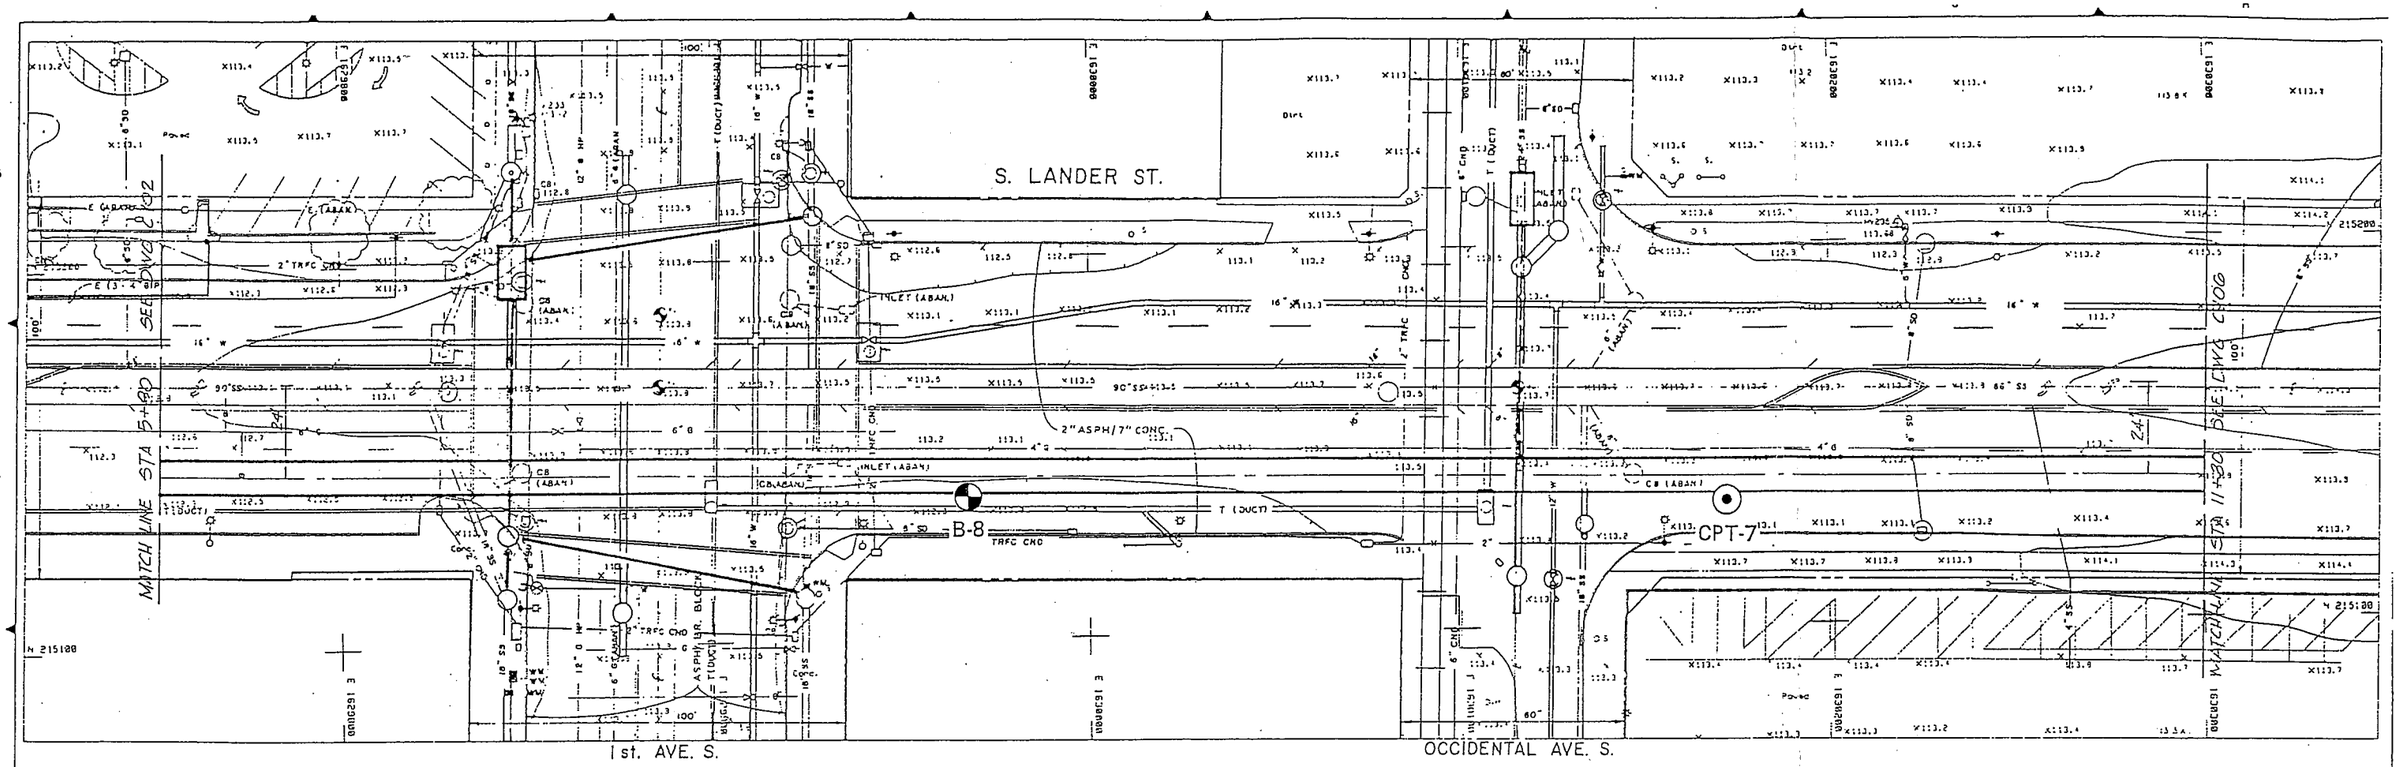

SITE AND EXPLORATION PLAN AND SUBSURFACE PROFILE

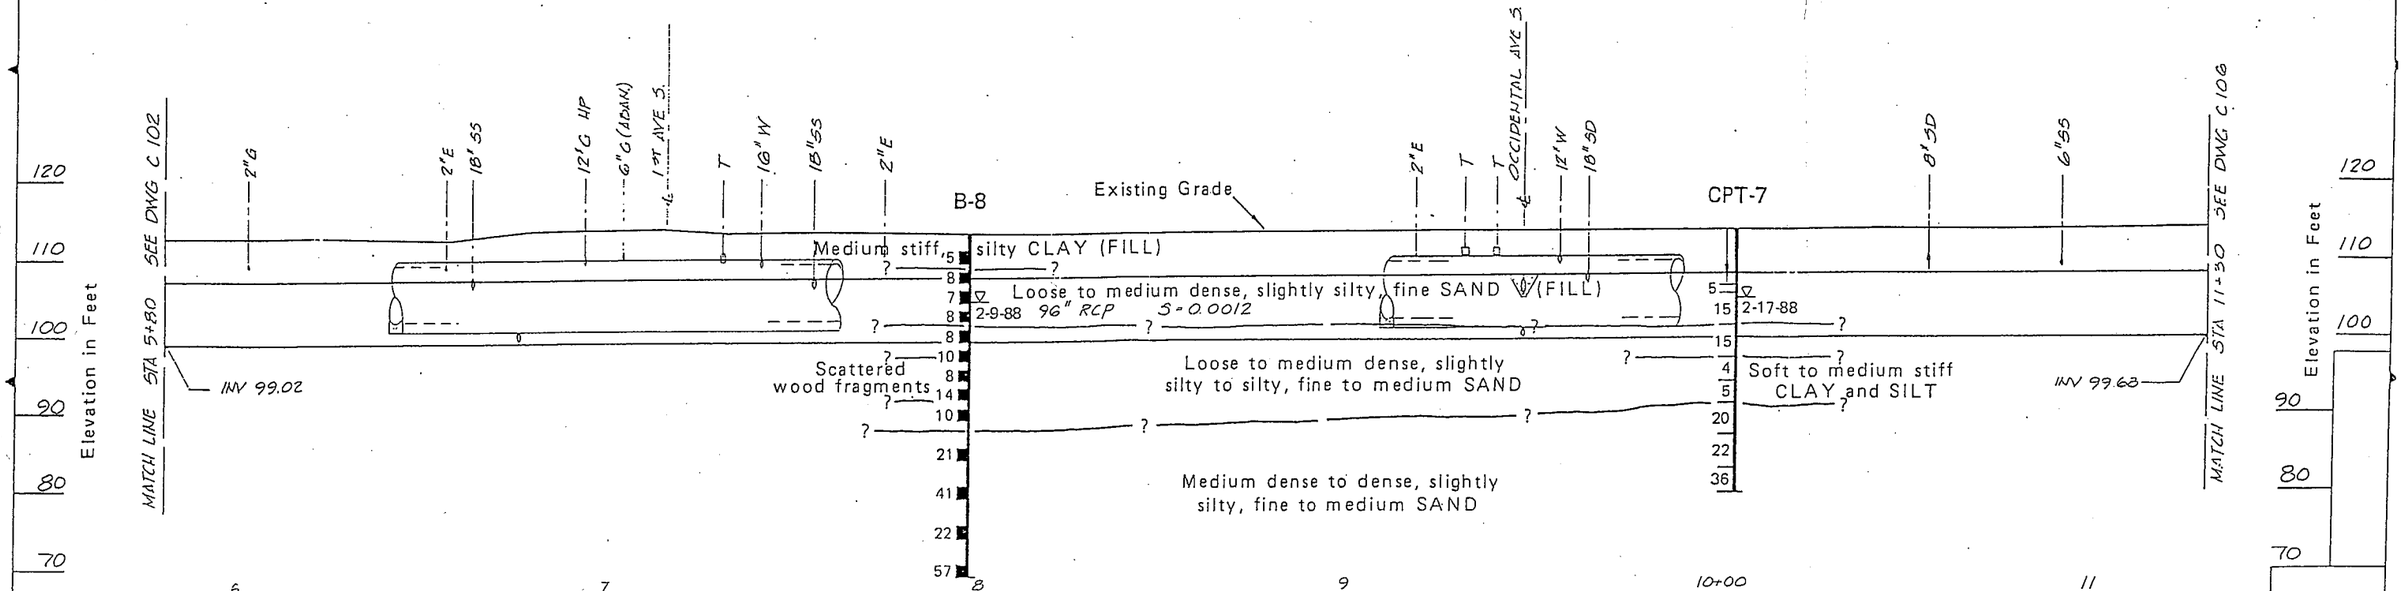

VERIFY SCALES
BAR IS ONE INCH ON ORIGINAL DRAWING
IF NOT ONE INCH ON THIS SHEET ADJUST SCALES ACCORDINGLY

KCM and Associated Firms

August 1988 W-4894-03

SHANNON & WILSON, INC. Geotechnical Consultants

DESIGNED: DRAWN: CHECKED: RECOMMENDED: APPROVED: SCALE: CONTRACT NO:

METRO Municipality of Metropolitan Seattle

LANDER SEPARATION PROJECT PHASE I
PLAN AND PROFILE
STA 5+80 TO STA 11+30

DRAWING NO. C 104

FIG. 4

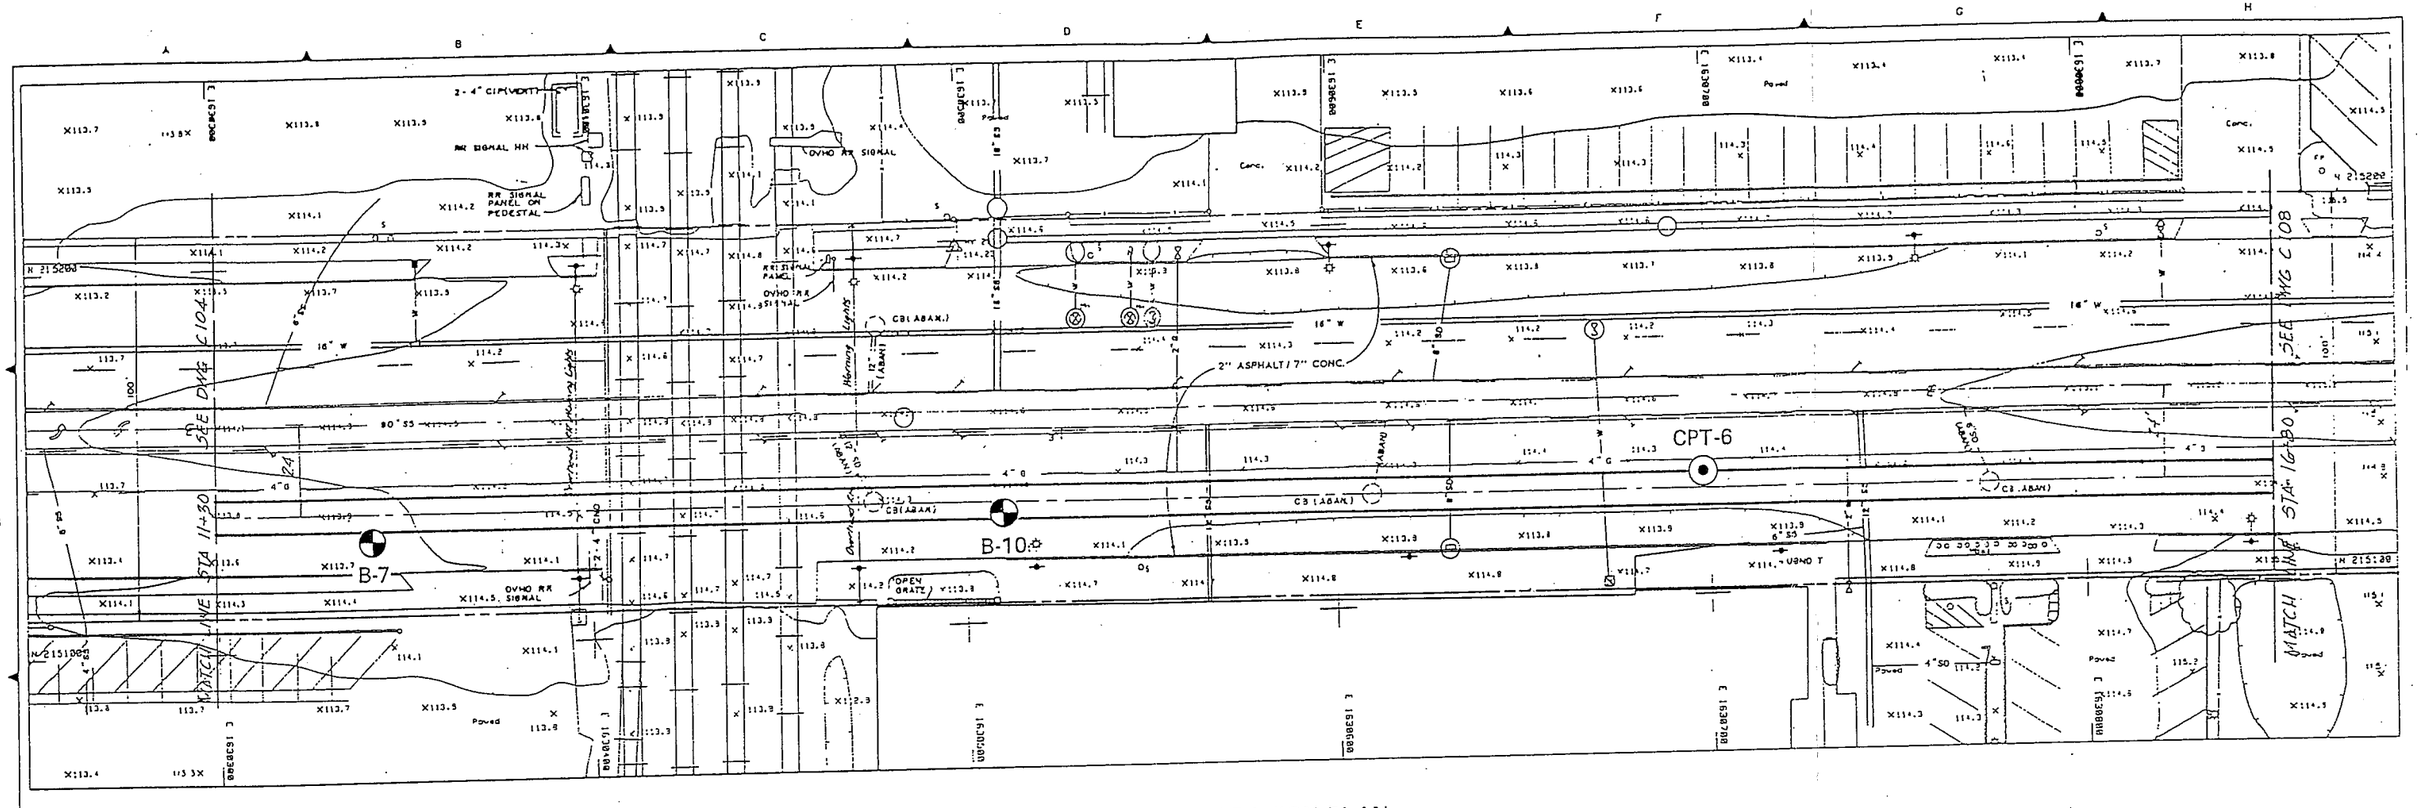

SITE AND EXPLORATION PLAN
AND
SUBSURFACE PROFILE

VERIFY SCALES
BAR IS ONE INCH ON ORIGINAL DRAWING
0 1
IF NOT ONE INCH ON THIS SHEET, ADJUST SCALES ACCORDINGLY

KCM and Associated Firms

August 1988 W-4894-03

SHANNON & WILSON, INC. Geotechnical Consultants

metro Municipality of Metropolitan Seattle

LANDER SEPARATION PROJECT PHASE I
PLAN AND PROFILE
STA 11+30 TO STA 16+80

FIG. 5

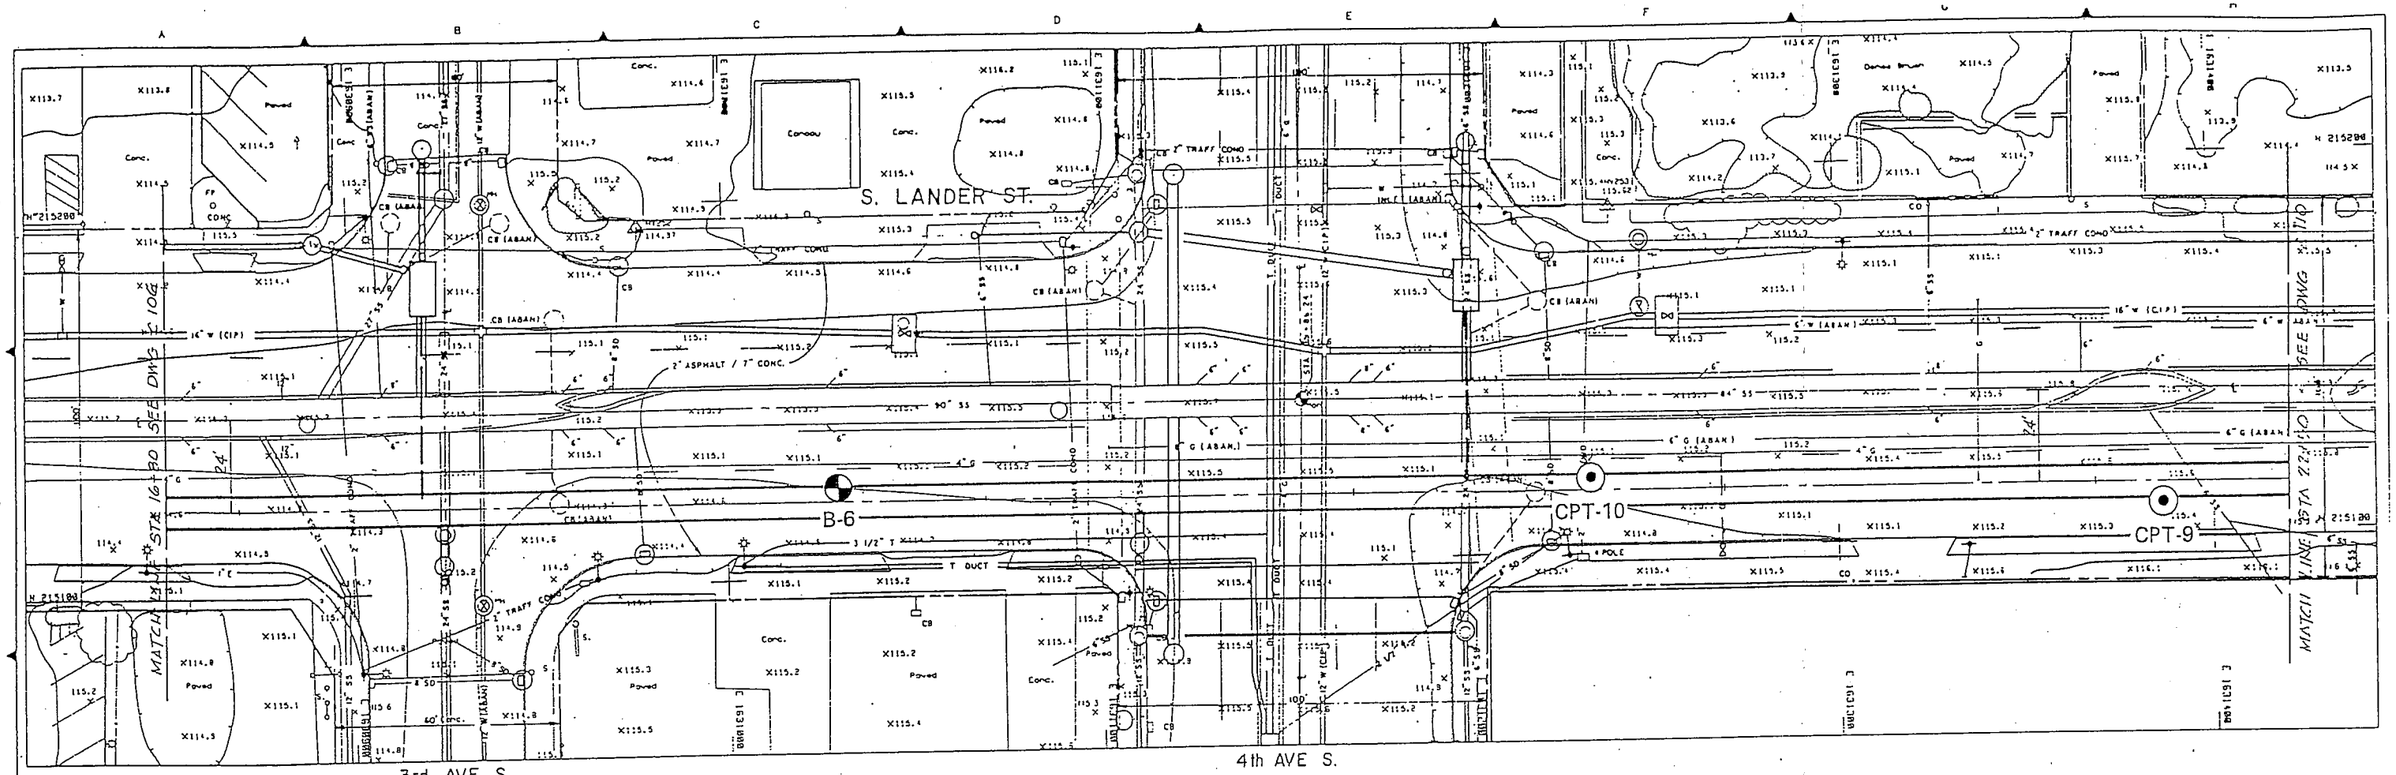

SITE AND EXPLORATION PLAN
AND
SUBSURFACE PROFILE

NO.	REVISION	BY	DATE

VERIFY SCALES
BAR IS ONE INCH ON ORIGINAL DRAWING
0 1
IF NOT ONE INCH ON THIS SHEET, ADJUST SCALES ACCORDINGLY

KCM and Associated Firms

August 1988 W-4894-03

SHANNON & WILSON, INC. Geotechnical Consultants

DESIGNED: DRAWN: CHECKED: RECOMMENDED: APPROVED: SCALE: CONTRACT NO:

METRO Municipality of Metropolitan Seattle

LANDER SEPARATION PROJECT PHASE I
PLAN AND PROFILE
STA 16+80 TO STA 22+50

DRAWING NO. C 108

FIG. 6