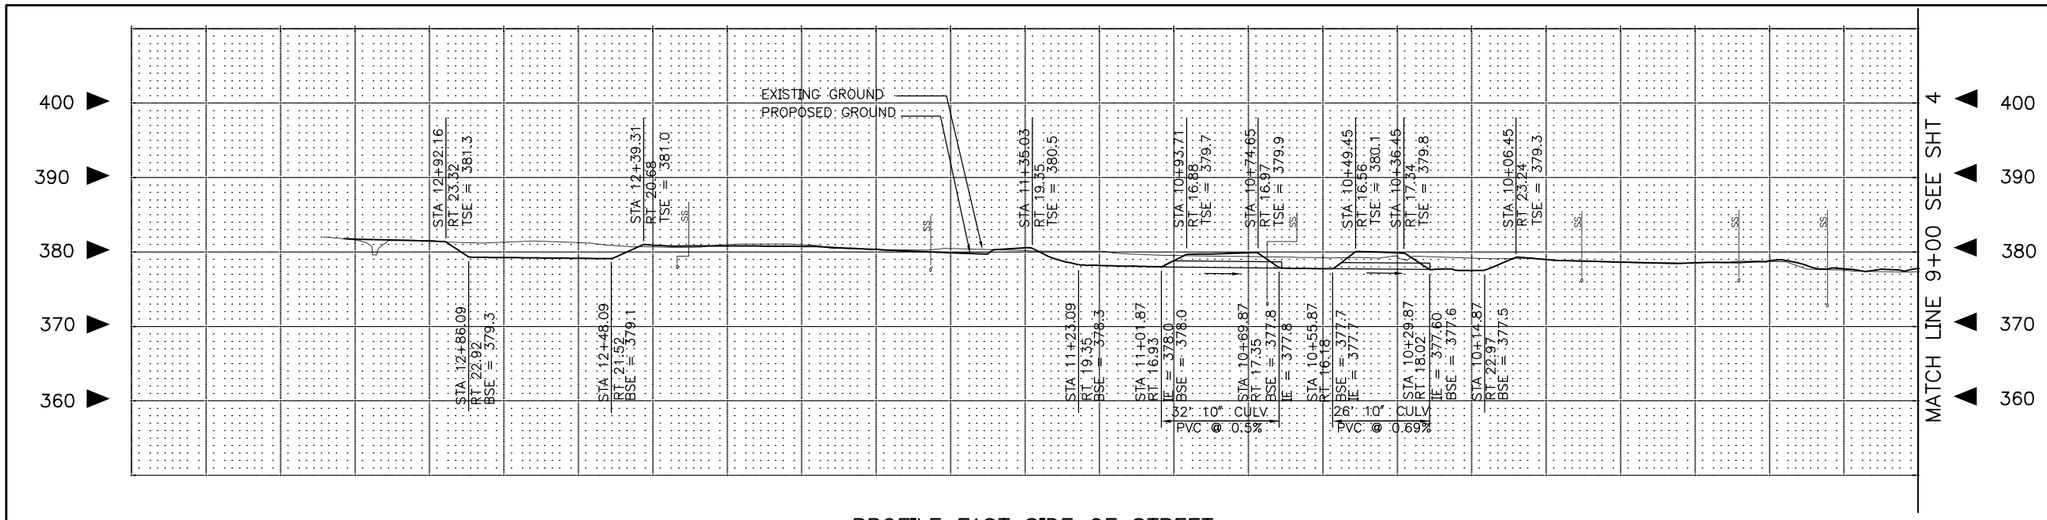

PROFILE EAST SIDE OF STREET

FOR PROFILE ON WEST SIDE OF STREET
SEE SHEET 5

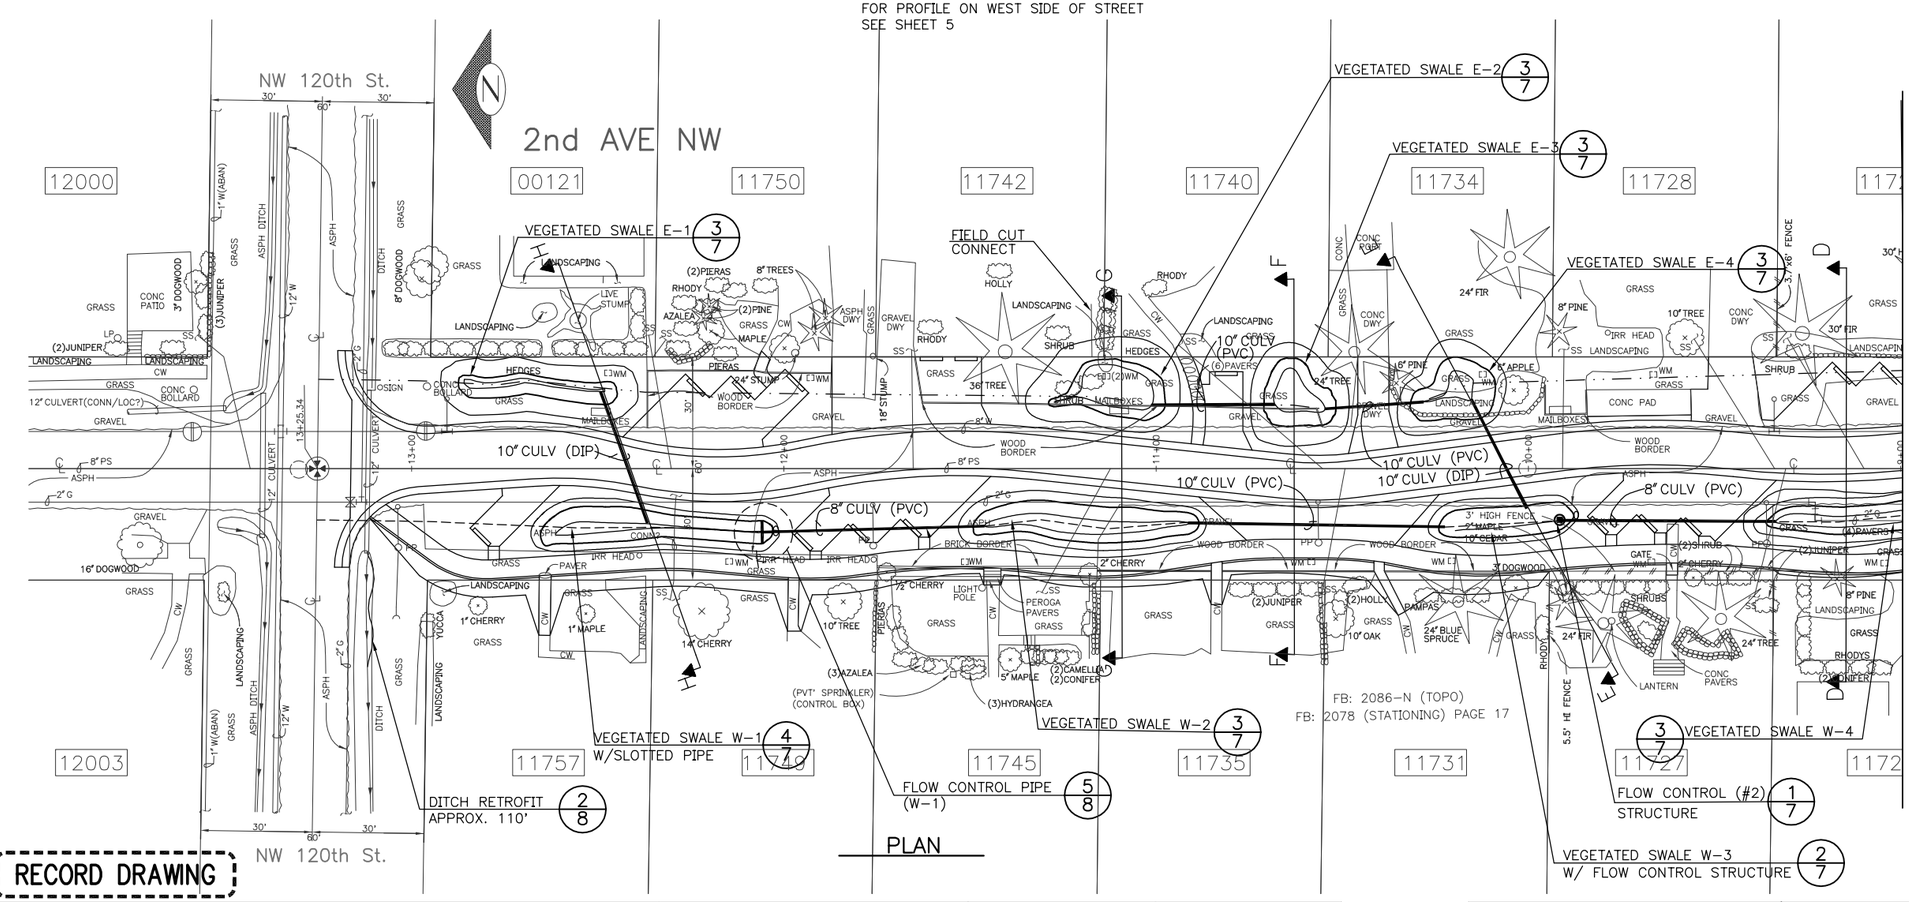

PLAN

LEGEND

- EAST SIDE DRAINAGE CENTERLINE
- WEST SIDE DRAINAGE CENTERLINE

FOR PAVING PLAN, SEE SHEET 10&11
FOR DRAINAGE PLAN, SEE SHEET 3&4
FOR LANSCAPING PLAN, SEE SHEET 12&13

DRAINAGE PLAN & PROFILE

RECORD DRAWING

MARK	DATE	NATURE REVISIONS	MADE	CHK'D	REV'D

VAULT SERIAL NO. 33655

P:\RecordDrawings\C399312\SWT04_P.dwg rainwab 09/21/00 09:33 AM

APPROVED FOR ADVERTISING
DWIGHT DIVELY
EXECUTIVE SERVICES DIRECTOR
SEATTLE, WASHINGTON 20

BY:
CONTRACTING MANAGER

NAME OR INITIALS AND DATE	INITIALS AND DATE
DESIGNED	REVIEWED: DES. CONST. SEATRAN PROJ. MGR.
CHECKED	
DRAWN	RECEIVED
CHECKED	REVISED AS BUILT

ALL WORK DONE IN ACCORDANCE WITH THE CITY OF SEATTLE STANDARD PLANS AND SPECIFICATIONS AND OTHER DOCUMENTS CALLED FOR IN SECTION 0-02.3 OF THE PROJECT MANUAL.

City of Seattle
Seattle Public Utilities
Diana Gale, Director

ORDINANCE NO. APPROVED
FUND:
SCALE: H 1"=20' V 1"=10' INSPECTOR'S BOOK

S.E.A. STREET
2nd AVE NW
(NW 117TH TO NW 120TH)

JOB NO. PC C399312 R/W CO C399312
VAULT PLAN NO. 777-162
SHEET 3 OF 14