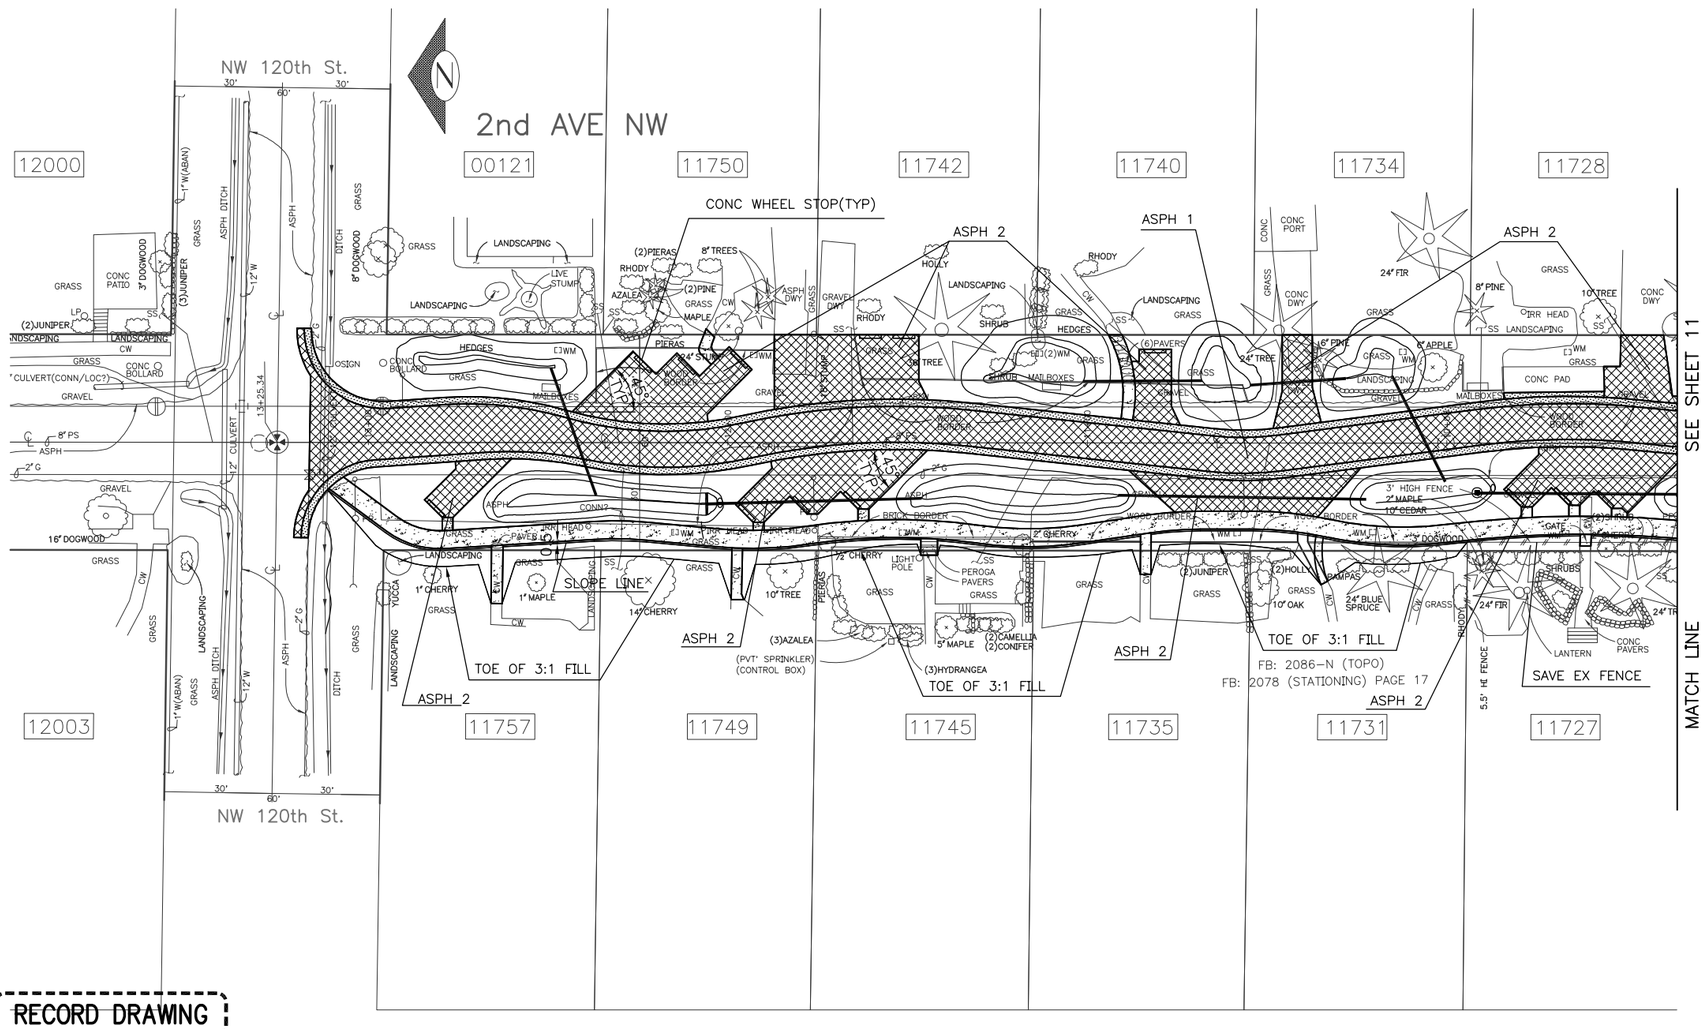

PAVING LEGEND

- ASPH 1 – 3" CL A ASPH OVER 6" TYPE 2 MNRL AGG.
- ASPH 2 – 3" CL A ASPH OVER 4" TYPE 2 MNRL AGG.
- CW – TYPE 420A
- CONC DWY – 6" TYPE 430A OR MODIFIED CURB AND GUTTER TYPE 410B(NO CURB)

FOR REMOVAL PLAN, SEE SHEET 2
FOR DRAINAGE PLAN, SEE SHEET 3 & 4
FOR LANDSCAPING PLAN, SEE SHEET 12 & 13

RECORD DRAWING

PAVING PLAN

P:\RecordDrawings\C399312\Spv01_p.dwg rainwab 09/21/00 08:46 AM 33655

VAULT SERIAL NO.	REVISIONS	MARK	DATE	MADE	CHK'D	REV'D	DESCRIPTION

APPROVED FOR ADVERTISING
DWIGHT DIVELY
EXECUTIVE SERVICES DIRECTOR
SEATTLE, WASHINGTON 20
BY: CONTRACTING MANAGER

NAME OR INITIALS AND DATE
DESIGNED
CHECKED
DRAWN
CHECKED

INITIALS AND DATE
REVIEWED:
DES. SPU CONST.
SEATRAN PROJ. MGR.
RECEIVED
REVISED AS BUILT

ALL WORK DONE IN ACCORDANCE WITH THE CITY OF SEATTLE STANDARD PLANS AND SPECIFICATIONS AND OTHER DOCUMENTS CALLED FOR IN SECTION 0-02.3 OF THE PROJECT MANUAL.

City of Seattle
SEATRAN
Seattle Transportation
ORDINANCE NO. APPROVED
FUND:
SCALE: H. V. INSPECTOR'S BOOK

S.E.A. STREETS
2ND AVENUE NW
(NW 117TH TO NW 120TH)

JOB NO. PC C399312
R/W CO C399312
VAULT PLAN NO. 774-162
SHEET 10 OF 14