

PSS Prefontaine Headhouse

Historic Preservation Board | December 19, 2025

PROJECT DESCRIPTION:

Originally constructed in the 1990s as part of the Downtown Seattle Transit Tunnel, the Prefontaine Headhouse is one of the most architecturally distinctive entries to the light rail system, known for its integrated public art and historic design elements. Planned upgrades aim to enhance accessibility, safety, and long-term maintenance while preserving the station's unique character. New hardware installed on the existing people gates will highlight and protect existing art panels, meet current accessibility standards, and improve both daily operations and emergency egress. A roof-mounted fall protection system will support safe maintenance of the glass barrel vault and drainage components. To deter unauthorized access and prevent damage, custom anti-climb panel, designed to complement the original architecture, will be added and prepared to support ambient lighting. In a separate project, interior and exterior lighting enhancements will also improve visibility, safety, and the overall passenger experience.

A. ARCHITECTURAL:

- 01 Site Plan / Project Context
- 02 Scope of Work / Key Plan
- 03 Visual Index
- 04 Material Palette

Gates

- A1 06 2nd Ave Public Art Entry
- 07 2nd Ave Public Art Entry
- 08 2nd Ave Public Art Entry
- A2 09 3rd Ave Elevator Access
- 10 3rd Ave Elevator Access
- 11 3rd Ave Elevator Access

Interior

- 13 Plinth
- 14 Plinth
- 15 Plinth at Night
- 16 Plinth
- 17 Duct Bank
- 18 Duct Bank

A4 Exterior Security

- 21 I-Beam Existing
- 22 I-Beam (Option 1 - Custom Panel)
- 23 I-Beam (Option 2 - Perforated Panel)
- 24 Design Options - Vertical Climbing Elements
- 25 Exterior Grills + Art
- 26 Grills + Art (Preferred Option - Scrim)
- 27 Grills + Art (Alternate 1 - Perf Panel)
- 28 Grills + Art (Alternate 2 - Custom Panel)
- 29 Grills + Art (Alternate 2 - Custom Panel)
- 30 Grills + Art (Alternate 2 - 3rd Ave Option)
- 31 Grills + Art (Alternate 3 - Replace Existing)
- 32 Horizontal Ladder
- 33 Horizontal Ladder

A5 Roof Maintenance

- 35 Fall Protection (Preferred Option - Post)
- 36 Fall Protection (Preferred Option - Post)
- 37 Fall Protection (Alternate - Stanchion)
- 38 Fall Protection (Alternate - Stanchion)
- 39 Roof Drainage

B. LIGHTING:

- 41 Section
- 42 Plans
- 43 Cut Sheet LG1-EM
- 45 Cut Sheet LS1
- 52 Cut Sheet LS2
- 56 Cut Sheet LN1
- 58 2nd Ave Entrance
- 59 Yesler Way to 3rd Ave
- 60 Jefferson St to 3rd Ave
- 61 Jefferson St to 2nd Ave
- 62 Yesler Way to 3rd Ave
- 63 3rd Ave Entrance
- 64 Escalator Down
- 65 Stair Down
- 66 Perspectives
- 67 Perspectives
- 68 Thank You
- 69 Questions



PREFONTAINE HEADHOUSE - 2ND AVE ENTRY

PROJECT ADDRESS:

Pioneer Square Station
Prefontaine Headhouse
425 3rd Ave
Seattle WA 98104

IDENTIFIED ISSUES:

The proposed project is intended to enhance accessibility and safety at the station and to support improved long-term maintenance of the existing headhouse structure.

A1 Public Art Entry - People Gates

The existing top-hung 'people gates,' which stack to either side of the stair/escalator entry, are opened by maintenance staff for the start of service in the morning and closed at the end of service at night. Due to their current top-hung design and rust, the current design of the gates makes daily opening and closing difficult for maintenance staff. When the station is closed at the end of service hours, the only way to secure the gates is by bolting them shut which prevents emergency egress from the station. Additionally, because the gates stack to the side, the integrated artwork is obscured and not easily visible to those entering the station during the service hours.

A2 3rd Ave Elevator Access Gates

The gates used to access the elevator along 3rd Ave do not meet current accessibility standards and the gate design provides hand and foot holds for unauthorized access to the roof.

A3 Interior Horizontal Elements

The glass block on the interior plinth at the top of the entry stairs is low enough that individuals have been climbing over it to access the plinth and then climb out onto the adjacent duct bank. Since the far end of the duct bank is approximately 20 feet above the floor below, this poses a significant safety hazard.

A4 Exterior Security Elements

The existing structure includes horizontal elements that function as handholds and footholds, enabling individuals to climb onto the roof. This unauthorized access is causing damage to the barrel vault glazing and contributing to debris accumulation on the roof which further adds to the drain blockages.

A5 Roof Maintenance

The low-slope roof and barrel vault require thorough cleaning and several broken glass panels on the vault need replacement. Roof drains are clogged with debris causing water to back up onto the structure. The existing structure lacks the necessary safety infrastructure to support safe and effective maintenance access to the roof.

B1 Lighting in Barrel Vaults

The existing lighting in the roof arches are nonfunctional and have begun to detach and fall, posing safety and maintenance concerns.



PROPOSED SOLUTIONS:

The proposed improvements to the headhouse include the following separate projects:

Project A Includes

A1 Public Art Entry - People Gates

Modifying the existing 'people gates' with new hardware to function as pivot gates will improve both usability and visibility. This change will bring the integrated artwork into clearer view for pedestrians entering and exiting the station, enhancing the public art experience. The pivot mechanism will also ease daily operations for maintenance staff and allow for secure closure at night while maintaining emergency egress from the station.

A2 3rd Ave Elevator Access Gates

Replace the existing gates along 3rd Avenue to meet current accessibility standards and enhance station security. The new design will ensure safe, compliant access to the elevator while preventing unauthorized entry.

A3 Interior Horizontal Elements

Add arched metal structure to the existing plinth and duct bank inside the station to deter climbing. The plinth structure will provide for a possible future option of integrated backlighting to improve ambient lighting and complement the station's design.

A4 Exterior Security Elements

Install custom perforated panels on the exterior structure to reduce climbability and discourage unauthorized access. The panel design will reflect the architectural themes of the station and incorporate provisions for ambient backlighting to enhance nighttime visibility and safety. Remove the "horizontal ladder" elements at the base of columns and grilles to eliminate footholds and further reduce climbability.



A5 Roof-Mounted Fall Protection and Drainage Improvement


Install a low-profile fall protection system on the roof to allow maintenance staff to safely access and maintain the structure. This system will support routine cleaning, debris removal from blocked drains, and the replacement of broken glass panels on the barrel vault. To improve drainage and attempt to limit water overflow from the roof's entry into the building, scuppers could be added to the flat sections of the roof.

Project B Includes


B1 Restored Lighting in Barrel Vaults

Replace existing nonfunctional lighting on the arched roof structure and restore lighting to the exterior to enhance visibility and highlight architectural features at night.

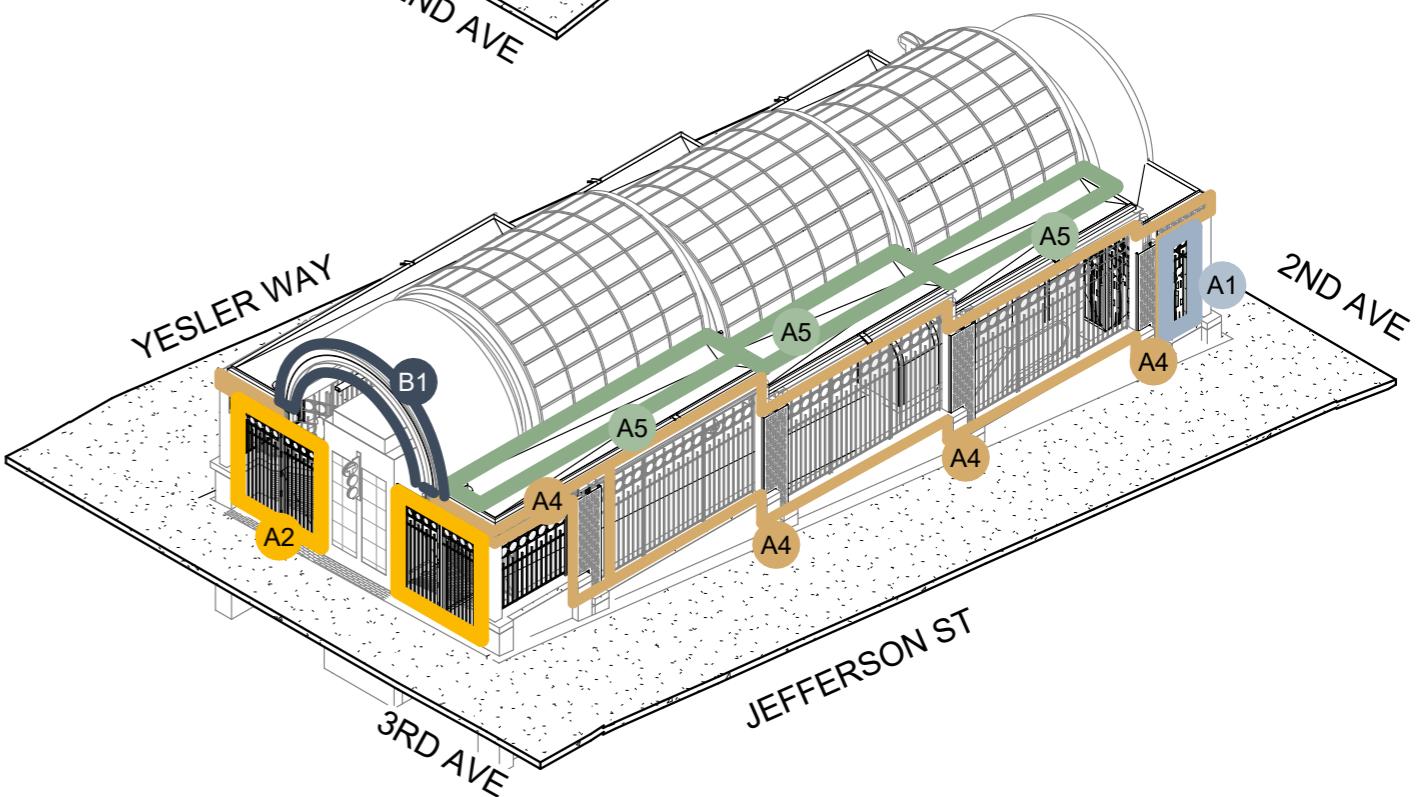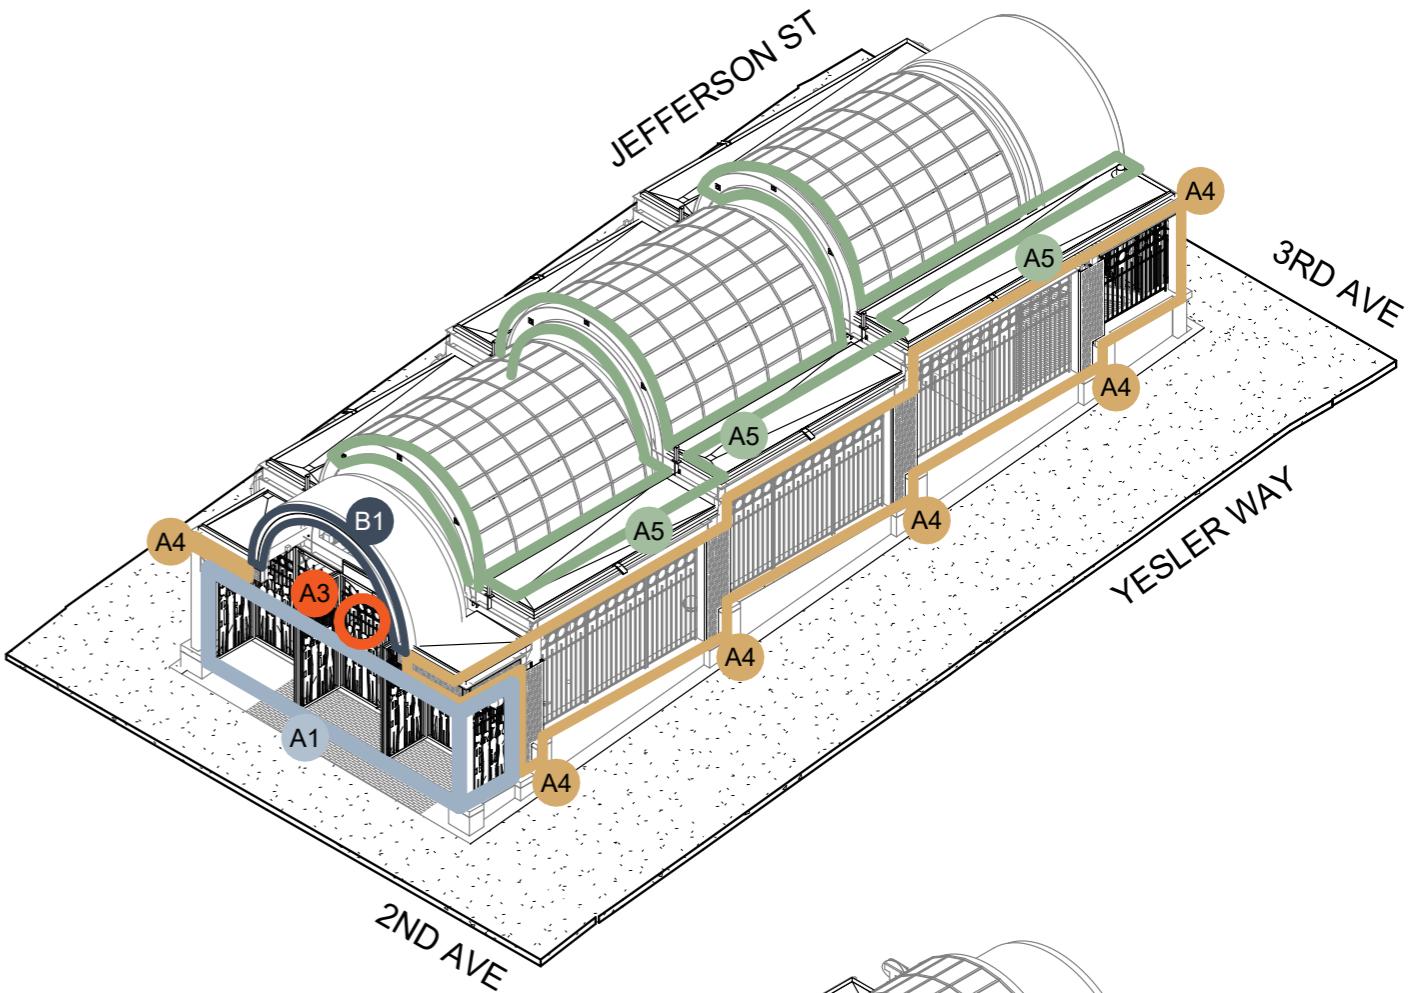

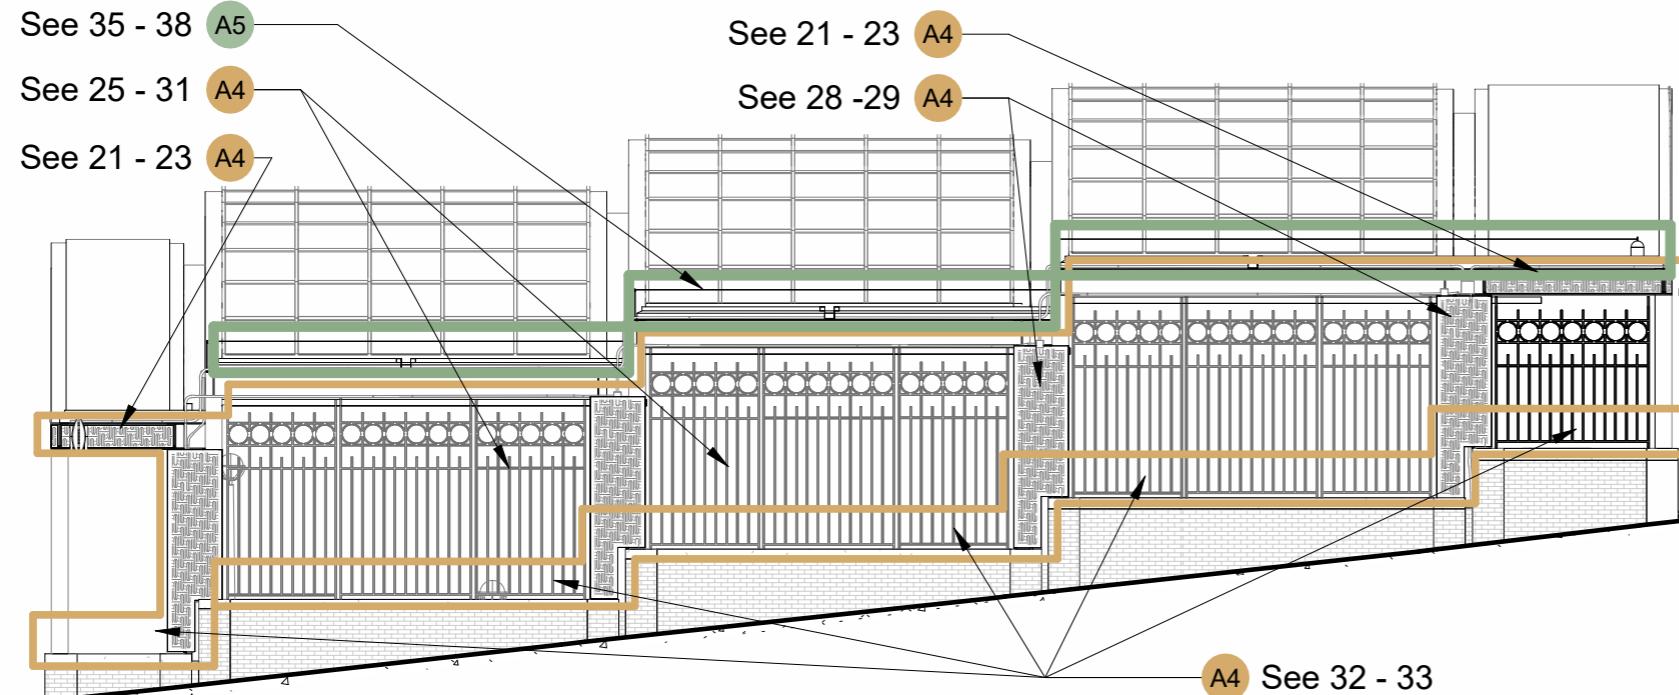

④ PROPOSED ELEVATION - EAST / YESLER WAY

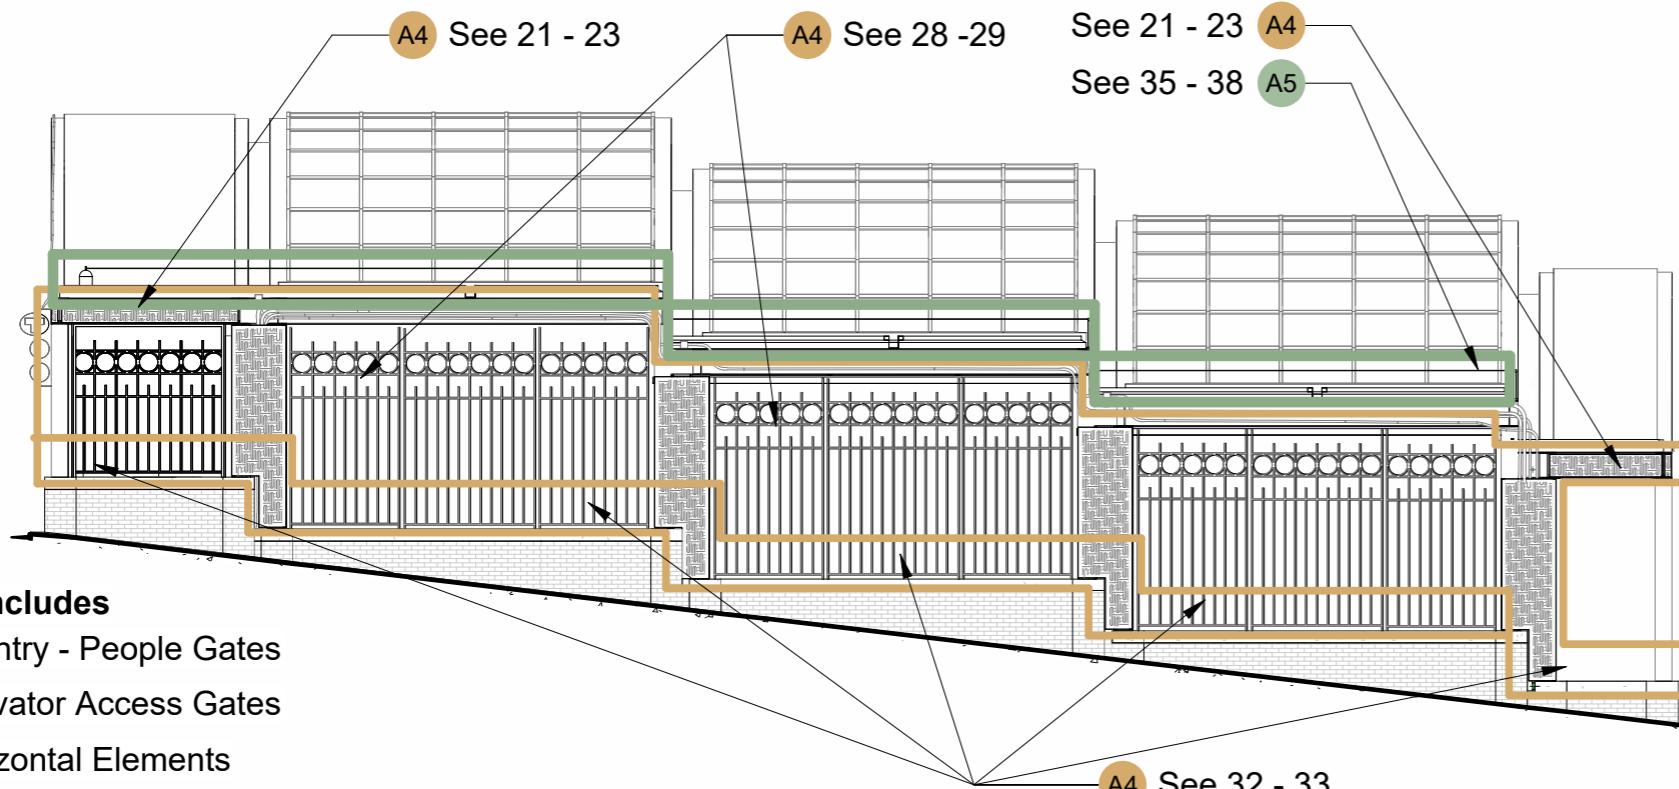

Project A Includes



- A1 Public Art Entry - People Gates
- A2 3rd Ave Elevator Access Gates
- A3 Interior Horizontal Elements
- A4 Exterior Security Elements
- A5 Roof-Mounted Fall Protection and Drainage Improvement

Project B Includes


- B1 Restored Lighting in Barrel Vaults




Tiscareno

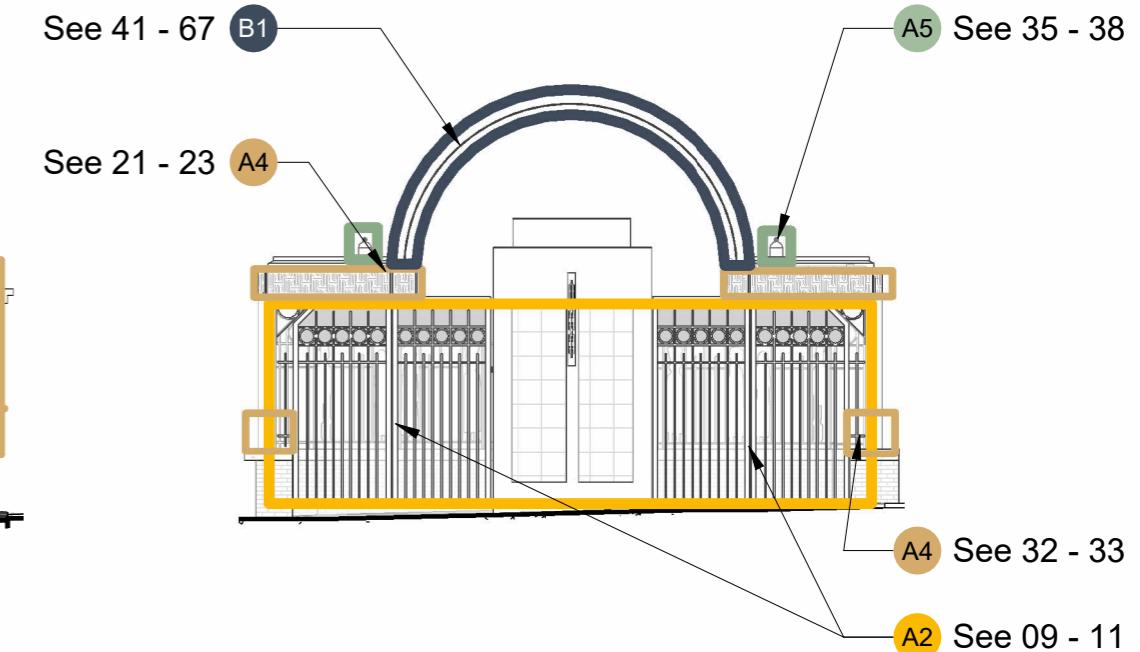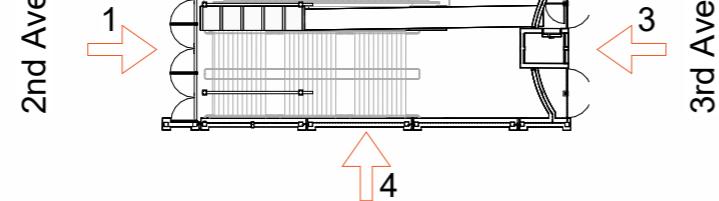


③ PROPOSED ELEVATION - 3RD AVE / ELEV ENTRY

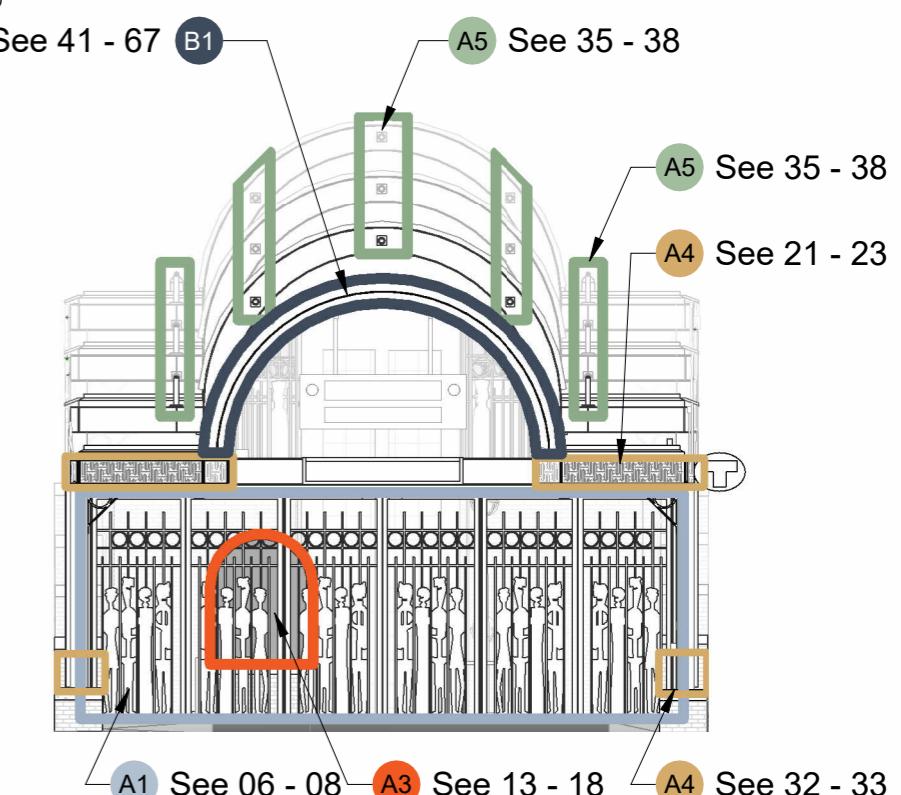

① PROPOSED ELEVATION - 2ND AVE / PUBLIC ART ENTRY

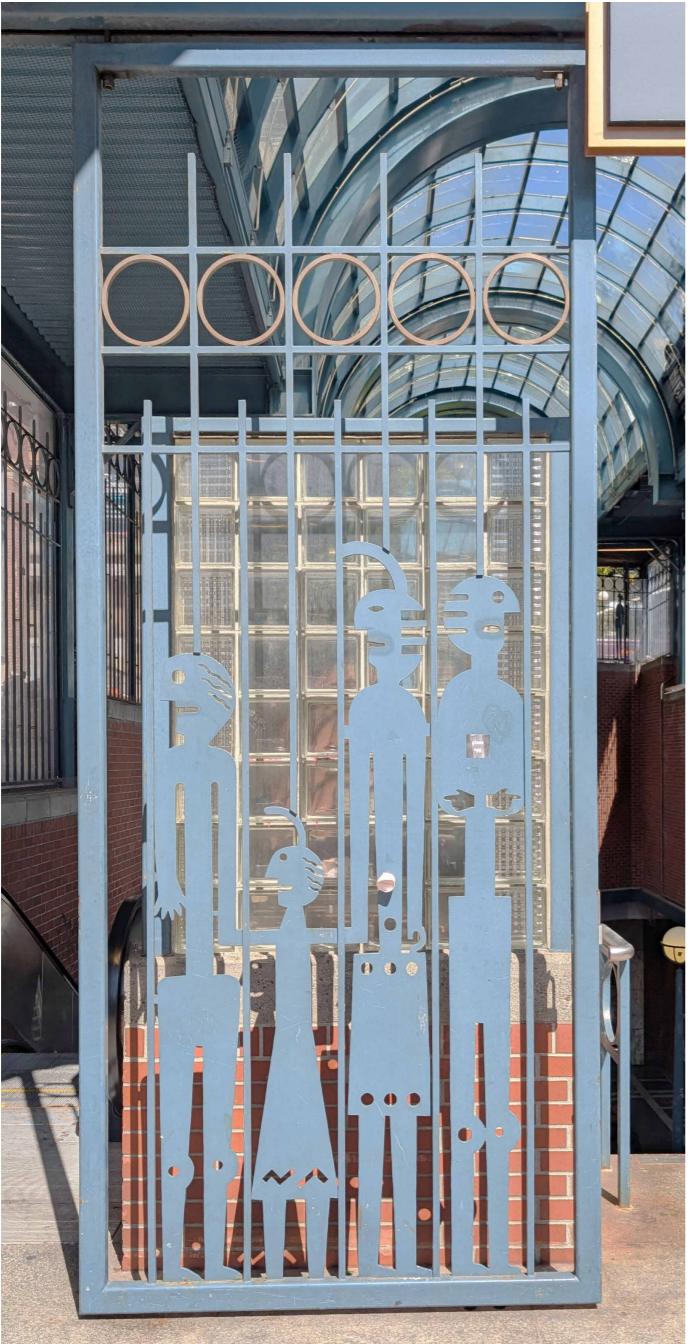

Existing Public Art Entry
'People Gates' to be reused, color to match
existing "Pioneer Blue"

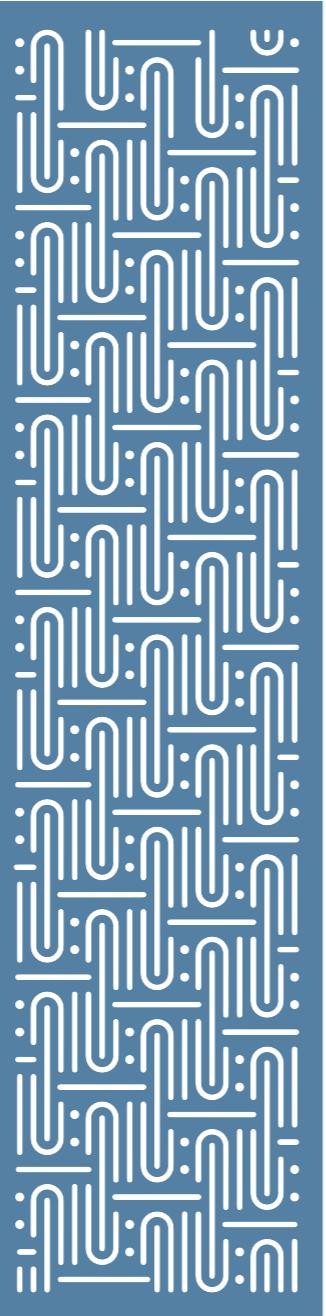


Custom Infill Panel
Color to match
existing "Pioneer Blue"



Perforated Stainless Steel Panel
Located at plinth cover and anti-
climb infill as indicated. To remain
unpainted



"Pioneer Blue" Paint Color (Exterior)
New work to be painted to match

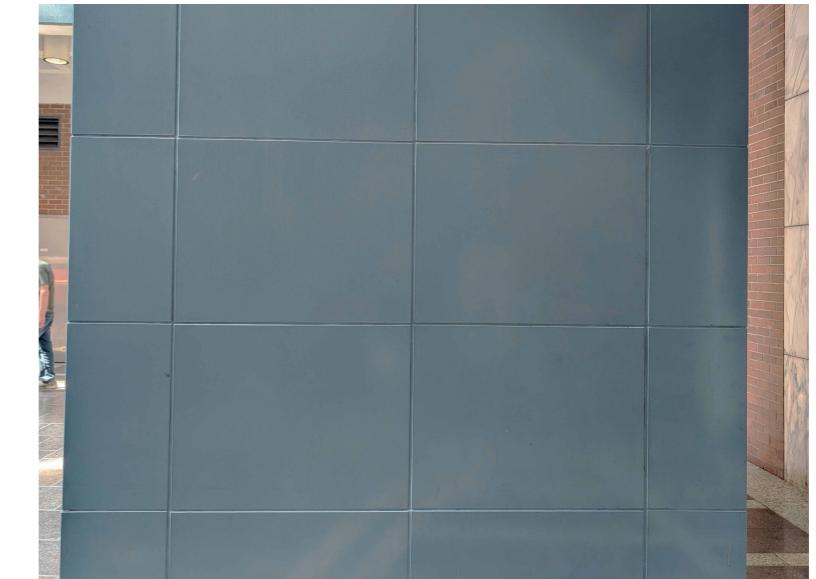


"Pioneer Blue" Paint Color (Interior)
New work to be painted to match

Proposed Gates




EXISTING FACADE - 2ND AVE / PUBLIC ART ENTRY - OPEN

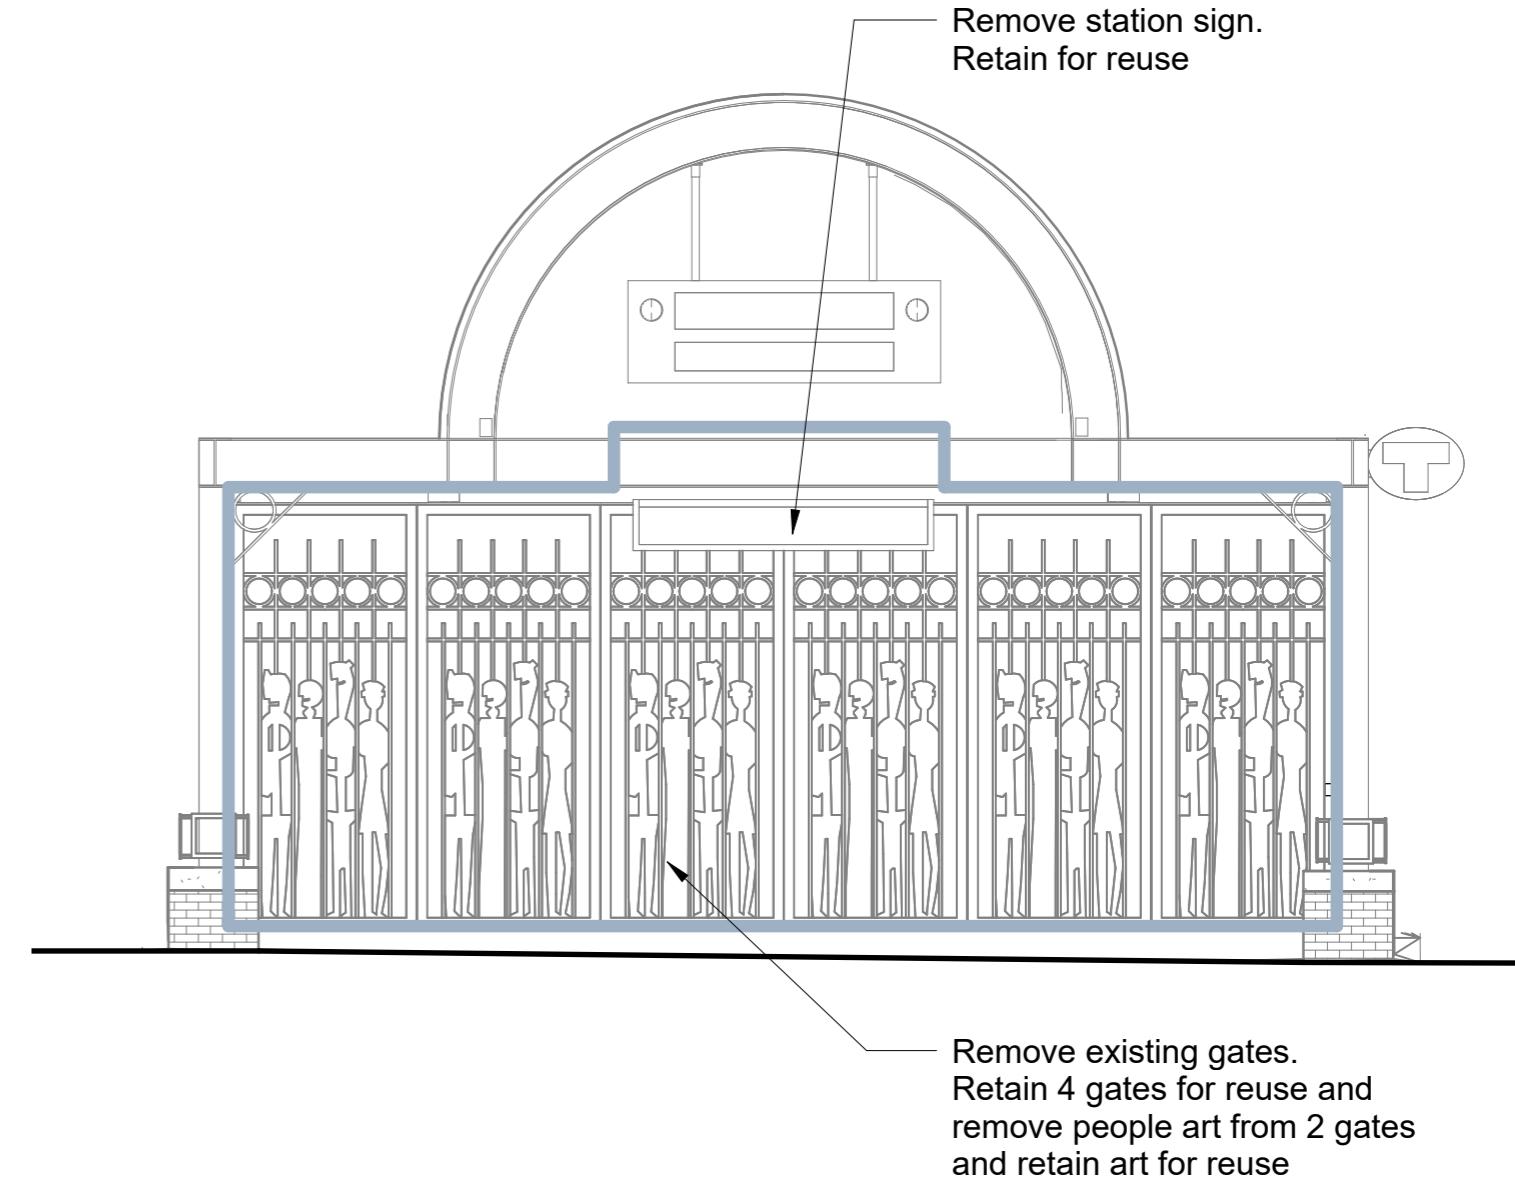

EXISTING ELEVATION - 2ND AVE / PUBLIC ART ENTRY - CLOSED




PROPOSED FAÇADE - 2ND AVE / PUBLIC ART ENTRY - OPEN

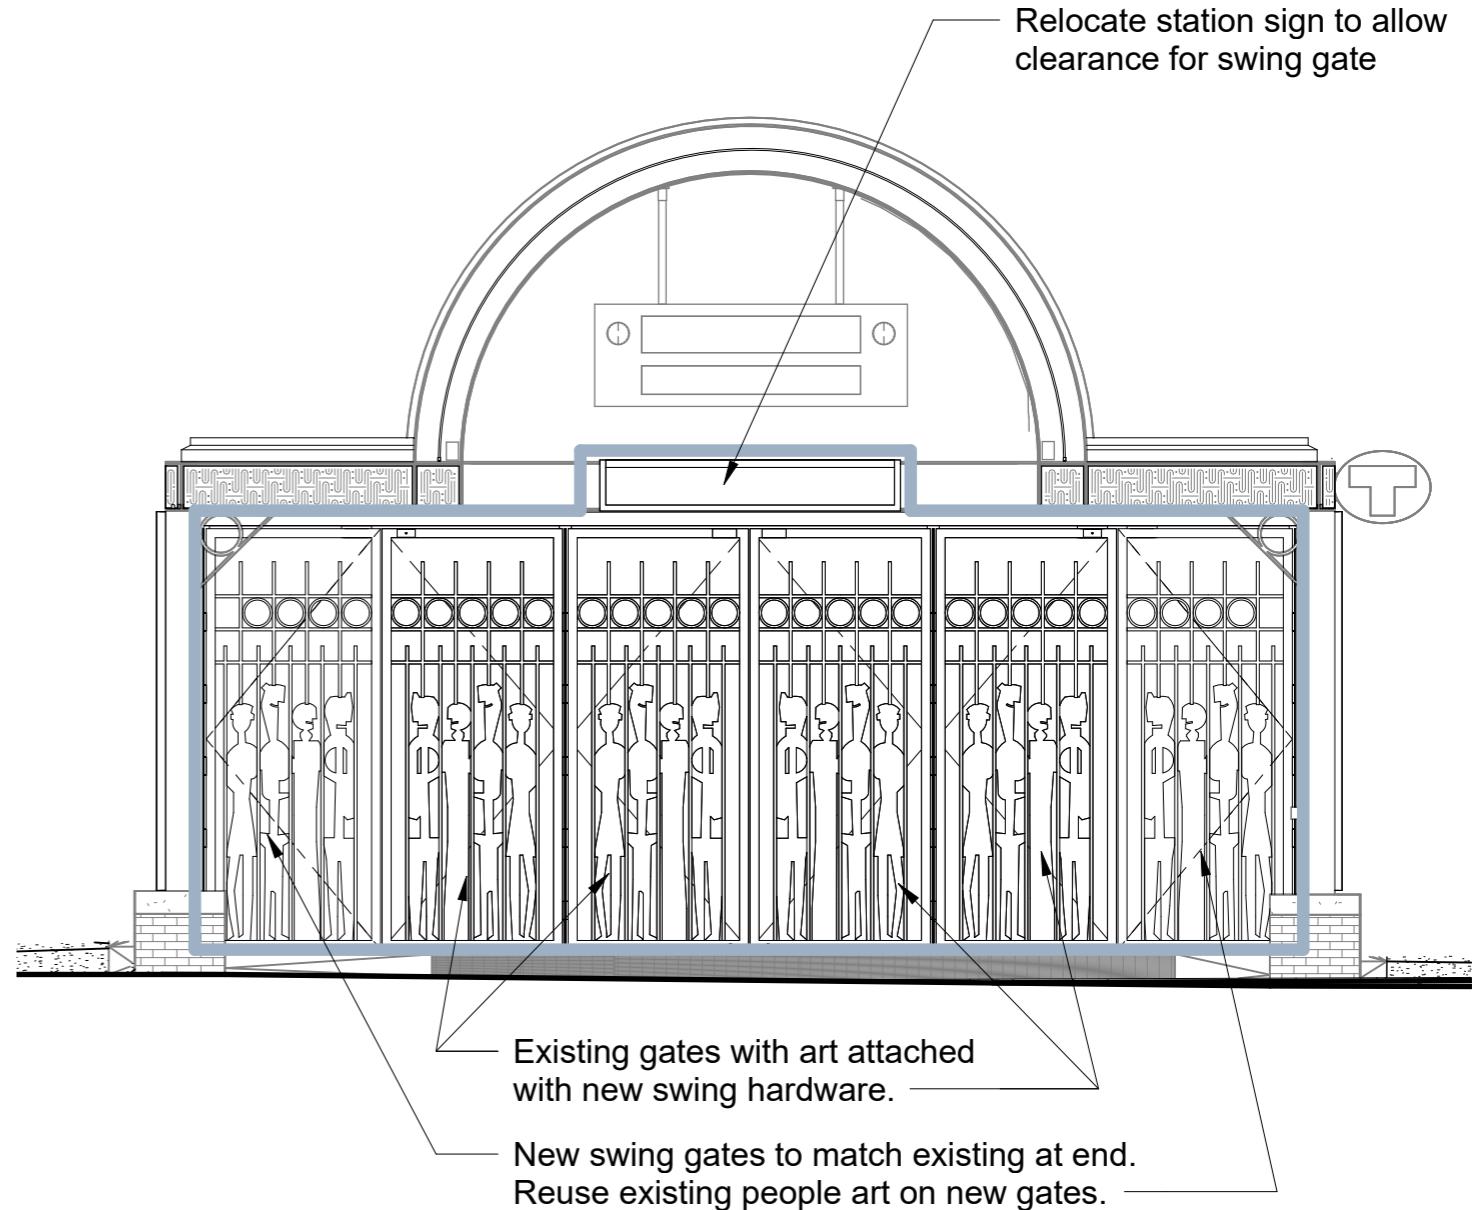

PROPOSED ELEVATION - 2ND AVE / PUBLIC ART ENTRY - CLOSED

Remove and salvage existing people art on gate panels. Retain art and apply to new gate

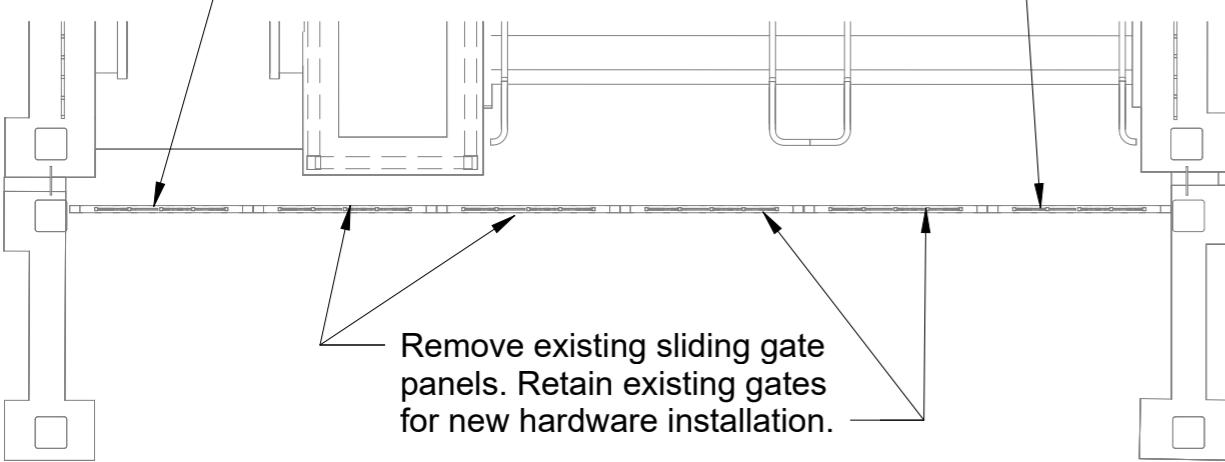

2 DEMO PLAN - 2ND AVE / PUBLIC ART ENTRY

Emergency door operator button

Gate column - end

Gate column - mid

Existing gates with new swing hardware

New slightly narrower gates at either end to fit plinth, designed to match the look of the existing gates. Existing people art relocated onto new end gates. Includes emergency egress hardware.


1 PROPOSED PLAN - 2ND AVE / PUBLIC ART ENTRY



Tiscareno


2nd Ave

3rd Ave


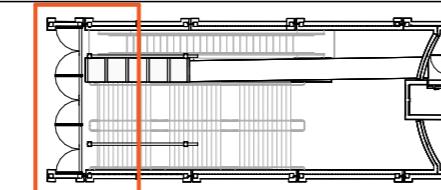


4 PLAN DETAIL - GATE AT END COLUMN


NOTE: ALL GATES, COLUMNS AND SUPPORTS ARE PAINTED TO MATCH EXISTING STRUCTURE

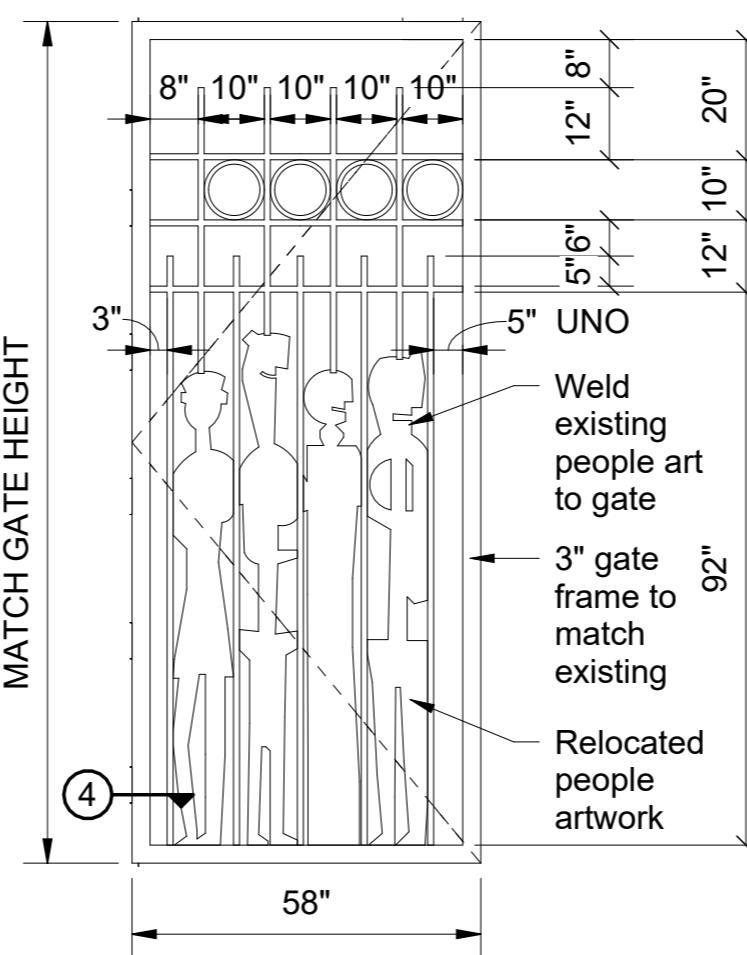

3 ENLARGED ELEVATION - NEW GATES

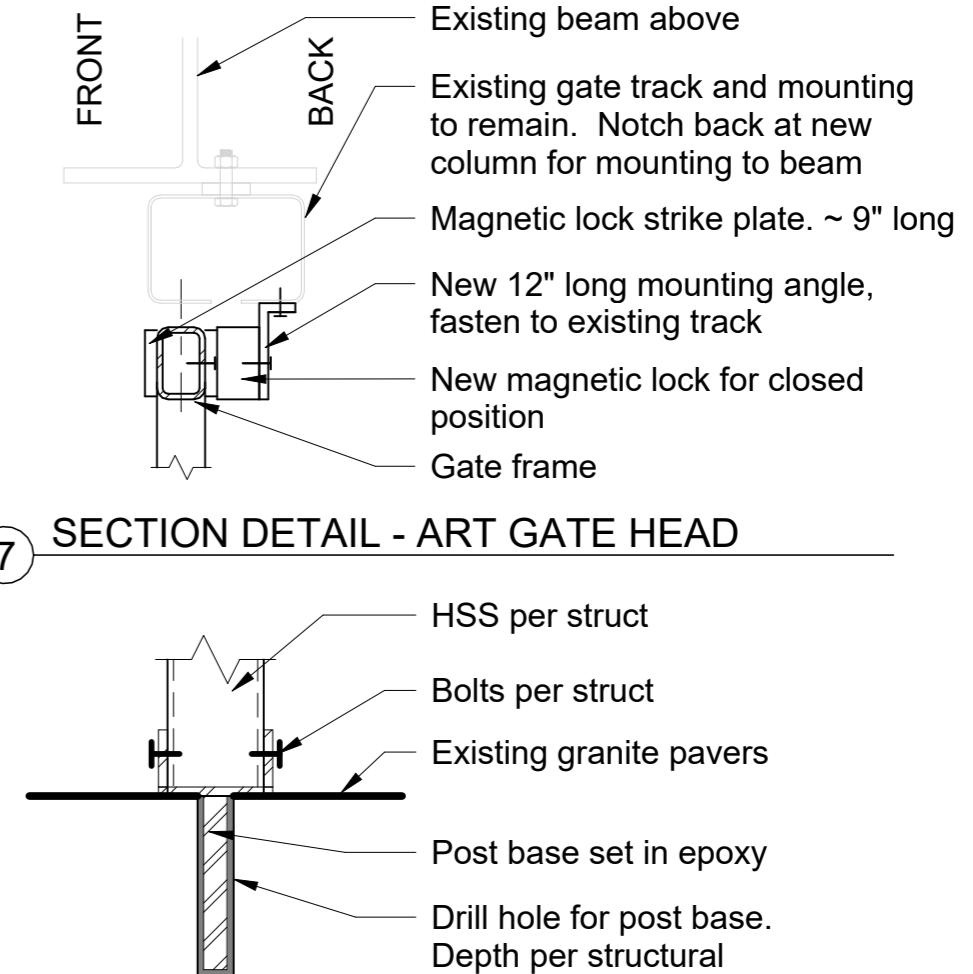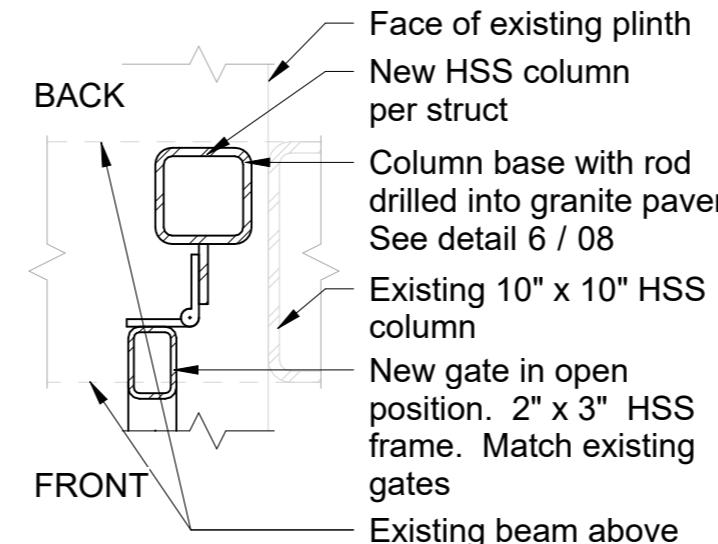

6 SECTION DETAIL - ART GATE COLUMN BASE

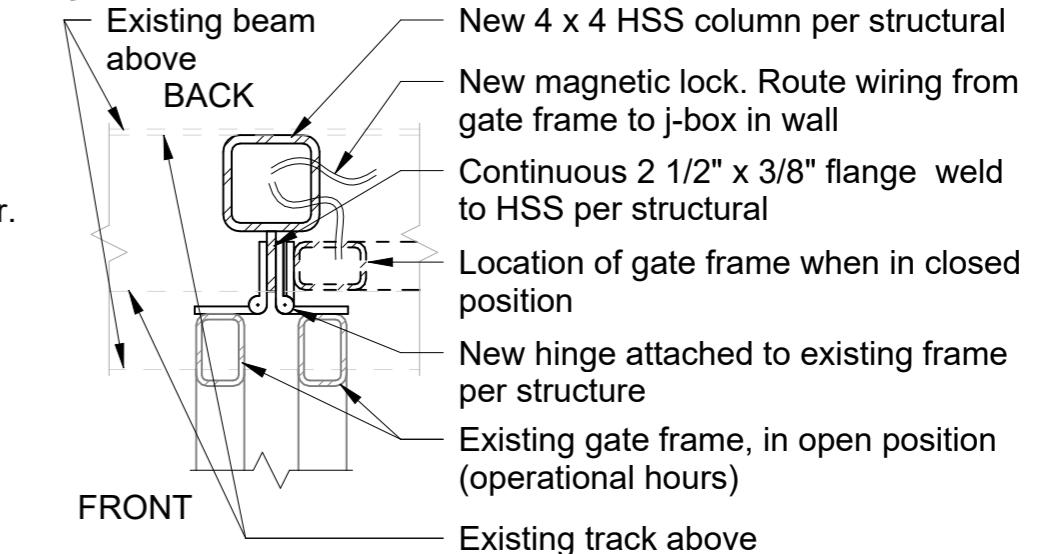

5 PLAN DETAIL - GATE AT MID COLUMN

Details

Gates | 2nd Ave Public Art Entry


A1

08



EXISTING FACADE - 3RD AVE / ELEV ENTRY DURING OPERATING HOURS


Outline represents the Area of Proposed work, Typical

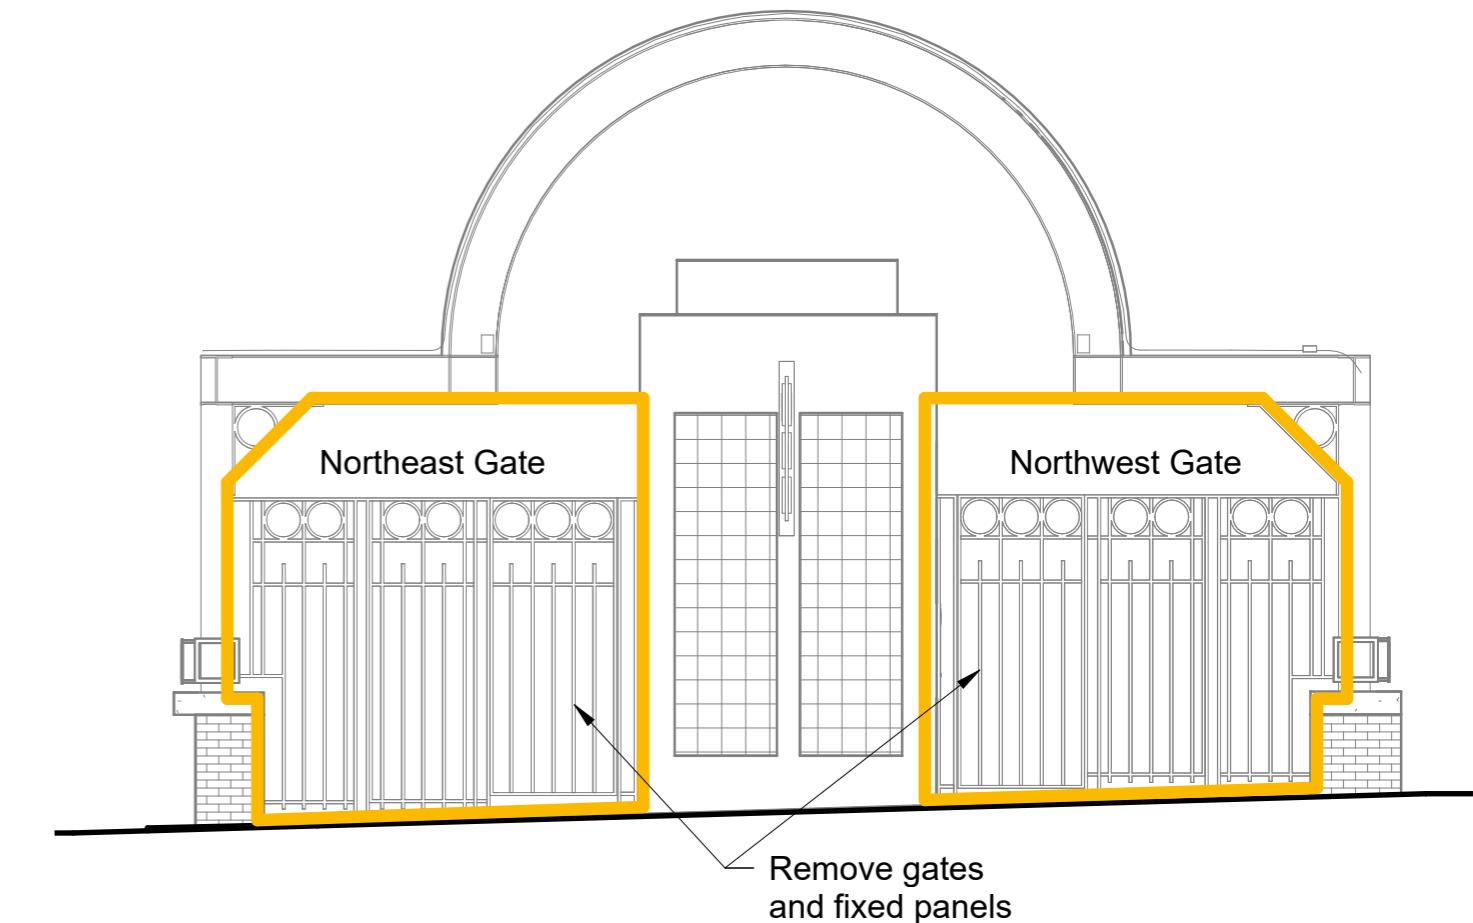


EXISTING ELEVATION - 3RD AVE / ELEV ENTRY




PROPOSED FACADE - 3RD AVE / ELEV ENTRY DURING OPERATING HOURS

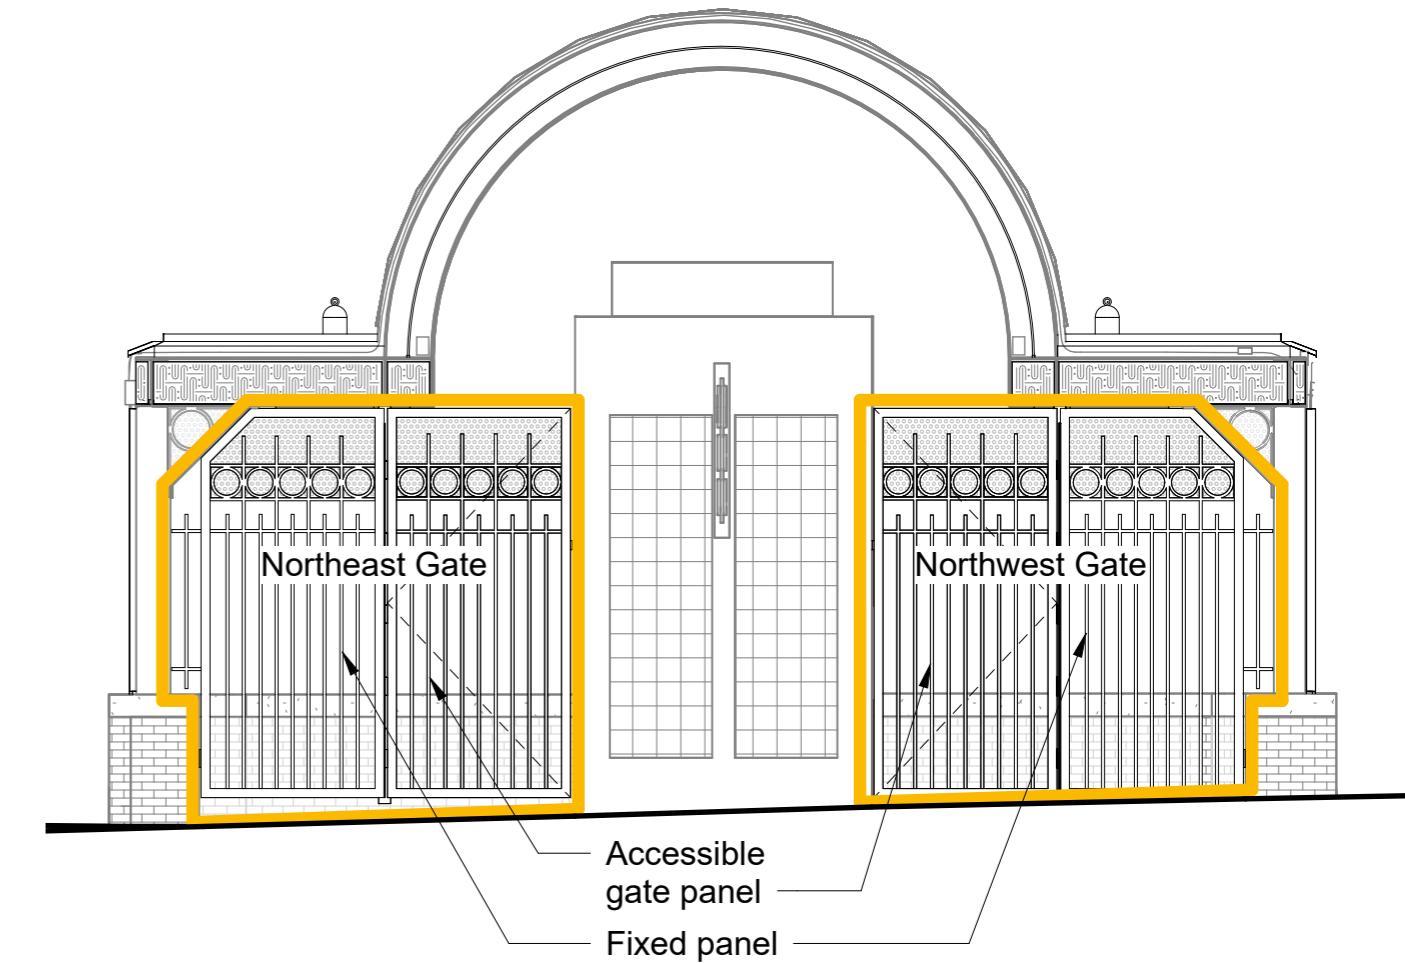


PROPOSED ELEVATION - 3RD AVE / ELEV ENTRY

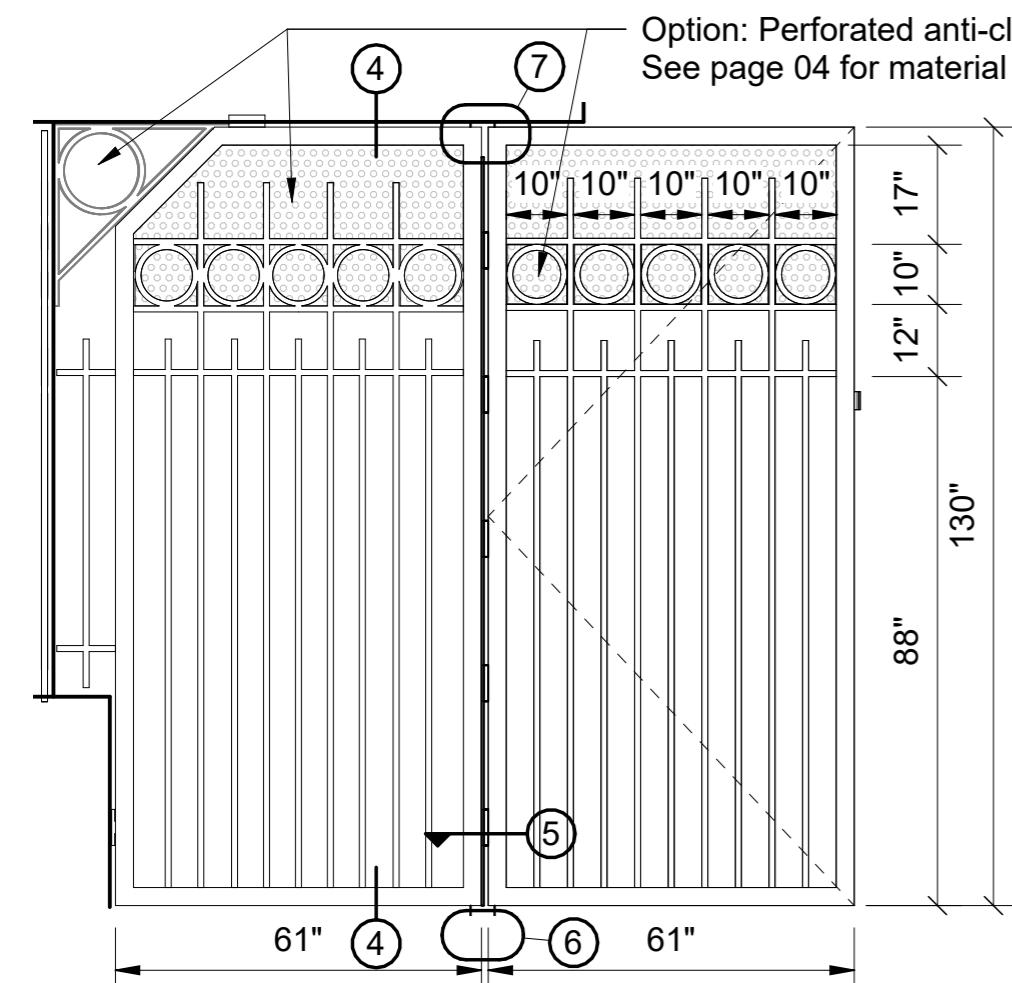


2 ENLARGED ELEVATION - NORTHEAST GATE

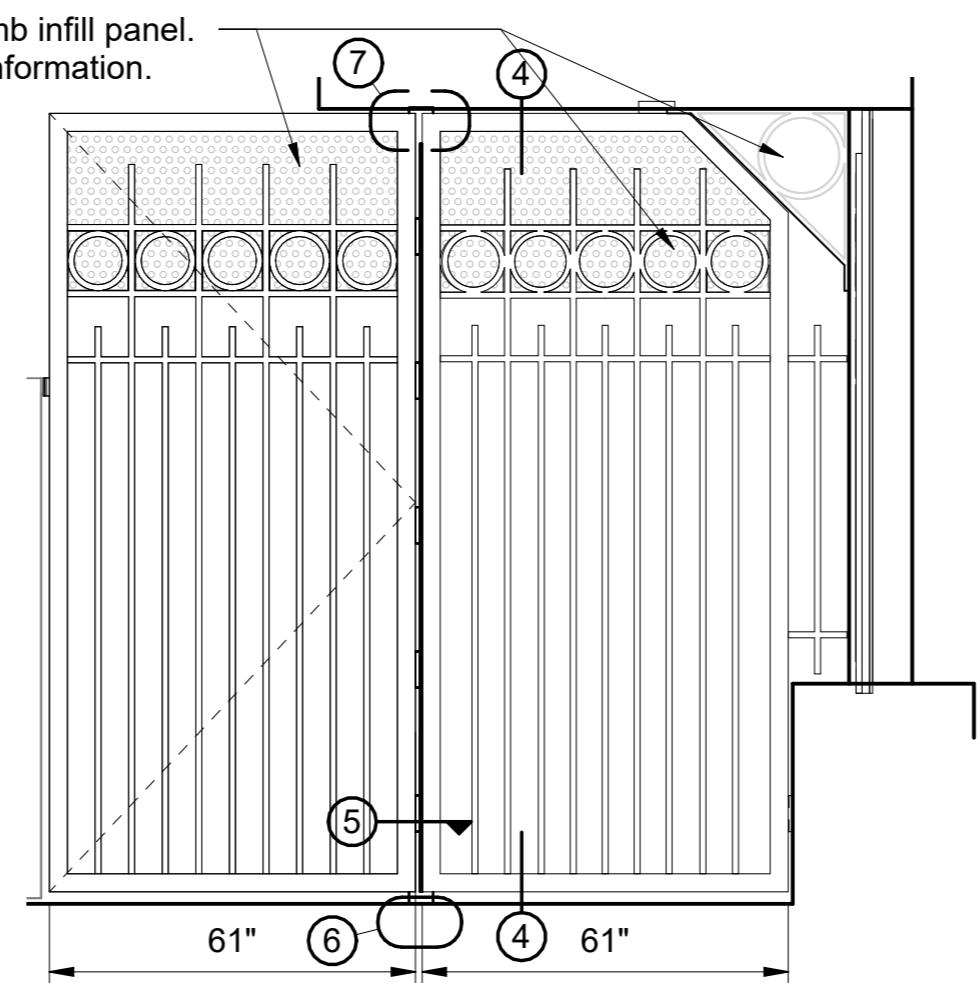


3 ENLARGED ELEVATION - NORTHWEST GATE

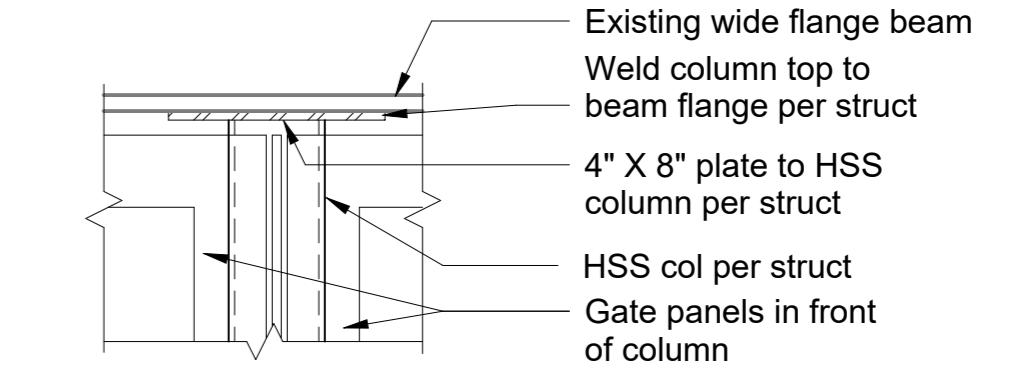


7 SECTION DETAIL - COLUMN HEAD

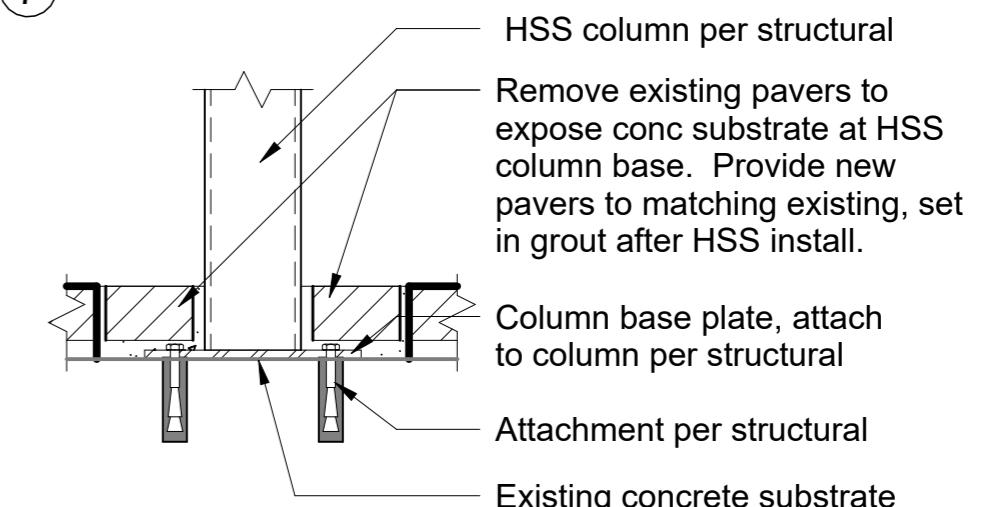


6 SECTION DETAIL - COLUMN BASE

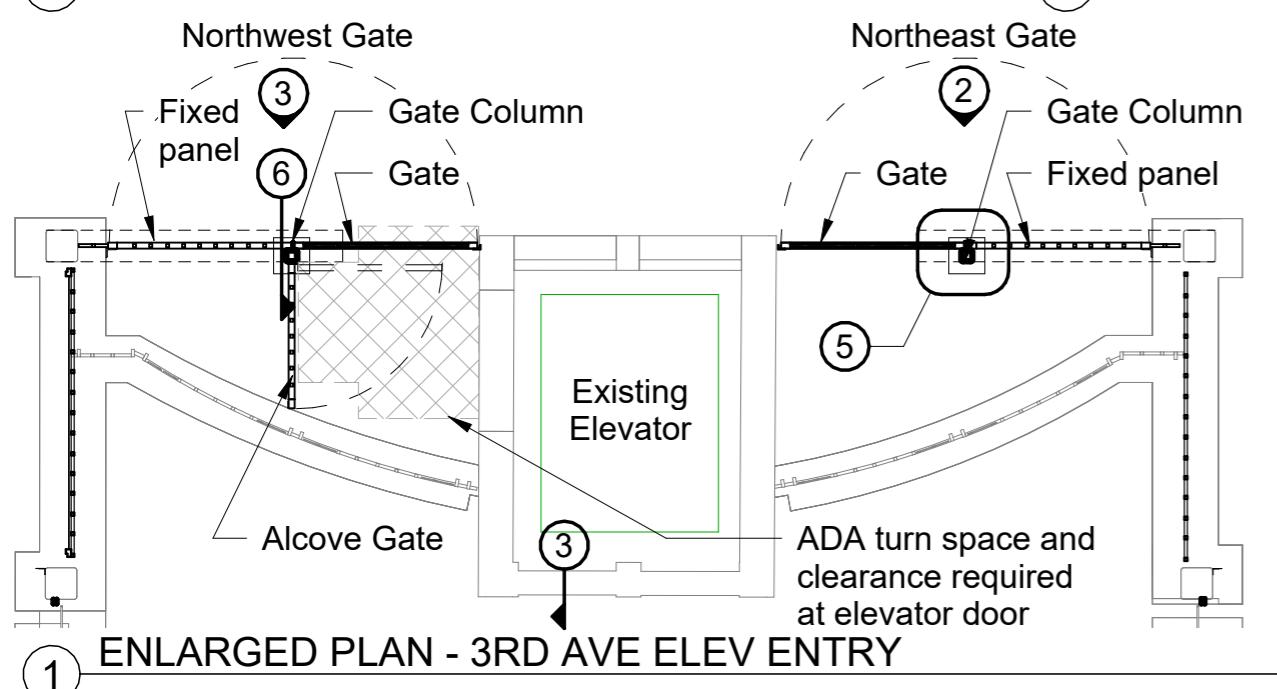

1 ENLARGED PLAN - 3RD AVE ELEV ENTRY

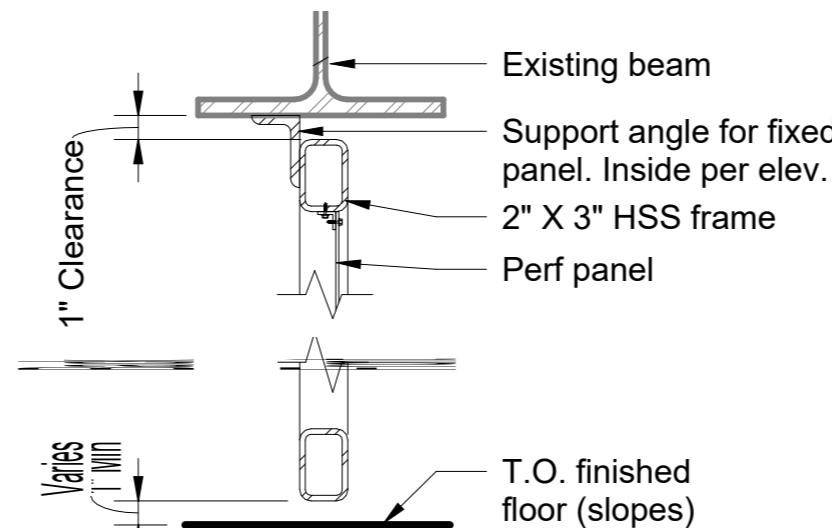

4 SECTION DETAIL - GATE FRAME

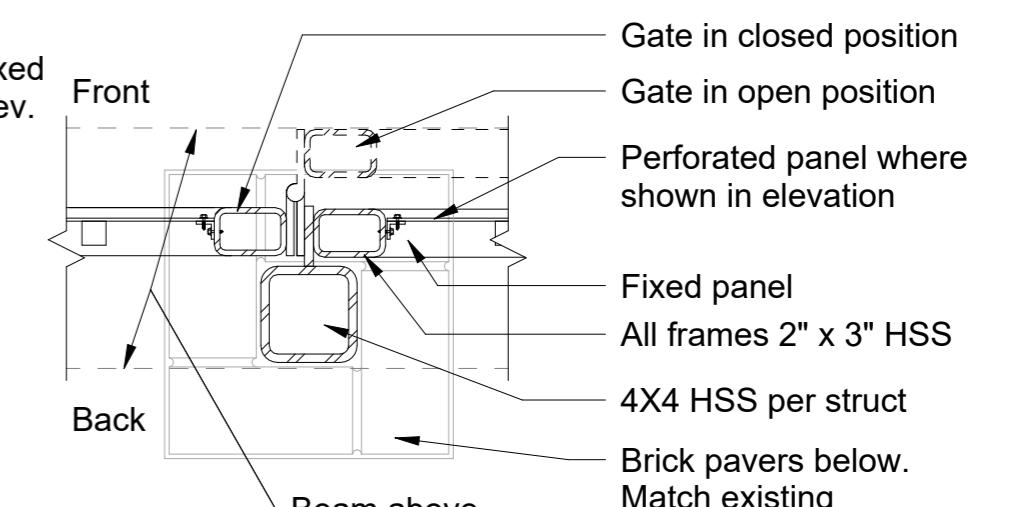

5 PLAN DETAIL - COLUMN AND GATE

NOTE: ALL GATES, COLUMNS
AND SUPPORTS ARE PAINTED TO
MATCH EXISTING STRUCTURE

Proposed Interior



EXISTING PLINTH


Remove glass block


Existing brick plinth to remain

Glass block wall was not recorded
in the original as-built drawings
indicating that it was a later addition

Existing brick plinth to remain

ORIGINAL AS-BUILT SECTION

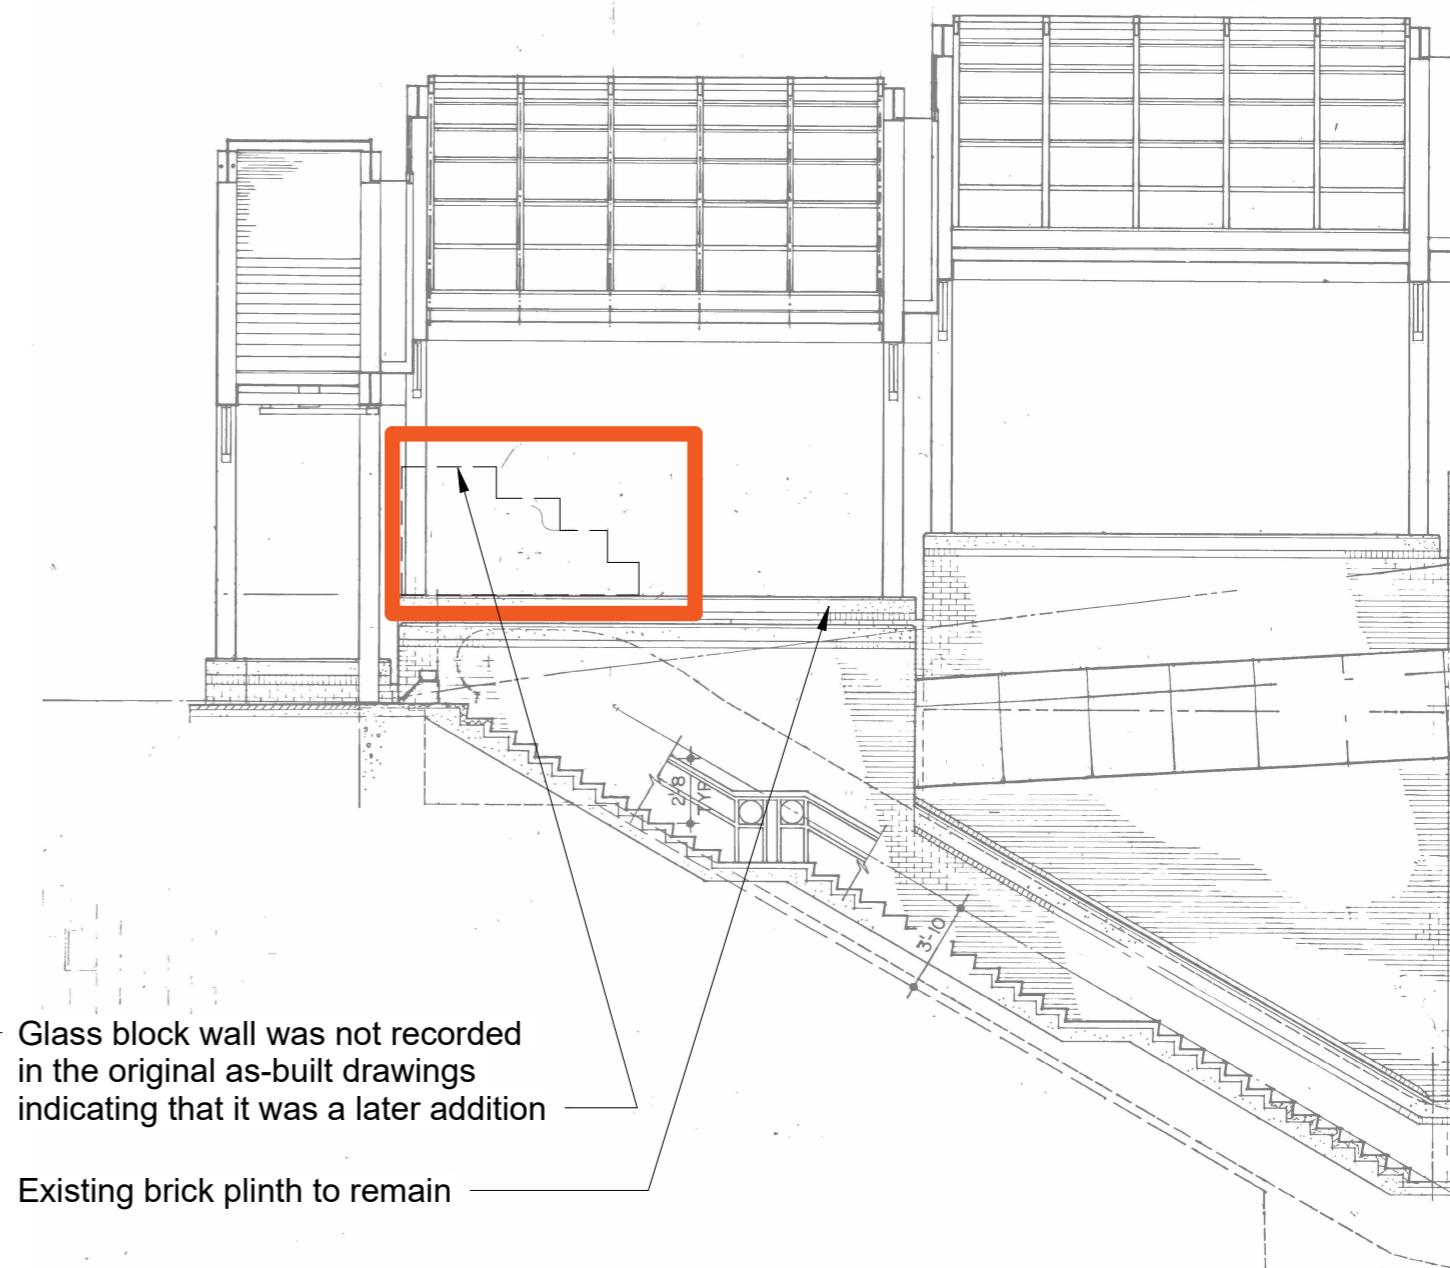


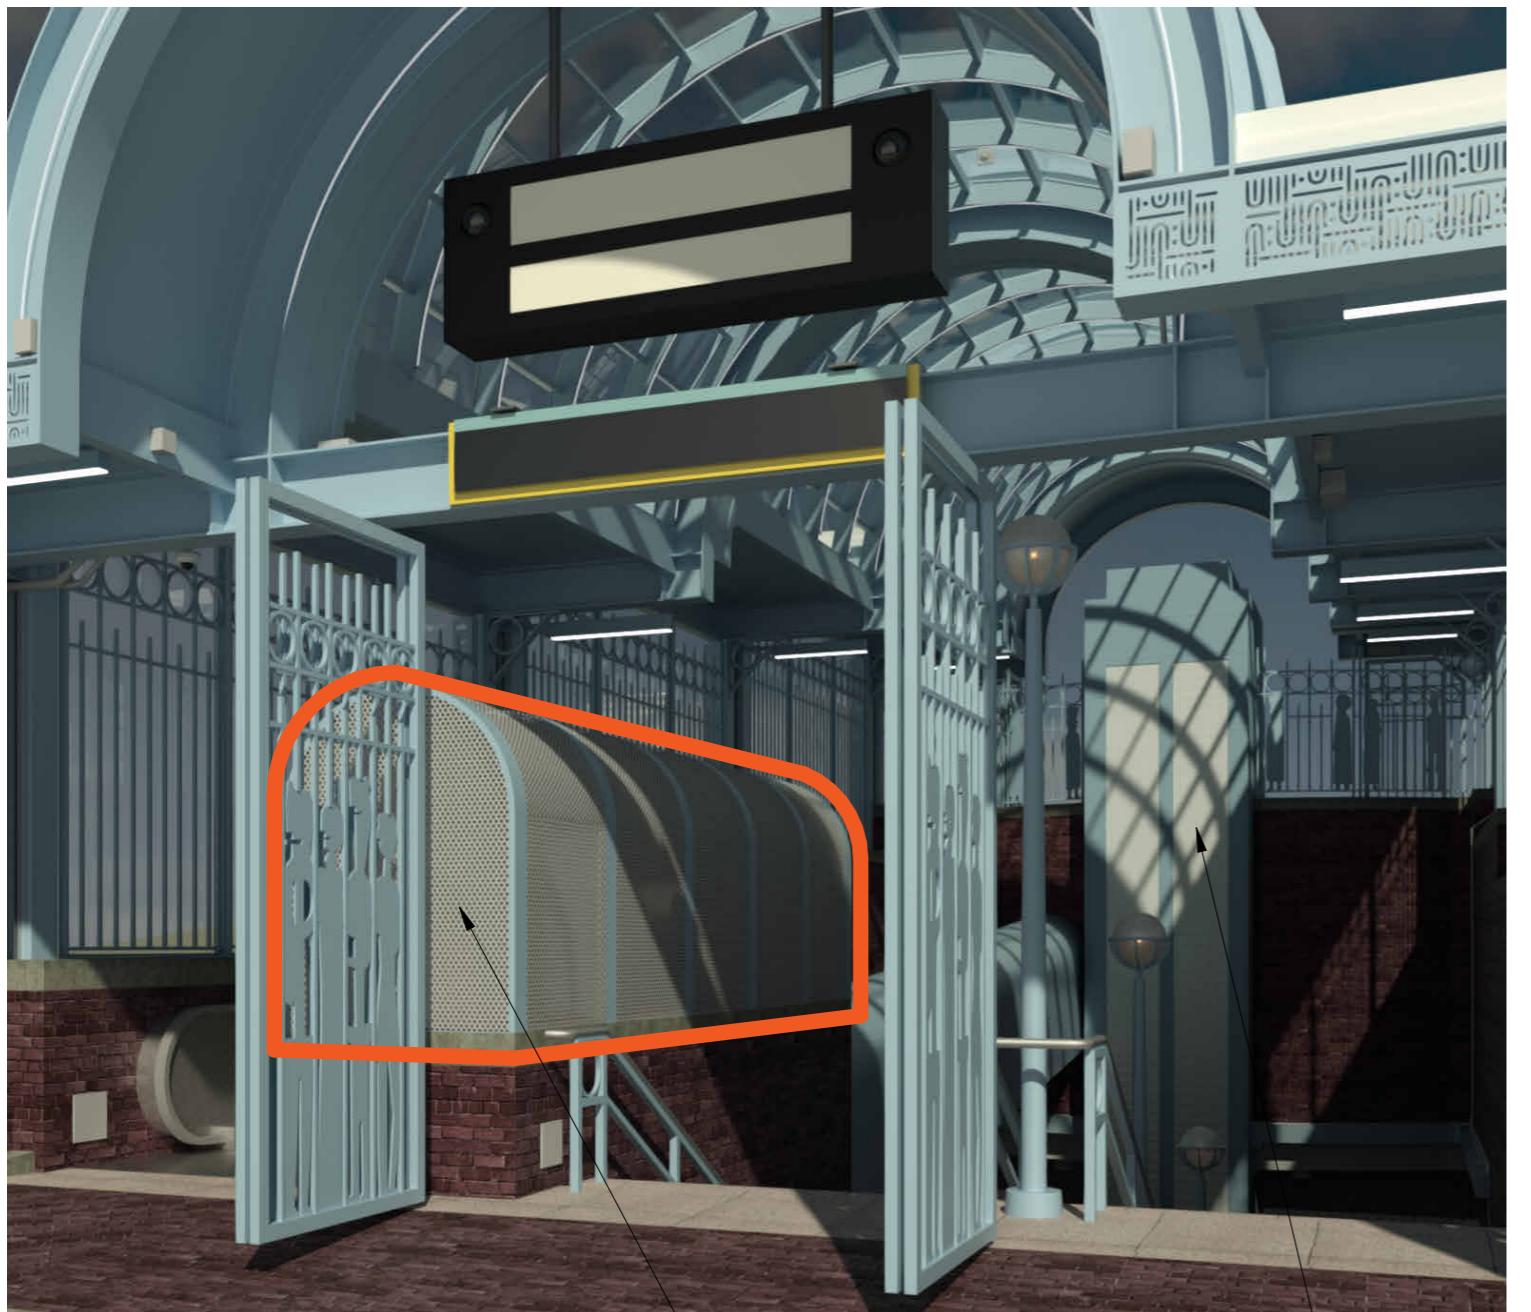


PROPOSED PLINTH COVER



Plinth with curved, anti-climb perforated panel with possible option for integrated lighting

Light-colored stainless steel perforated panel to mimic the open feeling of the roof vault, the arched barrel vault and circles on the gates

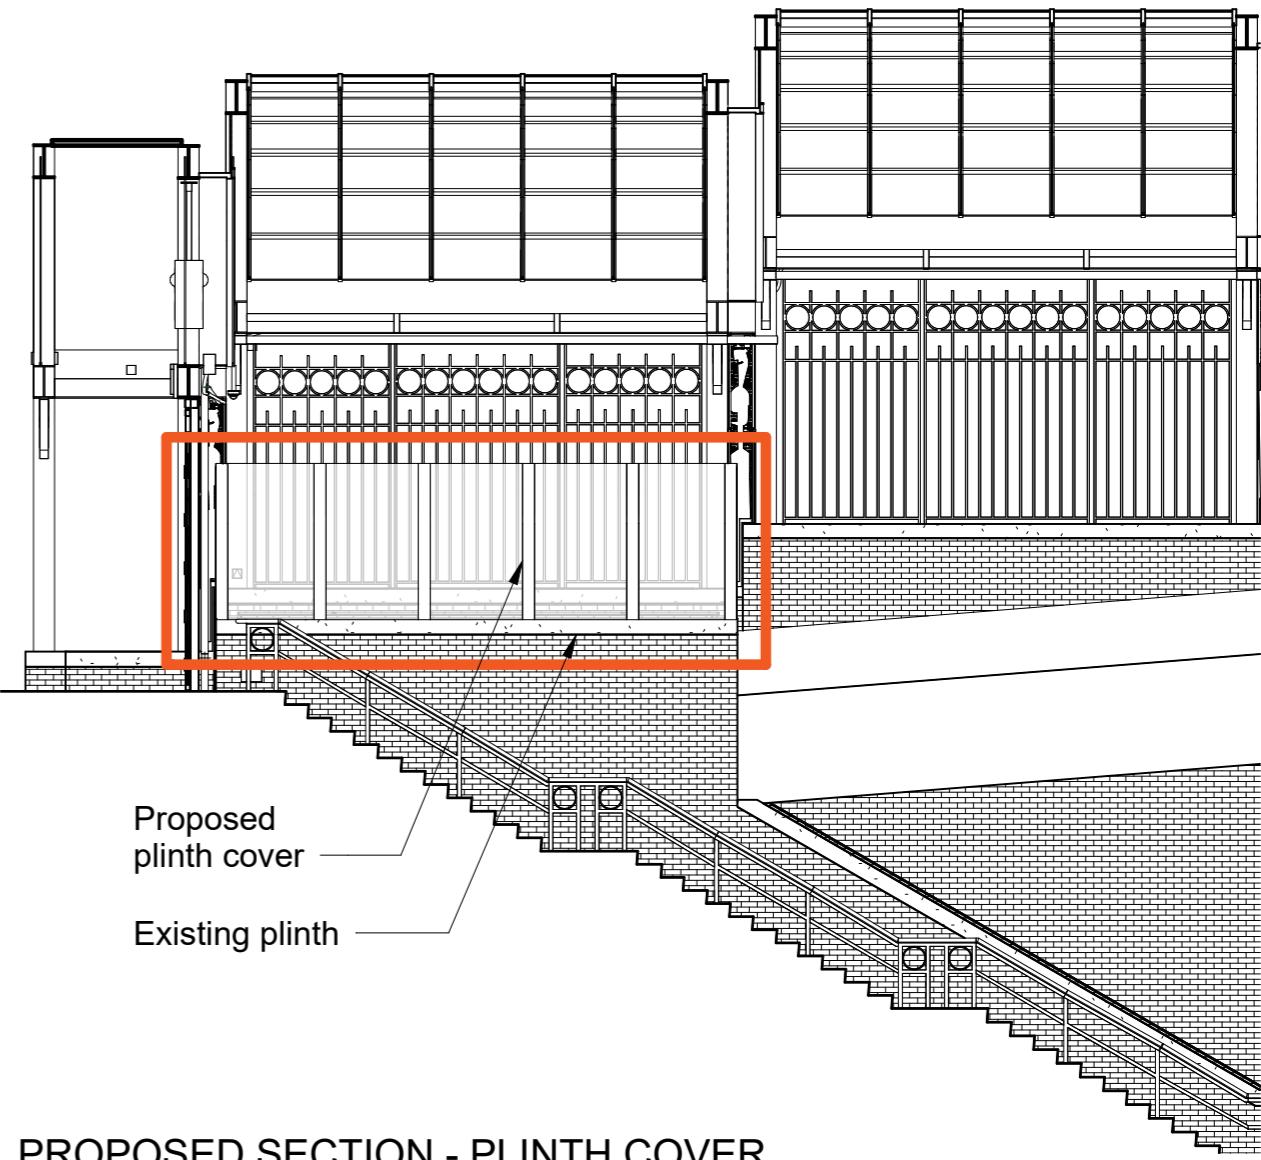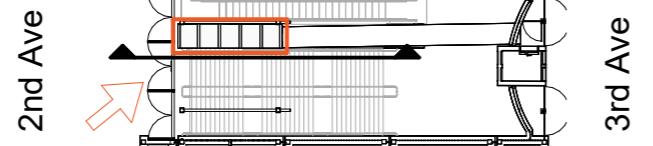

PROPOSED SECTION - PLINTH COVER



EXISTING PLINTH COVER




PROPOSED PLINTH COVER







B1 See 41 - 67


B1 See 41 - 67

Plinth with curved, anti-climb
perforated panel with possible
future integrated lighting

A3 To mitigate the significant safety hazard of individuals climbing over the low glass-block guard onto the adjacent elevated duct bank, we propose a custom arched metal structure atop the interior plinth. Inspired by the station's iconic barrel vault ceiling, the arched form reinforces the existing architectural language and creates a cohesive, visually integrated design. Clad in perforated stainless steel panels, the structure is designed to visually recede—appearing almost transparent from a distance—while physically deterring climbing. The cover will include provisions for a possible option to include integrated backlighting to enhance ambient illumination at the entry stair, improving visibility and drawing subtle attention to the vault-inspired geometry. This solution not only addresses safety concerns but also enhances the station's aesthetic quality.

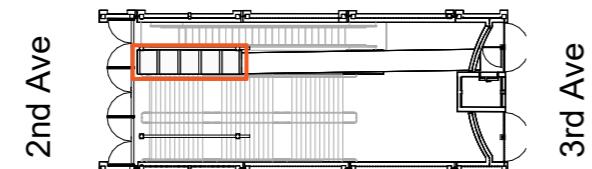

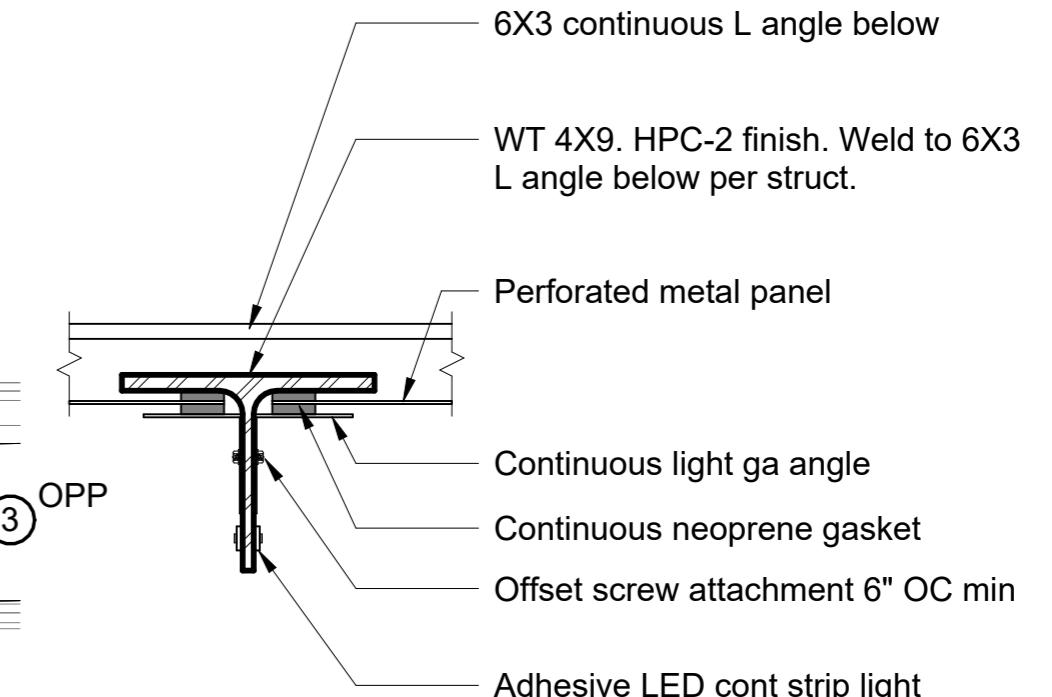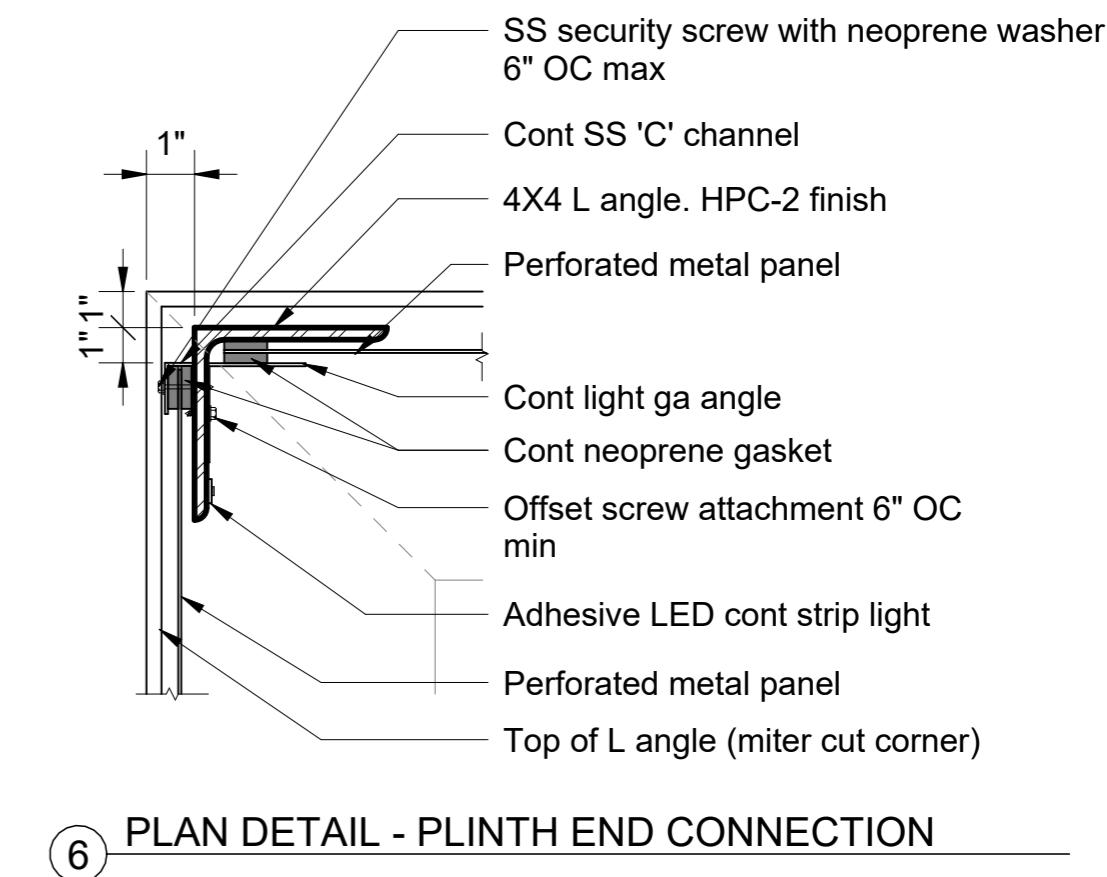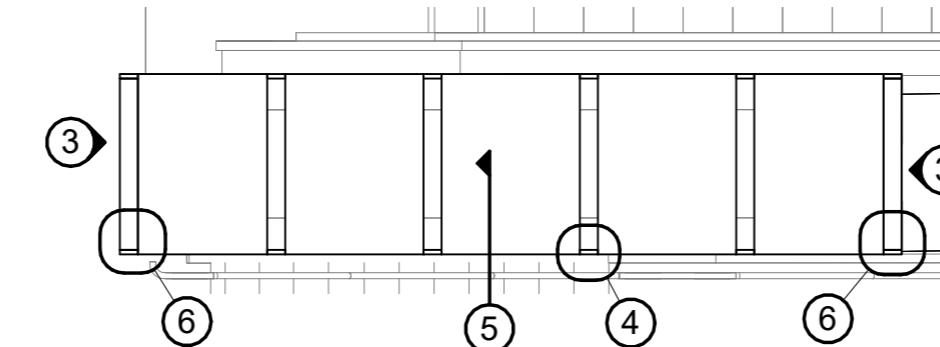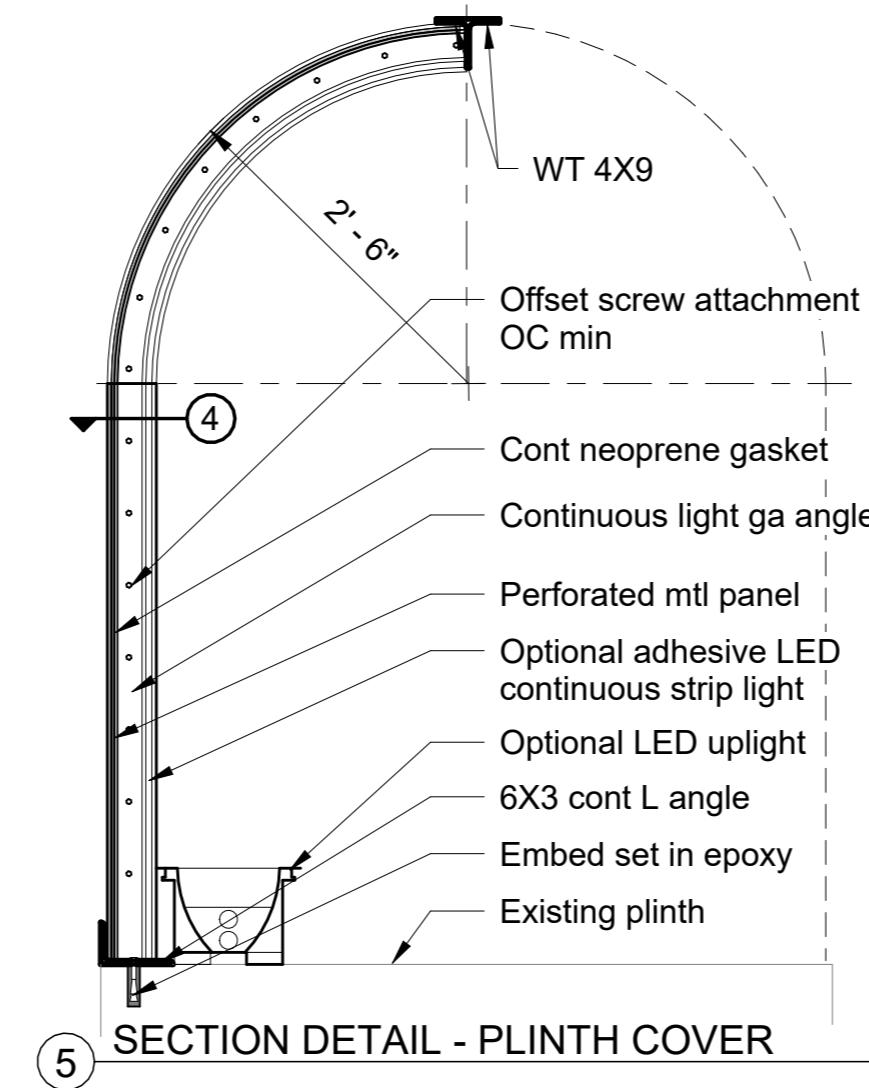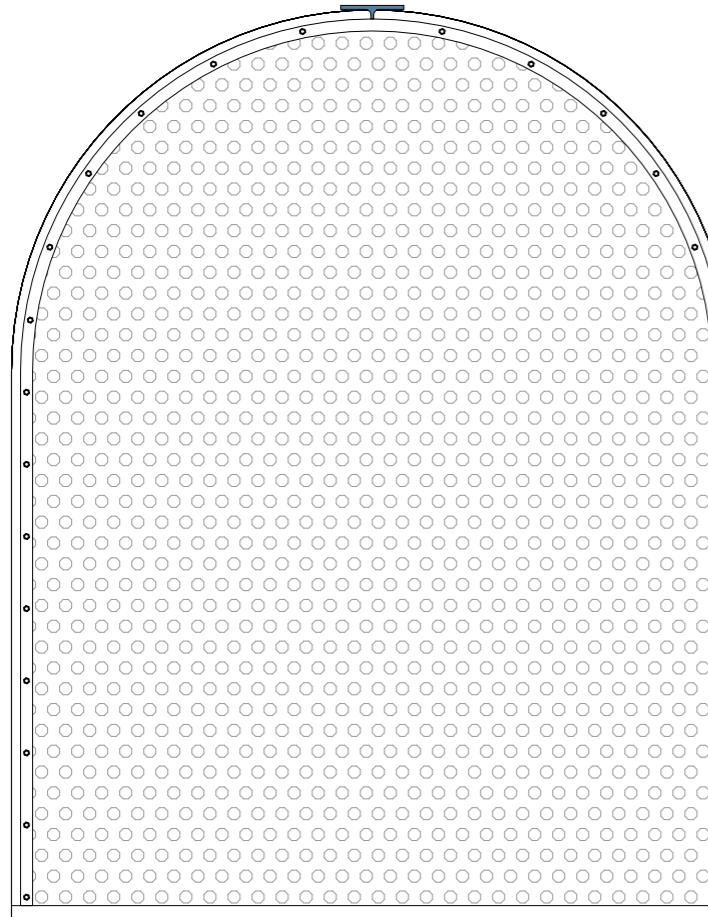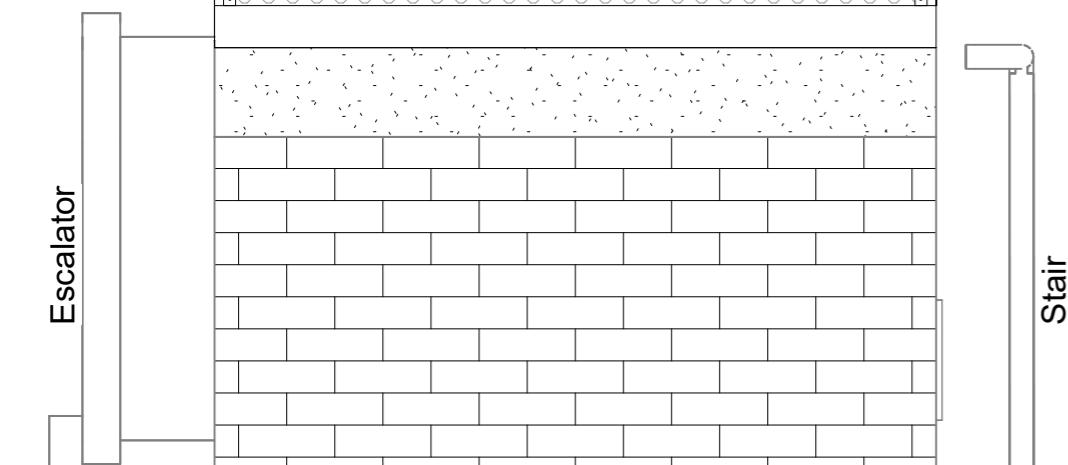

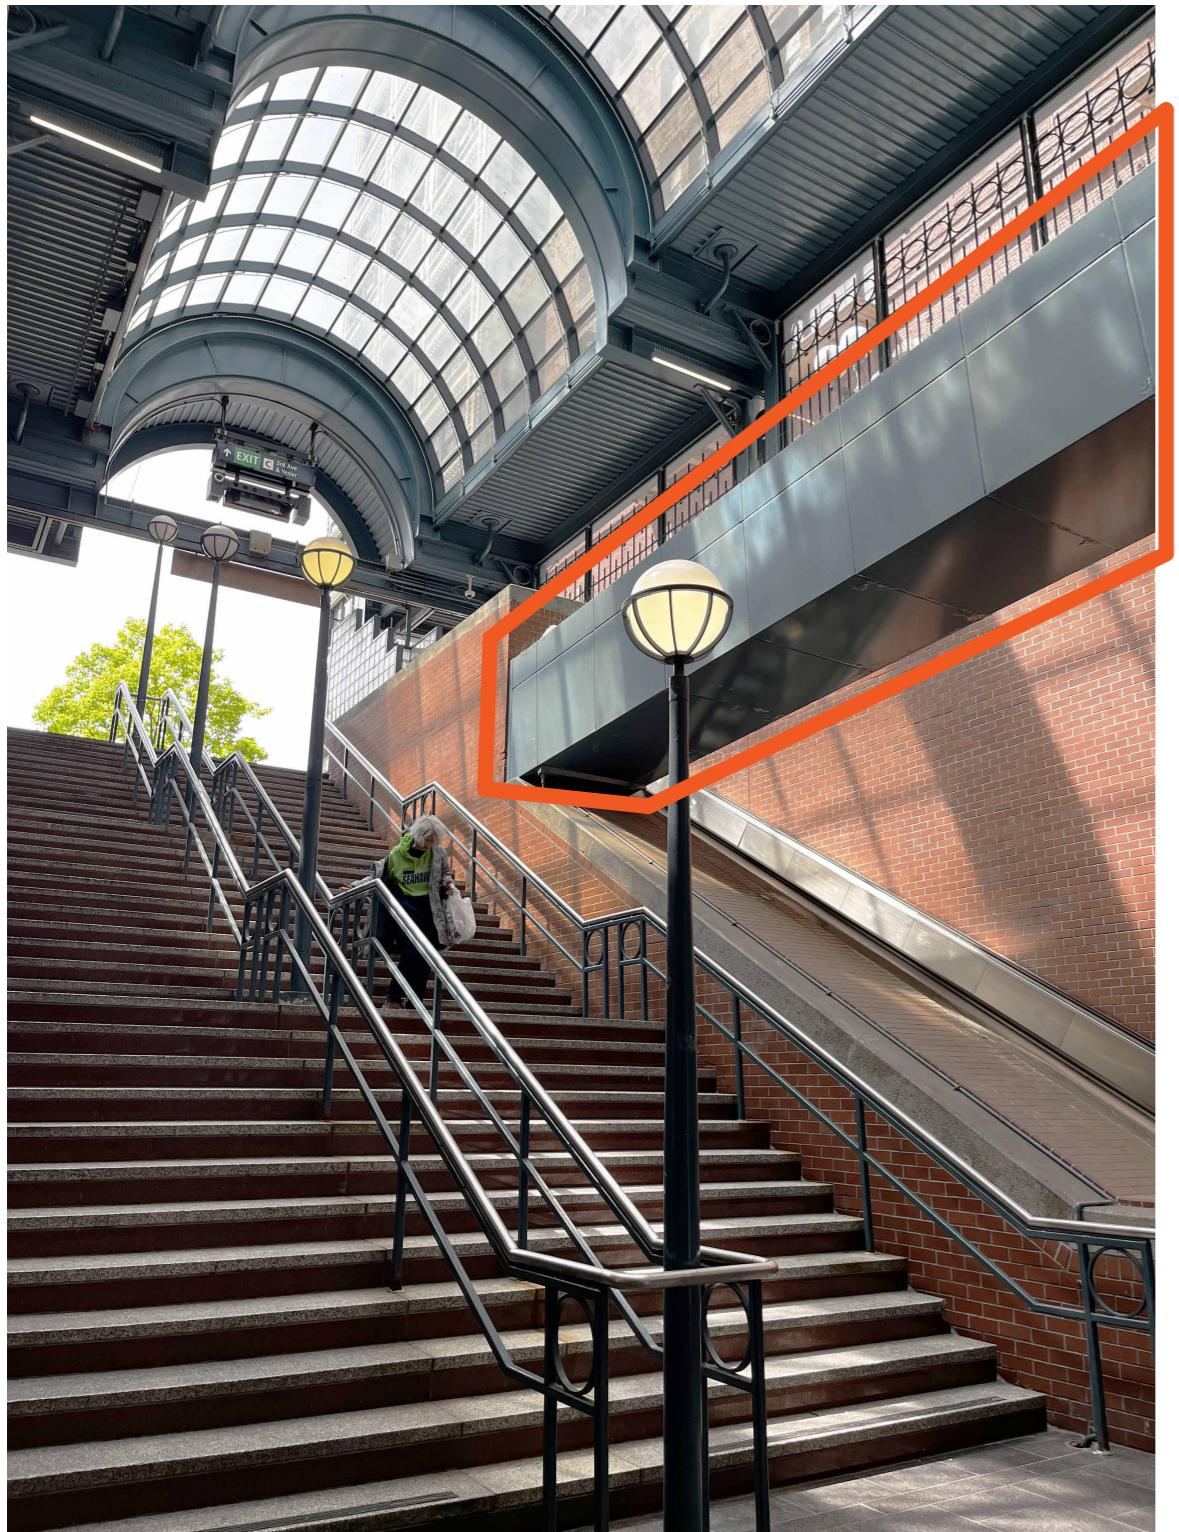


EXISTING - DUCT BANK

Plinth with curved, anti-climb
perforated panel. Possible
option to add interior lighting


Duct bank with curved,
anti-climb flush metal panel,
finish to match existing




PROPOSED - DUCT BANK

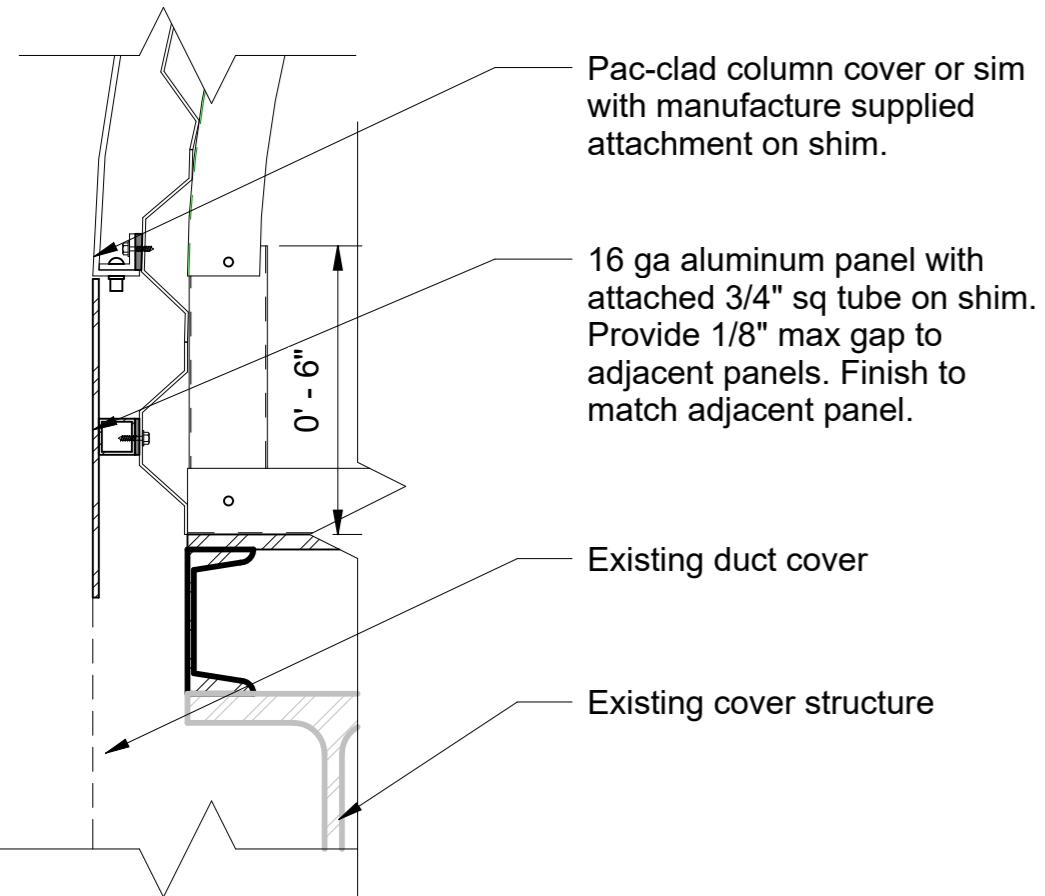

2 SECTION DETAIL - DUCT BANK COVER

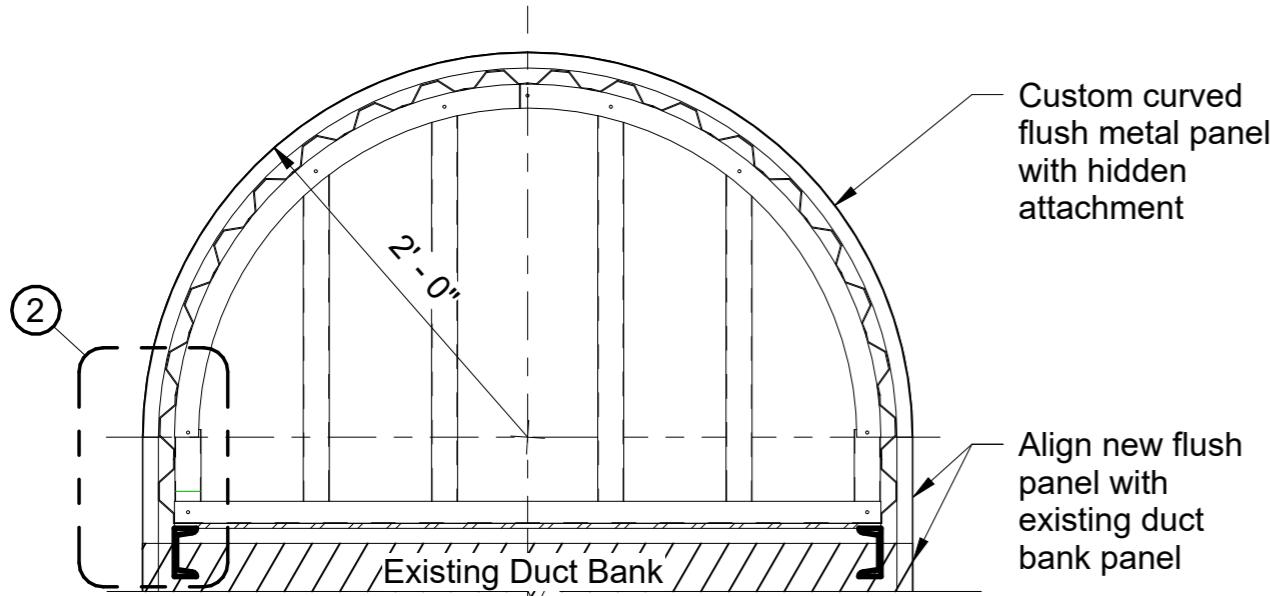

1 SECTION - DUCT BANK COVER

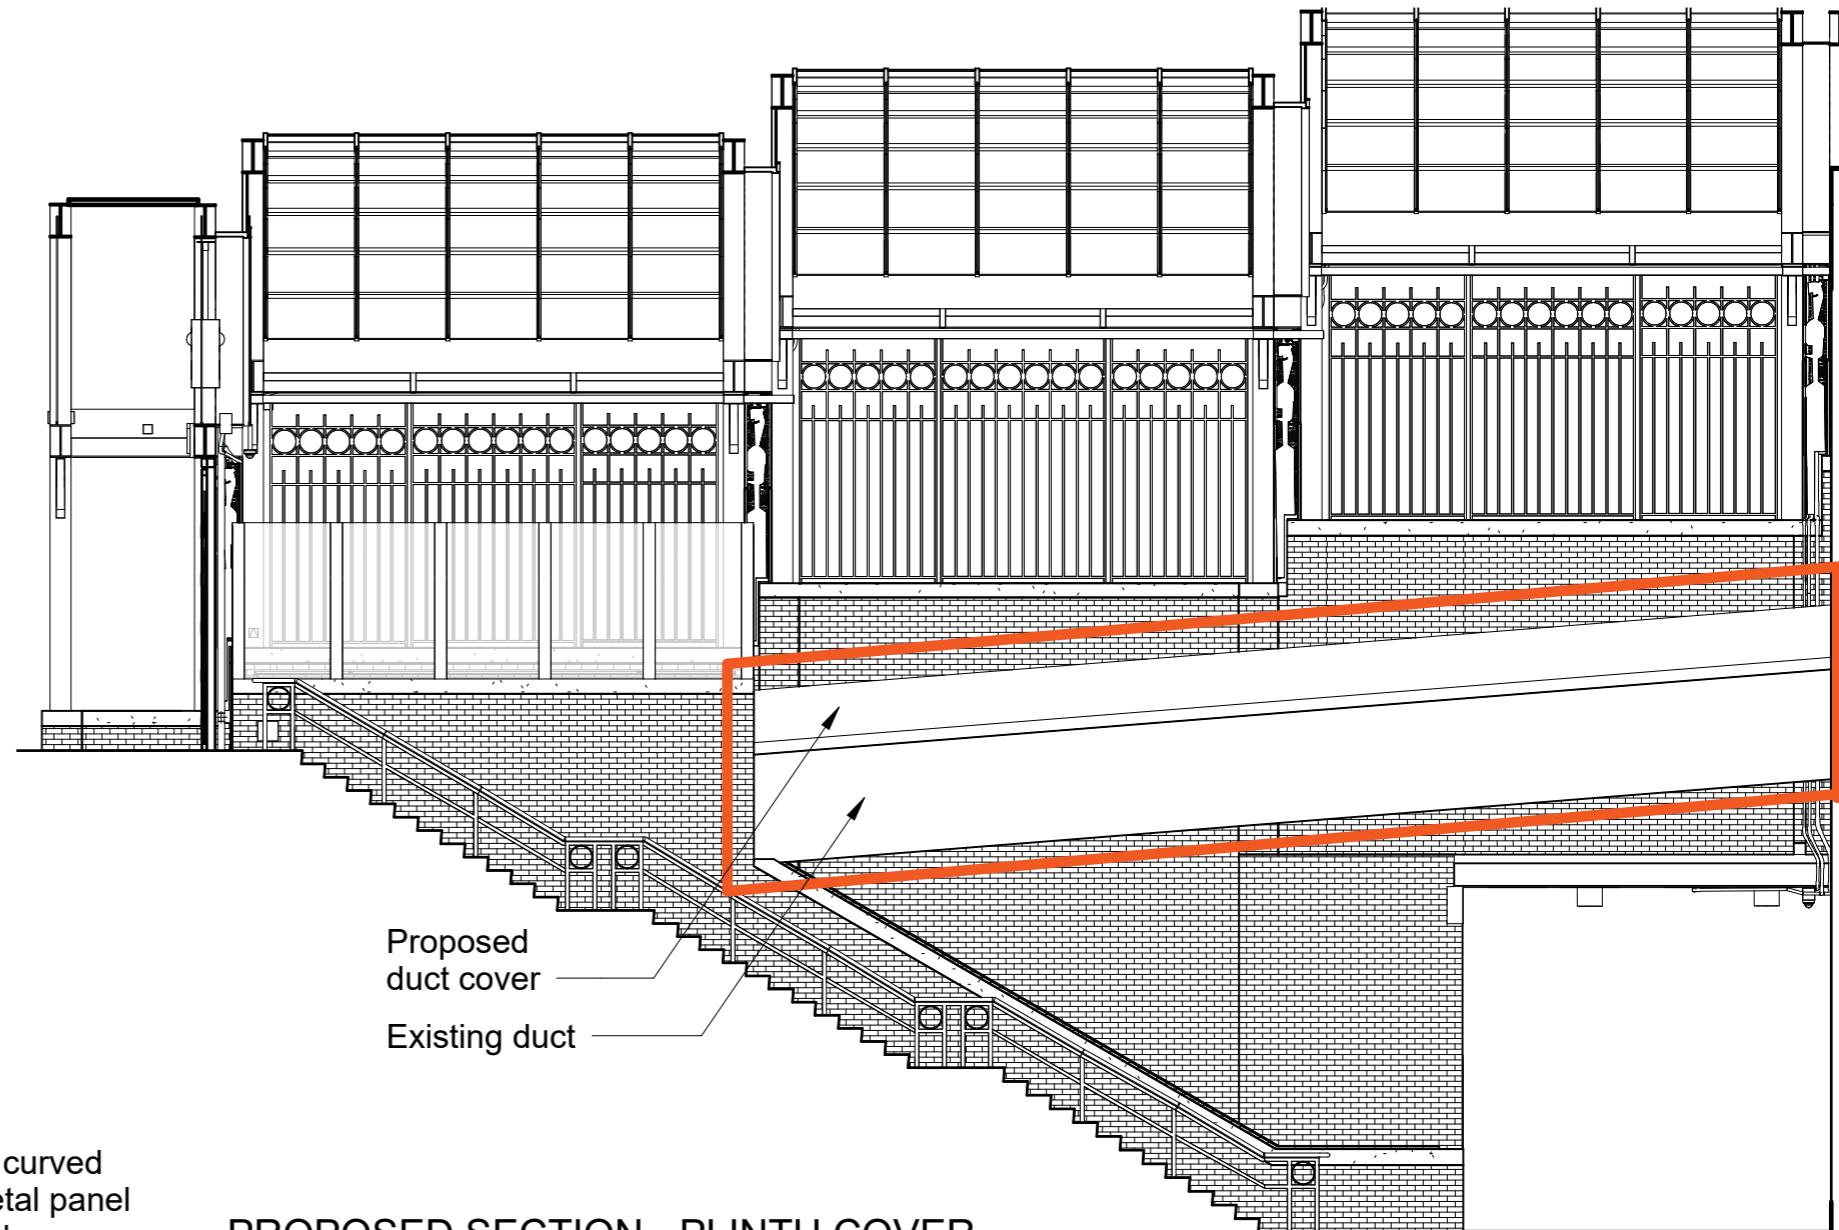

PROPOSED SECTION - PLINTH COVER

Design Options

Horizontal Elements

Vertical Elements


Fall Protection

Design Options


Horizontal Elements



EXISTING FACADE - 3RD AVE / ELEV ENTRY

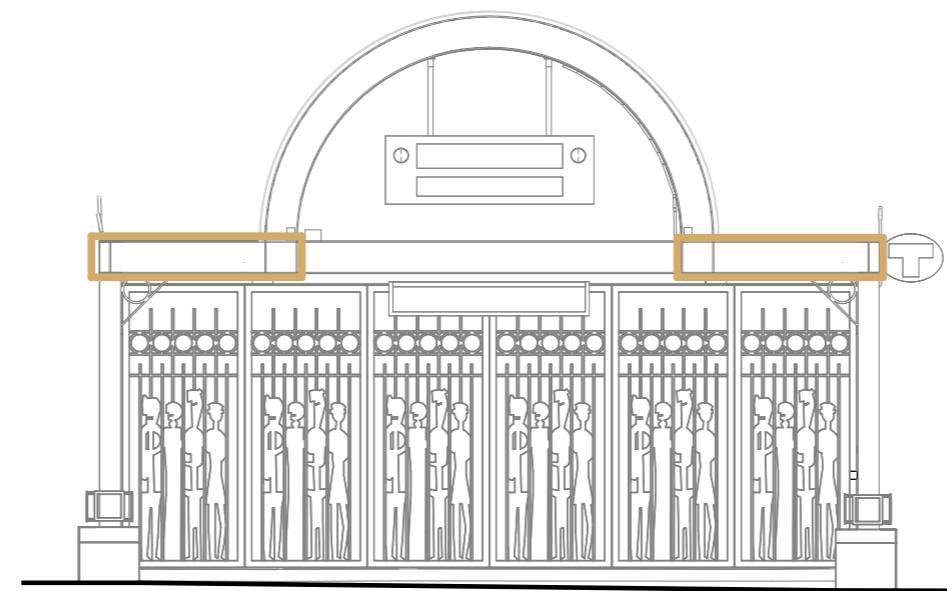

EXISTING ELEVATION -
2ND AVE / PUBLIC ART ENTRY

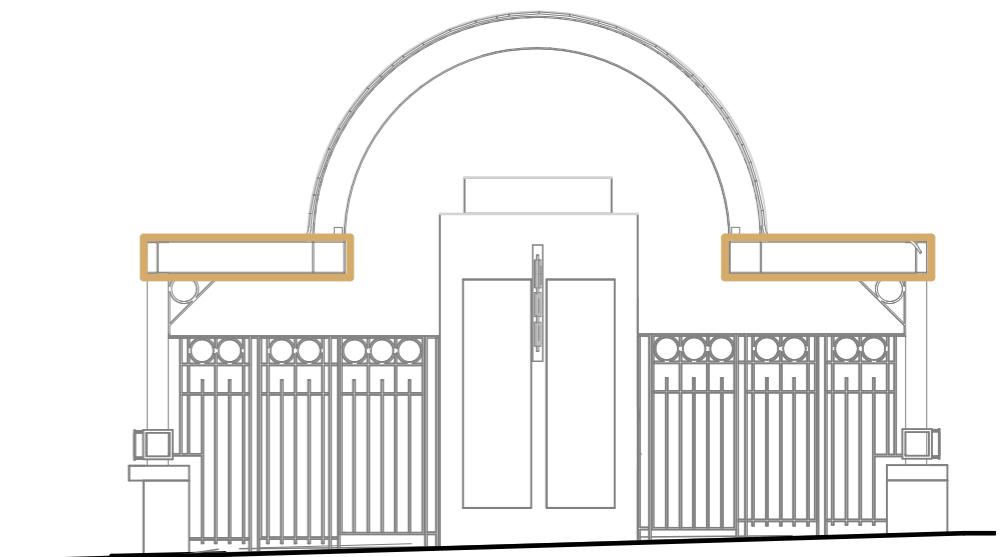


EXISTING ELEVATION - 3RD AVE / ELEV ENTRY




EXISTING ELEVATION - EAST / YESLER WAY




PROPOSED - OPTION 1

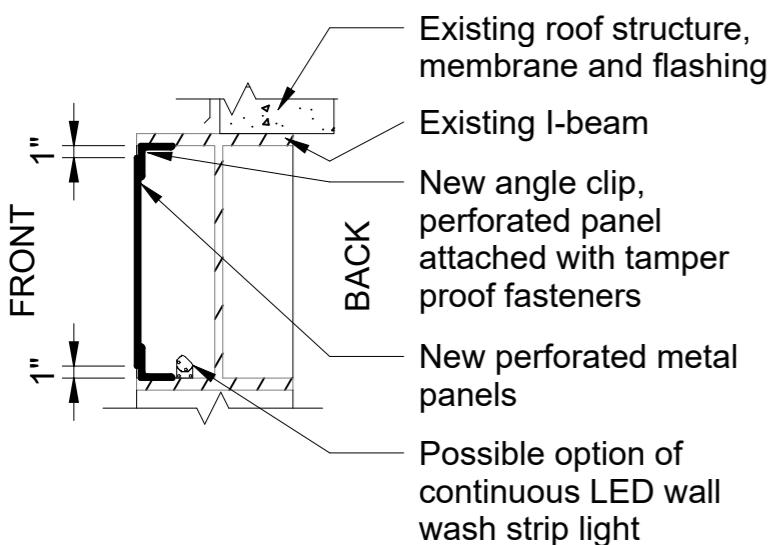


1 SECTION DETAIL - INFILL AT I BEAM

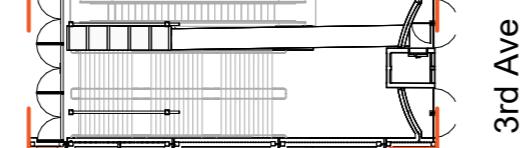


Tiscareno

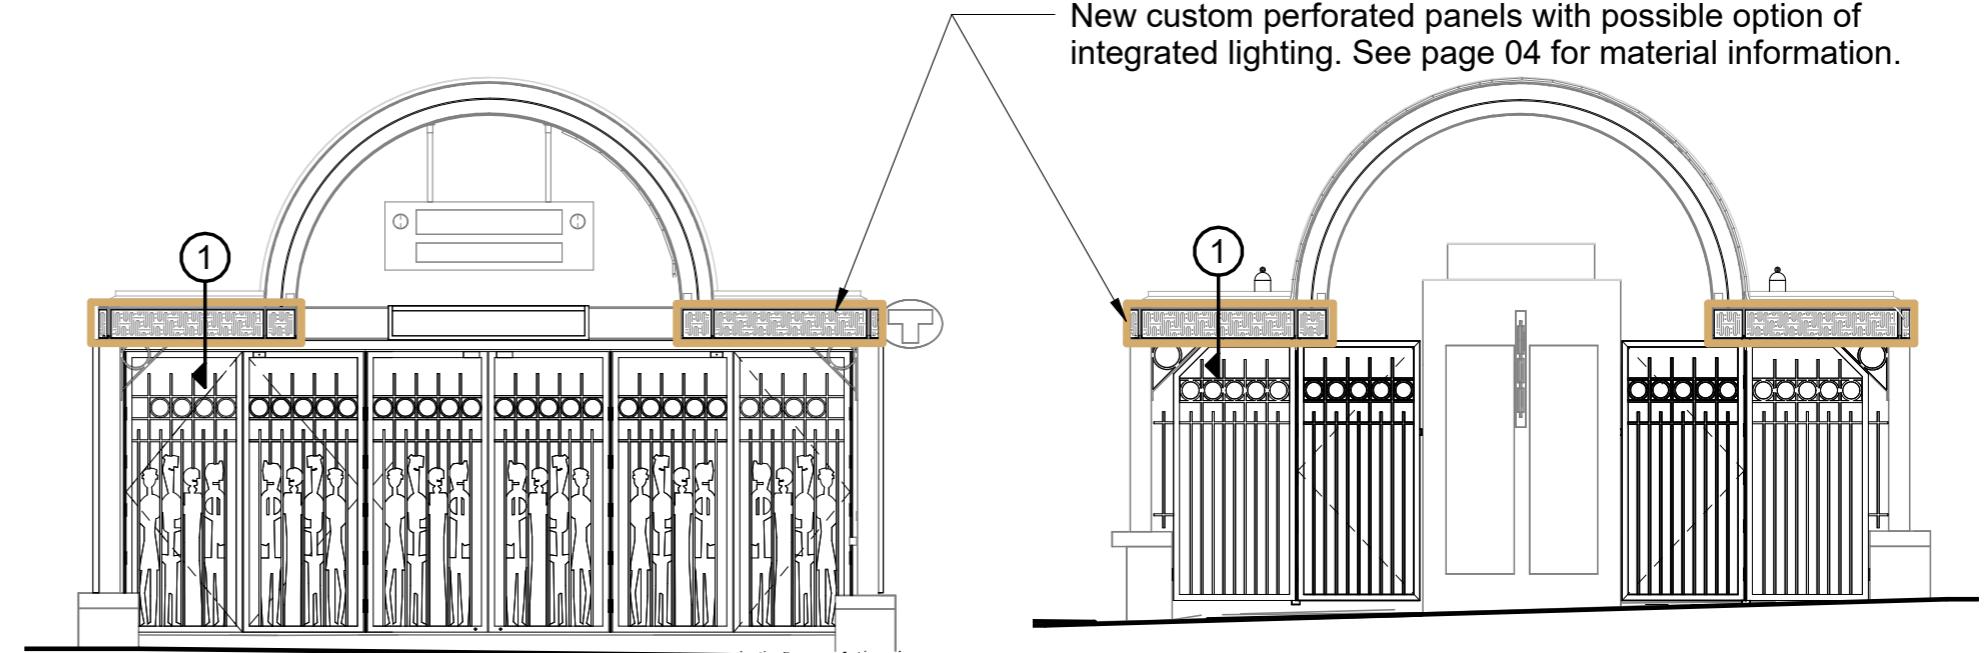

PROPOSED ELEVATION - 2ND AVE / PUBLIC ART ENTRY

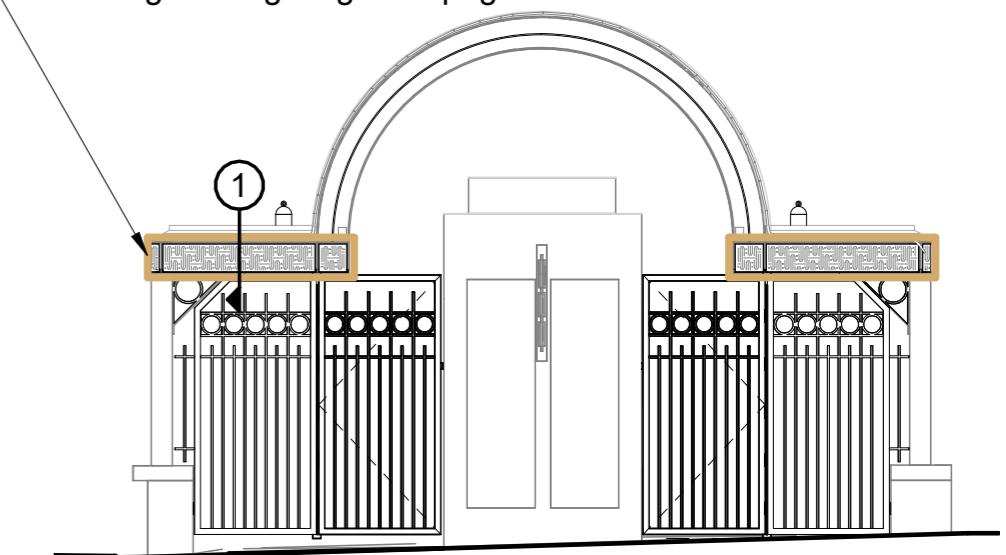

PROPOSED ELEVATION - 3RD AVE / ELEV ENTRY

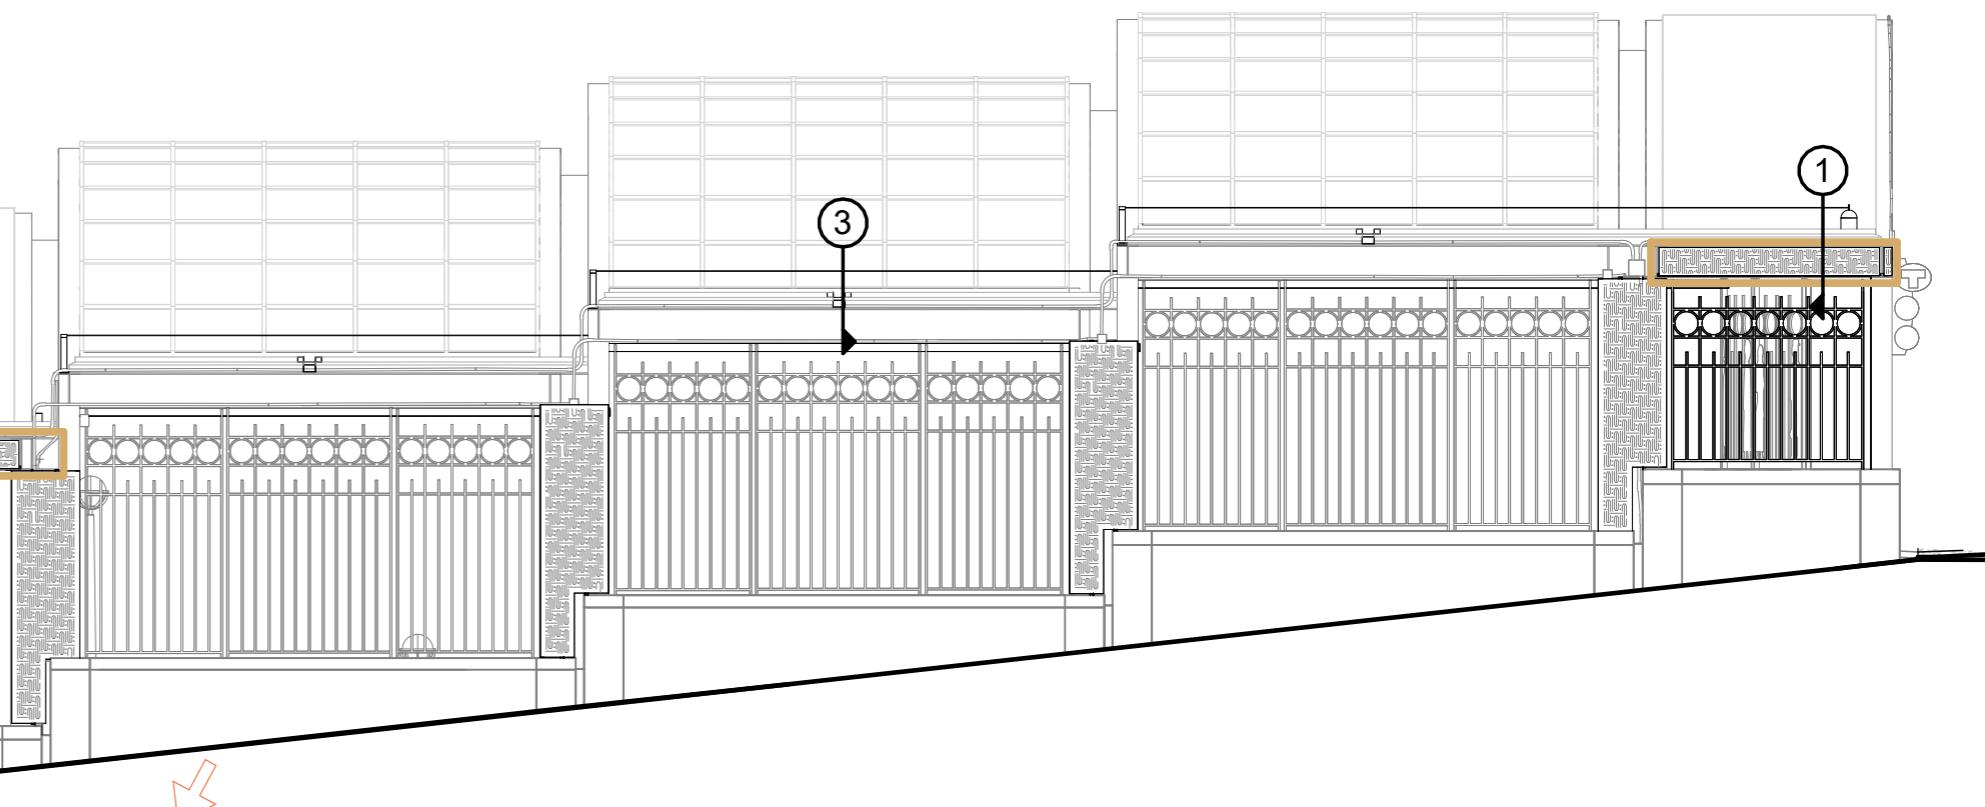

PROPOSED ELEVATION - EAST / YESLER WAY

Proposed and Detail



Exterior Security | I-Beam (Option 1 - Custom Panel)

Historic Preservation Board | PSS Prefontaine Headhouse | December 19, 2025

A4



22

New finely perforated panels in circular pattern painted in "Pioneer Blue". See page 04 for material information. Circular pattern echoes the arched barrel vault and circles on the gates

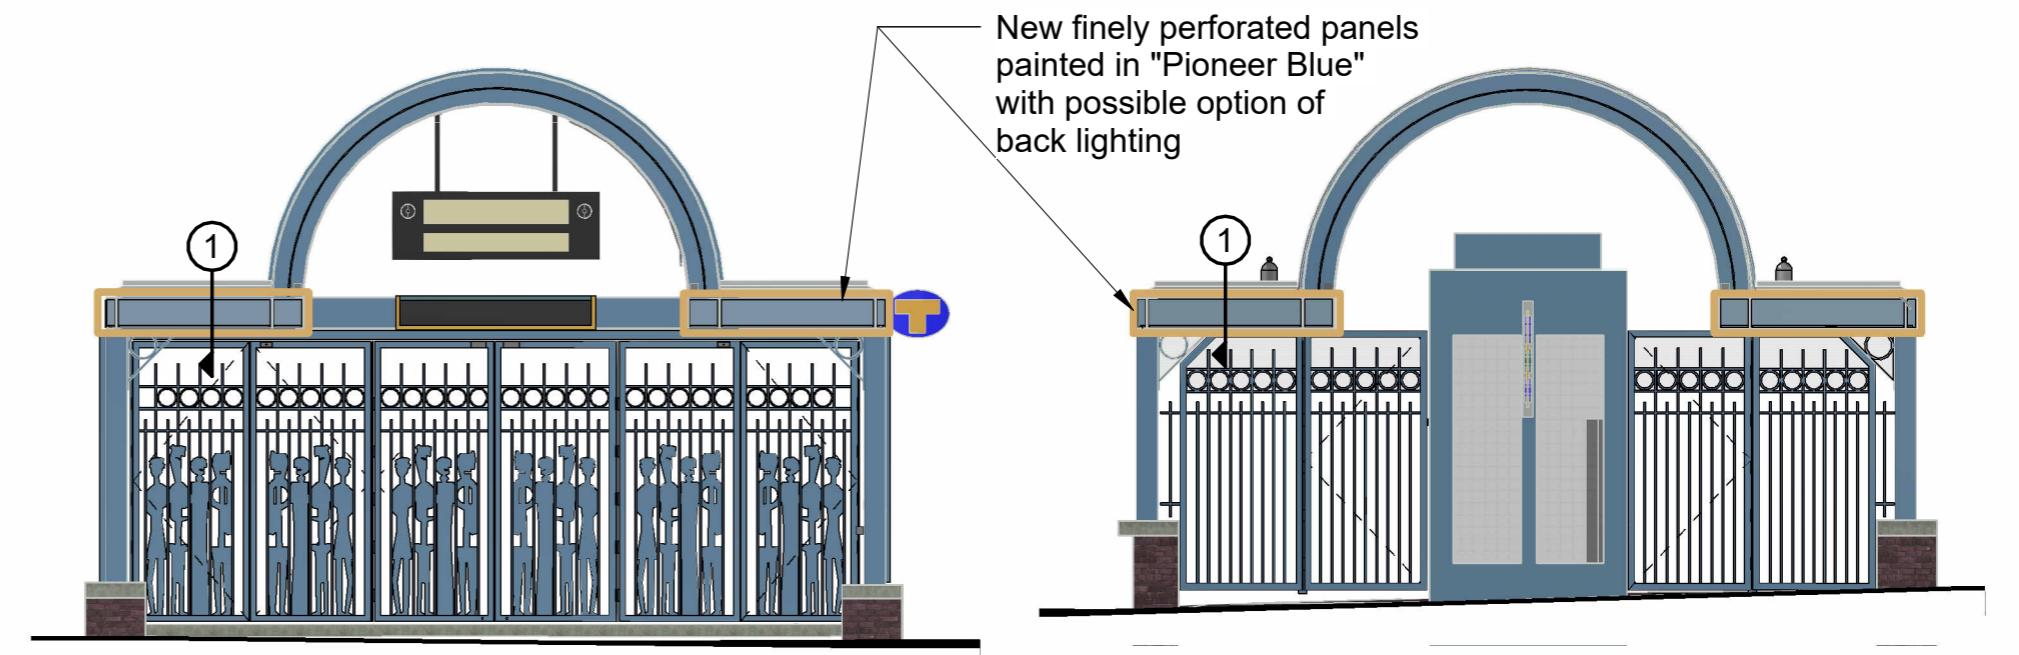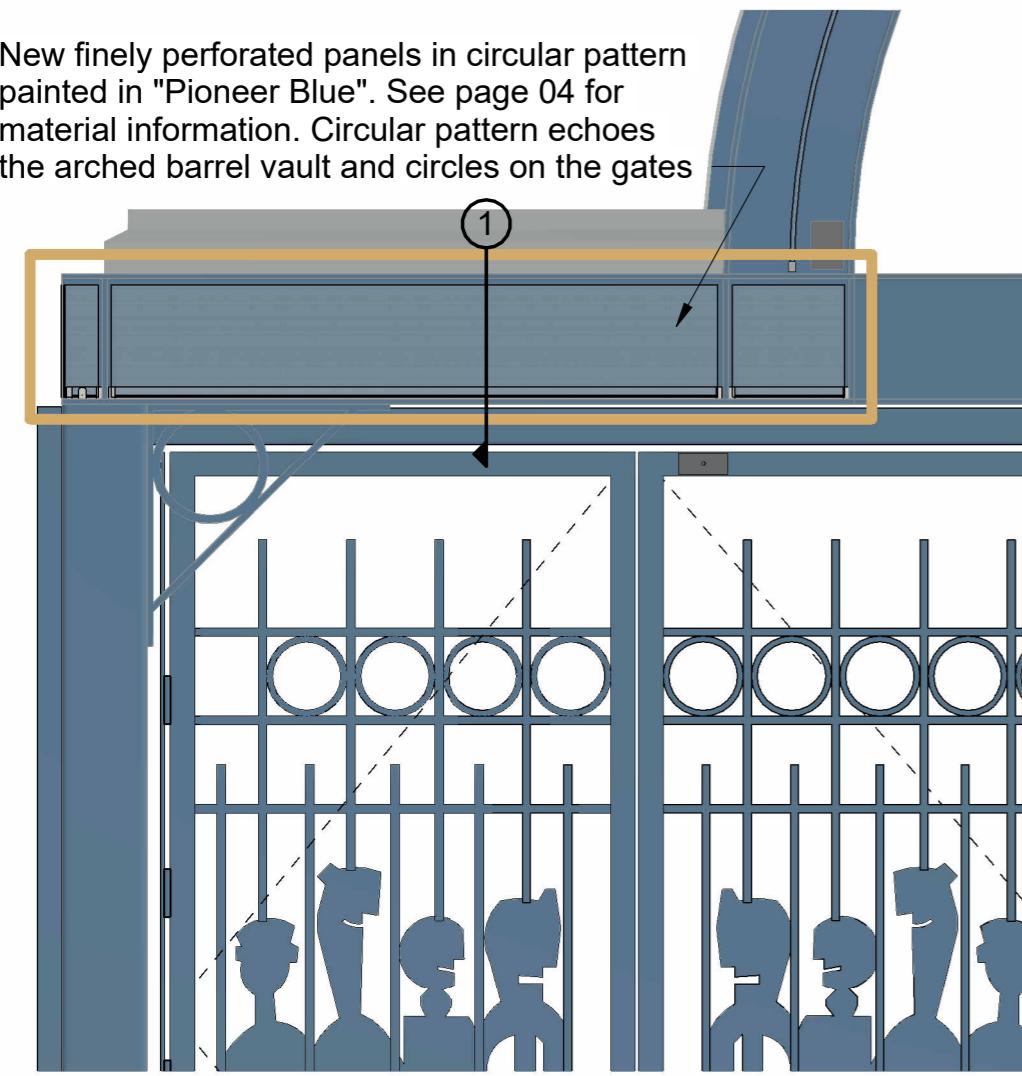


2

SECTION DETAIL - INFILL AT I BEAM

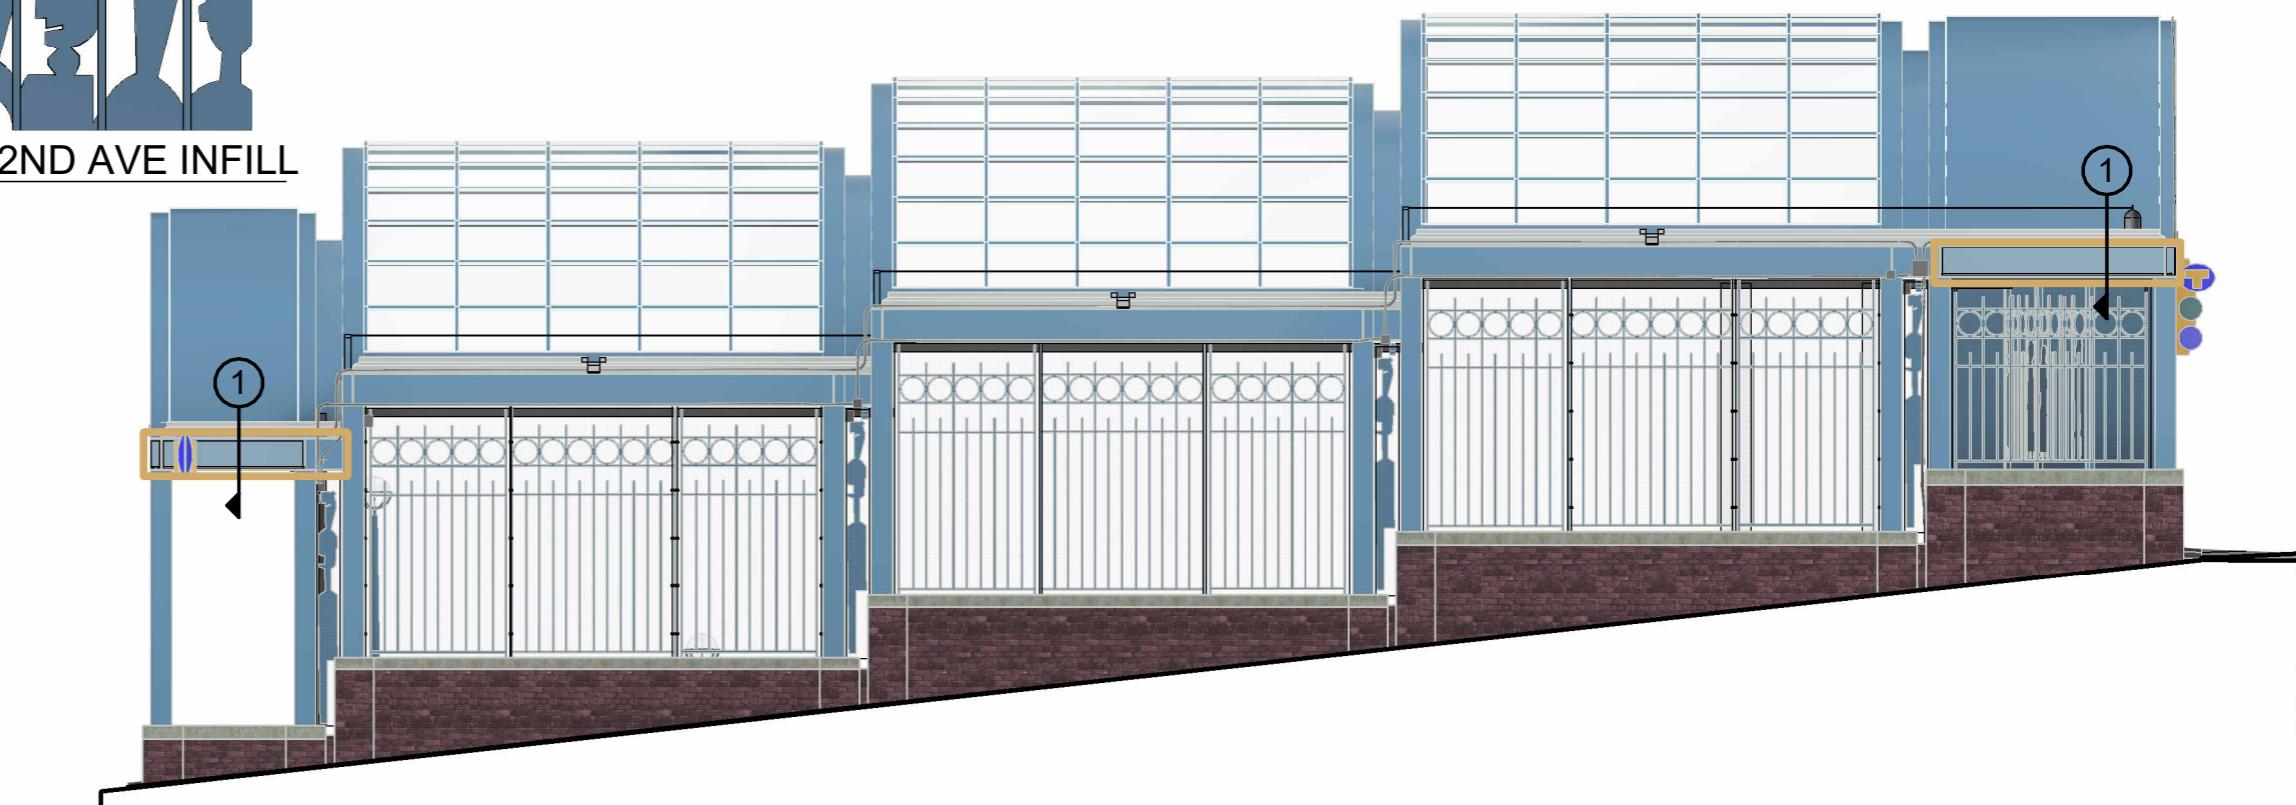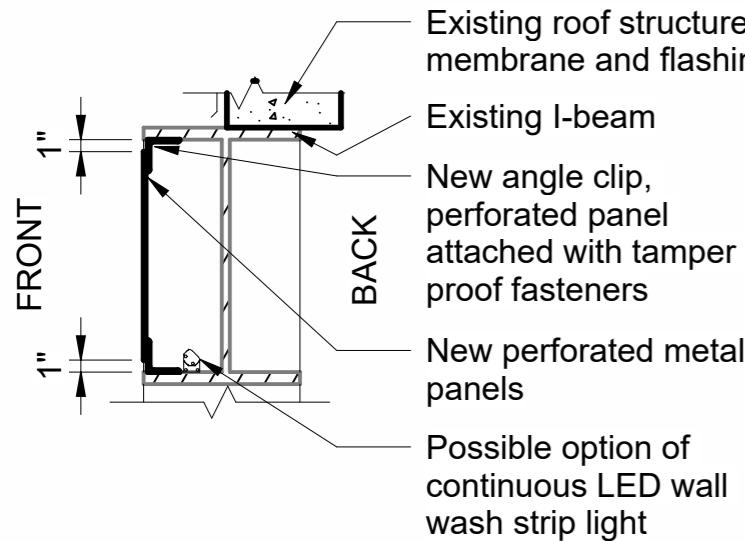


Design Options

Vertical Elements

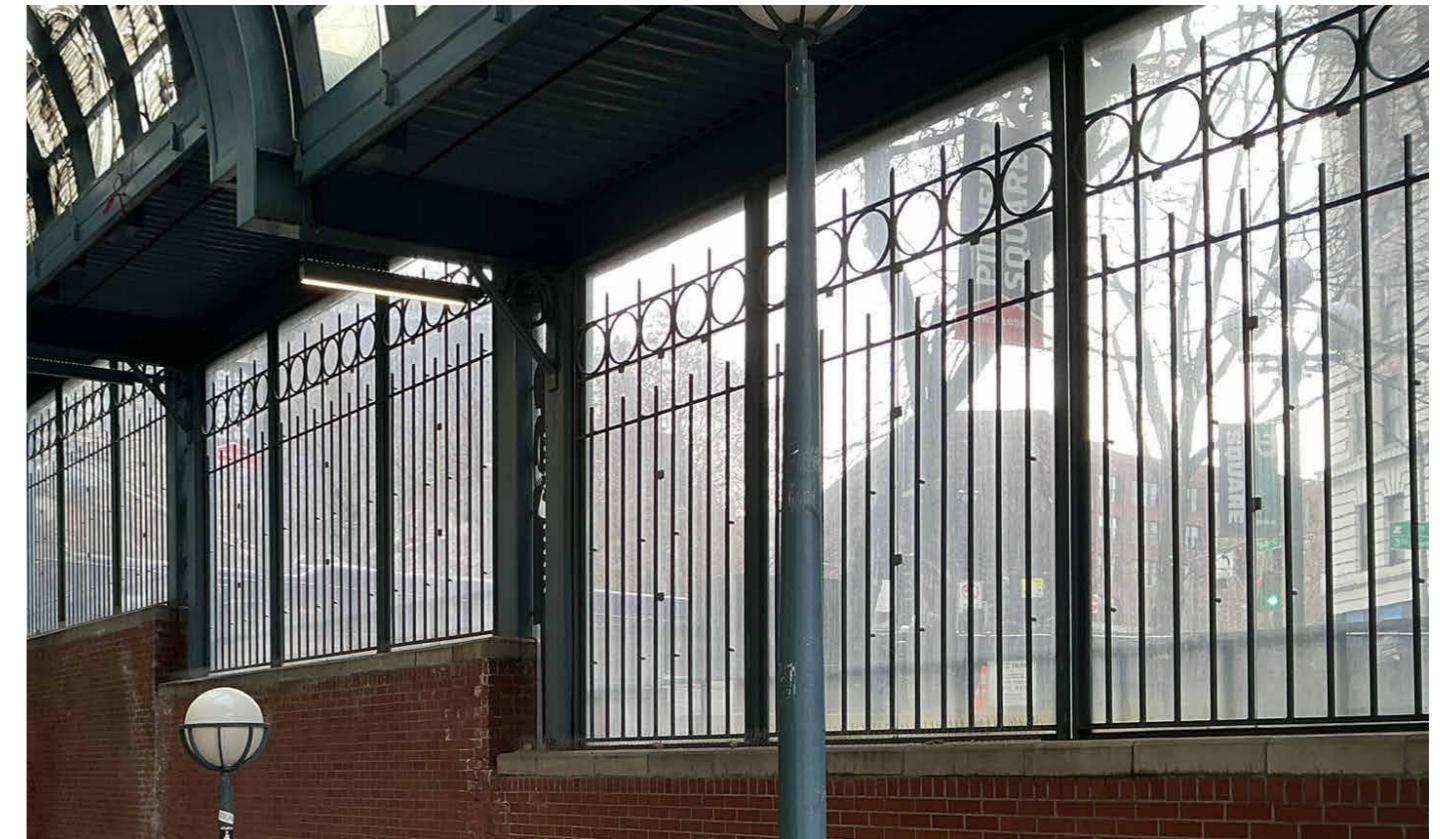

EXISTING CONDUITS

EXISTING ART BETWEEN COLUMNS

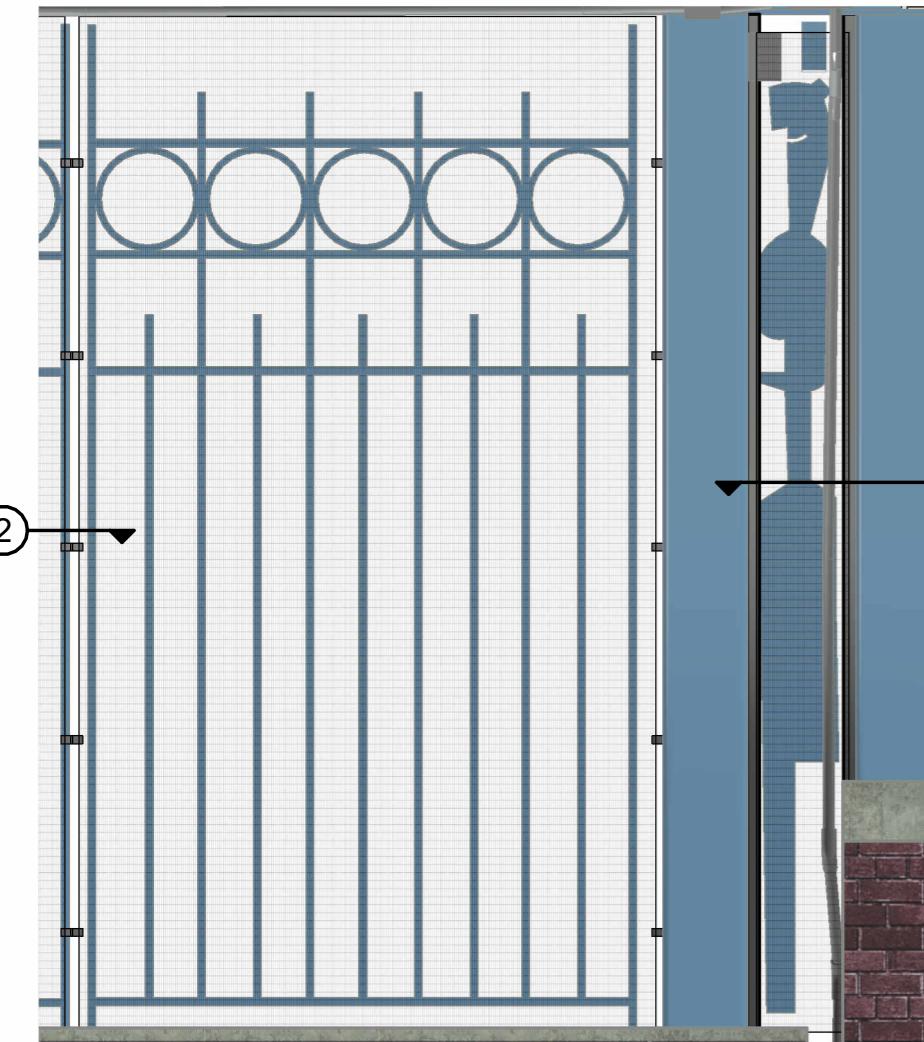

ENLARGED ELEVATION - GRILL WITH SCRIM



PRODUCT SAMPLE ON SITE
Stainless steel wire mesh



CLIP EXAMPLE
Clip attachment



METAL SCRIM PROJECT EXAMPLE
Transparency of scrim allows for highlighting the station structure

Outside New wire mesh set apart from original art

Inside Public Art

1 PLAN DETAIL - AT COLUMNS


Outside New clip with tamper proof fastener

Inside Existing Grill

Attach directly to existing frame between grill panels

New wire mesh panel

2 PLAN DETAIL - AT GRILL

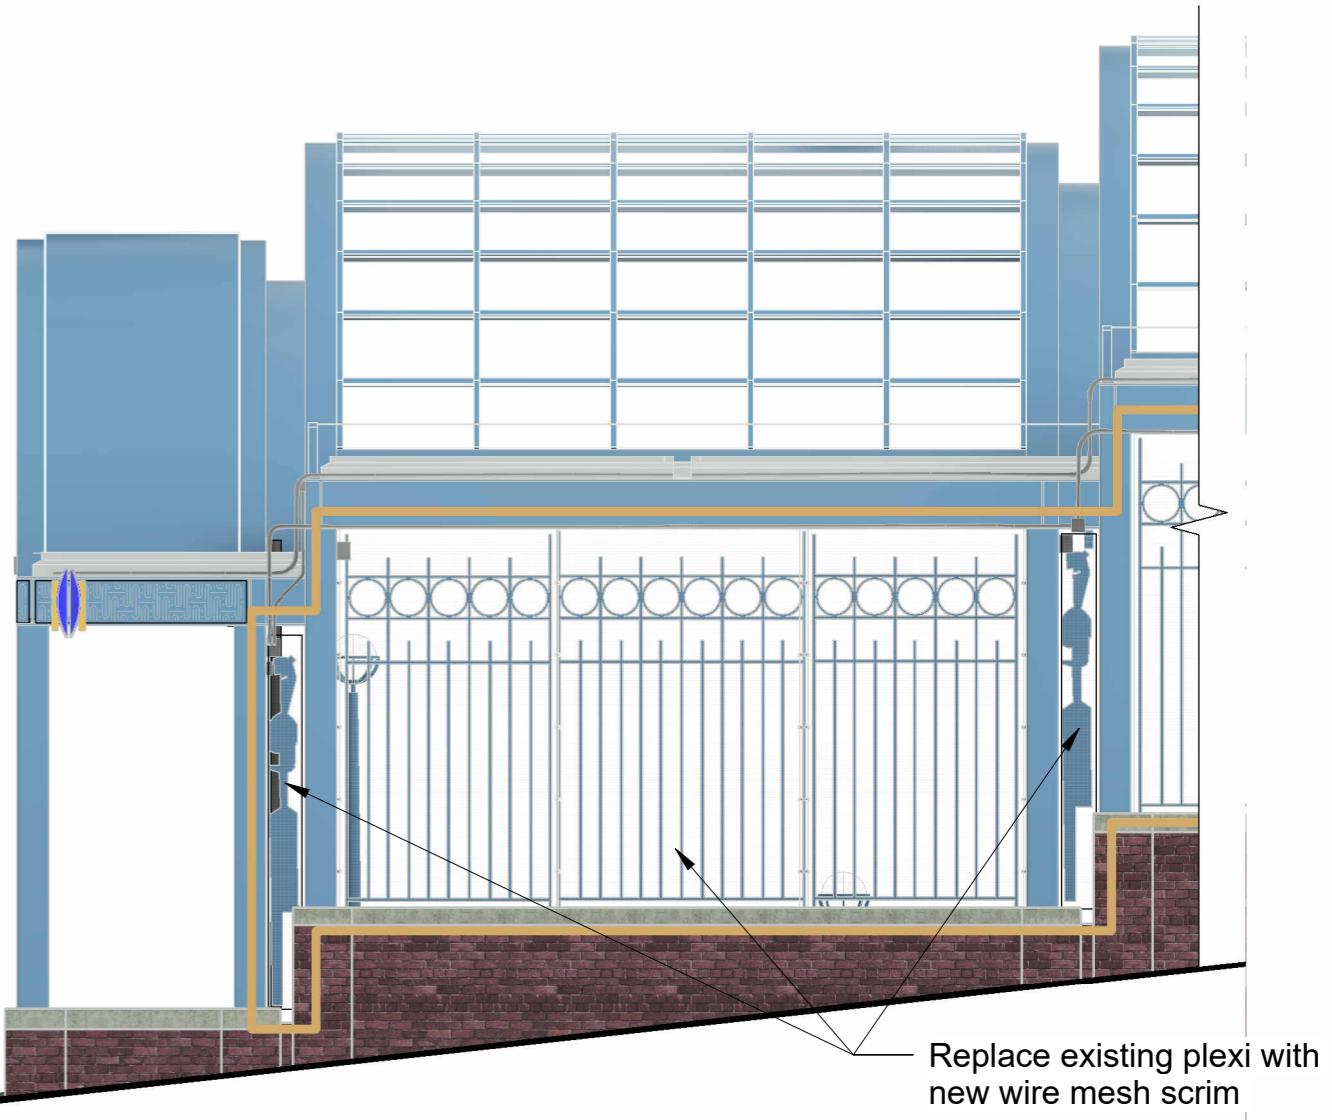

ELEVATION - EAST / YESLER WAY - WIRE SCRIM AT GRILL PANELS

Option 3 - Wire Mesh Scrim

Material: Stainless Steel (unpainted)
Pattern: Simple rectangular 64% open

Replace the existing plexi glass with a stainless steel mesh to create a scrim around the existing structure. The scrim would provide a non-reflective view into the headhouse and highlight the existing structure and artwork while preventing objects from falling into the headhouse.

Advantages:

- Minimal / scrim like expression
- Emphasizes existing grillwork and public art
- Does not produce reflection
- 76.9% open has a transparent and open feel
- Less prone to get tagged due to openness
- Clip attachment allows more transparency than a frame
- Contrast with main structure color
- Easiest option for maintenance


Disadvantages:

- Not a solid panel, small items could be pushed thru mesh
- Least effective at preventing rain from entering the station



Preferred Option - Stainless Steel Mesh Scrim

Exterior Security | Grills + Art (Preferred Option - Scrim)

A4

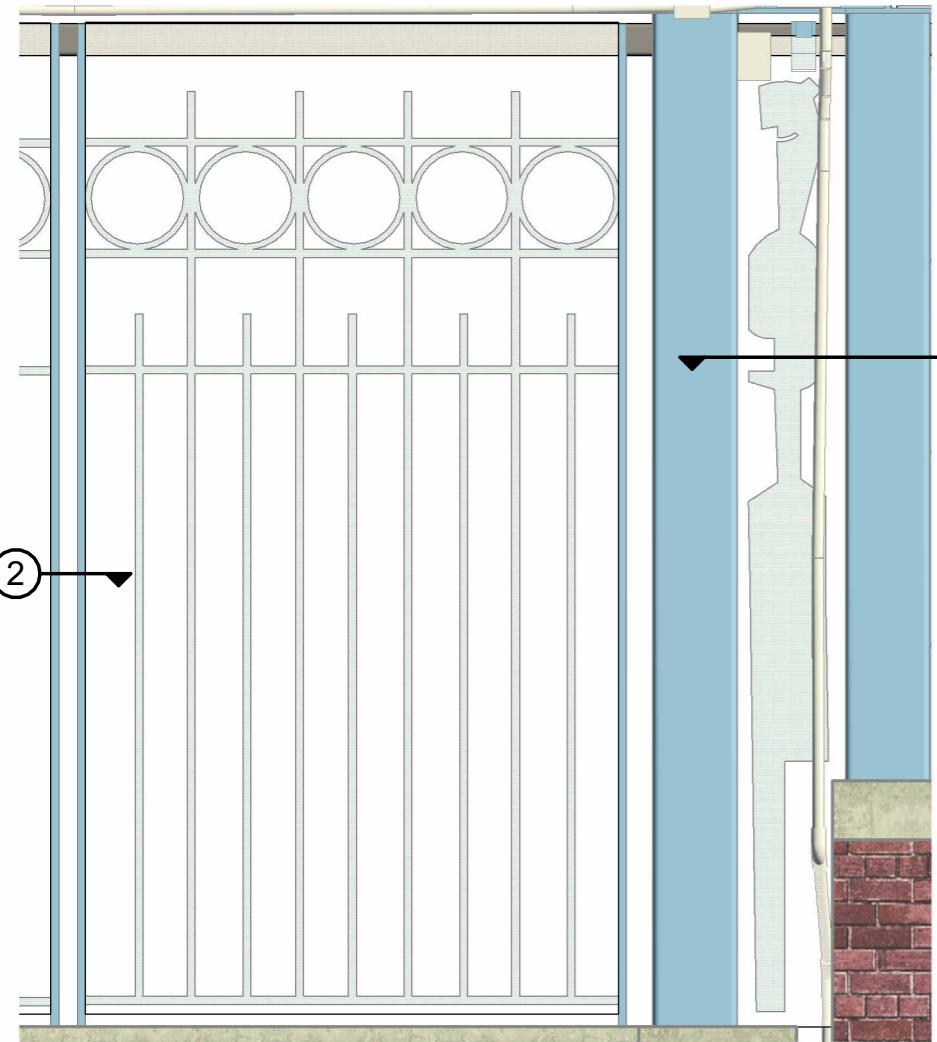

ELEVATION - GRILL ENLARGED

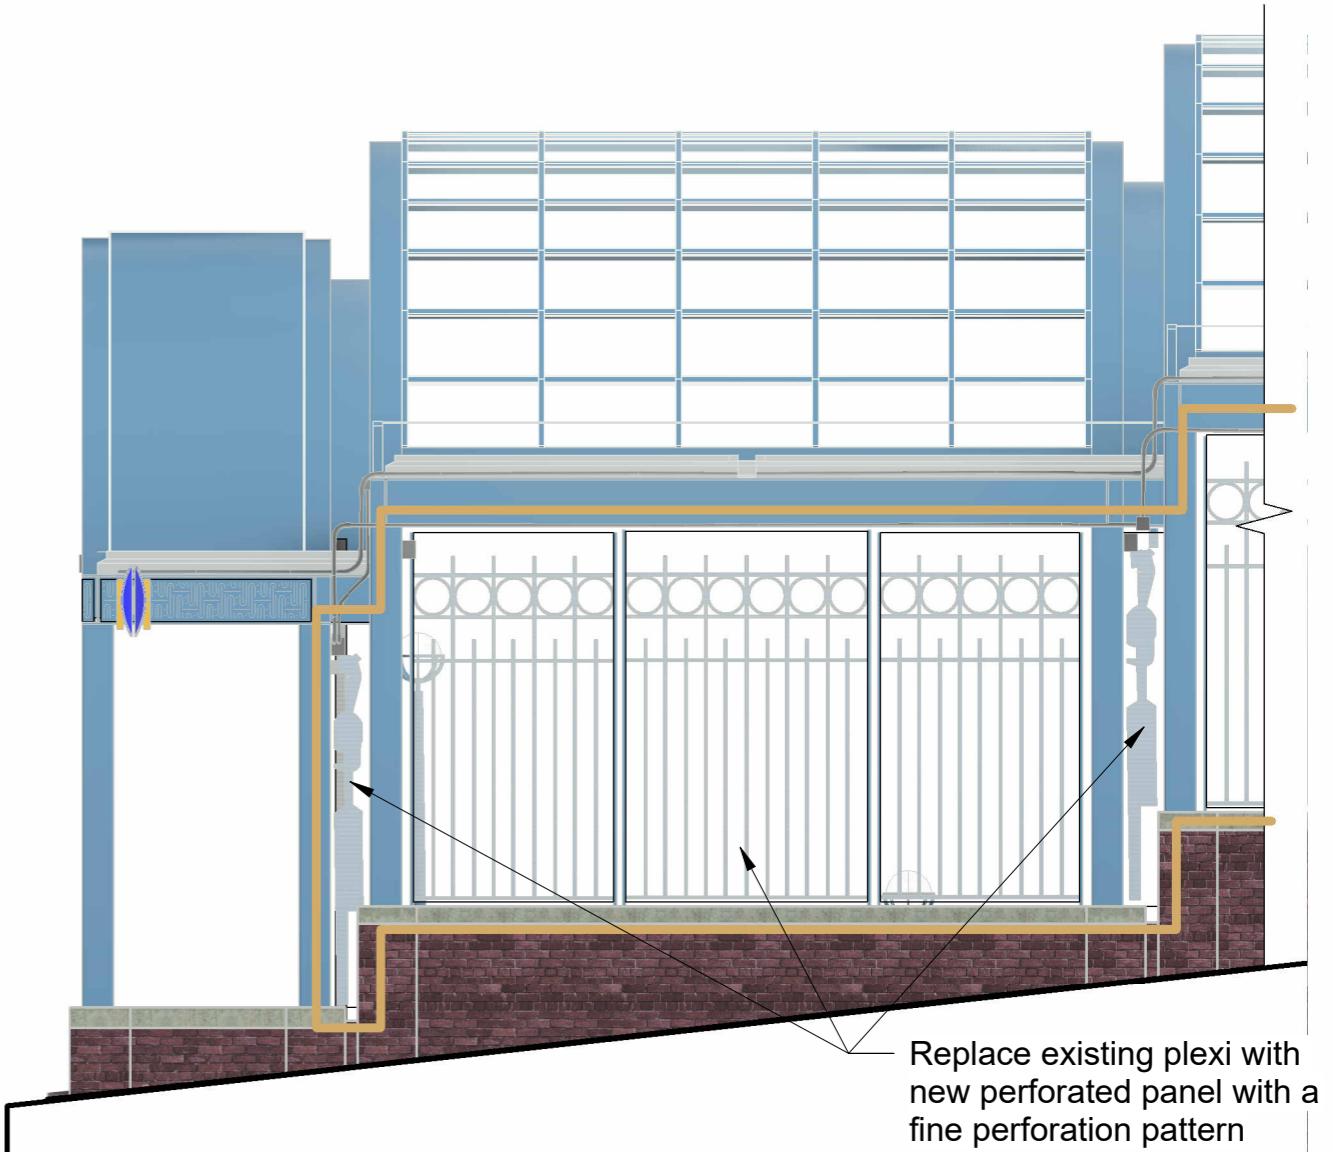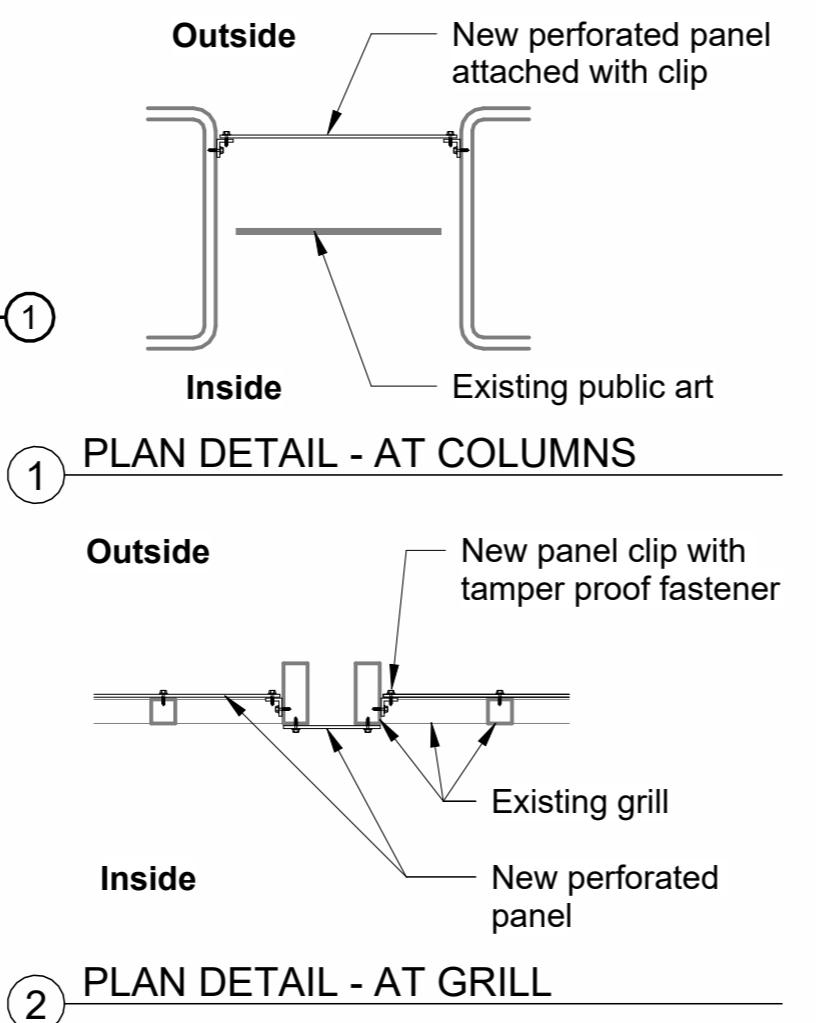

ELEVATION - EAST / YESLER WAY - OPEN PERF PANELS



PRODUCT SAMPLE ON SITE
Stainless steel 63% open perforated panel



PROJECT EXAMPLES
Fine pattern of perforated metal panel allows for view of existing structure

Option 4 - Perforated Panel
Material: Stainless Steel (unpainted)
Pattern: Fine perforation pattern
5/32" Dia 3/16" Ctrs. 63% open

Replace the existing plexi glass with a finely perforated panel. the panels would provide a non-reflective view into the headhouse and highlight the existing structure and artwork while preventing objects from falling into the headhouse.

Advantages:

- Reflection does not obscure public art
- Contrasting color emphasizes public art
- 63% open perforation has a transparent feel
- Not climbable material
- Prevents majority of items from being dropped into stair lobby
- Stops some rain from entering the headhouse

Disadvantage:

- More prone to show graffiti than wire mesh
- Does not prevent rain from entering the station

Alternate 1 - Perforated Panel

Exterior Security | Grills + Art (Alternate 1 - Perf Panel)

A4


Historic Preservation Board | PSS Prefontaine Headhouse | December 19, 2025

27



PROPOSED FACADE - EAST / YESLER WAY

New custom perforated panels with a possible option to add integrated lighting

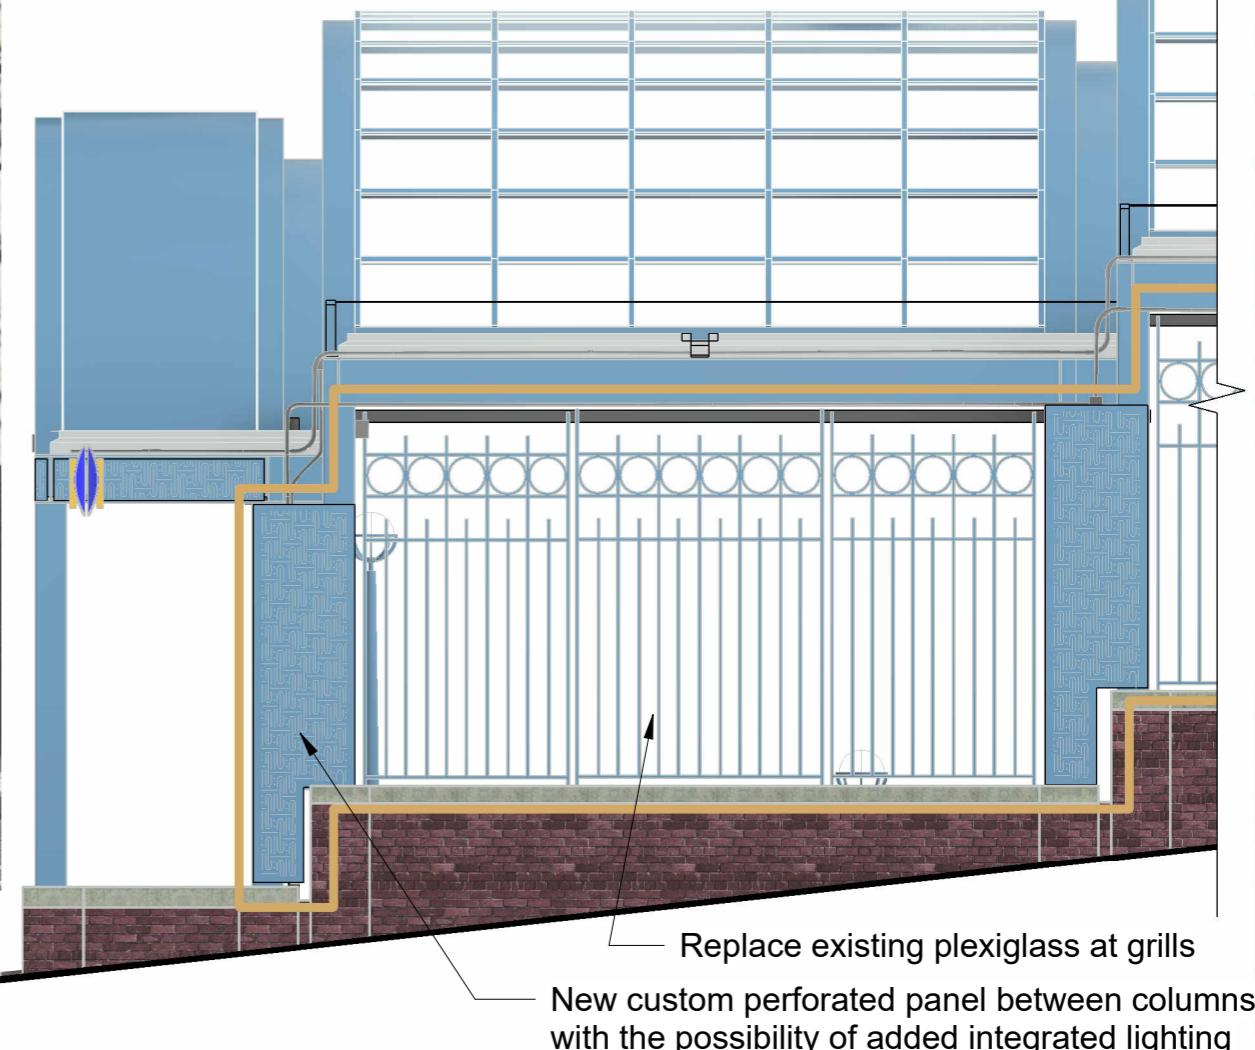

PROPOSED ELEVATION - EAST / YESLER WAY

Option 2 - Infill Panels and Replaced Plexiglass at Grills


Proposed solution to prevent unauthorized roof access is to remove and obscure existing horizontal elements that act as climbing aids. The project proposes to install custom perforated panels on the exterior of the structure. These panels are specifically designed to cover horizontal attachments for conduit, which will significantly reduce climbability and deter unauthorized entry. Beyond their crucial function, these panels will be designed to complement the station's architectural aesthetic and will incorporate provisions for a possible option to include integrated ambient backlighting to improve visibility and safety at night. These measures are intended to create a robust barrier against unauthorized roof access, protecting the structure while enhancing its visual appeal.

Advantages:

- Custom perforated panels cover all externally mounted conduit
- Plexi on the grills remains the same
- Back lighting would highlight people art inside of the station

Disadvantages:

- Could be prone to tagging
- Custom pattern could add costs
- Hides the original structure
- People art would not be as visible on the exterior

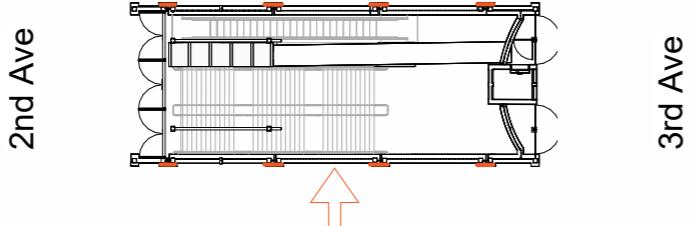


Alternate 2 - Custom Panel and Plexi

Exterior Security | Grills + Art (Alternate 2 - Custom Panel)

Historic Preservation Board | PSS Prefontaine Headhouse | December 19, 2025




PROPOSED

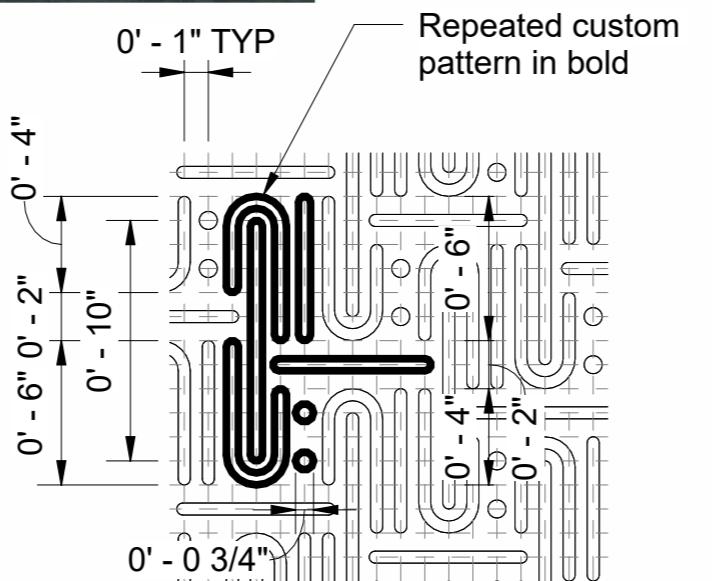


4 PATTERN DETAIL - VERTICAL PERF




The image shows two logos side-by-side. On the left is the Sound Transit logo, which consists of a stylized 'T' shape above the word 'SOUNDTRANSIT' in a bold, sans-serif font. On the right is the Tiscareno logo, which consists of the word 'Tiscareno' in a large, bold, sans-serif font.

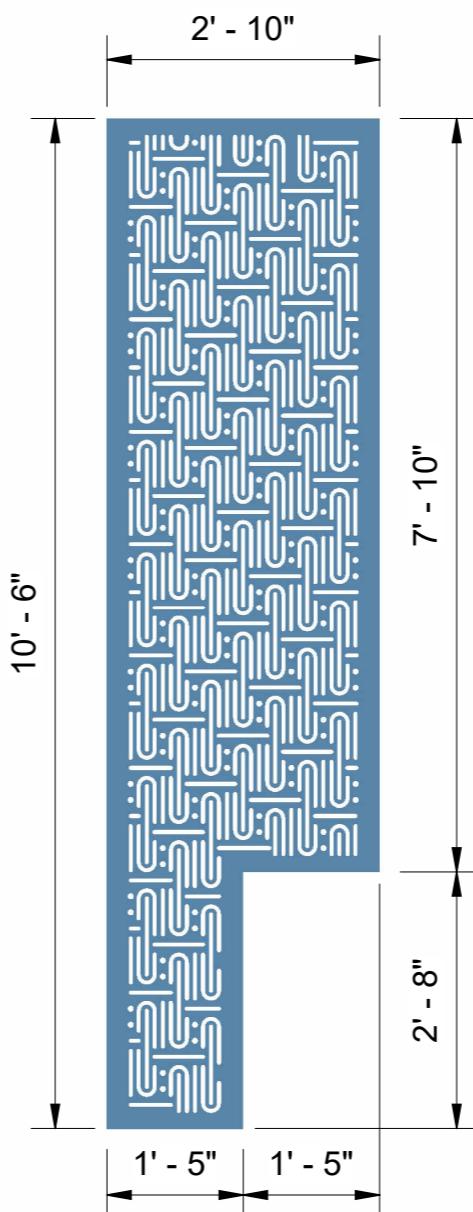

2 CUSTOM VERTICAL PANEL

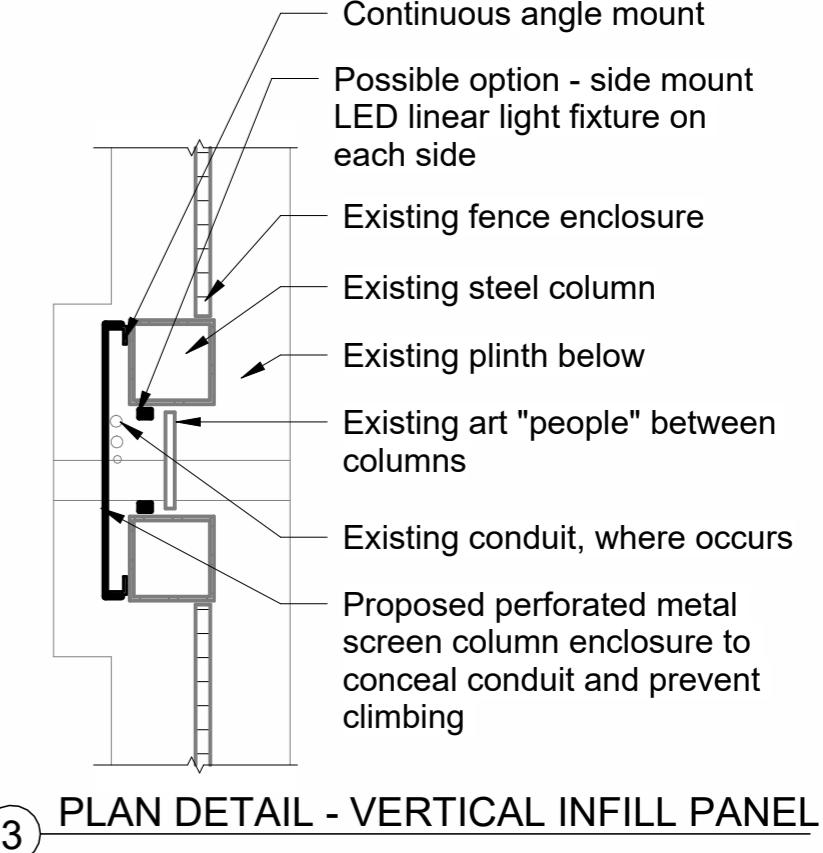


3 PLAN DETAIL - VERTICAL INFILL PANEL

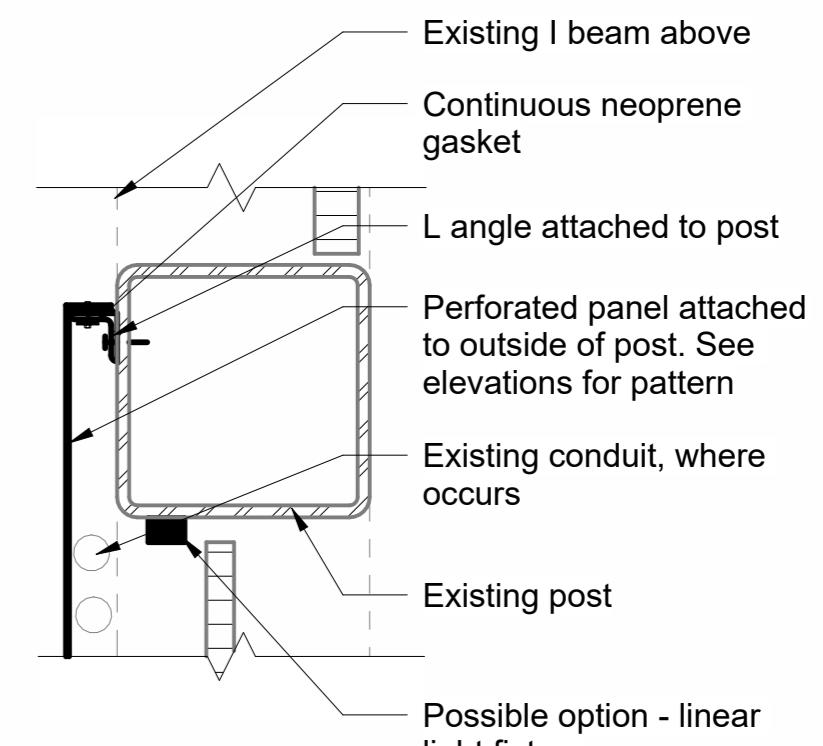

1 DETAIL - PANEL CONNECTION AT POSTS

Alternate 2 - Proposed Detail
Exterior Security | Grills + Art (Alternate 2 - Custom Panel) A4
Historic Preservation Board | PSS Prefontaine Headhouse | December 19, 2025 29

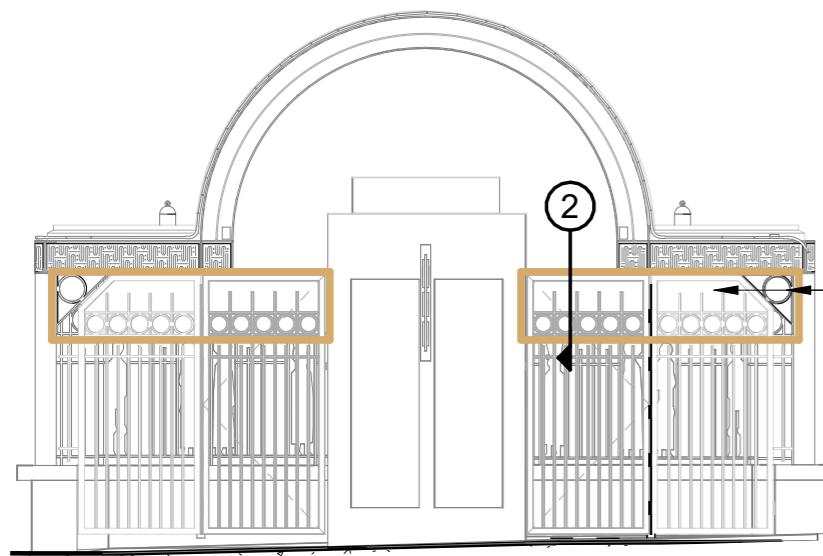


PROPOSED ELEVATION - 3RD AVE / ELEV ENTRY - ALT INFILL PANELS


Alternate - Anti climb material at top of gate, bracket and upper grill at side of alcove




Light-colored stainless steel anti-climb panel to match plinth cover. No acrylic glass panel below.

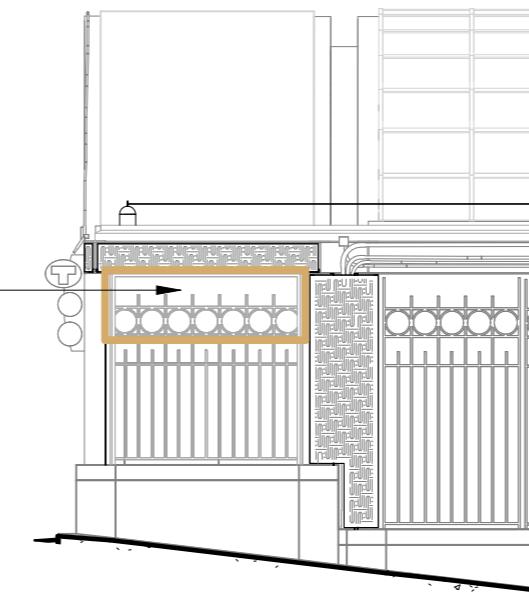

WEST / JEFFERSON ST - NW

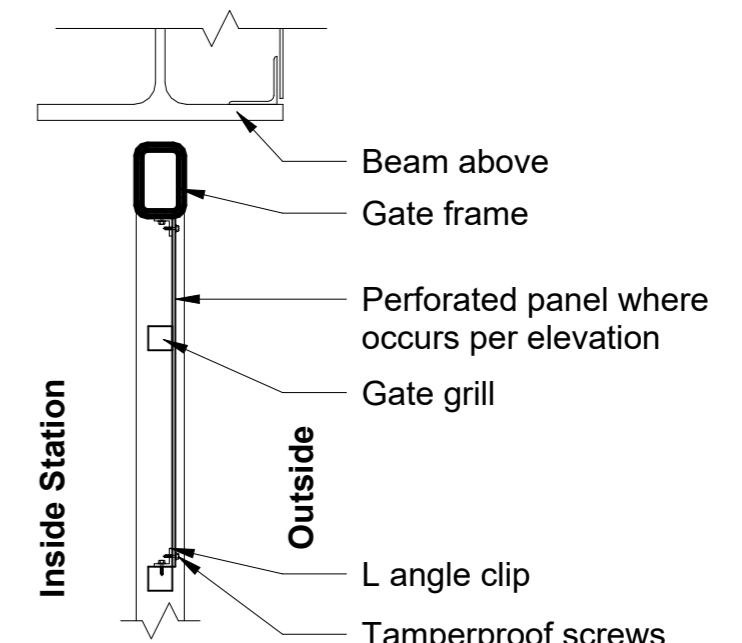


2 GATE INFILL PANEL

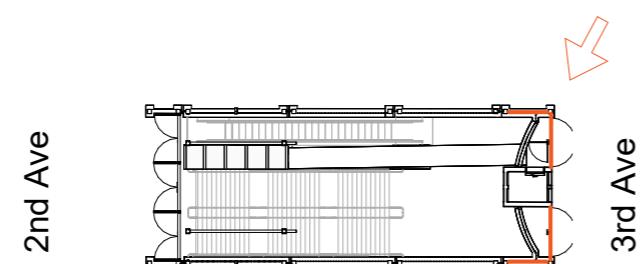


Alternate 2 - 3rd Ave Gate Infill and Plexi

Exterior Security | Grills + Art (Alternate 2 - 3rd Ave Option)

Historic Preservation Board | PSS Prefontaine Headhouse | December 19, 2025

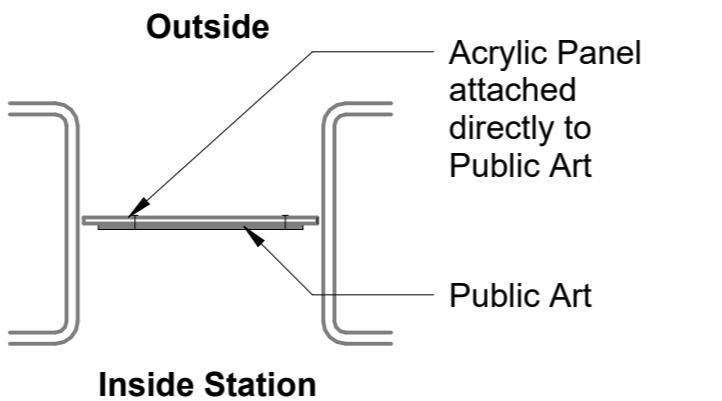

② ACRYLIC ATTACHMENT AT ART

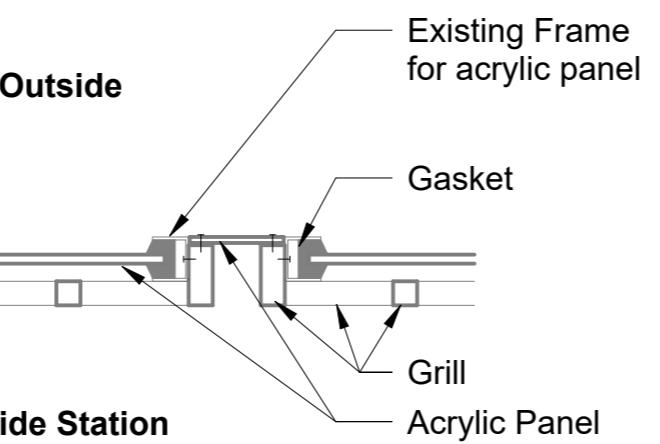

① ACRYLIC ATTACHMENT AT GRILL

Option 1 - Replace Existing Acrylic


The existing panels are scratched, faded and prone to tagging. From the outside their reflectivity reduces visibility of the metal grillwork and public art. The panels do not appear to be part of the original design and may have been added to prevent people from dropping items into the station from outside sidewalks. Panels could be replaced with new acrylic in existing frames to provide more clarity. Existing Panels are installed in a gasketed frame attached to the the grillwork. Between the grillwork, acrylic panels are flush to the outside. Between Columns panels are installed directly to the public art.

Advantages:

- Existing condition
- Prevents any size item from being dropped into stair lobby
- Prevents wind blown rain from entering the station
- Allows daylight into station

Disadvantages:

- Does not appear to be original. Is not shown on original as-built drawings.
- Reflections obscure public art and view into station
- Prone to tagging
- Gathers dirt along edge of station and inside of plexi
- Dusty interior creates a foggy appearance
- Frame around plexi adds visual bulk to facade

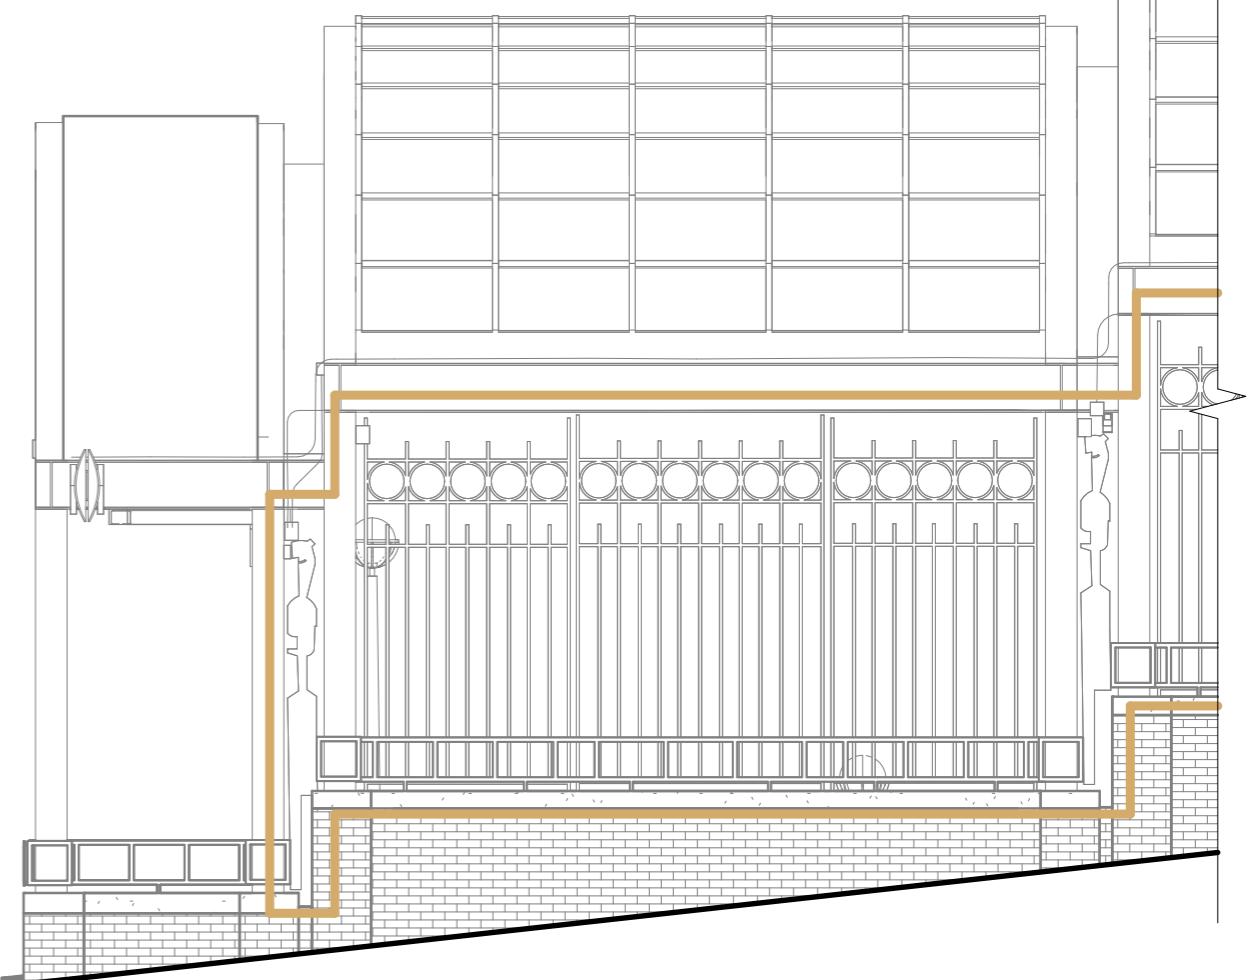


Alternate 3 - Replace Existing Plexi

Exterior Security | Grills + Art (Alternate 3 - Replace Existing)

A4


Historic Preservation Board | PSS Prefontaine Headhouse | December 19, 2025

31

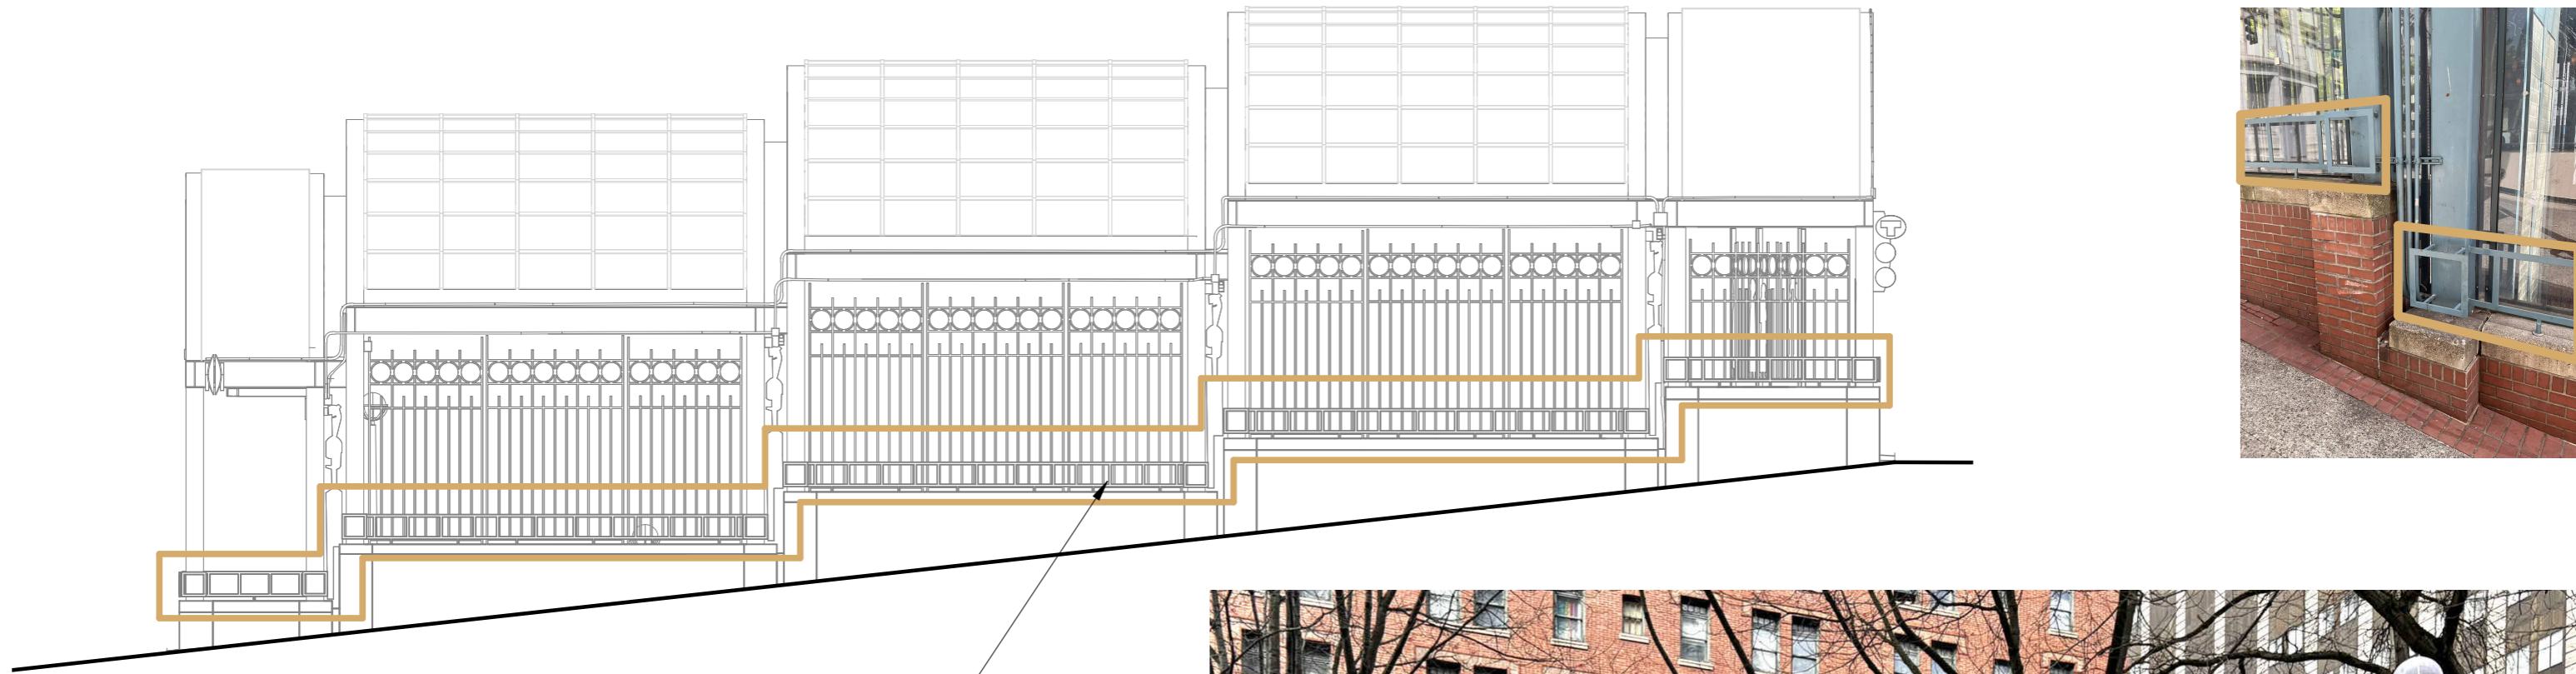


EXISTING ELEVATION - WEST / YESLER WAY

The horizontal ladders which are currently located along the outside ledge of the headhouse were not shown on the original as-built drawings.

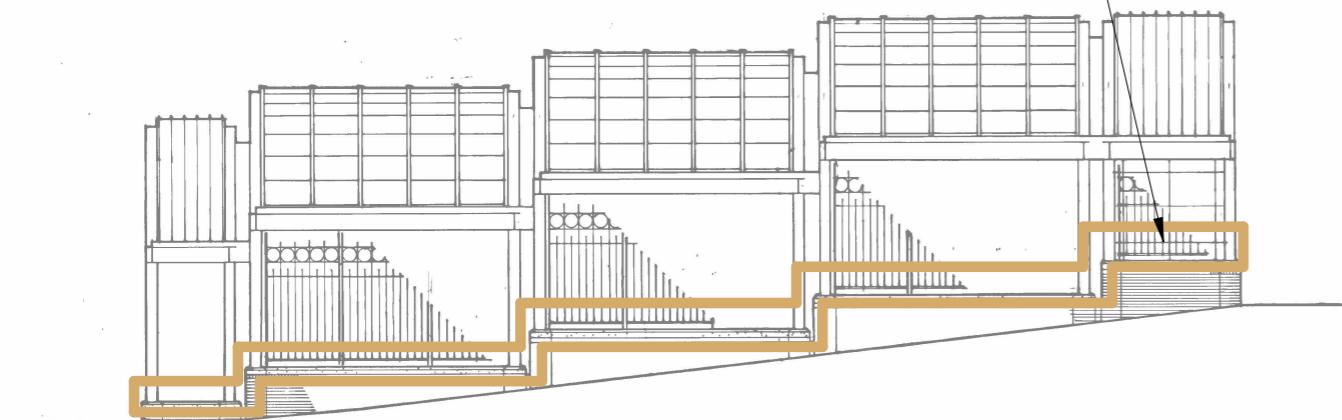


ORIGINAL AS-BUILT ELEVATION - WEST / YESLER WAY

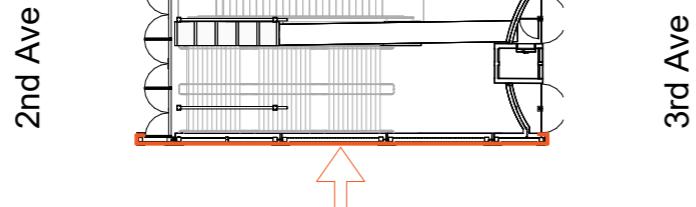

EXISTING FACADE - EAST / YESLER WAY




A4 Horizontal ladders

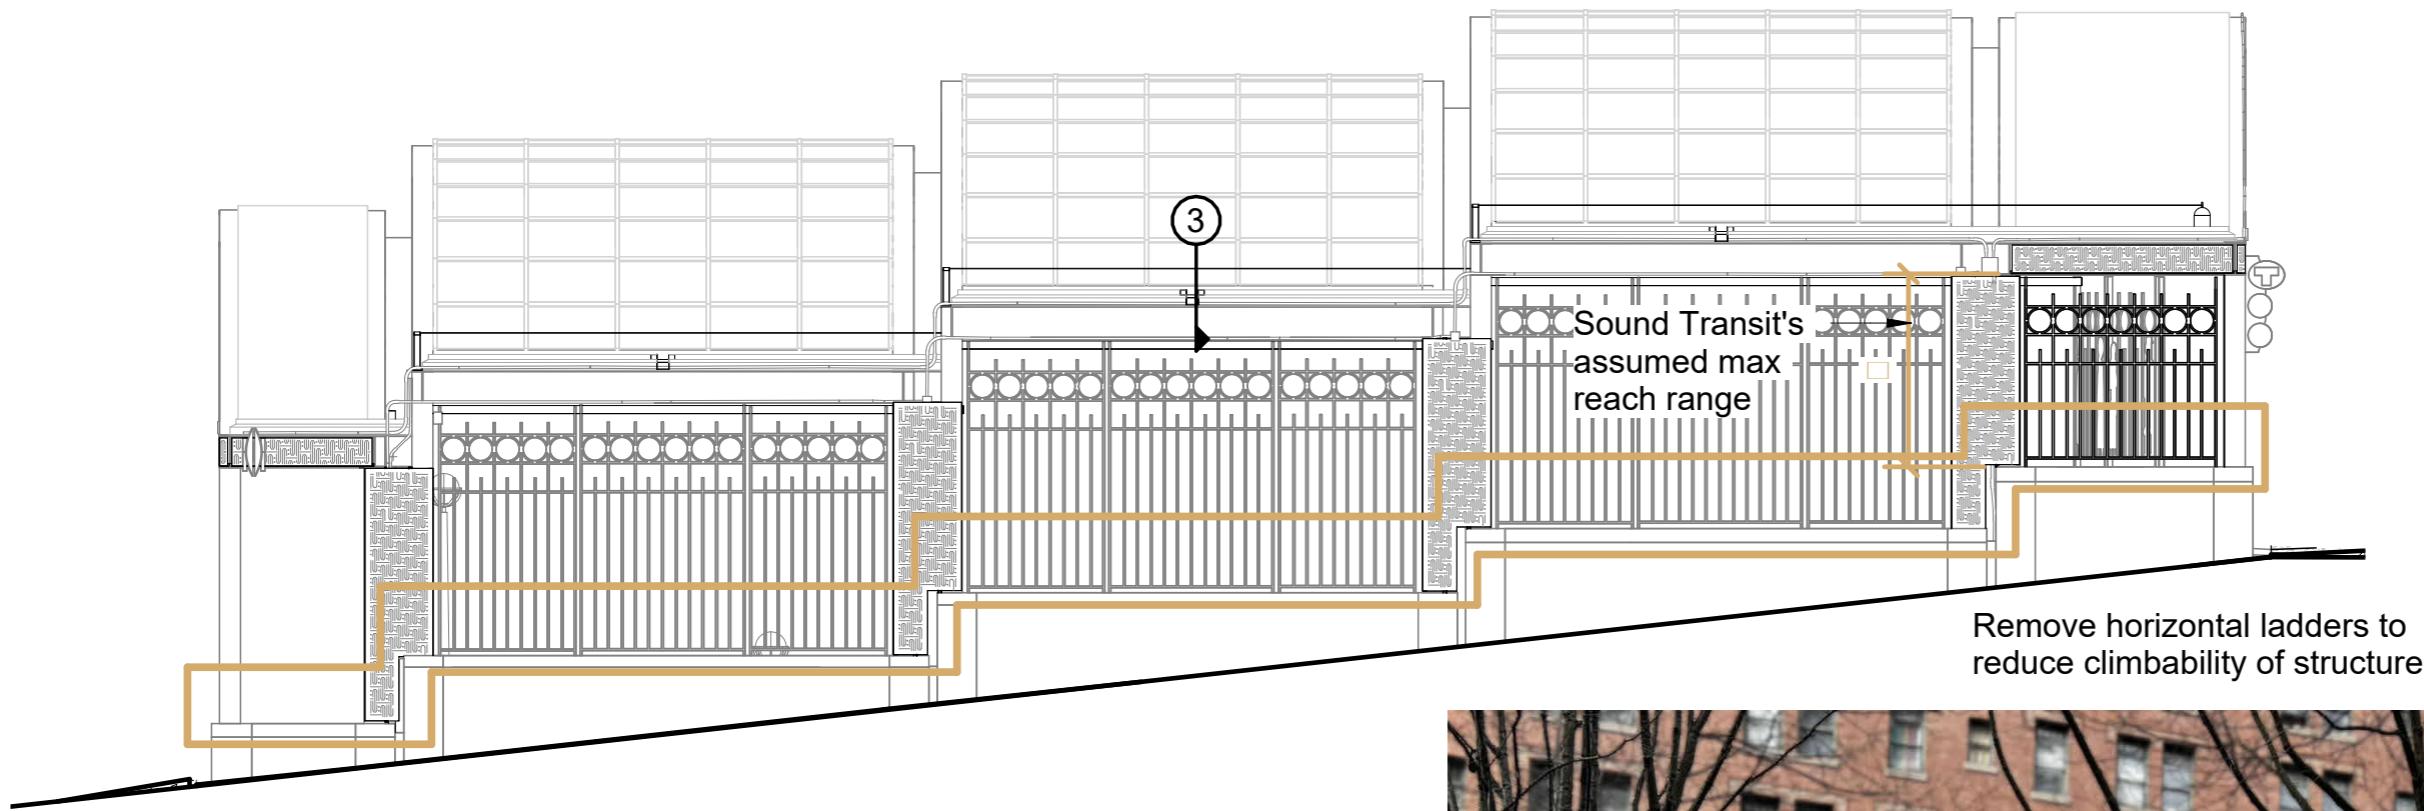


PROPOSED ELEVATION - EAST / YESLER WAY

A4 The proposed solution to prevent unauthorized roof access is to remove and obscure existing horizontal elements that act as climbing aids. This includes removing the "horizontal ladder" elements found at the base of columns and grilles, effectively eliminating potential footholds.

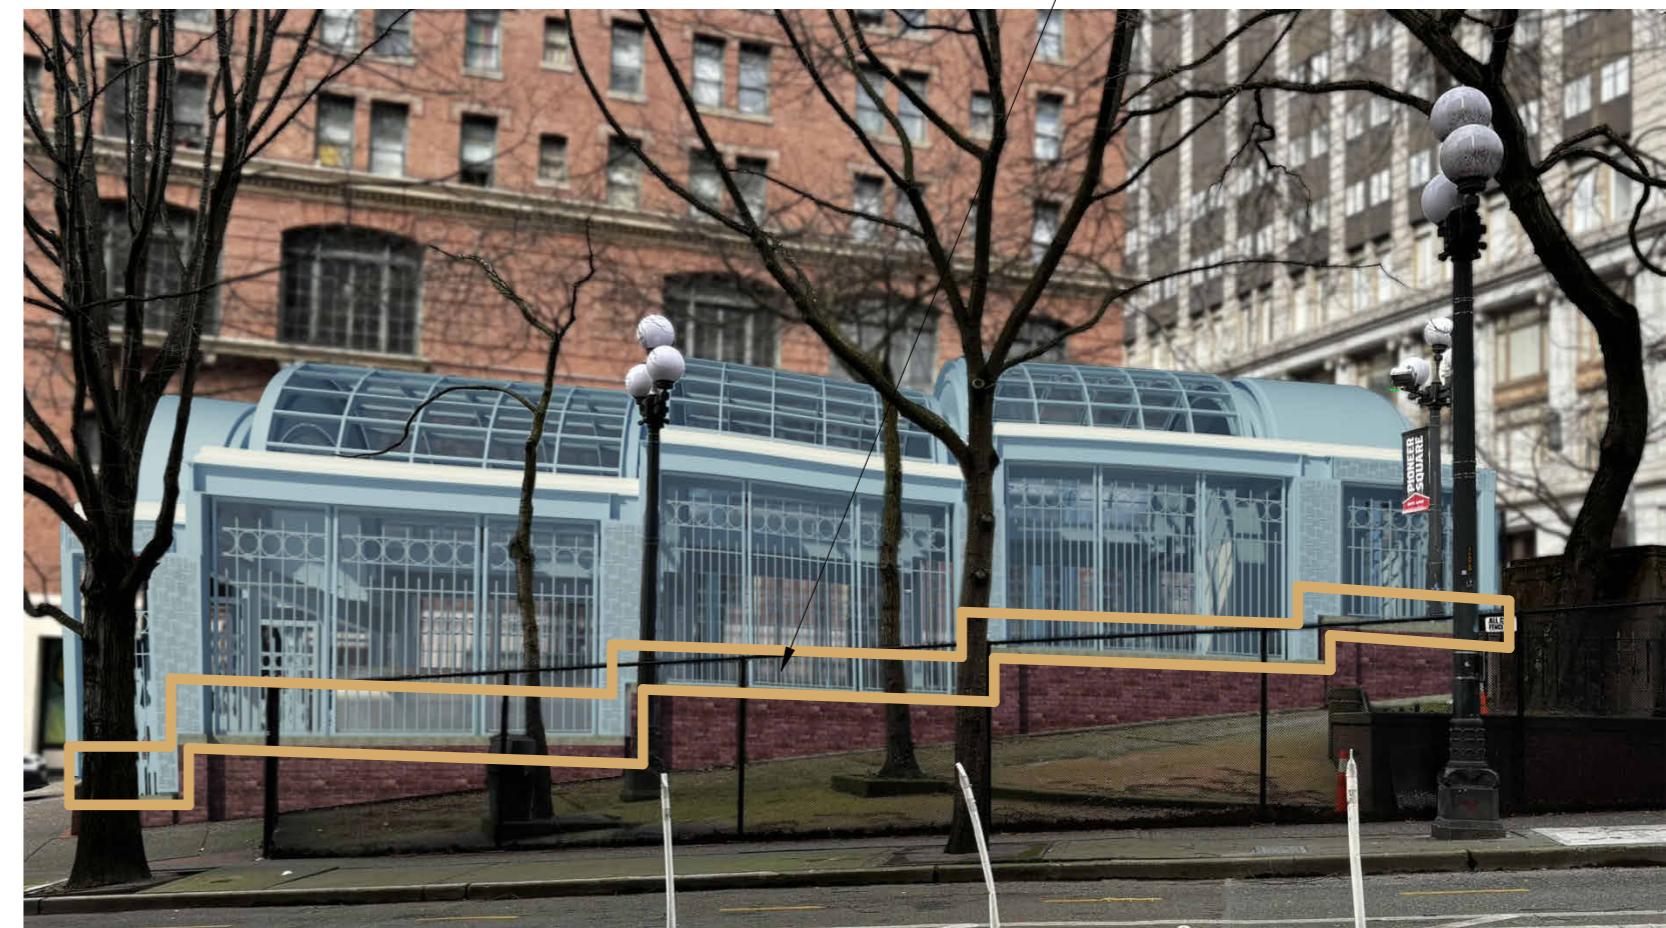

PROPOSED FACADE - EAST / YESLER WAY

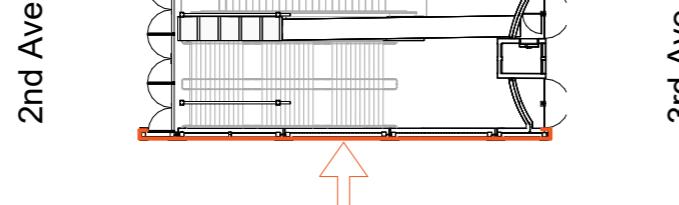

Design Options

Fall Protection

Fall Protection - Post and Point Anchors (Preferred Solution)



Proposed solution for exterior fall protection is to provide a roof mounted safety line at each level of flat roof for movement along the entire structure and provide safe access for maintenance at the roof drains and standing at the lower levels of the roof. Posts and single point anchors are mounted to the existing beams allowing the roof to remain free of penetrations. A safety line will provide ease of access and movement for maintenance personnel without significant visual impact or change to the structure. Single point connection anchors are proposed to be added along the steel structure of the barrel vault for tie offs that will allow limited access to the upper part of the roof as necessary, again these are proposed to keep the visual impact to the structure low.




Advantages:

- Minimal penetration of the roof allows for easier install and rooftop maintenance
- Reduced potential for leaks due to minimal roof penetrations
- Minimal visual impact of overall system
- Reduced visibility from 3rd Ave, where there's easy access to the underside of the roof
- Fall protection cables extend full length of the roof sections, increasing effectiveness of the safety system



Disadvantages:

- Front post visible from 2nd Ave

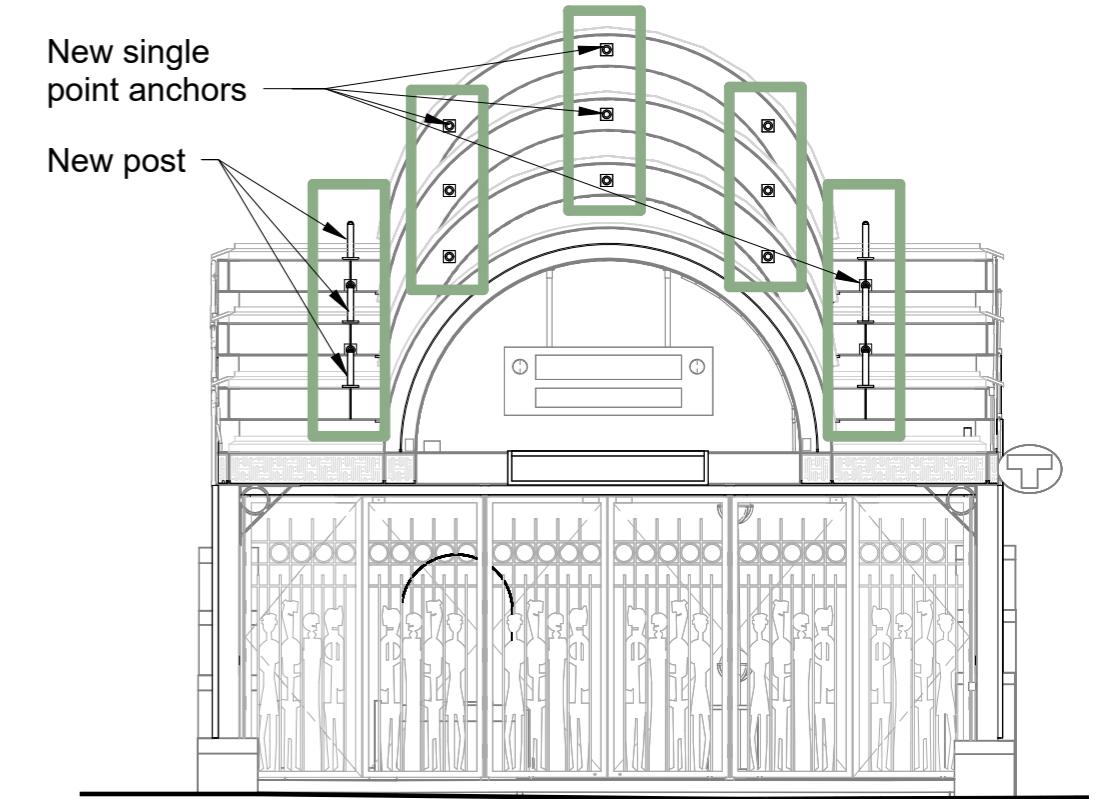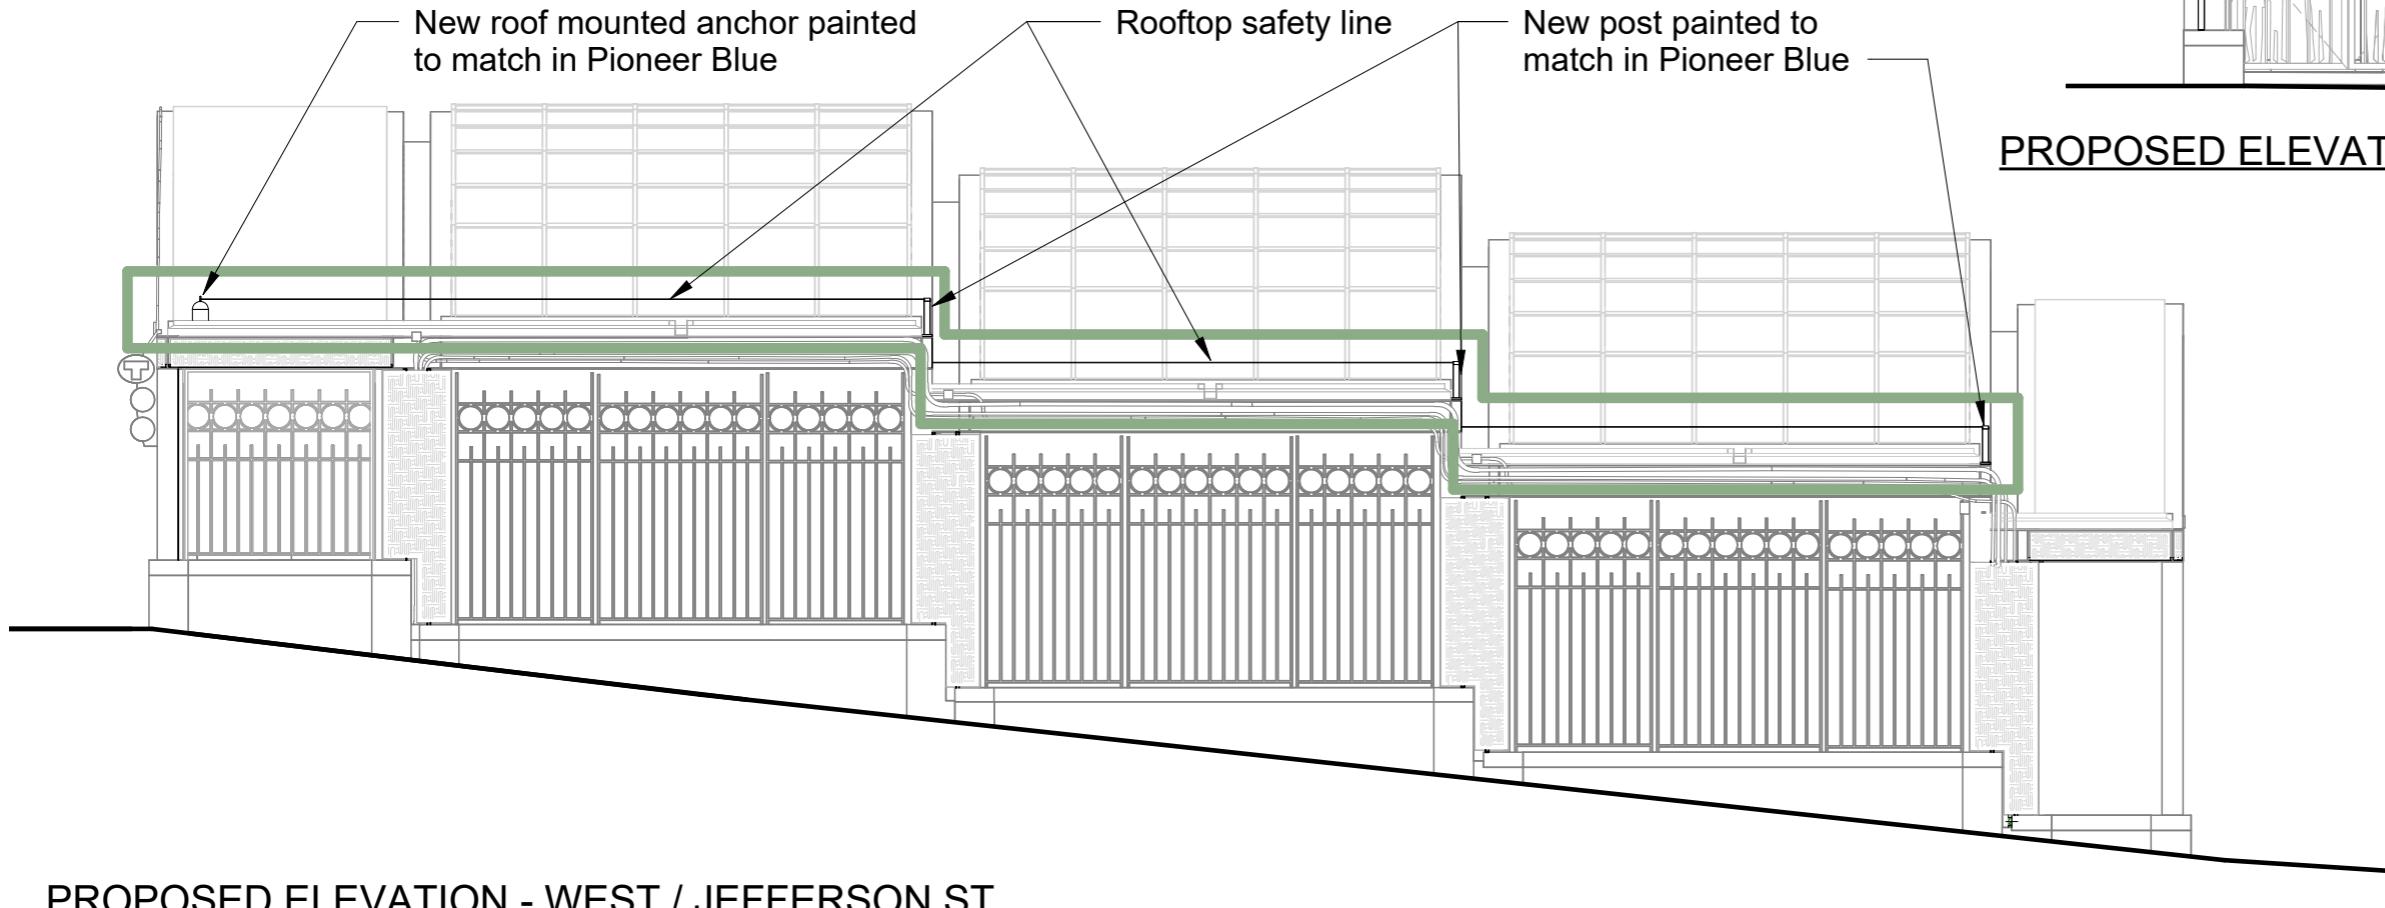


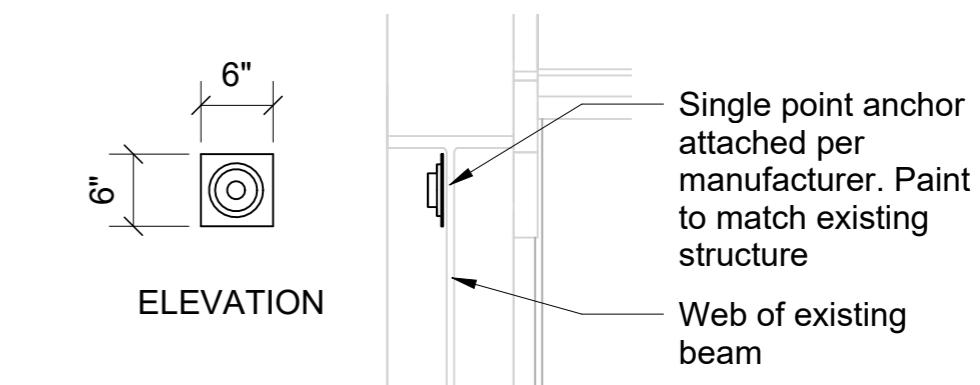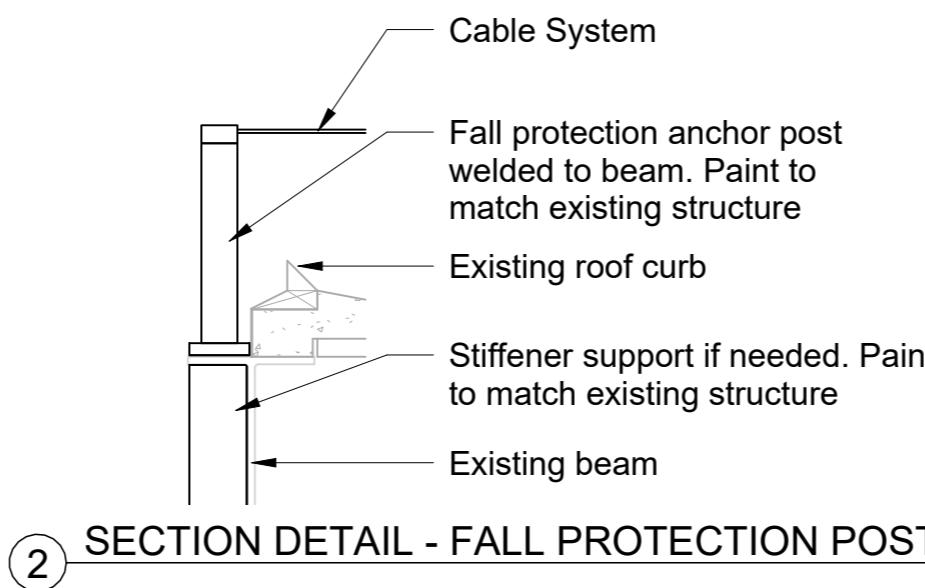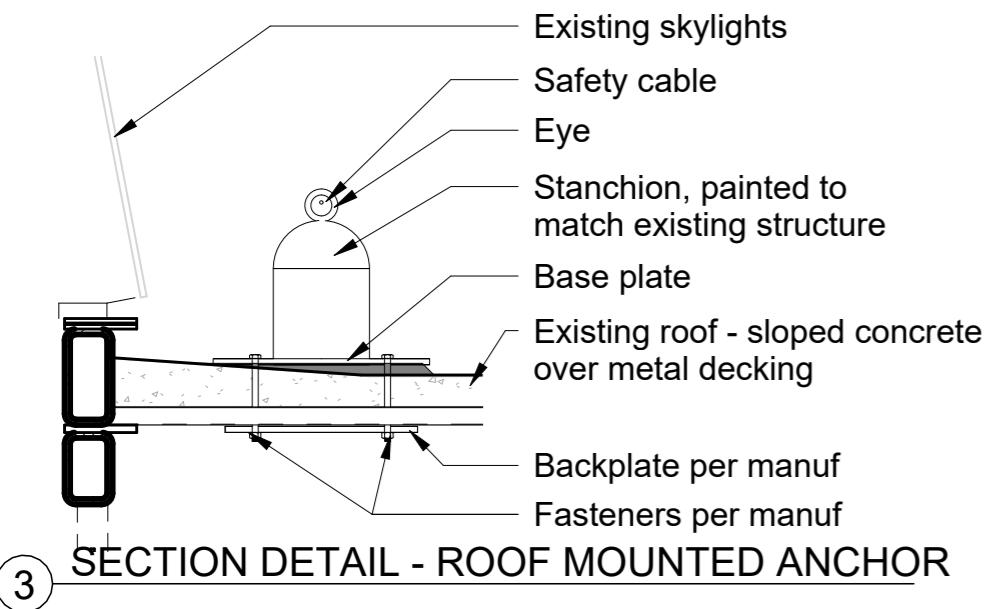

1 SECTION DETAIL - SINGLE POINT ANCHOR

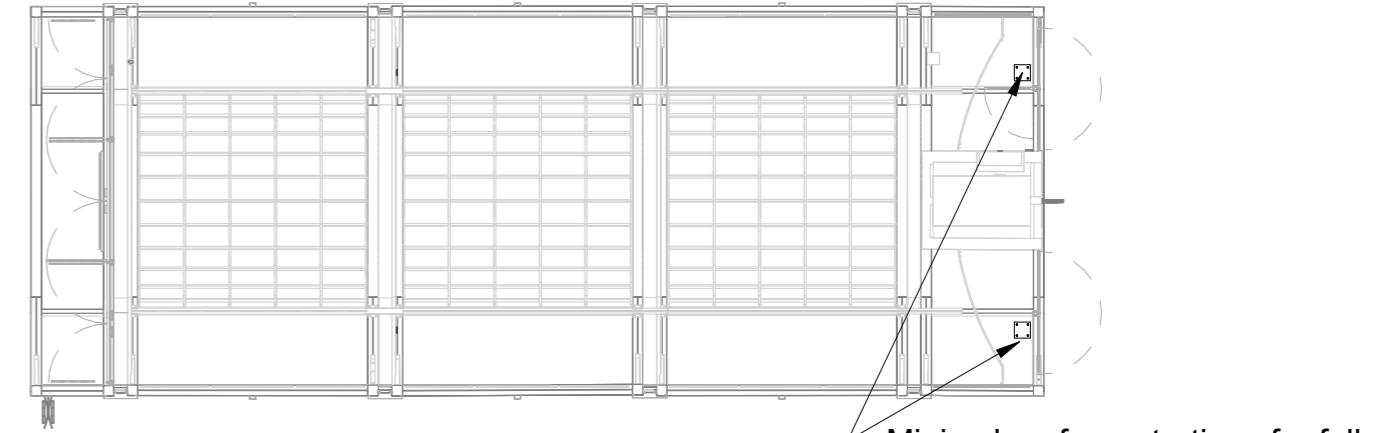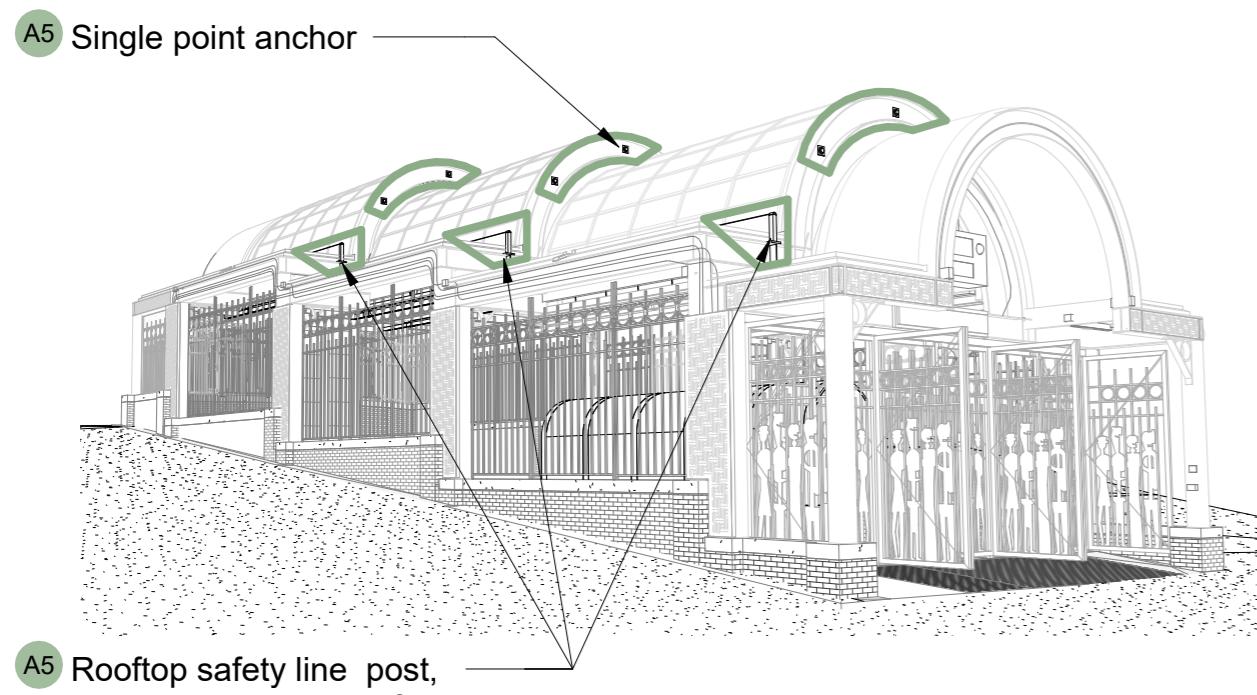

PROPOSED REFLECTED CEILING PLAN

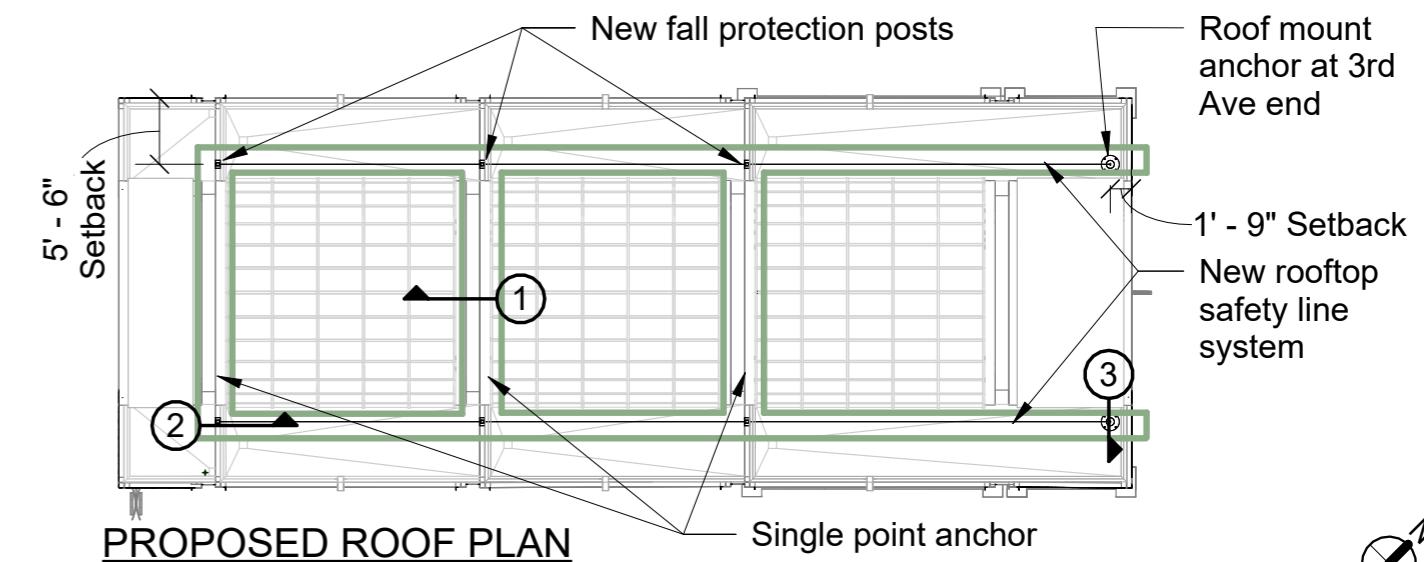

Post and Point Anchor Details (Preferred Option)

Roof Maintenance | Fall Protection (Preferred Option - Post)

Historic Preservation Board | PSS Prefontaine Headhouse | December 19, 2025

Fall Protection - Roof Mounted Stanchions (Alternate)



An alternate solution for exterior fall protection is to provide a roof mounted stanchions supporting a safety line at each level of flat roof for movement along the entire structure. Single point connection anchors are to be added along the steel structure of the barrel vault as in the other option.


Advantages:

- Less visible than the preferred option


Disadvantages:

- Large number of penetrations required through the roof
- Increased potential for leaks
- Roof maintenance more difficult
- Fall protection cables do not extend the full length of the roof, reducing the effectiveness of the safety system

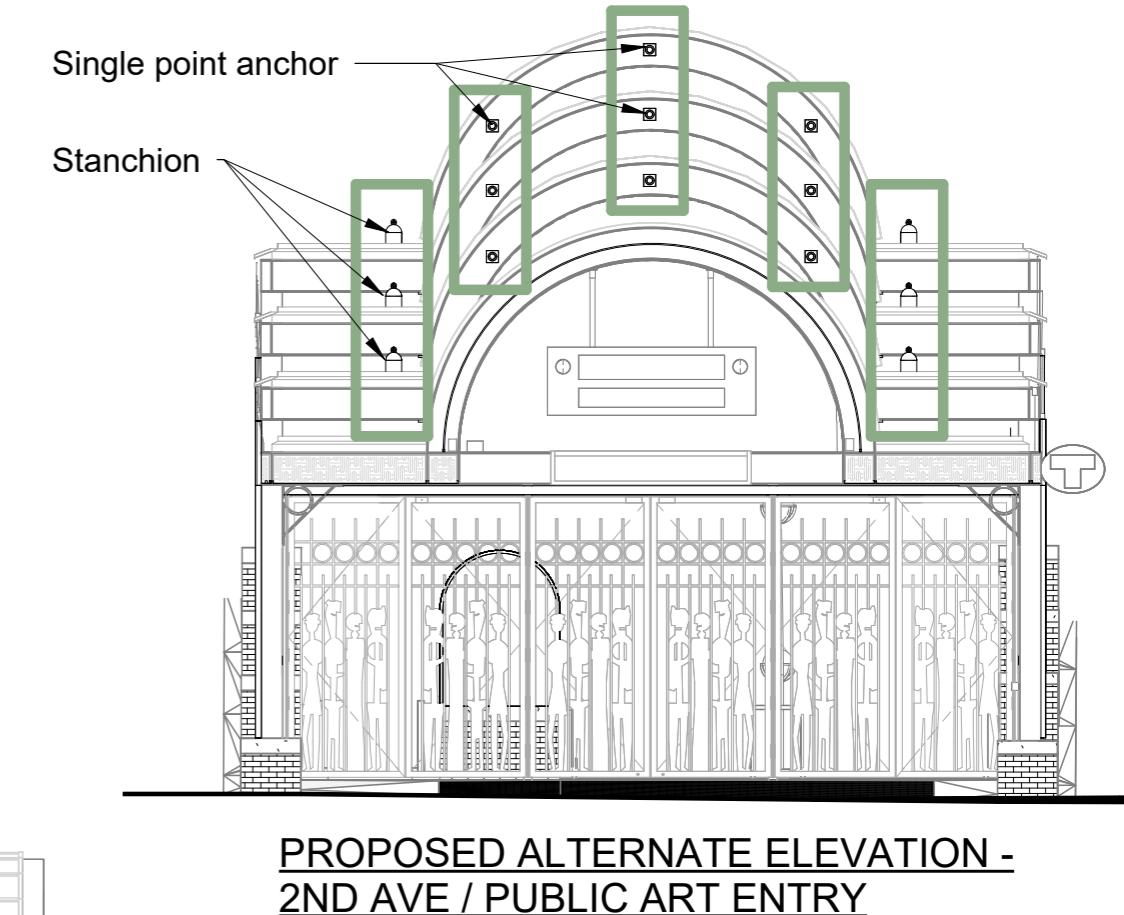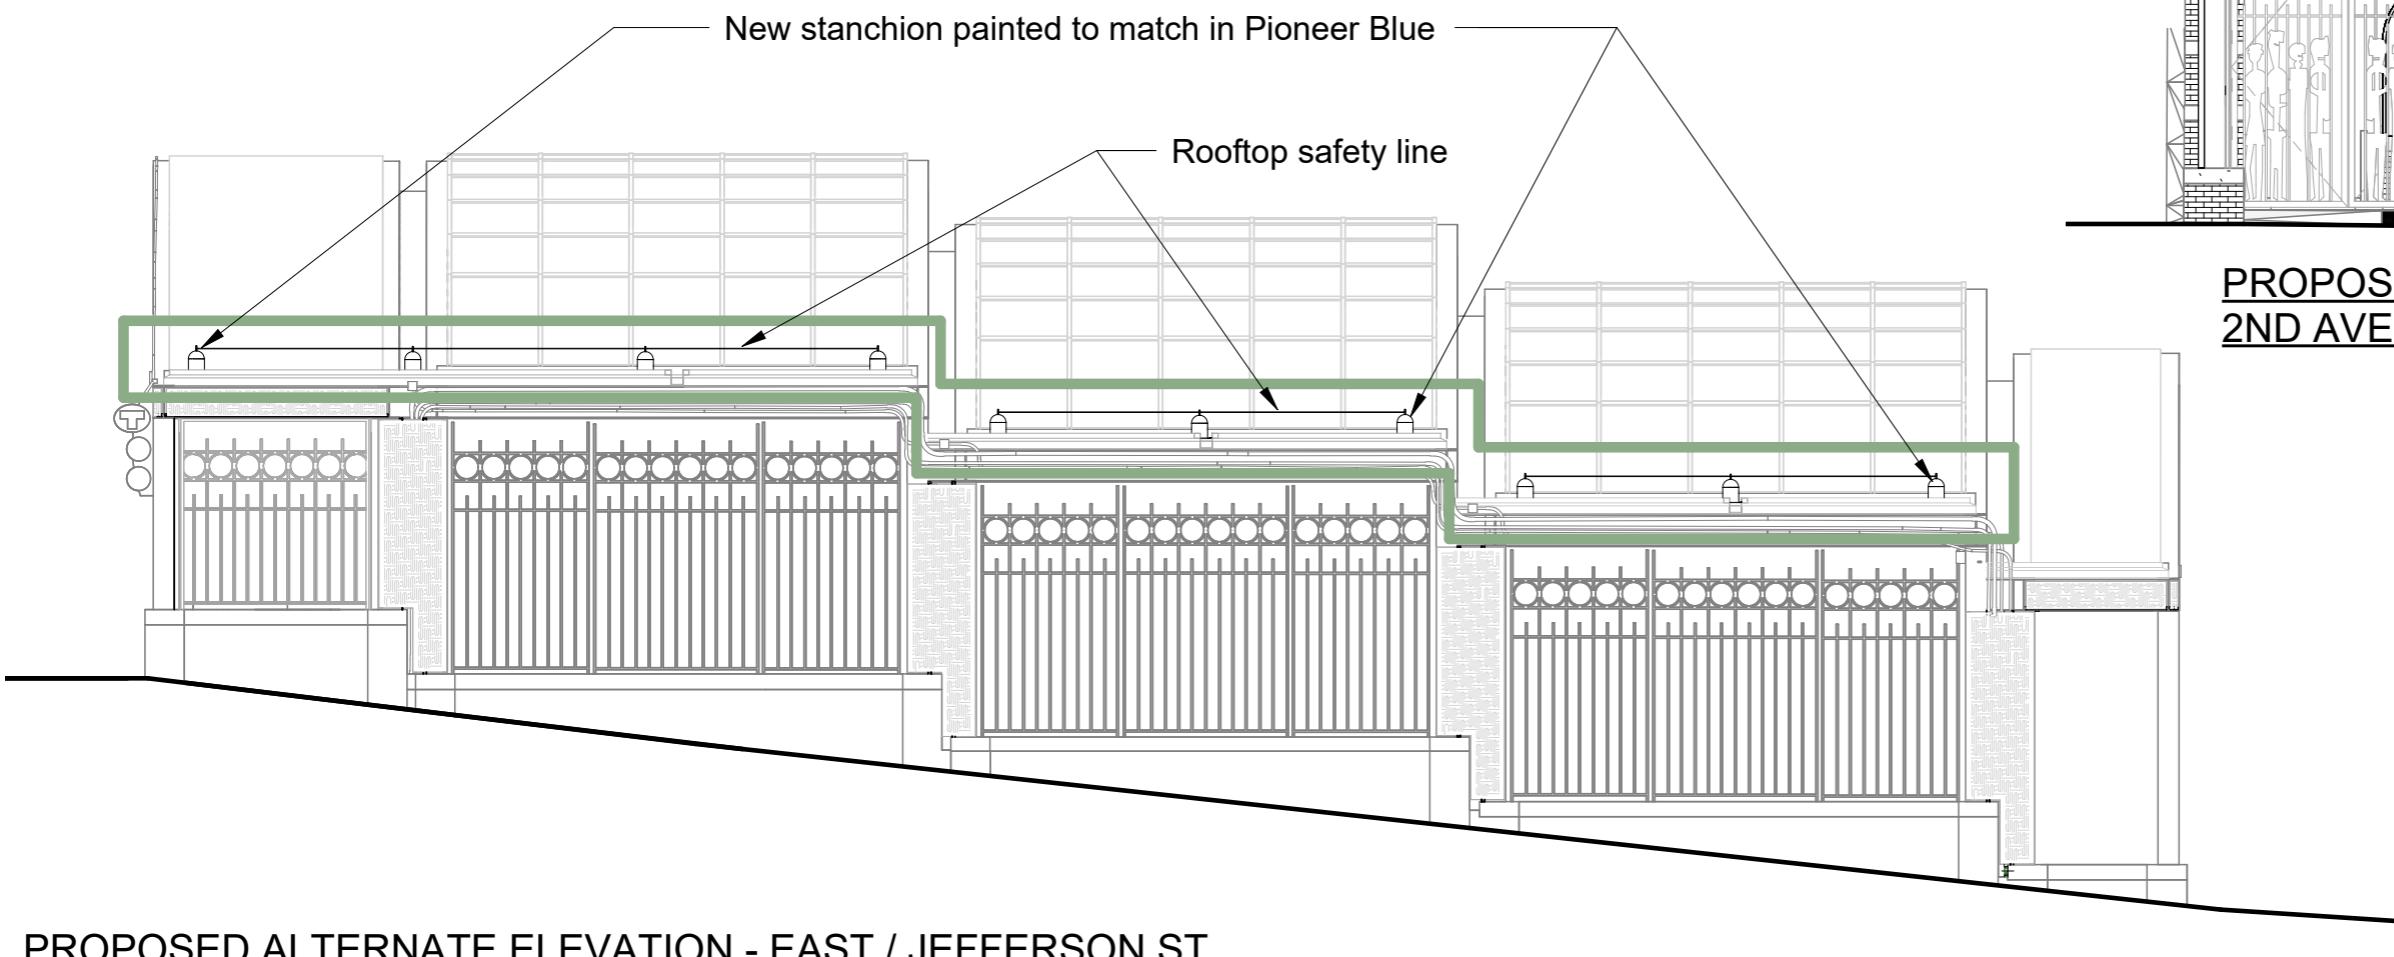

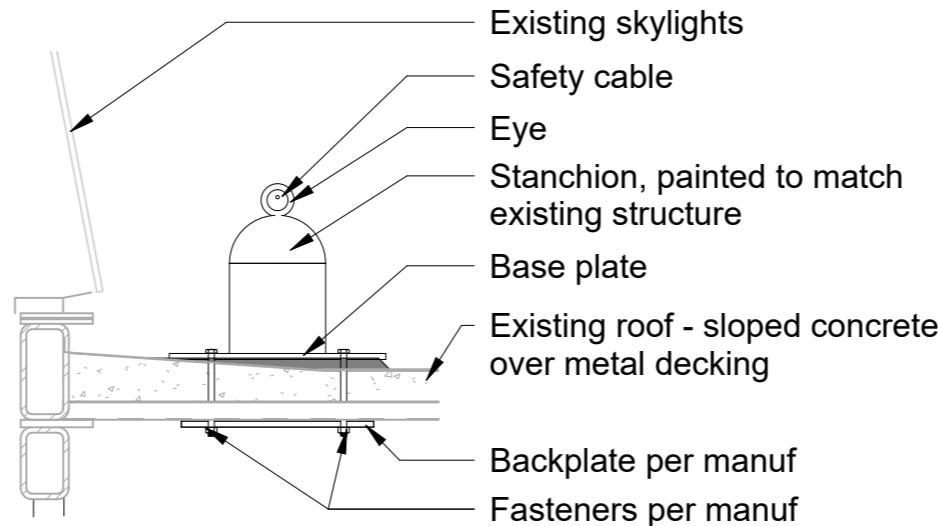




2 SECTION DETAIL - ROOFTOP SAFETY LINE

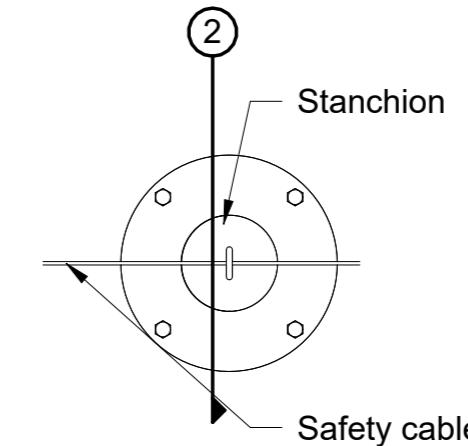

1 PLAN DETAIL - FALL PROTECTION ANCHOR


Note: roof anchor system is bidder designed. All engineering, final layout and attachment of system shall be provided by roof anchor manufacturer.

Basis of design anticipates end and intermediate anchors, eyes, pins and intermediate guides, base plates, back plates, cables, tensioners, and travelers.

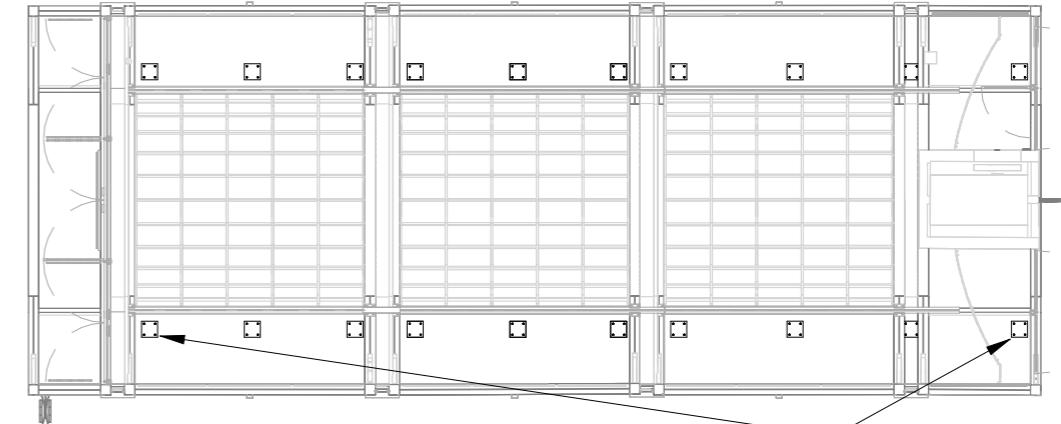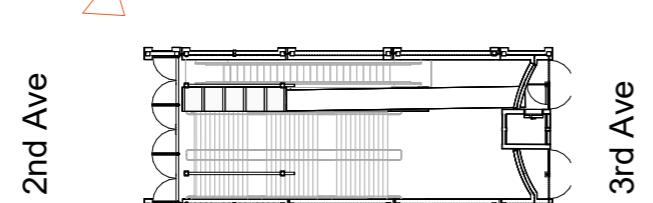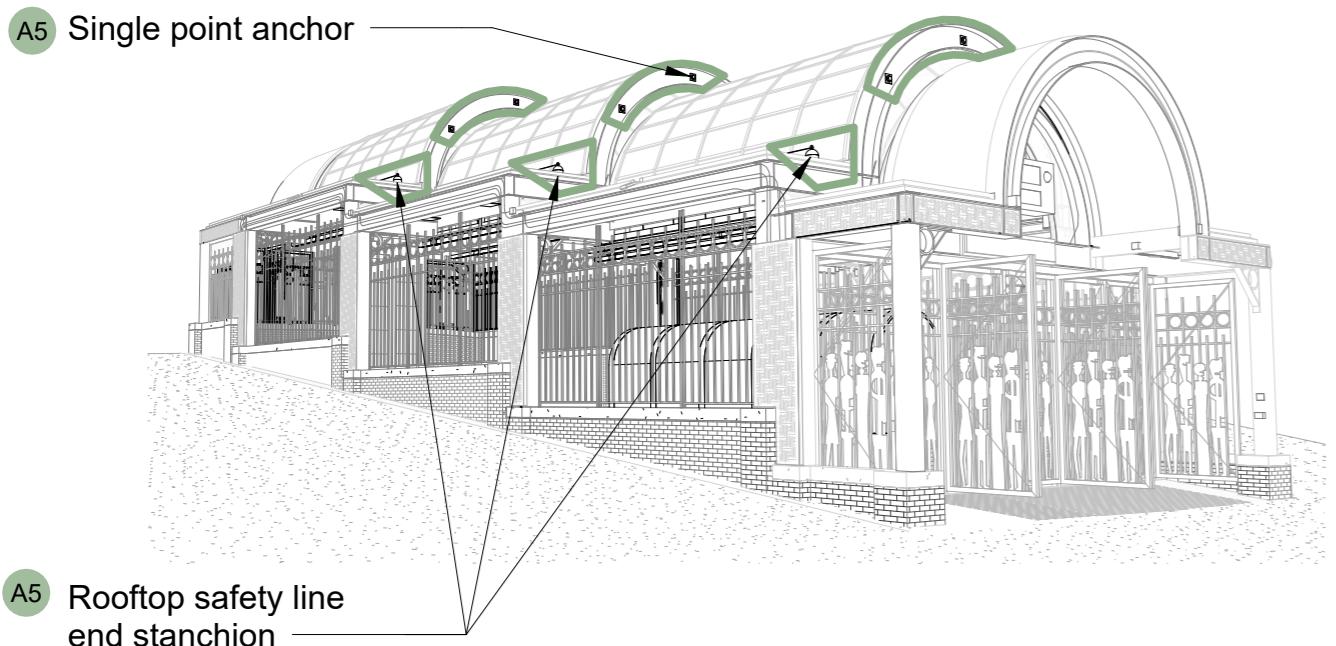


REFLECTED CEILING PLAN


Many roof penetrations at hard to access high ceiling locations increases the possibility of water intrusion into the headhouse

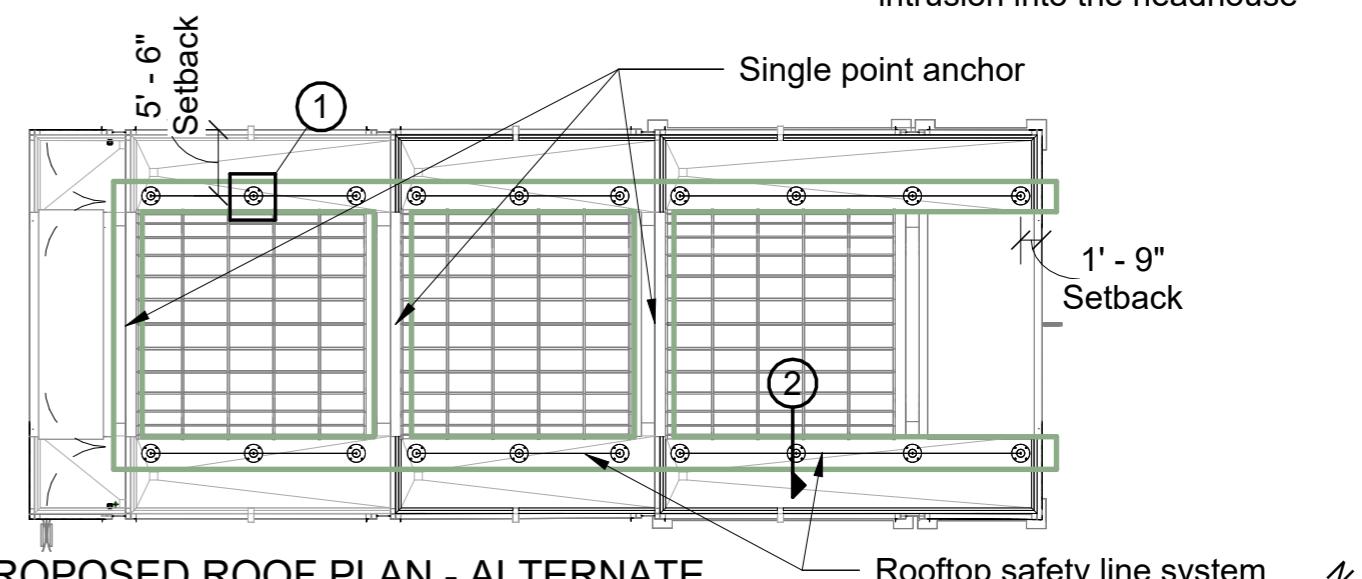


PROPOSED ROOF PLAN - ALTERNATE

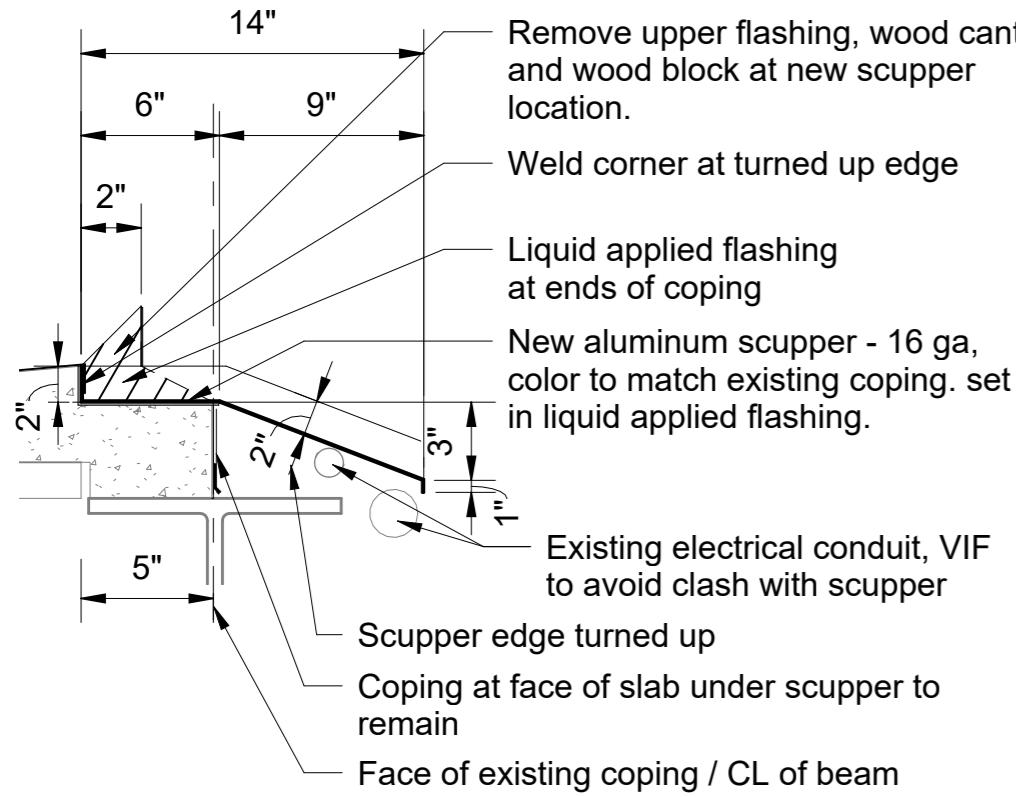

3 SECTION DETAIL - SCUPPER

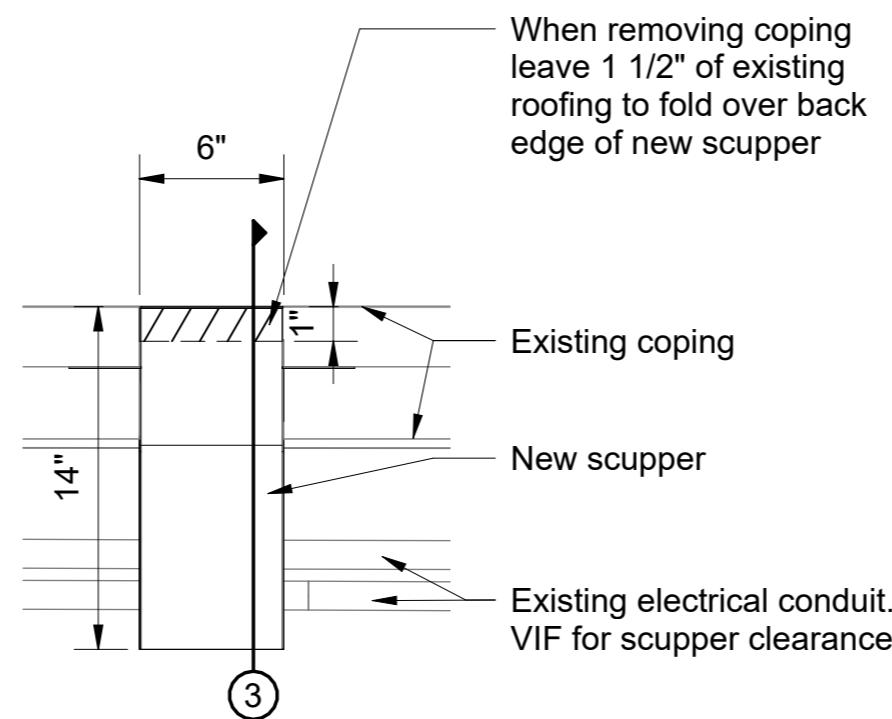


2 PLAN DETAIL - SCUPPER

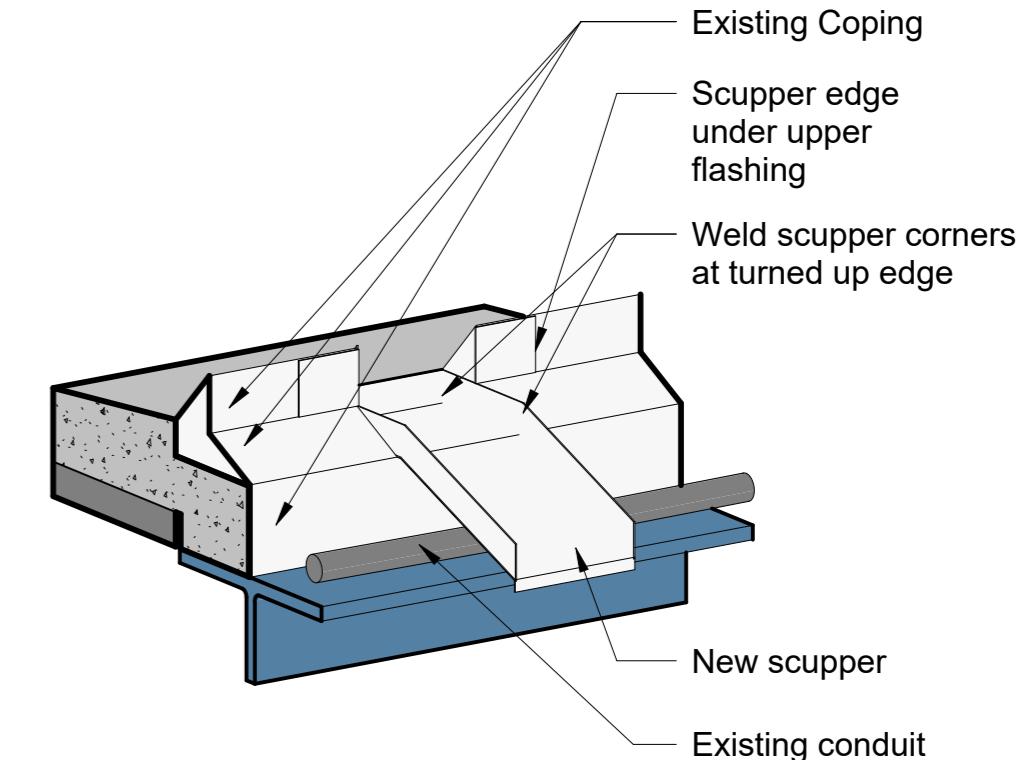


1 3D DETAIL - SCUPPER

Modify existing parapet with new scupper. Paint scupper to match existing structure.

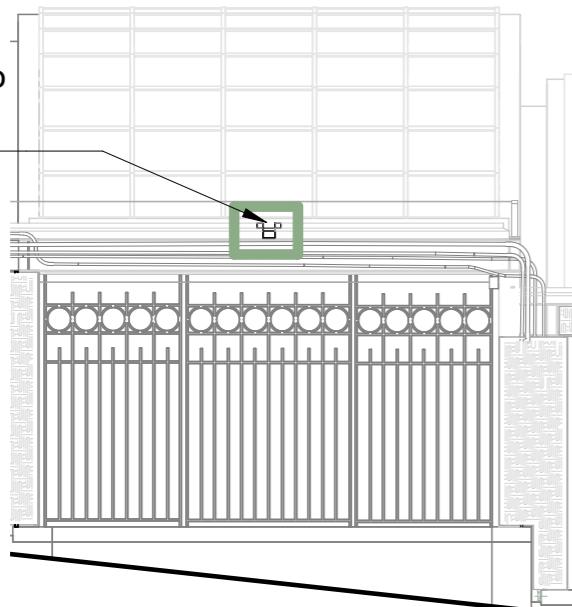

PROPOSED ELEVATION - SCUPPER AT TYPICAL BAY

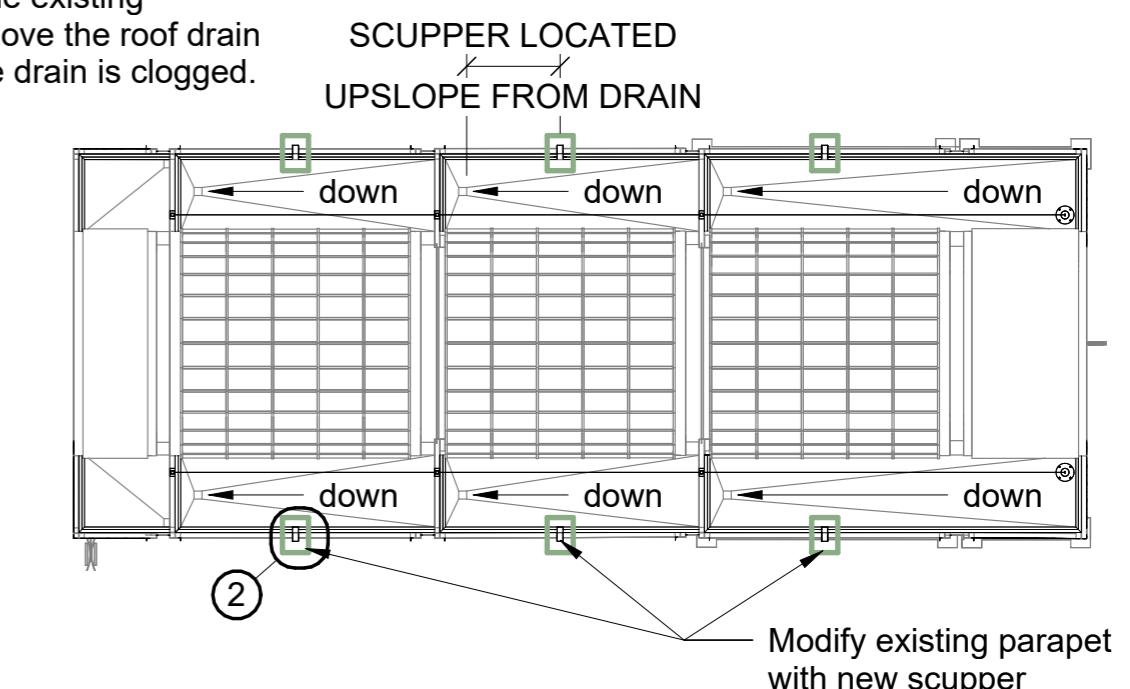

PROPOSED ROOF PLAN

Roof Drainage


Proposed solution for improving the roof drainage and reduce the water overflow into the building and onto the stairs and escalator is to modify a small section of the parapet, about 6-8" at each flat roof section, to have a scupper. That would allow overflow water from clogged drains to exit the roof perimeter onto the sidewalk before they rise to the level of the glass barrel vault bottom seal.

Scupper Details




Tiscareno

2nd Ave

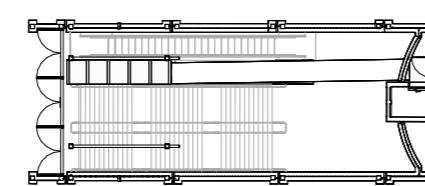


3rd Ave

Lighting

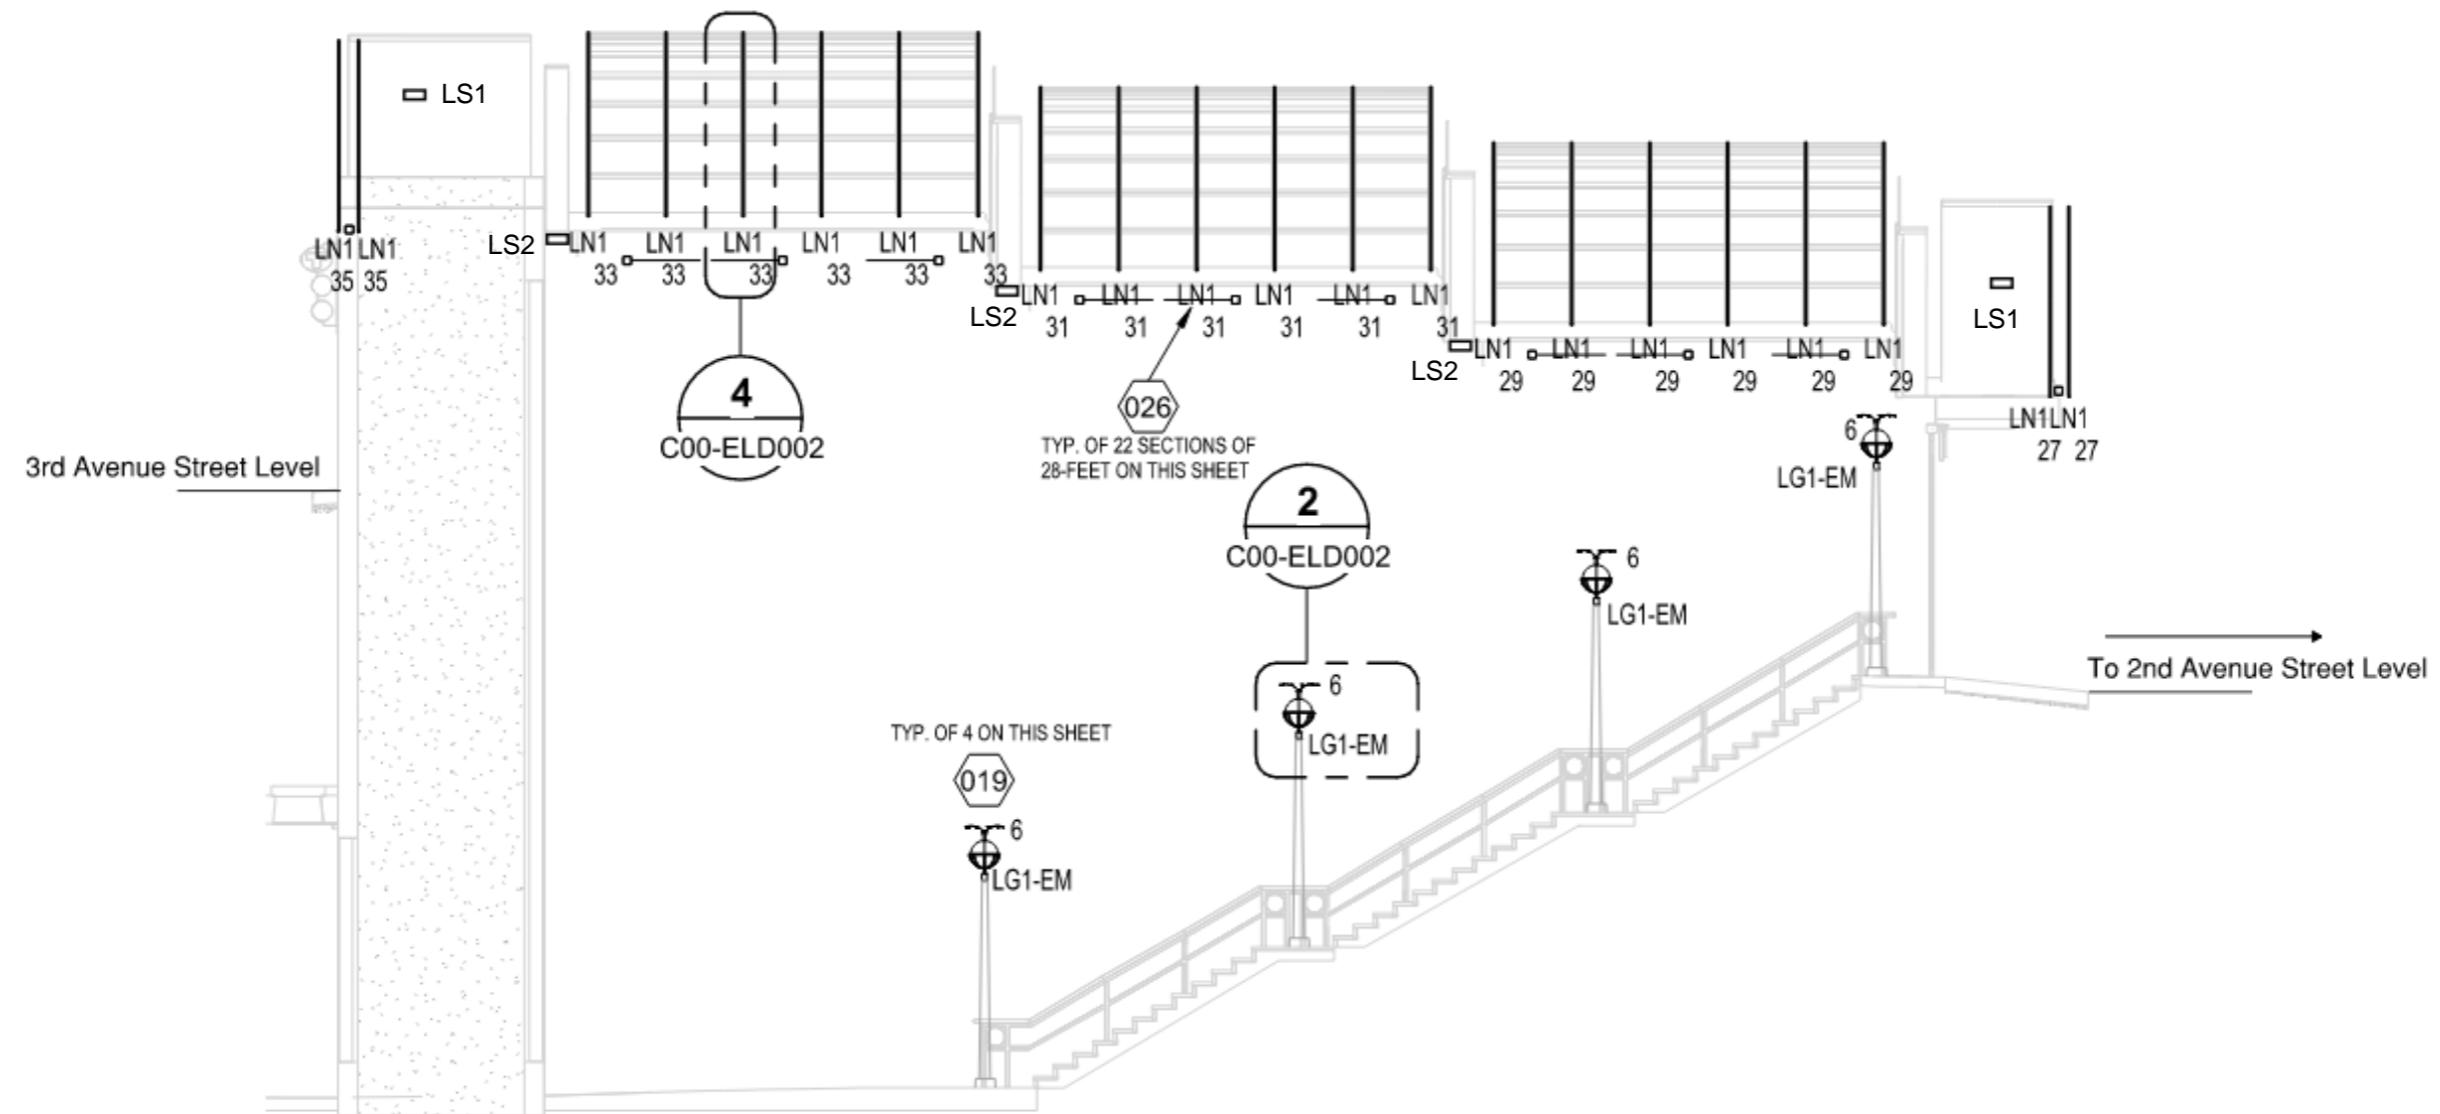

PREFONTAINE ENTRANCE

1

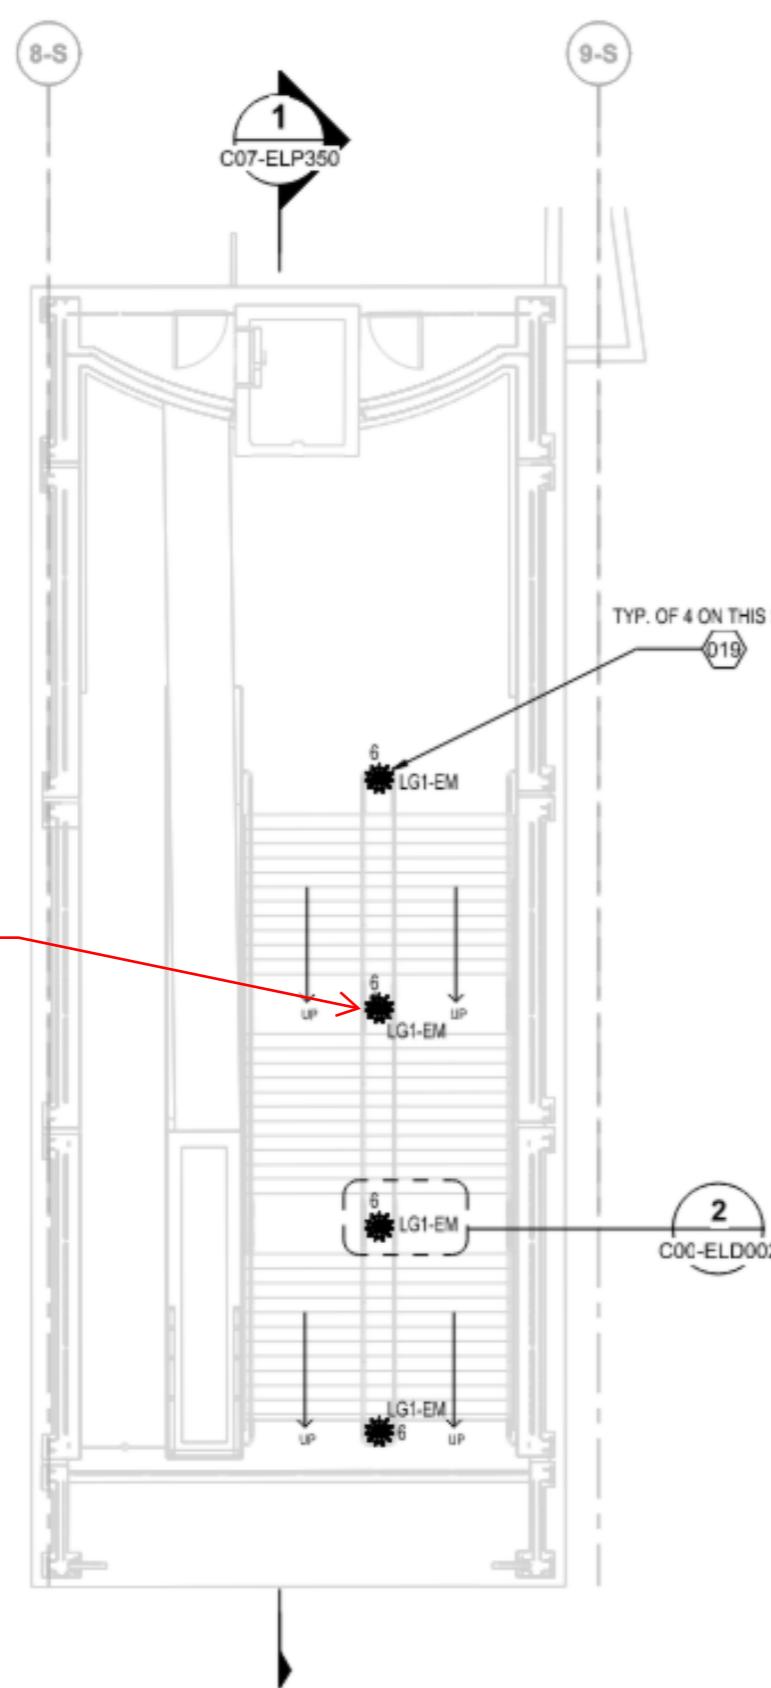


Light pole housing stay
as is. Type LG1-EM
will have LED retrofit.
(TYP OF 4)

Type LS1 is the replacement for the existing linear light fixtures.

Type LN1 is the replacement for the existing neon light fixtures.

Type LS1 is the replacement for the existing linear light fixtures at the entrances

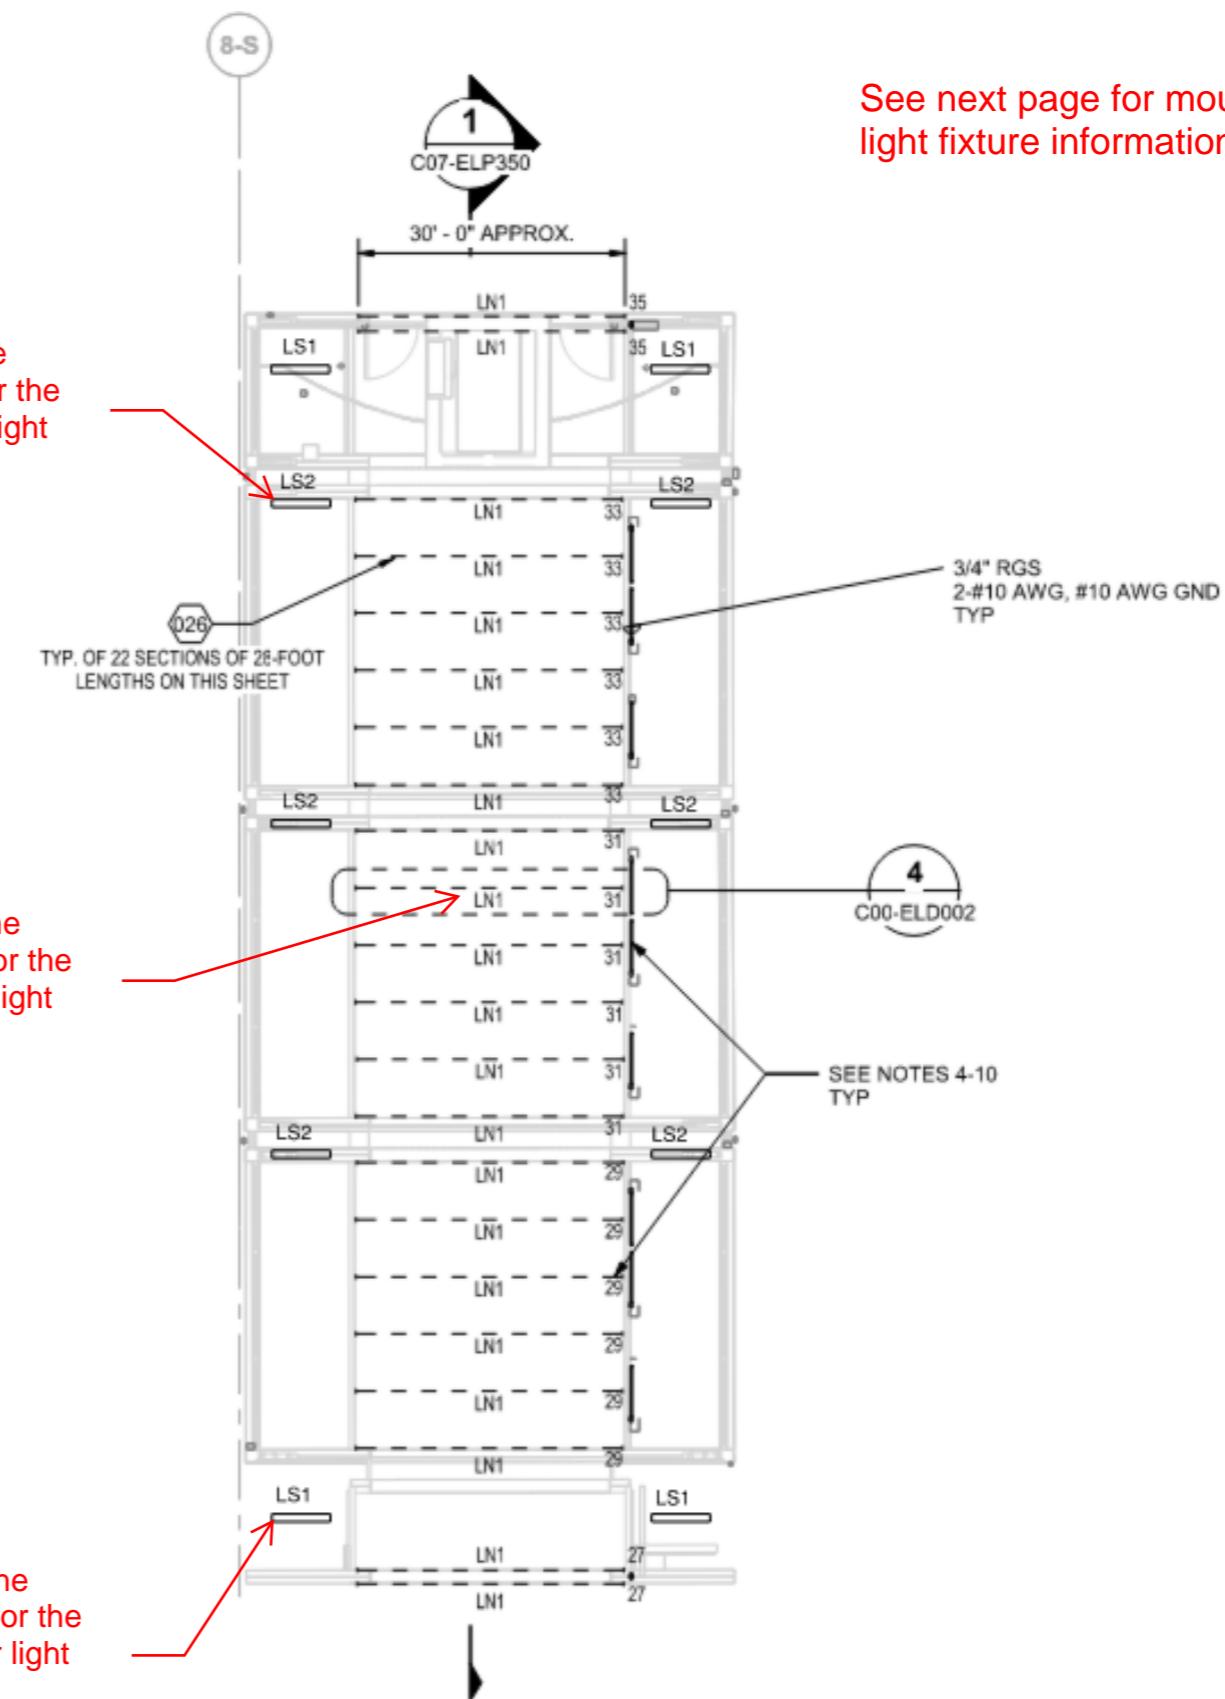

See next page for mounting detail and light fixture information.

PIONEER SQUARE STATION PREFONTAINE ENTRANCE

**PIONEER SQUARE STATION PREFONTAINE ENTRANCE
REFLECTED CEILING PLAN**



TYPE LG1-EM

Yellow highlights are information for the proposed light fixture.

Project Name:	Type:
Part Number:	Date:

HID BOLLARD LAMP

FEATURES

- Integral driver suitable for 120-277V
- Integral thermal sensor reduces power to the lamp in the event ambient temperature exceeds specified limitations
- Replaces 50W/70W/100W HID
- Suitable for damp locations and totally enclosed fixtures*
- Temperature rating: -4°F/-20°C - 95°F/35°C
- Rated lifetime (L70): 50,000hrs
- 5 year limited warranty**
- Integral 4kV surge protector (25HID models only)
- For installation in Post Top, Area light, or other fixtures exposed to high surge conditions, the use of our 10kV surge protector 97718-10SURGE/277V is recommended.





SPECIFICATIONS

Product	Model	Equiv. (HID)	Equiv. (Incandescent)	Input Voltage	Wattage	Lumens	CCT	CRI	Efficacy (LPW)	Beam Angle	Power Factor	THD	Fixture Rating	ES / DLC
35426	16A21/835/277V	70W	125W	120-277V	16	2,000	3500K	82	125	300°	0.9	<20%	Enclosed	✓ / N.A.
35414	25HID/835/277V/E26/R	70-100W	200W	120-277V	25	3,200	3500K	82	128	230°	0.9	<20%	Enclosed	✓ / N.A.



012324

Light fixture detail for Type LG1-EM.
Note: detail shown below is for bracket mounting.
For light pole installation, it will be similar as shown below except for mounting bracket.

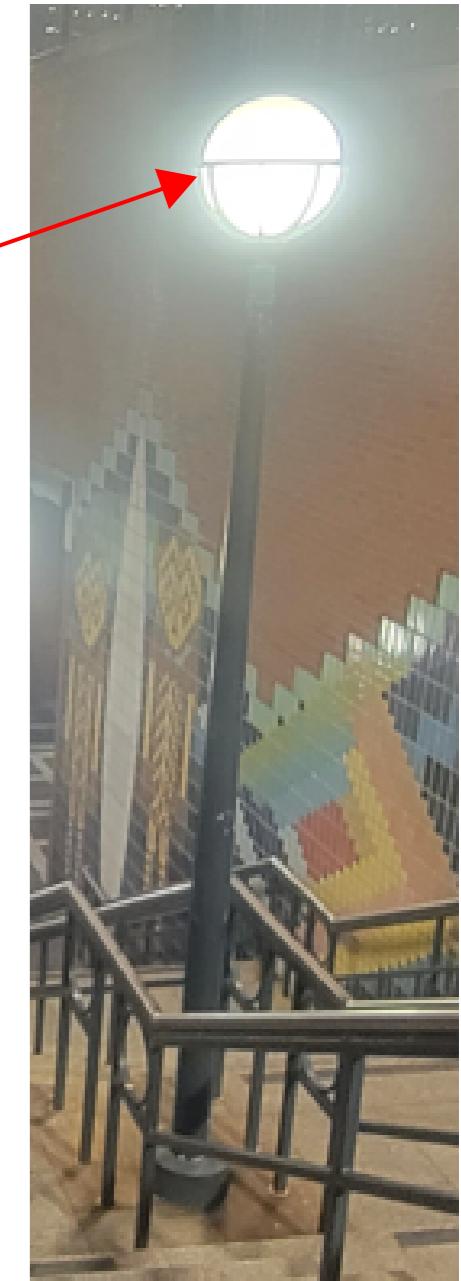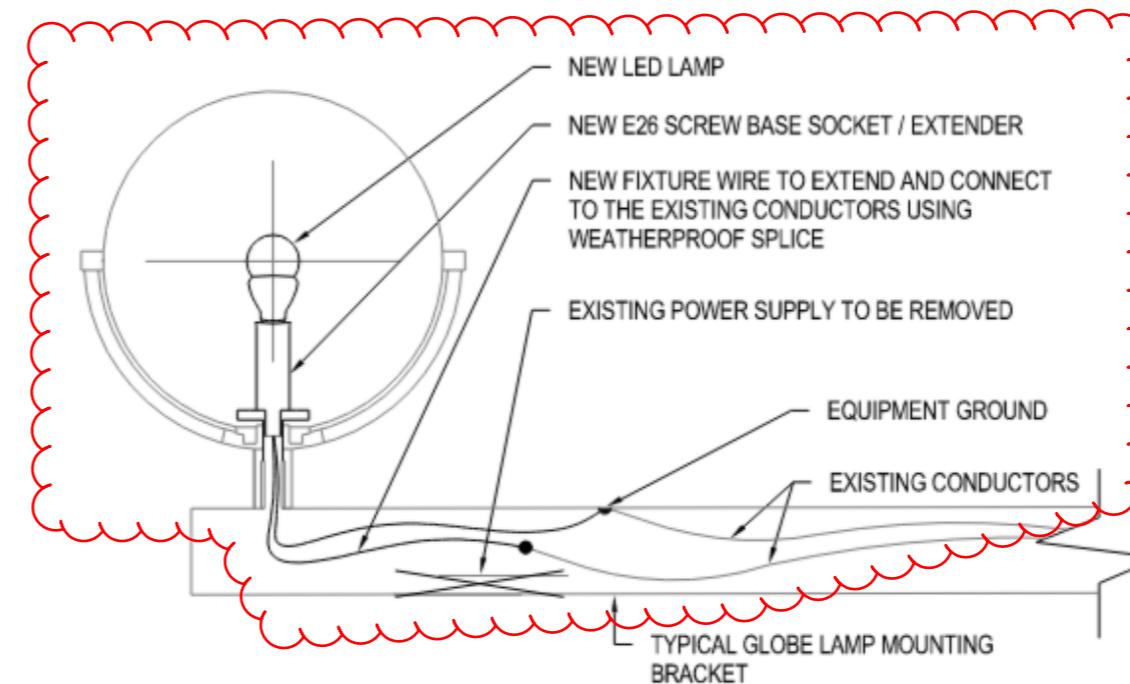

DETAIL NOTES:

1. REMOVE EXISTING POWER SUPPLY AND LED LAMP/ STEM.
2. INSTALL NEW SCREW BASE SOCKET AND EXTENDER.
3. NEW LED LAMP SHALL BE INSTALLED IN THE CENTER OF THE GLOBE SUCH THAT IT PROVIDES A UNIFORM GLOW THROUGHOUT THE GLOBE.
4. ELECTRICAL INSTALLATION INCLUDING ALL MATERIALS MUST BE RATED FOR WET LOCATION.
5. CLEAN EXISTING ACRYLIC GLOBES INSIDE/OUTSIDE.



SOUNDTRANSIT

Cut Sheet LG1-EM

B1

Project Name:	Type: LG1-EM
Part Number:	Date:



TYPE LG1-EM



HID BOLLARD LAMP

FEATURES

- Integral driver suitable for 120-277V
- Integral thermal sensor reduces power to the lamp in the event ambient temperature exceeds specified limitations
- Replaces 50W/70W/100W HID
- Suitable for damp locations and totally enclosed fixtures*
- Temperature rating: -4°F/-20°C - 95°F/35°C
- Rated lifetime (L70): 50,000hrs
- 5 year limited warranty**
- Integral 4kV surge protector (25HID models only)
- For installation in Post Top, Area light, or other fixtures exposed to high surge conditions, the use of our 10kV surge protector 97718-10SURGE/277V is recommended.




012324

SPECIFICATIONS

Product	Model	Equiv. (HID)	Equiv. (Incandescent)	Input Voltage	Wattage	Lumens	CCT	CRI	Efficacy (LPW)	Beam Angle	Power Factor	THD	Fixture Rating	ES/DLC
35426	16A21/835/277V	70W	125W	120-277V	16	2,000	3500K	82	125	300°	0.9	<20%	Enclosed	✓/N.A.
35414	25HID/835/277V/E26/R	70-100W	200W	120-277V	25	3,200	3500K	82	128	230°	0.9	<20%	Enclosed	✓/N.A.

** Please visit www.greencreative.com for Limited Warranty terms.

DIMENSION & WEIGHT

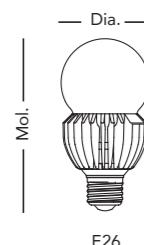

Model	Base	Mol.	Dia.	Weight
16A21/xxx/277V	E26	5"	2-9/16"	0.50lb
25HID/xxx/277V/E26/R	E26	6-3/8"	3-1/4"	1.04lb

Where xxx means 824-965 which indicates CRI and color temperature

E26

*MINIMUM COMPARTMENT DIMENSIONS (FOR ENCLOSED FIXTURES)

Model	Dia.	Height
16A21/xxx/277V	4"	5-1/2"
25HID/xxx/277V/E26/R	6"	8-1/2"

Installing lamp in a fixture that does not have the minimum compartment dimensions will void the warranty and could cause product failures.

HID EQUIVALENCE

GREEN CREATIVE HID LED		Metal Halide		Mercury Vapor		High Pressure Sodium	
Power	Lumens	Power	Mean Lumens	Power	Mean Lumens	Power	Mean Lumens
25W	3,300	70W	3,400	100W	3,300	50W	3,600

TYPE LG1-EM



HID BOLLARD LAMP

OPTIONAL ACCESSORY ORDERING INFORMATION

Product	Model	Description	Picture	Dimensions
97718	10SURGE/277V	10kV Surge Protector Recommended for use in Area light retrofits and other applications subject to high surge conditions.		1-3/8" x 2-1/2"
16325	E26 EXTENDER	E26 Lamp Extender Adds 1-5/16" to Lamp Height		1-7/16" x 2-3/8"
35050	E39 EXTENDER	EX39 Lamp Extender Adds 1-11/16" to Lamp Height		2-3/16" x 4"

Note: All rights reserved. All sizes and specifications are subject to change at any time without notice.

TYPE LS1

Yellow highlights are information for the proposed light fixture.



Series - High Lumen Family - Specification Sheet

The LUX IK10+ series features COMPETITIVE EFFICACY across a BROAD LUMEN RANGE. We build the IK10+ from durable 6463 EXTRUDED ALUMINUM making it beautiful while maintaining terrific STABILITY and LONGEVITY.




WA (White Acrylic) Lens					
Delivered Lumens @ 5000K, 80 CRI, High Lumen	Model	Delivered Lumens	Wattage	Efficacy	
	L-1-XX-850-4-XXX-WA	22,016	156	141	
	L-2-36lm-XX-850-4-XXX-WA	33,739	232	146	
	L-2-XX-850-4-XXX-WA	43,715	307	142	
	L-3-XX-850-4-XXX-WA	64,644	466	139	
	L-4-XX-850-4-XXX-WA	86,629	619	140	
	L-5-XX-850-4-XXX-WA	107,939	776	139	
	L-6-XX-850-4-XXX-WA	130,485	930	140	
	L-7-XX-850-4-XXX-WA	152,549	1,089	140	
	L-8-XX-850-4-XXX-WA	175,209	1,236	142	

CCT	
Standard = 5000K CCT	
6500K	97.1%
5700K	98.4%
5000K (nominal)	100.0%
4000K	100.0%
3500K	97.1%
3000K	93.2%
2700K	90.6%



New linear light fixture will be replaced with existing linear light fixture. Existing Unistrut mount will be reused for the Type LS1.

Light fixture at the 2nd Avenue Entrance.

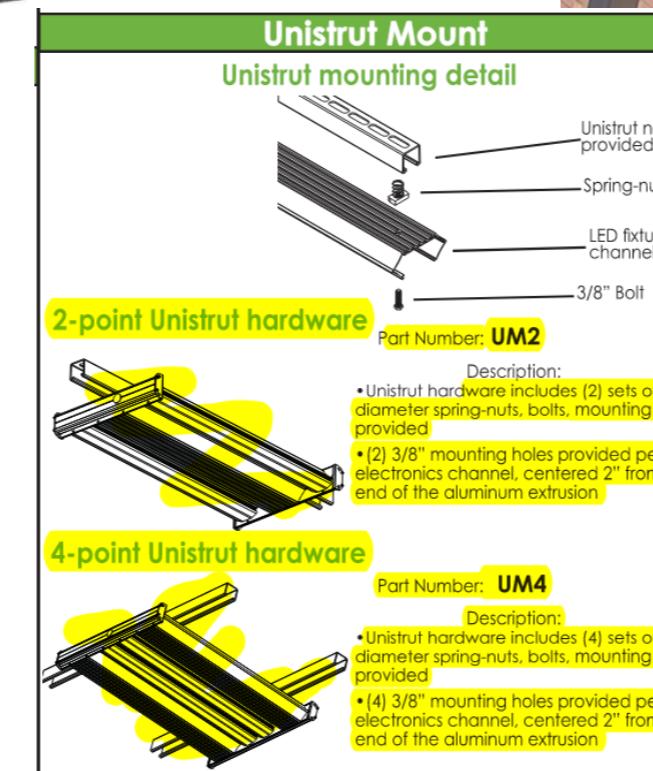

Round light fixtures will be removed once the new linear light fixtures are installed.


Light fixture at the 3rd Avenue Entrance.

4' Length All Distributions

Standard Configurations



Other Configurations

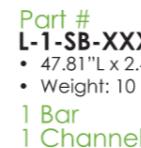

Options and Accessories Continued

Mounting

(leave blank)	No mounting hardware provided
10Y	Y-hanger AC cable up to 11' length, snap hook
4P10	4-point AC cable up to 10' length, hook
4P10S	Stainless steel 4-point AC cable up to 10' length, hook
SPM	Adapter to suspend luminaire below existing stem
MH1	Myer's hub 1-point, 3/4" GRC adapter, Galv. Steel
MH2	Myer's hub 2-point, 3/4" GRC adapter, Galv. Steel
MH1S	Myer's hub 1-point, 3/4" GRC adapter, stainless-steel
MH2S	Myer's hub 2-point, 3/4" GRC adapter, stainless-steel
SM	Surface mount, no machining or hardware provided
SMH	Surface mount, incl. pre-machined mounting points
UM2	Unistrut mount, includes (2) points of mounting, suitable for mounting to single strut.
UM4	Unistrut mount, includes (4) points of mounting, suitable for mounting to (2) struts.
YK	Yoke mount, adjustable trunnion (Not suitable for WET locations)

Finish

(leave blank)	Standard natatorium-grade bright dip anodized aluminum and green hanging brackets, shown on specification sheet
M	Silver stainless-steel hanging brackets (no green). Standard bright dip anodized aluminum body
PC	Custom color by powdercoat. Must specify RAL number and components to be finished
BLKG	Glossy black finish on all components
BLKM	Matte black finish on all components
AND	Anodize color finish, available on 2' fixtures only, consult Factory

Custom color anodized aluminum available in 2' configurations, consult Factory. Nonstandard fixture finishes may reduce delivered lumens, consult Factory for details.

Controls

OC	Integral on/off occupancy sensor (120-277V)
DO	Integral high/low/off occupancy and daylight harvesting sensor (120-277V)
OCH	High voltage (347/480V) knockout-mounted on/off occupancy sensor, not installed
DOKH	High voltage (347/480V) knockout-mounted high/low/off occupancy and daylight harvesting sensor, not installed
Wireless Controls	Multiple wireless control systems available. Contact Factory for options and details

LUX is controls-agnostic and can use most requested control systems

Application (Select all that apply)

GEN	General applications (Not rated for WET, NSF, or high abuse environments)
WET	Wet location (Includes conformal coated LED modules, HO5)
COR*	Caustic/natatorium environments (Includes conformal coated LED modules, HO5)
NSF	EPH rated for food-safe applications
TC	Tennis court (Polycarbonate lensing recommended)
MFG	Manufacturing or industrial
WHS	Warehousing or storage
HNG	Hangar
GYM	Gymnasium or sports court (Polycarbonate lensing required)
AFH	Arena or fieldhouse (Polycarbonate lensing recommended)
ARCH	Architectural (White lensing recommended)
ICE	Ice rink (Polycarbonate lensing recommended)
GAR	Garage or canopy
FRZ	Freezer or cold storage
HT	High temp, 55°C/131°F or higher (E-Series recommended)
BABA	Build America Buy America (BABA) Compliant (Not all configurations meet BABA, consult Factory)

*COR application not suitable for all caustic environments, consult Factory. Lensing and Bottom Access required for WET, COR, and EPH/NSF applications. Consult Factory for cost adders for WET, COR and EPH/NSF applications.

2' Performance - Wide Distribution

(Data Based on 5000K and 80CRI - Static White ONLY)

No Lens				
	Model	Delivered Lumens	Wattage	Efficacy
Delivered Lumens @ 5000K, 80 CRI, High Lumen	L-1-XX-850-2-XXX	12,522	78	161
	L-2-18m-XX-850-2-XXX	19,190	116	166
	L-2-XX-850-2-XXX	24,864	154	162
	L-3-30lm-XX-850-2-XXX	32,750	201	163
	L-3-XX-850-2-XXX	36,768	233	158
	L-4-XX-850-2-XXX	49,272	309	159
	L-5-XX-850-2-XXX	61,393	388	158
	L-6-XX-850-2-XXX	74,216	465	160
	L-7-XX-850-2-XXX	86,766	544	159
	L-8-XX-850-2-XXX	99,654	618	161

CA (Clear Acrylic) Lens				
	Model	Delivered Lumens	Wattage	Efficacy
Delivered Lumens @ 5000K, 80 CRI, High Lumen	L-1-XX-850-2-XXX-CA	12,005	78	154
	L-2-18m-XX-850-2-XXX-CA	18,397	116	159
	L-2-XX-850-2-XXX-CA	23,837	154	155
	L-3-30lm-XX-850-2-XXX-CA	31,397	201	156
	L-3-XX-850-2-XXX-CA	35,249	233	151
	L-4-XX-850-2-XXX-CA	47,237	309	153
	L-5-XX-850-2-XXX-CA	58,857	388	152
	L-6-XX-850-2-XXX-CA	71,151	465	153
	L-7-XX-850-2-XXX-CA	83,182	544	153
	L-8-XX-850-2-XXX-CA	95,538	618	155

CP (Clear Polycarbonate) Lens				
	Model	Delivered Lumens	Wattage	Efficacy
Delivered Lumens @ 5000K, 80 CRI, High Lumen	L-1-XX-850-2-XXX-CP	11,080	78	142
	L-2-18m-XX-850-2-XXX-CP	16,979	116	146
	L-2-XX-850-2-XXX-CP	22,000	154	143
	L-3-30lm-XX-850-2-XXX-CP	28,977	201	144
	L-3-XX-850-2-XXX-CP	32,533	233	140
	L-4-XX-850-2-XXX-CP	43,597	309	141
	L-5-XX-850-2-XXX-CP	54,321	388	140
	L-6-XX-850-2-XXX-CP	65,668	465	141
	L-7-XX-850-2-XXX-CP	76,772	544	141
	L-8-XX-850-2-XXX-CP	88,176	618	143

WA (White Acrylic) Lens				
	Model	Delivered Lumens	Wattage	Efficacy
Delivered Lumens @ 5000K, 80 CRI, High Lumen	L-1-XX-850-2-XXX-WA	11,008	78	141
	L-2-18m-XX-850-2-XXX-WA	16,869	116	146
	L-2-XX-850-2-XXX-WA	21,858	154	142
	L-3-30lm-XX-850-2-XXX-WA	28,790	201	143
	L-3-XX-850-2-XXX-WA	32,322	233	139
	L-4-XX-850-2-XXX-WA	43,314	309	140
	L-5-XX-850-2-XXX-WA	53,970	388	139
	L-6-XX-850-2-XXX-WA	65,243	465	140
	L-7-XX-850-2-XXX-WA	76,275	544	140
	L-8-XX-850-2-XXX-WA	87,605	618	142

WP (White Polycarbonate) Lens				
	Model	Delivered Lumens	Wattage	Efficacy
Delivered Lumens @ 5000K, 80 CRI, High Lumen	L-1-XX-850-2-XXX-WP	8,673	78	111
	L-2-18m-XX-850-2-XXX-WP	13,291	116	115
	L-2-XX-850-2-XXX			

K10 Series - High Lumen Family

TYPE LS1



4' Performance - Wide Distribution

(Data Based on 5000K and 80CRI - Static White ONLY)

No Lens				
Model	Delivered Lumens	Wattage	Efficacy	
Delivered Lumens @ 5000K, 80 CRI, High Lumen	L-1-XX-850-4-XXX	25,044	156	161
	L-2-36lm-XX-850-4-XXX	38,379	232	166
	L-2-XX-850-4-XXX	49,728	307	162
	L-3-XX-850-4-XXX	73,535	466	158
	L-4-XX-850-4-XXX	98,544	619	159
	L-5-XX-850-4-XXX	122,786	776	158
	L-6-XX-850-4-XXX	148,433	930	160
	L-7-XX-850-4-XXX	173,532	1,089	159
	L-8-XX-850-4-XXX	199,308	1,236	161

CA (Clear Acrylic) Lens				
Model	Delivered Lumens	Wattage	Efficacy	
Delivered Lumens @ 5000K, 80 CRI, High Lumen	L-1-XX-850-4-XXX-CA	24,010	156	154
	L-2-36lm-XX-850-4-XXX-CA	36,794	232	159
	L-2-XX-850-4-XXX-CA	47,674	307	155
	L-3-XX-850-4-XXX-CA	70,498	466	151
	L-4-XX-850-4-XXX-CA	94,474	619	153
	L-5-XX-850-4-XXX-CA	117,714	776	152
	L-6-XX-850-4-XXX-CA	142,302	930	153
	L-7-XX-850-4-XXX-CA	166,364	1,089	153
	L-8-XX-850-4-XXX-CA	191,076	1,236	155

CP (Clear Polycarbonate) Lens				
Model	Delivered Lumens	Wattage	Efficacy	
Delivered Lumens @ 5000K, 80 CRI, High Lumen	L-1-XX-850-4-XXX-CP	22,160	156	142
	L-2-36lm-XX-850-4-XXX-CP	33,959	232	146
	L-2-XX-850-4-XXX-CP	44,000	307	143
	L-3-XX-850-4-XXX-CP	65,065	466	140
	L-4-XX-850-4-XXX-CP	87,194	619	141
	L-5-XX-850-4-XXX-CP	108,643	776	140
	L-6-XX-850-4-XXX-CP	131,336	930	141
	L-7-XX-850-4-XXX-CP	153,544	1,089	141
	L-8-XX-850-4-XXX-CP	176,351	1,236	143

WA (White Acrylic) Lens				
Model	Delivered Lumens	Wattage	Efficacy	
Delivered Lumens @ 5000K, 80 CRI, High Lumen	L-1-XX-850-4-XXX-WA	22,016	156	141
	L-2-36lm-XX-850-4-XXX-WA	33,739	232	146
	L-2-XX-850-4-XXX-WA	43,715	307	142
	L-3-XX-850-4-XXX-WA	64,644	466	139
	L-4-XX-850-4-XXX-WA	86,649	619	140
	L-5-XX-850-4-XXX-WA	107,939	776	139
	L-6-XX-850-4-XXX-WA	130,485	930	140
	L-7-XX-850-4-XXX-WA	152,549	1,089	140
	L-8-XX-850-4-XXX-WA	175,209	1,236	142

WP (White Polycarbonate) Lens				
Model	Delivered Lumens	Wattage	Efficacy	
Delivered Lumens @ 5000K, 80 CRI, High Lumen	L-1-XX-850-4-XXX-WP	17,347	156	111
	L-2-36lm-XX-850-4-XXX-WP	26,583	232	115
	L-2-XX-850-4-XXX-WP	34,444	307	112
	L-3-XX-850-4-XXX-WP	50,933	466	109
	L-4-XX-850-4-XXX-WP	68,256	619	110
	L-5-XX-850-4-XXX-WP	85,046	776	110
	L-6-XX-850-4-XXX-WP	102,810	930	111
	L-7-XX-850-4-XXX-WP	120,195	1,089	110
	L-8-XX-850-4-XXX-WP	138,049	1,236	112

Custom lumen/wattage output available with CFO option specified. Consult Factory.

Page 5 of 12

775.200.0707

luxdynamics.com

Revised 05/28/2025


K10 Series - High Lumen Family

TYPE LS1



Optical Distribution Variations

NL (No Lens)
Standard 120° distribution achieved when using bare LEDs with no secondary optics. Includes 0% uplight component

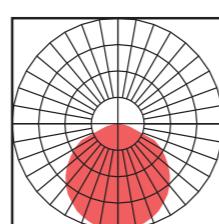

Lensed (CA,CP, WA, or WP)
Wide/diffused optic achieved using any of our standard lenses.
Clear lens includes minimum 3.4% uplight
White lens includes minimum 10% uplight



Lumen Multipliers

Lens	Standard = CA Lens
NL	104.3%
CA (nominal)	100.0%
CP	92.3%
WA	91.7%
WP	72.2%

CCT	Standard = 5000K CCT
4500K	97.1%
5700K	98.4%
5000K (nominal)	100.0%
4000K	100.0%
3500K	97.1%
3000K	93.2%
2700K	90.6%

CRI	Standard = 80 CRI
80 CRI (nominal)	100.0%
90 CRI	100.0%
6500K (90 CRI)	83.4%
5700K (90 CRI)	83.7%
5000K (90 CRI)	83.7%
4000K (90 CRI)	83.7%
3500K (90 CRI)	82.2%
3000K (CRI 90)	79.8%
2700K (CRI 90)	75.9%

Emergency Battery Performance

(Data Based on 5000K, 80CRI and CA Lens)

Integral EM Options

E10 (10 Watt EM)		E15 (15 Watt EM)		E20 (20 Watt EM)	
Lens Option	Delivered Lumens	Lens Option	Delivered Lumens	Lens Option	Delivered Lumens
NL	1,855	NL	2,774	NL	3,709
CA	1,778	CA	2,659	CA	3,556
CP	1,641	CP	2,454	CP	3,282
WA	1,630	WA	2,438	WA	3,261
WP	1,285	WP	1,921	WP	

IK10 Series - High Lumen Family

TYPE LS1



2' Length
Wide Distribution ONLY

Standard Configurations	Other Common Configurations
Part # L-1-SA-XXX-2-XXX • 24.75" L x 1.18" W x 2.4" H • Weight: 5 LBS 1 Bar 1 Channel	Part # L-1-SB-XXX-2-XXX • 24.75" L x 2.4" W x 9.18" H • Weight: 5 LBS 1 Bar 1 Channel
Part # L-2-SA-XXX-2-XXX • 24.75" L x 12.18" W x 2.4" H • Weight: 7 LBS 2 Bar 1 Channel	Part # L-2-DA-XXX-2-XXX • 24.75" L x 18.18" W x 2.4" H • Weight: 10 LBS 2 Bar 2 Channel
Part # L-3-SA-XXX-2-XXX • 24.75" L x 15.18" W x 2.4" H • Weight: 9 LBS 3 Bar 1 Channel	Part # L-3-DA-XXX-2-XXX • 24.75" L x 21.18" W x 2.4" H • Weight: 12 LBS 3 Bar 2 Channel
Part # L-4-SA-XXX-2-XXX • 24.75" L x 18.18" W x 2.4" H • Weight: 11 LBS 4 Bar 1 Channel	Part # L-4-DA-XXX-2-XXX • 24.75" L x 24.18" W x 2.4" H • Weight: 14 LBS 4 Bar 2 Channel
Part # L-5-DA-XXX-2-XXX • 24.75" L x 27.18" W x 2.4" H • Weight: 16 LBS 5 Bar 2 Channel	Part # L-5-DA-XXX-4-XXX • 47.81" L x 27.18" W x 2.4" H • Weight: 32 LBS 5 Bar 2 Channel
Part # L-6-DA-XXX-2-XXX • 24.75" L x 30.18" W x 2.4" H • Weight: 18 LBS 6 Bar 2 Channel	Part # L-6-TA-XXX-2-XXX • 24.75" L x 36.18" W x 2.4" H • Weight: 21 LBS 6 Bar 3 Channel
Part # L-7-TA-XXX-2-XXX • 24.75" L x 39.18" W x 2.4" H • Weight: 23 LBS 7 Bar 3 Channel	Part # L-7-TA-XXX-4-XXX • 47.81" L x 39.18" W x 2.4" H • Weight: 44 LBS 7 Bar 3 Channel
Part # L-8-TA-XXX-2-XXX • 24.75" L x 42.18" W x 2.4" H • Weight: 25 LBS 8 Bar 3 Channel	Part # L-8-TA-XXX-4-XXX • 47.81" L x 42.18" W x 2.4" H • Weight: 48 LBS 8 Bar 3 Channel

4' Length
All Distributions

Standard Configurations	Other Common Configurations
Part # L-1-SA-XXX-4-XXX • 47.81" L x 9.18" W x 2.4" H • Weight: 10 LBS 1 Bar 1 Channel	Part # L-1-SB-XXX-4-XXX • 47.81" L x 2.4" W x 9.18" H • Weight: 10 LBS 1 Bar 1 Channel
Part # L-2-SA-XXX-4-XXX • 47.81" L x 12.18" W x 2.4" H • Weight: 14 LBS 2 Bar 1 Channel	Part # L-2-DA-XXX-4-XXX • 47.81" L x 18.18" W x 2.4" H • Weight: 20 LBS 2 Bar 2 Channel
Part # L-3-SA-XXX-4-XXX • 47.81" L x 15.18" W x 2.4" H • Weight: 18 LBS 3 Bar 2 Channel	Part # L-3-DA-XXX-4-XXX • 47.81" L x 21.18" W x 2.4" H • Weight: 24 LBS 3 Bar 2 Channel
Part # L-4-SA-XXX-4-XXX • 47.81" L x 18.18" W x 2.4" H • Weight: 22 LBS 4 Bar 1 Channel	Part # L-4-DA-XXX-4-XXX • 47.81" L x 24.18" W x 2.4" H • Weight: 28 LBS 4 Bar 2 Channel
Part # L-5-DA-XXX-4-XXX • 47.81" L x 27.18" W x 2.4" H • Weight: 32 LBS 5 Bar 2 Channel	Part # L-6-TA-XXX-4-XXX • 47.81" L x 30.18" W x 2.4" H • Weight: 34 LBS 6 Bar 2 Channel
Part # L-7-TA-XXX-4-XXX • 47.81" L x 39.18" W x 2.4" H • Weight: 44 LBS 7 Bar 3 Channel	Part # L-8-TA-XXX-4-XXX • 47.81" L x 42.18" W x 2.4" H • Weight: 48 LBS 8 Bar 3 Channel

IK10 Series - High Lumen Family

TYPE LS1



2' Performance - Narrow Optic (HO7)
ONLY Offered with 840 and 850 Options
(Data Based on 5000K and 80CRI - Static White ONLY)


Delivered Lumen @ 5000K, 80 CRI, High Lumen	Injection-Molded Narrow Optic			
	Model	Delivered Lumens	Wattage	Efficacy
L-1-XX-850-2-XXX-N	10,304	68	153	
L-2-18m-XX-850-2-XXX-N	17,852	116	154	
L-2-XX-850-2-XXX-N	20,609	135	153	
L-3-XX-850-2-XXX-N	30,914	200	155	
L-4-36m-XX-850-2-XXX-N	35,704	232	154	
L-4-XX-850-2-XXX-N	41,218	270	153	
L-5-XX-850-2-XXX-N	51,522	338	153	
L-6-XX-850-2-XXX-N	61,828	400	155	
L-7-XX-850-2-XXX-N	72,131	473	153	
L-8-XX-850-2-XXX-N	82,436	540	153	

Custom lumen/wattage output available with CFO option specified. Consult Factory.

Optical Distribution

NRW Optic

Narrow optic achieved using a molded-acrylic, prismatic optic. Includes approximately 0% uplight.

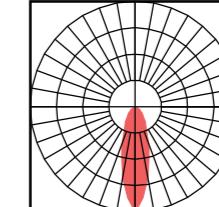

Emergency Battery Performance
(Data Based on 5000K and 80CRI)

Field-Installable (Non-Integral) EM Options

E10 (10 Watt EM)	E15 (15 Watt EM)	E20 (20 Watt EM)	E30 (30 Watt EM)
Lens Option	Lens Option	Lens Option	Lens Option
N	N	N	N
1,577	2,358	3,153	4,716

Field-Installable (Non-Integral) EM Options



E10 (10 Watt EM)	E15 (15 Watt EM)	E20 (20 Watt EM)
Lens Option	Lens Option	Lens Option
N	N	N
1,577	2,358	3,153

Optical Distribution Variations

NRW + Lens

Medium distribution achieved using narrow optic in addition to any standard lens.

- Clear lens includes minimum 2.4% uplight
- White lens includes minimum 6% uplight

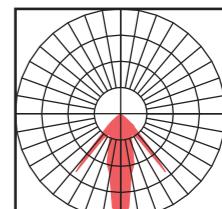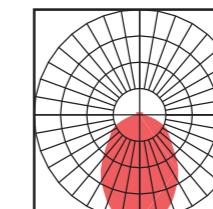

Lumen Multipliers

CCT	CRI
Standard = 5000K CCT 5000K (Nominal) 4000K	Standard = 80 CRI 80 CRI (Nominal) 100.0%

CCT	CRI
Standard = 5000K CCT 5000K (Nominal) 4000K	Standard = 80 CRI 80 CRI (Nominal) 100.0%

Delivered Lumen @ 3500K, 80 CRI, High Lumen	Narrow Optic with CA (Clear Acrylic) Lens - HO5			
	Model	Delivered Lumens	Wattage	Efficacy
L-1-XX-835-2-XXX-N	12,042	78	154	
L-2-18m-XX-835-2-XXX-N	18,453	116	159	
L-2-XX-835-2-XXX-N	24,084	154	157	
L-3-30m-XX-835-2-XXX-N	30,798	201	153	
L-3-XX-835-2-XXX-N	36,125	233	155	
L-4-XX-835-2-XXX-N	48,167	309	156	
L-5-XX-835-2-XXX-N	60,209	388	155	
L-6-XX-835-2-XXX-N	72,251	465	155	
L-7-XX-835-2-XXX-N	84,293	544	155	
L-8-XX-835-2-XXX-N	96,334	618	156	

Delivered Lumen @ 3500K, 80 CRI, High Lumen	Narrow Optic with CA (Clear Acrylic) Lens - HO5			
	Model	Delivered Lumens	Wattage	Efficacy
L-1-XX-835-2-XXX-N-CA	11,544	78	148	

**2' Length
Narrow Optic 840 and
850 Options ONLY**




**2' Length
Narrow Optic 835 and
90CRI Options ONLY**



Mounting Options

Cable Mount	Surface Mount
2-point Y-cable mount Part Numbers: 10Y, 20Y, 30Y Description: • "10", "20", "30" represents length in feet • Galvanized steel cable and hook • Some configurations may be unbalanced, 4-point hanger recommended for unbalanced fixtures, contact Factory for more information	Surface mounting (no additional hardware or mounting holes supplied) Part Number: SM Description: • Fixture may be anchored to any suitable substrate through electronics channel • No additional hanging hardware provided
4-point cable mount Part Numbers: 4P10, 4P20, 4P10S, 4P20S Description: • "10", "20", "30" represents length in feet • "S" in part number denotes natatorium-grade 316 stainless steel, recommended for natatoriums and other caustic environments	Surface mount - 3/8" mounting holes supplied Part Number: SMH Description: • Fixture may be anchored to any suitable substrate through electronics channel • (2) 3/8" mounting holes provided per electronics channel, centered 2" from the end of the aluminum extrusion
Stem Mount	Unistrut Mount
1-point rigid stem mount Part Numbers: MH1, MH1S Description: • 3/4" IP threaded hub to mount to 3/4" conduit or stem (other hub diameters available, contact factory for options) • Galvanized steel is standard, for stainless steel use "S" in part number • Stem/threaded rod not provided • Not available on all models and options • Cord installed through fixture end cap when ordered with stem mount option • Cord NOT installed when power feed is routed through stem	Unistrut mounting detail Unistrut not provided Spring-nut LED fixture channel 3/8" Bolt
2-point rigid stem mount Part Numbers: MH2, MH2S Description: • 3/4" IP threaded hub to mount to 3/4" conduit or stem (other hub diameters available, contact factory for options) • Galvanized steel is standard, for stainless steel use "S" in part number • Stem/threaded rod not provided • Not available on all models and options • Cord installed through fixture end cap when ordered with stem mount option • Cord NOT installed when power feed is routed through stem	2-point Unistrut hardware Part Number: UM2 Description: • Unistrut hardware includes (2) sets of 3/8" diameter spring-nuts, bolts, mounting holes provided • (2) 3/8" mounting holes provided per electronics channel, centered 2" from the end of the aluminum extrusion
Threaded junction box for single point mount Part Number for 3' Cable Lengths: SPM3' Part Number for 5' Cable Lengths: SPM5' Description: • 3/4" IP threaded hub attached to 3" x 6" x 6" junction box with (4) fixed-length cables (3' and 5') for fixture mounting • Power cord ordered separately	4-point Unistrut hardware Part Number: UM4 Description: • Unistrut hardware includes (4) sets of 3/8" diameter spring-nuts, bolts, mounting holes provided • (4) 3/8" mounting holes provided per electronics channel, centered 2" from the end of the aluminum extrusion
Yoke Mount	Yoke Mount
	Part Number: YKx ("x" to change based on fixture) Description: • Adjustable or static yoke mounts allows for ceiling or wall mounting, contact Factory • Power cord ordered separately • Yoke mount is installed on the fixture before shipping • Hardware to secure mount to structural surface NOT provided • Not suitable for WET locations

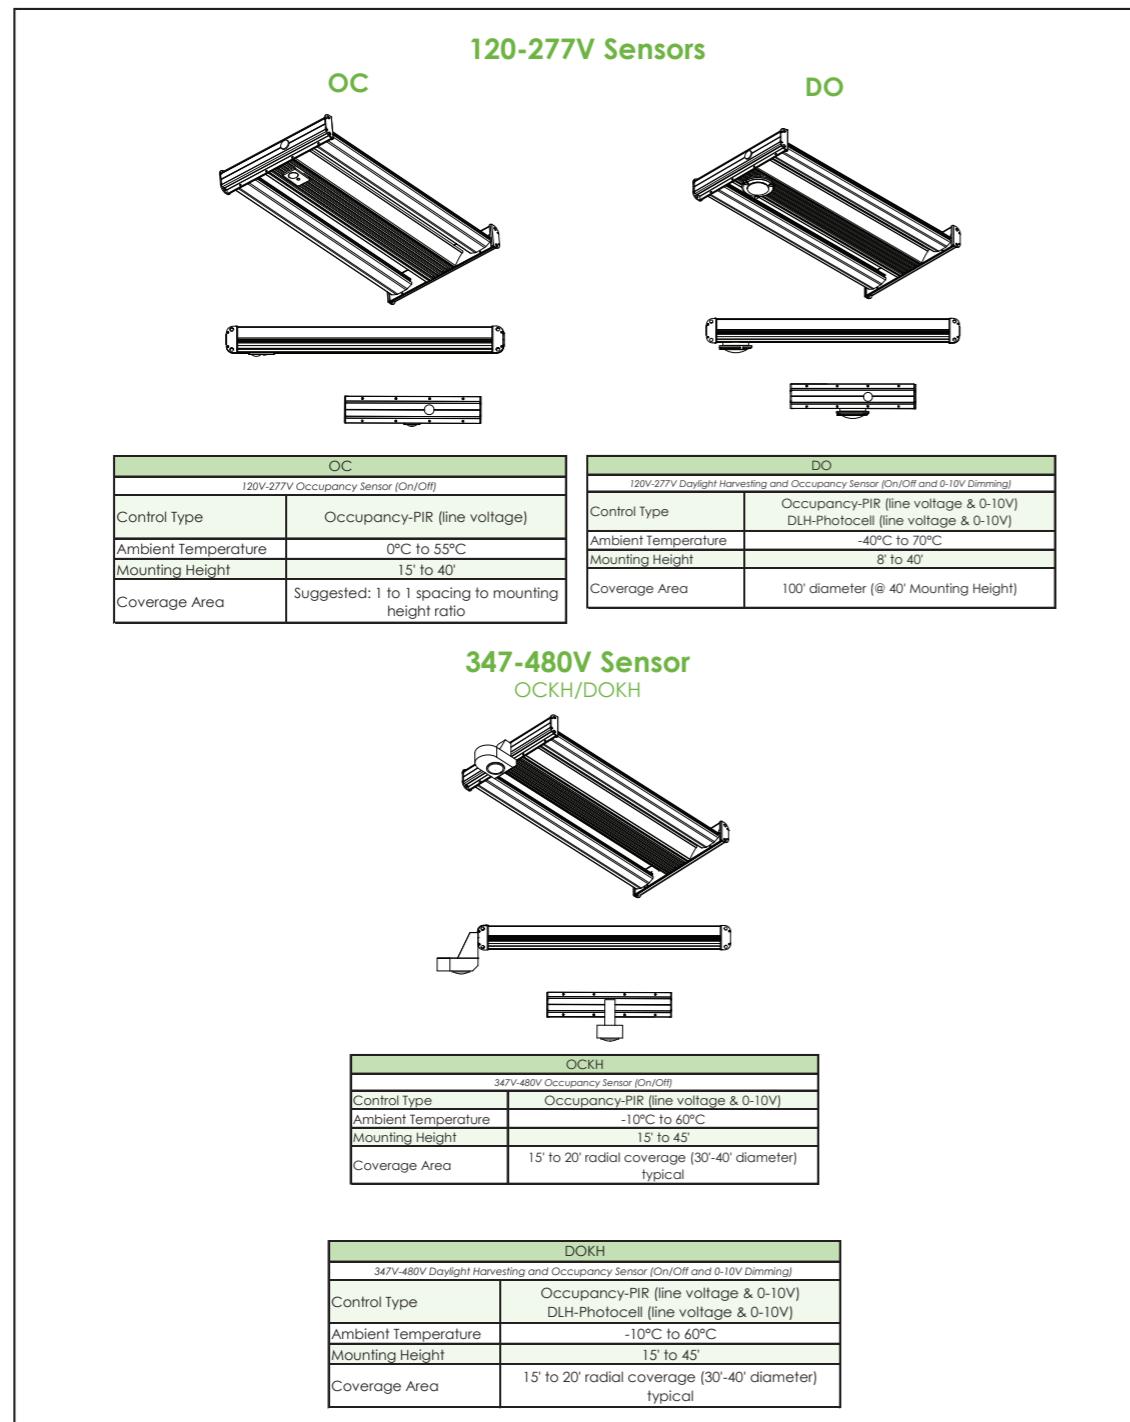

Page 11 of 12

775.200.0707

luxdynamics.com

Revised 05/28/2025

Electronics Channel Access

Page 12 of 12

775.200.0707

luxdynamics.com

Revised 05/28/2025


TYPE LS2

Yellow highlights are information for the proposed light fixture.



Extruded aluminum architectural and task lighting LED luminaire for use in applications including, but not limited to subways, parking garages, airports, and office spaces.

LUX
dynamics

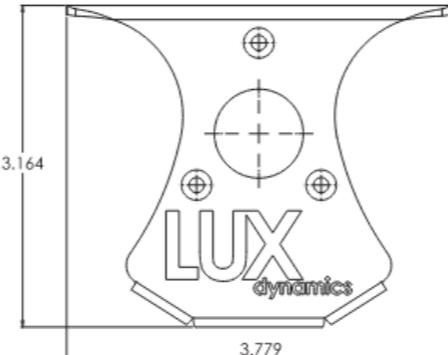

Surface Mount

Surface mount endcap
(surface-mounting hardware
provided by others)

HIGH		4	835	U10
Delivered lumens with 3500K color / WA lens		Other color rendering indexes and color temperatures are available. Consult factory.		Other driver options available. Consult factory.
Series	Length	CRI / CCT		Voltage and Dimming
HIGH	2	7,744lm	865 80CRI 6500K	U10 120-277V 0-10V dimming 10% min.
	4-6lm	6,058lm	857 80CRI 5700K	U1 120-277V 0-10V dimming 1% min.
	4-10lm	9,707lm	850 80CRI 5000K	H10 347-480V 0-10V dimming 10% min.
	4	15,488lm	840 80CRI 4000K	H1 347-480V 0-10V dimming 1% min.
	8	30,976lm	835 80CRI 3500K	
			830 80CRI 3000K	
			827 80CRI 2700K	
			950 90CRI 5000K	
			940 90CRI 4000K	
			935 90CRI 3500K	
			927 90CRI 2700K	
			TW* Tunable White	
			RGBW*RGB with XXX	
			GREYED options not stocked	
			and may need additional lead time	
			*Options significantly reduces lumen output, contact	
			Factory for more information	

Dimming curves and other
operating characteristics may
vary between models

Light fixture detail for Type LS2.
Existing Unistrut will be used to
mount the new light linear light fixture.



If needed additional
Unistrut will be added
to existing Unistrut
mount for additional
support.



TYPE LS2

LUX
dynamics

Extruded aluminum architectural and task lighting LED luminaire for use in applications including, but not limited to subways, parking garages, airports, and office spaces.



Performance

- Lumen output: **Up to 4,550 lumens per foot**
- Efficacy: **Up to 161 Lumens per Watt**
- L_{70} (per TM-21): **72,000 Hours**
- L_{70} (calculated): **147,000 Hours**
- Ambient Temp. Rating: **-40°F to 113°F (-40°C to 45°C)**
Ambient temperature rating varies for auxiliary components
- Surge Protection: **6kV**
- Driver: **120-277V input, 0-10V Dimming (1% min. optional)**
347-480V input, 0-10V Dimming (1% min. optional)

Construction

- Extruded 6463 aluminum construction
- Stainless-steel hardware
- Bright dip anodized fixture body

Optics

- Wide 120° beam angle LEDs
- Diffusing lens available in frosted and clear material
- Lens may be acrylic or polycarbonate material

Warranty

- 10-Year Warranty on fixture body
- 5-Year Warranty on electronics
- For special requests, contact factory



Page 1 of 6

775.200.0707

luxdynamics.com

Revised 06/26/2025

Applications

- Office/Commercial
- Education
- Industrial/Task
- Inspection
- Parking Garage
- Natatorium
- Gymnasium
- Cove Lighting

Installation

- Aircraft cable suspension
- Surface mounting
- For special requests, contact factory

Listings and Ratings

- UL 1598 for Dry, Damp, and Wet Locations
- ARRA Compliant (Made in America)
- DLC Listed
- IP55 Rated
- UL EPH Listed - NSF Rated
- Exceeds IK10 impact rating with polycarbonate lenses
- IK10 rating does not apply to acrylic lenses
- 3G Vibration Rated
- ARRA/BAA Compliant
- Conformal coated LED modules for WET locations

LUX
dynamics

TYPE LS2

LUX
HIGHline

Example Catalog Number:

HIGH

4

835

TYPE LS2

LUX
dynamics

U10

Series	Length	CRI / CCT	Voltage and Dimming
HIGH	2	7,744lm 865 80CRI 6500K	U10 120-277V 0-10V dimming 10% min.
	4-6lm	857 80CRI 5700K	U1 120-277V 0-10V dimming 1% min.
	4-10lm	850 80CRI 5000K	H10 347-480V 0-10V dimming 10% min.
	4	840 80CRI 4000K	H1 347-480V 0-10V dimming 1% min.
	8	835 80CRI 3500K	
		830 80CRI 3000K	
		827 80CRI 2700K	
		950 90CRI 5000K	
		940 90CRI 4000K	
		935 90CRI 3500K	
		927 90CRI 2700K	
		TW Tunable White RGBW RGB with XXX GREYED options not stocked and may need additional lead time contact factory for more information	

Dimming curves and other operating characteristics may vary between models

Some CRI, CCT and other output variations may affect DLC listing; contact LUX for further information.

Options and Accessories

Endcap

- HM** Hanger mount
- SM** **3G** rated surface mount
- TM** Tandem hanger or surface mount
- AIM** Rotatable surface mount bracket
- TM and AIM endcaps NOT acceptable for WET locations
- Standard powdercoat white, contact LUX for options

Lensing

- CA** Clear acrylic diffuse lens
- CP** Clear polycarbonate diffuse lens
- WA** **White** acrylic diffuse lens (standard)
- WP** White polycarbonate diffuse lens
- "2", "4", or "8" denotes fixture length

Lumen/Wattage Output

- CFO** Custom fixture output (specify custom lumen output or wattage lower than standard)

Emergency

- E20RL** 20-watt remote battery available, contact LUX for options

Remote Mounting

- (leave blank) Standard integral driver(s)
- RMS** **Remote** mount driver(s) - surface mount enclosure provided

- RMC** Remote mount driver(s) - cable mount enclosure provided

- RNK** Remote mount driver(s) - no enclosure provided

Restrictions may apply for certain applications, consult Factory 4' enclosure standard, other enclosure lengths available, consult Factory

Mounting

- 2Pxx** 2-point aircraft cable suspension - hook ends (galvanized)
- 2PxxS** 2-point aircraft cable suspension - hook ends (stainless-steel)
- SM** **Surface** mount, no additional hardware
- 20' and 30' cable lengths available, contact Factory for details

Cord

- (leave blank) No cord provided
- 3/10** 3-wire, 10' cord
- 4/10** 4-wire, 10' cord
- 5/10** 5-wire, 10' cord
- 6/10** 6-wire, 10' cord

Other cord lengths available as well as multi-circuit wiring and through-wiring options.

Standard 1/2" knockout provided in endcap for cord installation.

1st digit: Number of wires, including ground. Available from 3 through 6.

2nd digit: Overall length, including strips. Available from 10' through 30'.

Finish

- (leave blank) Standard natatorium-grade bright dip anodized aluminum and white powdercoat endcaps, shown on specification sheet

M

- Mill finish endcaps, standard bright dip anodized aluminum body

- PC** Custom color by powdercoat. Must specify RAL number for endcap finish.

- BLKG** Glossy black finish on all components

- BLKM** Matte black finish on all components

Custom color anodized aluminum available in 2' configurations, consult Factory.

Nonstandard fixture finishes may reduce delivered lumens, consult Factory for details.

Controls

- OC-KO** Knockout-mounted on/off occupancy sensor (120-277V input)

- DO-KO** Knockout-mounted daylight harvesting sensor (120-277V input)

- OCKH** High Voltage (347/480V) knockout-mounted on/off occupancy sensor, **not installed**

- DOKH** High Voltage (347/480V) knockout-mounted high/low/off occupancy and daylight harvesting sensor, **not installed**

- Wireless Controls** Multiple wireless control systems available. Contact Factory for options and details

Page 2 of 6

775.200.0707

luxdynamics.com

Revised 06/26/2025

Powerfeed

(leave blank) Power fed through endcap knockout
WB Wire through body, power feed through milled hole in fixture channel

Application (Select all that apply)

WET	Wet location
COR*	Caustic and natatorium environments (Includes conformal coated LED modules)
NSF	EPH rated for food-safe applications
TC	Tennis court
MFG	Manufacturing or industrial
WHS	Warehousing or storage
HNG	Hangar
GYM	Gymnasium or sports court
AFH	Arena or fieldhouse
ARCH	Architectural
COV	Cove lighting
ICE	Ice rink
GAR	Garage or canopy
FRZ	Freezer or cold storage
BABA	Build America Buy America (BABA) compliant (Not all configurations meet BABA, consult Factory)
DATA	Data entry and server rooms
SW	Stairwells

*COR application not suitable for all caustic environments, consult Factory
 Lensing required for WET and COR applications
 AIM endcap not suitable for WET applications
 Consult Factory for cost adders for WET and COR applications

Lensing Multipliers


Lens	
Standard/Nominal = WA Lens	
Lumen Multipliers Compared to "Nominal"	
CA	107.3%
CP	101.2%
WA (nominal)	100.0%
WP	77.5%

CCT	
Standard/Nominal = 3500K CCT	
Lumen Multipliers Compared to "Nominal"	
6500K	100.0%
5700K	100.0%
5000K	103.2%
4000K	103.9%
3500K (nominal)	100.0%
3000K	95.0%
2700K	90.0%

CRI	
Standard/Nominal = 80 CRI	
Lumen Multipliers Compared to "Nominal"	
80 CRI (nominal)	100.0%
90 CRI Options	
6500K (90 CRI)	84.9%
5700K (90 CRI)	85.2%
5000K (90 CRI)	85.2%
4000K (90 CRI)	85.2%
3500K (90 CRI)	83.5%
3000K (CRI 90)	81.0%
2700K (CRI 90)	76.6%

Optical Distribution Variations**Lensed (CA, CP, WA, or WP)**

Achieved using any of our standard lenses

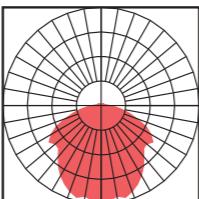

Page 3 of 6

775.200.0707


luxdynamics.com

Revised 06/26/2025

Technical Specifications**Part #**

HIGH-2-850 (for 5000K), HIGH-2-840 (for 4000K) or HIGH-2-835 (for 3500K)

- 23.14" L x 3.75" W x 3.34" H
- Weight: 3 LBS

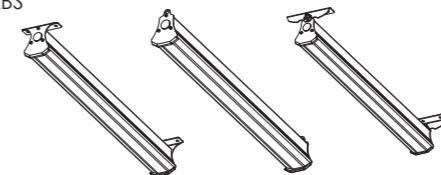

3500K

HIGH-2-835			
Lens Option	Delivered Lumens	Wattage	Efficacy
HIGH-2-835-U10-xx-CA	8,309	53.48	155
HIGH-2-835-U10-xx-CP	7,837	53.48	147
HIGH-2-835-U10-xx-WA	7,744	53.48	145
HIGH-2-835-U10-xx-WP	6,006	53.48	112

4000K

HIGH-2-840			
Lens Option	Delivered Lumens	Wattage	Efficacy
HIGH-2-840-U10-xx-CA	8,631	53.48	161
HIGH-2-840-U10-xx-CP	8,141	53.48	152
HIGH-2-840-U10-xx-WA	8,044	53.48	150
HIGH-2-840-U10-xx-WP	6,239	53.48	117


5000K

HIGH-2-850			
Lens Option	Delivered Lumens	Wattage	Efficacy
HIGH-2-850-U10-xx-CA	8,572	53.48	160
HIGH-2-850-U10-xx-CP	8,085	53.48	151
HIGH-2-850-U10-xx-WA	7,989	53.48	149
HIGH-2-850-U10-xx-WP	6,196	53.48	116

Part #

HIGH-4-850 (for 5000K), HIGH-4-840 (for 4000K) or HIGH-4-835 (for 3500K)

- 46.20" L x 3.75" W x 3.34" H
- Weight: 6 LBS

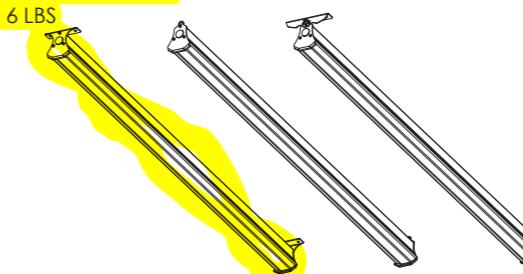

3500K

HIGH-4-835			
Lens Option	Delivered Lumens	Wattage	Efficacy
HIGH-4-835-U10-xx-CA	16,619	106.96	155
HIGH-4-835-U10-xx-CP	15,674	106.96	147
HIGH-4-835-U10-xx-WA	15,488	106.96	145
HIGH-4-835-U10-xx-WP	12,012	106.96	112

4000K

HIGH-4-840			
Lens Option	Delivered Lumens	Wattage	Efficacy
HIGH-4-840-U10-xx-CA	17,263	106.96	161
HIGH-4-840-U10-xx-CP	16,281	106.96	152
HIGH-4-840-U10-xx-WA	16,095	106.96	150
HIGH-4-840-U10-xx-WP	12,477	106.96	117


5000K

HIGH-4-850			
Lens Option	Delivered Lumens	Wattage	Efficacy
HIGH-4-850-U10-xx-CA	17,145	106.96	160
HIGH-4-850-U10-xx-CP	16,170	106.96	151
HIGH-4-850-U10-xx-WA	15,978	106.96	149
HIGH-4-850-U10-xx-WP	12,392	106.96	116

Page 4 of 6

HIGH-4-6lm-835

- 6.000lm for 6,000lm approx. or HIGH-4-10lm for 10,000lm approx.

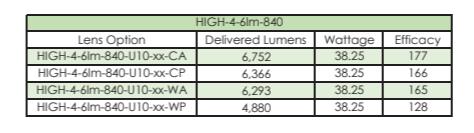

3500K

HIGH-4-10lm-835			
Lens Option	Delivered Lumens	Wattage	Efficacy


<tbl

Technical Specifications Cont.

Part

HIGH-8-850 (for 5000K), HIGH-8-840 (for 4000K) or HIGH-8-835 (for 3500K)

- 91.20" L x 3.75" W x 3.34" H
- Weight: 11 LBS

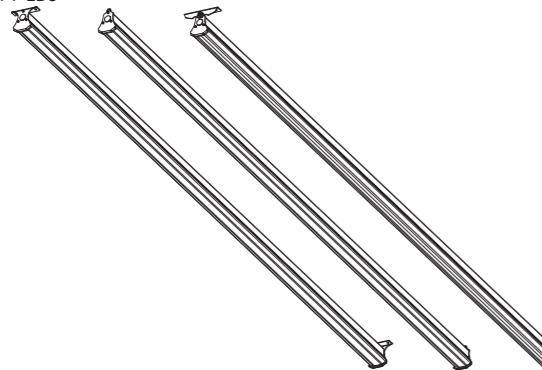

3500K

HIGH-8-835			
Lens Option	Delivered Lumens	Wattage	Efficacy
HIGH-8-835-U10-xx-CA	33,238	213.91	155
HIGH-8-835-U10-xx-CP	31,348	213.91	147
HIGH-8-835-U10-xx-WA	30,976	213.91	145
HIGH-8-835-U10-xx-WP	24,025	213.91	112


4000K

HIGH-8-840			
Lens Option	Delivered Lumens	Wattage	Efficacy
HIGH-8-840-U10-xx-CA	34,525	213.91	161
HIGH-8-840-U10-xx-CP	32,562	213.91	152
HIGH-8-840-U10-xx-WA	32,190	213.91	150
HIGH-8-840-U10-xx-WP	24,955	213.91	117

5000K

HIGH-8-850			
Lens Option	Delivered Lumens	Wattage	Efficacy
HIGH-8-850-U10-xx-CA	34,289	213.91	160
HIGH-8-850-U10-xx-CP	32,340	213.91	151
HIGH-8-850-U10-xx-WA	31,956	213.91	149
HIGH-8-850-U10-xx-WP	24,785	213.91	116


Endcap Option Details

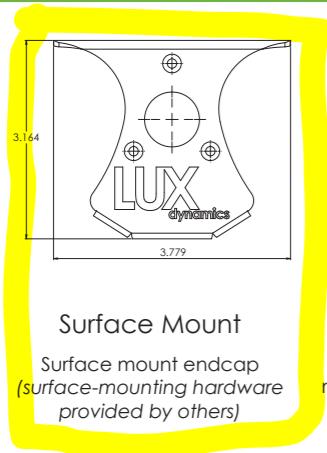


Surface Mount

Surface mount endcap
(surface-mounting hardware
provided by others)

Hanger Mount

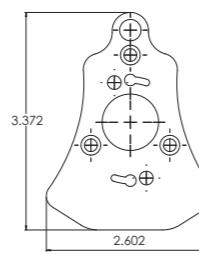2Pxx, 2PxxS: Aircraft cable
mounting with snap hooks (xx
denotes cable length)


Tandem Mount

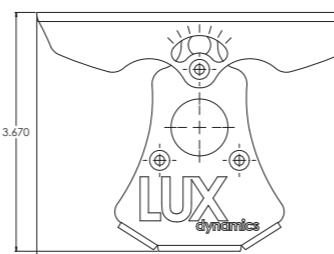
Rotatable Surface Mount

Rotatable surface mount endcap
(surface-mounting hardware
provided by others)

Tandem Mount

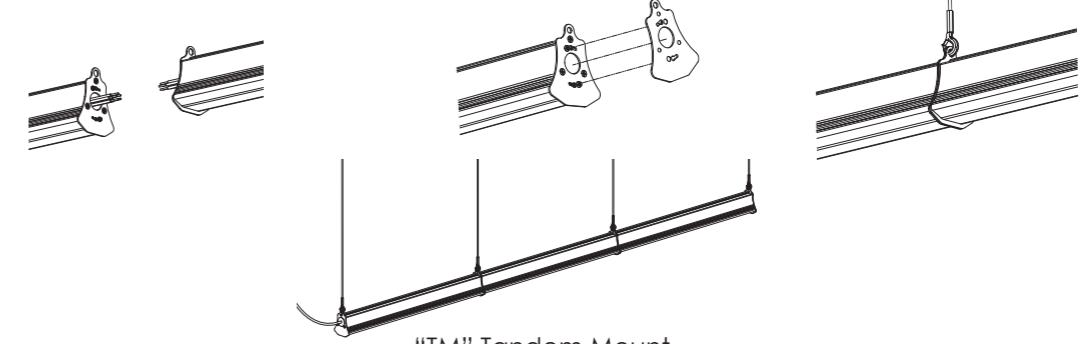


"TM" Tandem Mount

Hanger Mounting


- Consult factory for tandem mounting options
- Near seamless runs of fixtures in 2', 4', and 8' increments
- Tandem-bracket locking mechanism allows for easy installation
- Run length limitations may exist depending on application
- Wire connectors provided to splice tandem fixtures together

Electrical Connections

Standard Power Feed



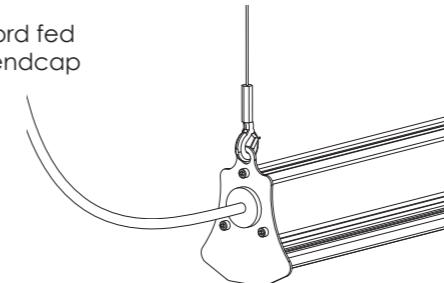
Power cord fed
through endcap

"WB" Power Feed

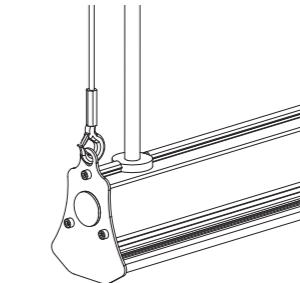Power cord fed
through machined
hole in
electronics
channel

TYPE LN1

□ SLX NEON 15X15VB

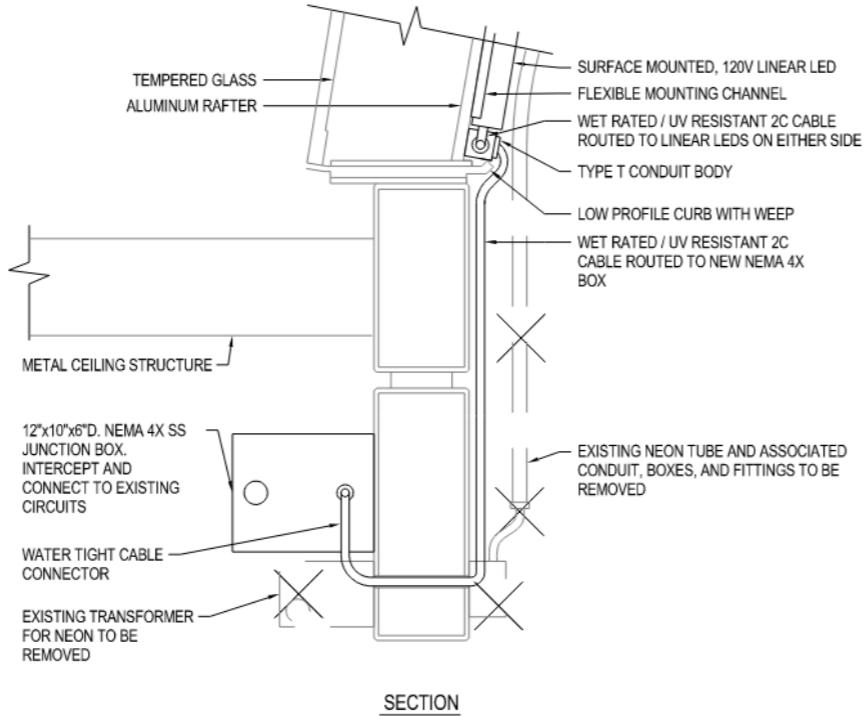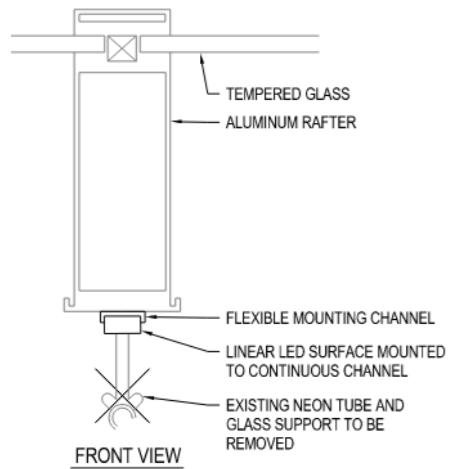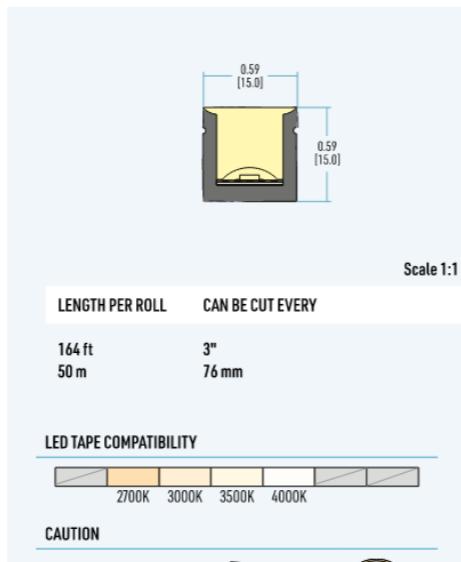


DETAIL NOTES:

1. MOUNT LINEAR LED PER MANUFACTURER'S INSTRUCTIONS.
2. ELECTRICAL INSTALLATION INCLUDING ALL MATERIALS MUST BE RATED FOR WET LOCATION.
3. ELECTRICAL INSTALLATIONS TO BE SECURED TO STRUCTURE USING STAINLESS STEEL SELF TAPPING SCREWS.
4. CONDUIT, JUNCTION BOXES, MOUNTING EQUIPMENT, AND ASSOCIATED HARDWARE SHALL BE PAINTED TO MATCH BACKGROUND SURFACE COLOR.

TYPE LN1 LED NEON REPLACEMENT DETAIL

4

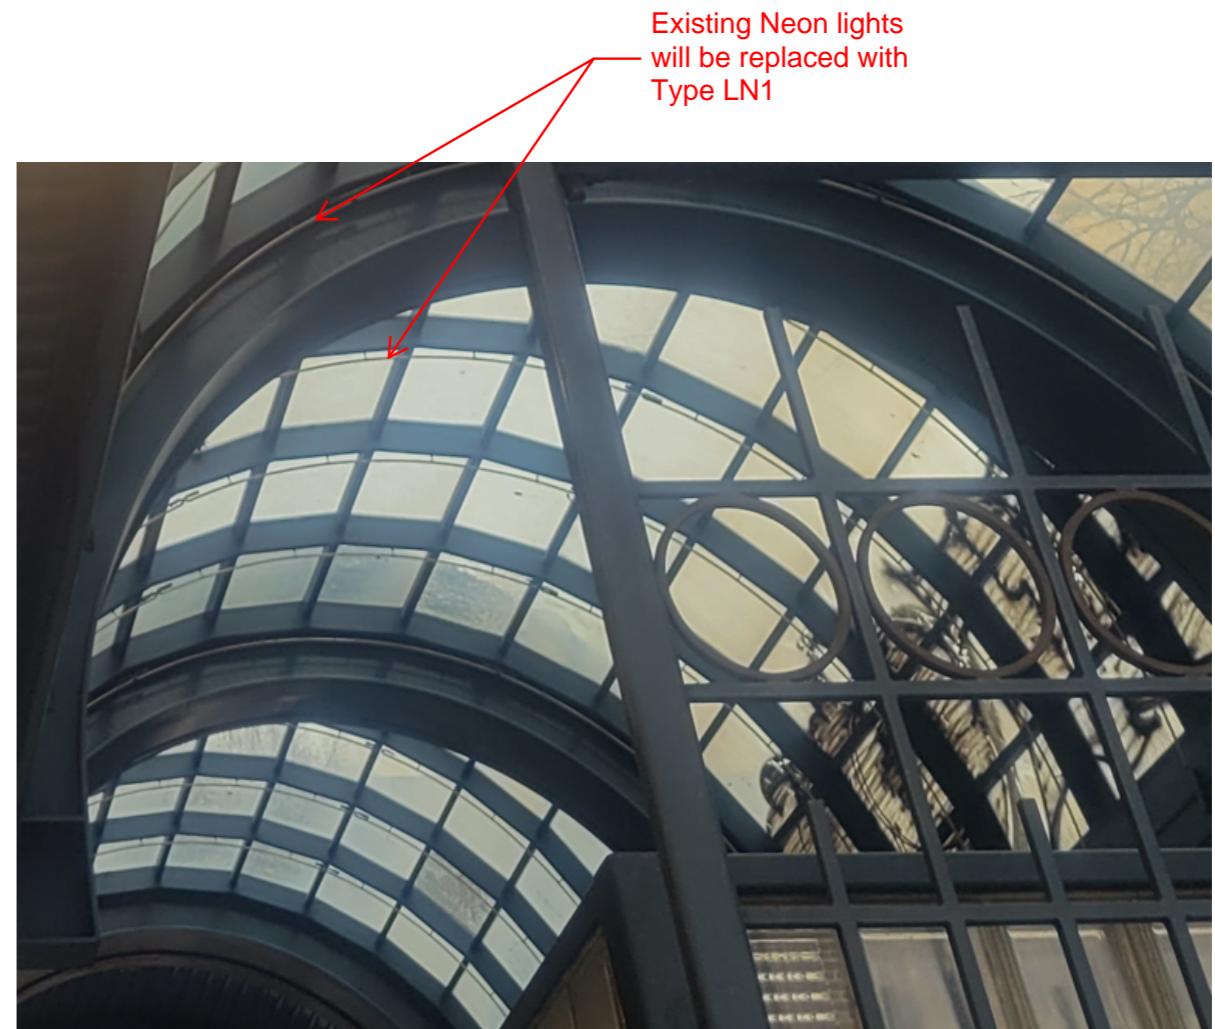



□ SLX NEON
15X15VB



The SLX Neon 15x15 VB is a line voltage 120V flexible silicone channel that bends up and down on the vertical axis. It provides a beautifully diffused uniform linear light. Designed to illuminate along curved surfaces. Resistant to UV light.

PRODUCT FEATURES

- 120VAC, 15x15mm, Vertical Bend, Min.section 3", Max.run 164'.
- IP65 silicone extrusion,matte coated process,smooth surface and dustproof.
- Dot free and perfectly homogeneous linear LED light line.
- Constant current design,overvoltage protection.
- Do not need transformer box to change AC to DC, connect with line voltage directly.
- For dimming applications, please use our LTN series drivers.
- With bared power cords with surge protector.
- ETL certified,5 years warranty for indoor use and 3 years warranty for outdoor use.
- Ambient working temperature -40°C to 40°C (-40°F to 104°F).

SUGGESTED APPLICATIONS

- bars
- displays
- shelving
- toe kick
- under cabinet
- cove

lumentruss



LUMINARE CUT SHEET


Type: **LN1**
DSTT LIGHTING IMPROVEMENT
CN 0113-25
SEATTLE, WA

Note: This Fixture Cut Is For Information Only. Refer To Specs For All Catalogue Numbers, Lamps Finishes, Accessories, Etc.



SOUNDTRANSIT

TYPE LN1

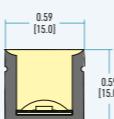


Scale 1:1

LENGTH PER ROLL CAN BE CUT EVERY

164 ft 3"
50 m 76 mm

LED TAPE COMPATIBILITY

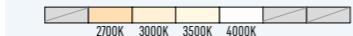

CAUTION



LOCATION RATING



OTHER OPTIONS



□□ STATIC WHITE ORDERING SHEET

1	2	3	4	5	6	7
Channel	Mounting	Lumen Package	CCT	Power Feed	Input / Output	Length, in
NS1515V	MCCF	LPL	K40	PCHX		

1	2	3	4	5	6	7
CHANNEL	Mounting	LUMEN PACKAGE	CCT	POWER FEED	INPUT / OUTPUT	LENGTH*
NS1515V	MCCF	LPL	K40	PCHX		

1 CHANNEL
NS1515V

2 MOUNTING
MCCR - Mount, channel, rigid
MCCF - Mount, channel, flexible
MNO - No mounting

3 LUMEN PACKAGE
120V - 120VAC
120V - 120VAC


4 CCT
K27 - 2700K
K30 - 3000K
K35 - 3500K
K40 - 4000K

5 POWER FEED
PCH3 - Hardwire, 3ft wire
PCHX - Hardwire, custom length
* (6" - 35" / 15 cm - 90 cm)

6 INPUT / OUTPUT
WSE - Simple lead-in, end feed
WPE - Pass-through, end feed

7 LENGTH*
Length of the luminaire in inches.
*Can be cut every 3 inches.

TYPE LN1

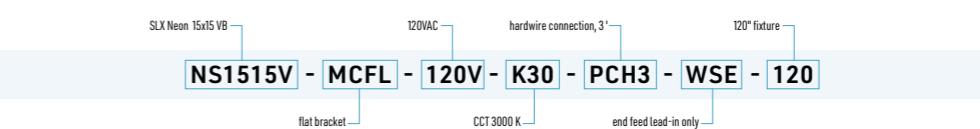

info@lumentruss.com / www.lumentruss.com / 1-855-394-2384
LumenTruss™. All rights reserved.

lumentruss



LUMINARE CUT SHEET

Type: **LN1**
DSTT LIGHTING IMPROVEMENT
CN 0113-25
SEATTLE, WA

Note: This Fixture Cut Is For Information Only. Refer To Specs For All Catalogue Numbers, Lamps Finishes, Accessories, Etc.

Cut Sheet LN1

B1




Pioneer Square Station (Prefontaine)
entrance along 2nd Avenue

Pioneer Square Station (Prefontaine) entrance along 2nd Avenue.
3D Rendering with Type LG1-EM, Type LS1, and Type LN1 light fixtures.

Type LN1
(Typical)

Type LS1
(Typical for 2)


NOTE: 3D Rendering only shows
the proposed light fixtures for the
station. Other light fixtures in the
area are not included.

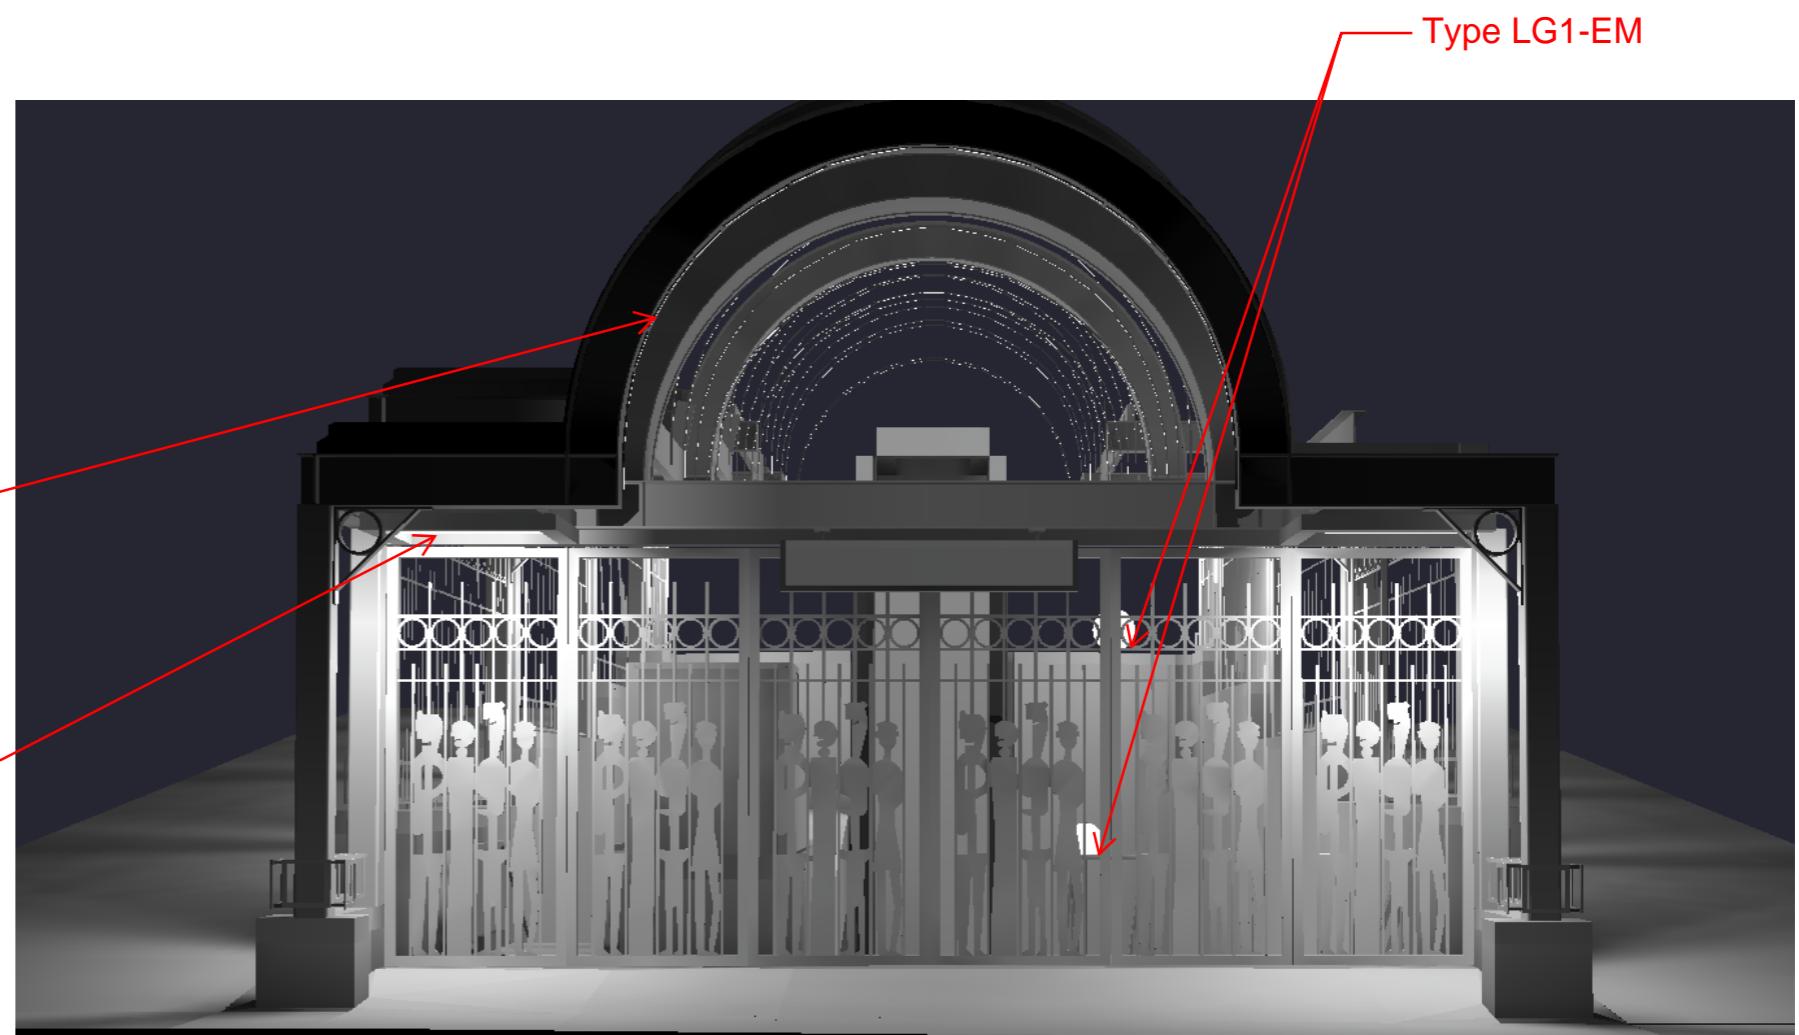



Pioneer Square Station (Prefontaine) along 3rd Avenue
PHOTO TAKEN IN 2019

Pioneer Square Station (Prefontaine) along 3rd Avenue. 3D Rendering with Type LG1-EM, Type LS1, Type LS2 and Type LN1 light fixtures.

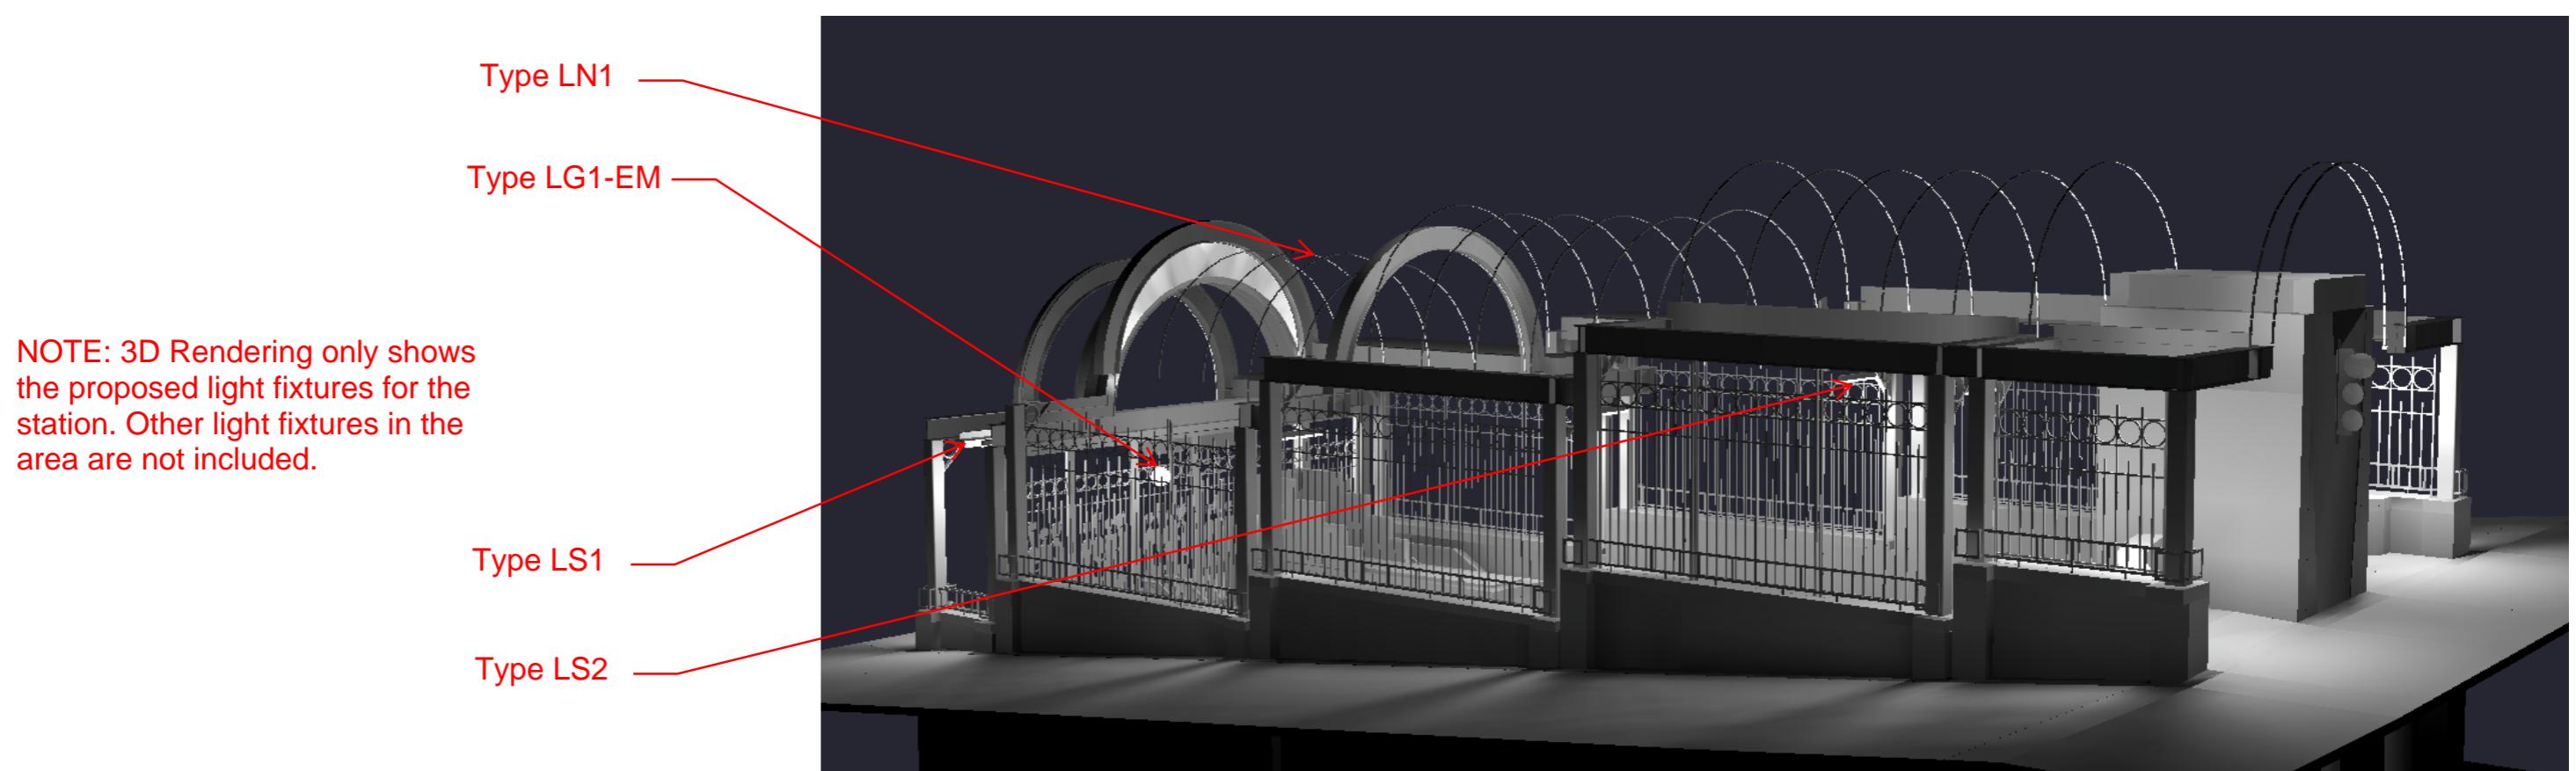

SOUNDTRANSIT

Yesler Way to 3rd Ave


B1



Pioneer Square Station (Prefontaine)
Jefferson Street to 3rd Avenue

NOTE: 3D Rendering only shows the proposed light fixtures for the station. Other light fixtures in the area are not included.

Pioneer Square Station (Prefontaine) Jefferson Street to 3rd Avenue
3D Rendering with Type LS1, Type LS2, and Type LN1 light fixtures.

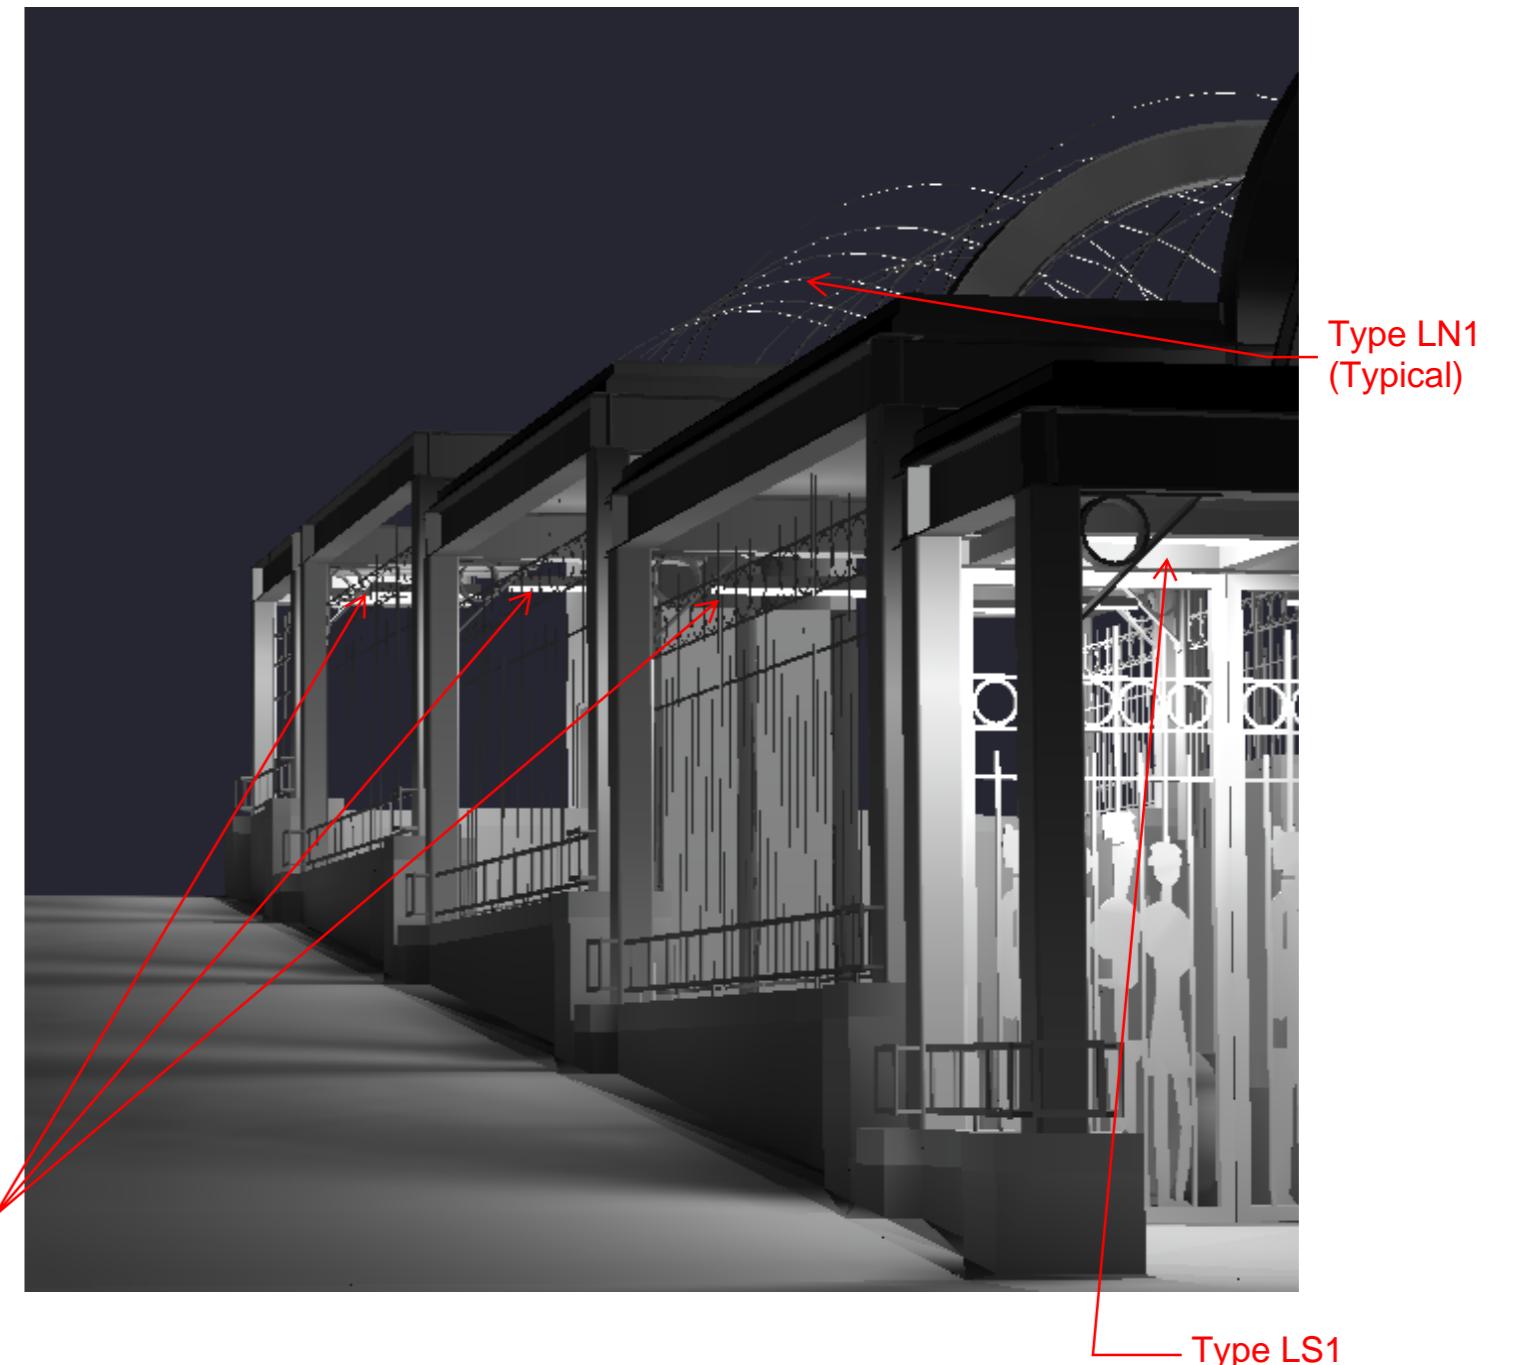




Pioneer Square Station (Prefontaine)
Jefferson Street to 2nd Avenue

Pioneer Square Station (Prefontaine) Jefferson Street to 2nd Avenue
3D Rendering with Type LS2 light fixtures.

Type LS2

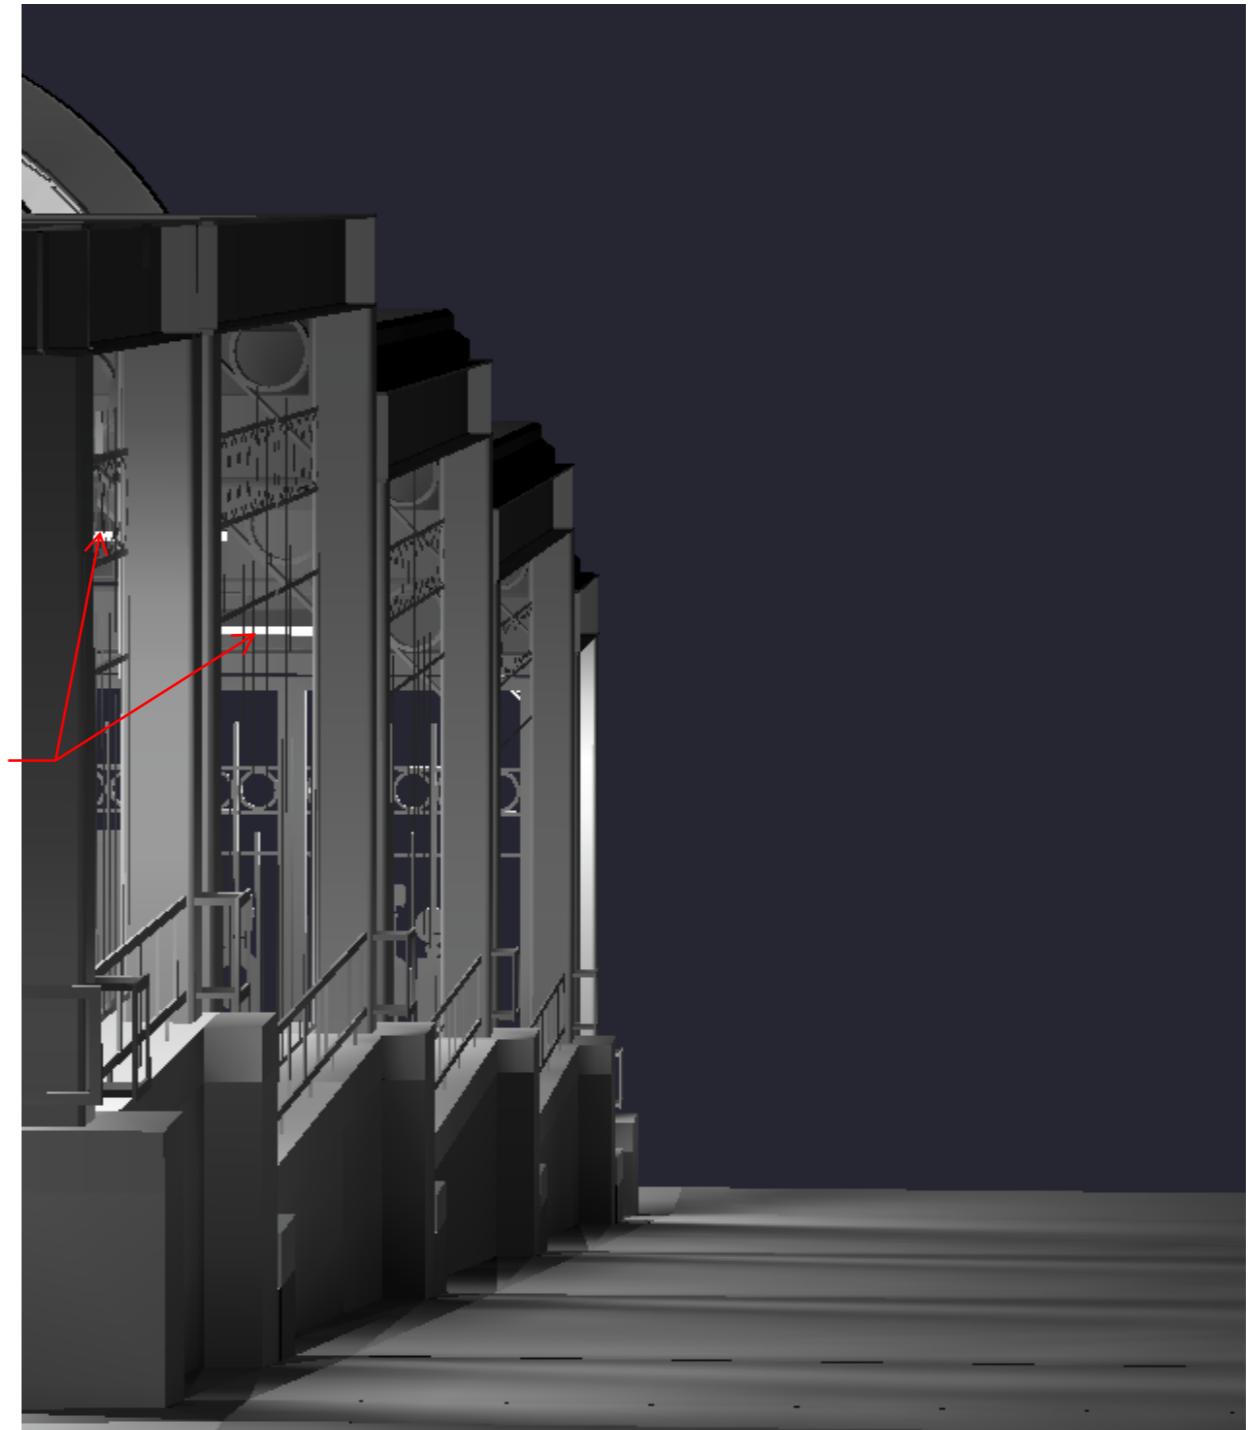


NOTE: 3D Rendering only shows
the proposed light fixtures for the
station. Other light fixtures in the
area are not included.




Pioneer Square Station (Prefontaine)
Yesler Way to 3rd Avenue

NOTE: 3D Rendering only shows the proposed light fixtures for the station. Other light fixtures in the area are not included.

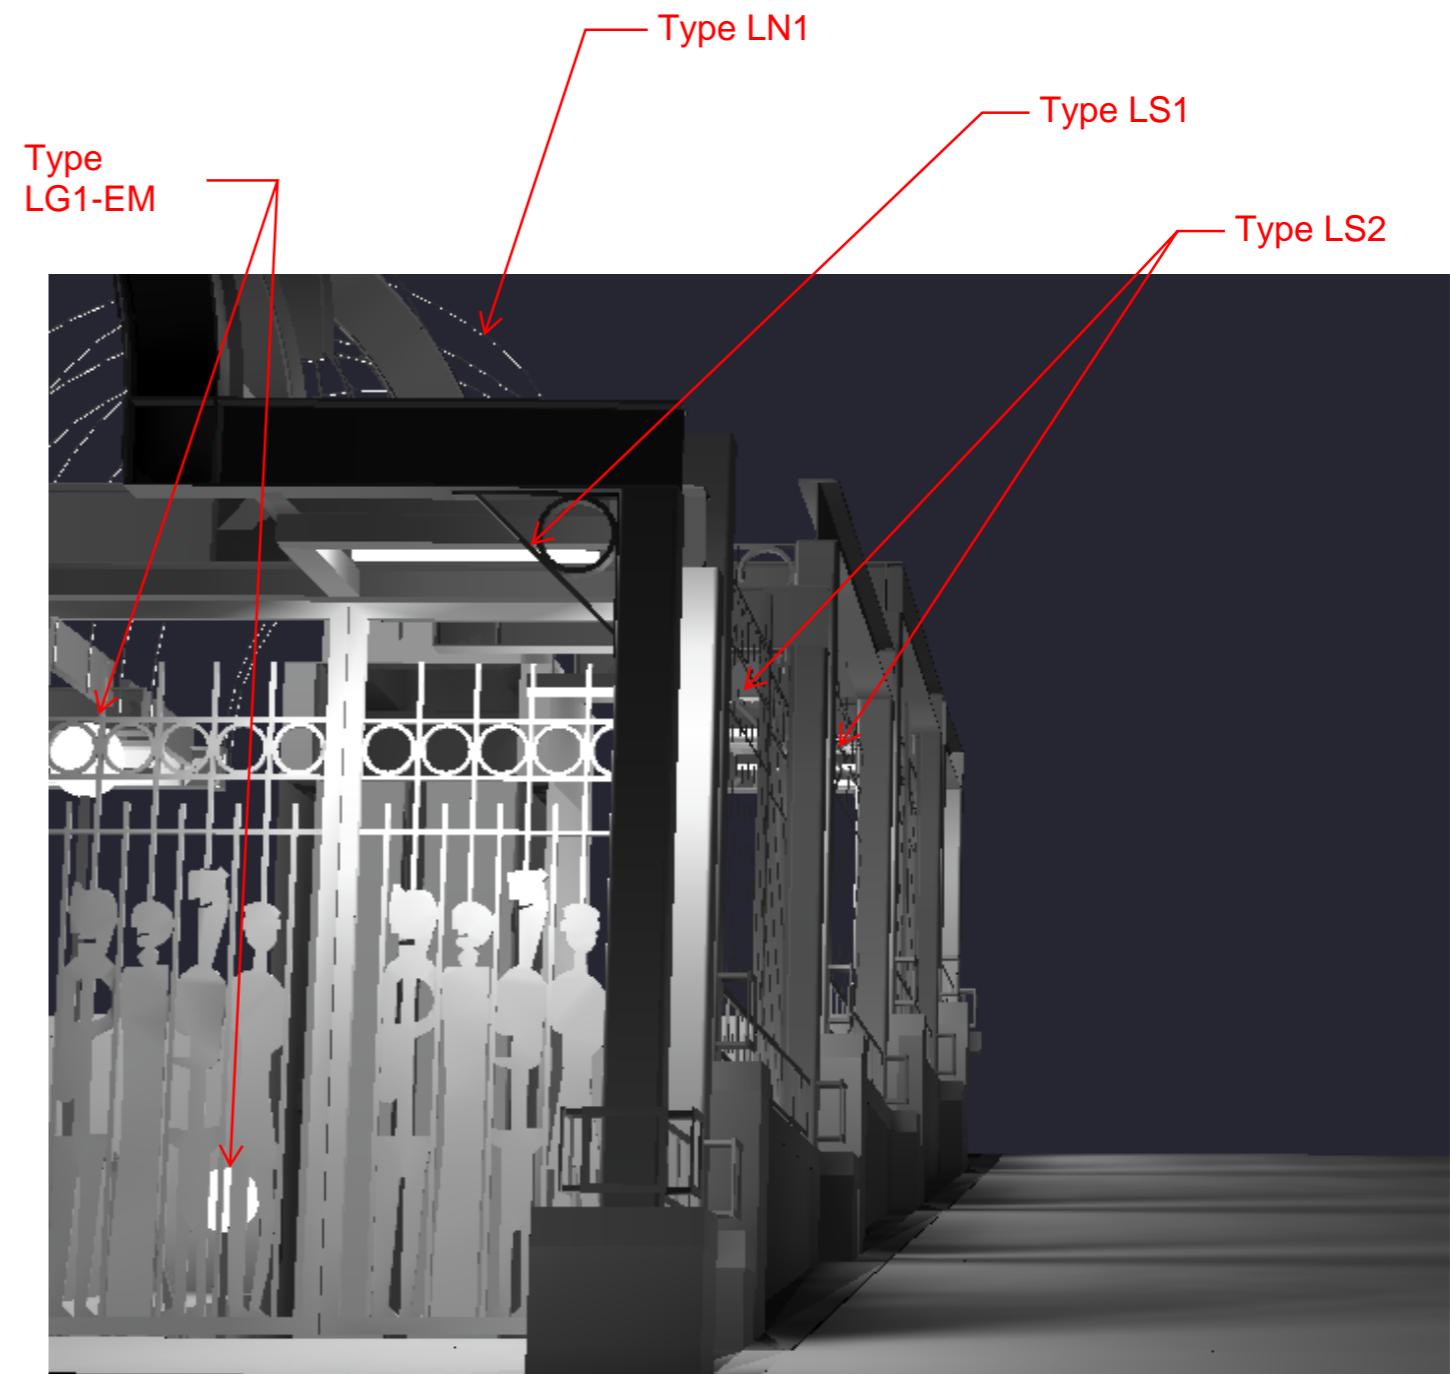


Pioneer Square Station (Prefontaine) Yesler Way to 2nd Avenue
3D Rendering with Type LG1-EM, Type LS1, and Type LN1 light fixtures.

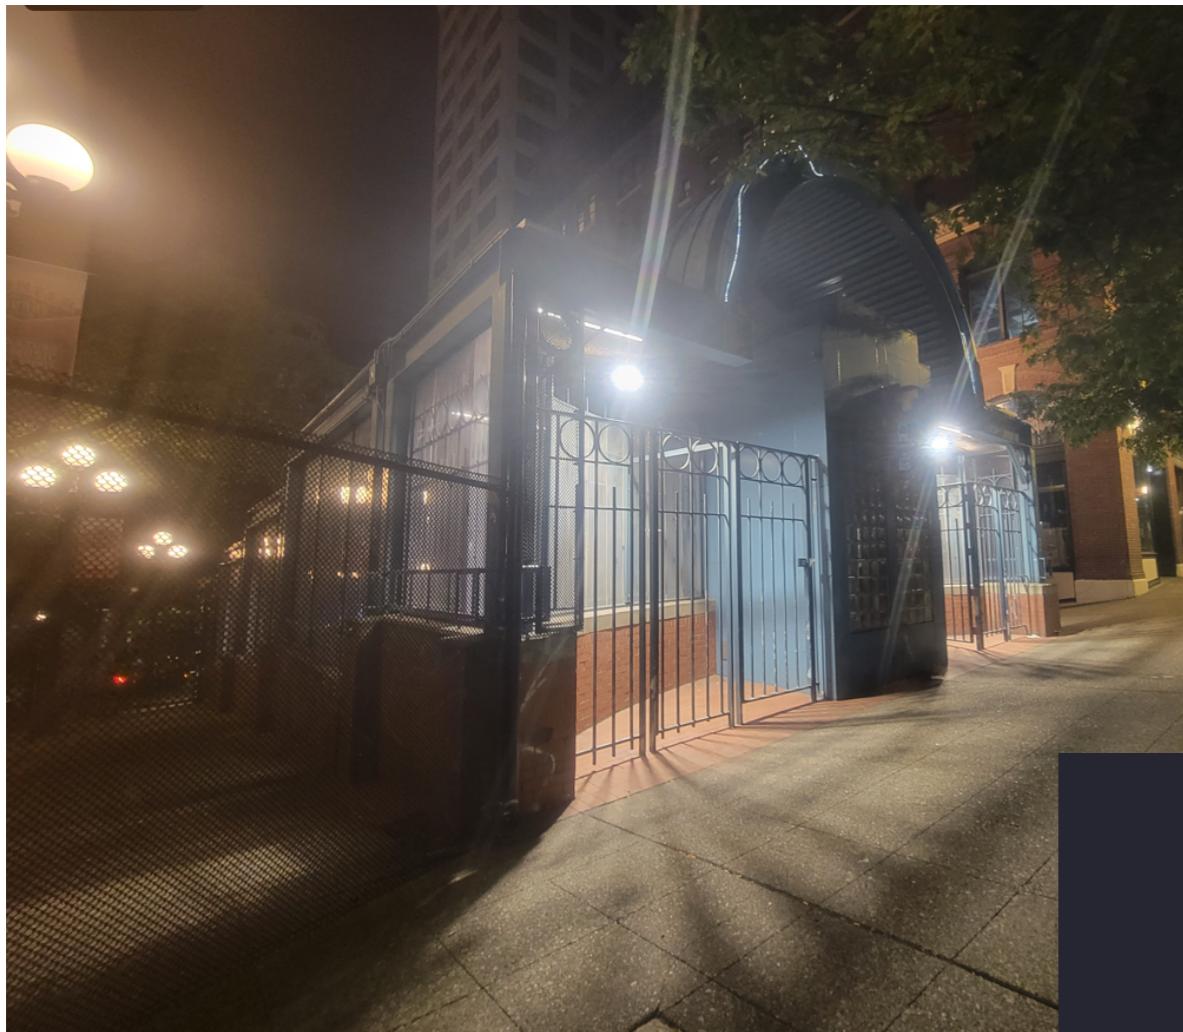


Pioneer Square Station (Prefontaine)
from 3rd Avenue

NOTE: 3D Rendering only shows
the proposed light fixtures for the
station. Other light fixtures in the
area are not included.


Pioneer Square Station (Prefontaine) from 3rd Avenue
3D Rendering with Type LG1-EM, Type LS1, and Type LN1 light
fixtures.

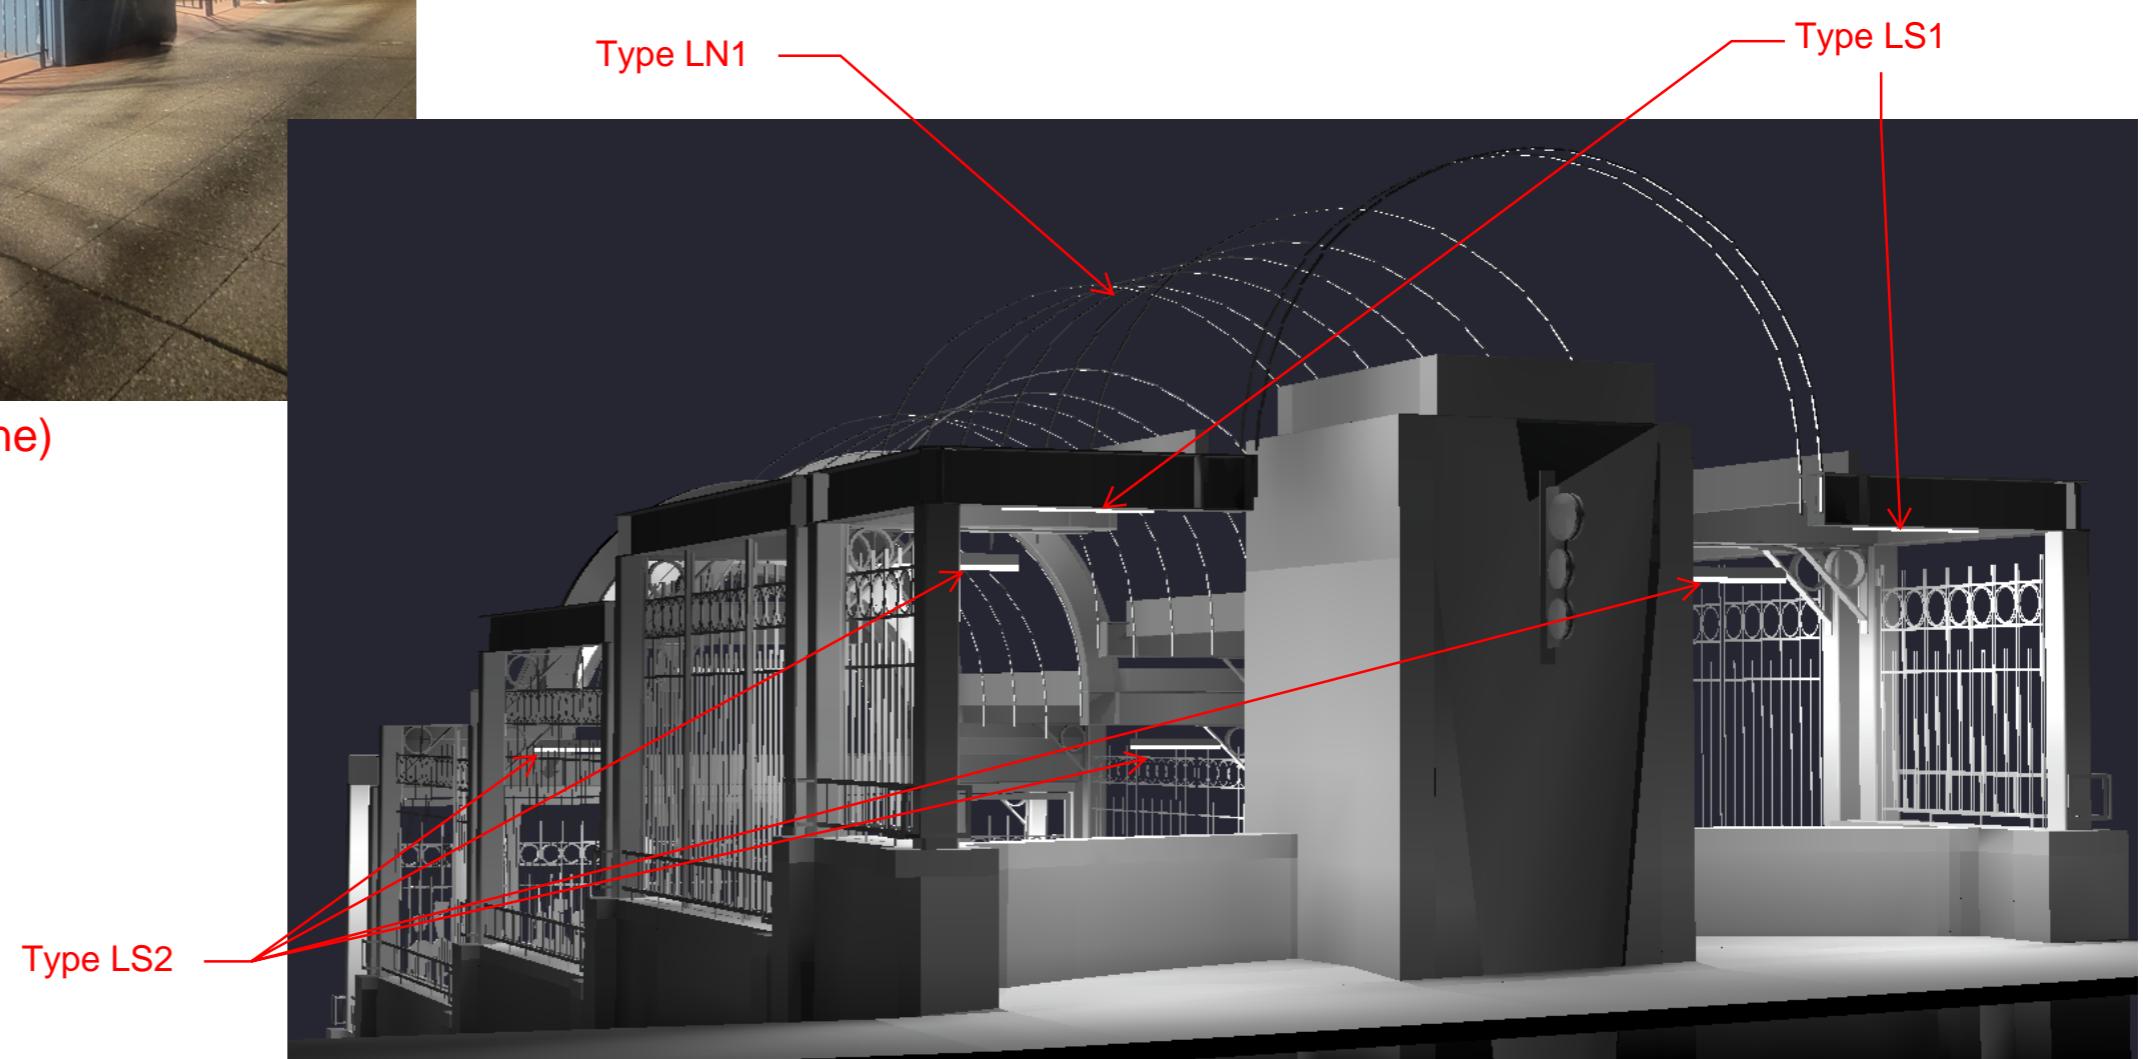

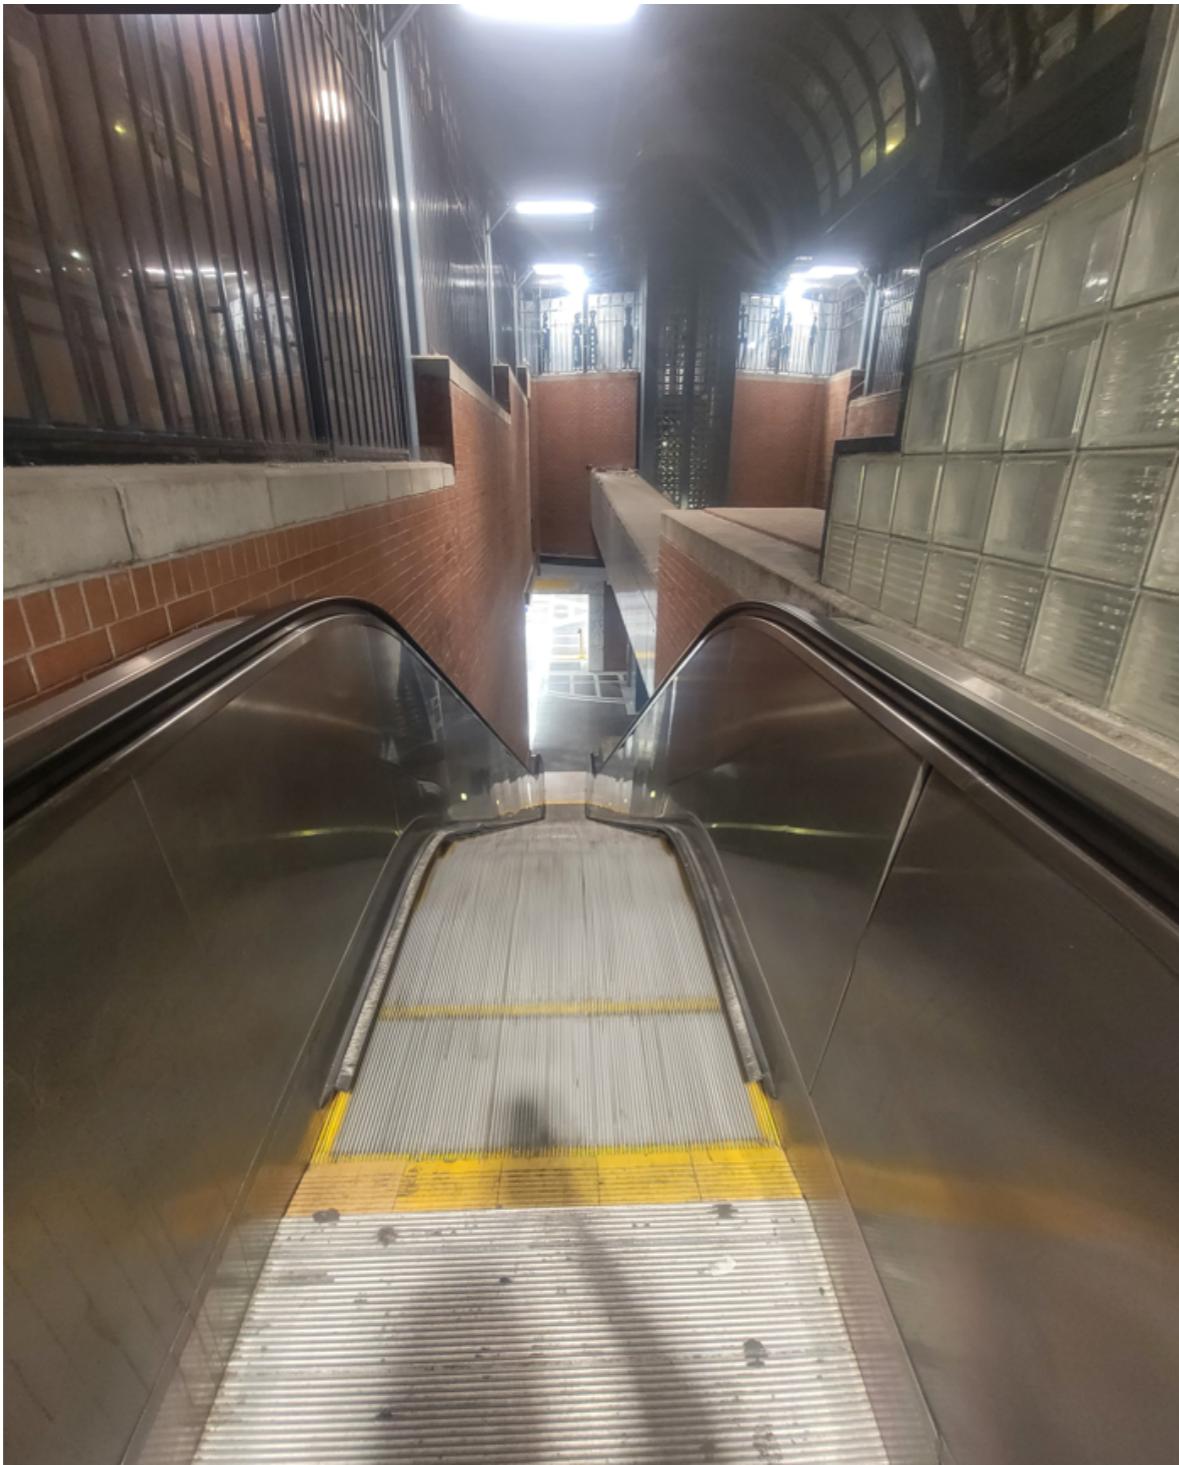


Pioneer Square Station (Prefontaine)
at the escalator area

NOTE: 3D Rendering only shows the proposed light fixtures for the station. Other light fixtures in the area are not included.

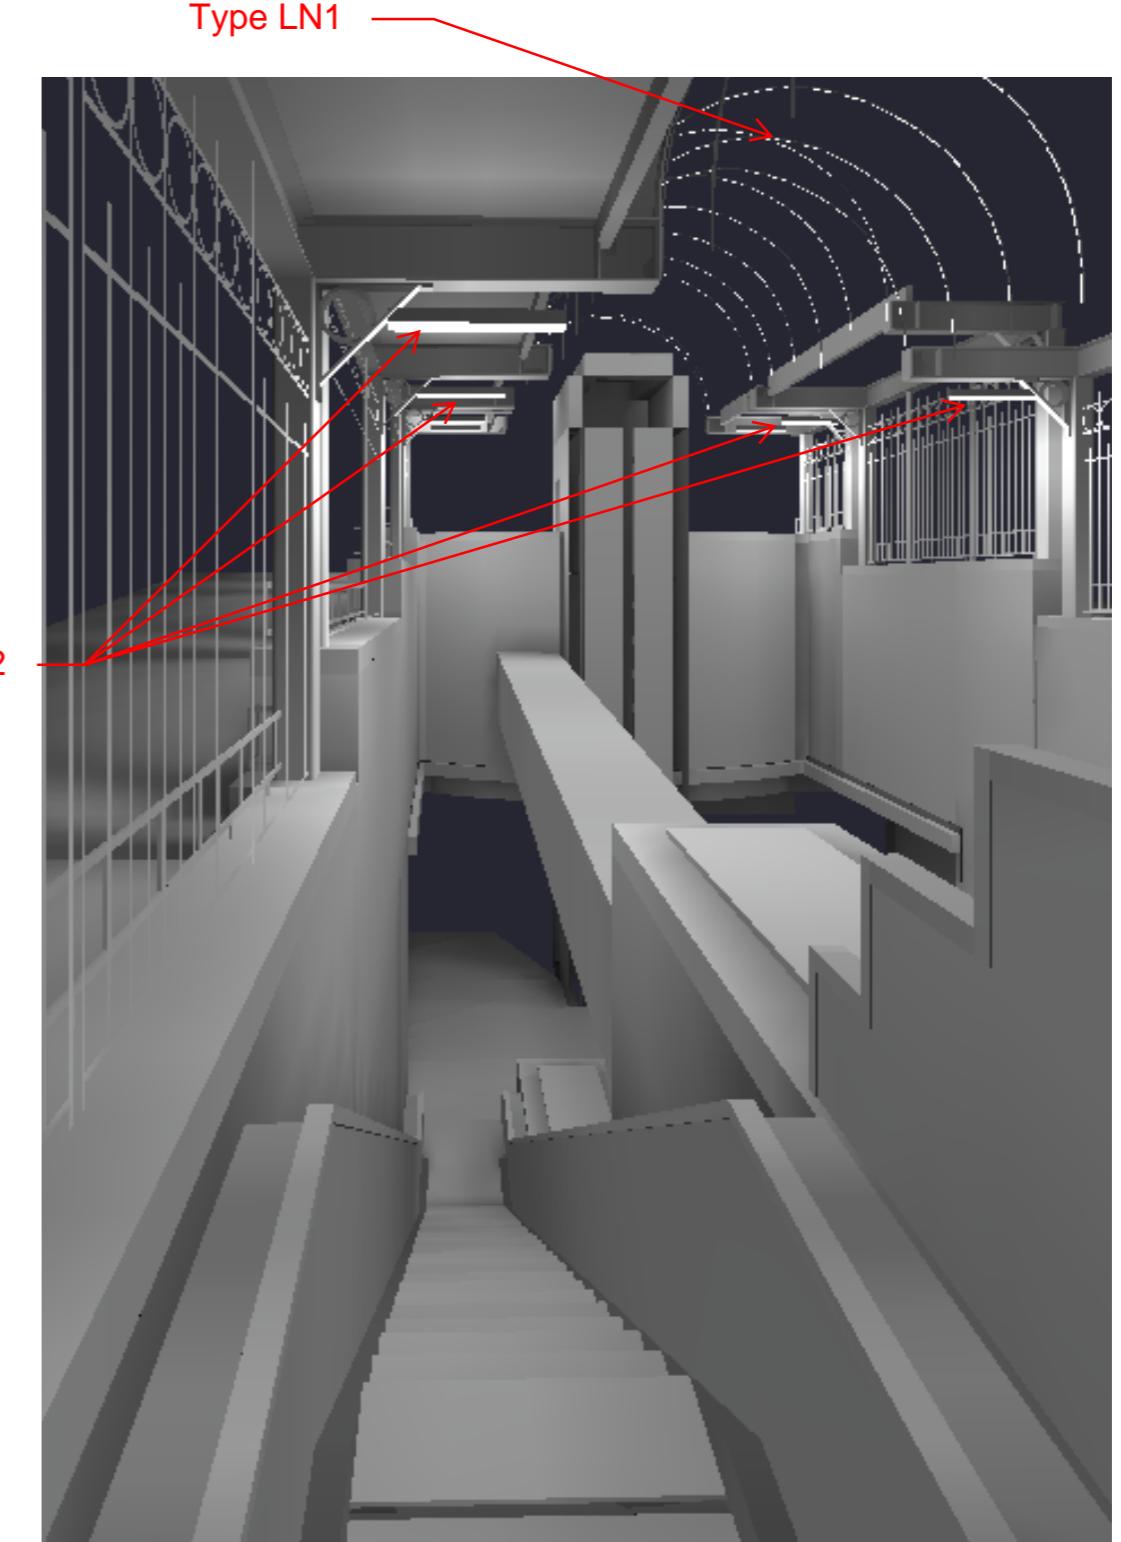


Pioneer Square Station (Prefontaine) at the escalator area
3D Rendering with Type LS2, and Type LN1 light fixtures.

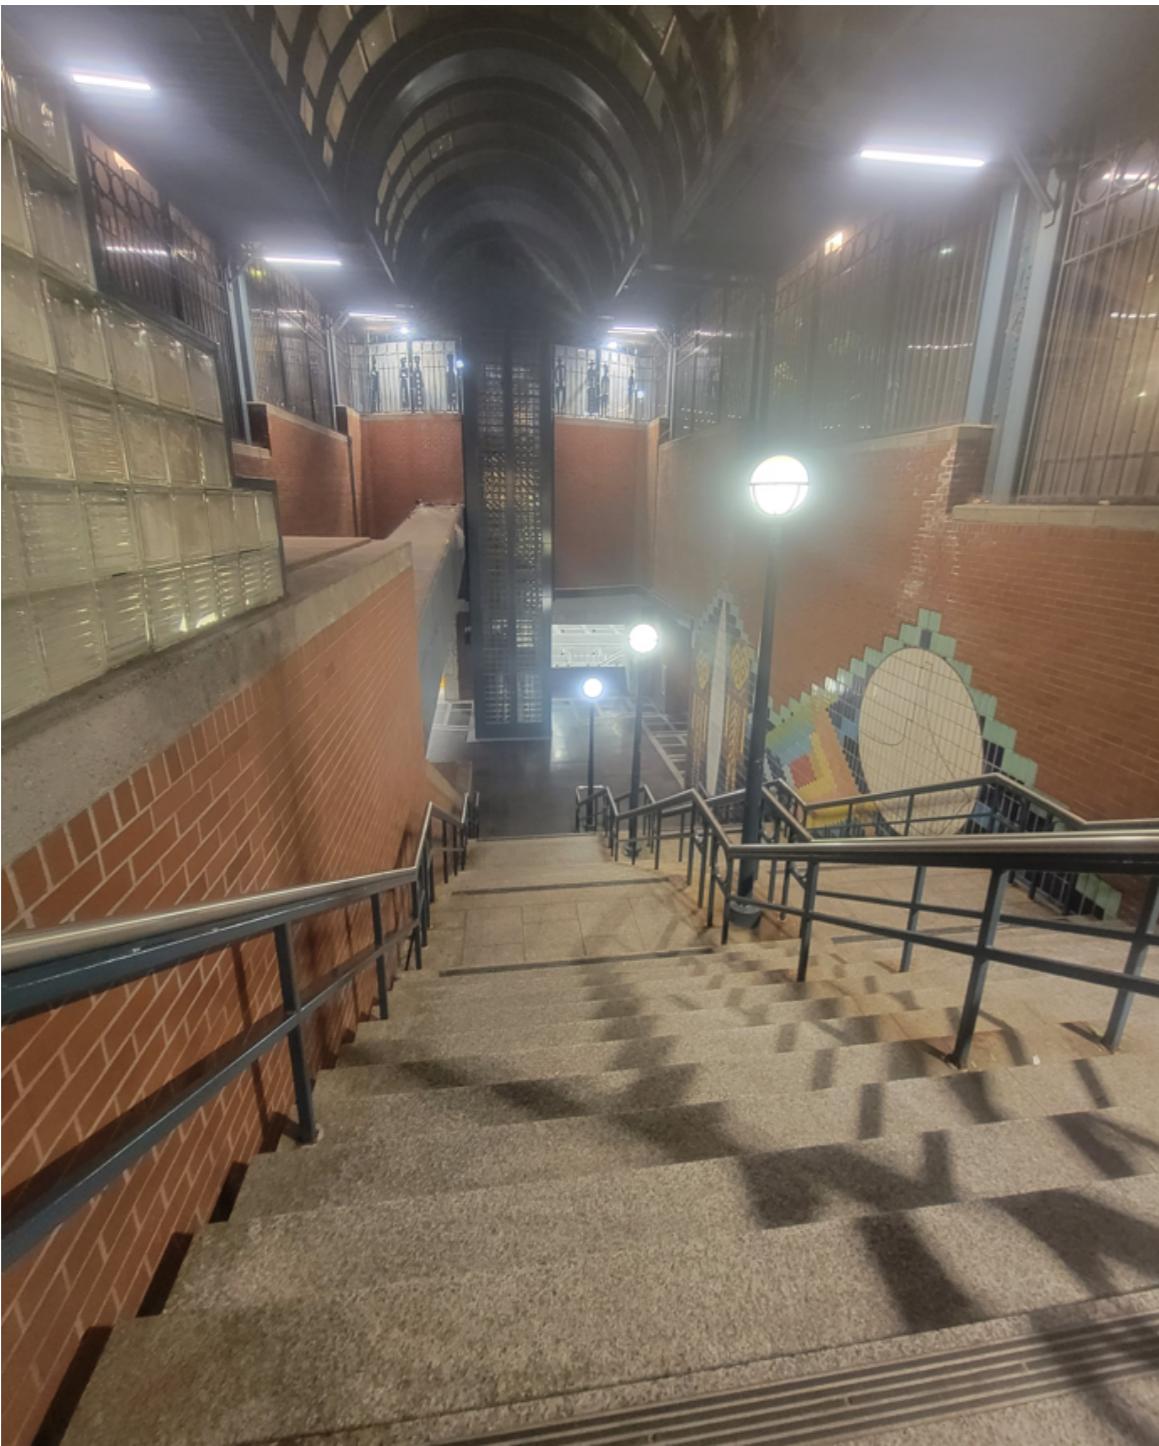

Pioneer Square Station (Prefontaine)
at the stair areas

NOTE: 3D Rendering only shows the proposed light fixtures for the station. Other light fixtures in the area are not included.

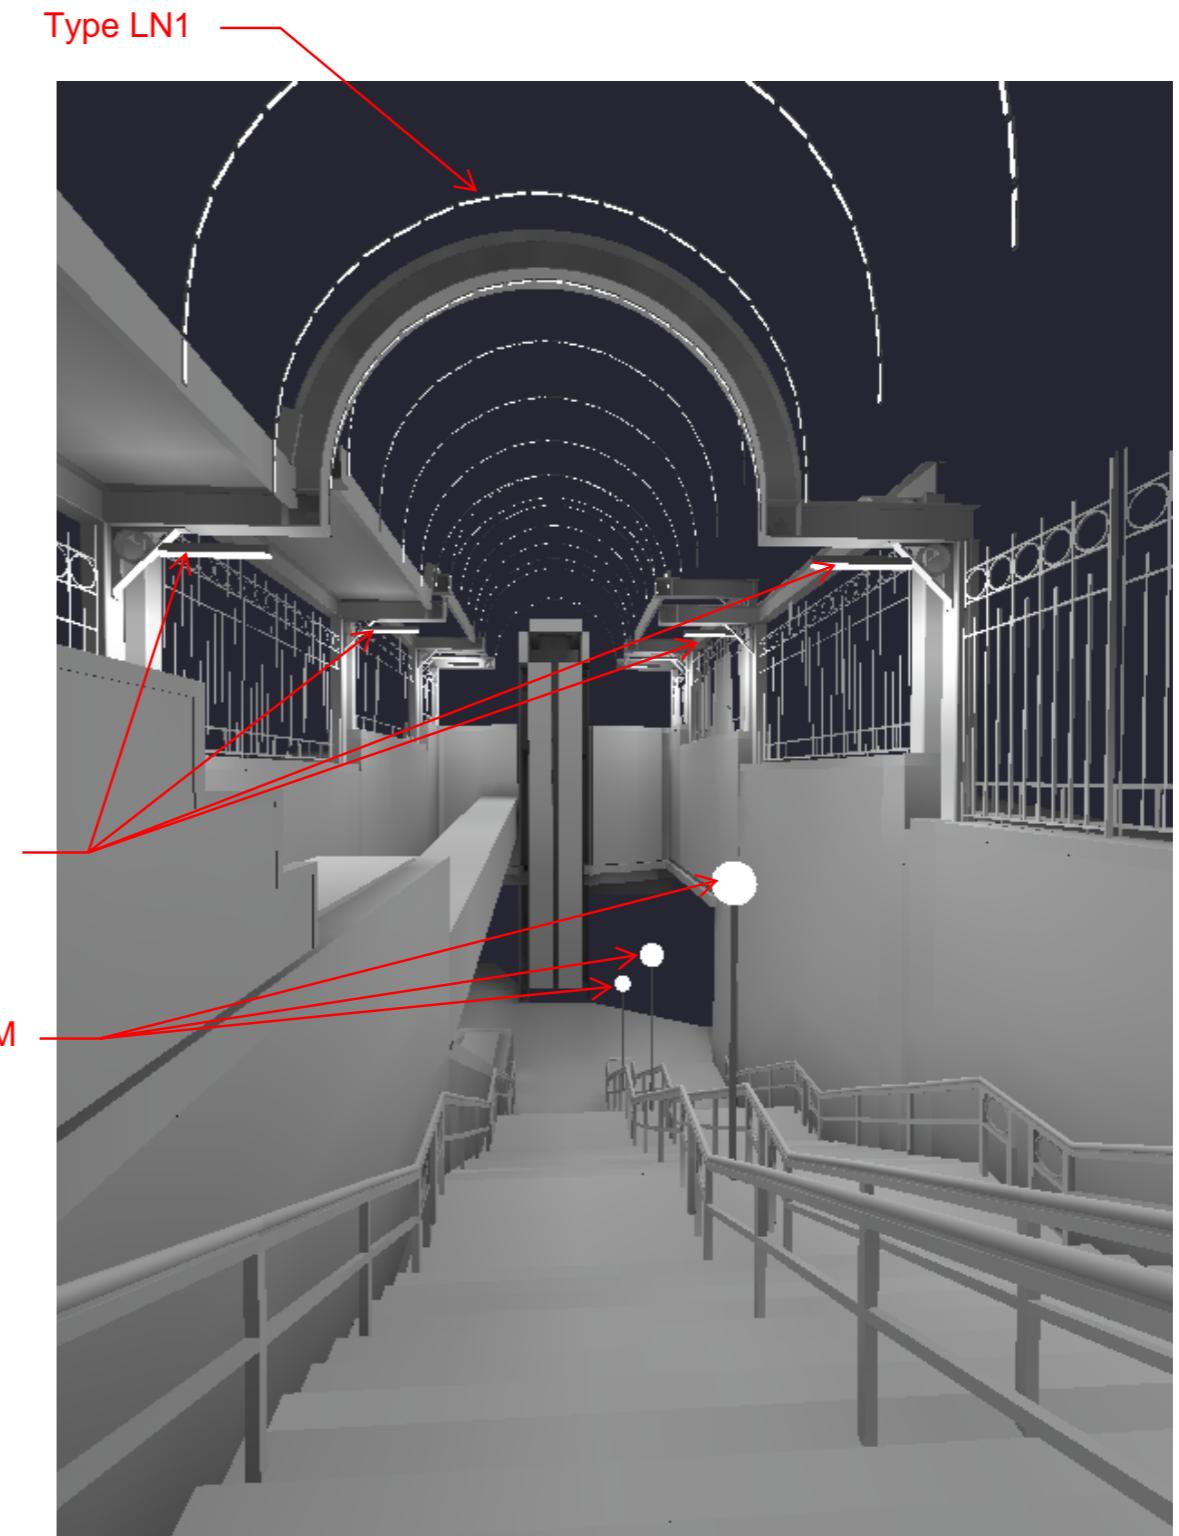

Pioneer Square Station (Prefontaine) at the stairs areas.
3D Rendering with Type LG1-EM, Type LS2, and Type LN1
light fixtures.



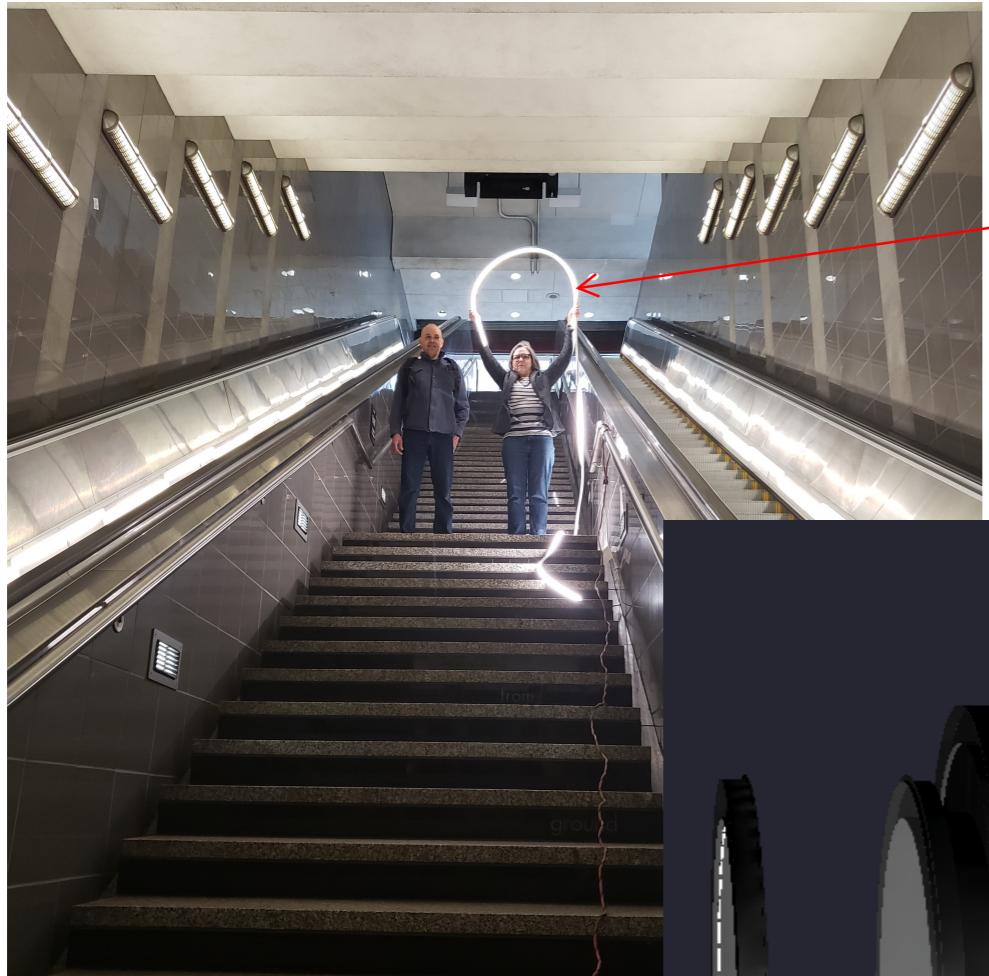


ILLUSTRATION OF
THE NEON LIGHT
REPLACEMENT
(TYPE LN1) THAT
WILL BE INSTALLED
ON THE ALUMINUM
RAFTER

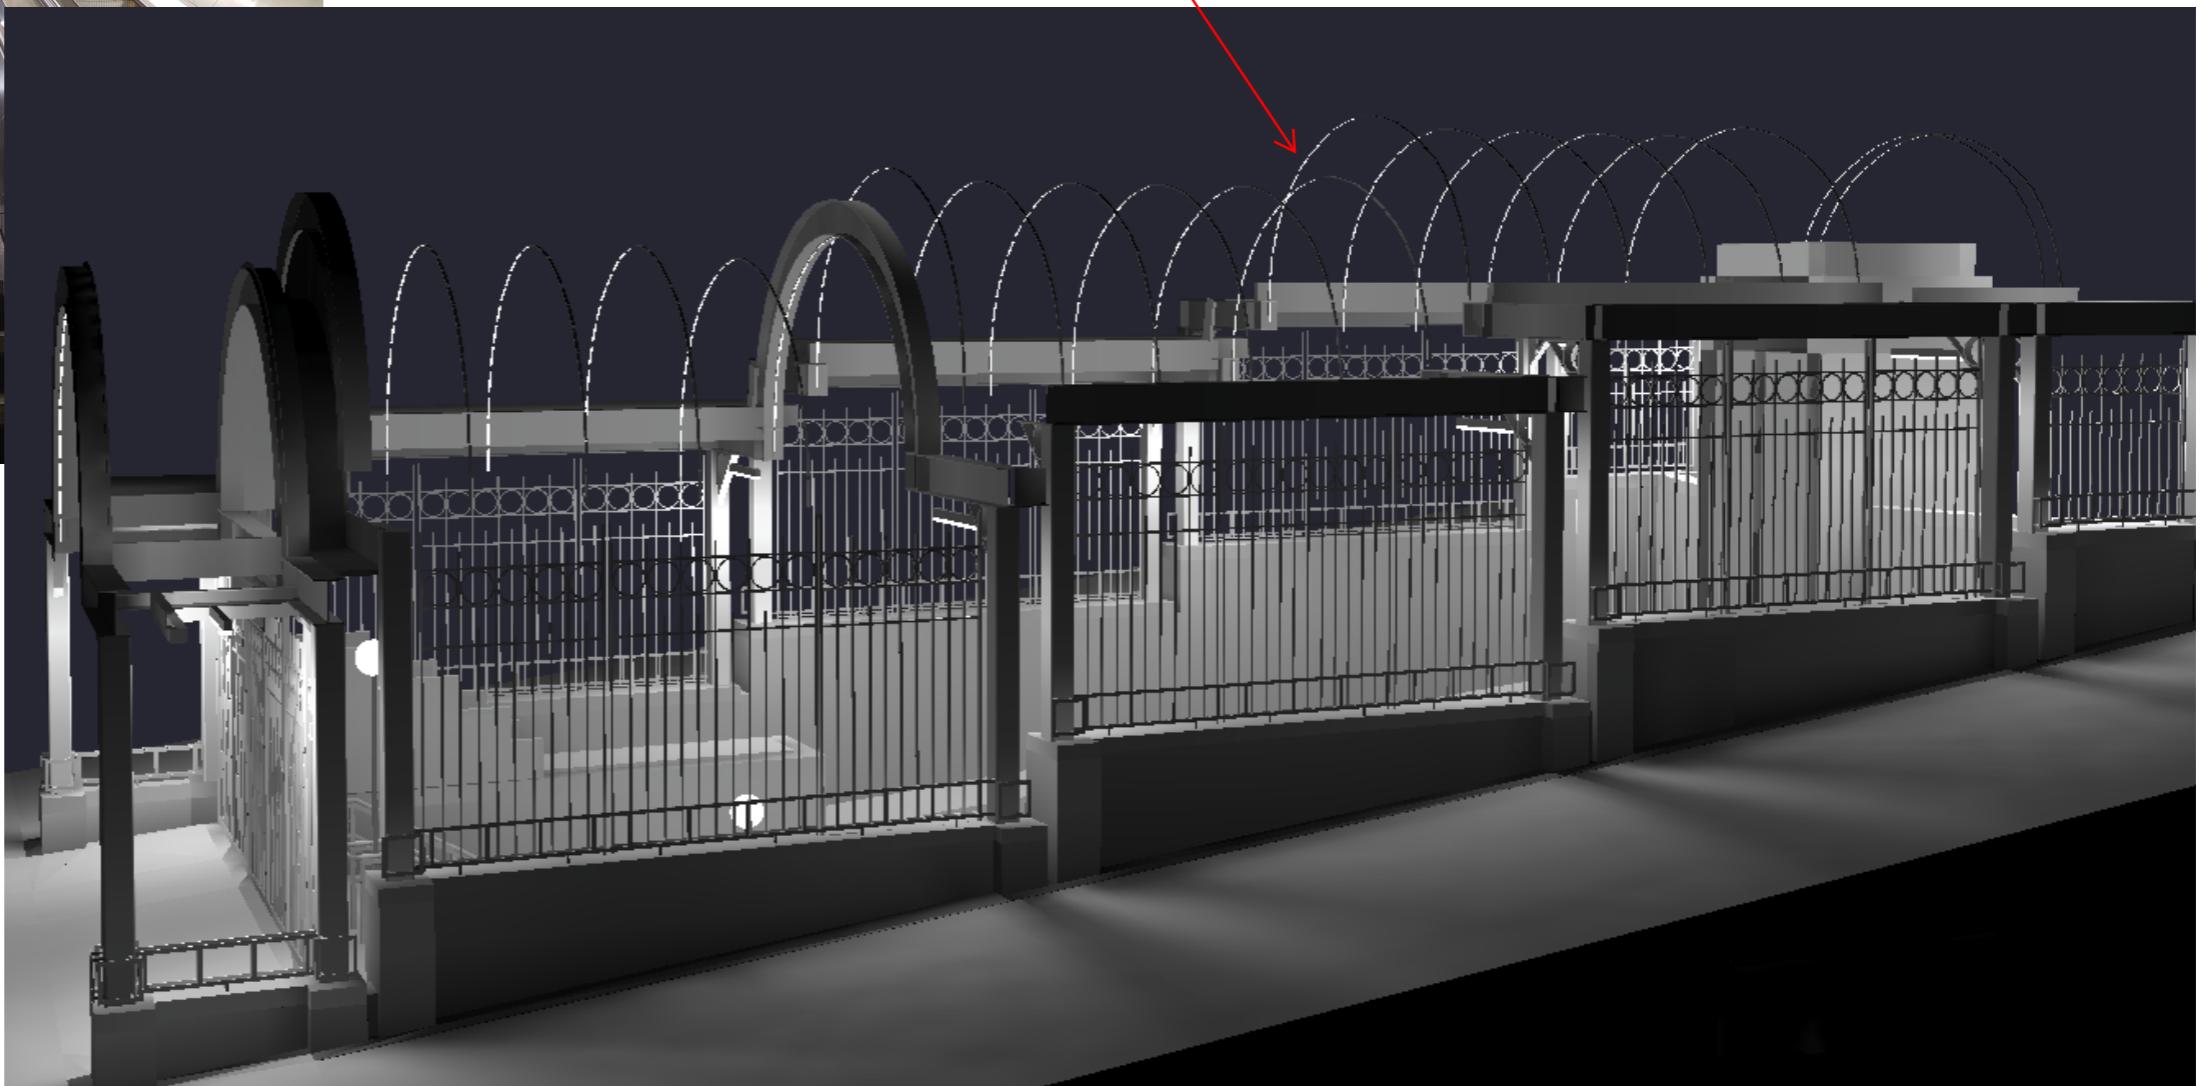


NOTE: 3D Rendering only shows the proposed light fixtures for the station. Other light fixtures in the area are not included.

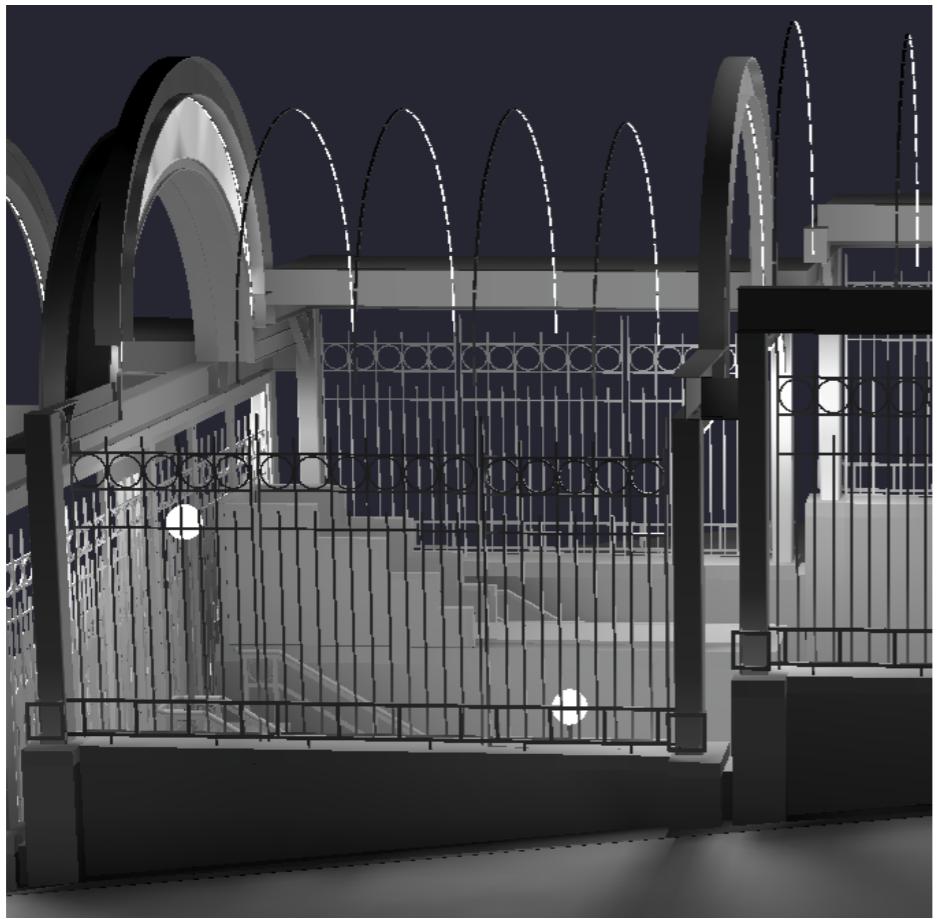

Pioneer Square Station (Prefontaine)
3D Rendering of Type LG1-EM
replacement for the existing neon
lights.

NOTE: 3D Rendering only shows
the proposed light fixtures for the
station. Other light fixtures in the
area are not included.

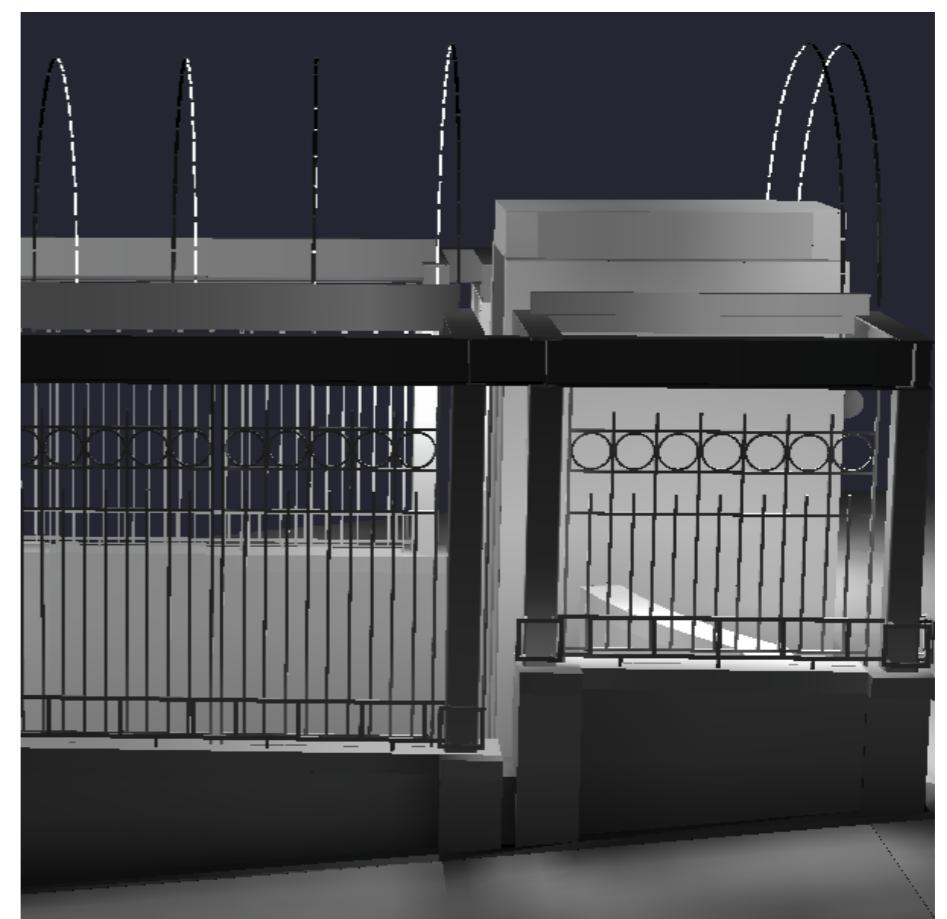

Thank you!

Questions?