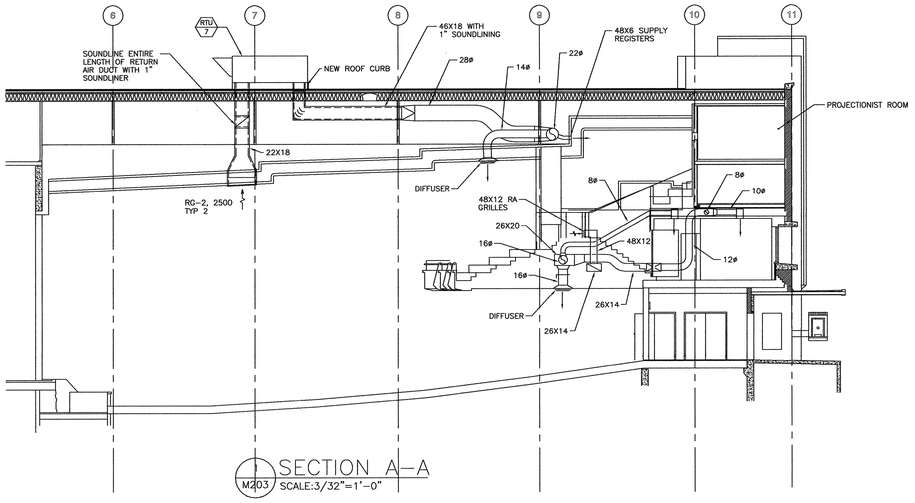

SECTION A–A
M203 SCALE:3/32"=1'-0"

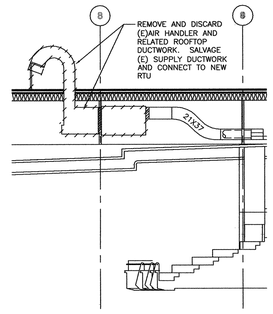

3 M203 SECTION C–C (DEMO)
SCALE:3/32"=1'-0"

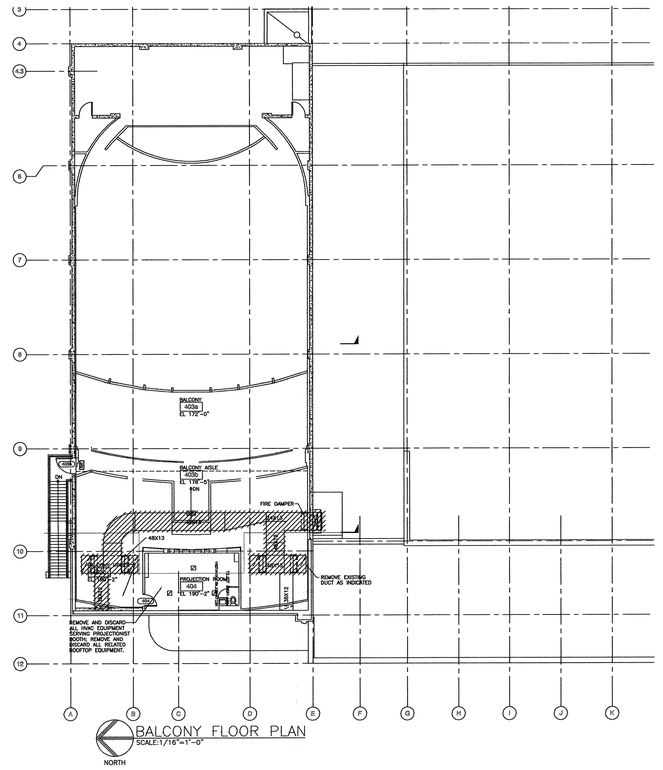

BALCONY FLOOR PLAN
SCALE:1/16"=1'-0"
NORTH

AS BUILT
11/18/03

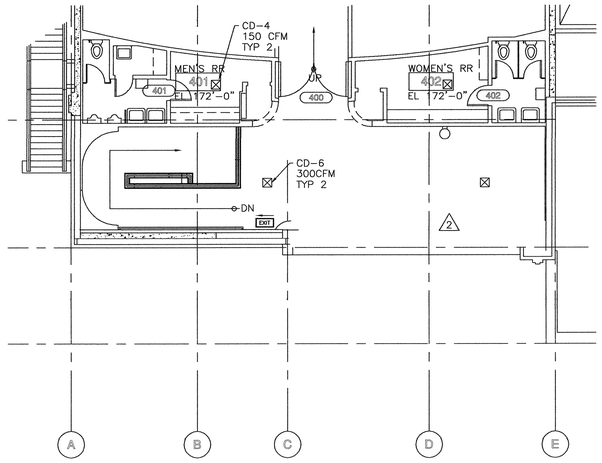

MEZZANINE FLOOR PLAN
SCALE:3/32"=1'-0"
NORTH

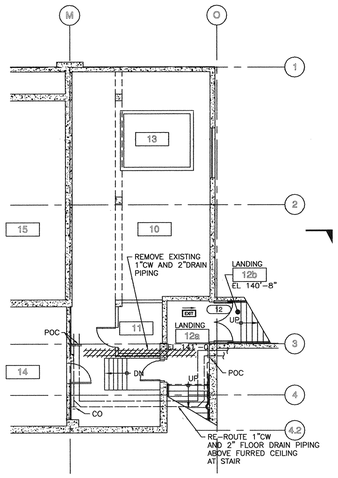

BASEMENT FLOOR PLAN
SCALE:3/32"=1'-0"
NORTH

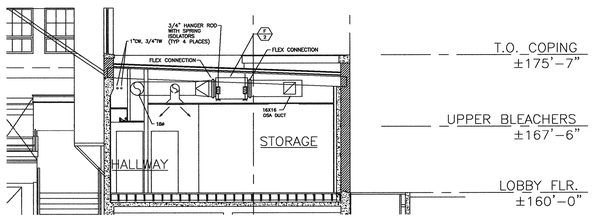

2 M203 SECTION B–B
SCALE:1/8"=1'-0"

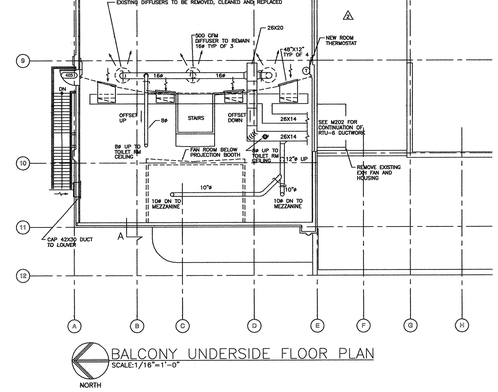

BALCONY UNDERSIDE FLOOR PLAN
SCALE:1/16"=1'-0"
NORTH

MAIN LEVEL

REVISIONS

REV	DESCRIPTION	DATE	APPROVED

MECH. CONTRACTOR
EMERALD AIRE, INC.
PROJECT MANAGER

TITLE:
MAGNUSON PARK COMM. CNTR.
BLDG 47 SAND POINT WAY
SEATTLE, WA
PLUMBING TODAY

SHEET CONTENTS:
SHEET CONTENTS

"Excellence & Integrity"
AIR CONDITIONING • HEATING • REFRIGERATION CONTROLS
SALES • SERVICE • INSTALLATION
5108 D STREET NW
AUBURN, WA 98001
(253) 872-5665 – (800) 291-5191
FAX: (253) 872-5797
CONT. #EMERAAI 035BL
EMERALD AIRE

DRAWN M STOKES
CHECKED BY G KNAPINSKI
DATE 11/17/03
SCALE AS NOTED
JOB NO. 302-426
M4

\\Server1\Company\CAD Drawings\Magnunson PHA\As Built Drawings\As Built M4.dwg, Layout1, 11/19/2003 11:00:31 AM